


Date: 02/15/05

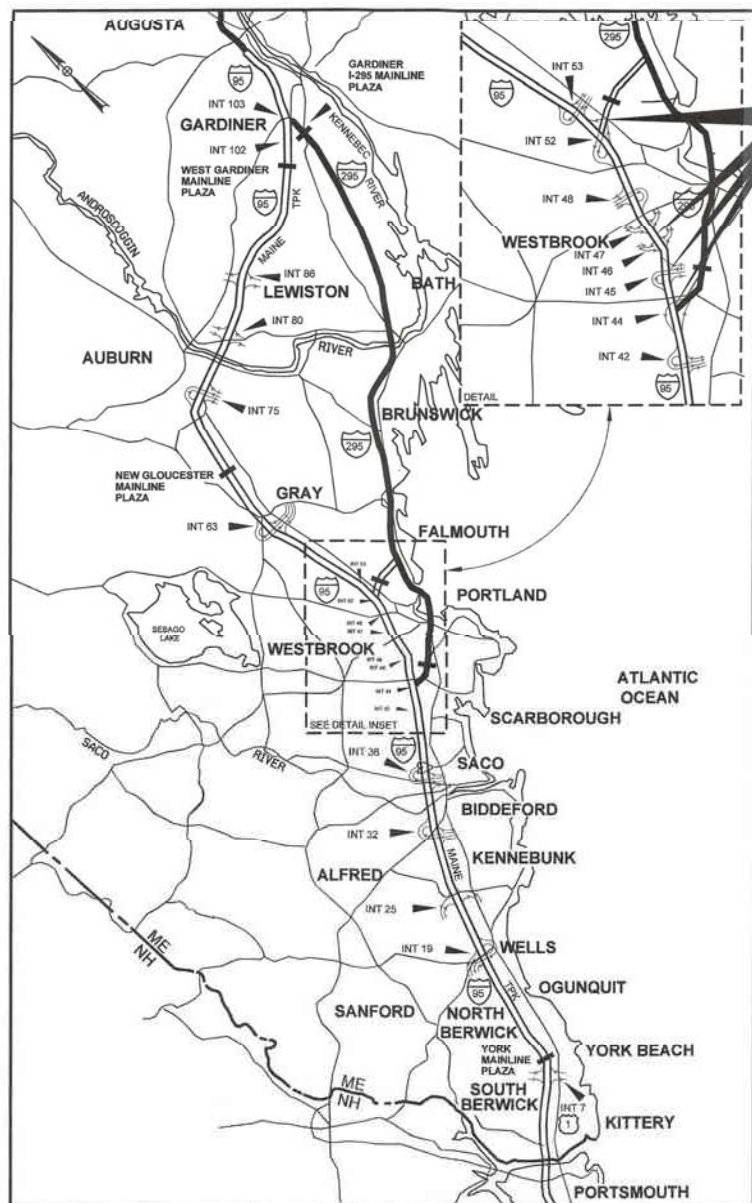

LOCATION MAP

EXIT 45 BRIDGE (MM 44.9)  
 EXIT 46 BRIDGE (MM 46.3)  
 EXIT 46 PAVING (MM 46.3)  
 MM 44.0 TO MM 49.01 AND FS 0.60



THE GOLD STAR  
 MEMORIAL HIGHWAY

# MAINE TURNPIKE AUTHORITY

DANIEL E. WATHEN, CHAIR  
 JAMES F. CLOUTIER, VICE CHAIR  
 GERARD P. CONLEY, SR., MEMBER  
 JOHN E. DORITY, MEMBER  
 ROBERT D. STONE, MEMBER  
 FREEMAN R. GOODRICH, MEMBER  
 KAREN DOYLE, MEMBER EX-OFFICIO

S. PETER MILLS, EXECUTIVE DIRECTOR

## CONTRACT 2015.03 BRIDGE REPAIRS EXIT 45 BRIDGE (MM 44.9) EXIT 46 BRIDGE (MM 46.3)

## PAVING REHABILITATION EXIT 46 (MM 46.3)

## MISCELLANEOUS TURNPIKE REPAIRS MM 44.0 TO MM 49.01 AND FS 0.60

INDEX OF SHEETS	
SHEET NO.	DESCRIPTION
1	TITLE SHEET
2	ESTIMATED QUANTITIES
3	GENERAL NOTES AND EARTHWORK SUMMARY
4	DRAINAGE SUMMARY AND DETAILS
5-8	EXIT 46 - TYPICAL SECTIONS
9-10	EXIT 46 - GUARDRAIL DETAILS
11	EXIT 46 - LIGHTING DETAILS
12	EXIT 46 - EROSION CONTROL DETAILS
13	EXIT 46 - SIGN DETAILS
14-29	MAINTENANCE OF TRAFFIC
30-31	GEOMETRIC PLANS
32-36	EXIT 46 PAVING PLANS
37	EXIT 46 SB OFF RAMP WIDENING PLAN
38-42	EXIT 46 SB OFF RAMP CROSS SECTIONS
43	EXIT 46 NB ON RAMP WIDENING PLAN
44-52	EXIT 46 NB ON RAMP CROSS SECTIONS
53	EXIT 46 LIMIT OF DISTURBANCE PLAN
54	EXIT 44 - SIGNS AND LINEWORK
55	EXIT 46 - STRIPING PLAN
56-63	EXIT 45 - BRIDGE PLANS
64-66	EXIT 46 - BRIDGE PLANS
67-69	SNOW FENCE PLANS
70-71	CONGRESS STREET - BRIDGE MOUNTED SIGN
72-73	RAILROAD BRIDGE CONDUIT
74-93	AS-BUILTS

CONTRACT 2015.03

APPROVED: MAINE TURNPIKE AUTHORITY

*Peter S. Merfeld* 01-20-15  
 PETER S. MERFELD, P.E. - CHIEF OPERATIONS OFFICER DATE


*Stephen R. Martre* 1/20/15  
 STEPHEN R. MARTRE, P.E. - DIRECTOR OF ENGINEERING & BUILDING MAINTENANCE DATE




*Roland A. Lavallee* 1/15/15  
 ROLAND A. LAVALLEE, P.E. DATE  
 VICE PRESIDENT  
 DIRECTOR OF OPERATIONS

Filename: 001\_MTATitle.dgn




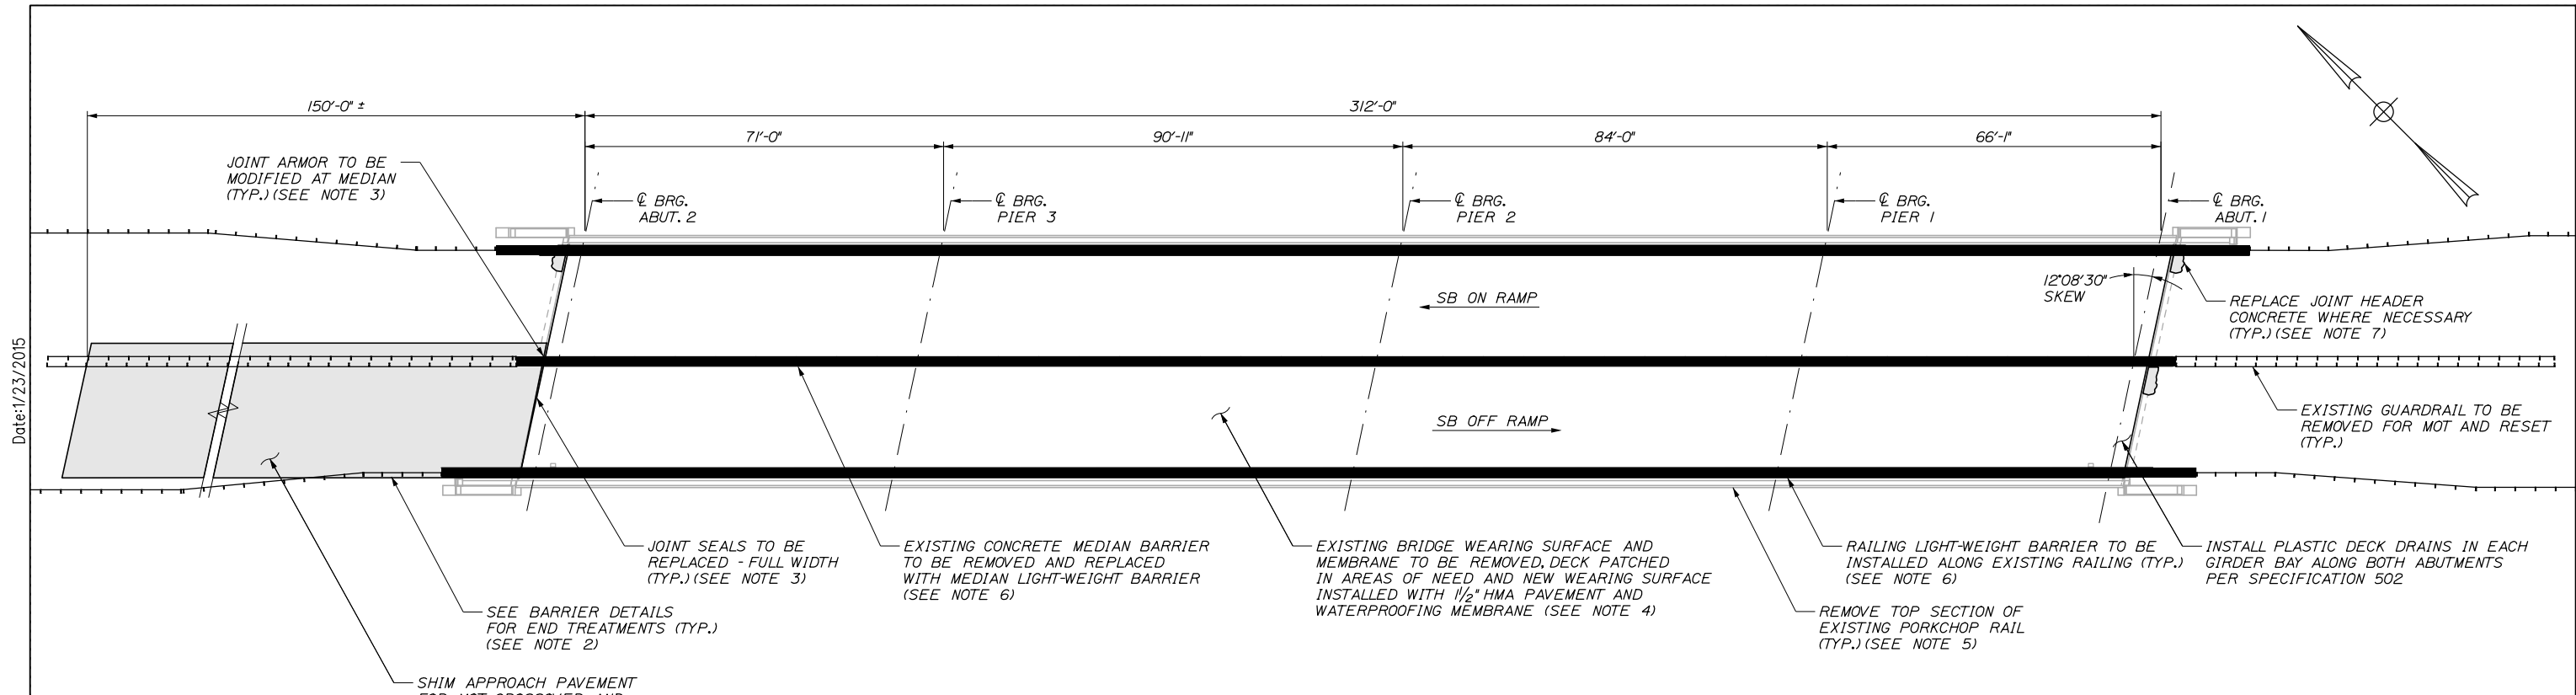

DECK PLAN  
1/16" = 1'-0"

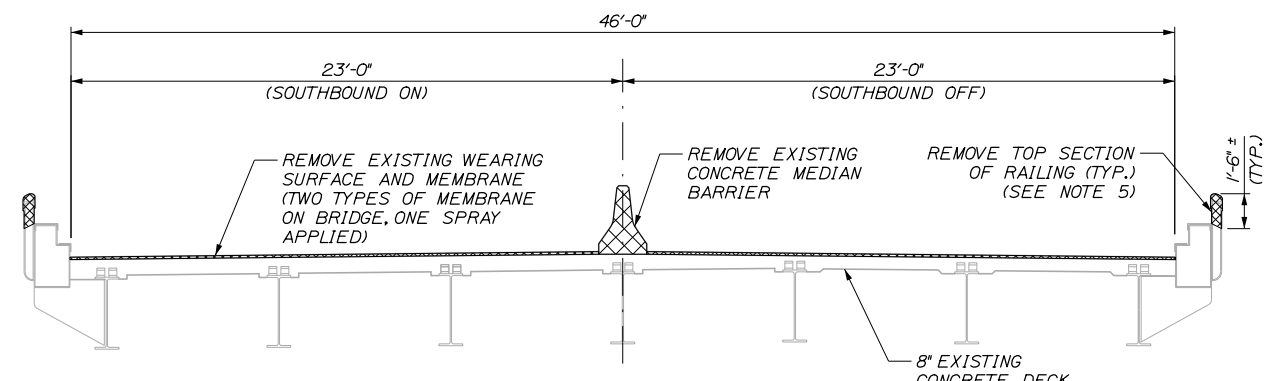

TYPICAL SECTION - EXISTING  
1/4" = 1'-0"

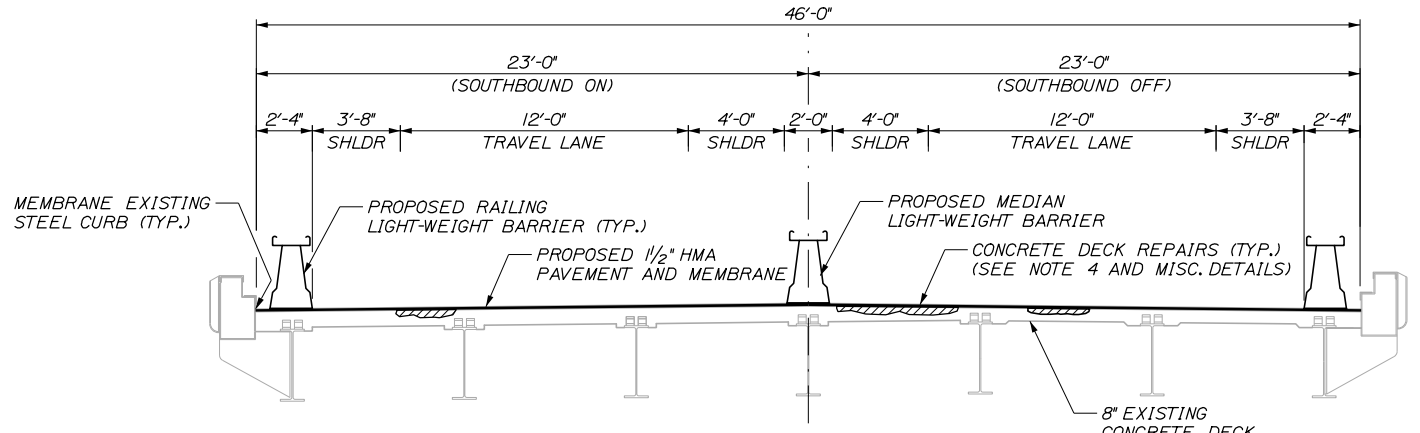

TYPICAL SECTION - PROPOSED  
1/4" = 1'-0"

- NOTES:**
1. THERE IS A HEIGHT DIFFERENTIAL OF APPROXIMATELY 6" BETWEEN THE WEST APPROACH PAVEMENT ON RAMP AND OFF RAMP. THE SOUTHWEST APPROACH PAVEMENT SHALL BE SHIMMED TO PROVIDE A SMOOTH CROSSOVER DURING MAINTENANCE OF TRAFFIC (MOT) OPERATIONS AND TO IMPROVE CURRENT RIDEABILITY. SEE MAINTENANCE OF TRAFFIC DETAILS FOR MORE INFORMATION ON LAYOUT AND SHIM LIMITS.
  2. PROPOSED LIGHT-WEIGHT BARRIER TRANSITIONS WILL REQUIRE DIRECT GUARDRAIL TRANSITIONS. SEE BARRIER DETAILS FOR MORE INFORMATION. THE TRANSITIONS SHALL BE MEASURED FOR PAYMENT UNDER PAY ITEM, LIGHT-WEIGHT BARRIER, 526.35.
  3. EXISTING MEDIAN BARRIER SHALL BE REMOVED TO THE LIMITS SHOWN IN THE BARRIER DETAILS. REMOVAL SHALL INCLUDE REMOVING PORTIONS OF THE EXISTING JOINT AT THE MEDIAN BARRIER. JOINT REMOVAL SHALL BE INCIDENTAL TO PAY ITEM 202.299, REMOVING CONCRETE BARRIER. JOINT MODIFICATIONS AND SEAL REPLACEMENT SHALL BE MEASURED FOR PAYMENT UNDER PAY ITEM 520.21, EXPANSION DEVICE-GLAND SEAL. FOR MORE INFORMATION ON DEMOLITION AND MODIFICATION SEE JOINT DETAILS.
  4. AFTER THE EXISTING WEARING SURFACE AND MEMBRANE ARE REMOVED THE RESIDENT SHALL IDENTIFY AREAS OF DECK REPAIRS BASED ON REQUIREMENTS IN SPECIAL PROVISION 503 AND 518. THE ACTUAL REPAIR AREAS FOR THIS ITEM ARE UNDEFINED, FOR QUANTITIES IT WAS ASSUMED THAT 7.5% OF THE DECK AREA WILL REQUIRE PARTIAL DEPTH CONCRETE DECK REPAIRS AND 1% OF THE DECK AREA WILL REQUIRE FULL DEPTH CONCRETE DECK REPAIRS. THIS WORK SHALL BE MEASURED FOR PAYMENT UNDER PAY ITEMS 518.80, PARTIAL DEPTH CONCRETE DECK REPAIRS AND 518.81, FULL DEPTH CONCRETE DECK REPAIRS.
  5. THE EXISTING PORKCHOP RAILINGS AND POSTS SHALL BE REMOVED TO THE LIMITS SHOWN IN THE TYPICAL SECTION. METHOD OF REMOVAL SHALL BE IN ACCORDANCE WITH SPECIAL PROVISION 107 AND 202. THIS WORK SHALL BE MEASURED FOR PAYMENT UNDER PAY ITEM 202.114, REMOVING EXISTING RAILINGS.
  6. THE PROPOSED MEDIAN LIGHT-WEIGHT BARRIER AND RAILING LIGHT-WEIGHT BARRIER SHALL BE "BARRIERGUARD 800 MDS". SEE BARRIER DETAILS AND SPECIAL PROVISION 507 FOR MORE INFORMATION ON LAYOUT, PRODUCT AND MANUFACTURER.
  7. BRIDGE JOINT HEADER REPLACEMENT, WHICH INCLUDES PATCHING APPROACH PAVEMENT, SHALL BE PERFORMED ON AN AS NEEDED BASIS ALONG ALL JOINTS. THE ACTUAL REPAIR AREAS FOR THIS ITEM ARE UNDEFINED AND WILL BE DETERMINED IN THE FIELD BY THE RESIDENT. THIS WORK SHALL BE MEASURED FOR PAYMENT UNDER PAY ITEM 518.86, BRIDGE JOINT HEADER REPLACEMENT.
  8. REMOVAL/INSTALLATION OF WEARING SURFACE AND PLACEMENT OF LIGHT-WEIGHT BARRIER SHALL BE ACCOMPLISHED USING THE CONSTRUCTION SEQUENCE PRESENTED IN THE EXIT 45 MAINTENANCE OF TRAFFIC DETAILS.
  9. BRIDGE JOINT SEALS SHALL BE INSTALLED PRIOR TO INSTALLATION OF PERMANENT LIGHT-WEIGHT BARRIER.

Filename: 056\_DeckPlan-45.dgn

No.	Revision	By	Date

Designed by:					
<b>HNTB</b>					
CONSULTANT PROJECT MANAGER: Craig R. Morin, P.E.					
	By	Date		By	Date
Designed	KEB	01/15	Checked	CRM	01/15
Drawn	MPC	01/15	In Charge of	RAL	01/15

HNTB CORPORATION  
340 County Road, Suite 6-C  
Westbrook, ME 04092  
TEL (207) 774-5155  
FAX (207) 228-0909



**THE GOLD STAR  
MEMORIAL HIGHWAY**

MTA PROJECT MANAGER: Ralph C. Norwood, IV, P.E., P.T.O.E.

**BRIDGE REPAIRS  
PAVEMENT REHABILITATION**

EXIT 45 BRIDGE  
DECK PLAN AND TYPICAL SECTION

SHEET NUMBER: S-01

CONTRACT: 2015.03

96 OF 93

Date: 1/23/2015

**REMOVAL PROCEDURES:**


1. PRIOR TO THE START OF THE CONCRETE REMOVALS, THE CONTRACTOR SHALL REMOVE TECTYL COATING WHERE PRESENT.
  2. THE RESIDENT SHALL THEN SOUND THE ABUTMENT CONCRETE AND DELINEATE AREAS OF REPAIR SIMILAR TO WHAT IS SHOWN IN THE PLANS. IT SHOULD BE NOTED THAT DURING THE DESIGN PHASE THE SUBSTRUCTURE WAS NOT SOUNDED, AREAS DELINEATED REPRESENT OBVIOUS LOCATIONS OF REPAIR (I.E., EXPOSED REINFORCING OR SPALLS). THIS REPAIR PROJECT DOES NOT INTEND TO REPAIR SMALL AREAS OF DETERIORATION, RESIDENT TO FOCUS ON AREAS EXPOSED TO THE ELEMENTS, UNLESS EXTENSIVE DETERIORATION OR DELAMINATIONS ARE FOUND IN OTHER LOCATIONS.
  3. AFTER THE RESIDENT HAS DELINEATED THE REPAIR AREAS THE CONTRACTOR SHALL AGREE ON THE LIMITS. SHOULD THE REMOVAL AREA LIMITS APPEAR TO CHANGE DURING THE REPAIR PROCESS, THE CONTRACTOR SHALL NOTIFY THE RESIDENT. THE RESIDENT AND CONTRACTOR SHALL AGREE ON THE REVISED PAY LIMITS PRIOR TO THE CONTRACTOR CONTINUING THE REMOVALS. WORK SHALL BE INCIDENTAL TO THE SPECIFIED REPAIR ITEM IN SPECIAL PROVISION 518.
2. PERFORM 1 INCH DEEP SAWCUTS ALONG LIMITS OF REMOVAL.
  3. CHIP CONCRETE TO DEPTH SHOWN AND DESCRIBED IN SPECIAL PROVISION 518.

**CONCRETE SURFACE PATCH/REPAIR PROCEDURE:**


1. PREPARE AND PATCH REPAIR AREAS WITH CLASS AAA MODIFIED CONCRETE. SEE SPECIFICATIONS FOR MATERIAL PREPARATION, PLACEMENT, AND CURING REQUIREMENTS.
2. PERFORM GENERAL FINISHING (SEE BELOW).

**GENERAL FINISHING:**

1. CONTRACTOR SHALL ENSURE ALL TECTYL COATING HAS BEEN REMOVED PRIOR TO APPLYING PROTECTIVE CONCRETE COATING. WORK SHALL BE INCIDENTAL TO THE SPECIFIED REPAIR ITEM IN SPECIAL PROVISION 518.
2. ALL EXPOSED SURFACES SHALL BE COATED WITH A PROTECTIVE COATING SUITABLE FOR CONCRETE SURFACES AFTER PATCHING IS COMPLETED AND PATCH MATERIALS HAVE CURED.

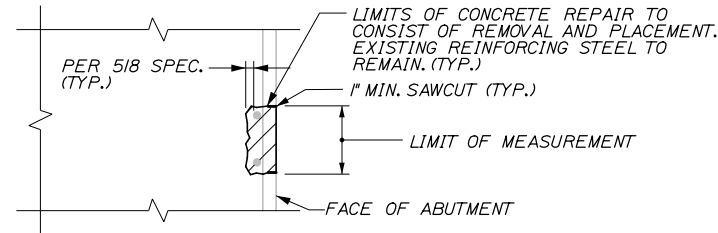


CONCRETE SURFACE PATCH/REPAIR DETAIL  
1" = 1'-0"

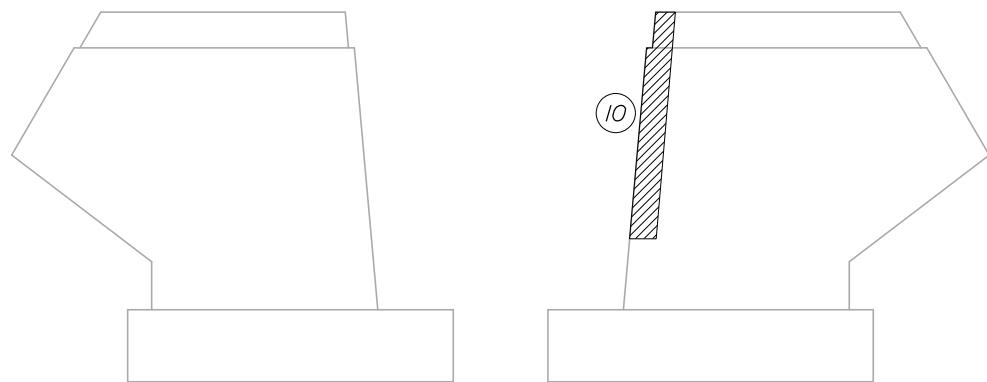

NORTHEAST WINGWALL  
1/4" = 1'-0"

SOUTHEAST WINGWALL  
1/4" = 1'-0"

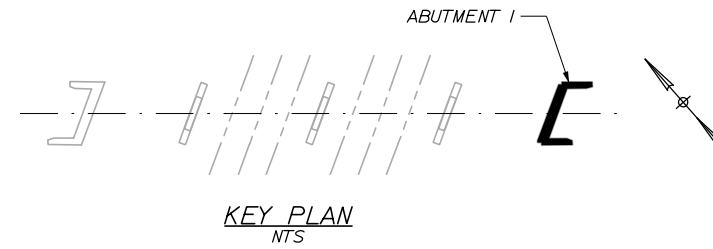

**REPAIR QUANTITIES**


ABUTMENT SURFACE PATCH REPAIR 44 S.F.\*

\* INCLUDES 10 S.F. ADDITIONAL REPAIR QUANTITY AS A CONTINGENCY.


**LEGEND**

▨ LIMIT OF SURFACE PATCH REPAIR

⊕ SQUARE FOOT AREA OF REPAIR

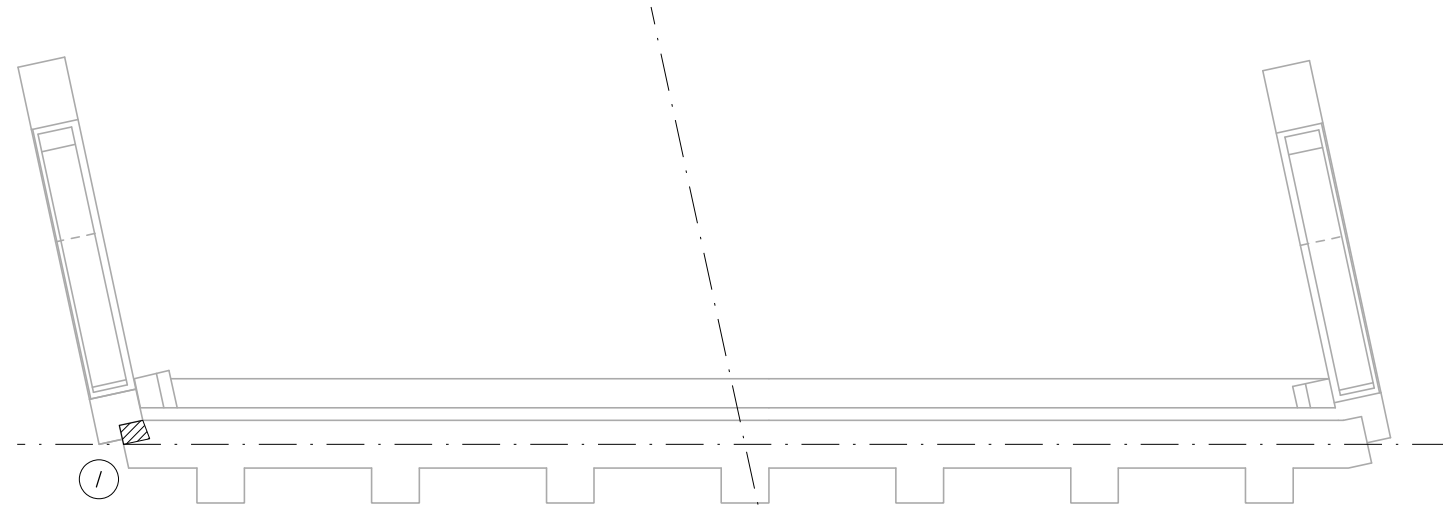

ABUTMENT 1 PLAN  
1/4" = 1'-0"

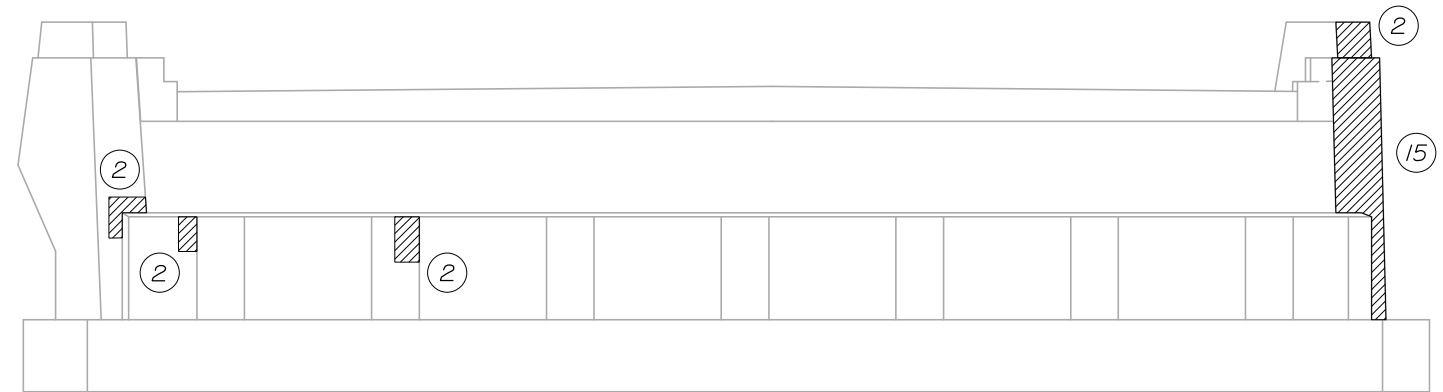

ABUTMENT 1 ELEVATION  
1/4" = 1'-0"

Filename: 057\_SubSt-45a.dgn

No.	Revision	By	Date

Designed by:

**HNTB**

CONSULTANT PROJECT MANAGER: Craig R. Morin, P.E.

	By	Date	Checked	By	Date
Designed	KEB	01/15	Checked	CRM	01/15
Drawn	MPC	01/15	In Charge of	RAL	01/15

HNTB CORPORATION  
340 County Road, Suite 6-C  
Westbrook, ME 04092  
TEL (207) 774-5155  
FAX (207) 228-0909


THE GOLD STAR  
MEMORIAL HIGHWAY

MTA PROJECT MANAGER: Ralph C. Norwood, IV, P.E., P.T.O.E.

BRIDGE REPAIRS  
PAVEMENT REHABILITATION  
EXIT 45 BRIDGE  
SUBSTRUCTURE REPAIRS I



SHEET NUMBER: S-02  
CONTRACT: 2015.03  
57 OF 93

NOTES:  
1. SEE SHEET S-02 FOR NOTES.

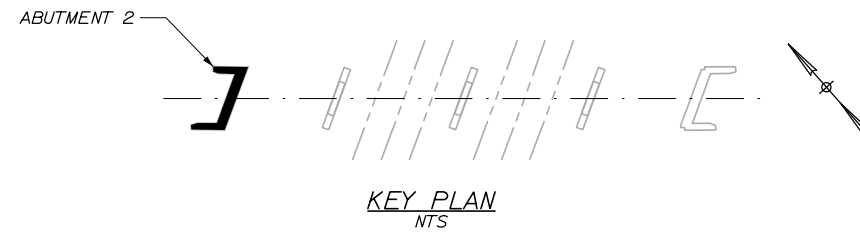

**REPAIR QUANTITIES**  
ABUTMENT SURFACE PATCH REPAIR 31 S.F.\*  
\* INCLUDES 10 S.F. ADDITIONAL REPAIR QUANTITY AS A CONTINGENCY.

**LEGEND**  
 LIMIT OF SURFACE PATCH REPAIR  
 SQUARE FOOT AREA OF REPAIR

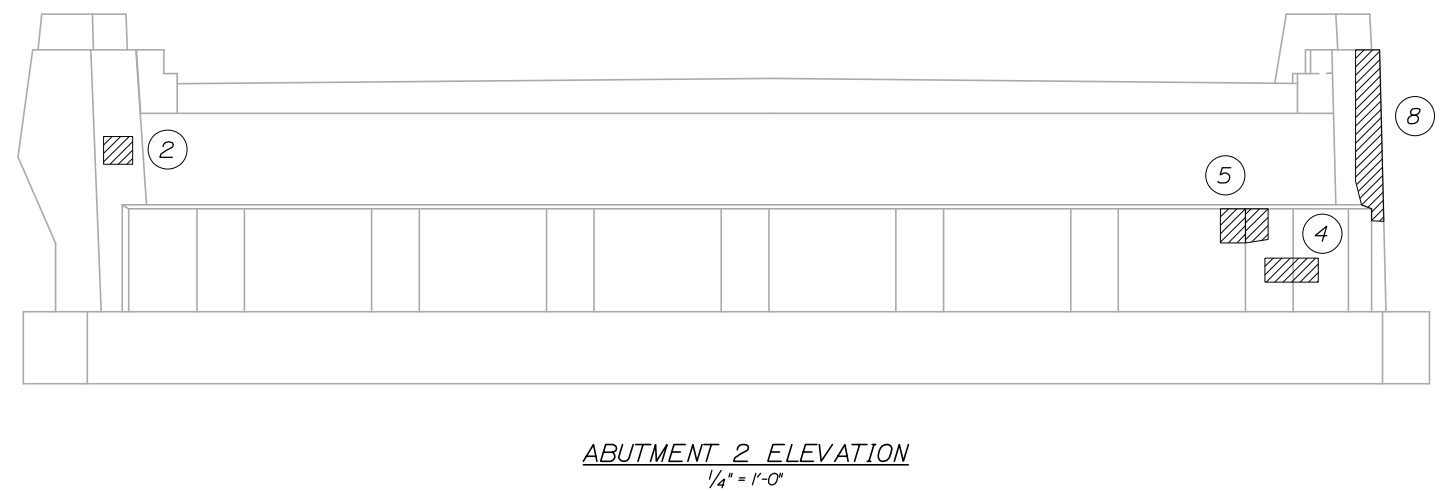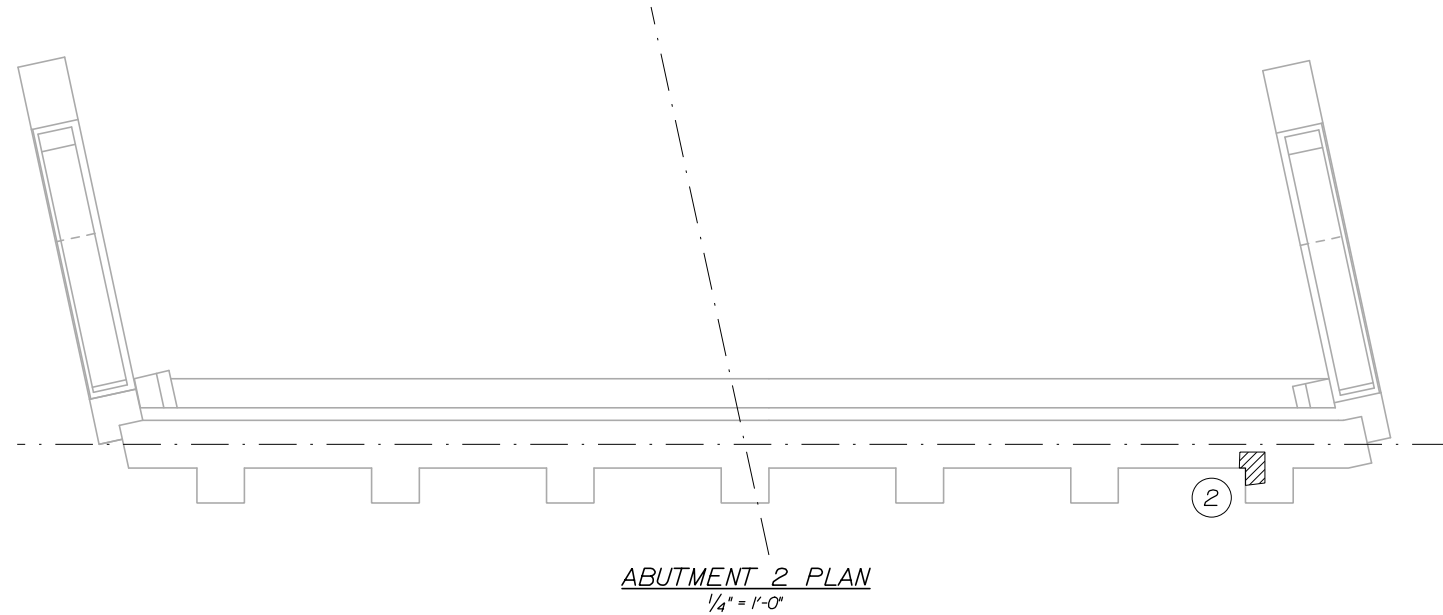

Scale:

No.	Revision	By	Date


Designed by:

**HNTB**

CONSULTANT PROJECT MANAGER: Craig R. Morin, P.E.

	By	Date		By	Date
Designed	KEB	01/15	Checked	CRM	01/15
Drawn	MPC	01/15	In Charge of	RAL	01/15

HNTB CORPORATION  
340 County Road, Suite 6-C  
Westbrook, ME 04092  
TEL (207) 774-5155  
FAX (207) 228-0909



**THE GOLD STAR  
MEMORIAL HIGHWAY**

MTA PROJECT MANAGER: Ralph C. Norwood, IV, P.E., P.T.O.E.

BRIDGE REPAIRS  
PAVEMENT REHABILITATION  
EXIT 45 BRIDGE  
SUBSTRUCTURE REPAIRS II


SHEET NUMBER: S-03  
CONTRACT: 2015.03  
58 OF 93

Date: 1/23/2015


Filename: 058\_SubSt-45b.dgn

**NOTES:**


1. FOR SECTIONS A-A, B-B AND C-C SEE SHEET S-05 AND FOR SECTIONS E-E, F-F, G-G AND H-H SEE SHEET S-07.
2. PROPOSED BARRIER ANCHORAGE SHALL BE IN ACCORDANCE WITH MANUFACTURER'S CRASH TESTED CONFIGURATION TO ACHIEVE A TL-3 MINIMUM DEFLECTION SYSTEM.
3. BARRIER TRANSITIONS TO GUARDRAIL SHALL BE DETAILED AND PROVIDED BY MANUFACTURER FOR REVIEW.
4. CONTRACTOR SHALL LAYOUT BARRIER SEGMENTS SYMMETRIC ABOUT THE CENTER OF THE BRIDGE. THE FINAL LAYOUT CONFIGURATION SHALL MEET THE MANUFACTURER'S REQUIREMENTS FOR JOINT MOVEMENT.
5. CONTRACTOR SHALL ORDER 80' OF EXTRA BARRIER SEGMENTS TO BE STORED AT A TURNPIKE MAINTENANCE YARD. THESE SEGMENTS WILL SERVE AS REPLACEMENT PIECES IF A COLLISION OCCURS IN THE FUTURE.

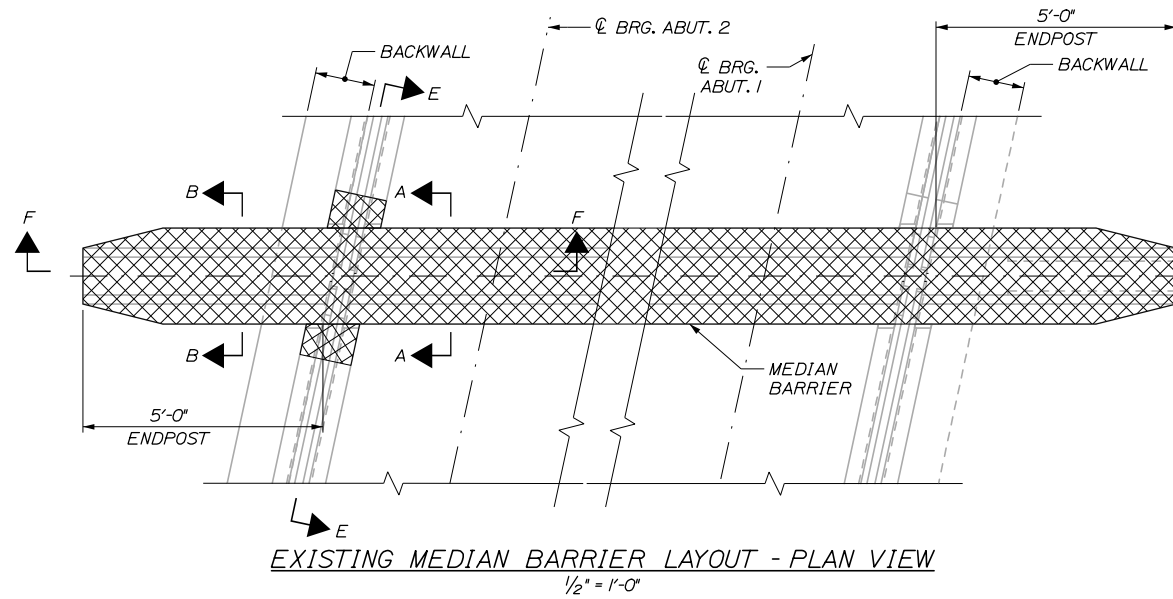

EXISTING MEDIAN BARRIER LAYOUT - PLAN VIEW  
1/2" = 1'-0"

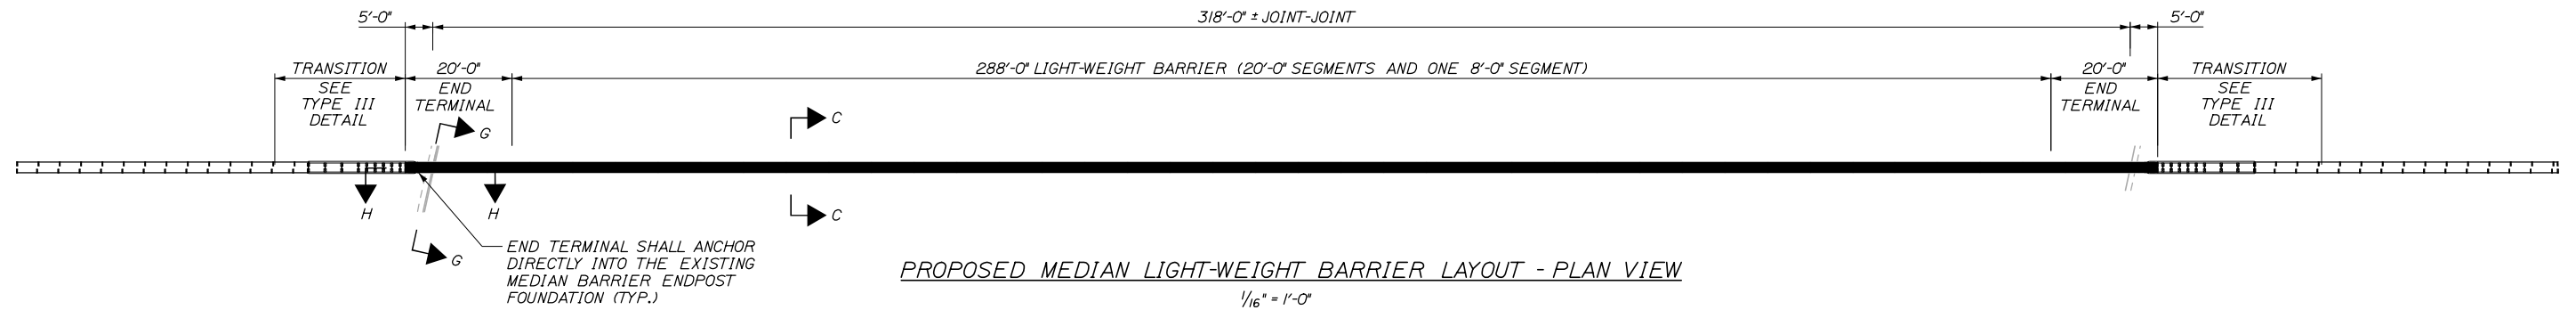

PROPOSED MEDIAN LIGHT-WEIGHT BARRIER LAYOUT - PLAN VIEW  
1/16" = 1'-0"

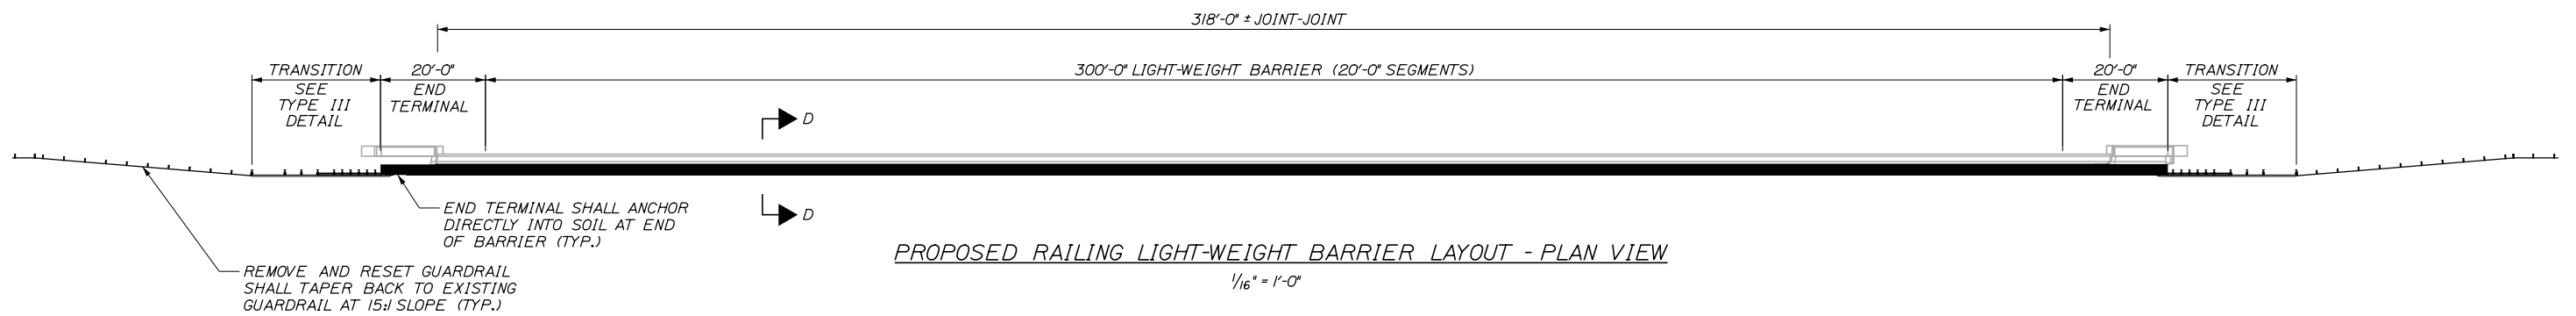

PROPOSED RAILING LIGHT-WEIGHT BARRIER LAYOUT - PLAN VIEW  
1/16" = 1'-0"

Date: 1/23/2015

Filename: 059\_BarrierDets.l.dgn

Scale:			
No.	Revision	By	Date

Designed by:					
<b>HNTB</b>					
CONSULTANT PROJECT MANAGER: Craig R. Morin, P.E.					
	By	Date		By	Date
Designed	KEB	01/15	Checked	CRM	01/15
Drawn	MPC	01/15	In Charge of	RAL	01/15

HNTB CORPORATION  
340 County Road, Suite 6-C  
Westbrook, ME 04092  
TEL (207) 774-5155  
FAX (207) 228-0909

**THE GOLD STAR  
MEMORIAL HIGHWAY**

MTA PROJECT MANAGER: Ralph C. Norwood, IV, P.E., P.T.O.E.






BRIDGE REPAIRS  
PAVEMENT REHABILITATION  
EXIT 45 BRIDGE  
BARRIER DETAILS I

SHEET NUMBER: S-04

CONTRACT: 2015.03

59 OF 93

Date: 1/23/2015

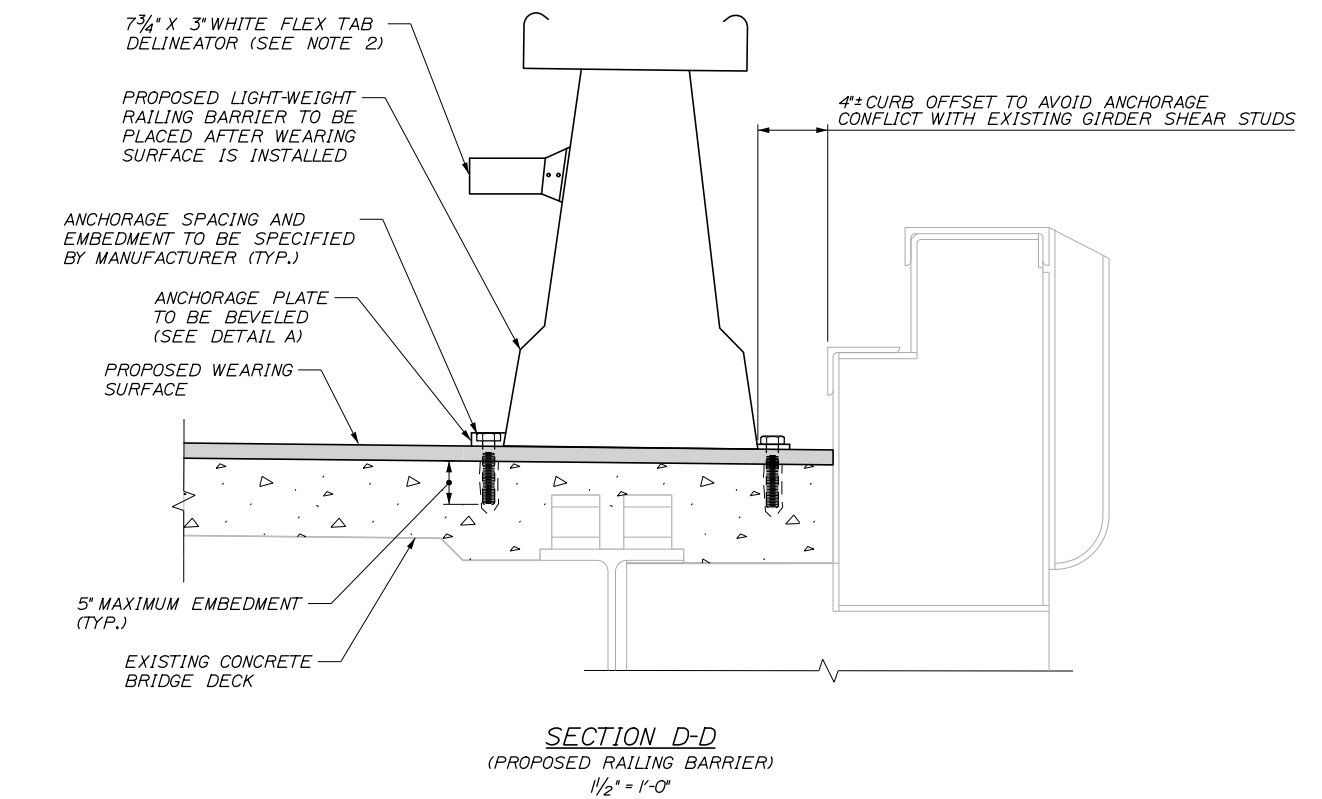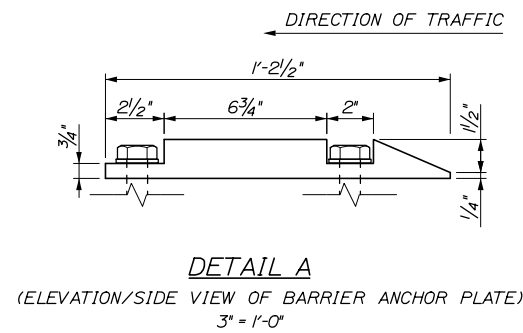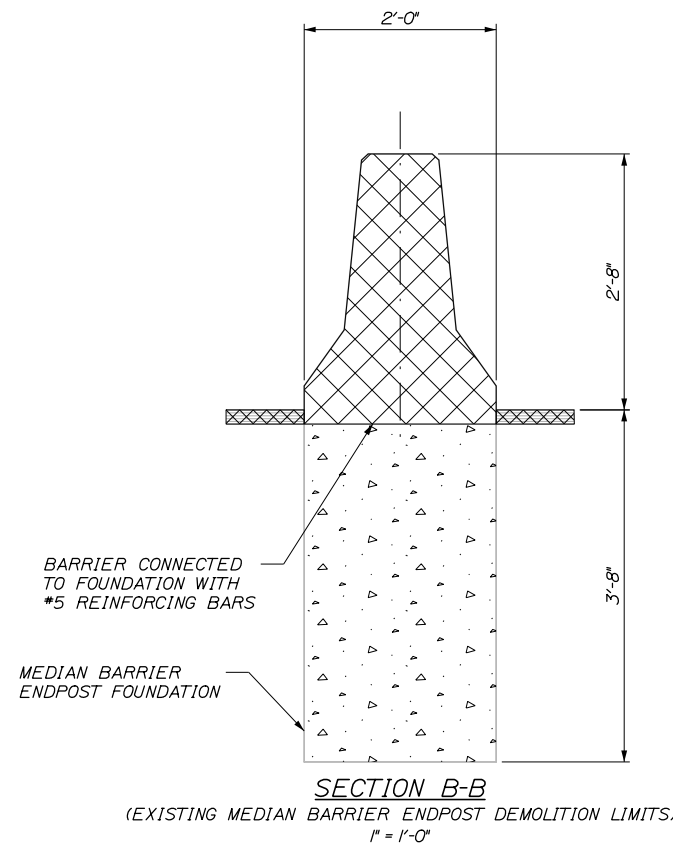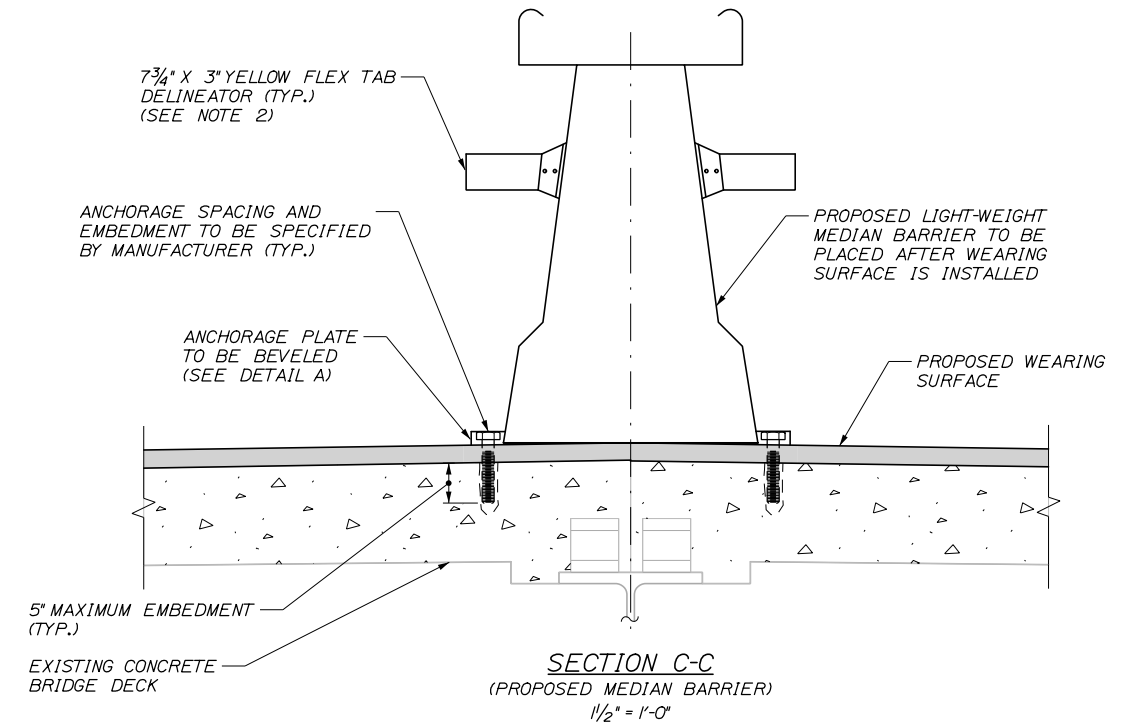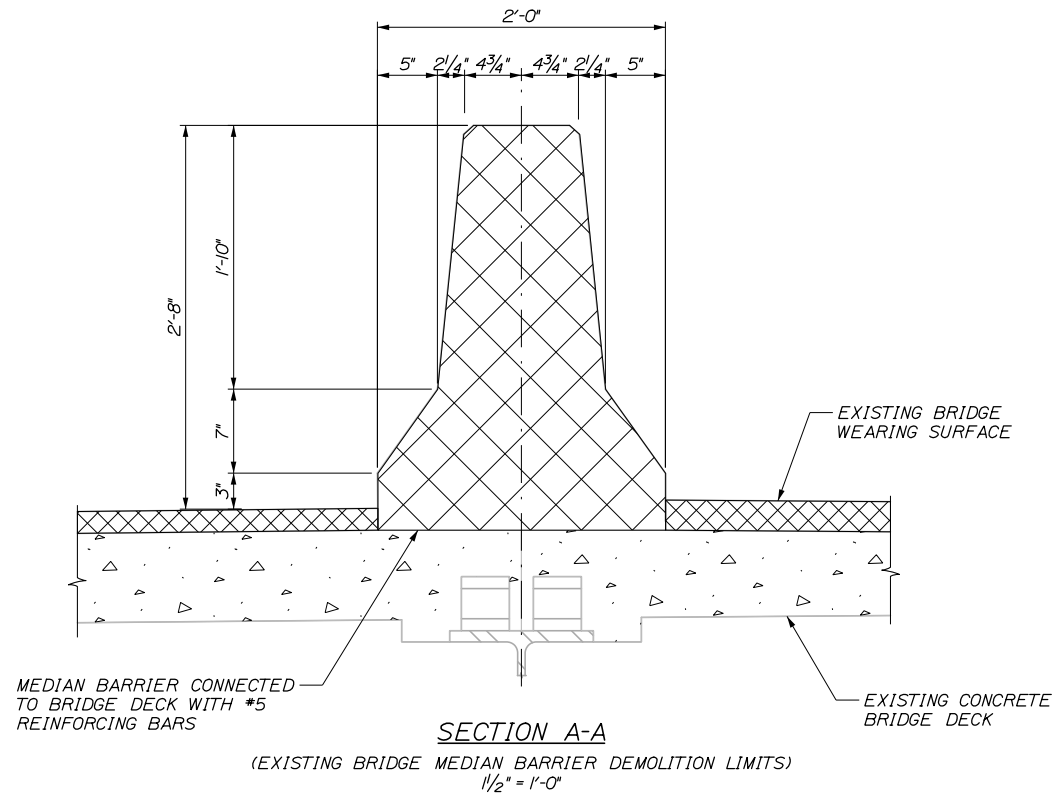

**NOTES:**

1. SEE BARRIER SHEET S-04 FOR SECTION CUT LOCATIONS.
2. FLEX TAB DELINEATORS SHALL BE INSTALLED ON EACH BARRIER FACE EXPOSED TO TRAFFIC. THE FLEX TABS SHALL BE FABRICATED AND INSTALLED (ADHESIVE MOUNTED) ACCORDING TO THE BARRIER MANUFACTURERS DETAIL. THE FLEX TABS SHALL BE INCIDENTAL TO THE LIGHT-WEIGHT BARRIER ITEM.
3. ANCHORAGE PLATES SHALL BE BEVELED TO PROVIDE A GUIDE FOR THE PLOW BLADES TO RIDE UP AND CLEAR THE ANCHORAGE BOLTS.

Filename: 060\_BarrierDets II.dgn

Scale:				
No.	Revision	By	Date	

Designed by:					
<b>HNTB</b>					
CONSULTANT PROJECT MANAGER: Craig R. Morin, P.E.					
	By	Date		By	Date
	Designed	KEB 01/15		Checked	CRM 01/15
	Drawn	MPC 01/15		In Charge of	RAL 01/15

HNTB CORPORATION  
 340 County Road, Suite 6-C  
 Westbrook, ME 04092  
 TEL (207) 774-5155  
 FAX (207) 228-0909



**THE GOLD STAR  
MEMORIAL HIGHWAY**

MTA PROJECT MANAGER: Ralph C. Norwood, IV, P.E., P.T.O.E.


**BRIDGE REPAIRS  
PAVEMENT REHABILITATION  
EXIT 45 BRIDGE  
BARRIER DETAILS II**

SHEET NUMBER: S-05  
CONTRACT: 2015.03  
60 OF 93



Date: 1/23/2015

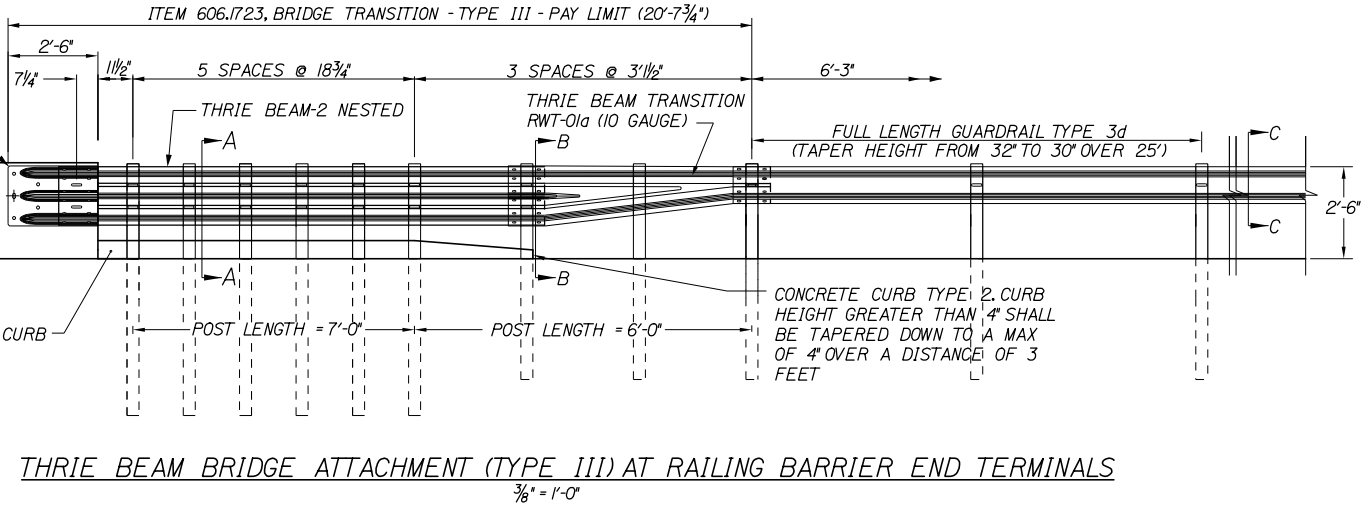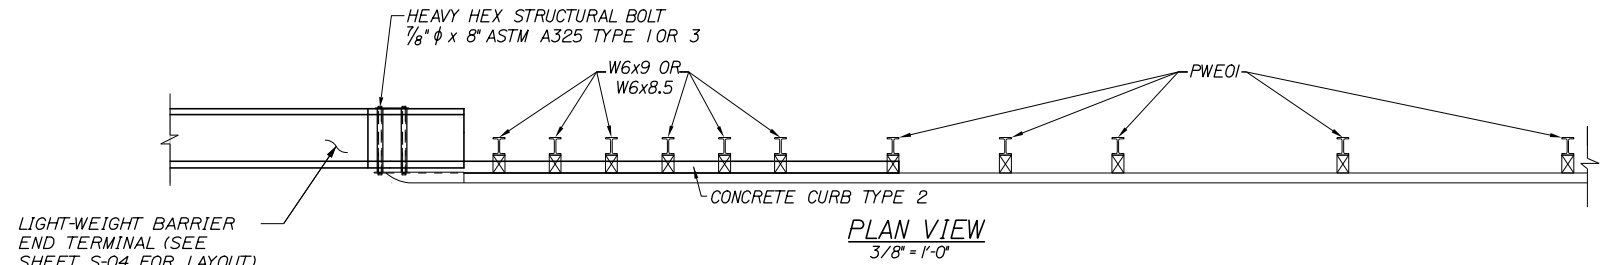


THRIE BEAM BRIDGE ATTACHMENT (TYPE III) AT RAILING BARRIER END TERMINALS  
3/8" = 1'-0"

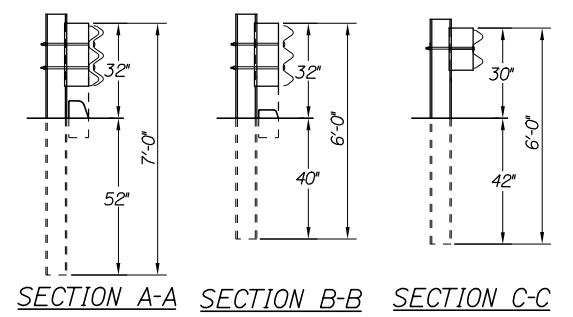

- GENERAL NOTES:**
- ADDITIONAL HOLES MAY BE MADE IN THE THRIE-BEAM PANELS BY DRILLING, PUNCHING, OR OTHER MEANS THAT PRODUCE A NEAT, CLEAN HOLE. BURNING HOLES WILL NOT BE ALLOWED.
  - THRIE BEAM SHALL BE PLACED WITH THE COMPOSITE BLOCKOUT FACE IN FRONT OF OR DIRECTLY ABOVE THE CURB FACE.
  - RAIL ELEMENT SHALL MEET ALL REQUIREMENTS OF AASHTO M-180 EXCEPT AS MODIFIED ON THE PLANS. THE THRIE BEAM TRANSITION TO W-BEAM SHALL BE OF THE SAME MATERIAL, BUT SHALL NOT BE LESS THAN 10 GAUGE.
  - AFTER INSTALLATION IS COMPLETE, UPSET THE THREAD ON THE ANCHOR BOLTS IN THREE PLACES AROUND EACH BOLT, AT THE JUNCTION OF THE NUT AND THE EXPOSED THREAD, WITH A CENTER PUNCH OR SIMILAR TOOL.
  - STANDARD BARRIER HARDWARE HAS BEEN USED TO DEVELOP THESE GUARDRAIL ATTACHMENTS. DESIGNATIONS PROVIDED IN PARENTHESIS RELATE TO STANDARD ELEMENTS DETAILED IN "A GUIDE TO STANDARDIZED BARRIER RAIL HARDWARE," 1979. AASHTO-AGC-ARTBA JOINT COOPERATE COMMITTEE.
  - CONNECTION TO LIGHT-WEIGHT BARRIER SHALL BE IN ACCORDANCE WITH MANUFACTURER CRASH TESTED REQUIREMENTS.
  - FOR THE GUARDRAIL TRANSITION, SECTION C-C AND F-F, GUARDRAIL TYPE 3d SHALL TAPER FROM 30" TO TOP OF POST TO 27" OVER 50' MIN IN ORDER TO MATCH IN TO EXISTING GUARDRAIL.
  - THRIE BEAM BRIDGE ATTACHMENT SHALL HAVE 3" x 7/8" SLOTS AT THE FIRST BOLT CONNECTIONS ON THE BRIDGE DECK. THE THREADS ON THE BOLTS AT THE SLOTS SHALL BE UPSET AT THE JUNCTION OF THE NUT WITH A CENTER PUNCH OR SIMILAR TOOL.

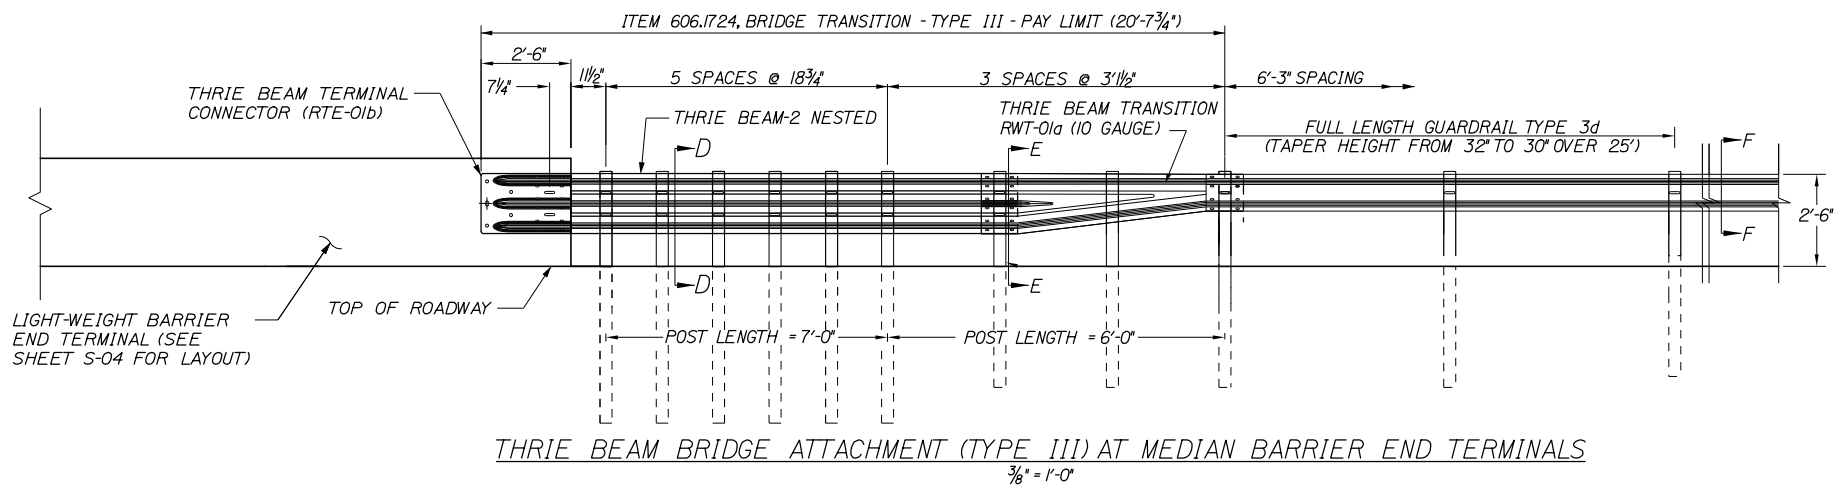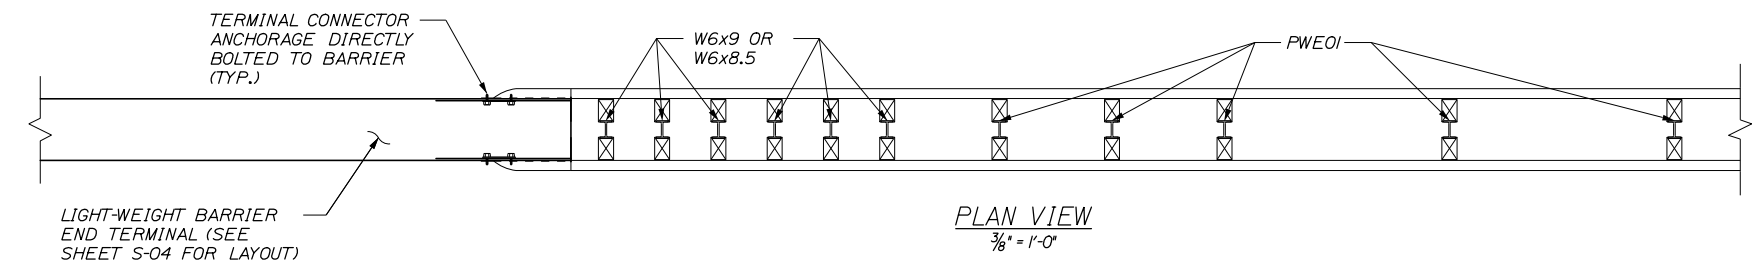

THRIE BEAM BRIDGE ATTACHMENT (TYPE III) AT MEDIAN BARRIER END TERMINALS  
3/8" = 1'-0"

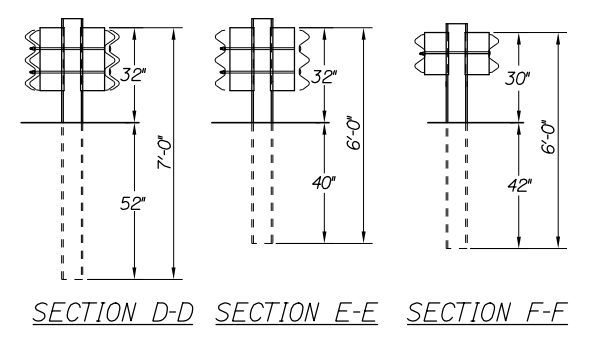

Scale:

No.	Revision	By	Date

Designed by:

**HNTB**

CONSULTANT PROJECT MANAGER: Craig R. Morin, P.E.

	By	Date	By	Date	
Designed	KEB	01/15	Checked	CRM	01/15
Drawn	MPC	01/15	In Charge of	RAL	01/15

HNTB CORPORATION  
340 County Road, Suite 6-C  
Westbrook, ME 04092  
TEL (207) 774-5155  
FAX (207) 228-0909

**MAINE TURNPIKE**

**THE GOLD STAR MEMORIAL HIGHWAY**




MTA PROJECT MANAGER: Ralph C. Norwood, IV, P.E., P.T.O.E.

BRIDGE REPAIRS  
PAVEMENT REHABILITATION  
EXIT 45 BRIDGE  
BARRIER DETAILS III



SHEET NUMBER: S-06  
CONTRACT: 2015.03  
61 OF 93

Filename: 061\_BarrierDets III.dgn



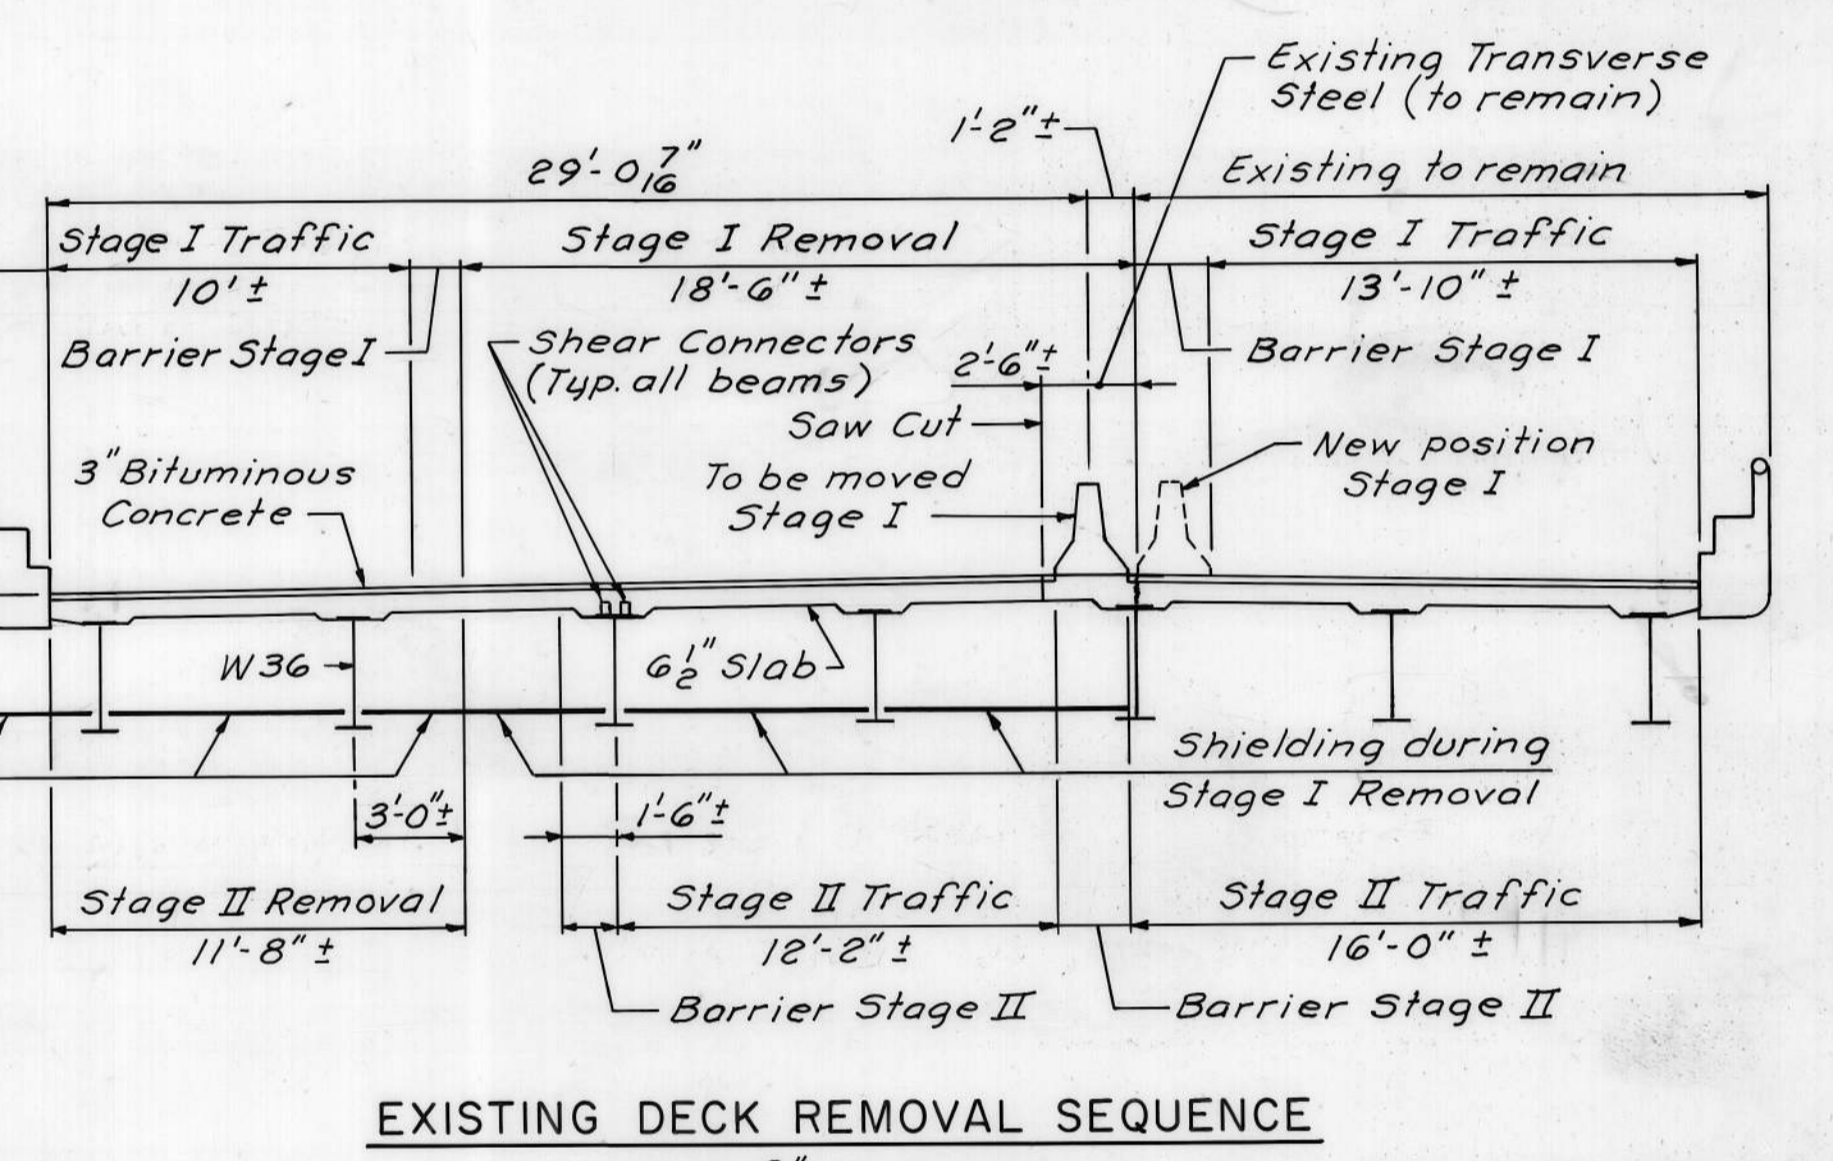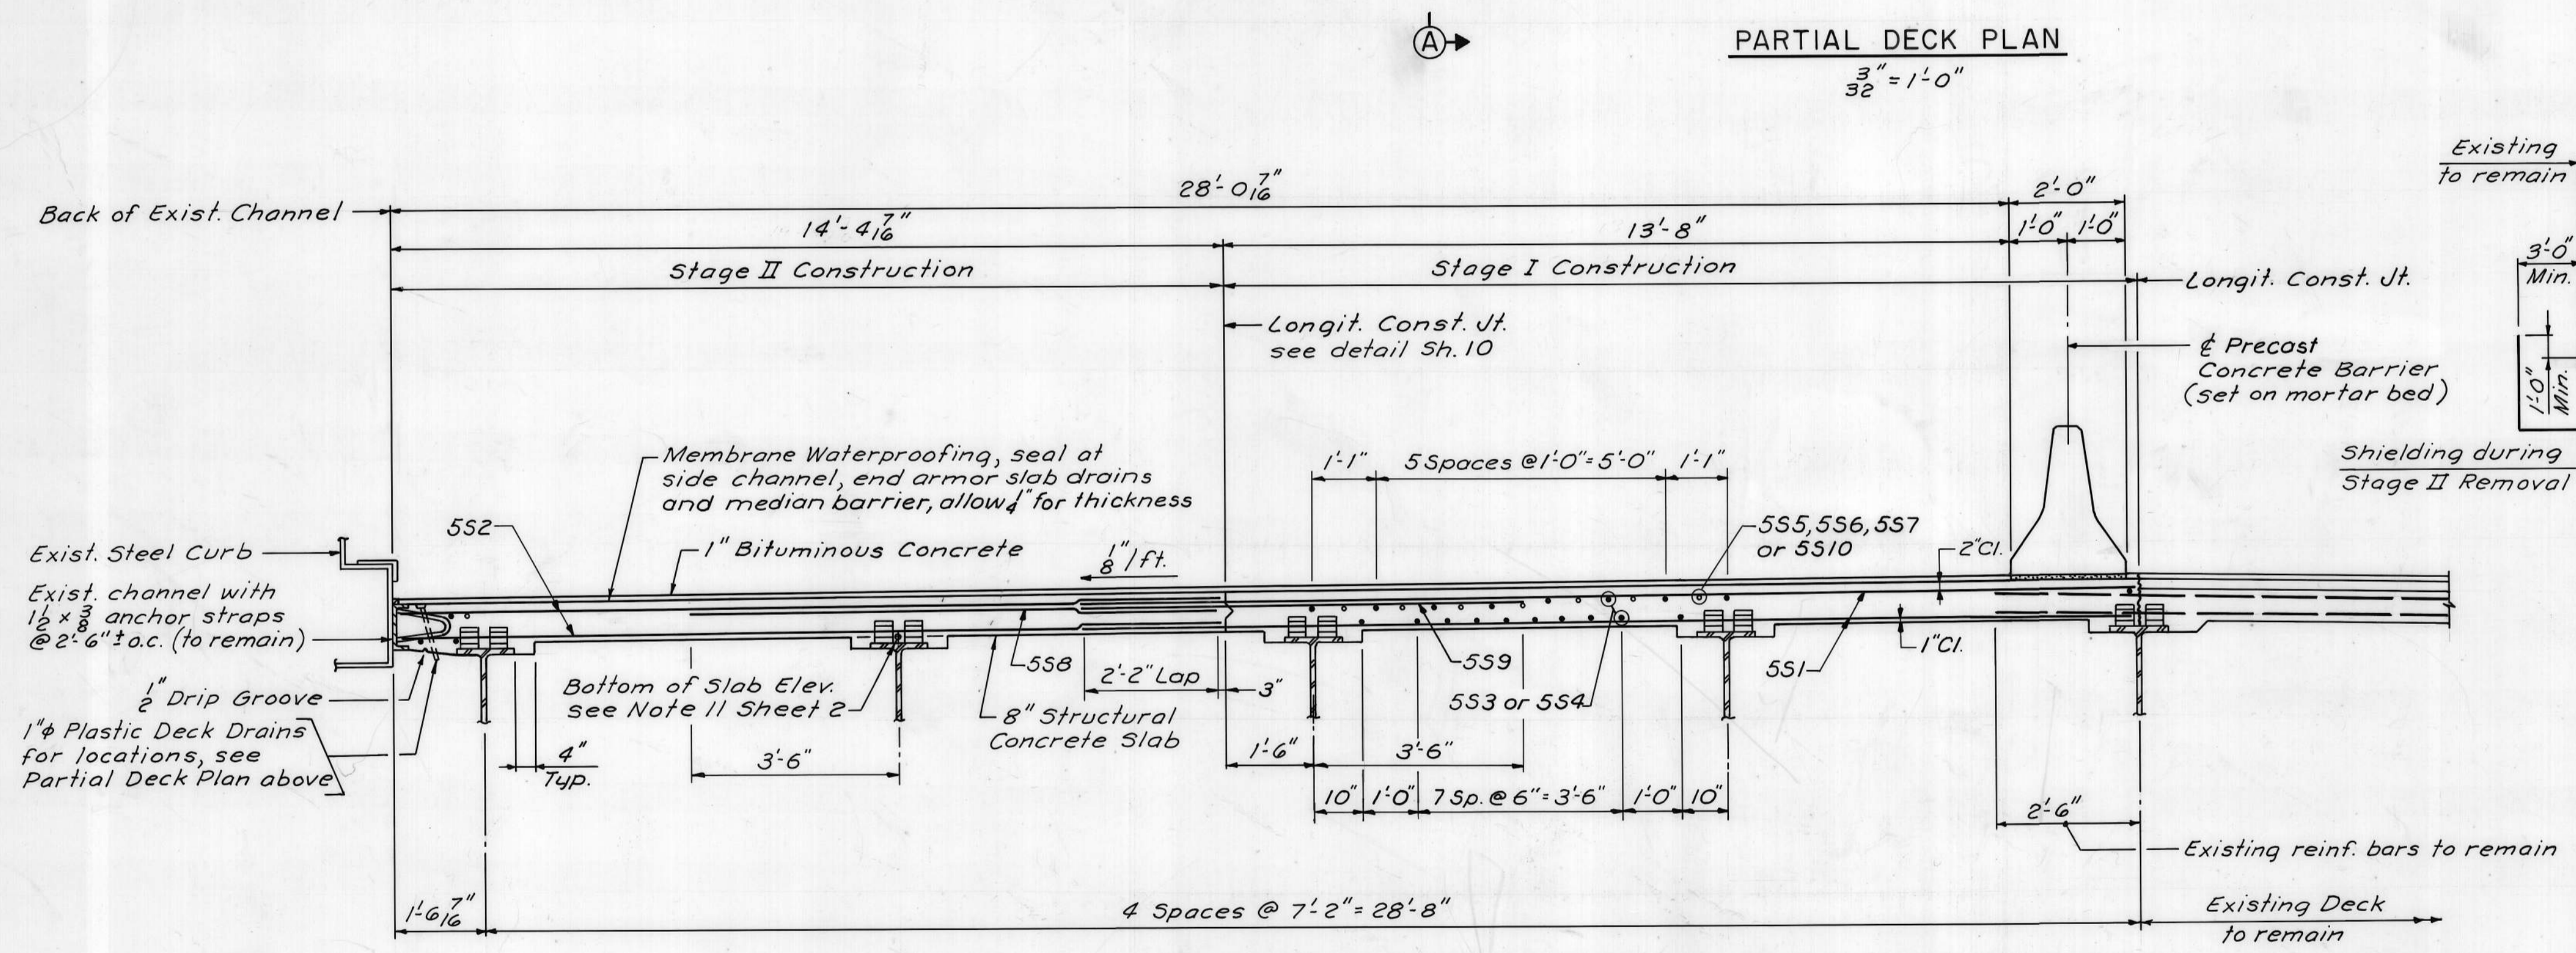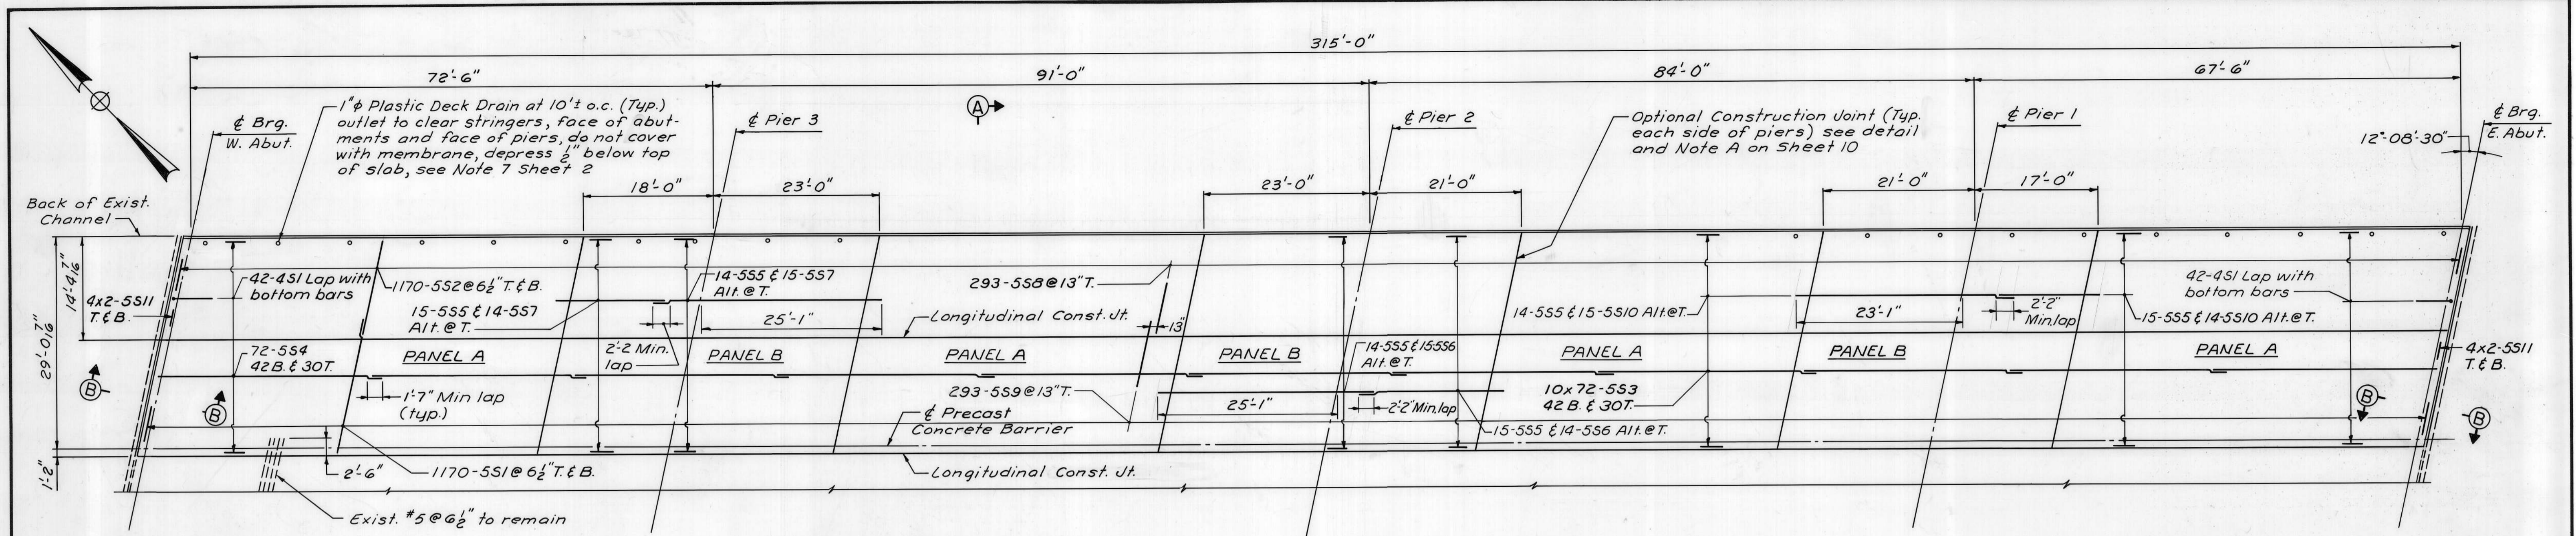

- NOTES:**
1. For General Notes and Quantities, see Sheet 2.
  2. For Barrier Details, see Sheet 10.
  3. For shielding limits parallel to bridge, see Note 10 Sheet 2.
  4. For Median Barrier details see Sheet 10.

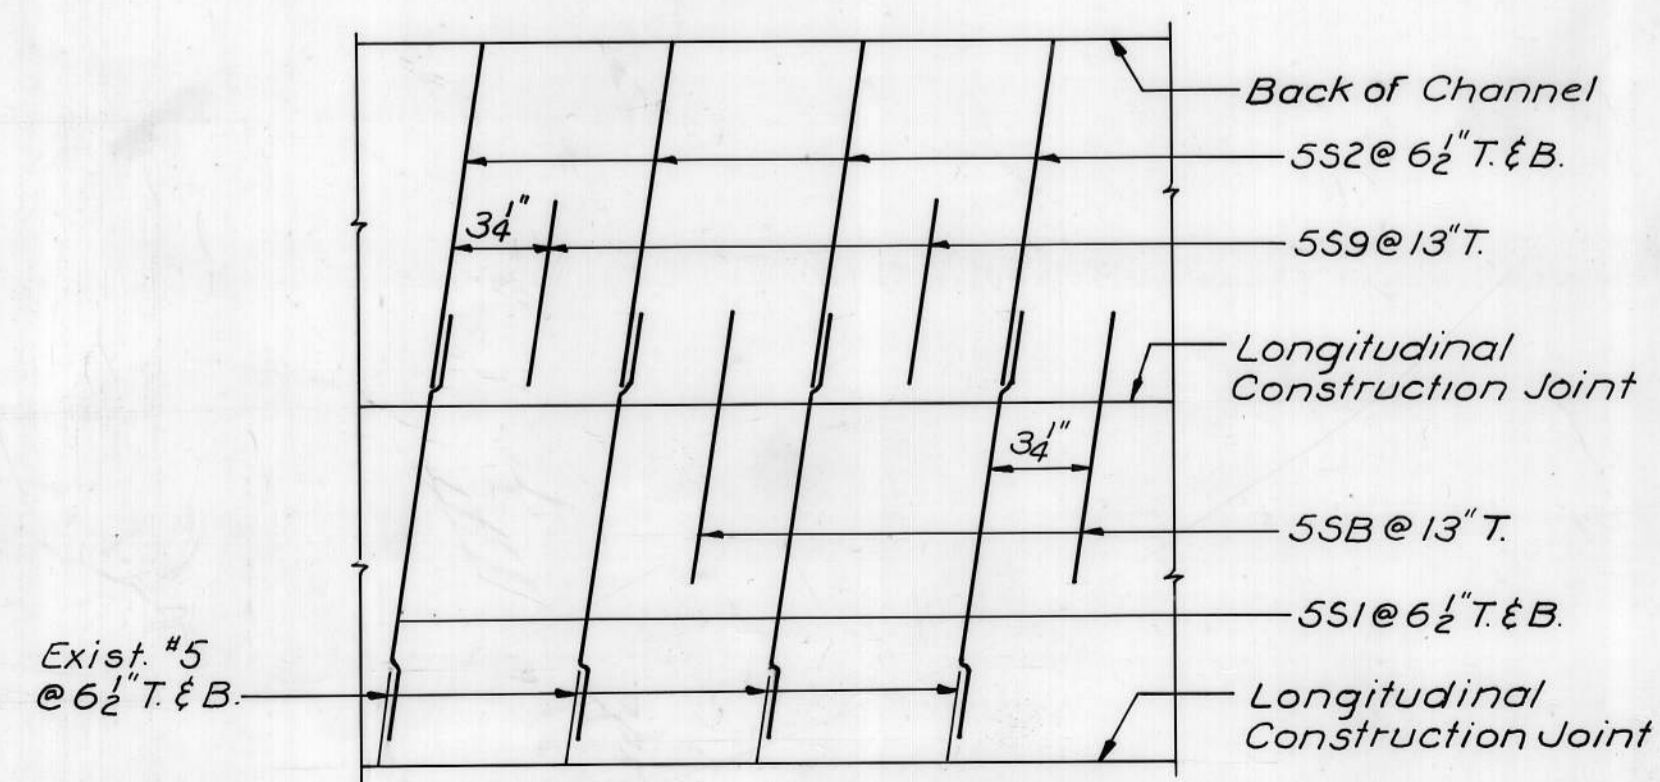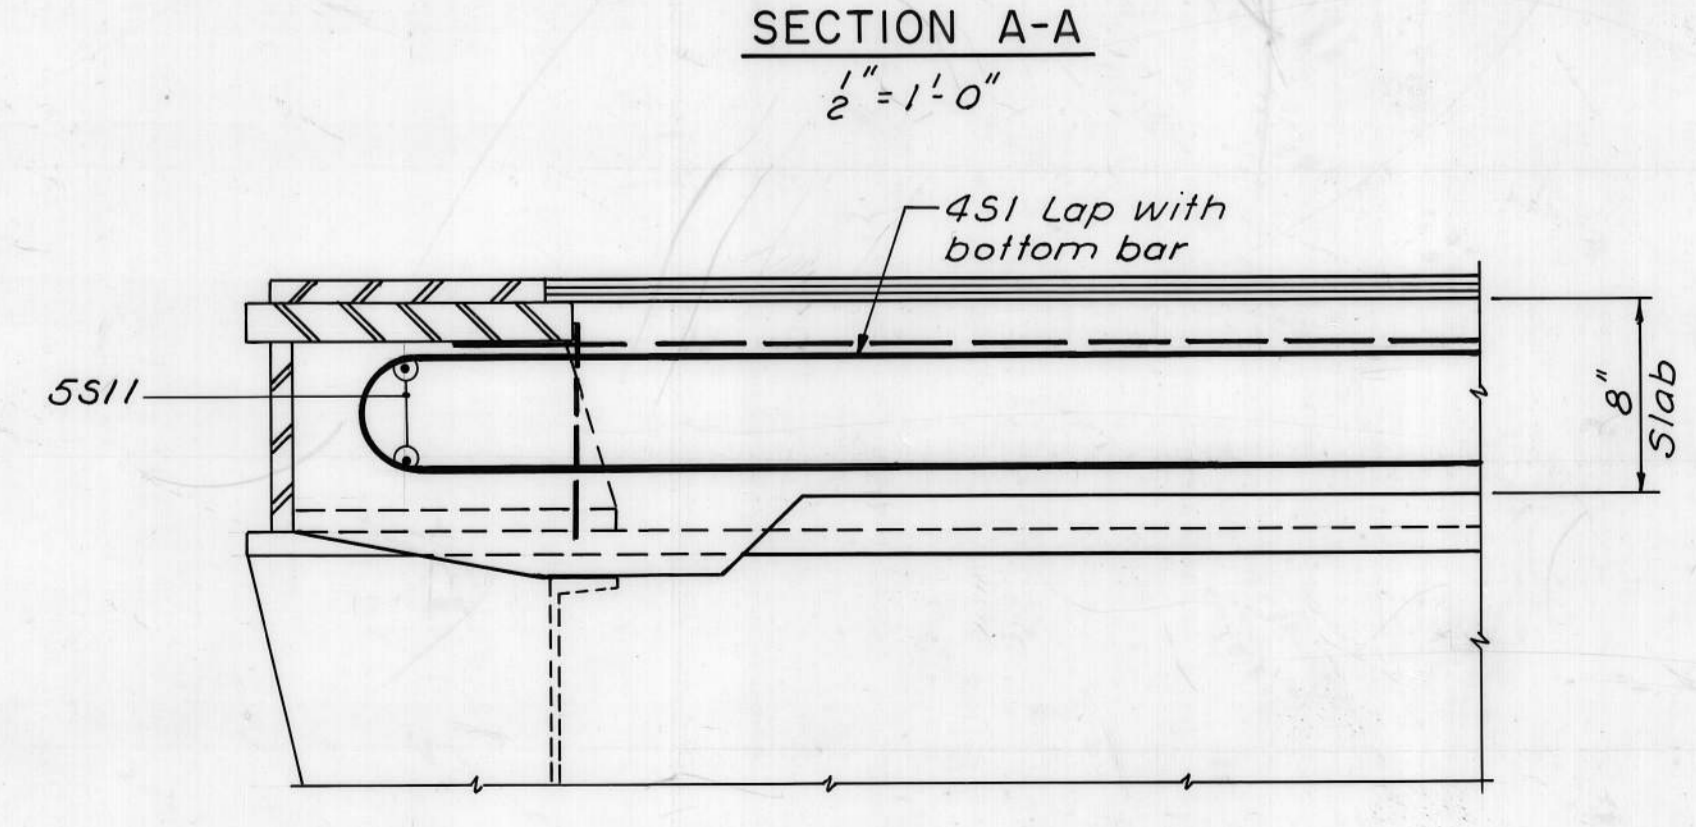

NO.	REVISION	BY	DATE	IN CHARGE OF
		MADE	J.M.M. 1-79	J.P.W.
		TRACED		
		CHECKED	I.S. 1-79	






MAINE TURNPIKE AUTHORITY  
**MAINE TURNPIKE**

SOUTH PORTLAND INTERCHANGE  
 RAMP "A"  
 PARTIAL DECK REPLACEMENT

HOWARD, NEEDLES, TAMMEN & BERGENDOFF  
 CONSULTING ENGINEERS  
 BOSTON

SCALE: AS NOTED

SHEET NO. 4 of 16

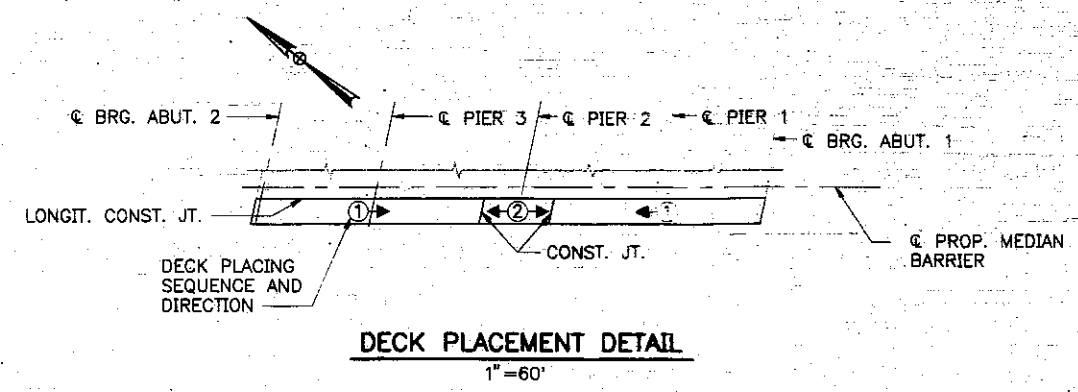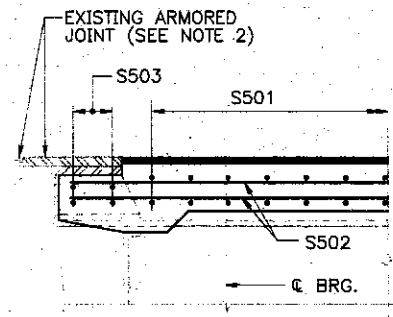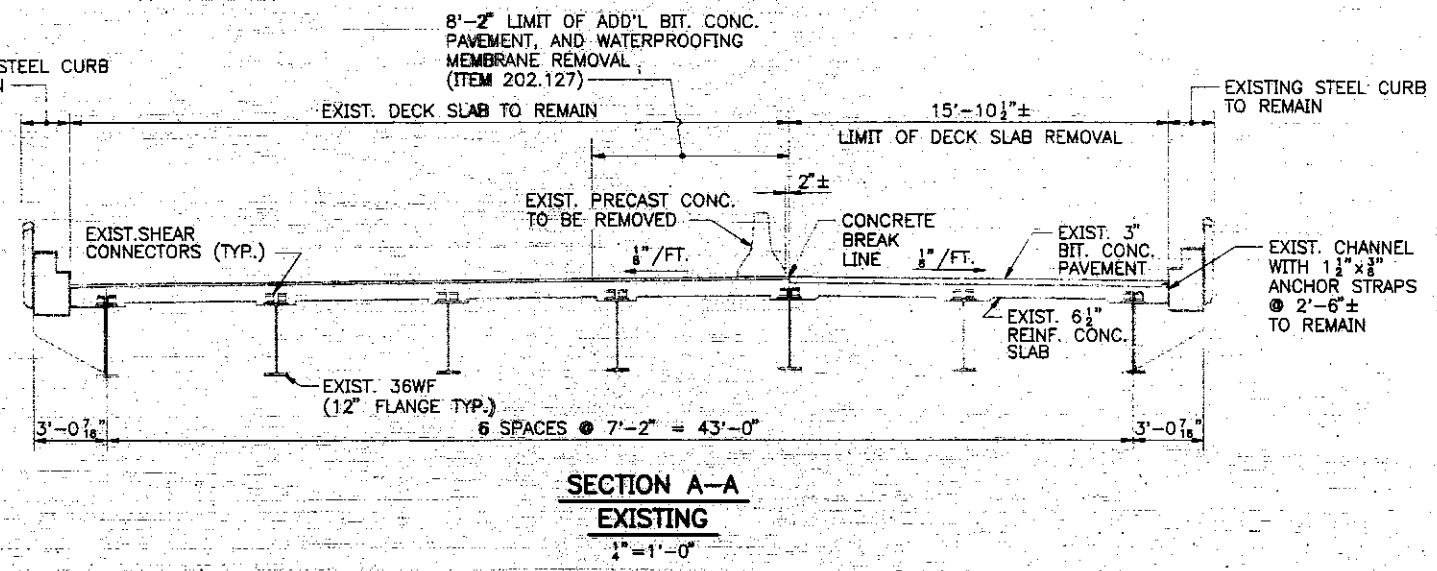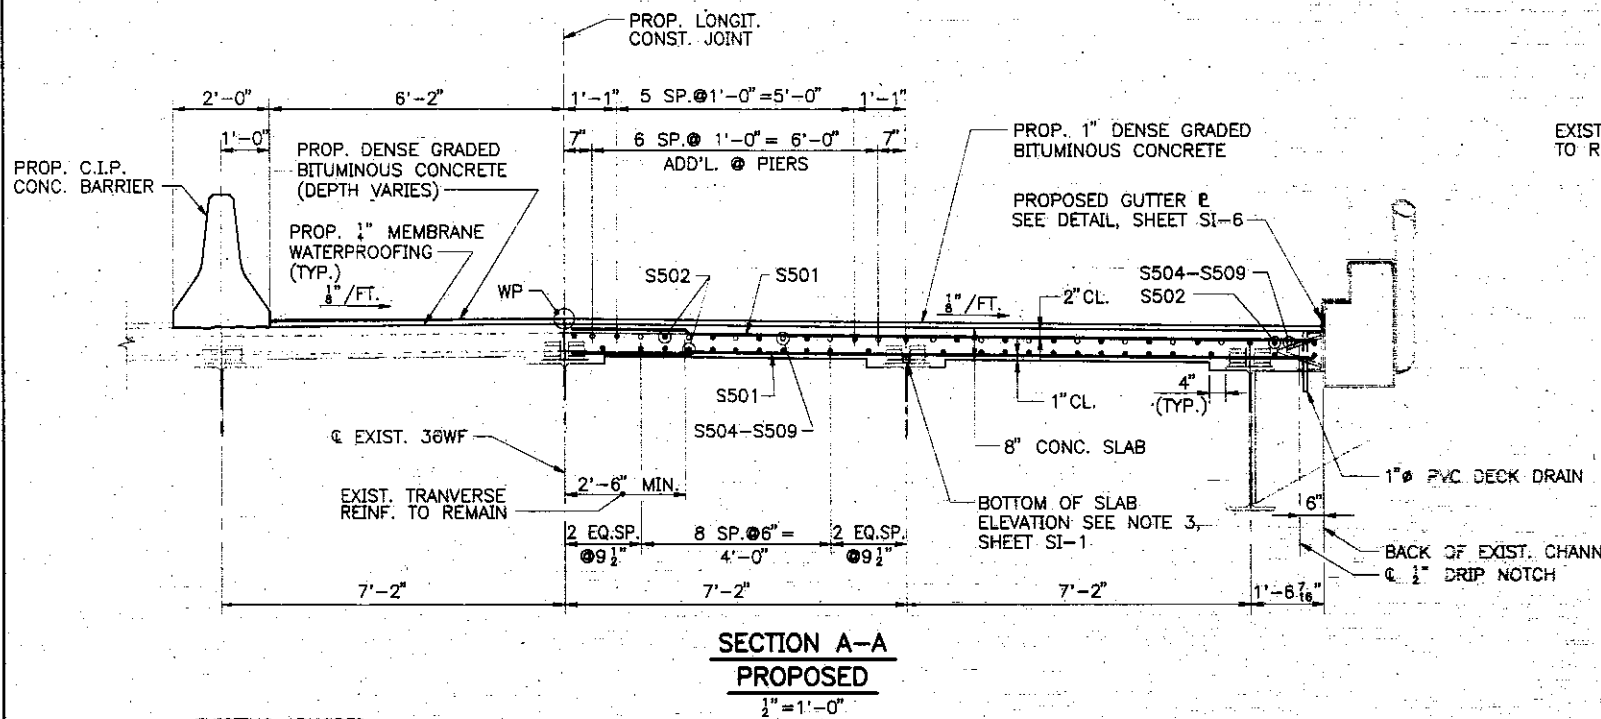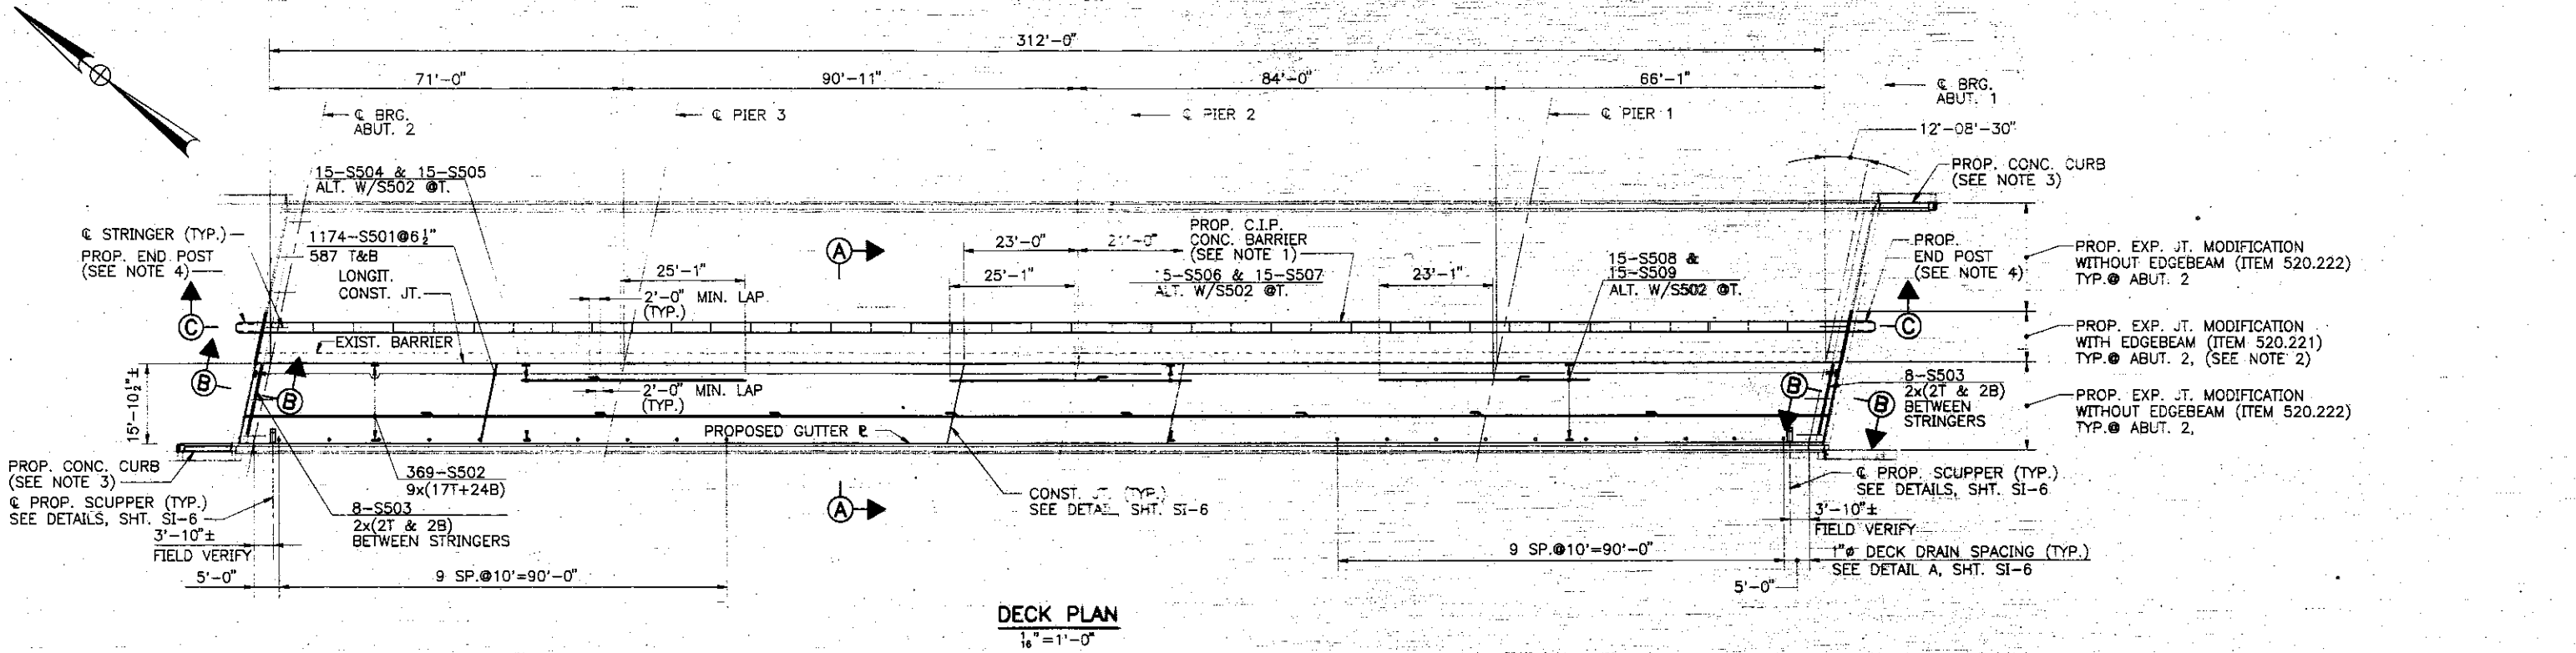

- NOTES**
- FOR SECTION C-C, AND PROP. C.I.P. BARRIER DETAILS, SEE SHT. SI-3.
  - FOR PROPOSED EXP. JT. MODIFICATION, WITH EDGEBEAM, SEE SHT. SI-4.
  - FOR PROPOSED WINGWALL MODIFICATION, SEE SHT. SI-5.
  - FOR PROPOSED END POST DETAILS, SEE SHT. SI-4.



Maine Turnpike Authority  
**Maine Turnpike**

SOUTH PORTLAND INTERCHANGE BRIDGE  
**SUPERSTRUCTURE DETAILS**

**HNTB** HOWARD NEEDLES TAMMEN & BERGENDOFF ARCHITECTS ENGINEERS PLANNERS




Contract 95.6 Sheet No. SI-2  
21 of 30

By	Date
Designed DMD	3/95
Drawn RSJ	3/95
Checked HNL	3/95
In Charge Of RAL	

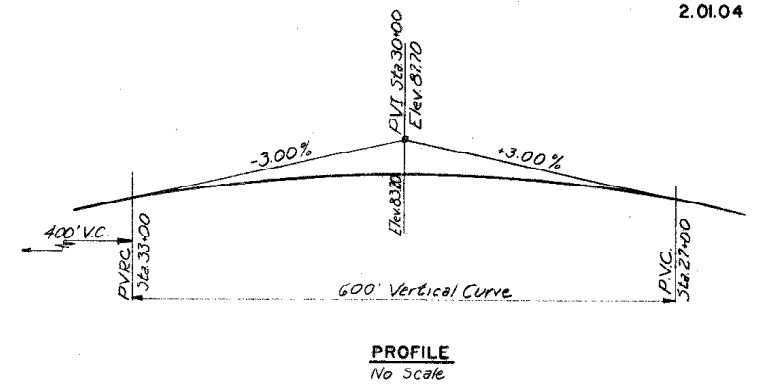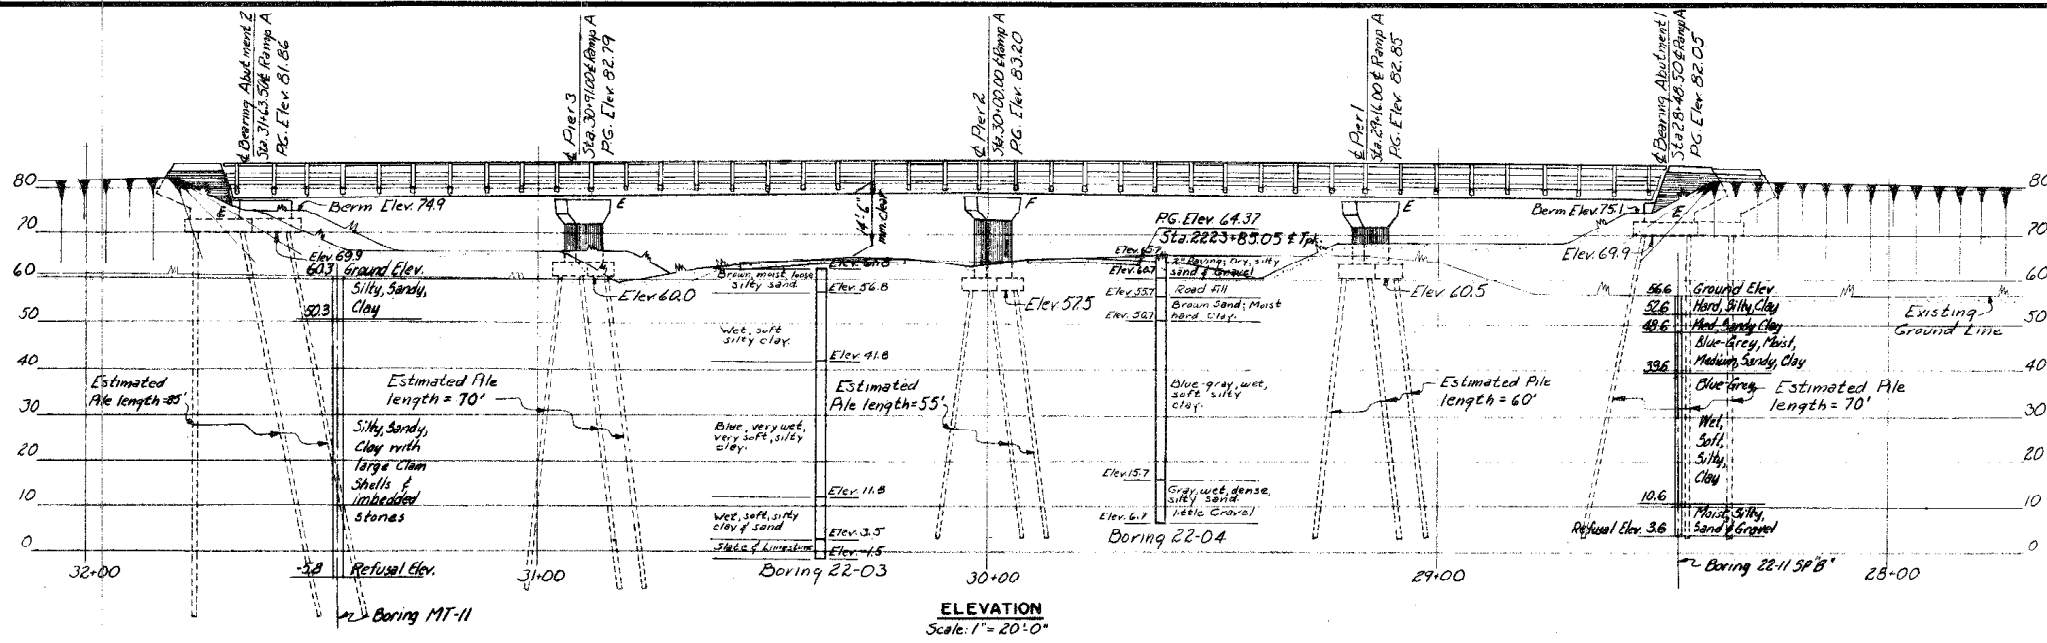

Drawing Number	Title	Structure Subcontractor	Superstructure		
			Steel Fabricator	Steel Erector	Floor Contractor
SD1A	Standard Abutment Details	✓	✓	✓	✓
SD2	Standard Pier Details	✓	✓	✓	✓
SD3	Standard Abut. Drainage Details	✓			
SD4	Standard Pile Details	✓			
SD5	Standard Handrail, Bearing Dences and Miscellaneous Details	✓	✓	✓	✓
SD6	Standard Diaphragm Details	✓	✓	✓	✓
SD10	Standard Type 'A' Splices for 3WF Beams	✓	✓	✓	✓
SD12A	Type 'Z' Expansion Joint Expanding Length Over 100'	✓	✓	✓	✓
SD20	Standard Bridge Floor Cross Section Steel Curb, 30'-0" Roadway	✓	✓	✓	✓

**GENERAL NOTES**  
 Design Specifications: AASHTO (1953) with minor modifications.  
 Design Live Load: H20-S16  
 Maximum Pile Load: Abutments 36.5 Tons per pile  
 Piers 1 & 3 54.7 Tons per pile  
 Pier 2 57.0 Tons per pile








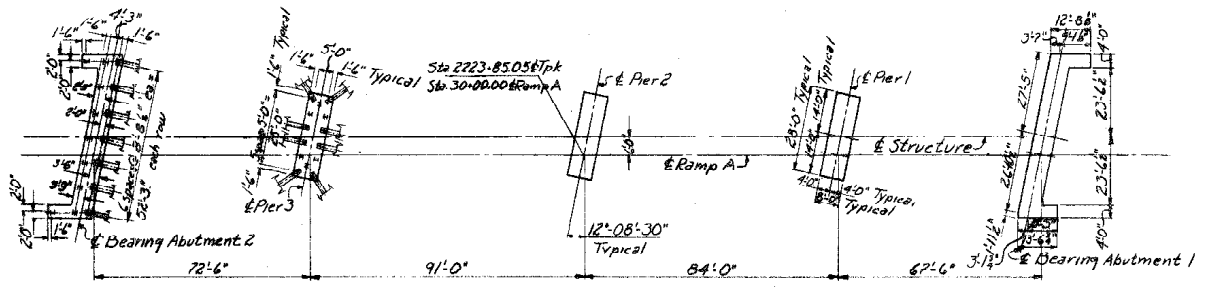
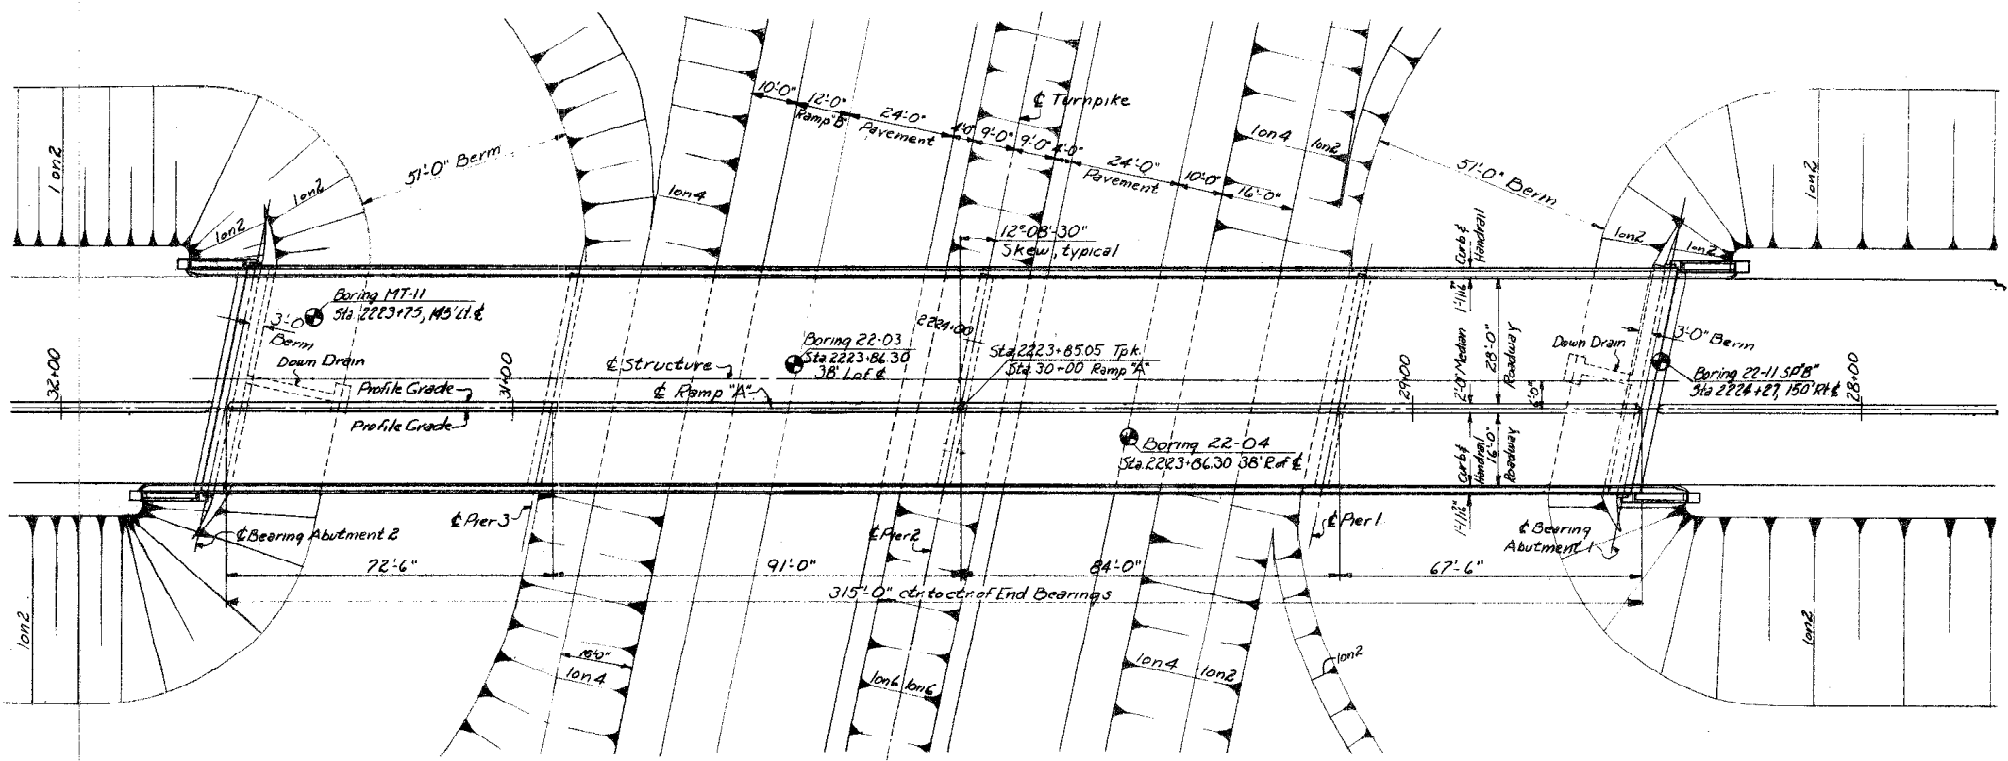
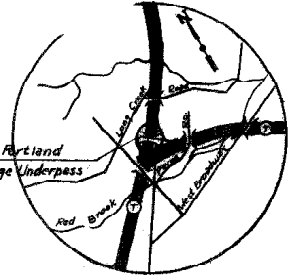


**Notes:**  
 All piles in Abutment footings to be 10BP42  
 All piles in Pier footings to be 12BP53  
 Batter piles 3" per foot as shown  
 Abutment dimensions similar by rotation  
 Footings for Piers 1, 2, & 3 are identical.

DRAWING NO. 2.01.04


BY	DATE	REVISION	BY	DATE
MADE	RSG	3-26-54		
TRACED			2	As-Built
CHECKED	RFS	4-2-54	1	Added Borings & Revised Piling Lengths
IN CHARGE OF	I.D.S.K.			

MAINE TURNPIKE AUTHORITY  
**MAINE TURNPIKE**  
 SECTION 2 — PORTLAND TO AUGUSTA  
 STRUCTURE NO. 2 TURNPIKE UNDER  
 SOUTH PORTLAND INTERCHANGE, RAMP "A"  
 STA. 2223+05.05  
**GENERAL PLAN AND ELEVATION**  
 HOWARD, NEEDLES, TAMMEN & BERGENDOFF CONSULTING ENGINEERS  
 NEW YORK KANSAS CITY  
 SCALE: As Shown  
 CONTRACT NO. \_\_\_\_\_  
 SHEET NO. 35 OF 382

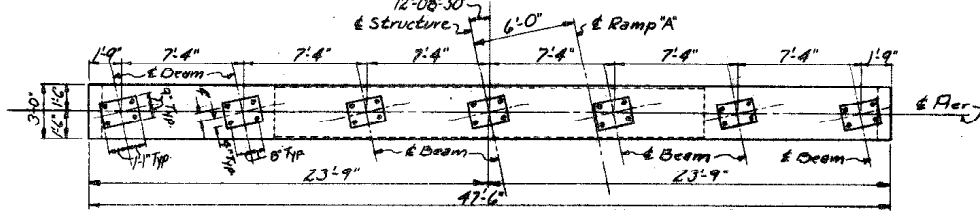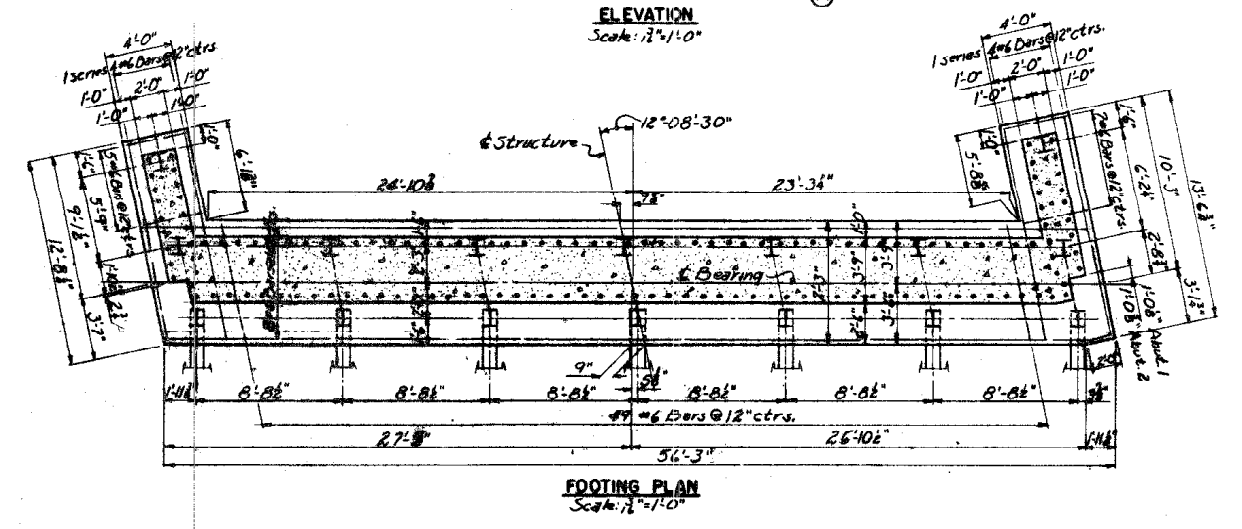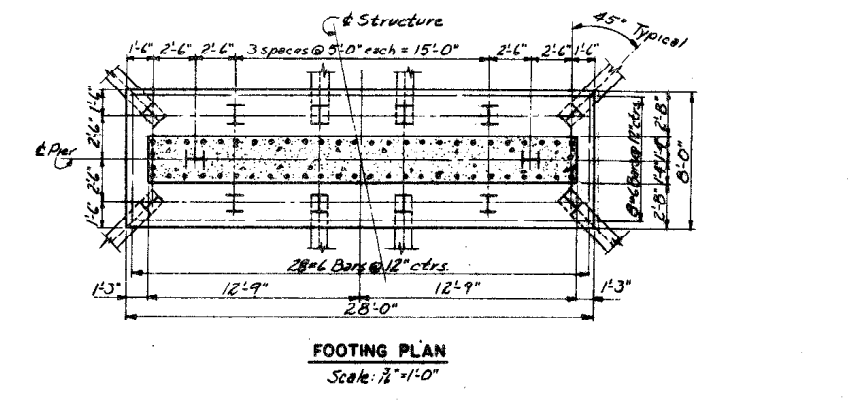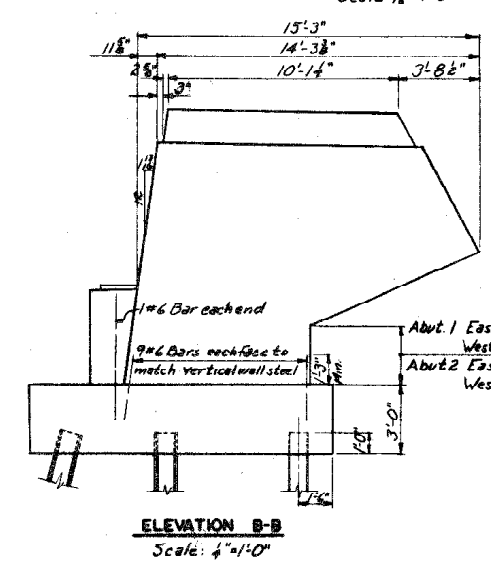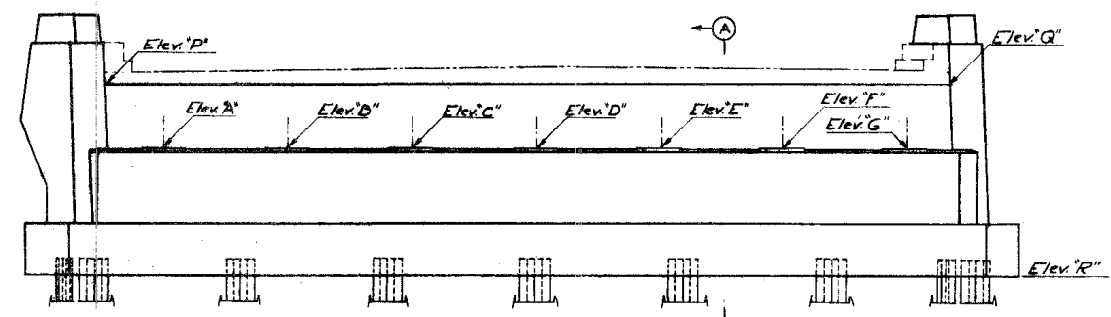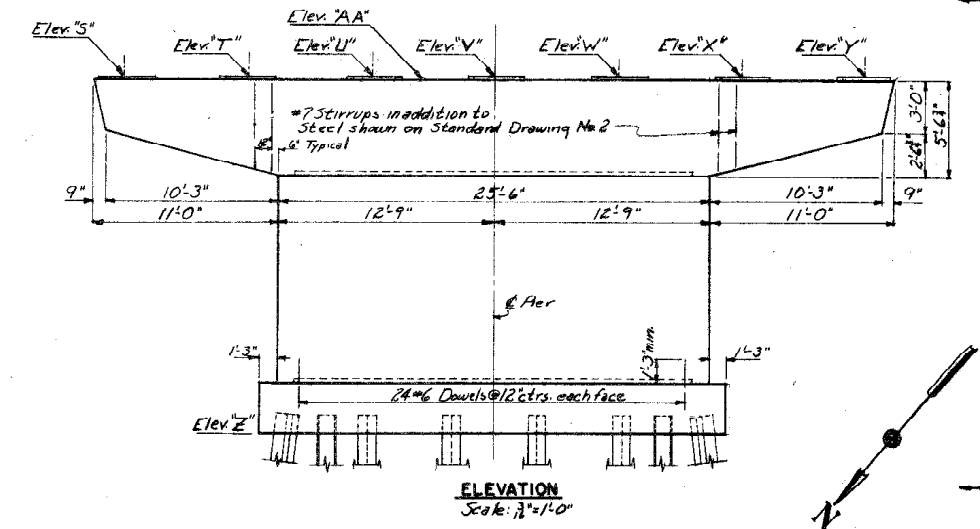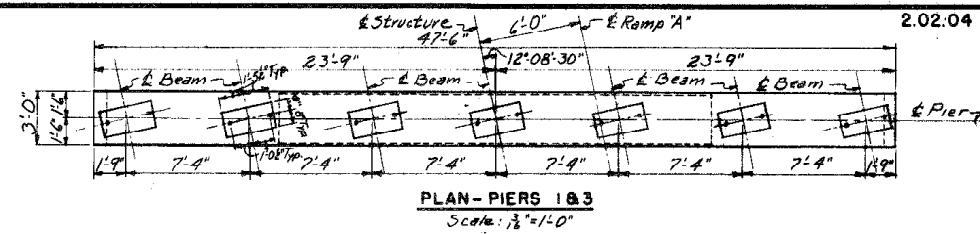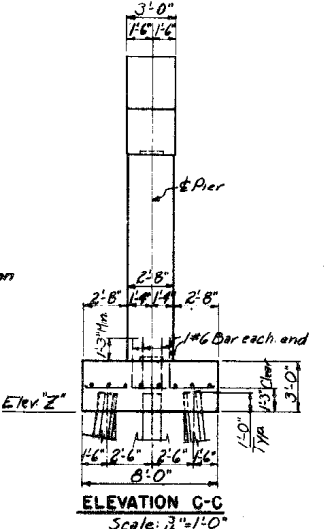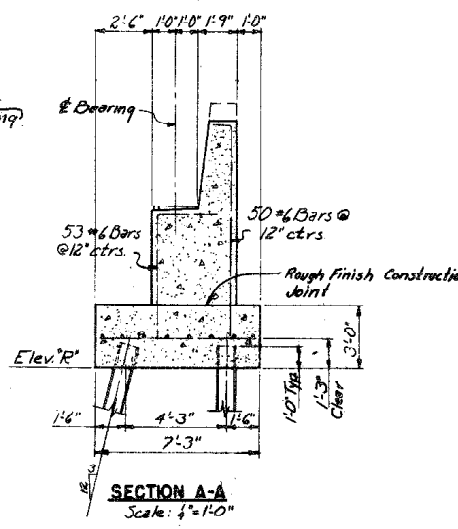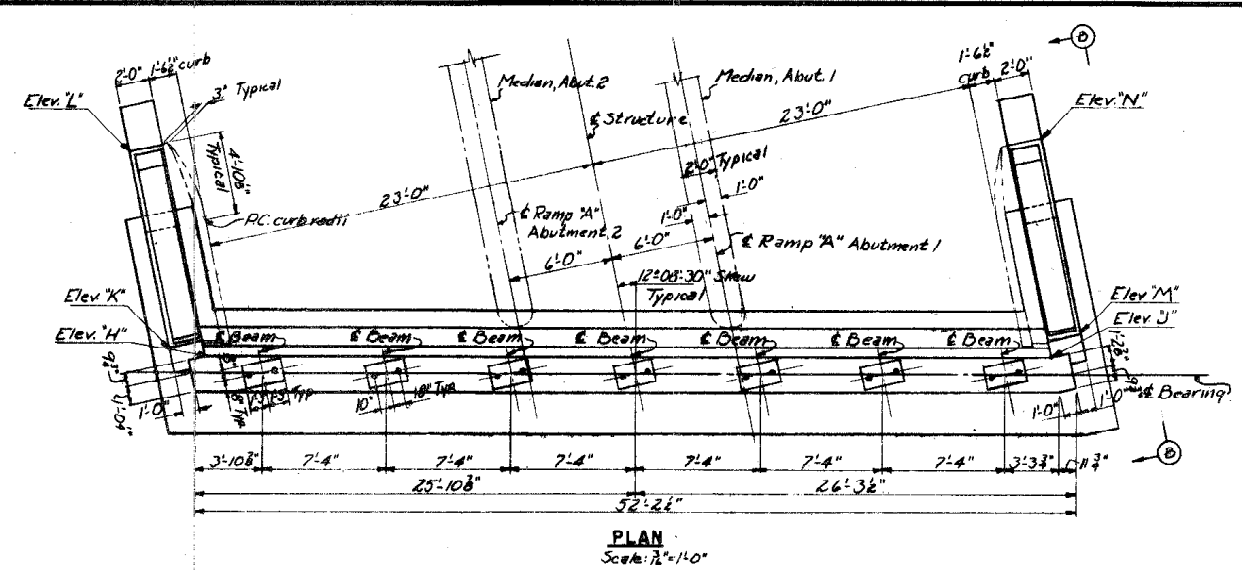

PIER ELEVATIONS									
Point	S	T	U	V	W	X	Y	Z	AA
Pier 1	77.60	77.67	77.76	77.85	77.91	77.85	77.81	60.50	77.58
Pier 2	78.29	78.31	78.39	78.46	78.51	78.44	78.41	57.50	78.27
Pier 3	77.63	77.64	77.71	77.77	77.80	77.72	77.68	60.00	77.61

Notes:  
 Abutments similar by rotation except as shown.  
 Piles in abutments are 10 B P 48  
 Piles in piers are 12 B P 53  
 Batter piles 3" per foot where shown.

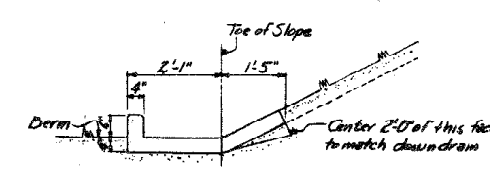


ABUTMENT ELEVATIONS																
Point	A	B	C	D	E	F	G	H	J	K	L	M	N	P	Q	R
Abutment 1	77.10	77.19	77.29	77.39	77.46	77.41	77.37	77.00	77.30	83.39	83.70	83.67	83.49	80.89	81.17	82.90
Abutment 2	77.07	77.13	77.23	77.21	77.16	77.11	77.10	76.99	77.02	83.35	83.44	83.40	83.21	80.85	80.97	82.90

DRAWING NO. 2.02.04

BY	DATE	REVISION	BY	DATE
MADE	R.S.G.	3-30-54		
TRACED				
CHECKED	M.J.G.	4-3-54	As-Built	MSB 1/26/54
IN CHARGE OF	L.D.S.K.			


MAINE TURNPIKE AUTHORITY  
**MAINE TURNPIKE**  
 SECTION 2 - PORTLAND TO AUGUSTA  
 STRUCTURE NO. 2 TURNPIKE UNDER  
 SOUTH PORTLAND INTERCHANGE, RAMP "A"  
 STA. 2223 + 08.08  
**ABUTMENTS AND PIERS**  
 HOWARD, NEEDLES, TAMMEN & BERGENDOFF SCALE: As Shown  
 CONSULTING ENGINEERS CONTRACT NO. \_\_\_\_\_  
 NEW YORK KANSAS CITY SHEET NO. 26 OF 222

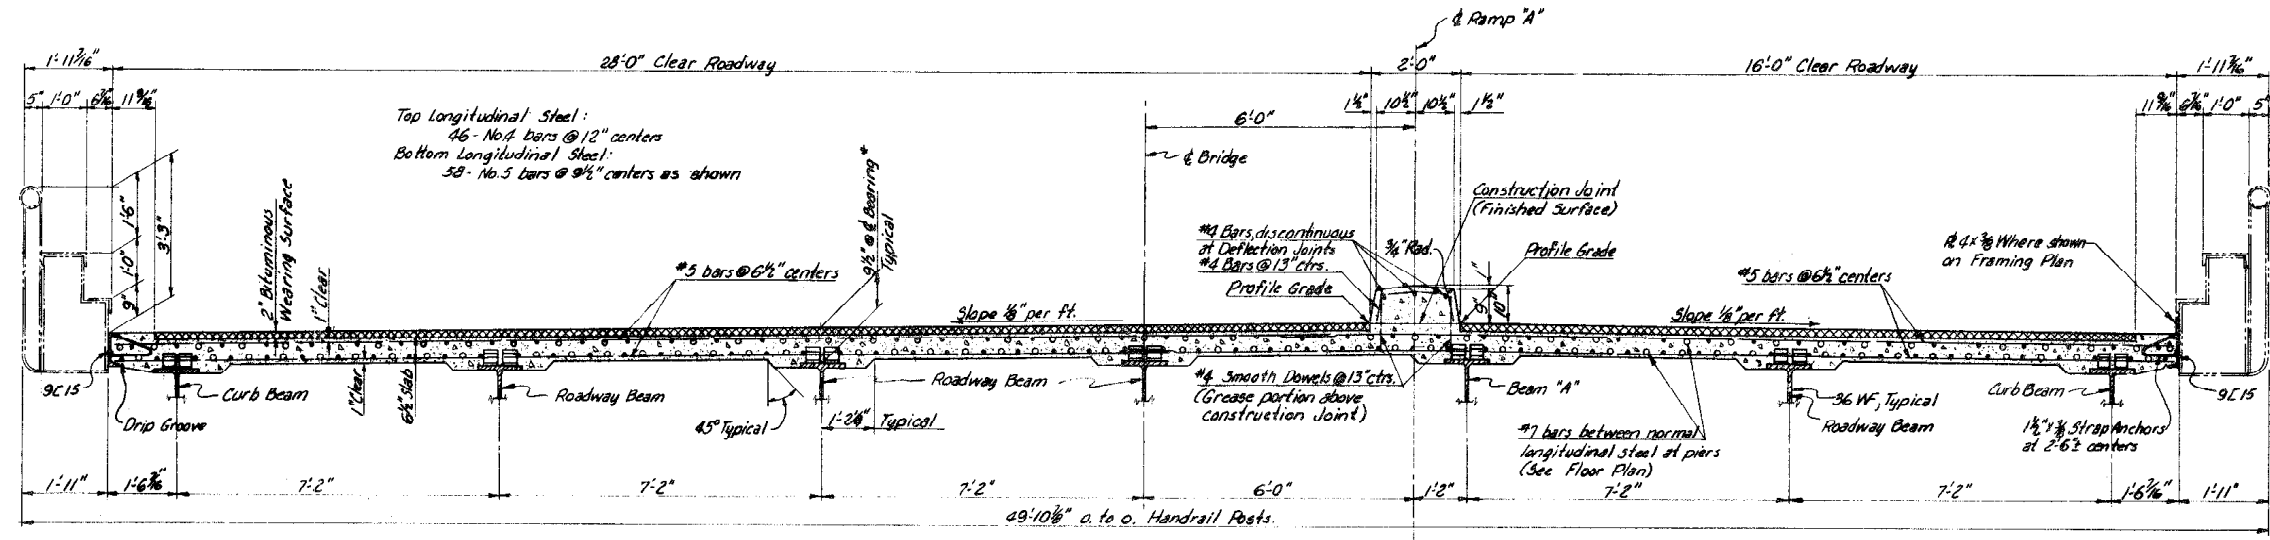


See Standard Drawing No. 20 For Steel Curb and Handrail Details.

\*The depth of concrete over the tops of beams shall be varied as necessary to insure uniform floor thickness between haunches and conformity of final surface of floor with required elevations after deflection under full dead load.


CROSS SECTION  
Scale: 1/2" = 1'-0"

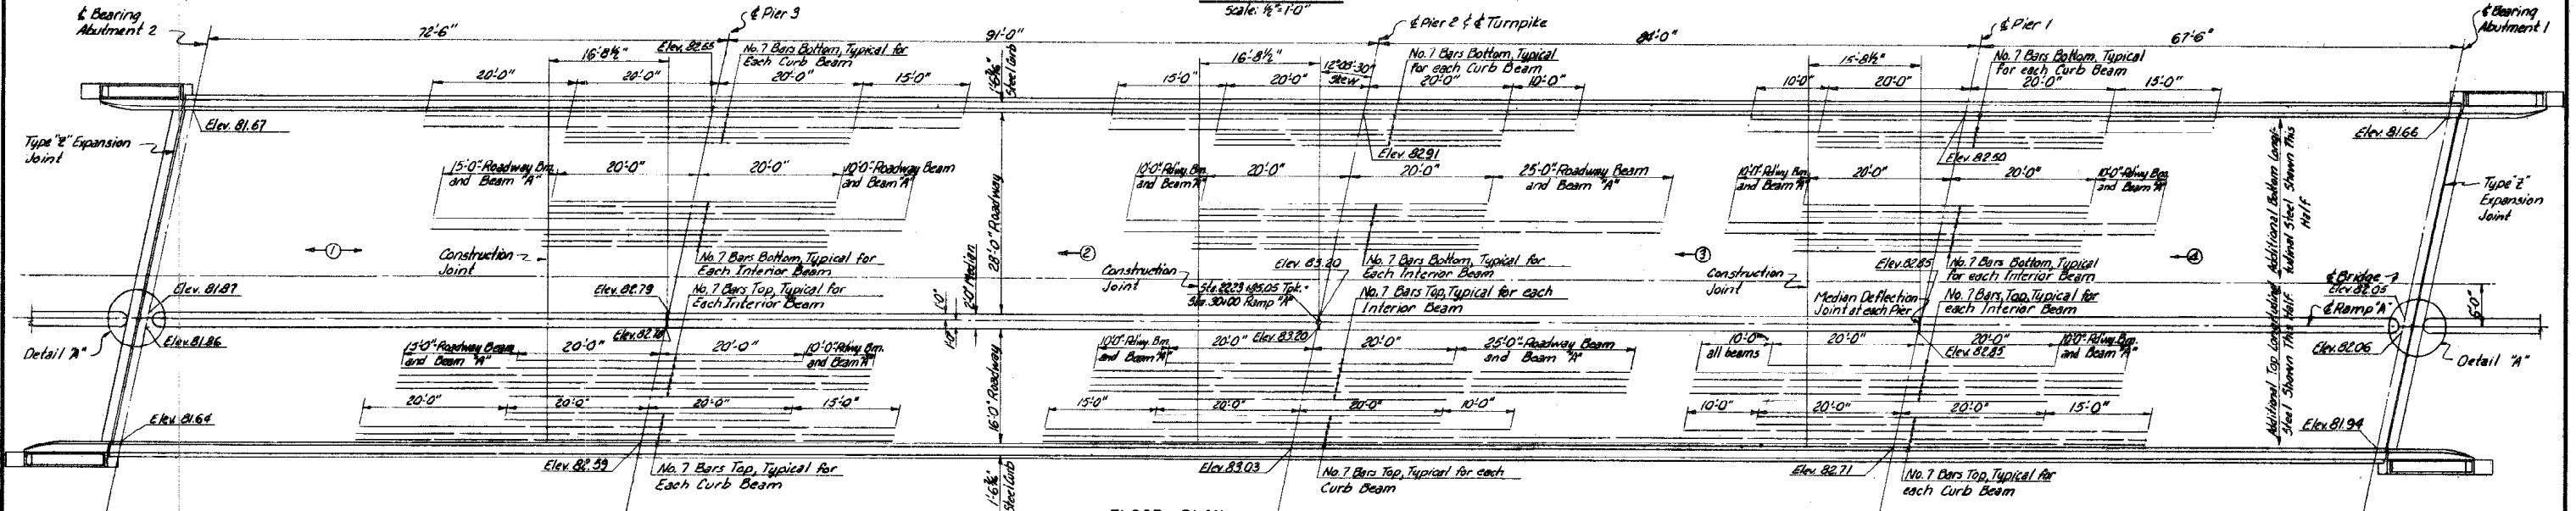

FLOOR PLAN  
Scale: 1/2" = 1'-0"

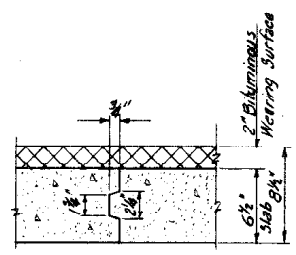

CONSTRUCTION JOINT  
Scale: 1 1/2" = 1'-0"

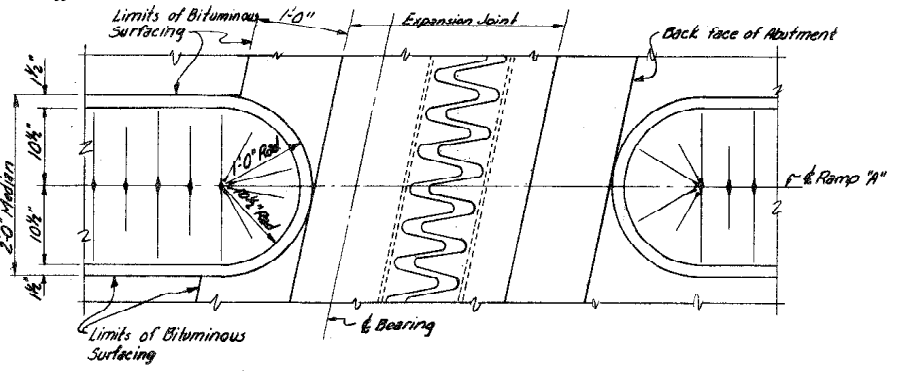

DETAIL "A"  
Scale: 1" = 1'-0"


Notes: Elevations shown on Floor Plan are to top of finished roadway.  
Concrete placing sequence and direction noted thus, →

For details of Cross Section not shown, see Standard Drawings Nos. 6 and 20.

DRAWING NO. 2.03.04

BY	DATE			
MADE	M.J.G.	3-30-54		
TRACED				
CHECKED	R.S.G.	4-3-54	As-Built	H.B.H. 12-21-54
IN CHARGE OF	I.D.S.A.	No.	REVISION	BY DATE


MAINE TURNPIKE AUTHORITY  
**MAINE TURNPIKE**  
 SECTION 2 — PORTLAND TO AUGUSTA  
 STRUCTURE NO. 2 TURNPIKE UNDER  
 SOUTH PORTLAND INTERCHANGE RAMP "A"  
 STA. 2223 + 89.05  
**CROSS SECTION AND FLOOR PLAN**  
 HOWARD, NEEDLES, TAMMEN & BERGENDOFF  
 CONSULTING ENGINEERS  
 NEW YORK KANSAS CITY  
 SCALE: As Shown  
 CONTRACT NO. \_\_\_\_\_  
 SHEET NO. 37 OF 382

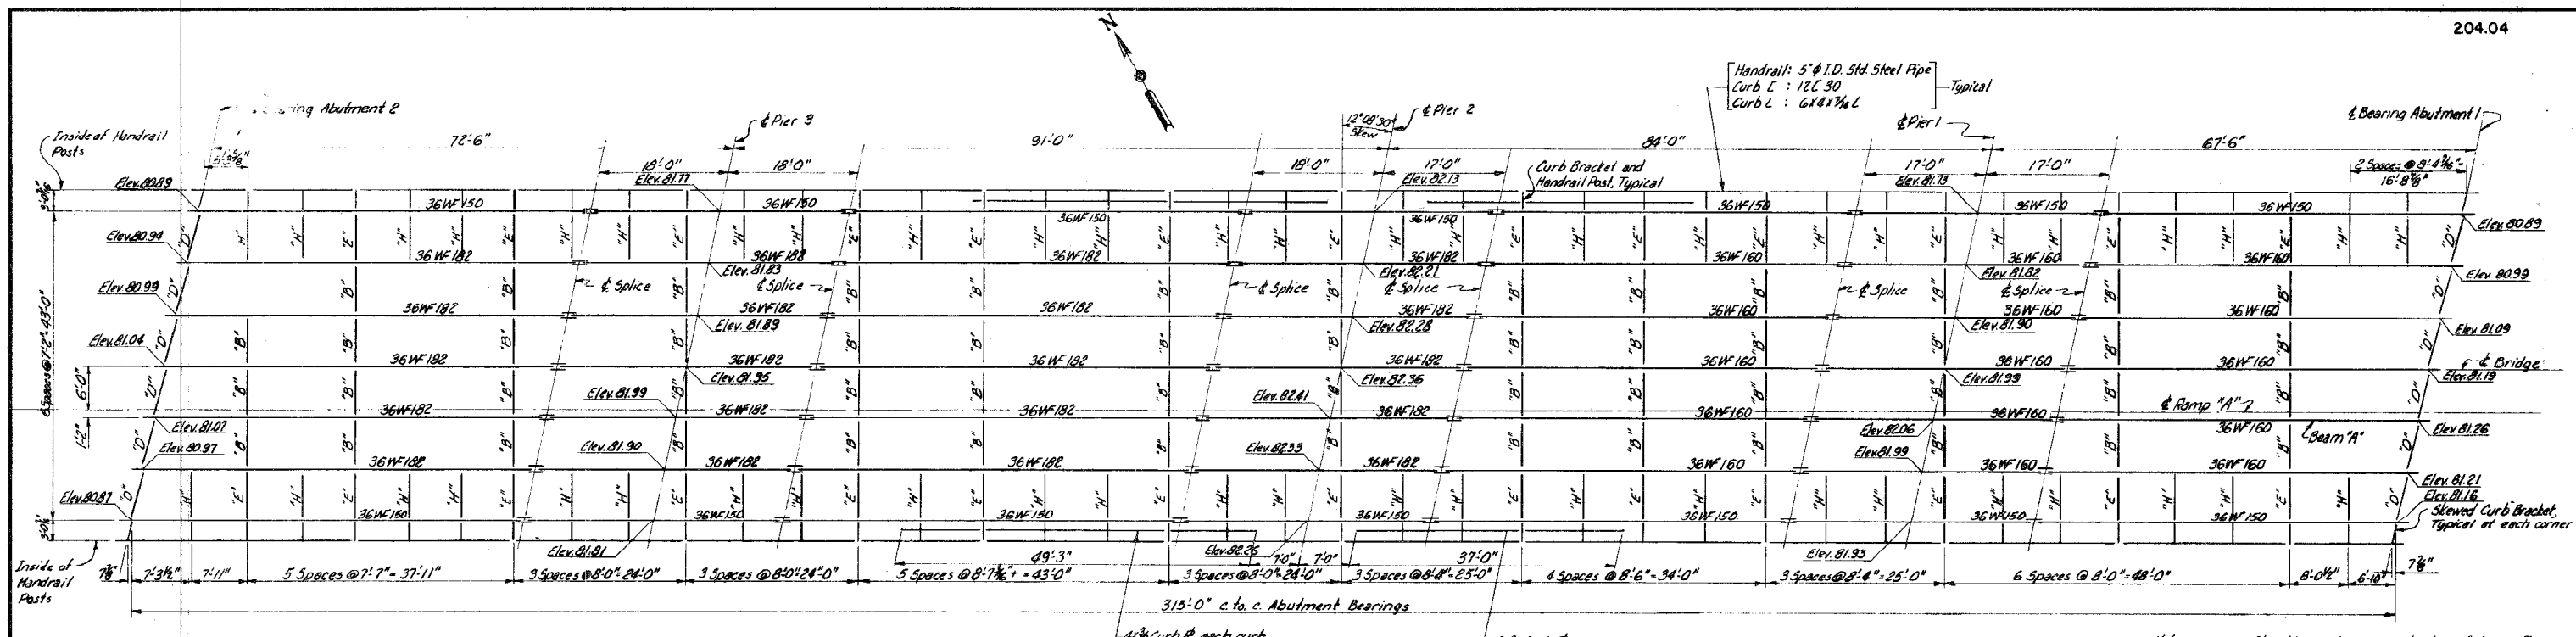

**FRAMING PLAN**  
Scale: 1/8" = 1'-0"

Note: Stiffener angles at points of support shall be milled to bear at bottom and tight fit at top.



Notes: Elevations shown are to top of beam flanges in place. Diaphragms are noted thus: "B", "D", "E" (See Standard Drawing No. 20). Curb bracket struts (3/4"x3/4"x1/2") are noted thus: "H" (See Standard Drawing No. 20).

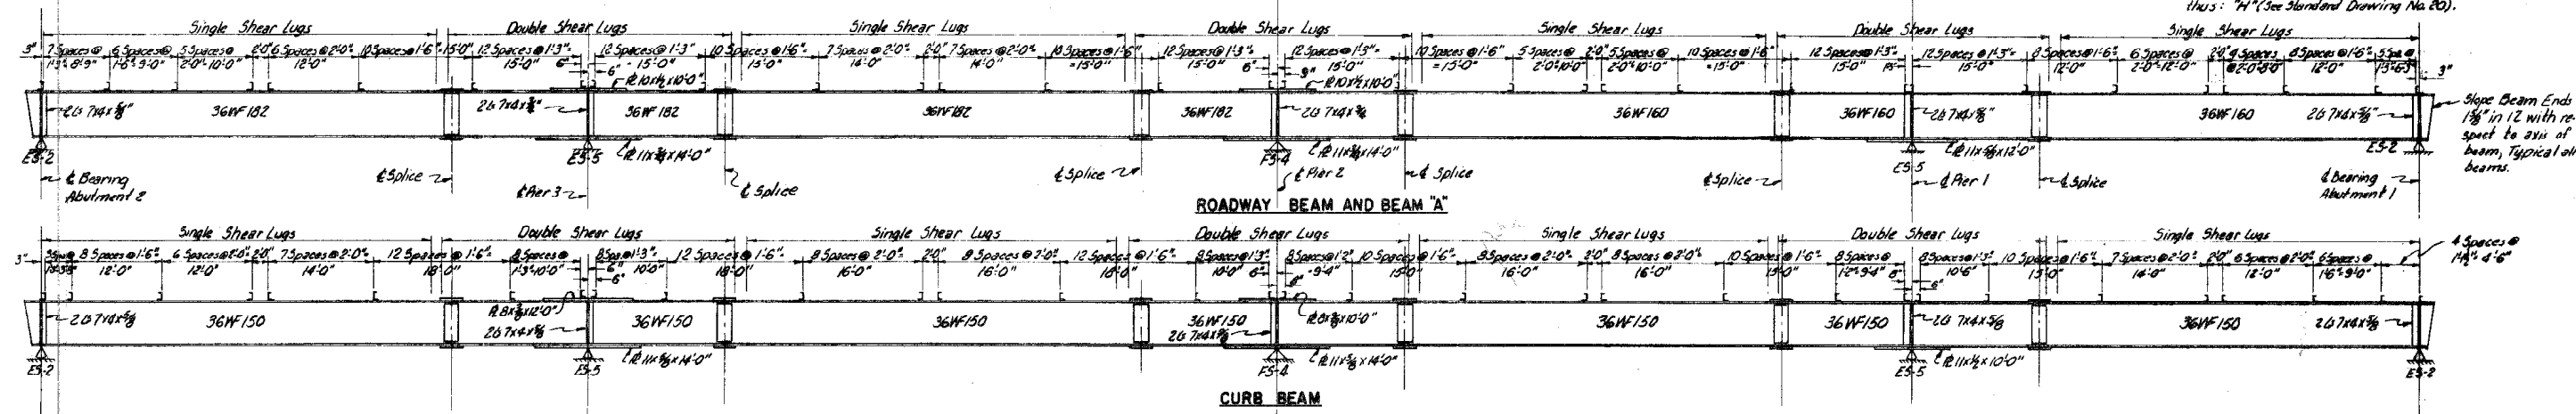

**BEAM ELEVATIONS**  
Scale: 1/8" = 1'-0" Horizontal, 1/4" = 1'-0" Vert.

Notes: All cover plates are centered on piers.


Position of shear lugs on beam splice may be offset from that shown so as to fit lugs to splice rivet pattern. (See Detail "B")  
All shear lugs are 4x3/4" BA119. See Standard Drawing No. 5

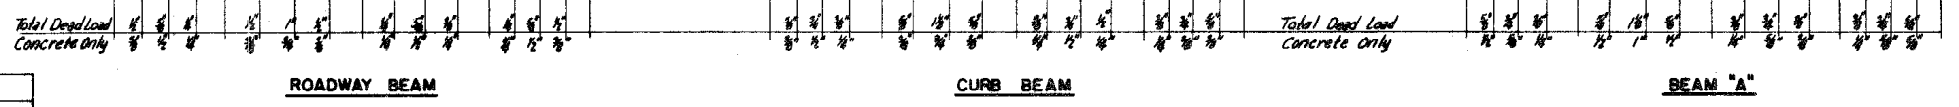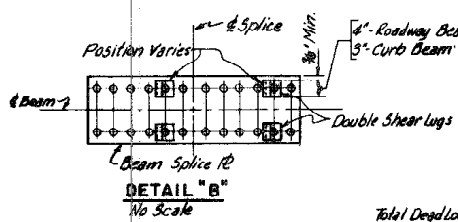


**DEAD LOAD DEFLECTION DIAGRAMS**  
No Scale

DRAWING NO. 204.04			
BY	DATE		
MADE	M.J.G.	4-1-54	
TRACED			
CHECKED	R.S.C.	4-3-54	1 As-Built
IN CHARGE OF	I.D.S.K.		
	NO.	REVISION	BY DATE

MAINE TURNPIKE AUTHORITY <b>MAINE TURNPIKE</b> SECTION 2 — PORTLAND TO AUGUSTA	
STRUCTURE NO. 2 SOUTH PORTLAND INTERCHANGE RAMP "A" STA. 2223 + 85.00	TURNPIKE UNDER SOUTH PORTLAND INTERCHANGE RAMP "A" STA. 2223 + 85.00
<b>FRAMING PLAN AND BEAM DETAILS</b>	
HOWARD, NEEDLES, TAMMEN & BERGENDOFF CONSULTING ENGINEERS NEW YORK      KANSAS CITY	SCALE: As Shown CONTRACT NO. _____ SHEET NO. 22 of 382

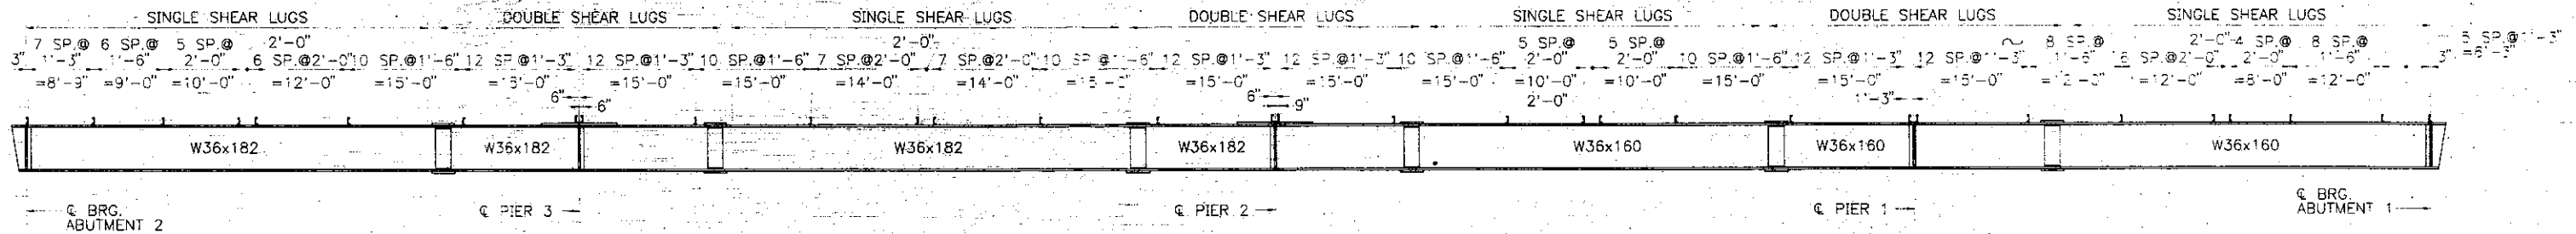

INTERIOR STRINGERS

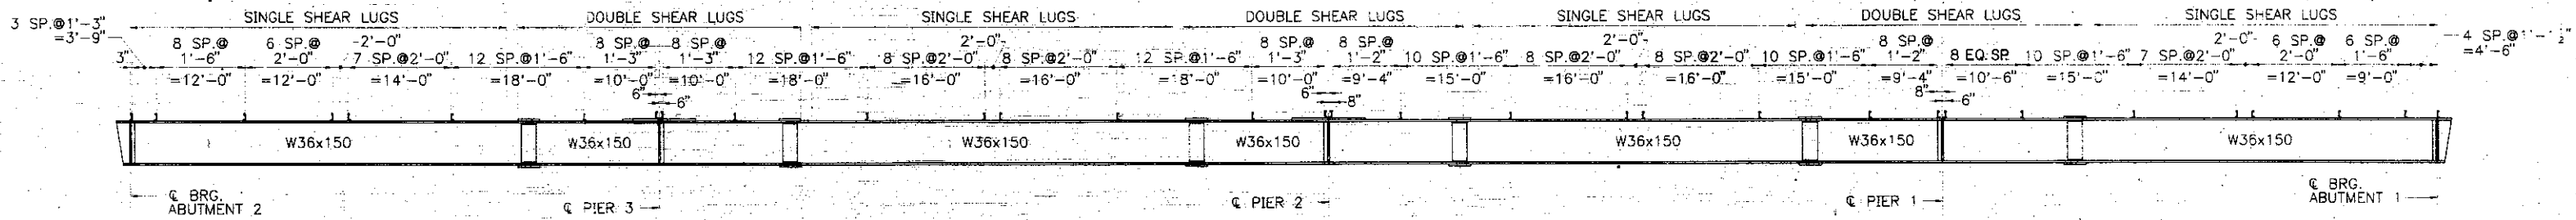

FASCIA STRINGER

EXISTING SHEAR LUG LAYOUT

HORIZ.  $\frac{3}{32}'' = 1'-0''$   
 VERT.  $\frac{3}{16}'' = 1'-0''$

Maine Turnpike Authority  
 Maine Turnpike

SOUTH PORTLAND  
 INTERCHANGE BRIDGE

MISCELLANEOUS DETAILS II



HOWARD NEEDLES TAMMEN & BERGENDOFF  
 ARCHITECTS ENGINEERS PLANNERS

By	Date
Designat	DMD 3/95
Drawn	MAA 3/95
Checked	HNL 3/95
No.	Revision
By	Date
In Charge Of	RAL

Contract 95.6 Sheet No. SI-7  
 26 of 30