

STATE OF MAINE
STATE HIGHWAY COMMISSION

PLANS

YORK

YORK COUNTY


MAINE FEDERAL AID INTERSTATE

PROJECT NO. 1-95-1 (8) 7

TOTAL LENGTH 0.511 MILES


SCALES { PLAN 1 IN. = 50 FT.
PROFILE { HOR. 1 IN. = 50 FT.
VER. 1 IN. = 5 FT. } OR AS SHOWN
CROSS SECTIONS 1 IN. = 5 FT.

AS CONSTRUCTED
1969 - 1970

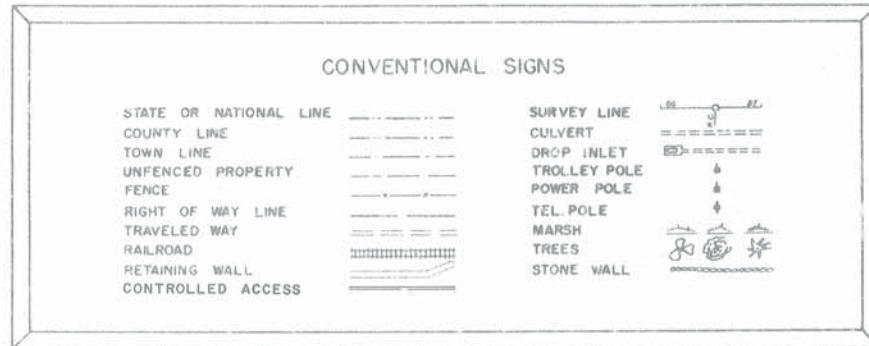


INDEX OF SHEETS

SHEET NO.	TITLE PAGE
1	TITLE PAGE
2-3	TYPICAL SECTIONS
4-5	QUANTITIES
6-16	STANDARD DETAILS
17-40	TOLL PLAZA PLANS
41-44	PLAN AND PROFILE STA. 252+00 TO STA. 281+00
45-46	DETOUR PLAN AND PROFILE
47	GRADING PLAN
48	EXISTING KITTERY TOLL PLAZA PLAN
49-56	CROSS SECTION STA. 252+00 TO STA. 281+00
57-58	CROSS SECTION - ACCESS RD.

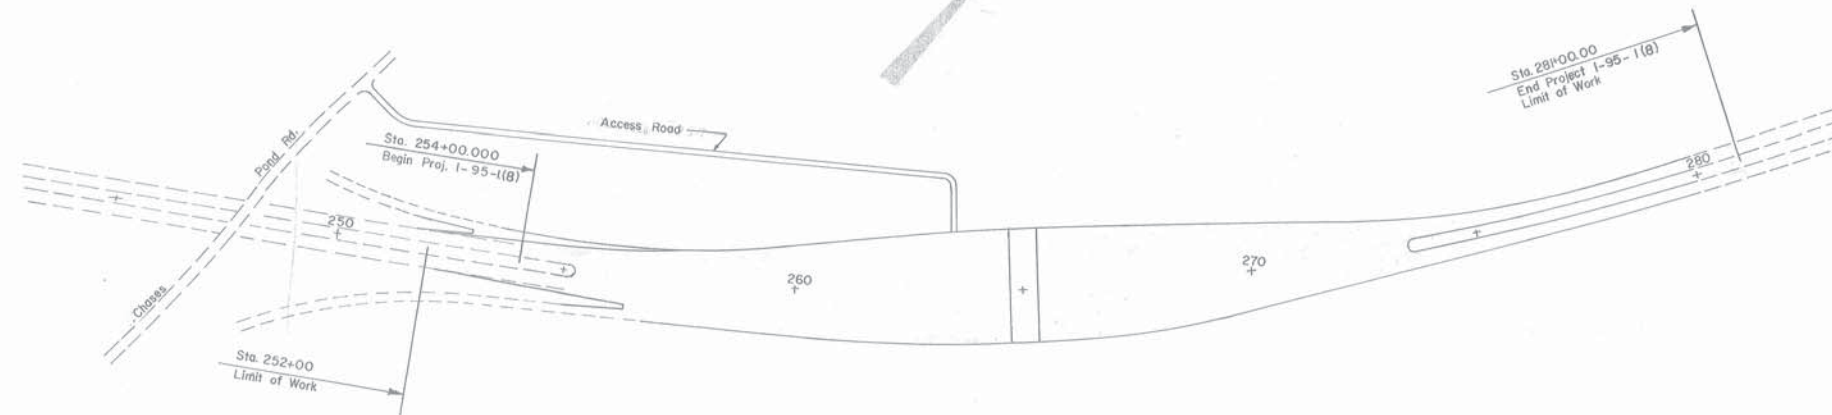

LAYOUT PLAN
SCALE: 1" = 200'

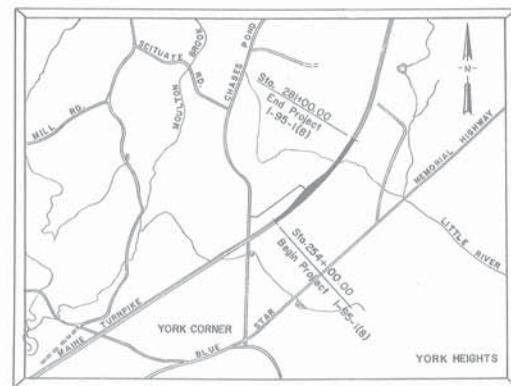

A PORTION OF YORK COUNTY

SCALE 1" = 2000'

NOTE
All Work Contemplated Under This Contract To Be Governed By And In Conformity With The Standard Specifications (Revision Of June 1968) And Supplementals Thereto, Except As Modified On The Plans And In The Special Provisions.

TRAFFIC DATA

A.D.T. 1970 14,600
A.D.T. 1990 33,700
D.H.V. 5,729
T. (%) 13.7
D. (%) 70
V. Not Applicable

APPROVED:
MAINE STATE HIGHWAY COMMISSION

David G. Stevens CHIEF ENGINEER
Stephen D. Shaw
Robert G. Leopold
Agnes L. Poor CHIEF ENGINEER

DATE
APRIL 9, 1969
APRIL 9, 1969
APRIL 9, 1969
APRIL 9, 1969




HOWARD, NEEDLES, TAMMEN & BERGENDOFF
CONSULTING ENGINEERS
NEW YORK BOSTON KANSAS CITY

Van Wachtel Mar 28, 1969 DATE

DEPARTMENT OF TRANSPORTATION
FEDERAL HIGHWAY ADMINISTRATION
BUREAU OF PUBLIC ROADS
REGION 1


APPROVED:
DIVISION ENGINEER DATE



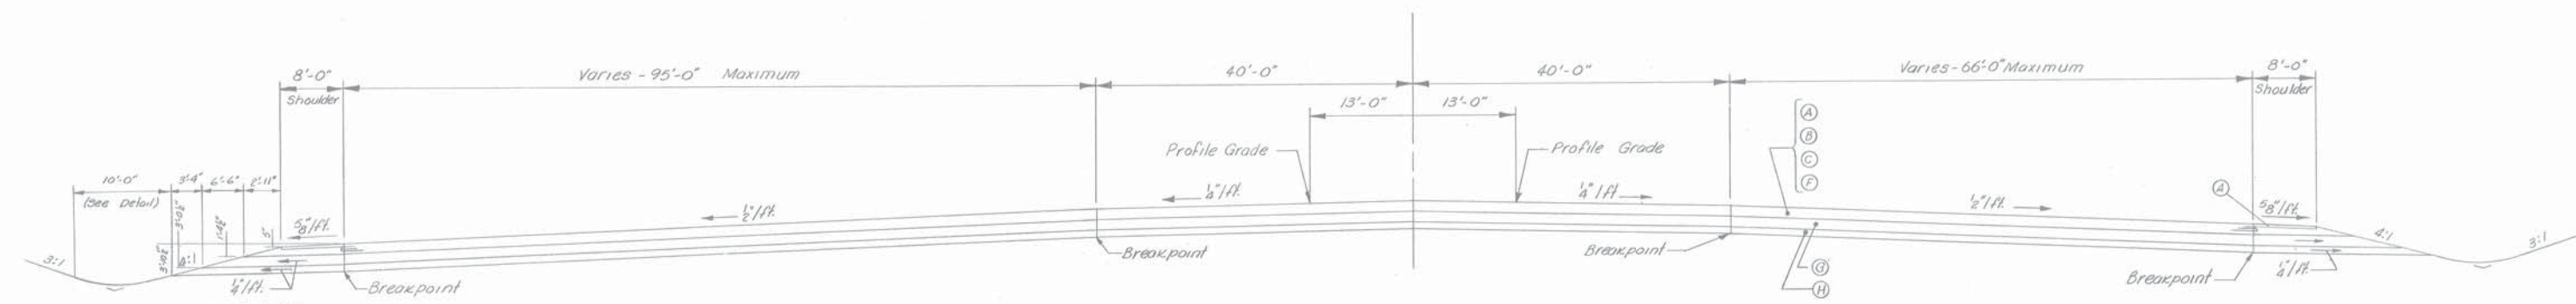

8' SHOULDER
 28.50
 Aggregate Base Course - Crushed = 26.90 C.Y./100 L.F.
 18" Aggregate Subbase Course - Gravel = 79.57 C.Y./100 L.F. 78.58
 9" Aggregate Subbase Course - Granular = 54.26 C.Y./100 L.F. 53.05




VARIABLE WIDTH PAVEMENT
 4" Aggregate Base Course - Crushed = 1.23 C.Y./ft. of width/100 L.F.
 18" Aggregate Subbase Course - Gravel = 5.56 C.Y./ft. of width/100 L.F.
 9" Aggregate Subbase Course - Granular = 2.78 C.Y./ft. of width/100 L.F.

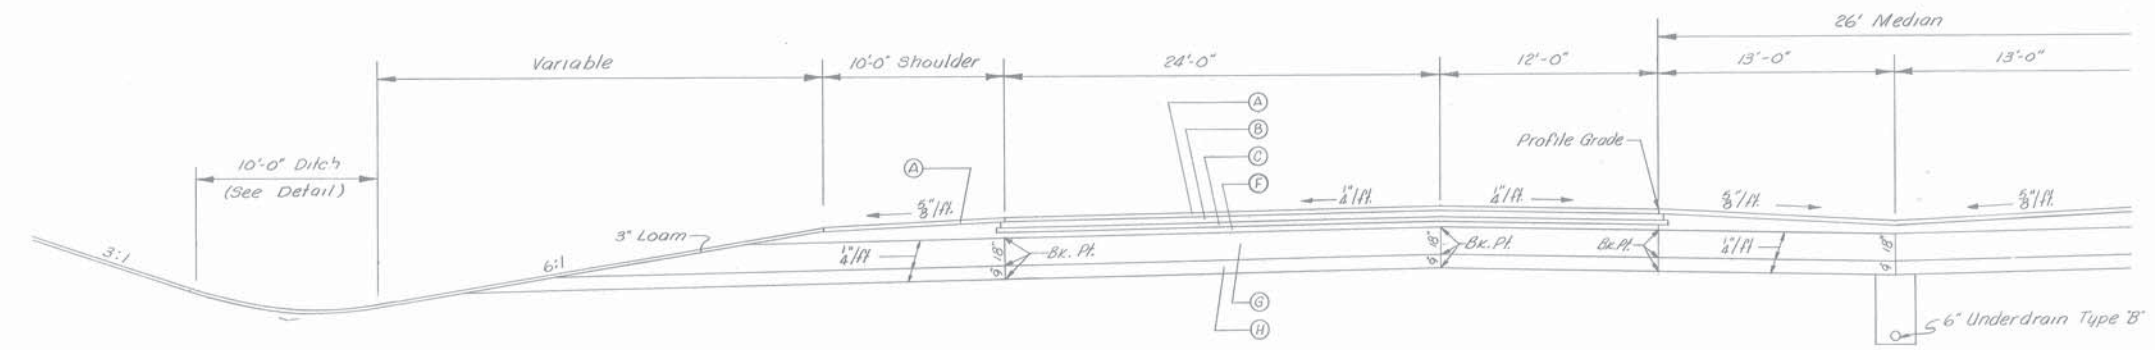

10' SHOULDER
 Aggregate Base Course - Crushed = 31.99 C.Y./100 L.F.
 18" Aggregate Subbase Course - Gravel = 107.88 C.Y./100 L.F. 94.74
 9" Aggregate Subbase Course - Granular = 71.62 C.Y./100 L.F.

36' PAVEMENT
 4" Aggregate Base Course - Crushed = 44.00 C.Y./100 L.F.
 18" Aggregate Subbase Course - Gravel = 200.00 C.Y./100 L.F.
 9" Aggregate Subbase Course - Granular = 100.00 C.Y./100 L.F.

26' MEDIAN
 Aggregate Base Course - Crushed = 69.68 C.Y./100 L.F.
 18" Aggregate Subbase Course - Gravel = 144.44 C.Y./100 L.F.
 9" Aggregate Subbase Course - Granular = 72.22 C.Y./100 L.F.

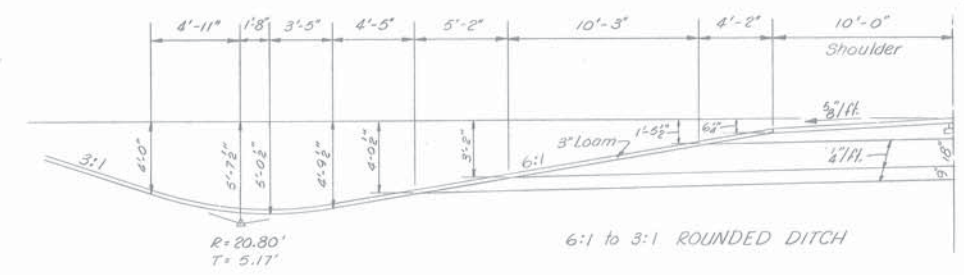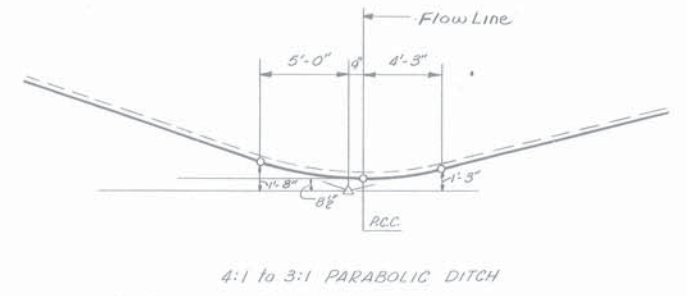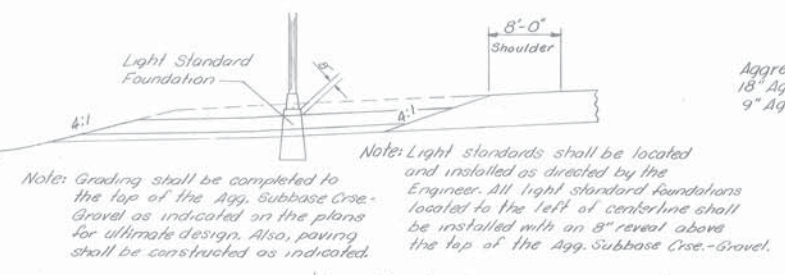

SURFACE TREATMENT OF ACCESS ROAD
 The bituminous treatment of the Access Road shall consist of a Prime Coat of RT-5, Item 410.13 and Cover Coat Material - Sand, Item 410.16 (if required) followed by a Seal Coat of RT-6, Item 410.13 and Cover Coat Material - Sand, Item 410.16.
 The use of rollers as specified in subsection 405.05 and 410.05 may be substituted by adequate rolling in accordance with subsection 411.04.

- COMPLIMENTARY NOTES**
- The bituminous binder material for the mixture shall be Penetration Grade (85-100) asphalt cement and will be paid for separately under Item 403.14.
 - The asphalt contents shown are to serve as a guide only and are not specifications.
 - Mixtures meeting the aggregate gradation of "B" or "C" above may be used for the bottom layer with payment to be made under Item 403.12.
 - The density requirements are waived.
 - The type of bituminous material shall conform to the option provided in subsection 310.03 of the Standard Specifications.
 - When directed by the Engineer, this course may be placed in one layer.

BITUMINOUS MATERIALS								
LOCATION	ITEM NO.	DESCRIPTION	NO. OF LAYERS	TOTAL THICK.	WIDTH	GRADATION DESIGNATION	ASPHALT % OF MIX	COMP. NOTES
A	403.09	Hot Bituminous Pavement	1	1 1/2"	Varies	C	7.0	1,2
	403.07	"	1	1 3/4"	Varies	B	5.5	1,2
B	301.08	Plant Mix Bituminous Base Course	2	4"	Varies	A	5.0	1,2
C	310.11	Bituminous Stabilized Base	1	3"	Varies	Item 703.17	4.0	2,5
AGGREGATE MATERIALS								
F	304.09	Aggregate Base Course - Crushed		4"				
G	304.10	Aggregate Subbase Course - Gravel		18"				
H	304.11	Aggregate Subbase Course - Granular		9"				


MAINE STATE HIGHWAY COMMISSION
 AUGUSTA, MAINE

TYPICAL SECTION
 I-95

HOWARD, NEEDLES, TAMMEN & BERGENDOFF
 CONSULTING ENGINEERS


NEW YORK BOSTON KANSAS CITY

D. P. R. REG. NO.	STATE	PROJECT NUMBER	SHEET NO.	TOTAL SHEETS
1	MAINE	1-95-1(8)	3	58

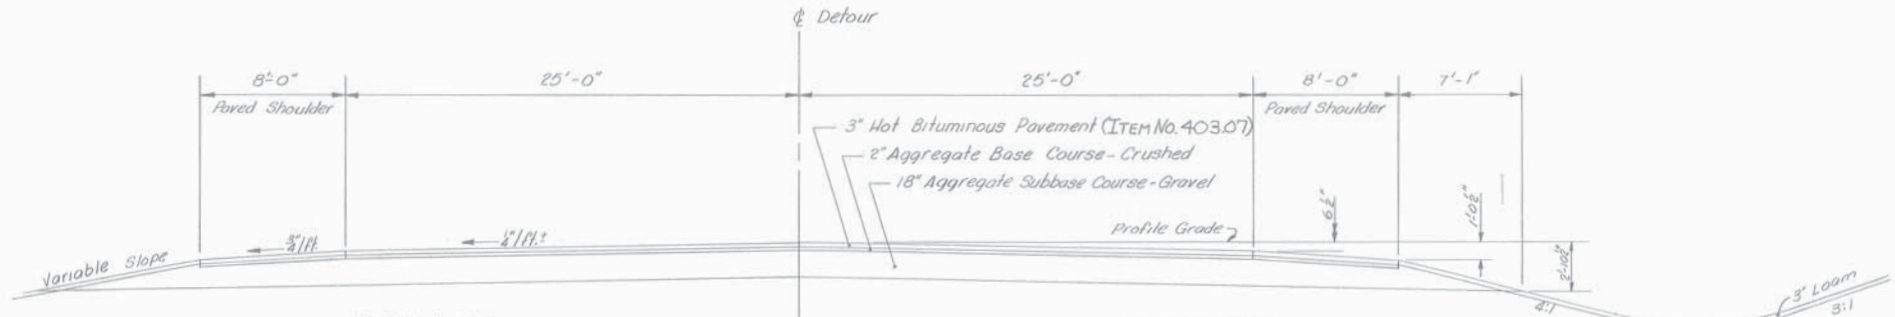


8' SHOULDER
Normal and Low Side of Superlevation
Aggregate Subbase Course - Gravel = 36.97 C.Y./100 L.F.
2" Aggregate Base Course - Crushed = 4.94 C.Y./100 L.F.

50' PAVEMENT
2" Aggregate Base Course - Crushed = 30.87 C.Y./100 L.F.
18" Aggregate Subbase Course - Gravel = 277.78 C.Y./100 L.F.

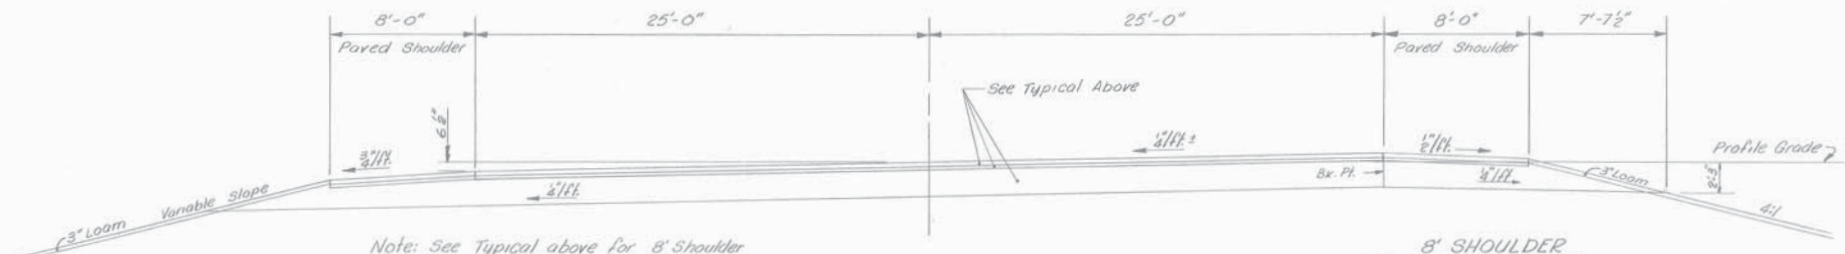


Note: See Typical above for 8' Shoulder and 50' Pavement Quantity Factors.

8' SHOULDER
High Side of Superlevation
Aggregate Subbase Course - Gravel = 38.17 C.Y./100 L.F.
2" Aggregate Base Course - Crushed = 4.94 C.Y./100 L.F.

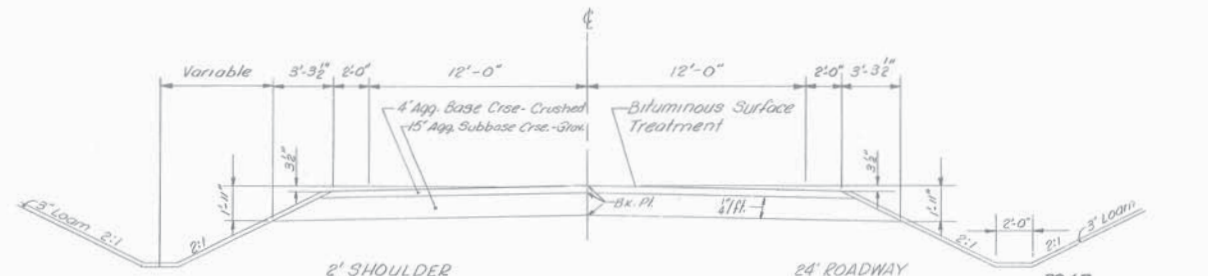

2' SHOULDER
4" Aggregate Base Course - Crushed = 2.95 C.Y./100 L.F.
15" Aggregate Subbase Course - Gravel = 18.36 C.Y./100 L.F.


24' ROADWAY
4" Aggregate Base Course - Crushed = 29.63 C.Y./100 L.F.
15" Aggregate Subbase Course - Gravel = 111.11 C.Y./100 L.F.

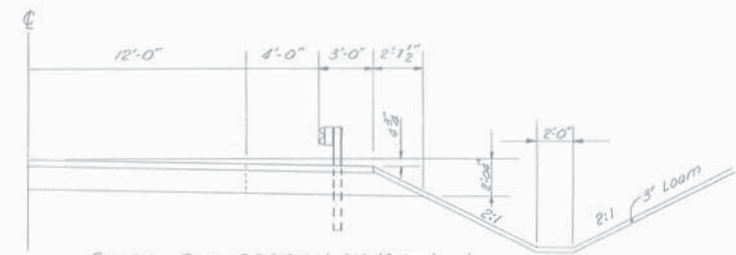

GUARD RAIL SECTION (Half Section)
7' Shoulder - Low Side of Superlevation
4" Aggregate Base Course - Crushed = 8.56 C.Y./100 L.F.
15" Aggregate Subbase Course - Gravel = 19.29 C.Y./100 L.F.

7' Shoulder - High Side of Superlevation
4" Aggregate Base Course - Crushed = 8.56 C.Y./100 L.F.
15" Aggregate Subbase Course - Gravel = 19.29 C.Y./100 L.F.

Note: The 7' high-side shoulder shall be grade at 1/4" slope up and the subgrade at 1/4" slope up.

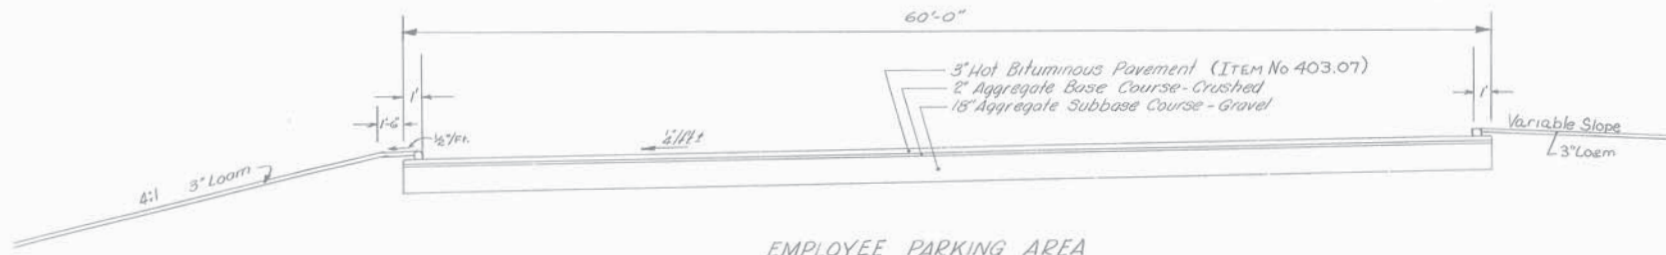

EMPLOYEE PARKING AREA

MAINE STATE HIGHWAY COMMISSION
AUGUSTA, MAINE

TYPICAL SECTION
DETOUR, ACCESS Rd. & PARK AREA

HOWARD, NEEDLES, TAMMEN & BERGENDOFF
CONSULTING ENGINEERS
NEW YORK BOSTON KANSAS CITY

ESTIMATED QUANTITIES

ITEM NO.	DESCRIPTION	QUANTITY	UNIT
201.11	Clearing	11.446	Acre
201.12	Selective Clearing and Thinning	7.342	Acre
202.16	Removal of Existing Kittery Toll Plaza	1	L.S.
203.20	Common Excavation	28,697	C.Y.
203.24	Common Borrow		C.Y.
203.25	Granular Borrow	77,040	C.Y.
206.06	Structural Earth Excavation - Drainage and Minor Structures	877	C.Y.
206.07	Structural Rock Excavation - Drainage and Minor Structures	15.5	C.Y.
301.08	Plant Mix. Bit. Base Course - Grading A	7,617.97	Ton
301.12	Asphalt Cement, Base Course	326.19	Ton
304.09	Aggregate Base Course - Crushed	55566	C.Y.
304.10	Aggregate Subbase Course - Gravel	150,143	C.Y.
304.11	Aggregate Subbase Course - Granular	9812	C.Y.
310.11	Bituminous Stabilized Base Course (3 inches)	32,130	S.Y.
403.07	Hot Bituminous Pavement, Grading B	6,924.90	Ton
403.09	Hot Bituminous Pavement, Grading C (Crushed Ledge)	2,288.28	Ton
403.121	Hot Bituminous Pavement, Grading E (Shimming)	882.20	Ton
403.14	Asphalt Cement, Hot Bituminous Surface Pavements	637.16	Ton
410.13	Tar, Applied	2714	Gal.
410.16	Cover Coat Material, Sand	48.6	C.Y.
501.21	Steel H-Beam Piles 42 lb./ft.	14,527.50	L.F.
501.21	Steel H-Beam Piles 72 lb./ft. Cuts	460	L.F.
603.155	12 inch Reinforced Concrete Pipe Class III	166	L.F.
603.172	18 inch Bituminous Coated Corr. Metal Pipe	44	L.F.
603.245	54 inch Reinforced Concrete Pipe Class III	80	L.F.
604.09	Catch Basin Type B-1	2	Each
605.09	6 inch Underdrain Type B	1524	L.F.
606.17	Guard Rail Type 3b - Single Rail		L.F.
606.22	Guard Rail Type 3b - Circular - Greater than 15 Foot Radius		L.F.
606.26	Terminal Ends - Single Rail		Each
607.09	Woven Wire Fence - Metal Posts	4407	L.F.
607.32	Bracing Assembly, Type I - Metal Posts	4	Each
607.33	Bracing Assembly, Type II - Metal Posts	6	Each
609.32	Curb Type 3a	330.5	L.F.
610.09	Hand Laid Riprap	156	C.Y.
610.12	Portland Cement for Riprap Grout		Bbl.
612.06	Bituminous Hand Sealing - Black	37	S.Y.
615.07	Loom	3558	C.Y.
616.08	Sodding	369	S.Y.
617.10	Erosion Control Mesh (Heavy Duty)	19	S.Y.
618.14	Seeding, Method Number 2	381	Unit
619.08	Hay Mulch	25.15	Ton
623.06	Right of Way Monuments	8	Each
* 629.05	Hand Labor, Straight Time	156.5	M.Hr.
* 630.06	Traffic Officers	254	M.Hr.
* 631.09	Aerator (Including operator)		Hour
* 631.10	Air Compressor (Including operator)	39	Hour
* 631.11	Air Tool (Including operator)	59	Hour
* 631.12	All Purpose Excavator (Including operator)	1	Hour
* 631.13	Bulldozer (Including operator)	3.5	Hour
* 631.14	Grader (Including operator)	2	Hour
* 631.172	Truck - Large (Including operator)		Hour
* 631.22	Front End Loader (inc. operator)	7.5	Hour
632.08	Warning Lights	4	Group
633.09	Portable Barricade	4	Each
633.10	Portable Barricade with Flashing Lights	4	Each
633.12	Portable Barricades Remove and Reset	4	Each
633.13	Portable Barricades with Flashing Lights Remove and Reset	4	Each
634.16	Highway Lighting	1	L.S.
634.171	Junction Box, Type A	7	Each
634.18	Steel Conduit	285	L.F.
634.19	Non-metallic Conduit	4790	L.F.
636.06	Refractorization of Bit. Concrete	4.44	S.Y.
637.07	Sprinkling	5.4	M.G.
637.08	Calcium Chloride	185	Ton
639.08	Field Office, Type A	1	Each
639.11	Testing Facilities, Soil	1	L.S.
639.12	Testing Facilities, Bituminous Mixes	1	L.S.
639.13	Testing Facilities, Bituminous Liquids and Cements	1	L.S.
650.07	Mineral Filler		Ton
650.08	Hydrated Lime		Ton
804.03	Toll Plaza Construction	1	L.S.
804.04	Toll Booth and Canopy Construction	1	L.S.

* UNDETERMINED LOCATION

ESTIMATED QUANTITIES

ITEM NO.	DESCRIPTION	QUANTITY	UNIT
916.04	Utility Building and Mechanical Work	1	L.S.
916.05	Drilling Water Well	133	L.F.
916.06	Septic Tank and Filter Bed	1	L.S.
917.06	Guaranty - Warranty	1	L.S.
918.05	Utility Service Lines	1	L.S.
EWO #2	Electrical Service	1	L.S.
EWO #5	12" CMP	96	L.F.
EWO #10	Exhaust Fan	1	L.S.
EWO #14	Telephone Booth Base Lt	1	L.S.
EWO #15	P.C.C. Sidewalk	1	L.S.
EWO #18	Tank Coat	973	Gal
EWO #19	Telephone Booth Base Rt	1	L.S.
EWO #22	Insulate Storage Tank	1	L.S.
EWO #23	Temporary Traffic Control	1	L.S.
EWO #20	Day Tank	1	L.S.
304.10	ASC Gravel for Foundations	15,07	C.Y.

SUMMARY OF EXCAVATION AND BORROW

COMMON EXCAVATION FOR ESTIMATE

Common Excavation (from cross sections)	12,385
Grubbing in Fill Sections	11,876
Total Common Excavation	24,261 Cubic Yards

FILL FOR COMMON BORROW CALCULATIONS

Fill (from cross sections)	37,570
Grubbing (fill areas) see Granular Computations	
Total Fill	37,570 Cubic Yards

AVAILABLE COMMON EXCAVATION FOR COMMON BORROW CALCULATIONS

Total Common Excavation	24,261 Cubic Yards
Deductions:	
Grubbing in Cut Areas	5,525
Grubbing in Fill Areas	11,876
Total Deductions	17,401 Cubic Yards
Total Available Common Excavation	6,860 Cubic Yards

COMPUTATIONS OF COMMON BORROW FOR ESTIMATE

Total Fill	37,570 Cubic Yards
Total Available Common Excavation 6,860 x 0.85	5,831
Total Fill Minus Total Available Common	31,739
Total Common Borrow 31,739 x 1.15	36,500 Cubic Yards

COMPUTATIONS OF GRANULAR BORROW FOR ESTIMATE

Grubbing in Fill Areas	11,876
Granular to Upgrade Excav.	5,515
Total Gran. Fill	17,391 Cubic Yards
Total Granular Borrow 17,391 x 1.15	20,000 Cubic Yards

DRAINAGE

STATION	RCP			BCCMP		CMP		CULVERT PIPE		CATCH BASINS					MAN HOLES	UNDERDRAINS				REMARKS		
	SIZE	LENGTH	CLASS	SIZE	LENGTH	SIZE	LENGTH	SIZE	LENGTH	A1	A2	B1	B2	C1		C2	E	LENGTH	SIZE		LENGTH	OUTLET LENGTH
Sta 254+00 to Sta 255+98																		198				
Sta 256+00 LI	12"	92'	III																			
Sta 256+00																						
Sta 256+02 to Sta 256+12																		10				
Sta 272+61 LI	54"	48'	III																			
Sta 272+61 RI	54"	32'	III																			
Sta 274+10 to Sta 274+45																		175				
Sta 274+47 RI																						
Sta 274+49 to Sta 280+00																		551				
Sta 282+00, Access Road				18"	44'																	
Sta 265 = DeFour Road				12"	96'																	


DRAINAGE CONT'D.

R. P. R. REG. NO.	STATE	PROJECT NUMBER	SHEET NO.	TOTAL SHEETS
1	MAINE	1-95-1(B)	5	58


STATION	RCP			BCCMP		CMP		CULVERT PIPE		CATCH BASINS					MAN HOLES	UNDERDRAINS				REMARKS			
	SIZE	LENGTH	CLASS	SIZE	LENGTH	SIZE	LENGTH	SIZE	LENGTH	A1	A2	B1	B2	C1		C2	E	LENGTH	SIZE		LENGTH	OUTLET LENGTH	
																							'B'

GENERAL NOTES

- The utilities involved in this contract are: Central Maine Power Company and New England Telephone and Telegraph Company.
- All utilities are to be adjusted by the respective utilities unless noted.
- Removal or abandonment of any existing drainage must be first approved by the Engineer.
- All catch basins to be abandoned shall be filled with suitable aggregate material as directed by the Engineer. Proper compaction shall be employed to reduce future settlement. Prior to filling with aggregate material, all pipe and underdrains shall be sealed with a cement plug.
- The normal grubbing width in fills is determined by the intersection of a one to one slope from the shoulder berm and the existing ground or as shown on the cross sections. When the height of fill is two feet or less, the grubbing width shall be extended to the intersection of the side slope and the old ground.
- Clearing limits shall be 15' outside of and parallel to the construction slope limit line or as shown, except on the Access Road it shall be 5' outside of and parallel to the construction slope limit line.
- Selective clearing shall be performed between the clearing limits and Right of Way Lines or selective clearing and thinning lines as shown on the plans.
- The loam, seed and hay mulch notes shown apply as a general guide. In all cases the Engineer has the final authority as to the placement of these items.
- Hay mulch and asphalt binder shall be applied to all areas seeded with method no. 2.
- All reinforced concrete pipe shall be class III unless otherwise noted on the plans.
- All ditch elevations shown on cross sections are to the top of loam.
- The use of Portland Cement for riprap grout shall be restricted to specific installations as directed by the Engineer.
- All existing headwalls to be removed shall be paid for under Item 206.07 Structural Rock Excavation-Drainage and Minor Structures.
- The contractor shall be responsible for maintaining all traffic signs required for the construction until completion of the contract.

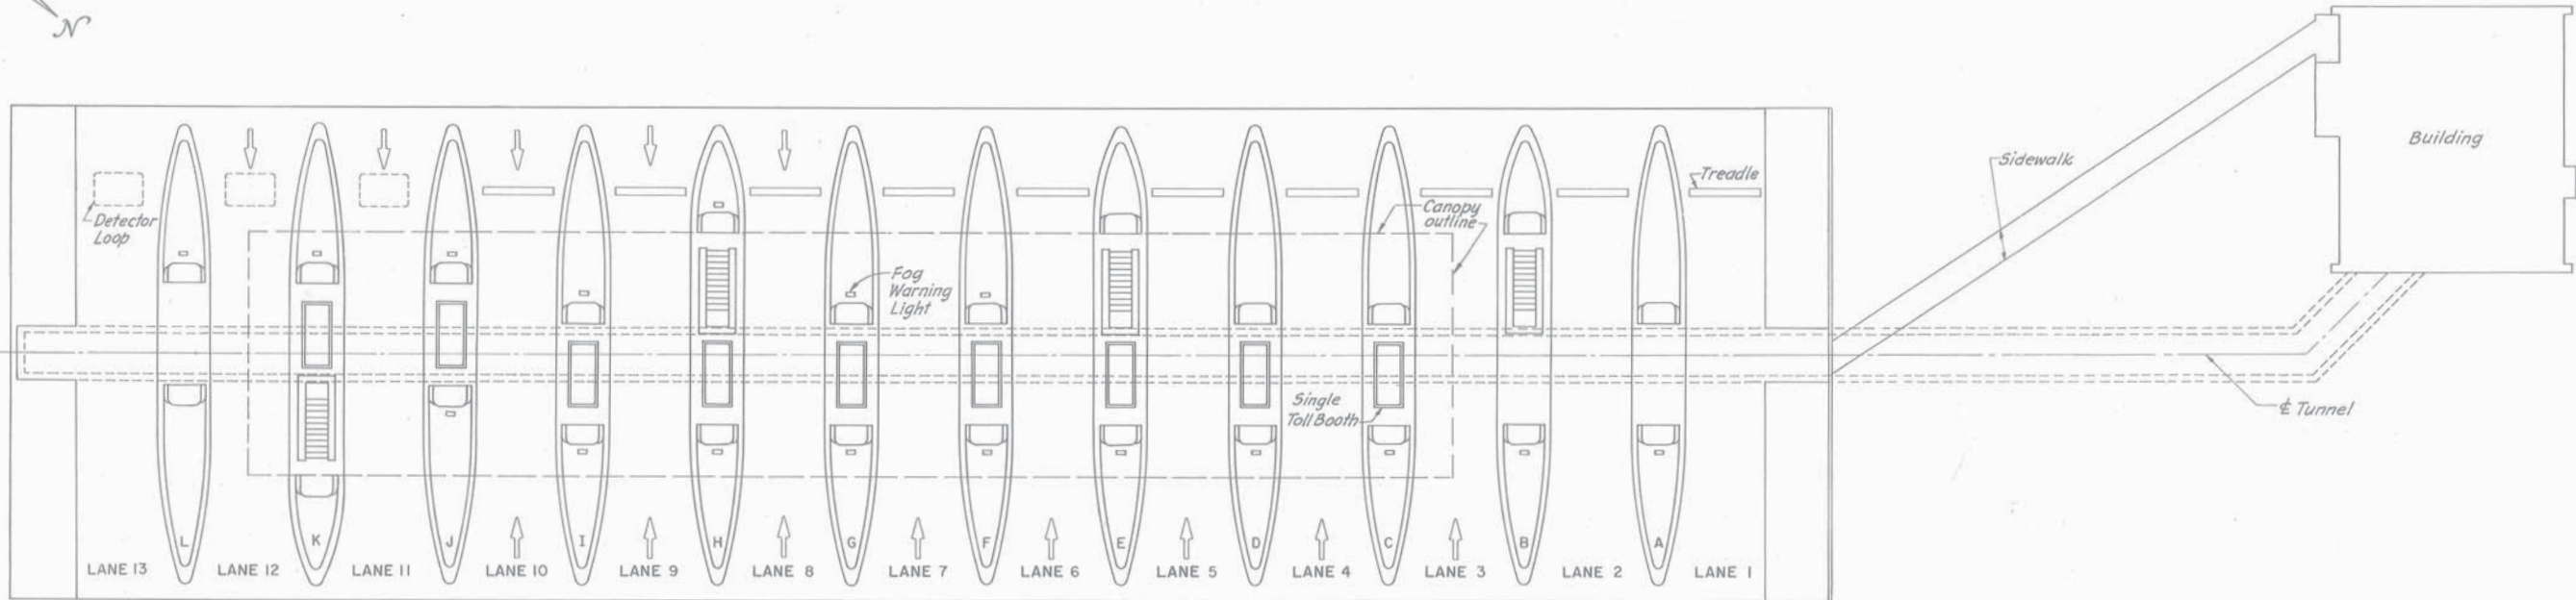

PLAN

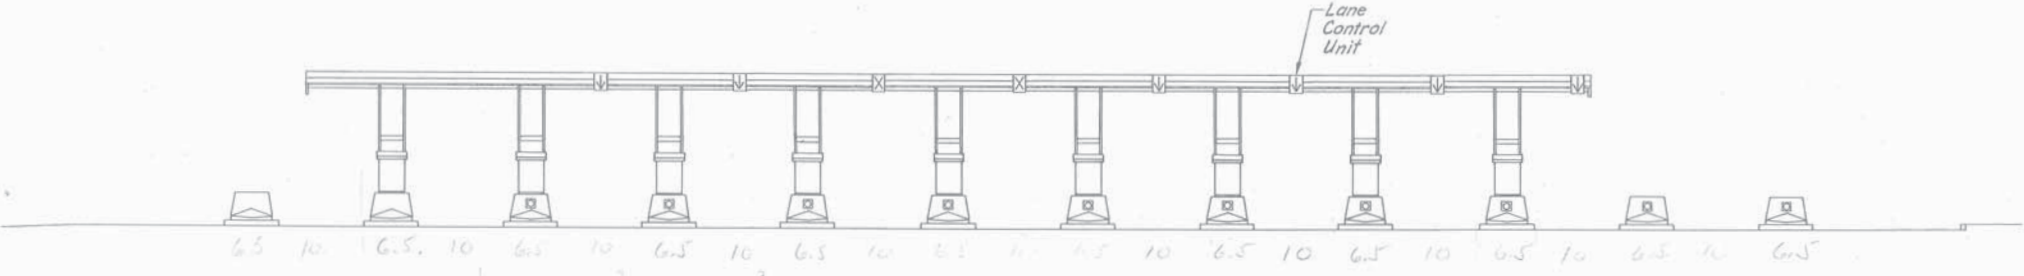

NORTH ELEVATION

YORK BARRIER TOLL PLAZA

$\frac{3}{32} = 1'-0"$

152
152.0
10
12
100
100.5
10.5






152
152.5
10
16
100.5

MAINE STATE HIGHWAY COMMISSION
AUGUSTA, MAINE

TOLL BOOTHS & CANOPY
PLAN & ELEVATION

HOWARD, NEEDLES, TAMMEN & BERGENDOFF
CONSULTING ENGINEERS

NEW YORK BOSTON KANSAS CITY





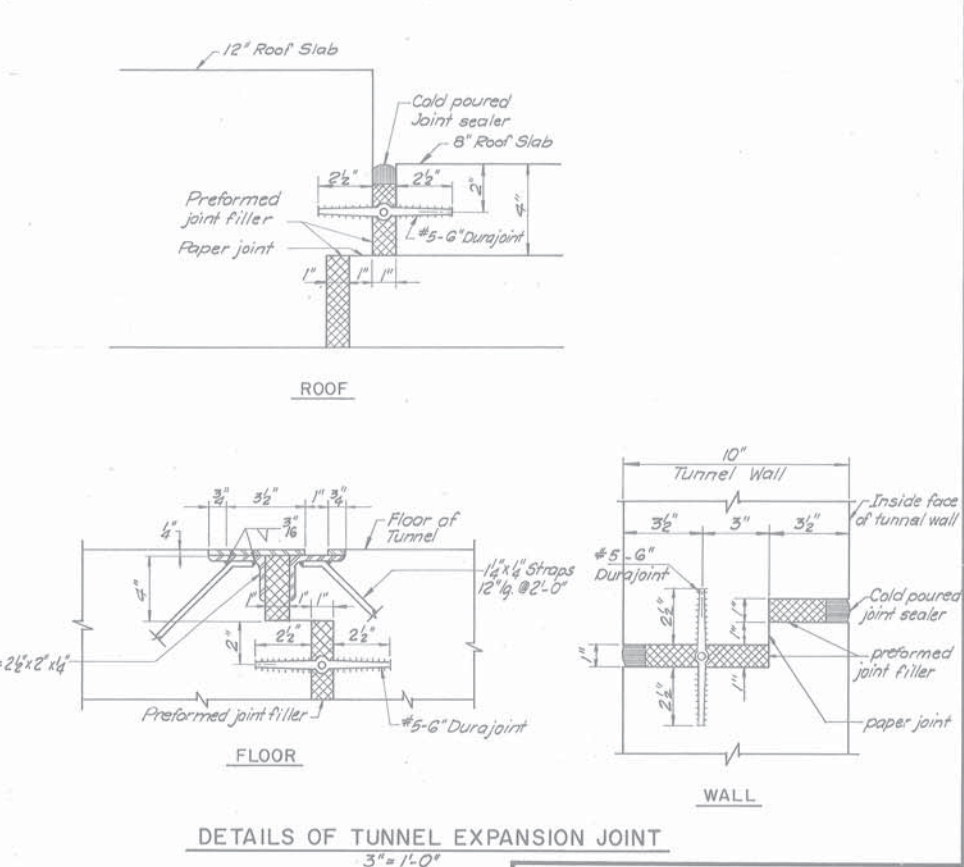
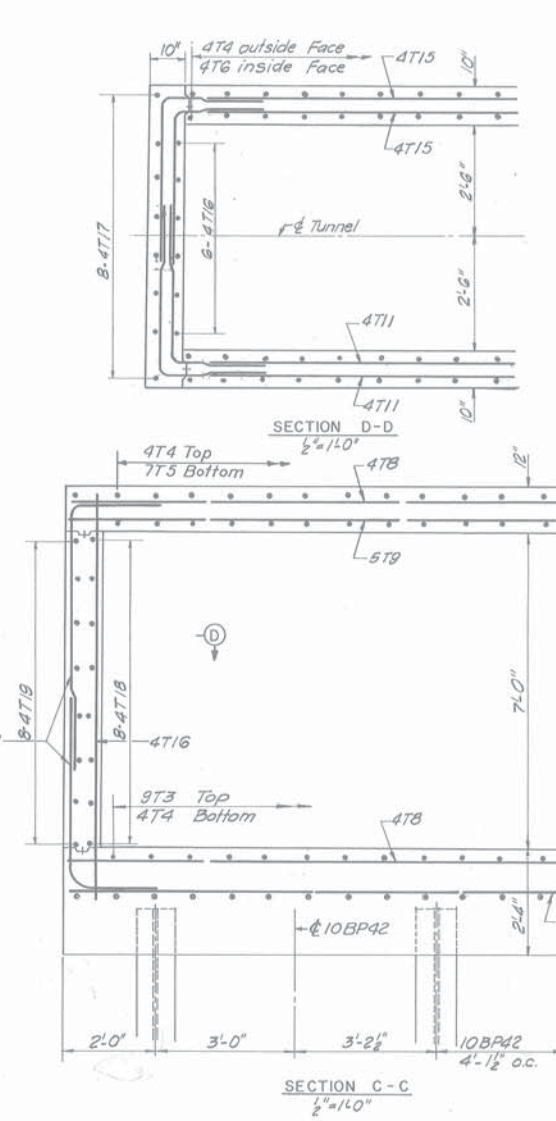
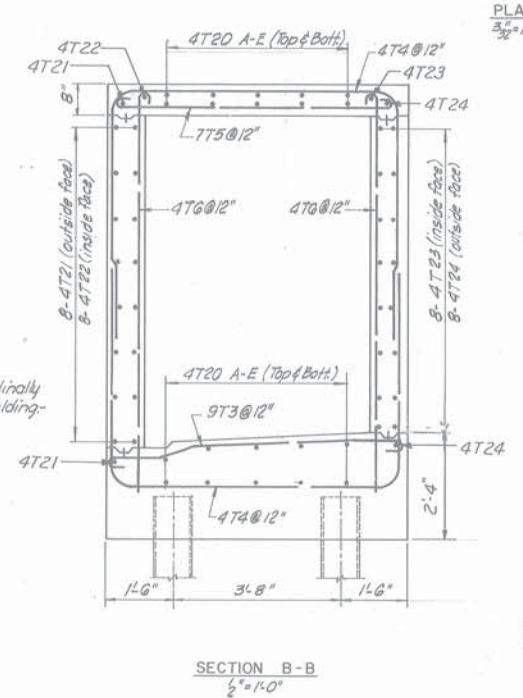
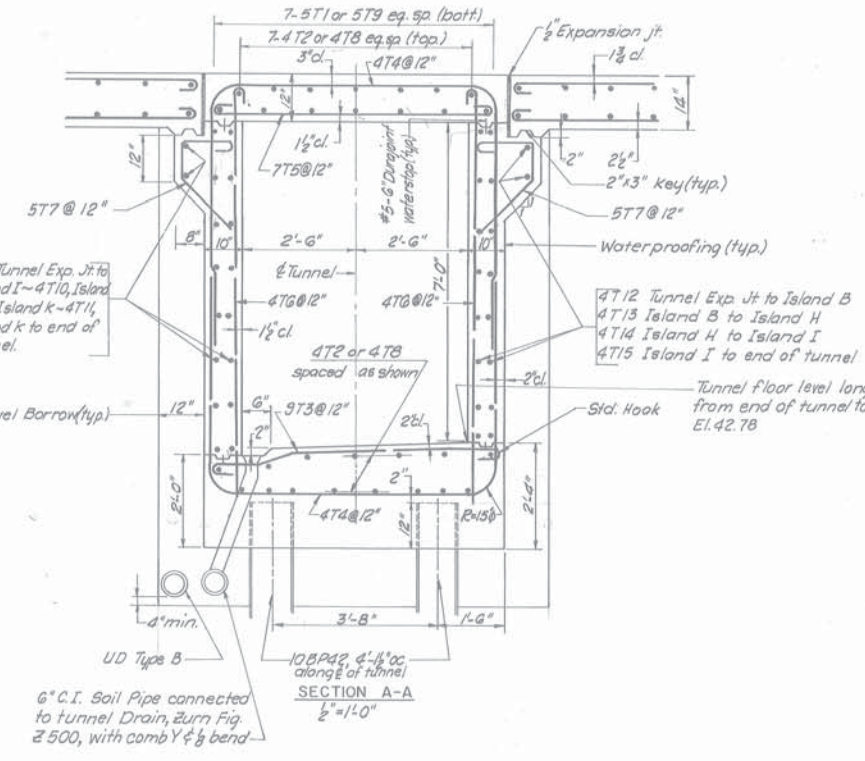
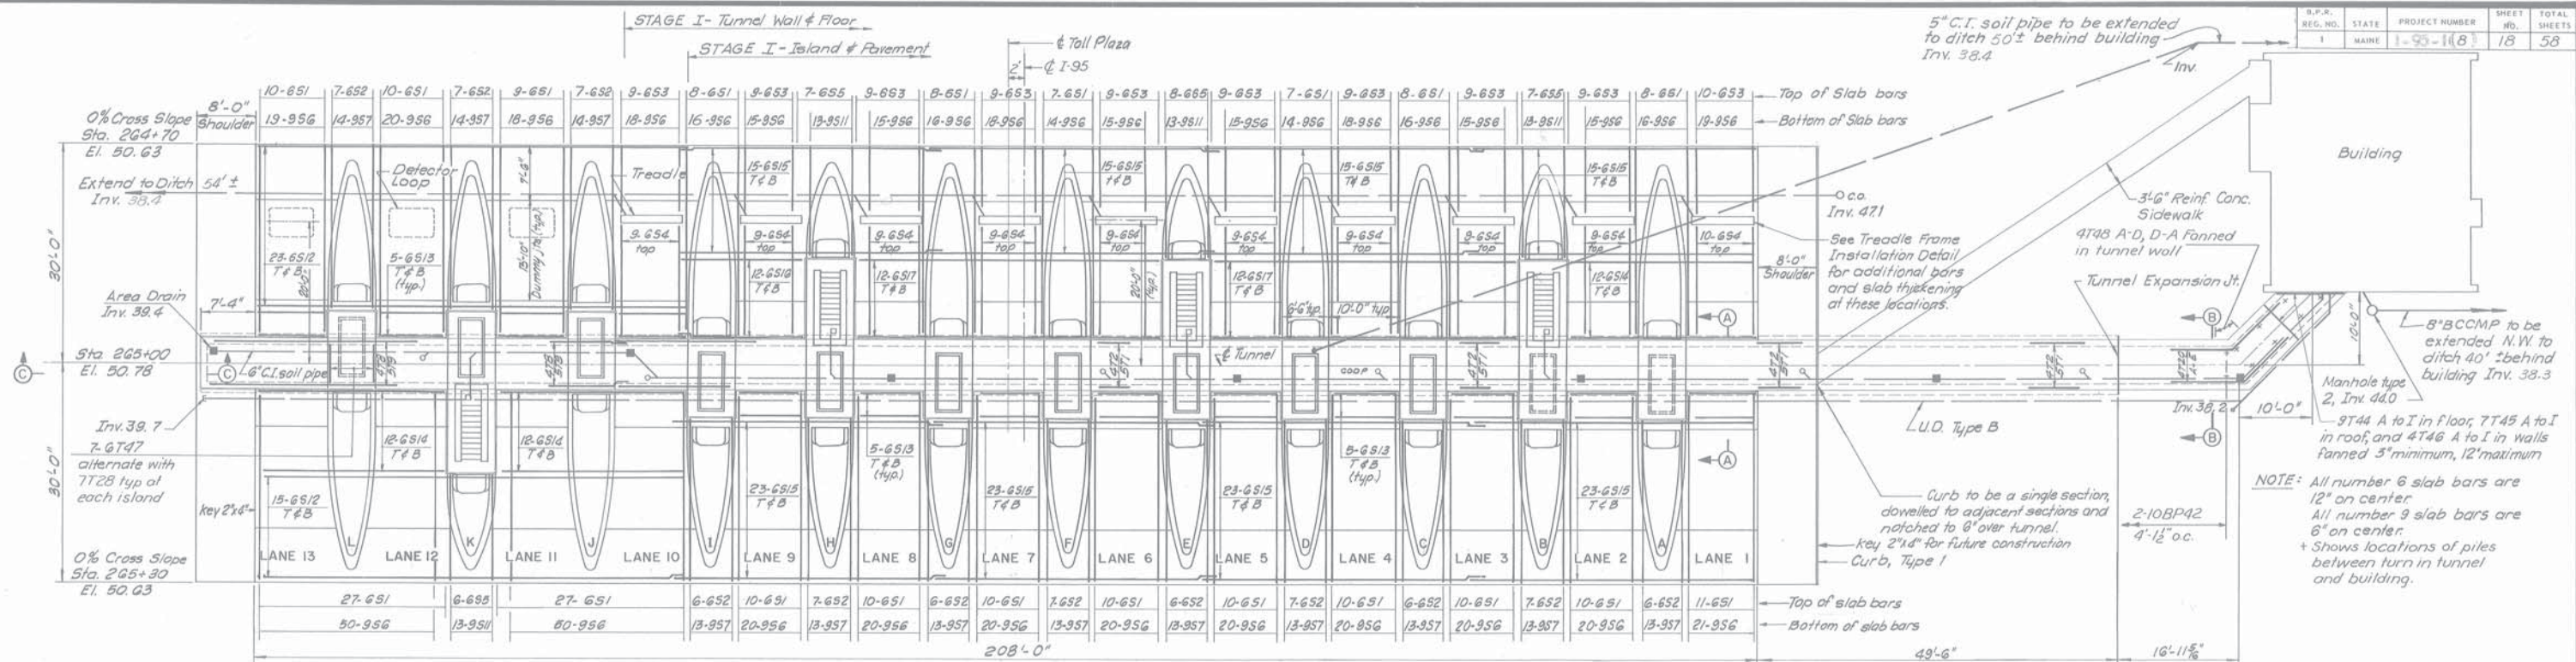


MAINE STATE HIGHWAY COMMISSION
AUGUSTA, MAINE

TOLL PLAZA
PLAN & TUNNEL DETAILS

HOWARD, NEEDLES, TAMMEN & BERGENDOFF
CONSULTING ENGINEERS

NEW YORK BOSTON KANSAS CITY

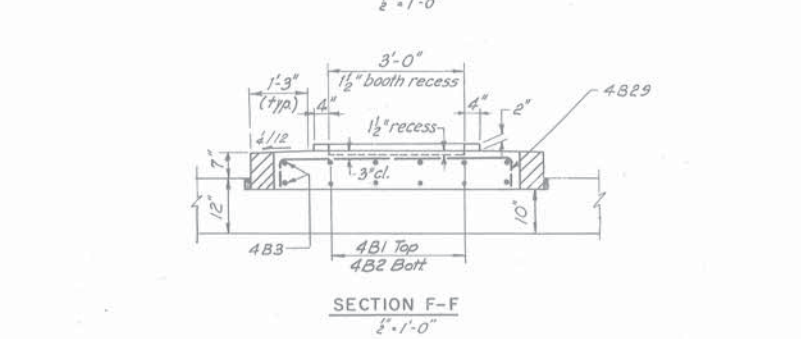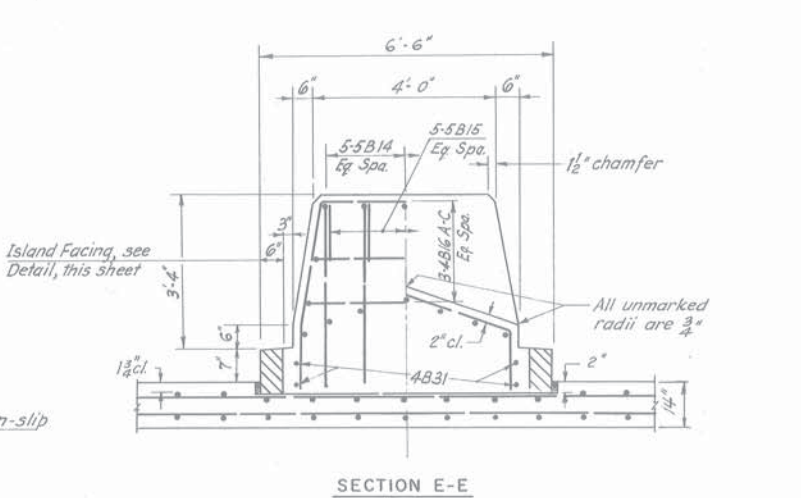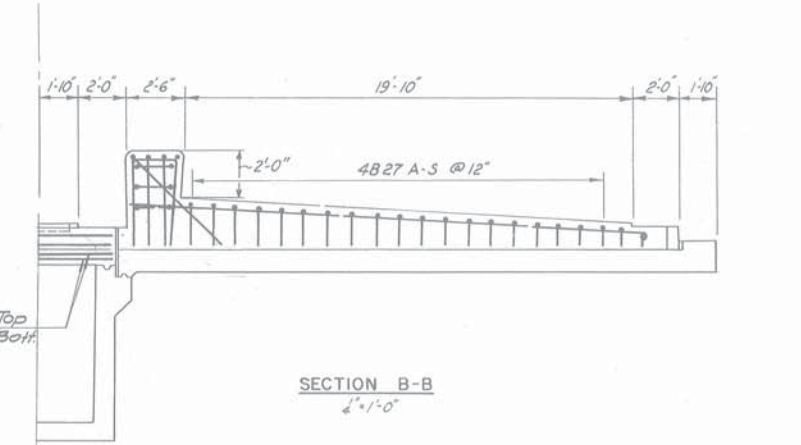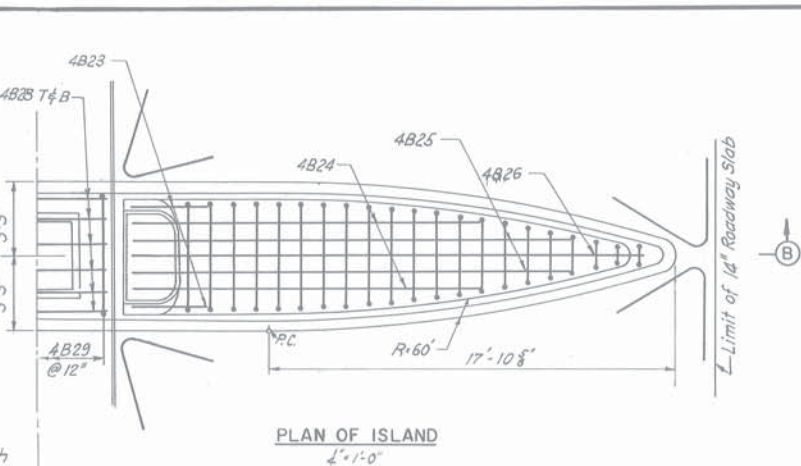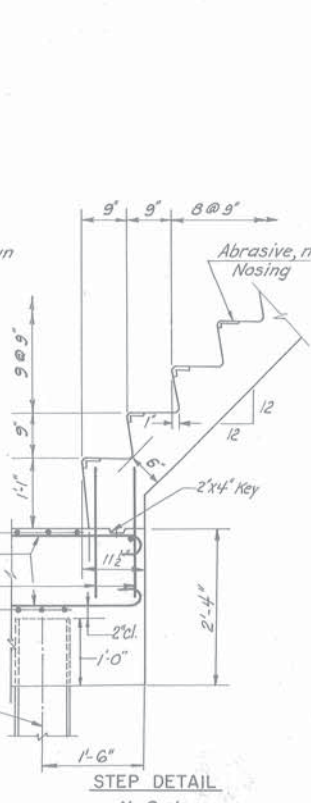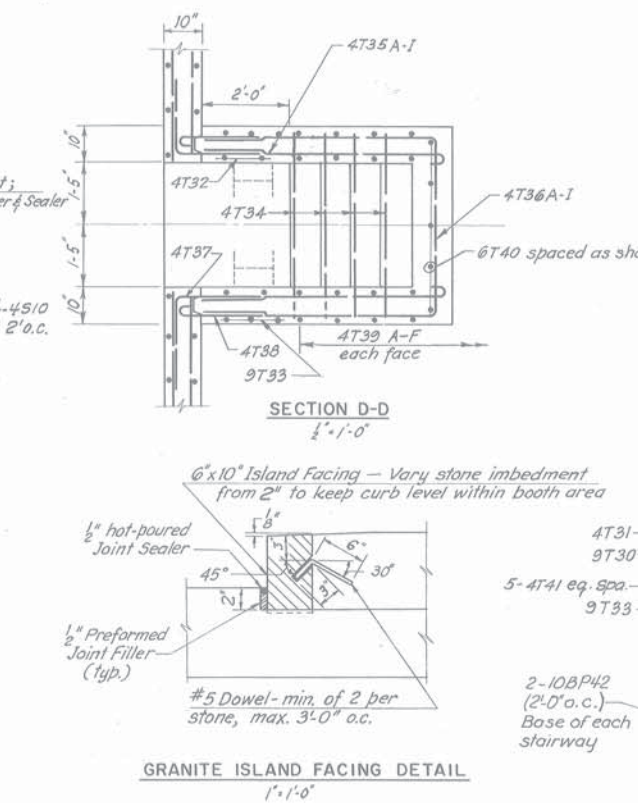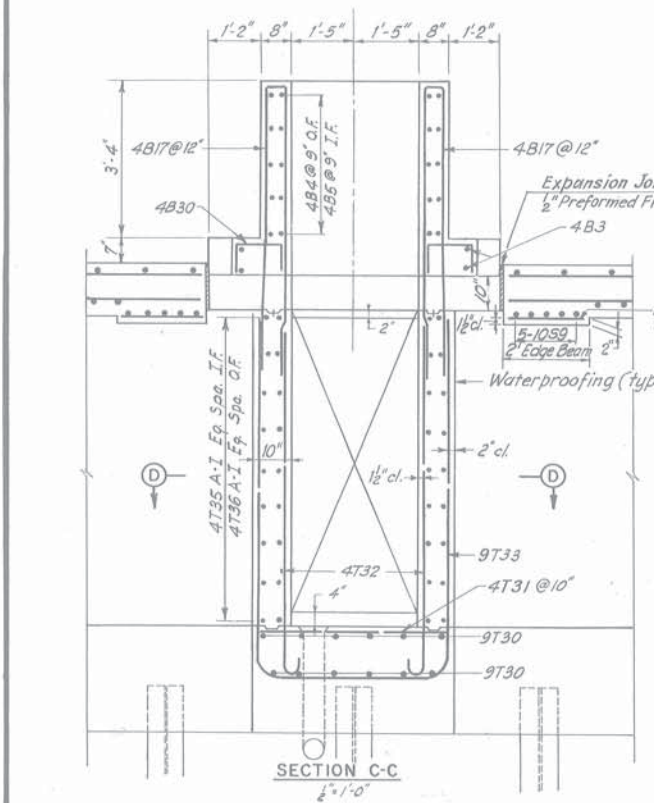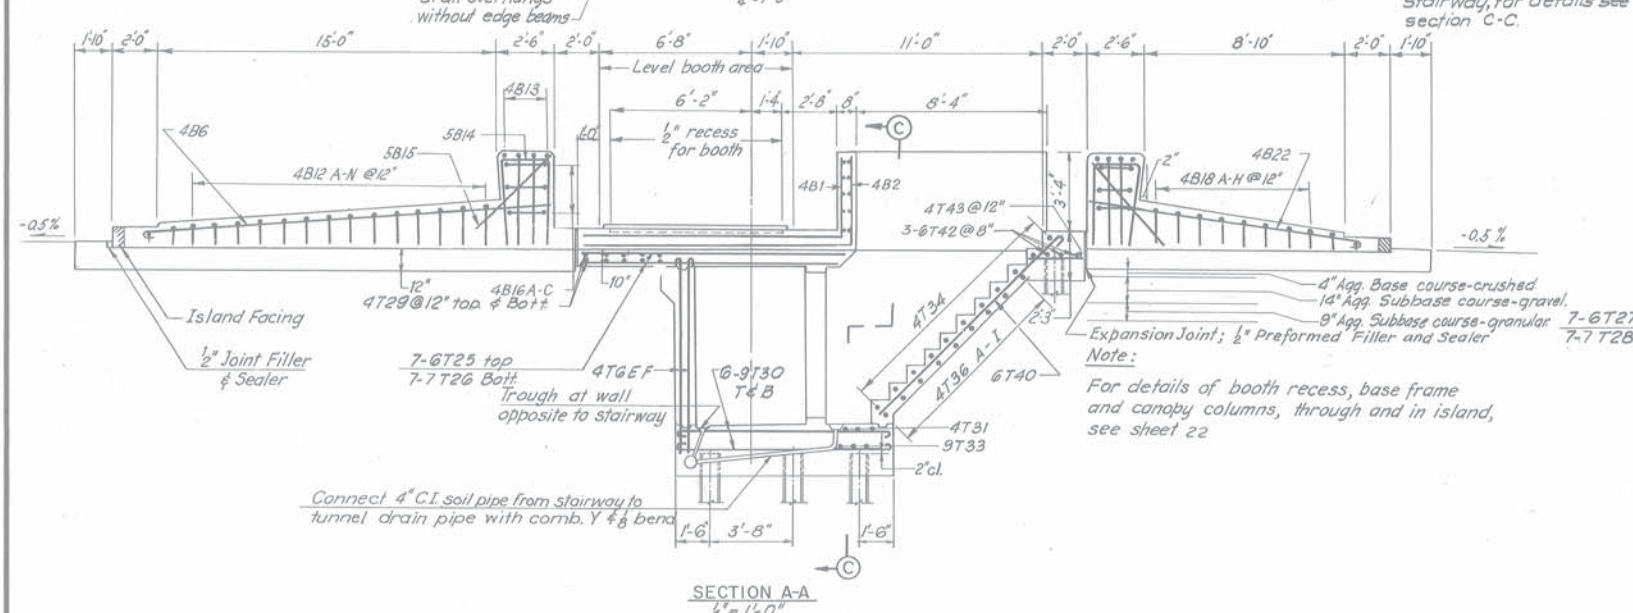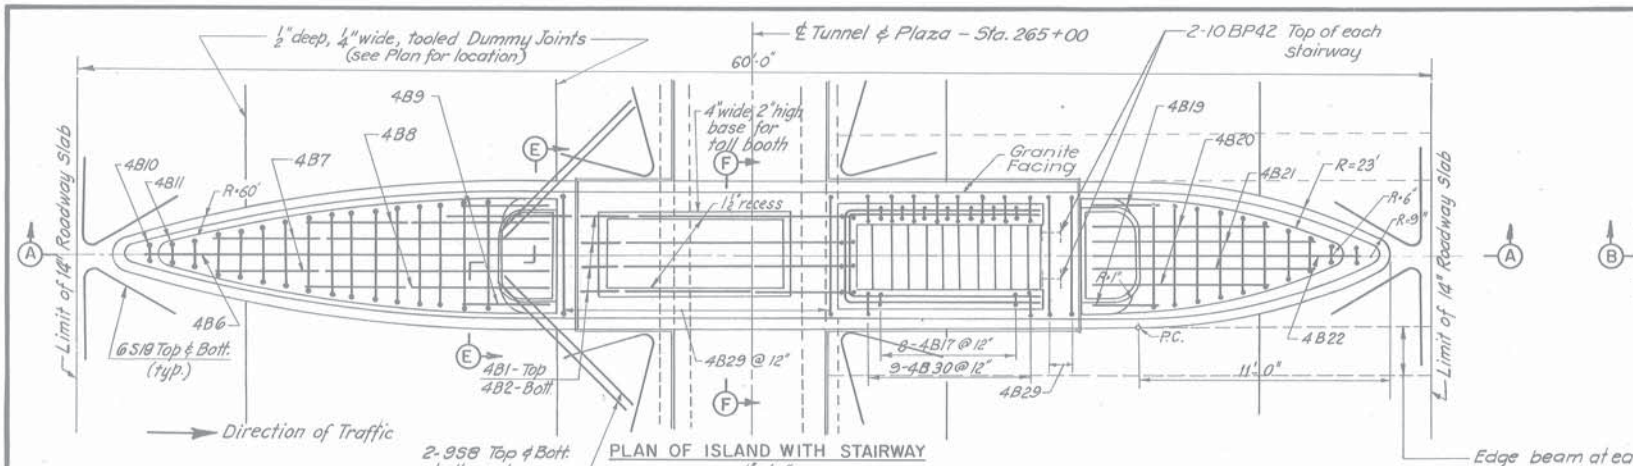

BAR MARK	NO.	LENGTH	TYPE	A	B	C
5T1	35	42'-9"	STR			
4T2	200	42'-6"	STR			
9T3	290	8'-10"	12	6'-4"	1'-3"	
4T4	534	16'-6"	1	6'-4"	5'-1"	5'-1"
7T5	219	8'-0"	12	6'-4"	0'-10"	
4T6	592	9'-6"	3	9'-0"	0'-6"	
5T7	516	4'-4"	6			
4T8	44	30'-0"	STR			
5T9	14	30'-1"	STR			
4T10	18	20'-2"	STR			
4T11	18	34'-7"	STR			
4T12	36	39'-6"	STR			
4T13	36	46'-4"	STR			
4T14	18	28'-2"	STR			
4T15	36	29'-8"	STR			
4T16	6	9'-0"	STR			
4T17	16	6'-3"	2	5'-0"	1'-3"	
4T18	16	5'-0"	2	3'-4"	1'-8"	
4T19	16	5'-9"	2	3'-9"	2'-0"	
4T20	20	27'-1"	11	16'-0"	11'-1"	
A-E	4ea.	34'-9"		17'-8"	17'-1"	
4T21	10	36'-6"	11	18'-1"	18'-5"	
4T22	8	35'-9"	11	17'-11"	17'-10"	
4T23	8	25'-11"	11	15'-8"	10'-3"	
4T24	10	25'-2"	11	15'-6"	9'-8"	
6T25	28	12'-0"	STR			
7T26	28	11'-6"	STR			
6T27	56	10'-9"	STR			
7T28	56	10'-9"	STR			
4T29	120	7'-3"	12	6'-3"	0'-6"	
9T30	48	11'-10"	12	9'-4"	1'-3"	
4T31	16	4'-2"	STR			
4T32	16	8'-7"	3	8'-1"	0'-6"	
9T33	24	20'-4"	1	4'-2"	8'-1"	8'-1"
4T34	44	4'-2"	STR			
4T35	72	2'-9"	3	2'-3"	0'-6"	
A-I	8ea.	8'-11"		8'-5"	0'-6"	
4T36	36	8'-6"	1	4'-0"	2'-3"	2'-3"
A-I	4ea.	20'-10"		4'-0"	8'-5"	8'-5"
4T37	72	3'-8"	2	1'-10"	1'-10"	
4T38	72	2'-4"	3	1'-10"	0'-6"	
4T39	96	2'-0"	3	1'-6"	0'-6"	
A-F	16ea.	7'-0"		6'-6"	0'-6"	
6T40	20	11'-11"	3	11'-3"	0'-8"	
4T41	40	2'-0"	STR			
6T42	12	7'-6"	12	6'-2"	0'-8"	
4T43	28	3'-3"	12	2'-3"	0'-6"	
9T44	9	8'-0"	12	6'-4"	1'-3"	
A-I	1ea.	11'-5"		8'-11"	1'-3"	
7T45	9	8'-0"	12	6'-4"	0'-10"	
A-I	1ea.	10'-7"		8'-11"	0'-10"	
4T46	18	16'-4"	1	6'-4"	5'-0"	5'-0"
A-I	2ea.	18'-11"		8'-11"	5'-0"	5'-0"
6T47	84	7'-8"	12	6'-4"	0'-8"	
4T48	16	16'-4"	1	6'-4"	5'-0"	5'-0"
A-D	4ea.	16'-3"		6'-9"	5'-0"	5'-0"



Note: First number of bar mark denotes bar size.

MAINE STATE HIGHWAY COMMISSION
 AUGUSTA, MAINE

TOLL PLAZA ISLAND &
 TUNNEL DETAILS

HOWARD, NEEDLES, TAMMEN & BERGENDOFF
 CONSULTING ENGINEERS



NEW YORK BOSTON KANSAS CITY

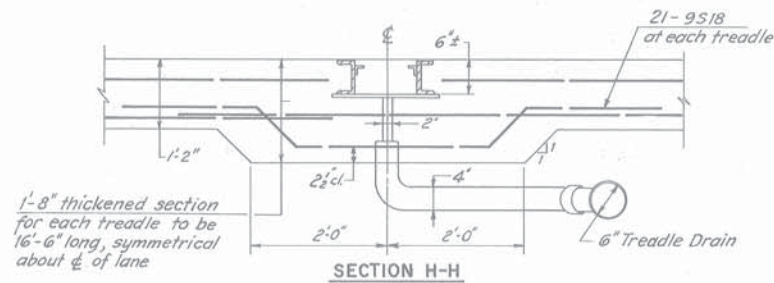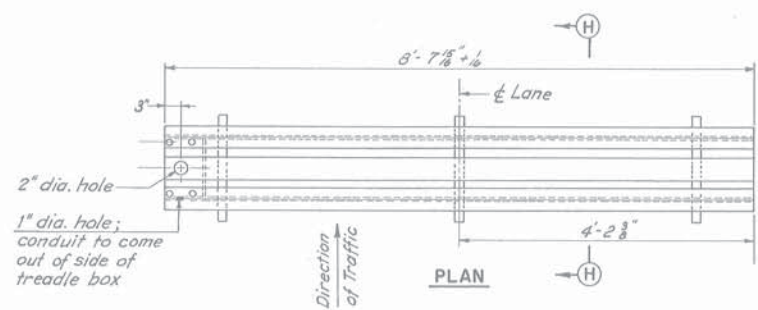

8 FT. TREADLE FRAME INSTALLATION



No scale

Treadle frame to be as manufactured by Teller & Cooper #TC-208 or approved equal. Dimension for drain and electrical connection to be verified with frame manufacturer.

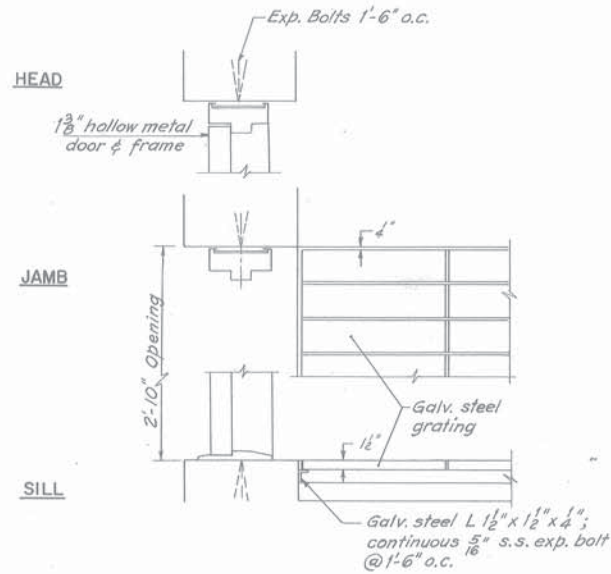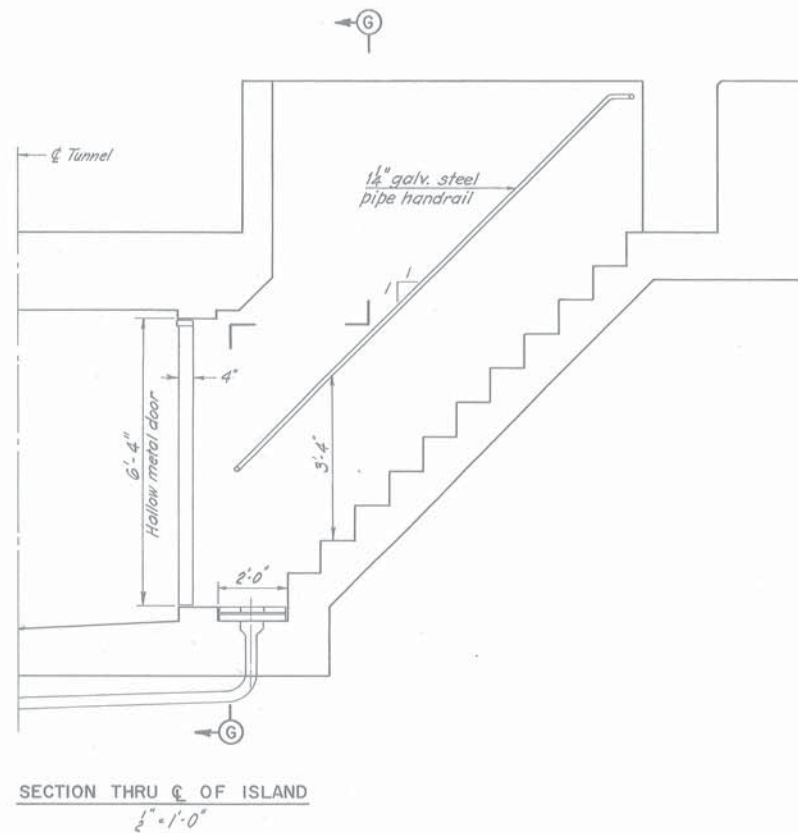


TUNNEL DOOR DETAILS

1/2\"/>

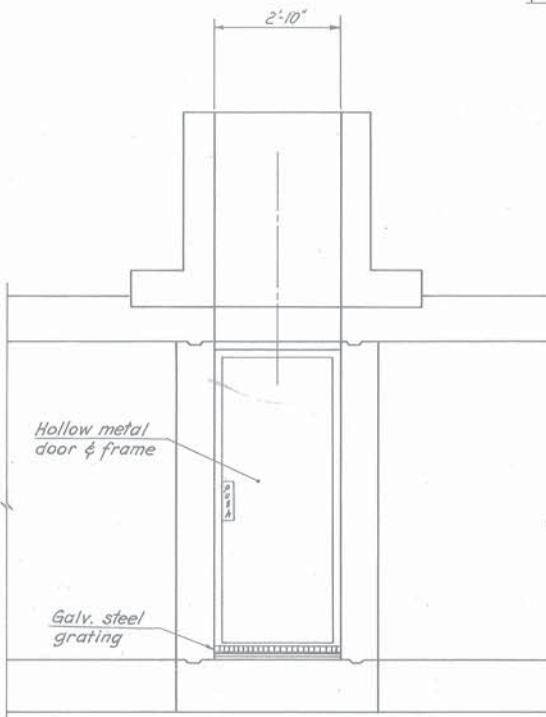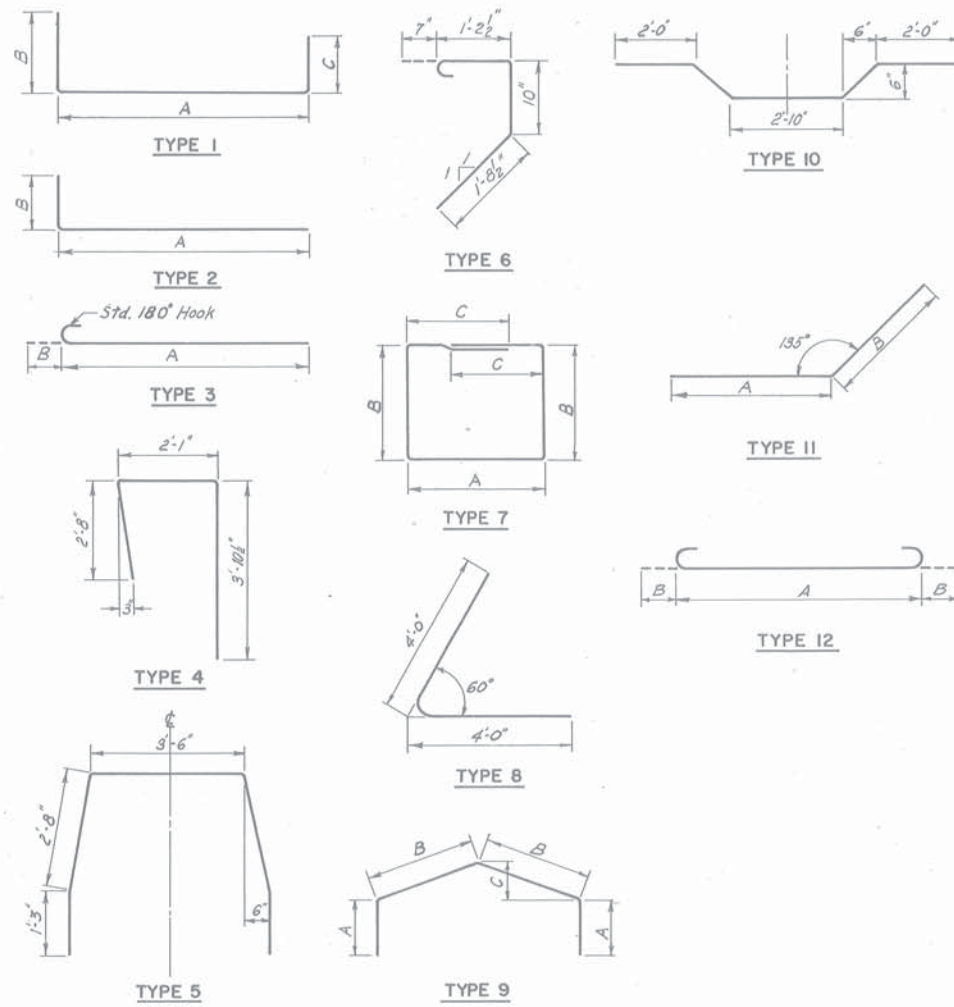

SECTION G-G

1/2\"/>

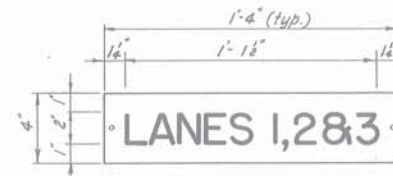

One each required as noted below:
 Lanes 1, 2 & 3
 Lanes 4, 5 & 6
 Lanes 7, 8 & 9
 Lanes 10, 11, 12 & 13

Black bakelite name plate with 2\"/>

BAKELITE SIGN DETAIL

No scale

BAR MARK	NO.	LENGTH	TYPE	A	B	C
651	220	27'-1"	3	26'-4 1/2"	0'-8 1/2"	
652	79	22'-9"	3	22'-0 1/2"	0'-8 1/2"	
653	91	9'-1"	STR			
654	91	16'-6"	3	15'-9 1/2"	0'-8 1/2"	
655	28	14'-11"	STR			
956	593	27'-8"	3	26'-4 1/2"	1'-3 1/2"	
957	159	23'-4"	3	22'-0 1/2"	1'-3 1/2"	
958	96	8'-0"	STR			
1059	40	27'-10"	3	26'-4 1/2"	1'-5 1/2"	
4510	112	1'-8"	STR			
9511	52	14'-11"	STR			
6512	76	59'-4"	STR			
6513	130	9'-9"	STR			
6514	72	26'-3"	STR			
6515	304	39'-1"	STR			
6516	24	18'-5"	STR			
6517	48	32'-9"	STR			
9518	210	8'-3"	10			
6519	192	8'-0"	8			

481	16	15'-1"	2	11'-8"	3'-5"	
482	16	15'-10"	2	12'-1 1/2"	3'-9"	
483	16	22'-0"	STR			
484	20	21'-5"	1	3'-11"	8'-9"	8'-9"
485	20	19'-9"	1	3'-1 1/2"	8'-4"	8'-4"
486	12	18'-6"	3	18'-0"	0'-6"	
487	24	18'-0"	3	14'-6"	0'-6"	
488	24	11'-0"	3	10'-6"	0'-6"	
489	24	4'-6"	3	4'-0"	0'-6"	
4B10	24	1'-10"	1	0'-10"	0'-6"	0'-6"
4B11	24	2'-4"	1	1'-4"	0'-6"	0'-6"
4B12	168	3'-0"	9	0'-10"	0'-8 1/2"	0'-0 1/2"
A to N	12ea.	7'-4"		1'-2"	2'-6"	1'-0"
4B13	96	1'-4"	5			
5B14	120	8'-8"	4			
5B15	120	5'-0"	STR			
4B16	72	12'-4"	7	3'-6"	2'-0"	2'-5"
A to C	24ea.	13'-8"		4'-4"	1'-10"	2'-10"
4B17	64	13'-3"	1	0'-5"	6'-5"	6'-5"
4B18	32	3'-0"	9	0'-10"	0'-8 1/2"	0'-0 1/2"
A to H	4ea.	7'-9"		1'-2"	2'-6"	1'-0"
4B19	8	3'-6"	3	3'-0"	0'-6"	
4B20	8	8'-0"	3	7'-6"	0'-6"	
4B21	8	10'-3"	3	9'-9"	0'-6"	
4B22	4	12'-6"	3	12'-0"	0'-6"	
4B23	16	4'-0"	3	3'-6"	0'-6"	
4B24	16	16'-0"	3	15'-6"	0'-6"	
4B25	16	20'-0"	3	19'-6"	0'-6"	
4B26	8	23'-3"	3	22'-9"	0'-6"	
4B27	152	3'-0"	9	0'-10"	0'-8 1/2"	0'-0 1/2"
A to S	8ea.	7'-4"		1'-2"	2'-6"	1'-0"
4B28	96	10'-8"	STR			
4B29	156	6'-3"	1	5'-3"	0'-6"	0'-6"
4B30	72	2'-2"	1	1'-0"	0'-7"	0'-7"
4B31	96	4'-0"	STR			










Note: First number of bar mark denotes bar size.

MAINE STATE HIGHWAY COMMISSION
AUGUSTA, MAINE

TOLL PLAZA
MISCELLANEOUS DETAILS

HOWARD, NEEDLES, TAMMEN & BERGENDOFF
CONSULTING ENGINEERS


NEW YORK BOSTON KANSAS CITY

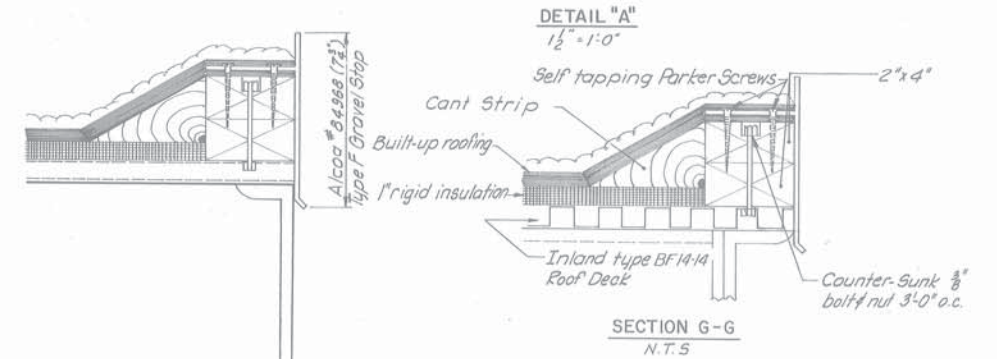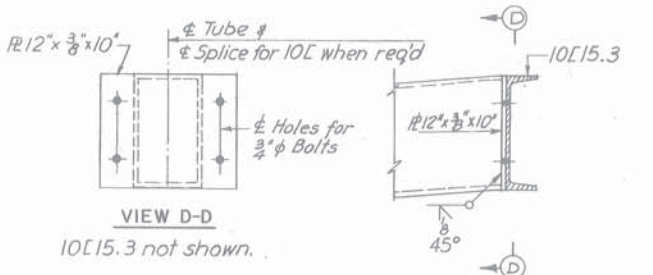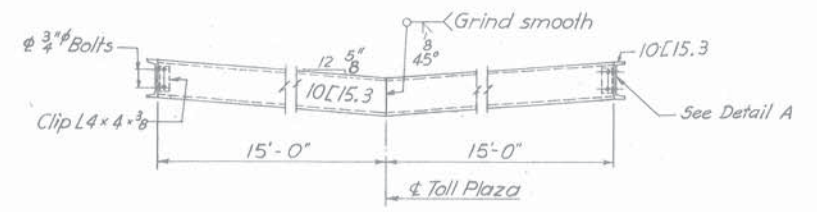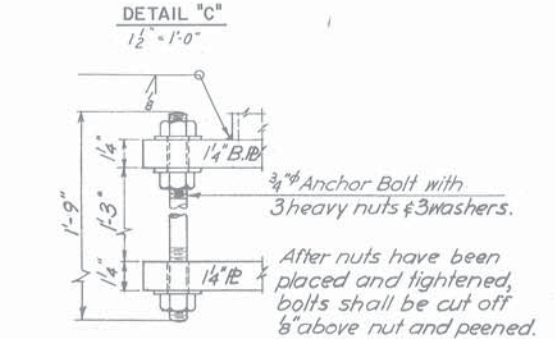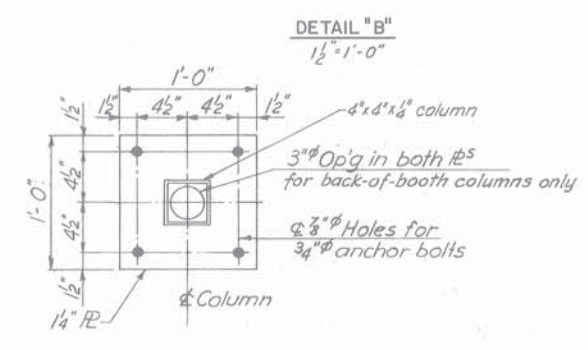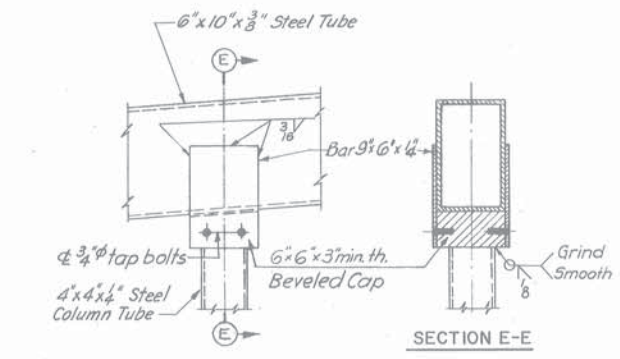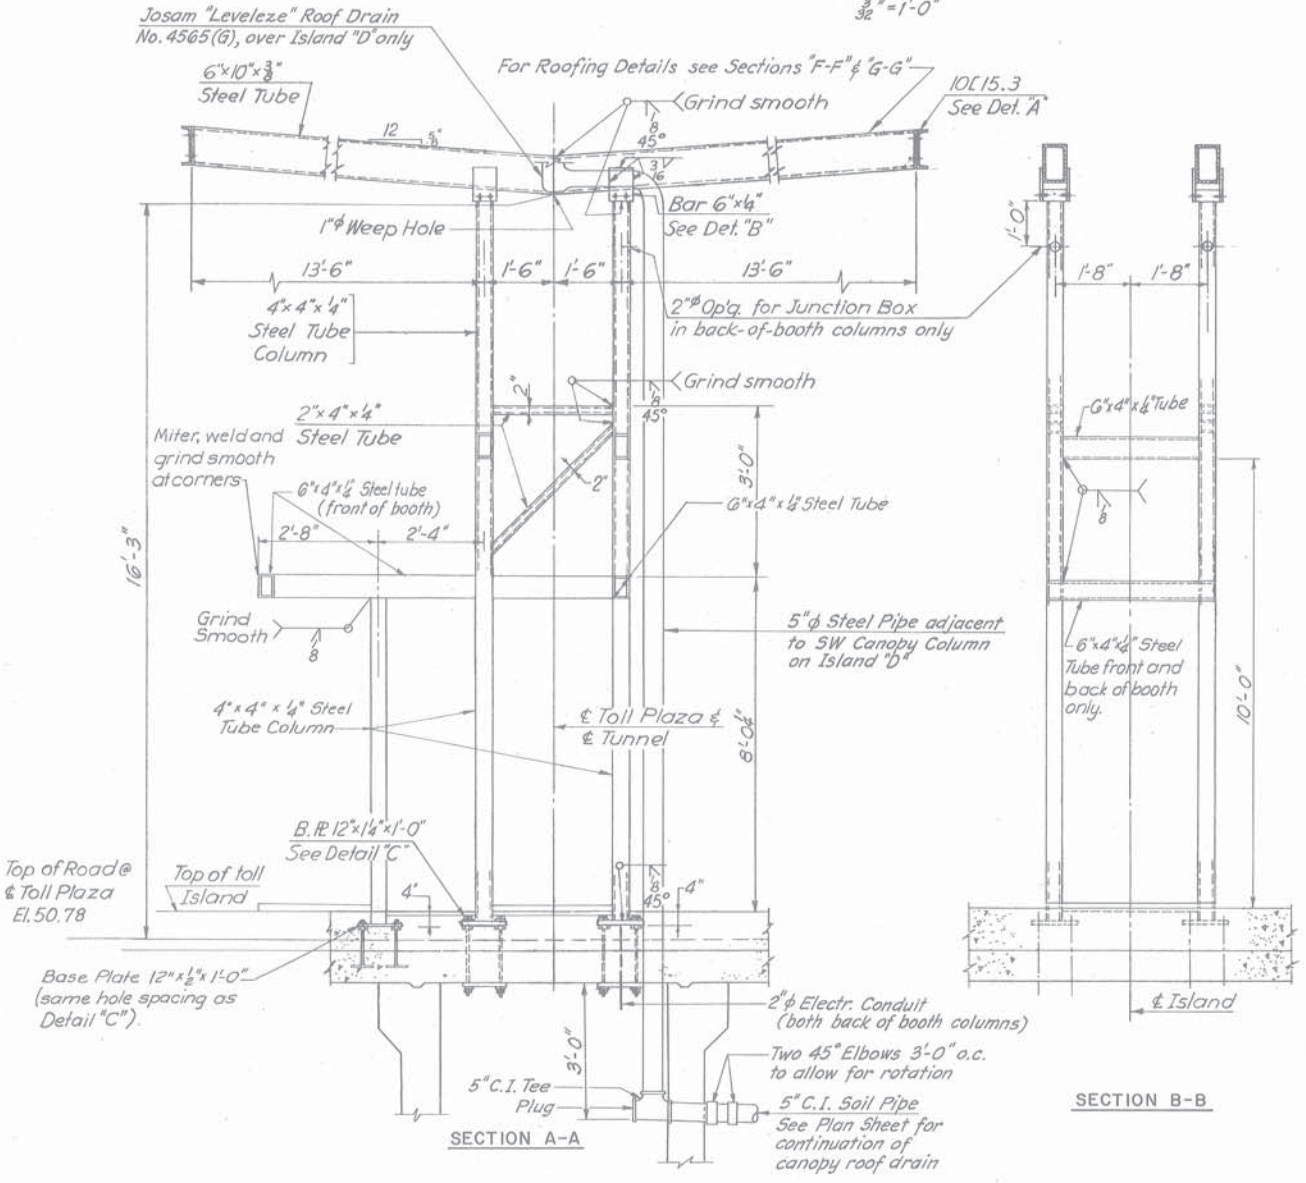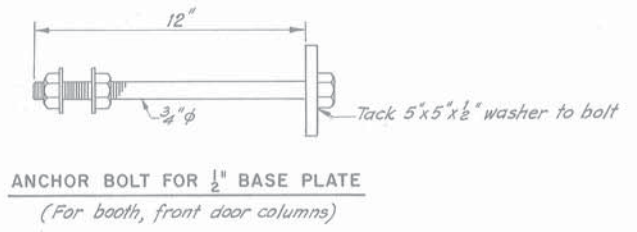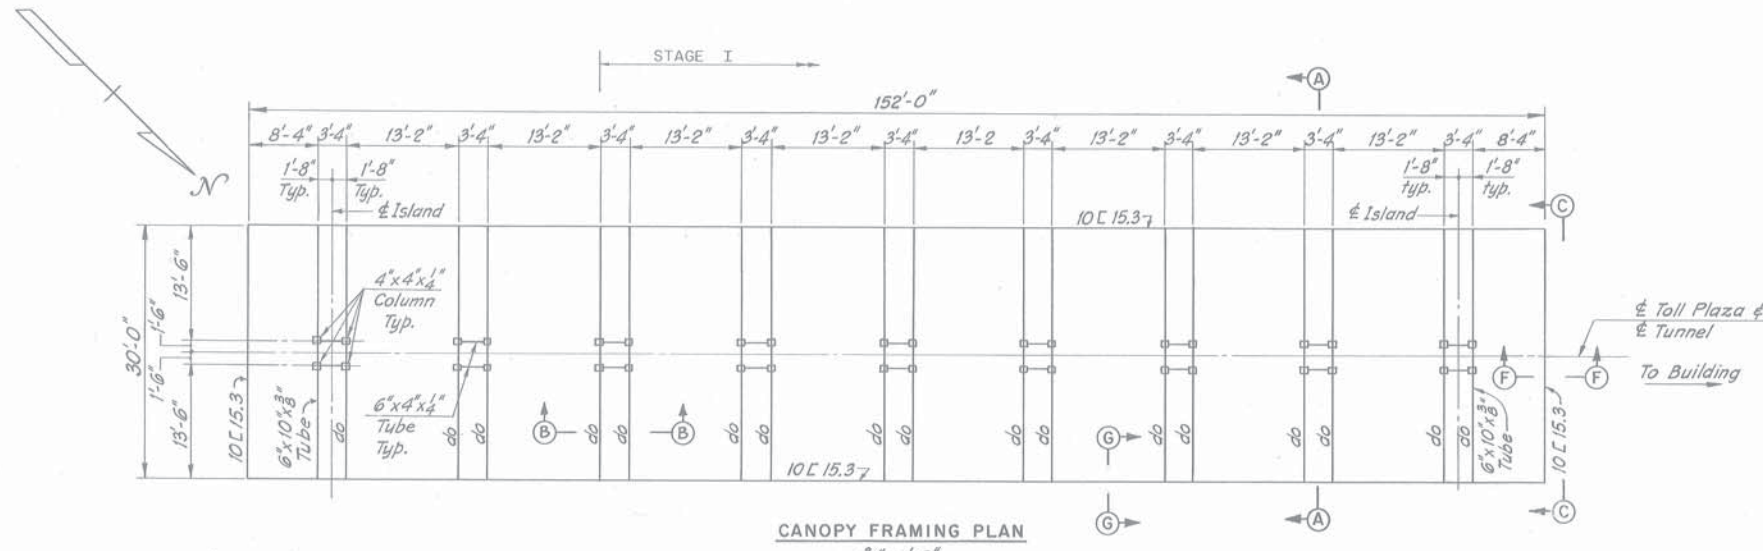


MAINE STATE HIGHWAY COMMISSION
 AUGUSTA, MAINE

**TOLL BOOTHS & CANOPY
 FRAMING & DETAILS**


HOWARD, NEEDLES, TAMMEN & BERGENDOFF
 CONSULTING ENGINEERS
 NEW YORK BOSTON KANSAS CITY

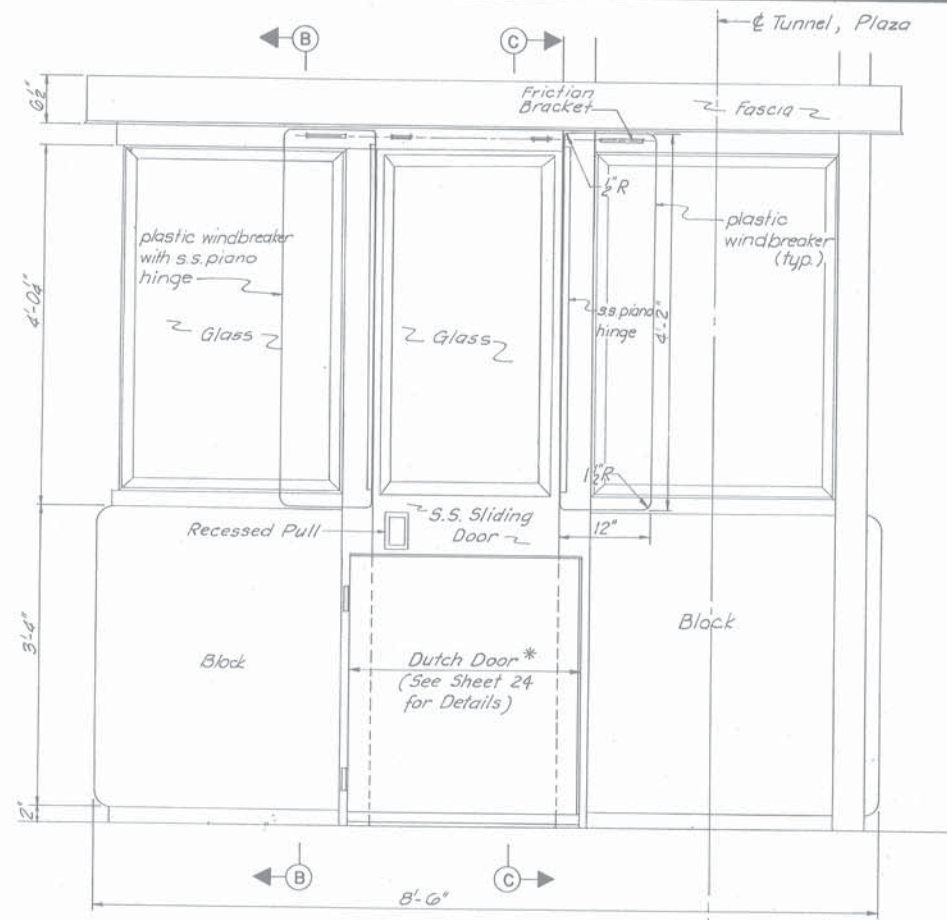

SIDE ELEVATION
1" = 1'-0"

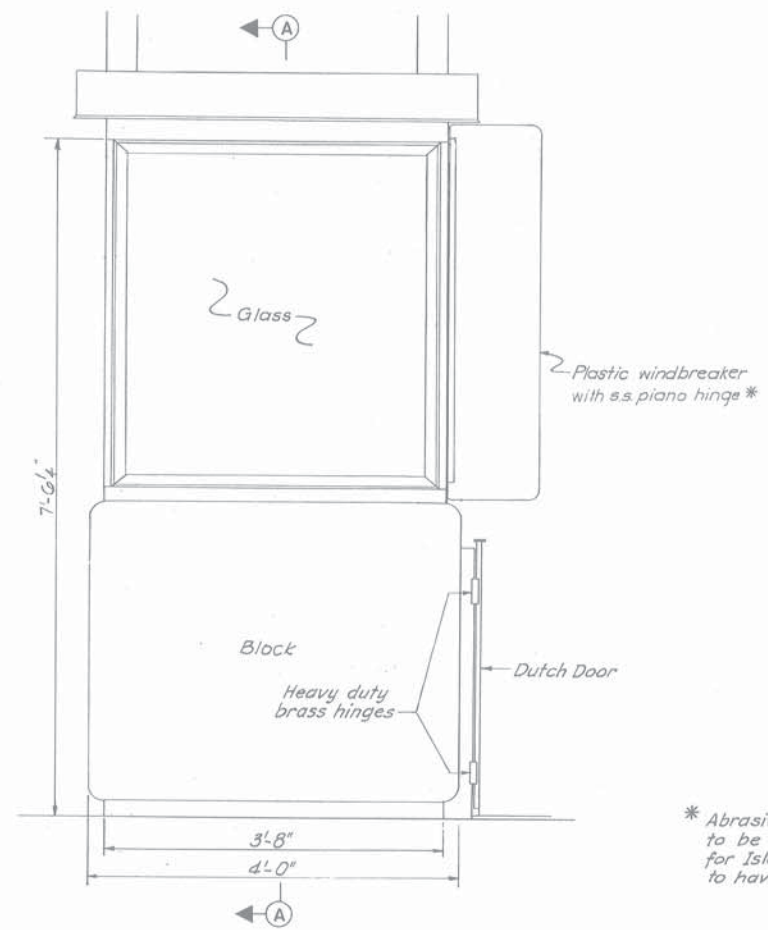


FRONT ELEVATION
1" = 1'-0"

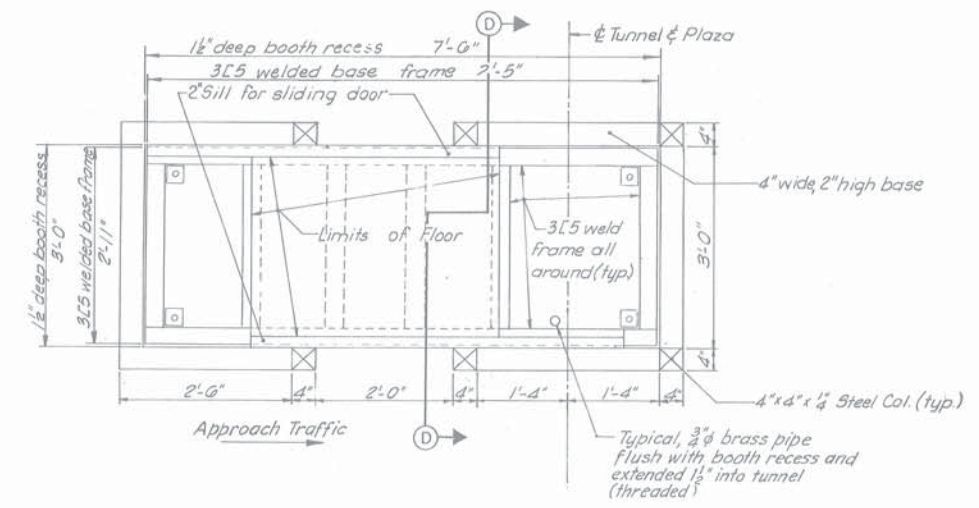


FRAMING PLAN AT BASE OF TOLL BOOTHS
3/4" = 1'-0"


* Abrasive threshold, plastic windbreaker and dutch door to be used only on approach traffic side of booths, for Islands C-F and K; booths on Islands G-J are to have these items at both doors.

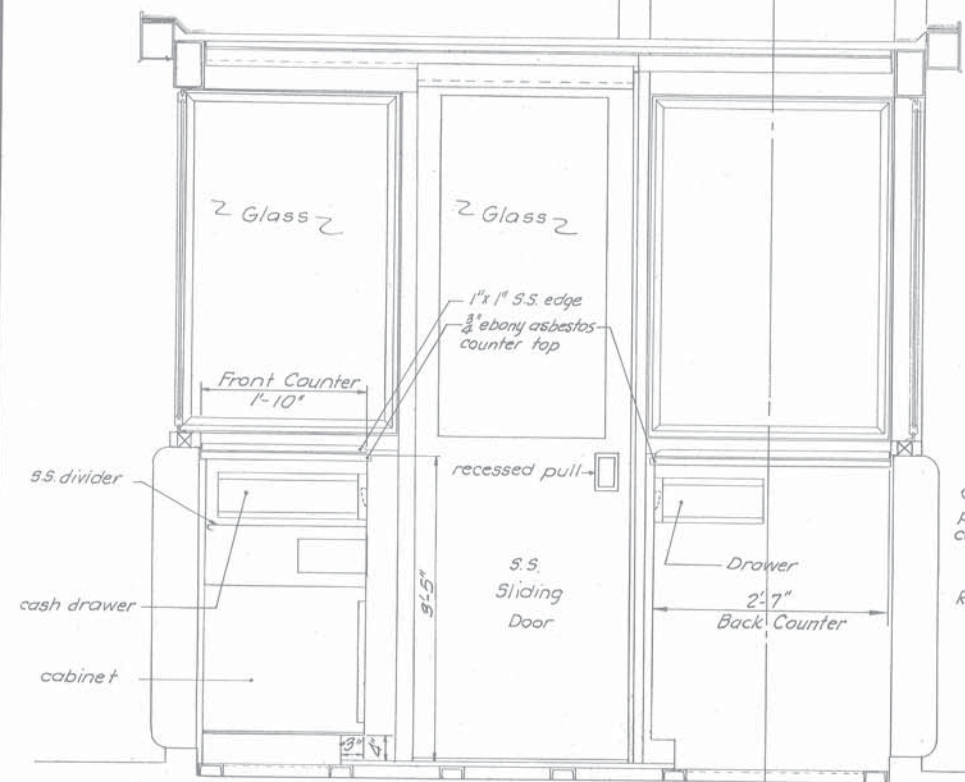


SECTION A-A
1" = 1'-0"

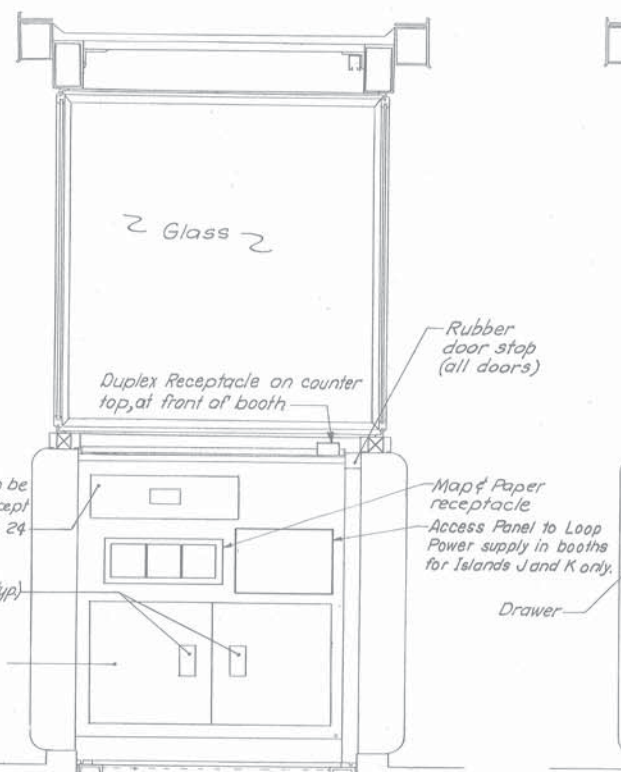

SECTION B-B
1" = 1'-0"

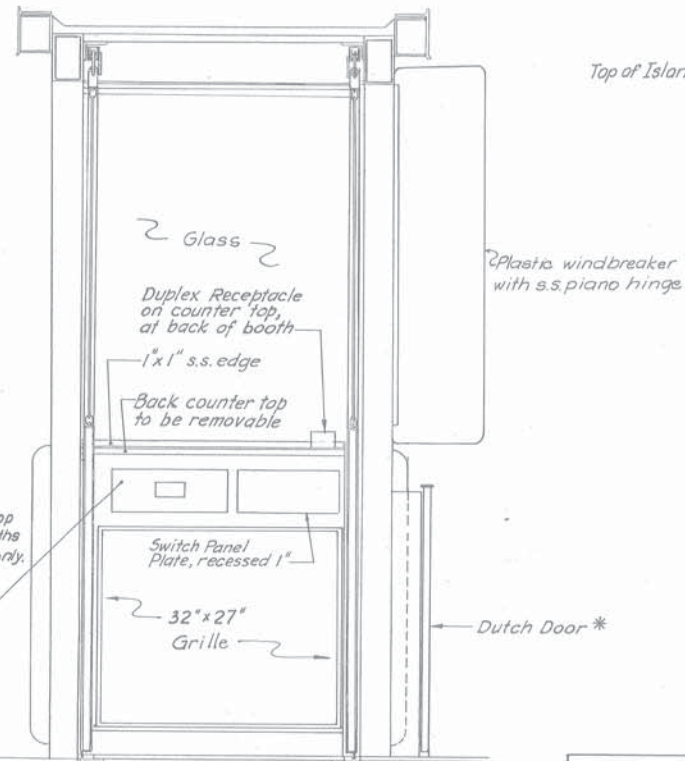

SECTION C-C
1" = 1'-0"

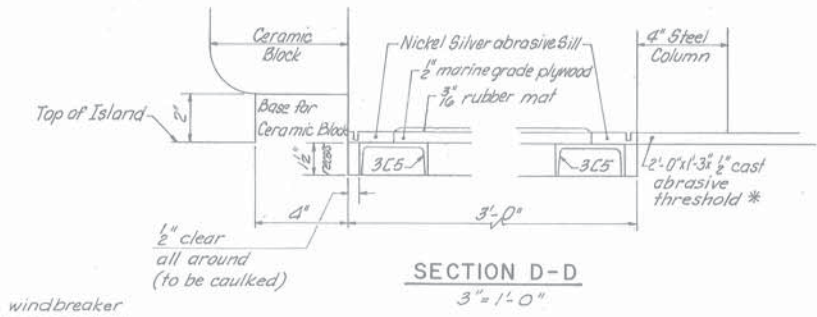


SECTION D-D
3" = 1'-0"

- NOTES:**
1. For details of booth construction see Sheet 23
 2. For details of cash tray, map receptacle and dutch door see Sheet 24


MAINE STATE HIGHWAY COMMISSION
AUGUSTA, MAINE

**TOLL BOOTHS
ELEVATIONS & SECTIONS**


HOWARD, NEEDLES, TAMMEN & BERGENDOFF
CONSULTING ENGINEERS
NEW YORK BOSTON KANSAS CITY

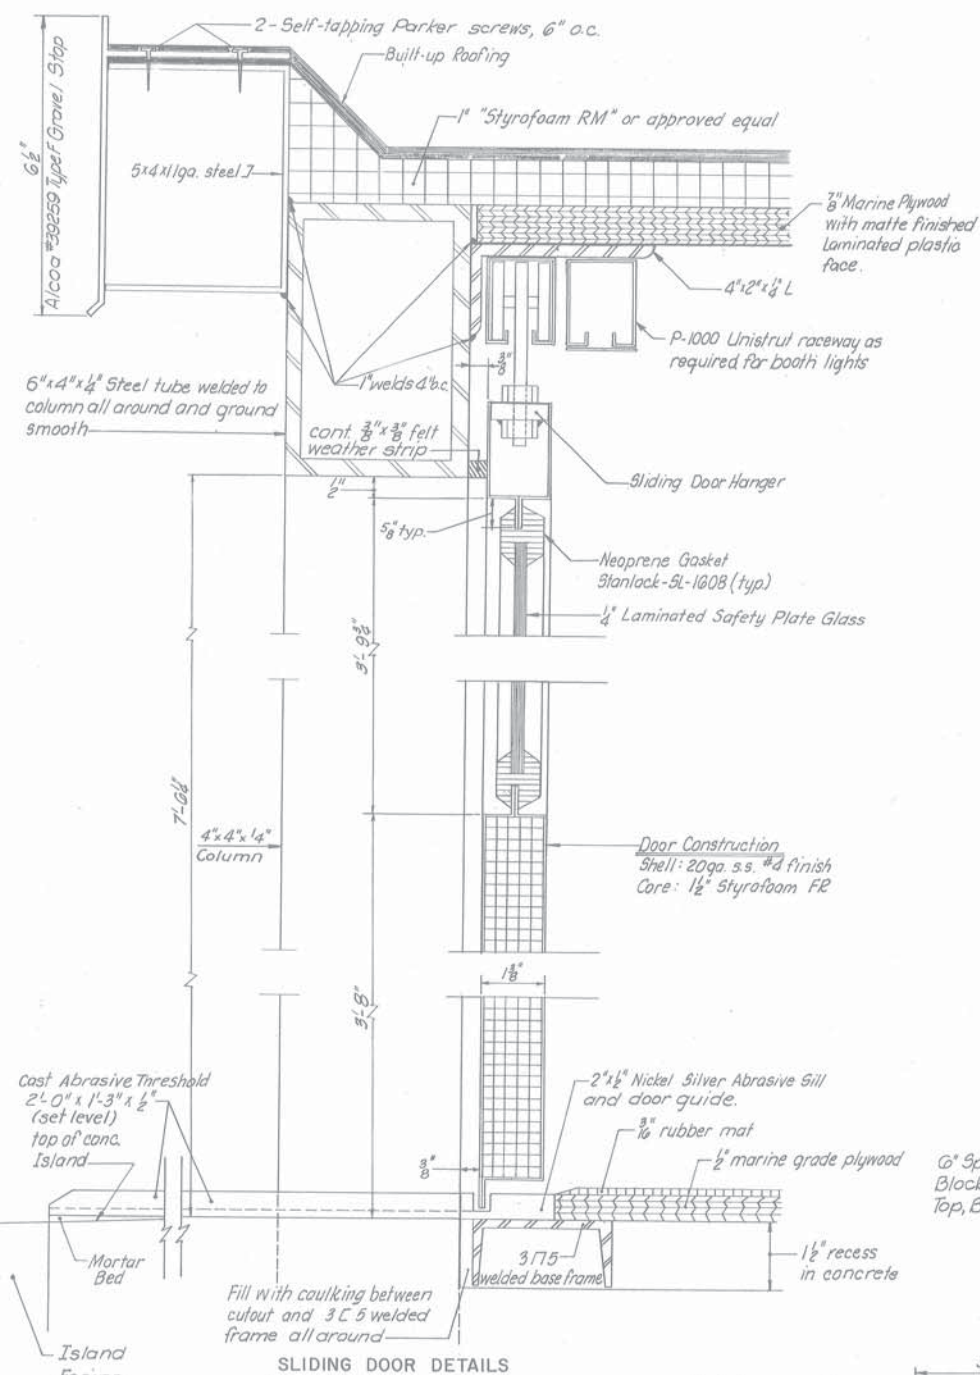


SLIDING DOOR DETAILS

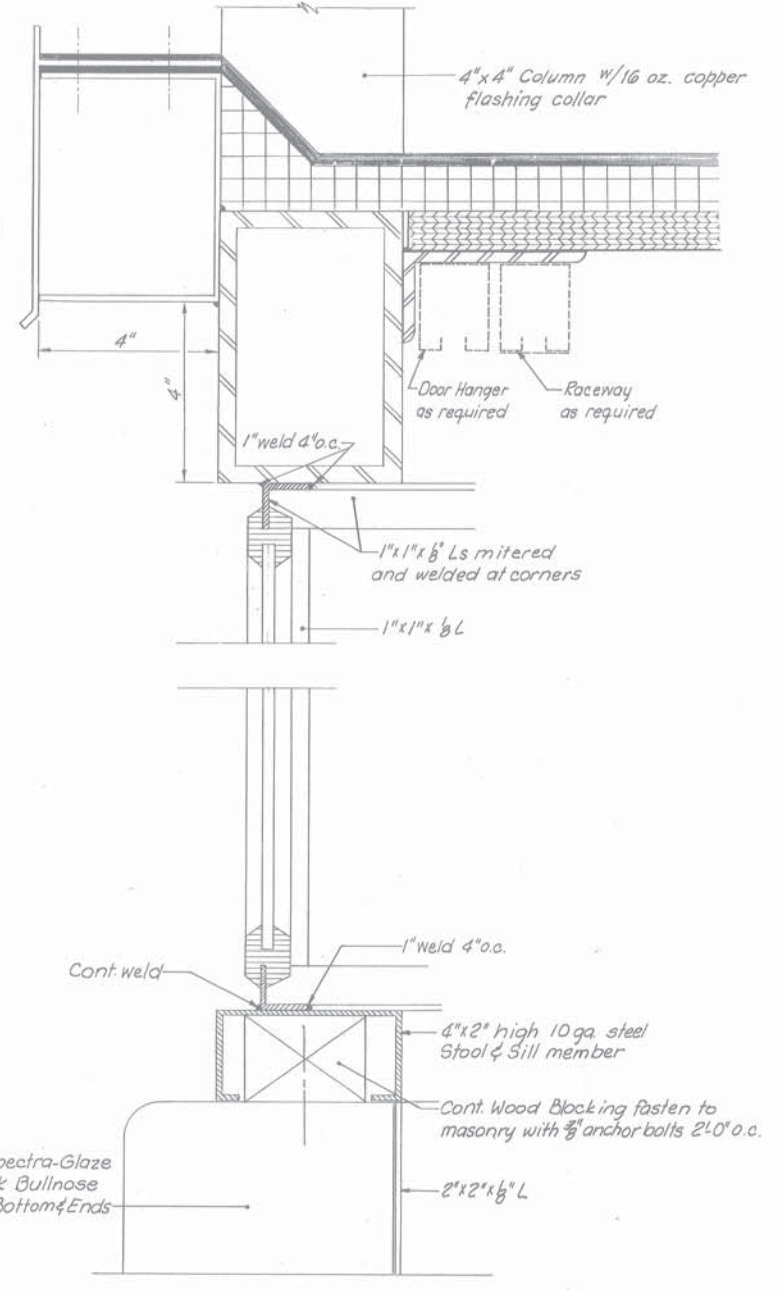


WINDOW DETAIL

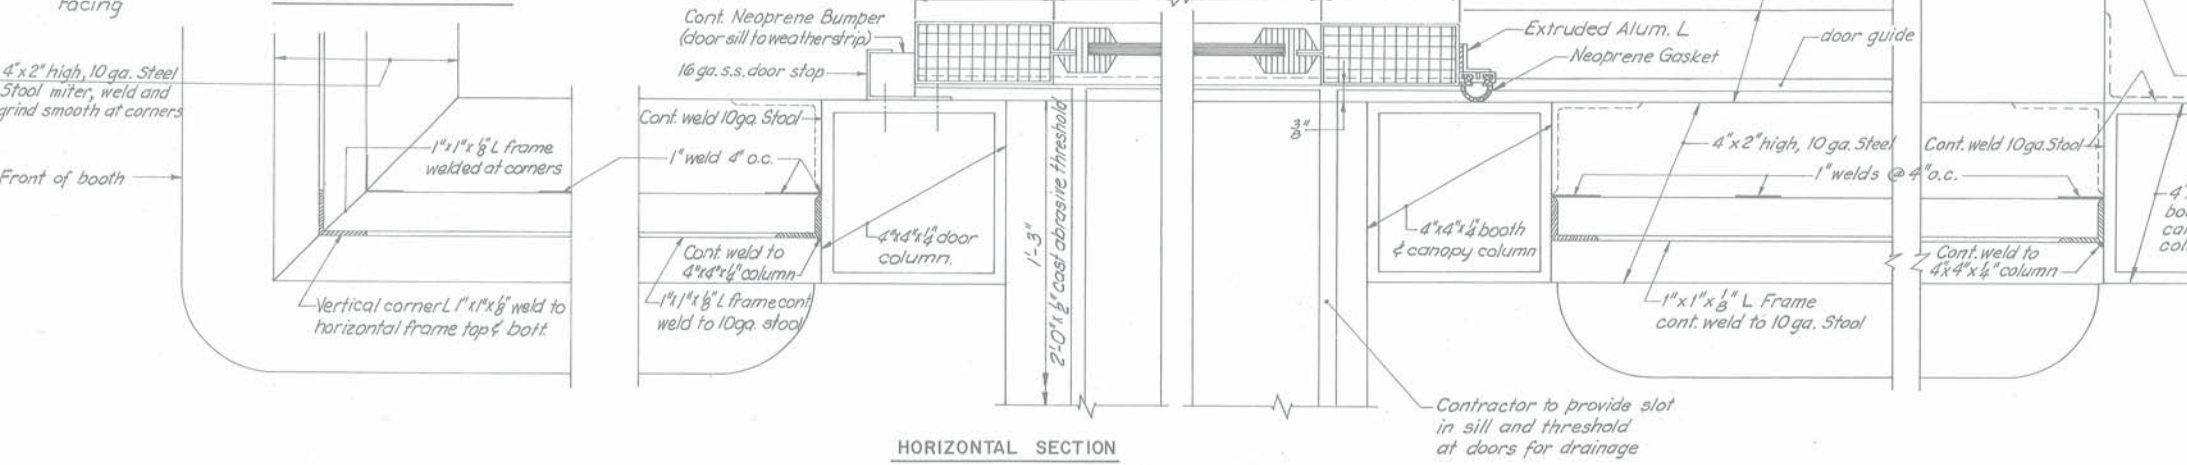

HORIZONTAL SECTION

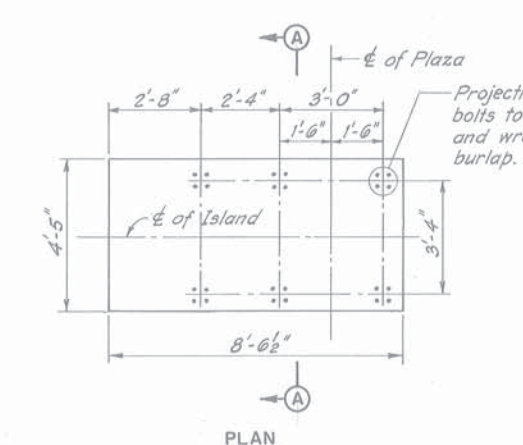


PLAN

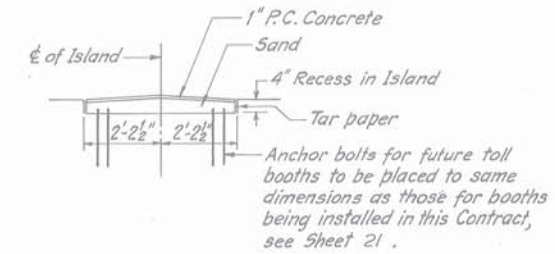

SECTION A-A

FUTURE BOOTH RECESS
(Use on Islands A, B & L)
3/8" = 1'-0"

For anchor bolt placement and details see Sheet 21
For conduit locations and termination details see Sheets 26 or 27

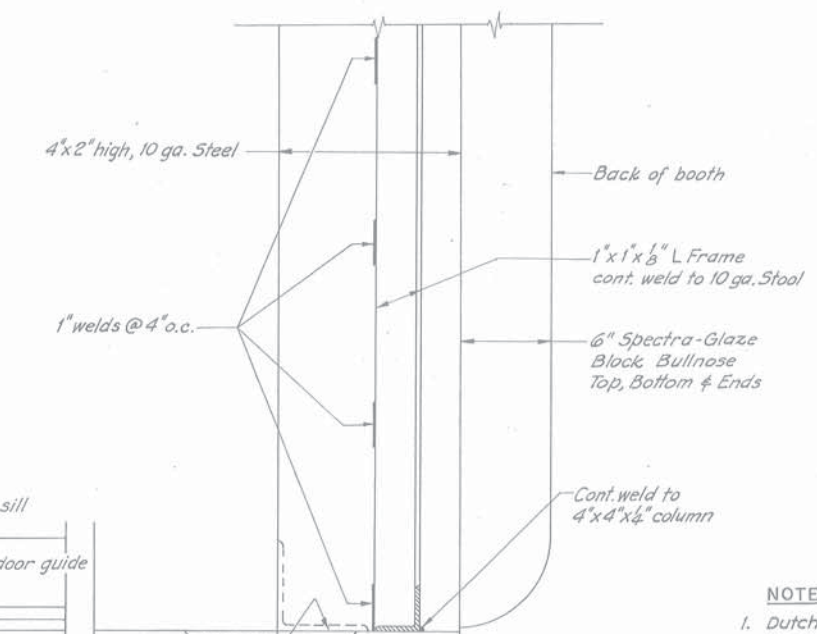


- NOTE:**
- Dutch Door omitted from these Sections. For Dutch Door details see Sheet 24
 - All details are half size unless otherwise noted.

MAINE STATE HIGHWAY COMMISSION
AUGUSTA, MAINE


TOLL BOTH DETAILS

HOWARD, NEEDLES, TAMMEN & BERGENDOFF
CONSULTING ENGINEERS

NEW YORK BOSTON KANSAS CITY


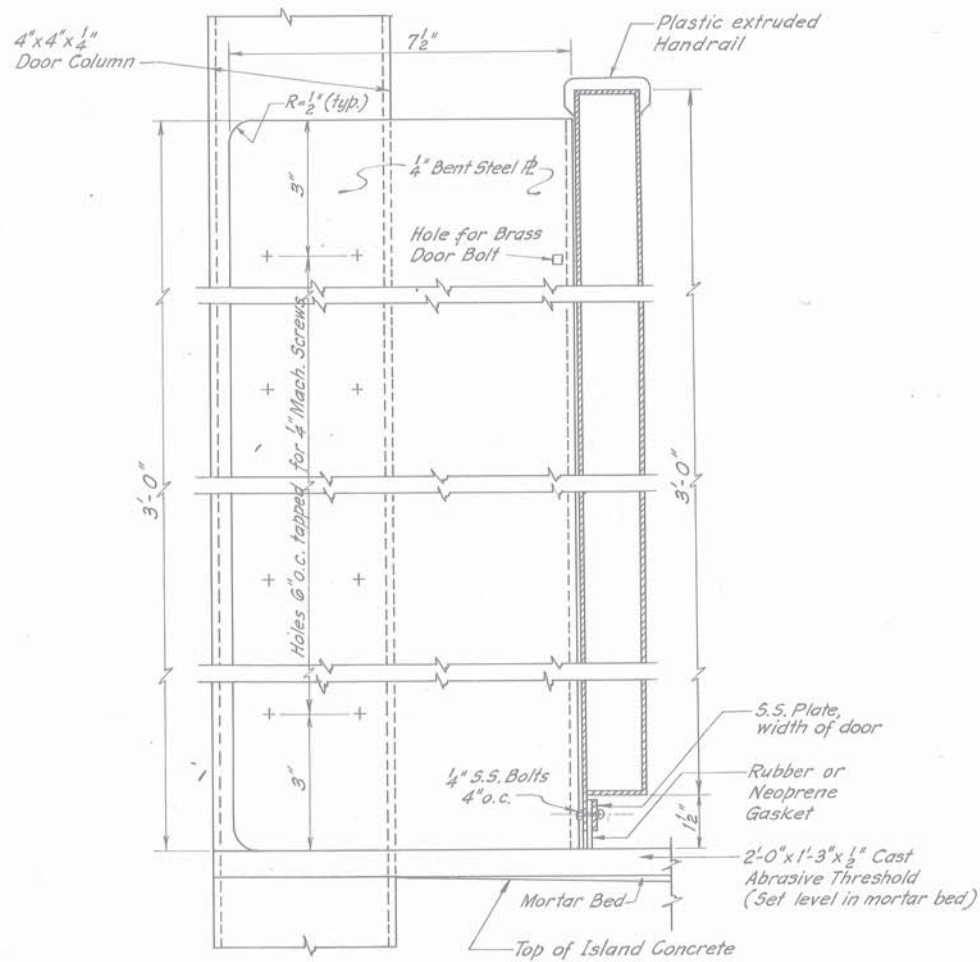


SECTION B-B

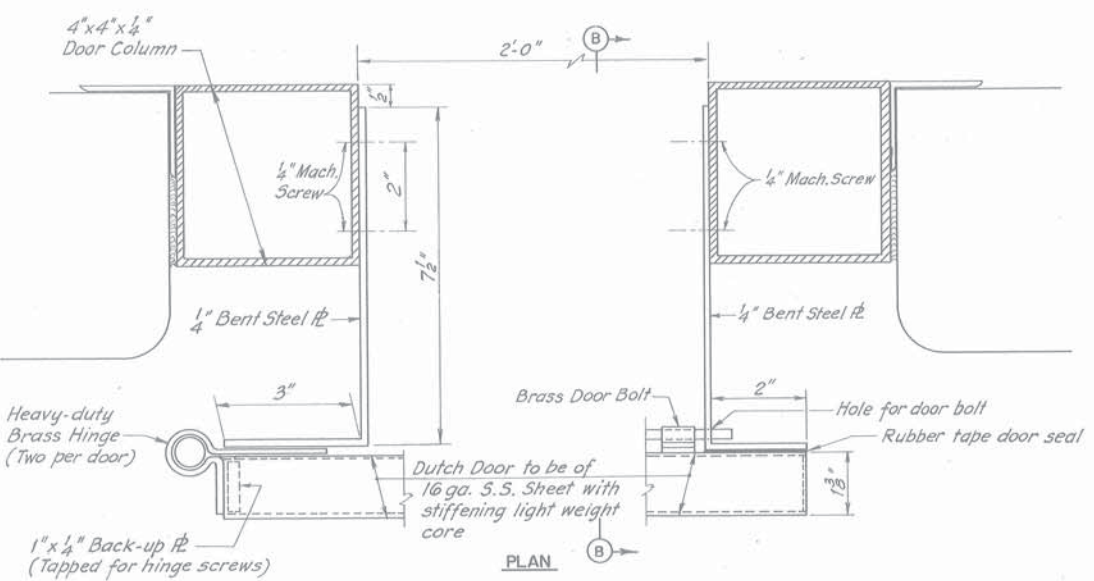

DUTCH DOOR DETAILS


Half size

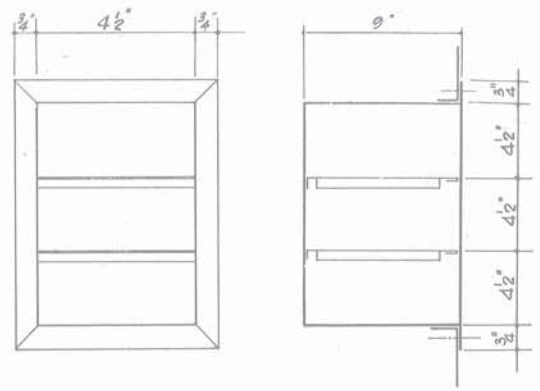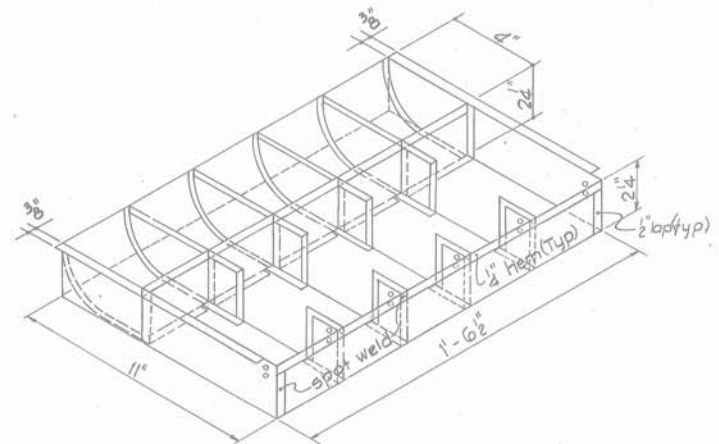

ELEVATION SECTION


MAP & PAPER RECEPTACLE
N.T.S.

CASH TRAY INSERT
N.T.S.

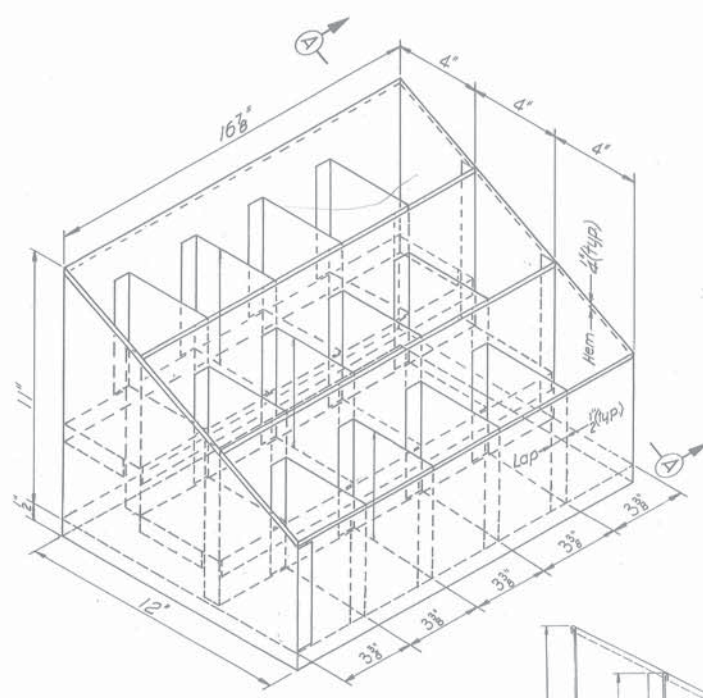

TOLL TICKET HOLDER

3'-1'-0"

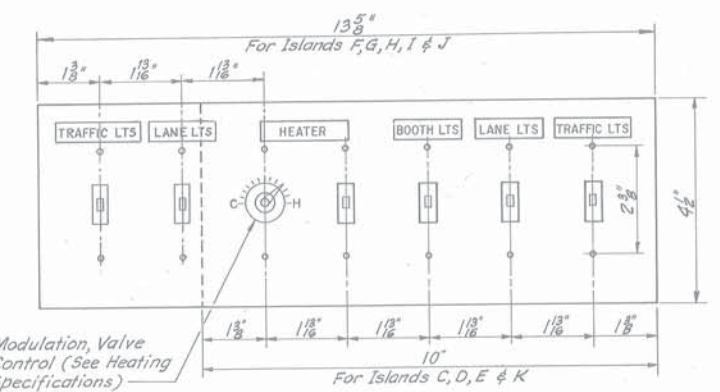


SWITCH PANEL PLATE DETAIL

Half size


Note: Plate shall be Stainless Steel .040" Recessed 3/8" into face of Counter.

SWITCH SCHEDULE:
Heater - 20A-3-position Hubbell Cat. No. 1385
Traffic Lights - 20A-1-pole Hubbell Cat. No. 2971.
Single Booth Lts - 20A-1-pole Hubbell Cat. No. 2971.
Lane Lts - 30A-1-pole Hubbell Cat. No. 2923
Lane Lts - 30A-3 way Hubbell Cat. No. 2925.

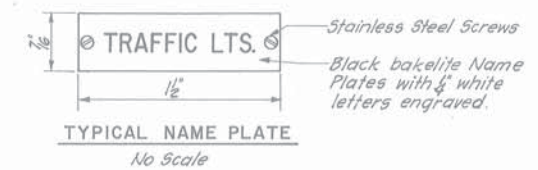

TYPICAL NAME PLATE

No Scale

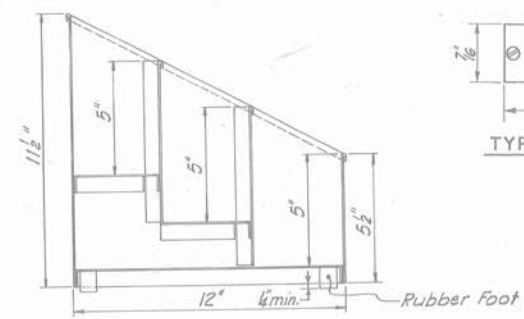

SECTION A-A


3'-1'-0"

MAINE STATE HIGHWAY COMMISSION
AUGUSTA, MAINE

MISCELLANEOUS DETAILS

HOWARD, NEEDLES, TAMMEN & BERGENDOFF
CONSULTING ENGINEERS

NEW YORK BOSTON KANSAS CITY

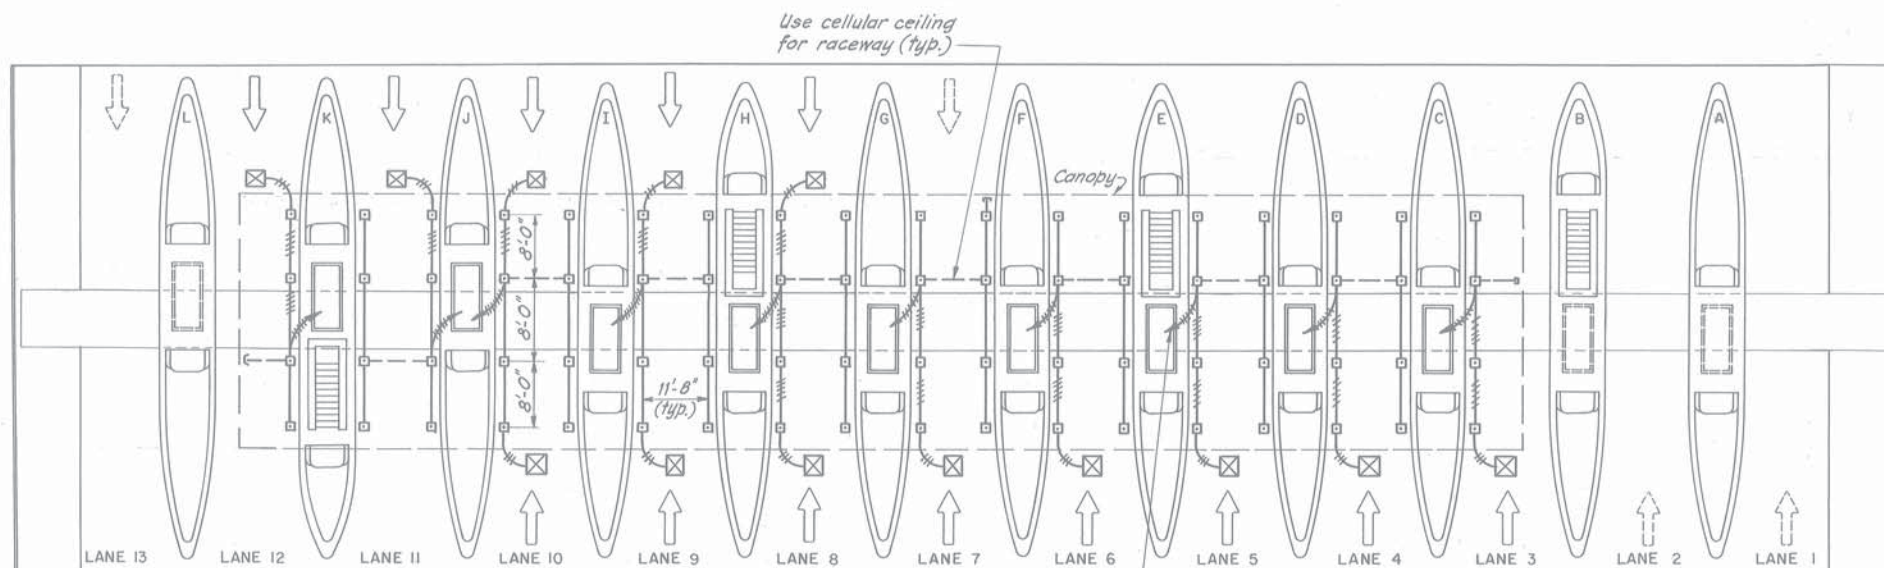


LANE LIGHTING PLAN

$\frac{3}{32}'' = 1'-0''$

LEGEND

- Toll Booths
- Future Toll Booths
- Lane Control Signal
- Lane Light
- Toll Island Circuit Breaker Panel
- Treadle Terminal Box

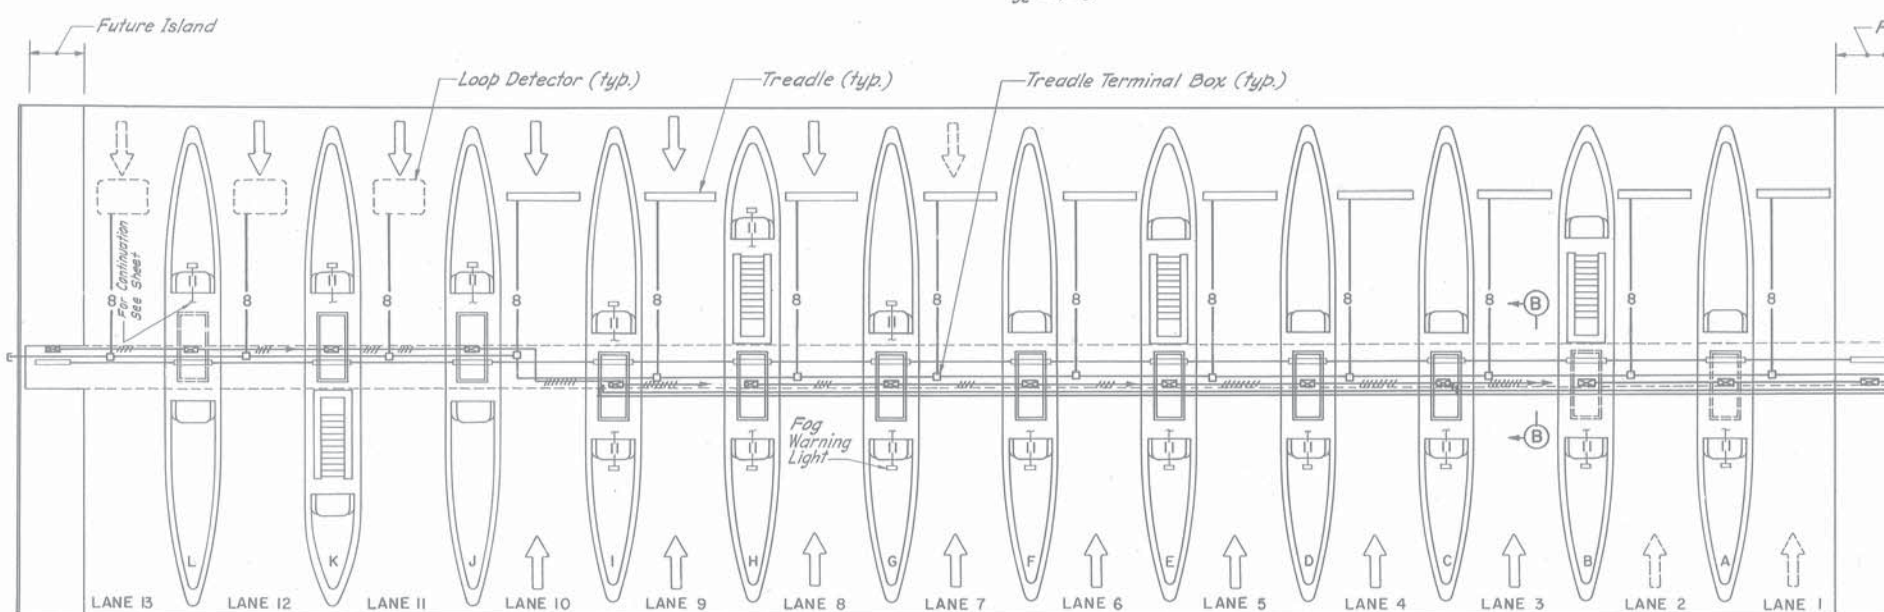

TUNNEL & LIGHTING CONDUIT FEEDERS

$\frac{3}{32}'' = 1'-0''$










NOTES:

1. Duplex receptacle to be installed adjacent to each circuit breaker panel.
2. See Sheet 27 for Section B-B and locations of conduit and panel on tunnel wall and typical conduit layout for each booth.
3. See Sheet 27 for conduit schedule and circuit breaker layout.

MAINE STATE HIGHWAY COMMISSION
AUGUSTA, MAINE

TOLL PLAZA
LIGHTING PLAN

HOWARD, NEEDLES, TAMMEN & BERGENDOFF
CONSULTING ENGINEERS
NEW YORK BOSTON KANSAS CITY

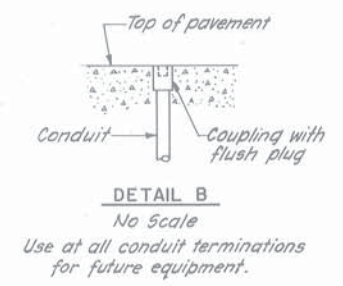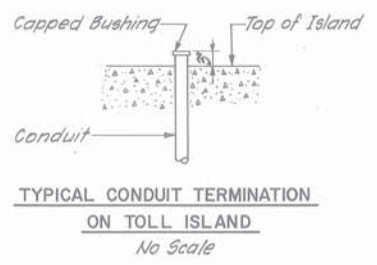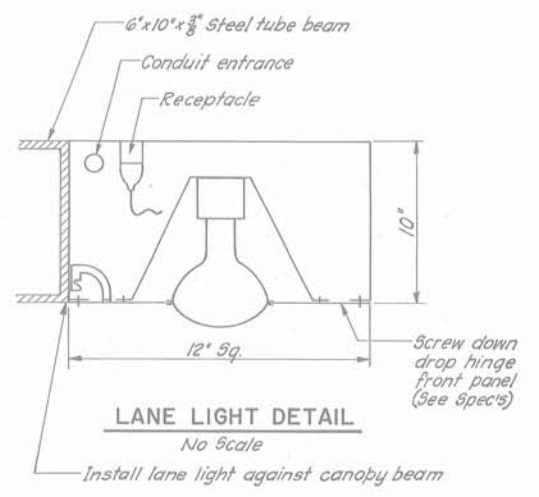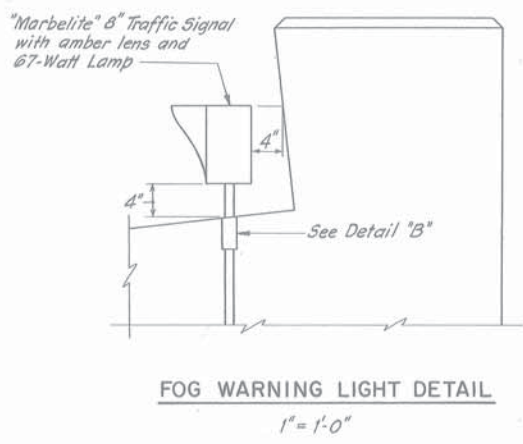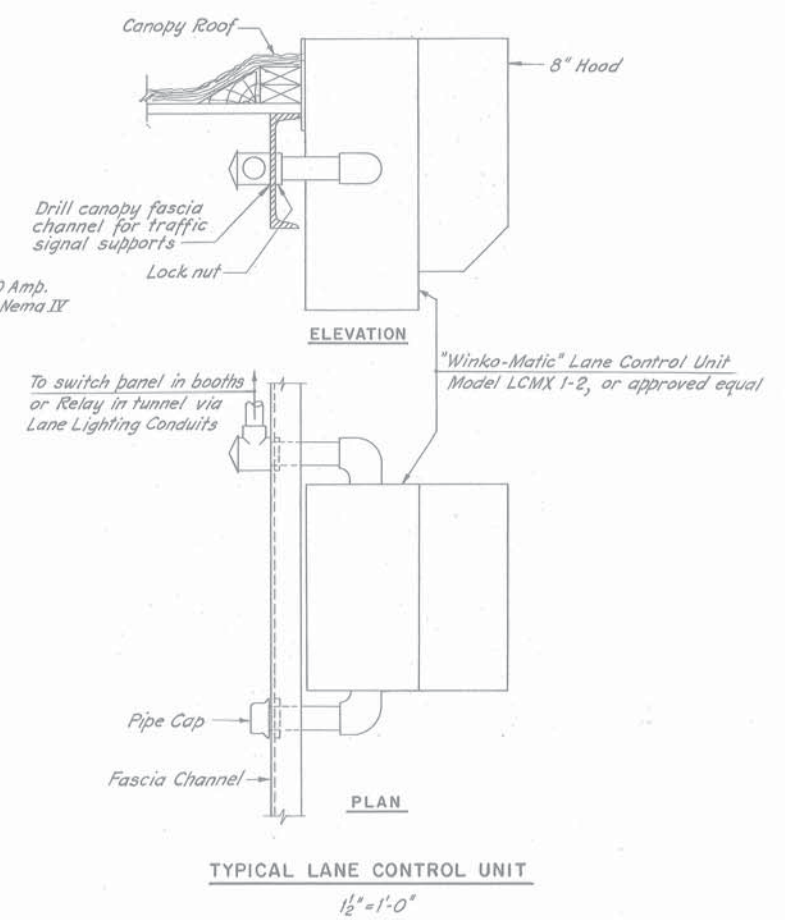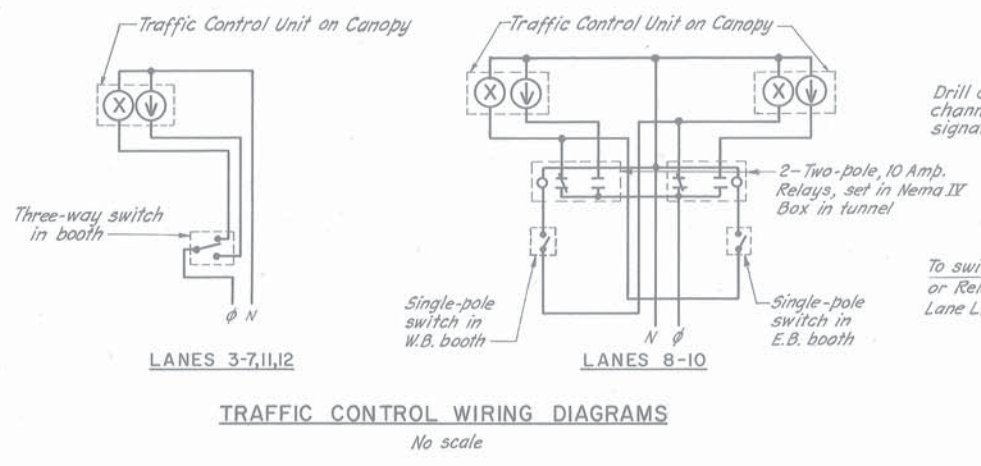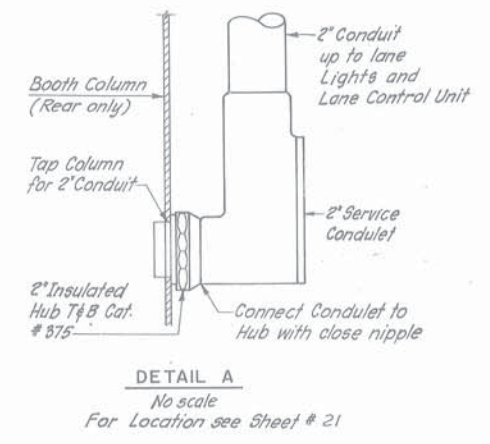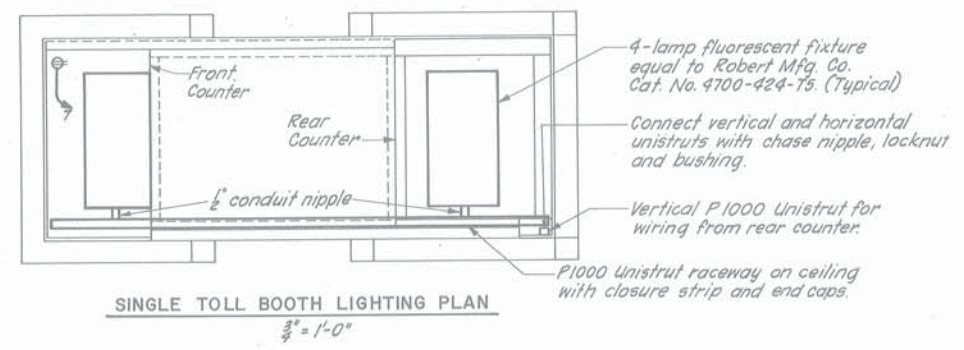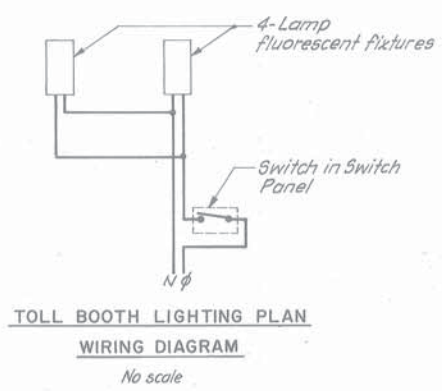


MAINE STATE HIGHWAY COMMISSION
AUGUSTA, MAINE

ELECTRICAL DETAILS

HOWARD, NEEDLES, TAMMEN & BERGENDOFF
CONSULTING ENGINEERS

NEW YORK BOSTON KANSAS CITY

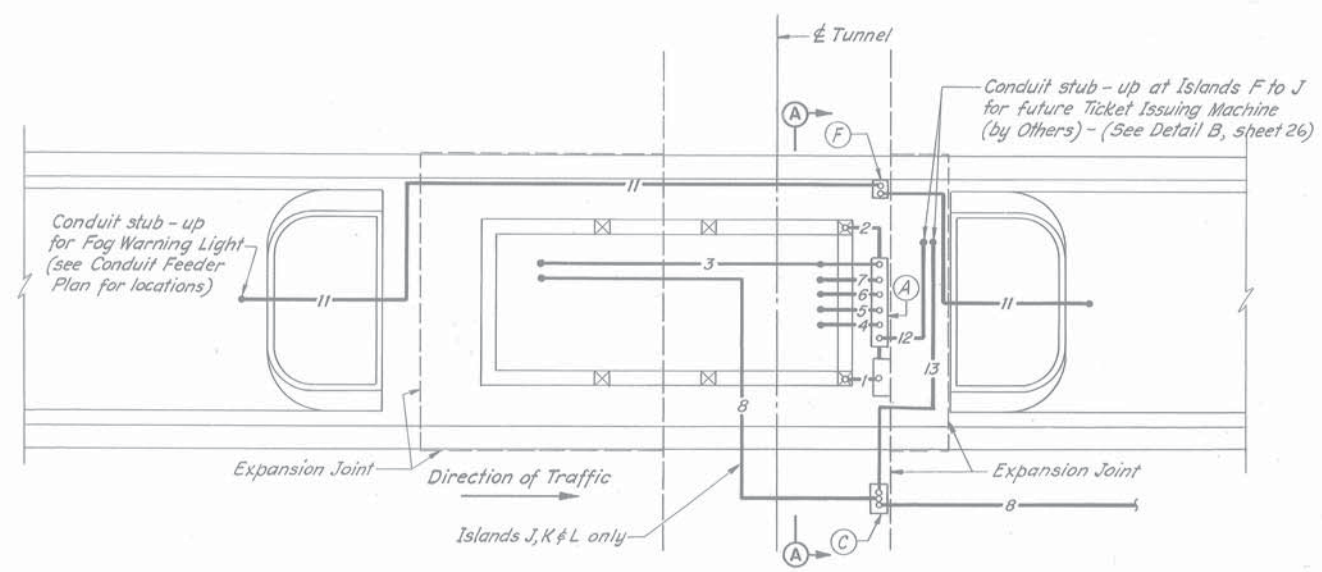


TYPICAL ISLAND CONDUIT LAYOUT

1/2" = 1'-0"


On Islands A, B, L & Future Islands conduit to be terminated as shown in Detail B, Sheet 26

TOLL PLAZA EQUIPMENT SCHEDULE

- (A) Toll Island Circuit Breaker Panel
- (B) Booth Heating Unit
- (C) Treadle Terminal Box
- (D) Toll Booth
- (E) Duplex Receptacle in F.D. Box
- (F) Fog Warning Light Junction Box

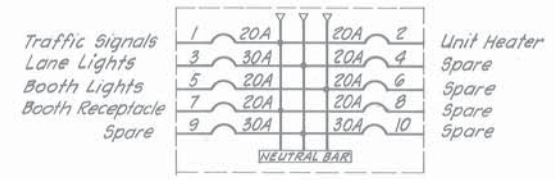

ISLANDS A thru I, K & L

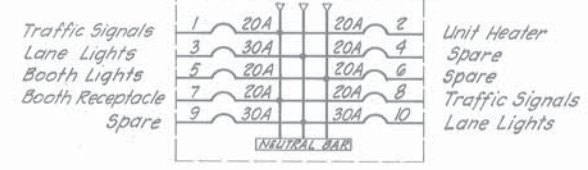


ISLAND J


TOLL ISLAND CIRCUIT BREAKER PANEL ARRANGEMENTS

CONDUIT SCHEDULE

CONDUIT NO.	DESIGNATION	FOR	CONDUIT SIZE
1	Lane Control Units and Lane Lights	Canopy	1 1/4"
2	Spare (except Island J, used same as Conduit No.1)	Canopy	1 1/4"
3	Booth Duplex Receptacle	Booths	1"
4	Unit Heater Power Supply	Booths	1"
5	Lane Control Signal Units	Booths	1"
6	Booth Lights	Booths	1 1/4"
7	Spare	Booths	1 1/2"
8	Treadle	Booths	1 1/2"
9	Radio (Island C & I only)	Booths	3/4"
10	Telephone (Island C & I only)	Booths	3/4"
11	Fog Warning Light	Island	1 1/2"
12	Ticket Issuing Machine, Power Supply	Island	1 1/2"
13	Ticket Issuing Machine, Control	Island	1 1/2"

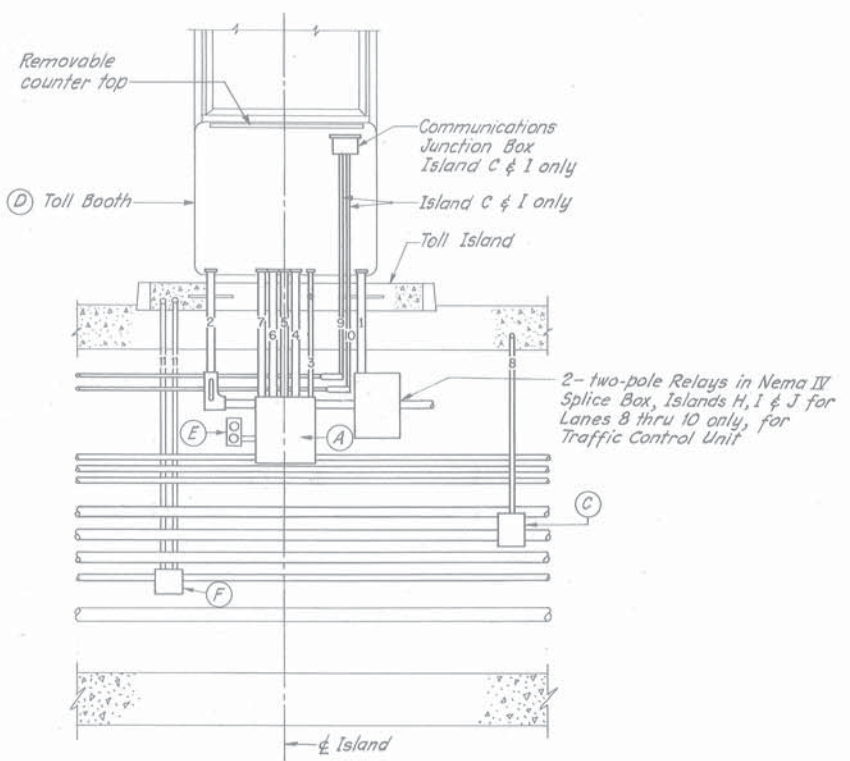

SECTION A-A
1/2" = 1'-0"

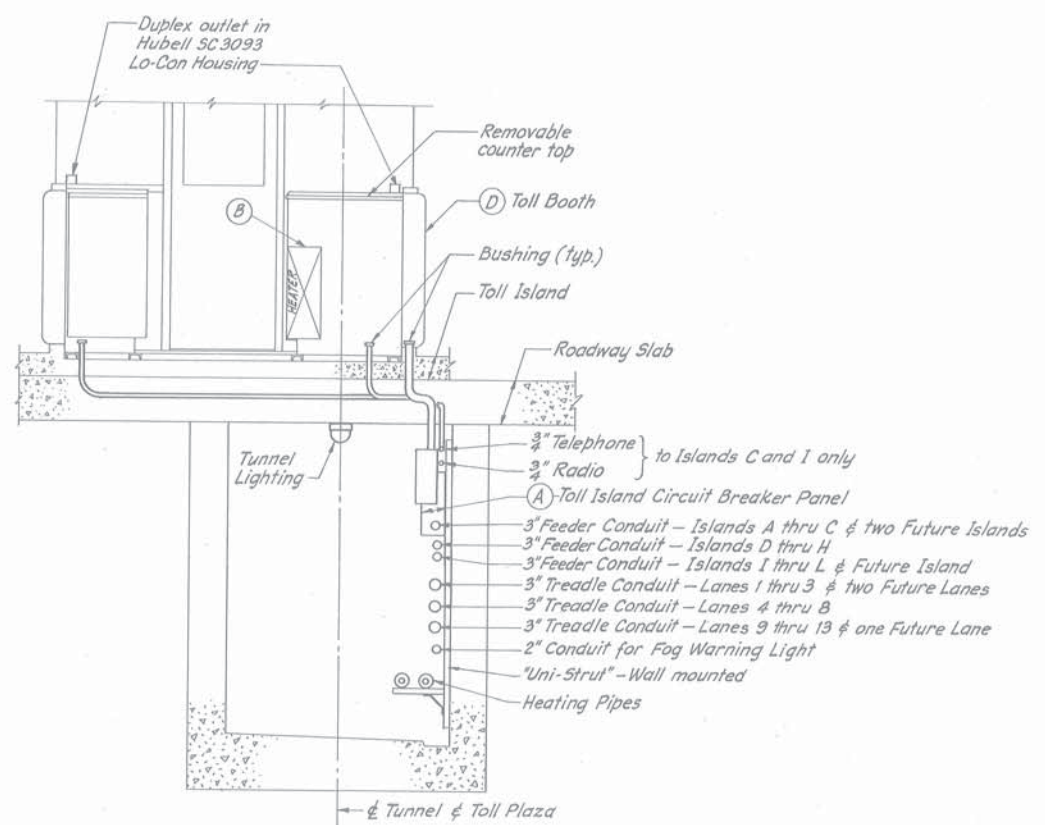

SECTION B-B
1/2" = 1'-0"

NOTES:

1. All horizontal runs shall be installed in tunnel roof or roadway slab. All vertical runs from panel boxes on tunnel wall to roof slab shall be exposed.
2. Provide a "Uni-Strut" support system complete with fittings and connections for mounting conduits and piping.
3. All conduits for future Islands shall be completely installed and terminated as indicated in Detail B, sheet 26.
4. Both ends of all conduits shall be identified with brass wrap-around tags embossed with high numbers. Tags shall be equal to Seton Name Plate Co's Cable Markers.
5. Expansion deflection couplings are to be provided wherever conduits pass through expansion joints.

MAINE STATE HIGHWAY COMMISSION
AUGUSTA, MAINE

TOLL PLAZA TUNNEL
ELECTRICAL DETAILS

HOWARD, NEEDLES, TAMMEN & BERGENDOFF
CONSULTING ENGINEERS

NEW YORK BOSTON KANSAS CITY

S.P.R. REG. NO.	STATE	PROJECT NUMBER	SHEET NO.	TOTAL SHEETS
1	MAINE	108	28	58

LEGEND

- CONCRETE
- CONCRETE BLOCK
- RIGID INSULATION
- BLANKET INSULATION
- ROUGH WOOD
- FINISH HARD WOOD
- WOOD STUD PARTITION
- ROOM NUMBER
- DOOR NUMBER
- SECTION
- ELEVATION
- SECTION OR DETAIL NUMBER
- DWG. OR SHEET NUMBER

ABBREVIATIONS

- B.F. BOTTOM OF FOOTING
- EL. ELEVATION
- H.M. HOLLOW METAL DOOR
- PL. GL. PLATE GLASS
- T.O. TRIMMED OPENING
- V.A.T. VINYL ASBESTOS TILE
- W.D. WOOD DOOR
- GYP. BD. GYPSUM BOARD
- AL. OR ALUM. ALUMINUM
- D.S. DOWN SPOUT

NOTE:
SEE STRUCTURAL DWG. A7
FOR SIZE & LOCATION OF PILES




MAINE STATE HIGHWAY COMMISSION
AUGUSTA, MAINE


**UTILITY BUILDING
BASEMENT FIRST FLOOR
& FRAMING PLANS**

HOWARD, NEEDLES, TAMMEN & BERGENDOFF
CONSULTING ENGINEERS


NEW YORK BOSTON KANSAS CITY

DWG. A-1

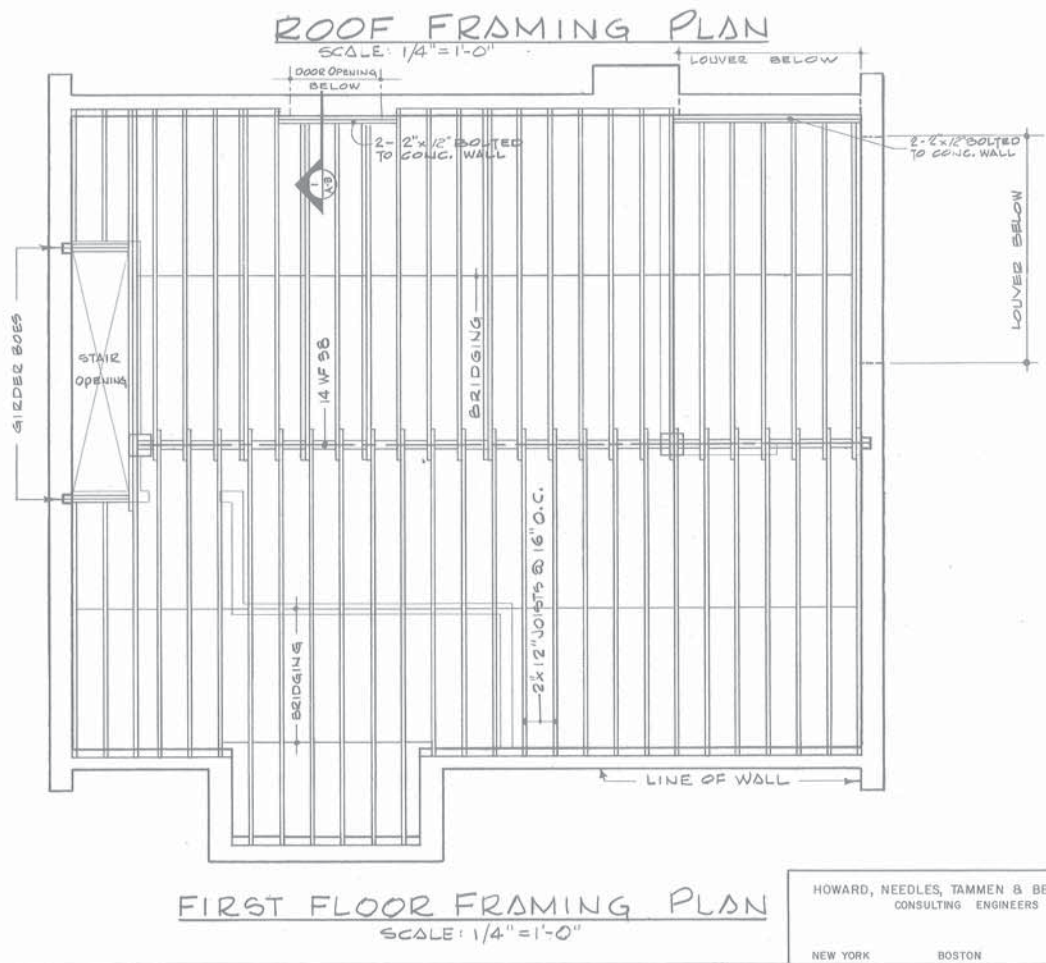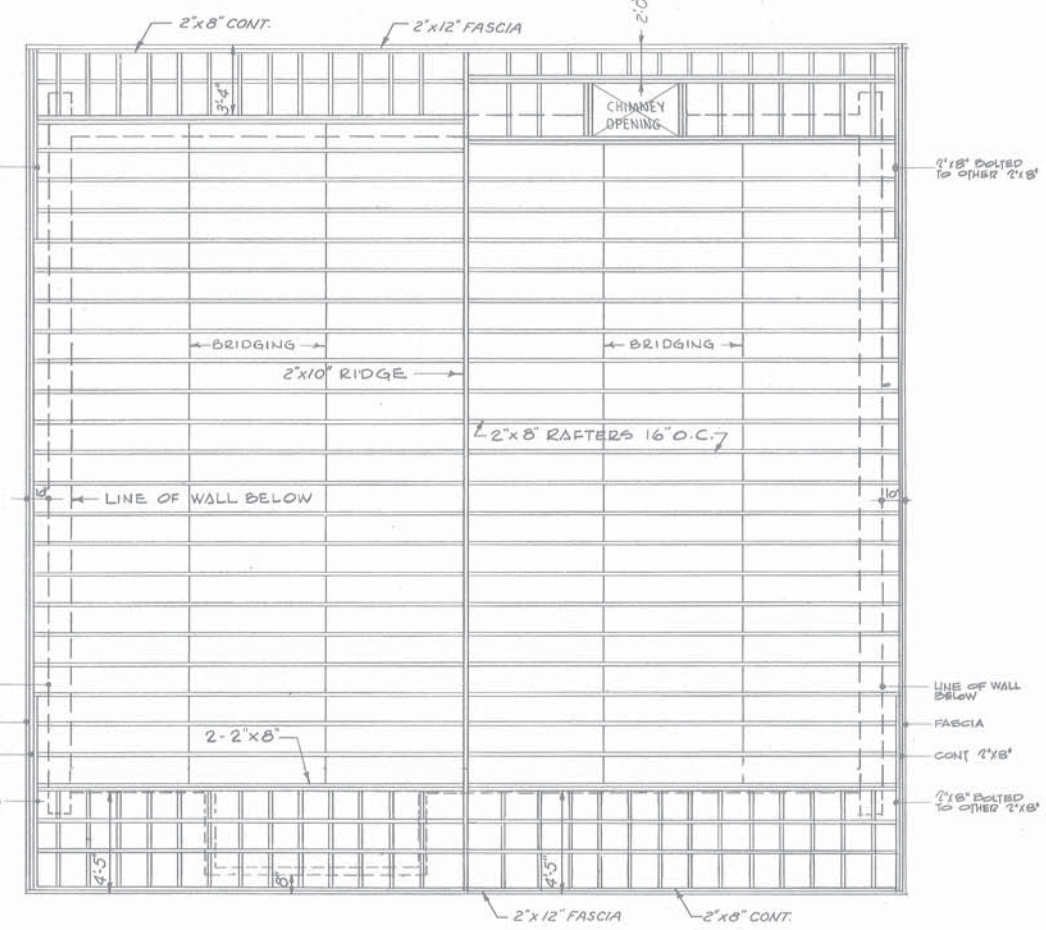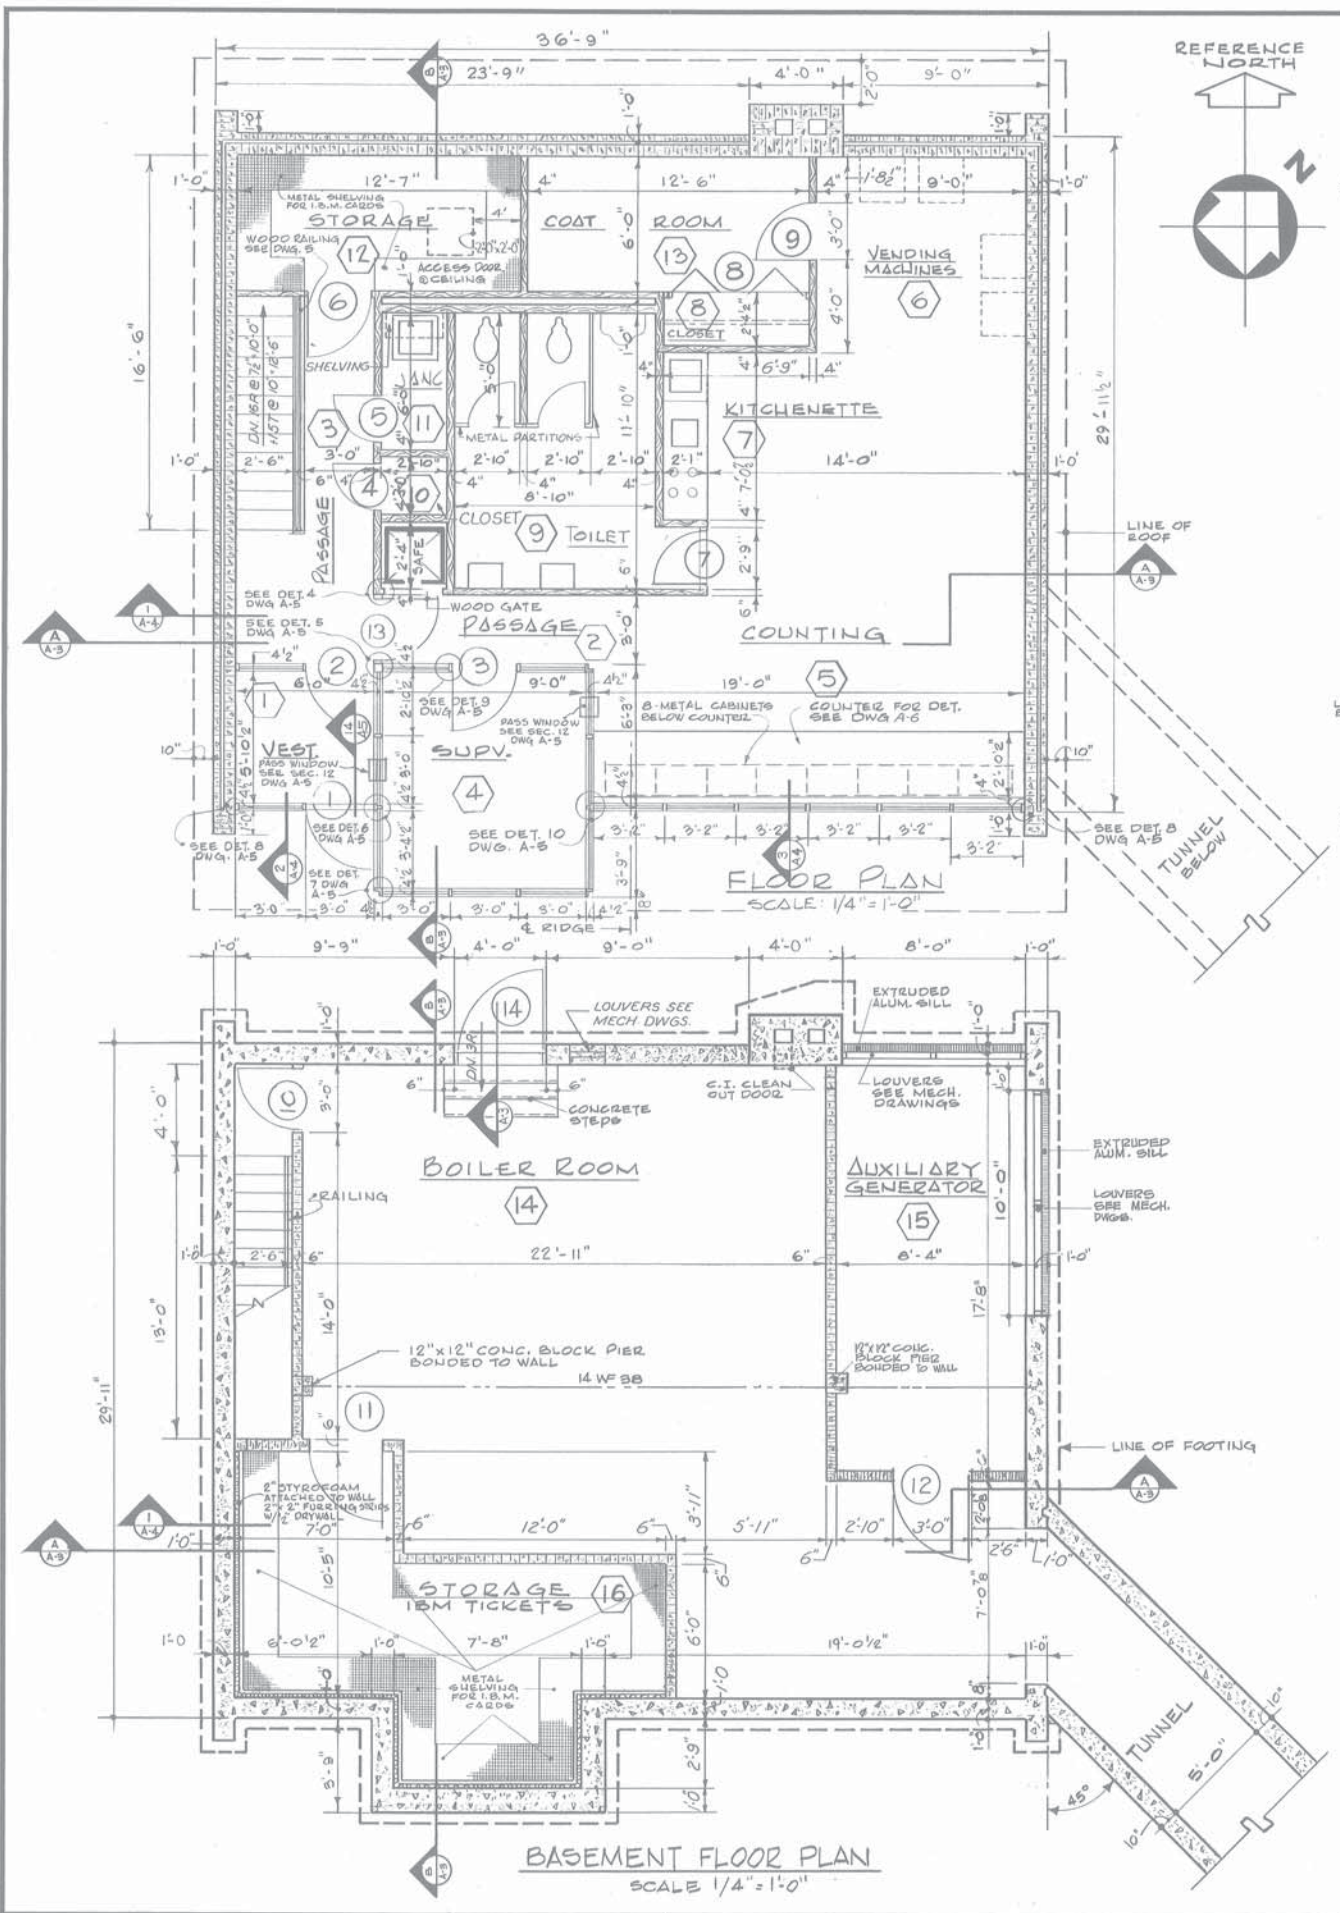


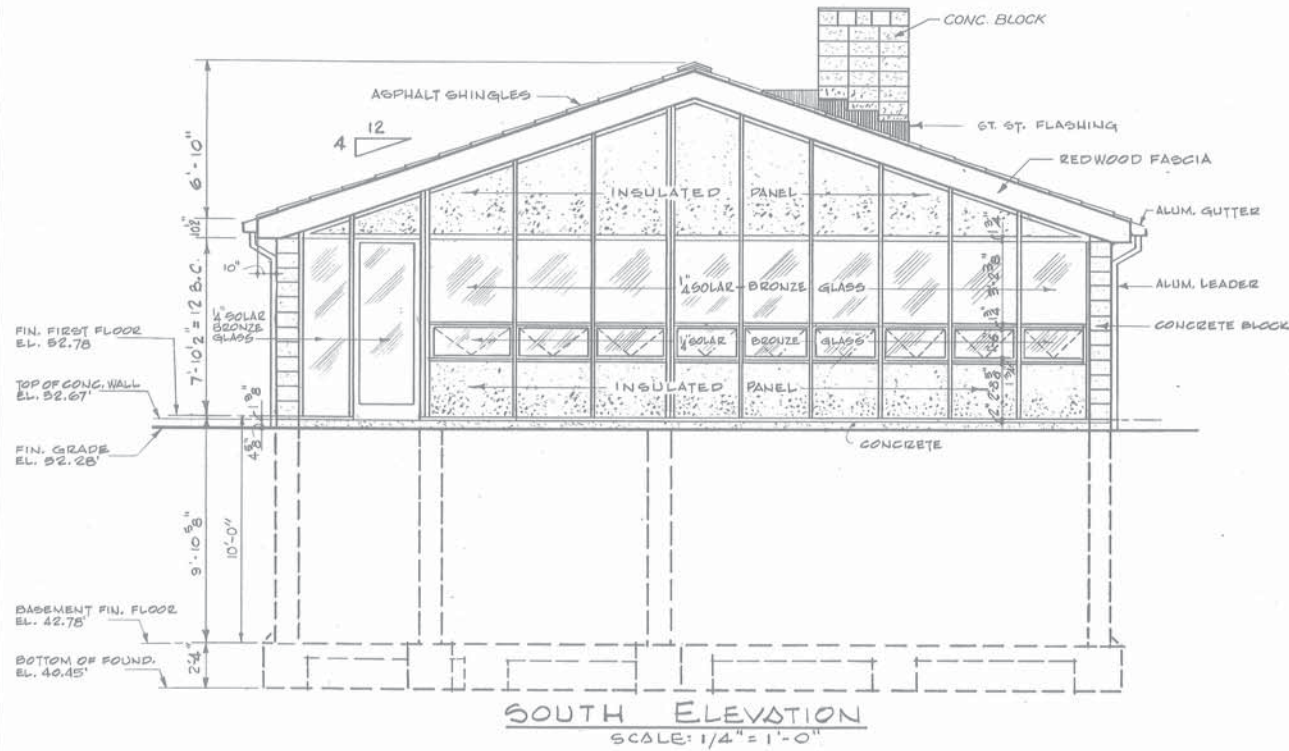


SOUTH ELEVATION
SCALE: 1/4" = 1'-0"

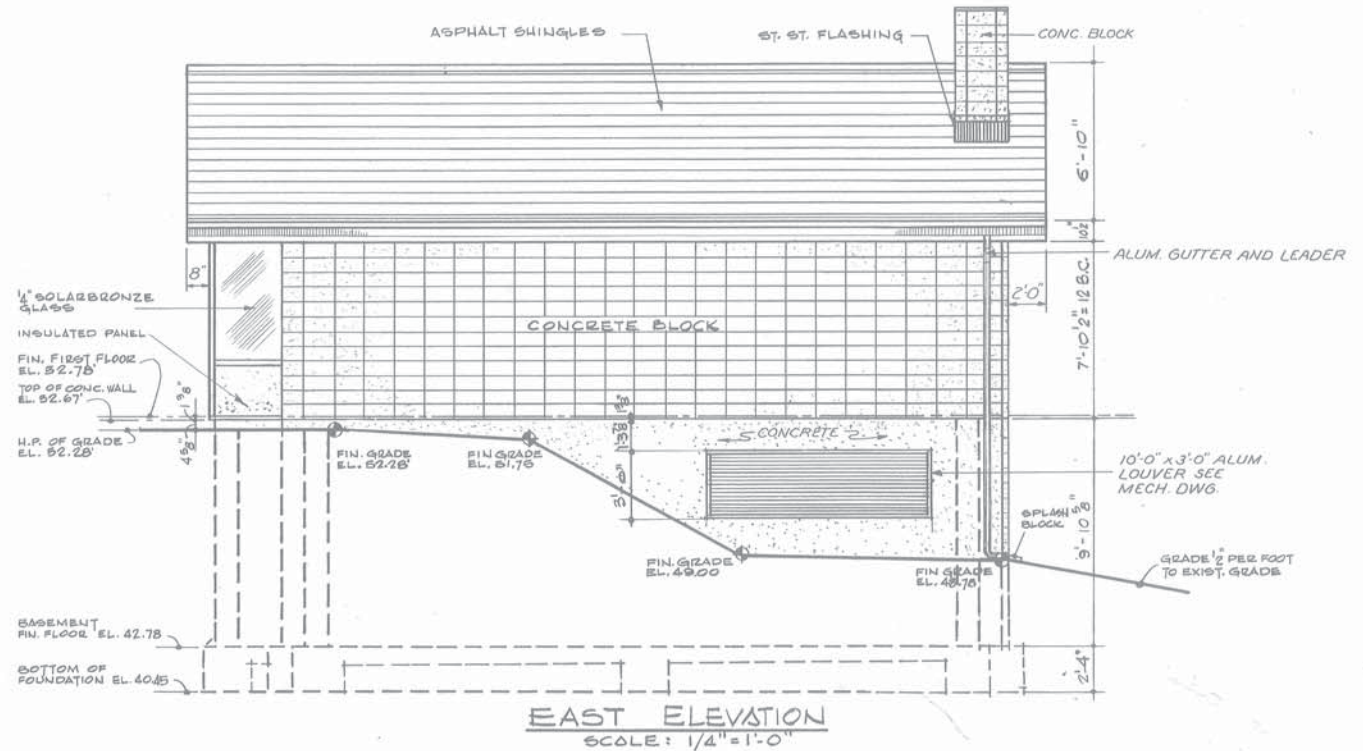

EAST ELEVATION
SCALE: 1/4" = 1'-0"

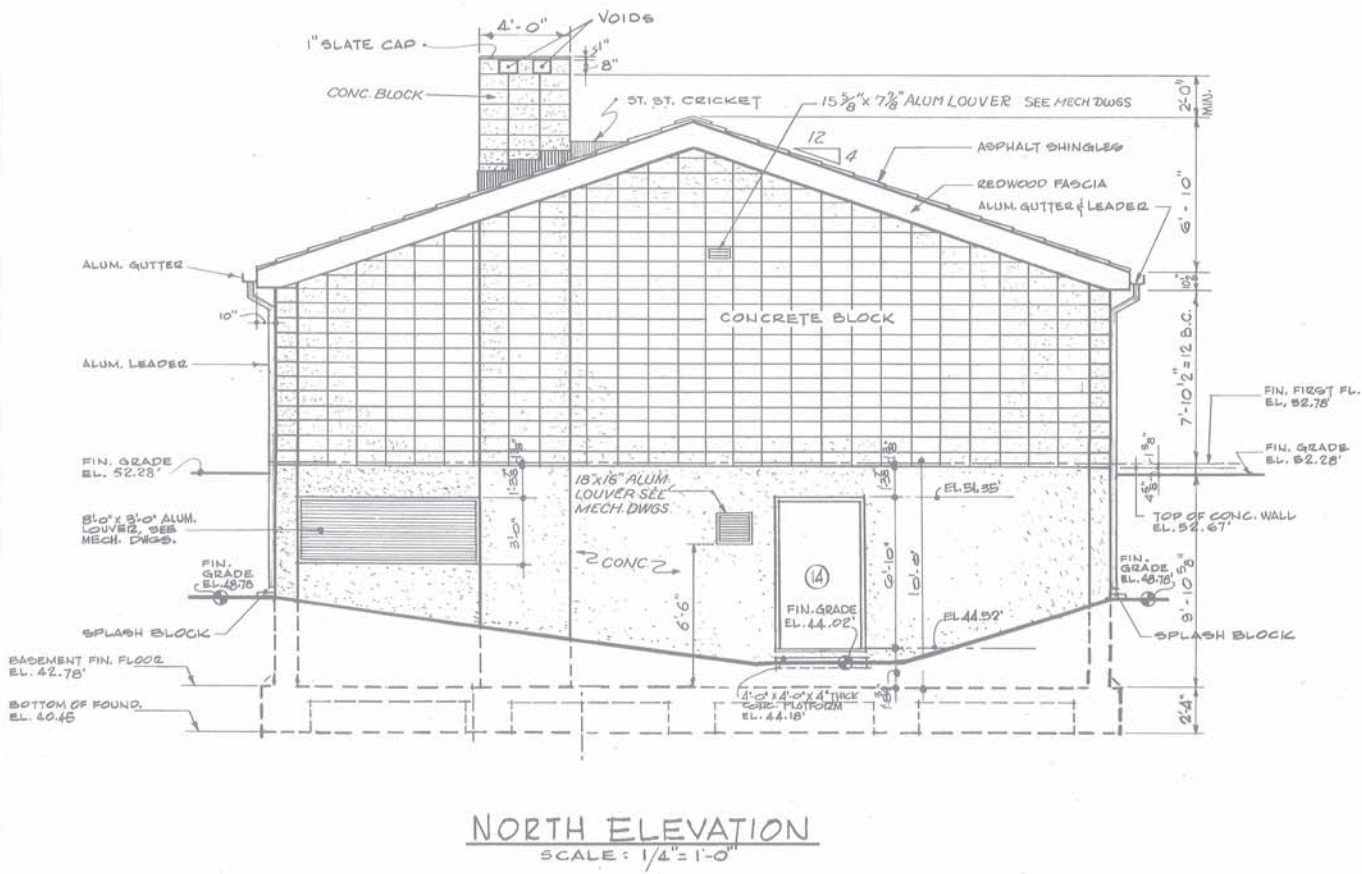

NORTH ELEVATION
SCALE: 1/4" = 1'-0"

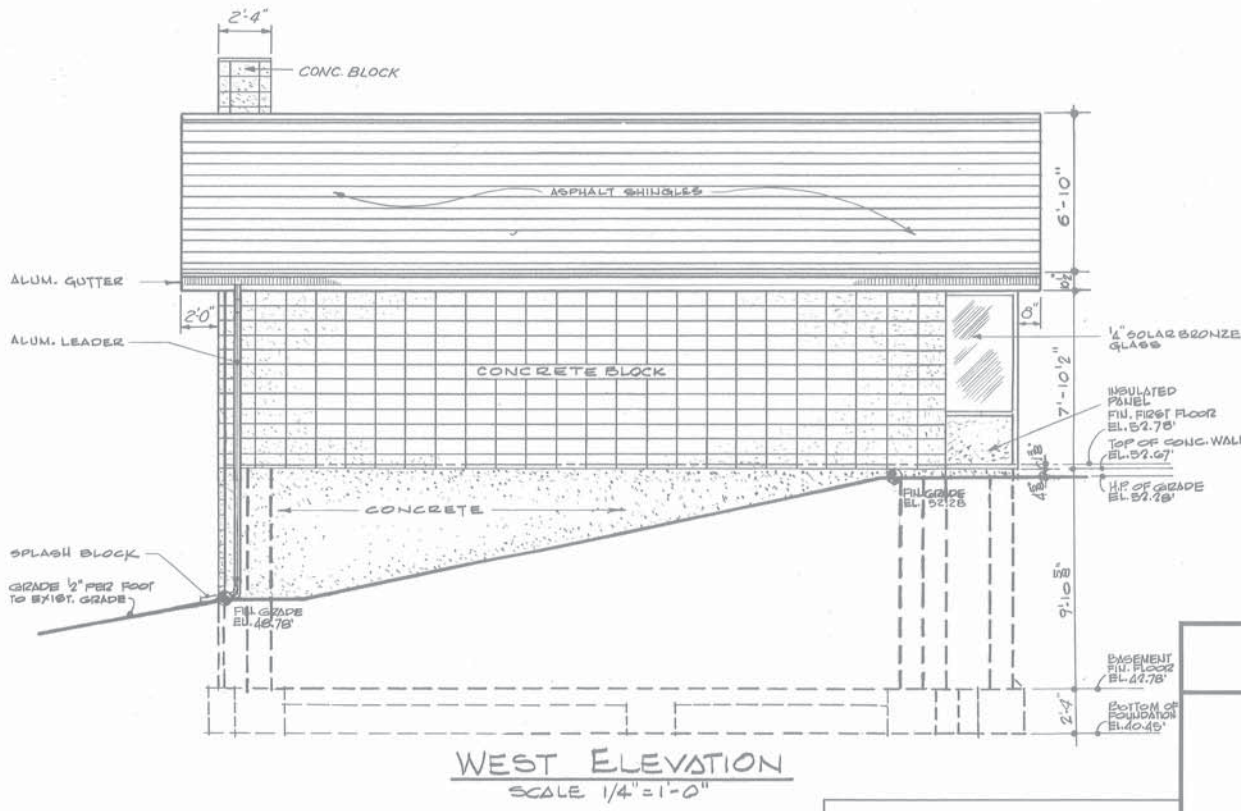





WEST ELEVATION
SCALE: 1/4" = 1'-0"

MAINE STATE HIGHWAY COMMISSION
AUGUSTA, MAINE

UTILITY BUILDING
EXTERIOR ELEVATIONS

HOWARD, NEEDLES, TAMMEN & BERGENDOFF
CONSULTING ENGINEERS
NEW YORK BOSTON KANSAS CITY

S.P.R.	STATE	PROJECT NUMBER	SHEET NO.	TOTAL SHEETS
1	MAINE	1-55-118	30	58

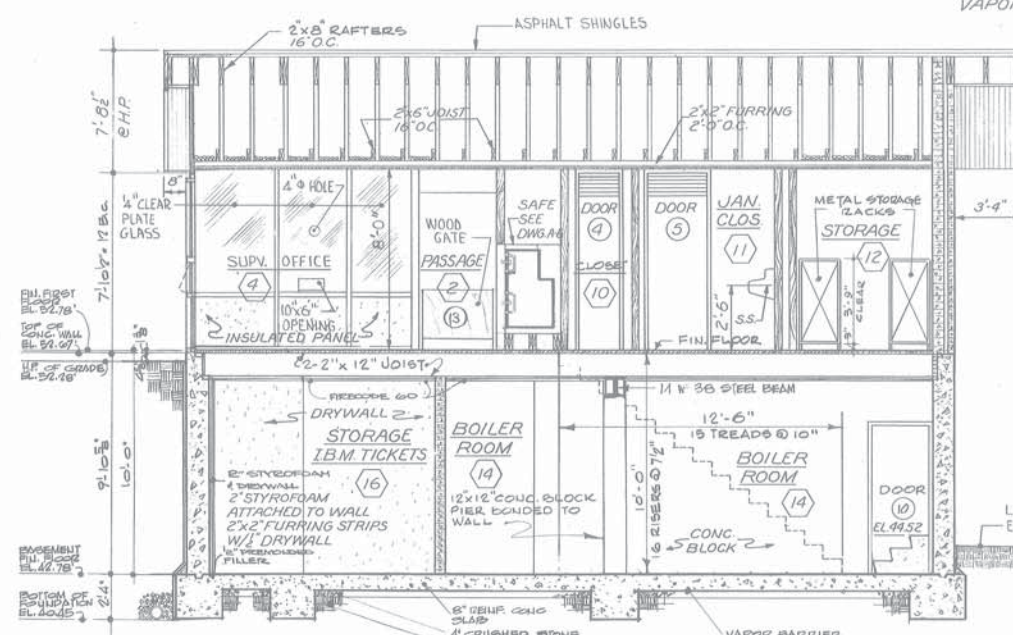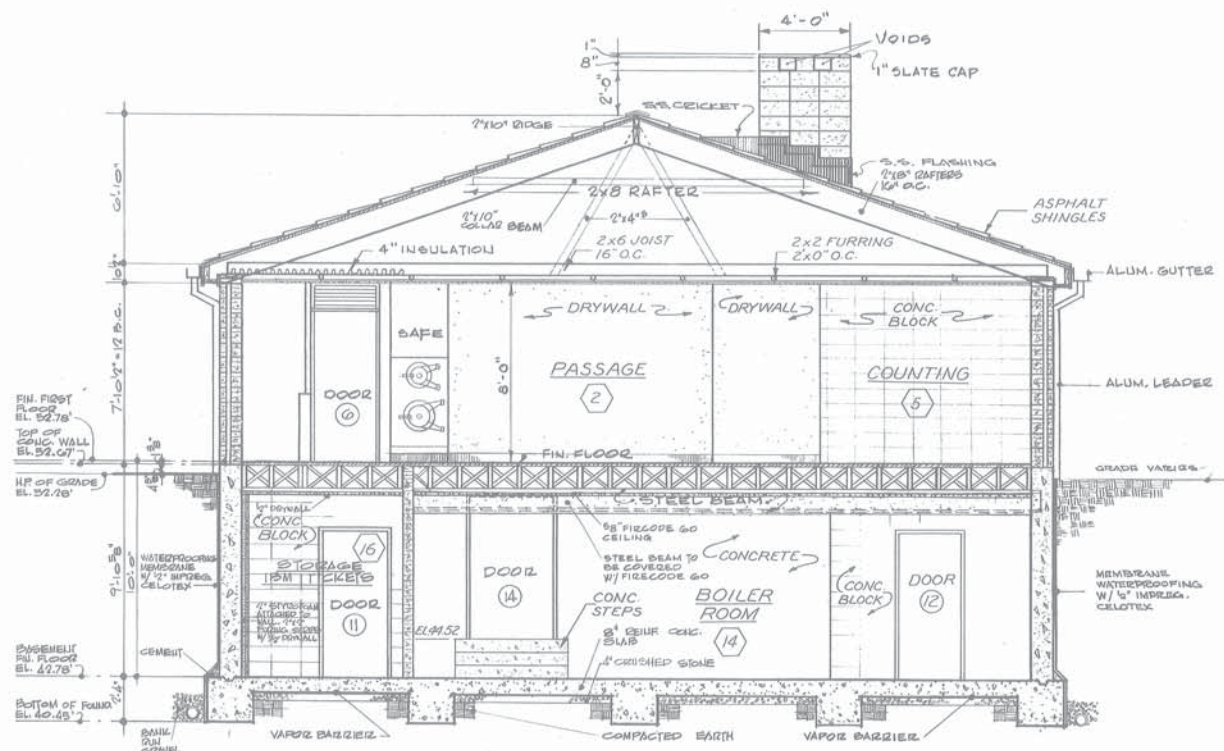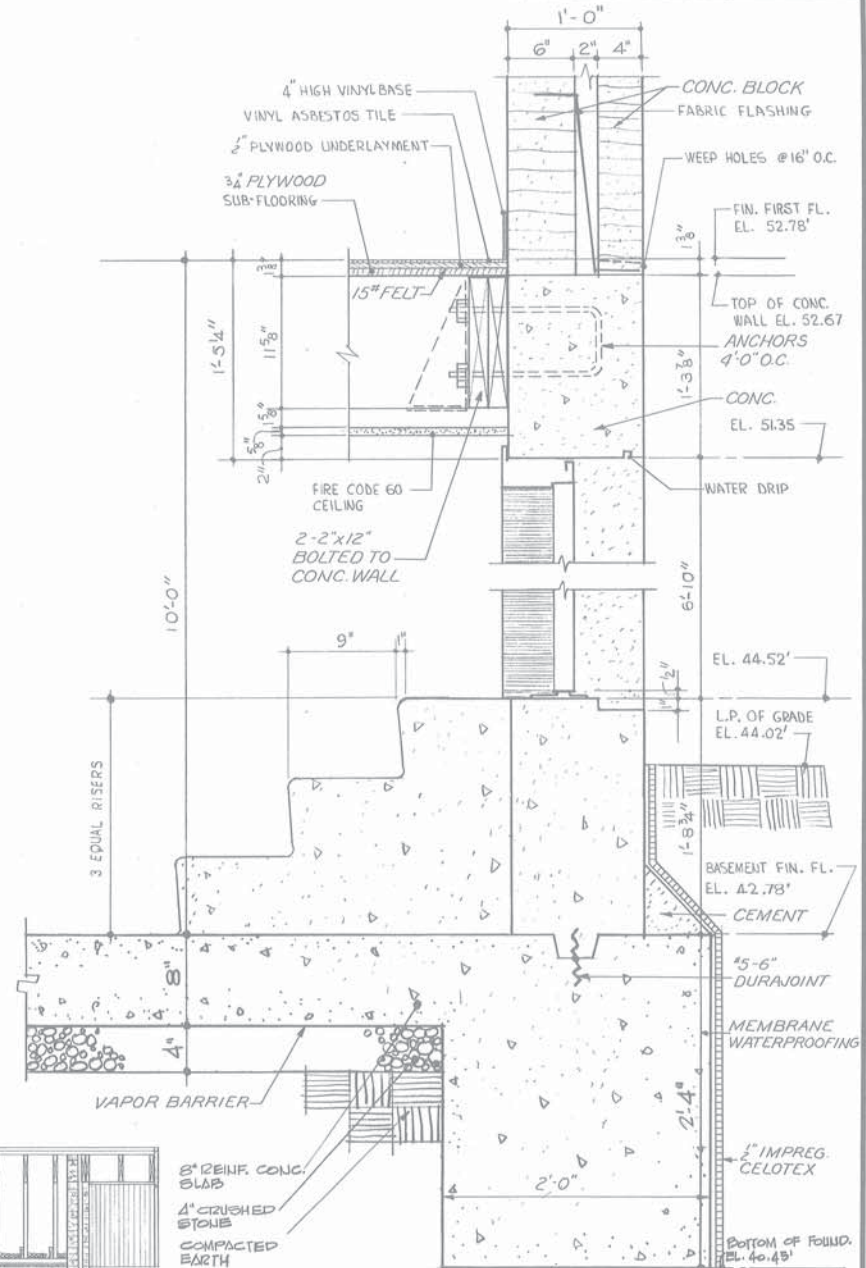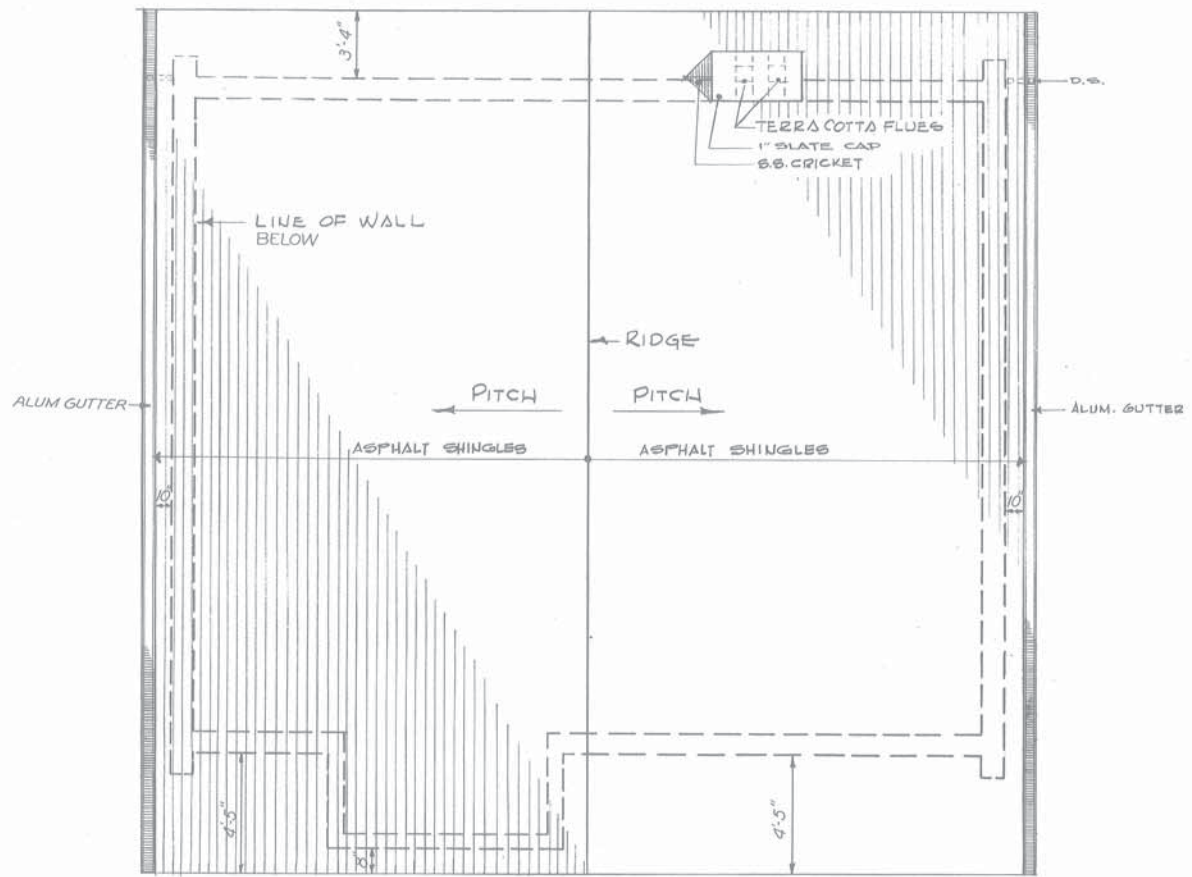

NOTE:
SEE STRUCTURAL DWGS.
FOR LOCATION AND SIZE OF
PILES AND REINFORCEMENT.

MAINE STATE HIGHWAY COMMISSION
AUGUSTA, MAINE


UTILITY BUILDING
ROOF PLAN, SECTIONS
& DETAILS

HOWARD, NEEDLES, TAMMEN & BERGENDOFF
CONSULTING ENGINEERS


NEW YORK BOSTON KANSAS CITY

DWG. A-3


YORK (8)

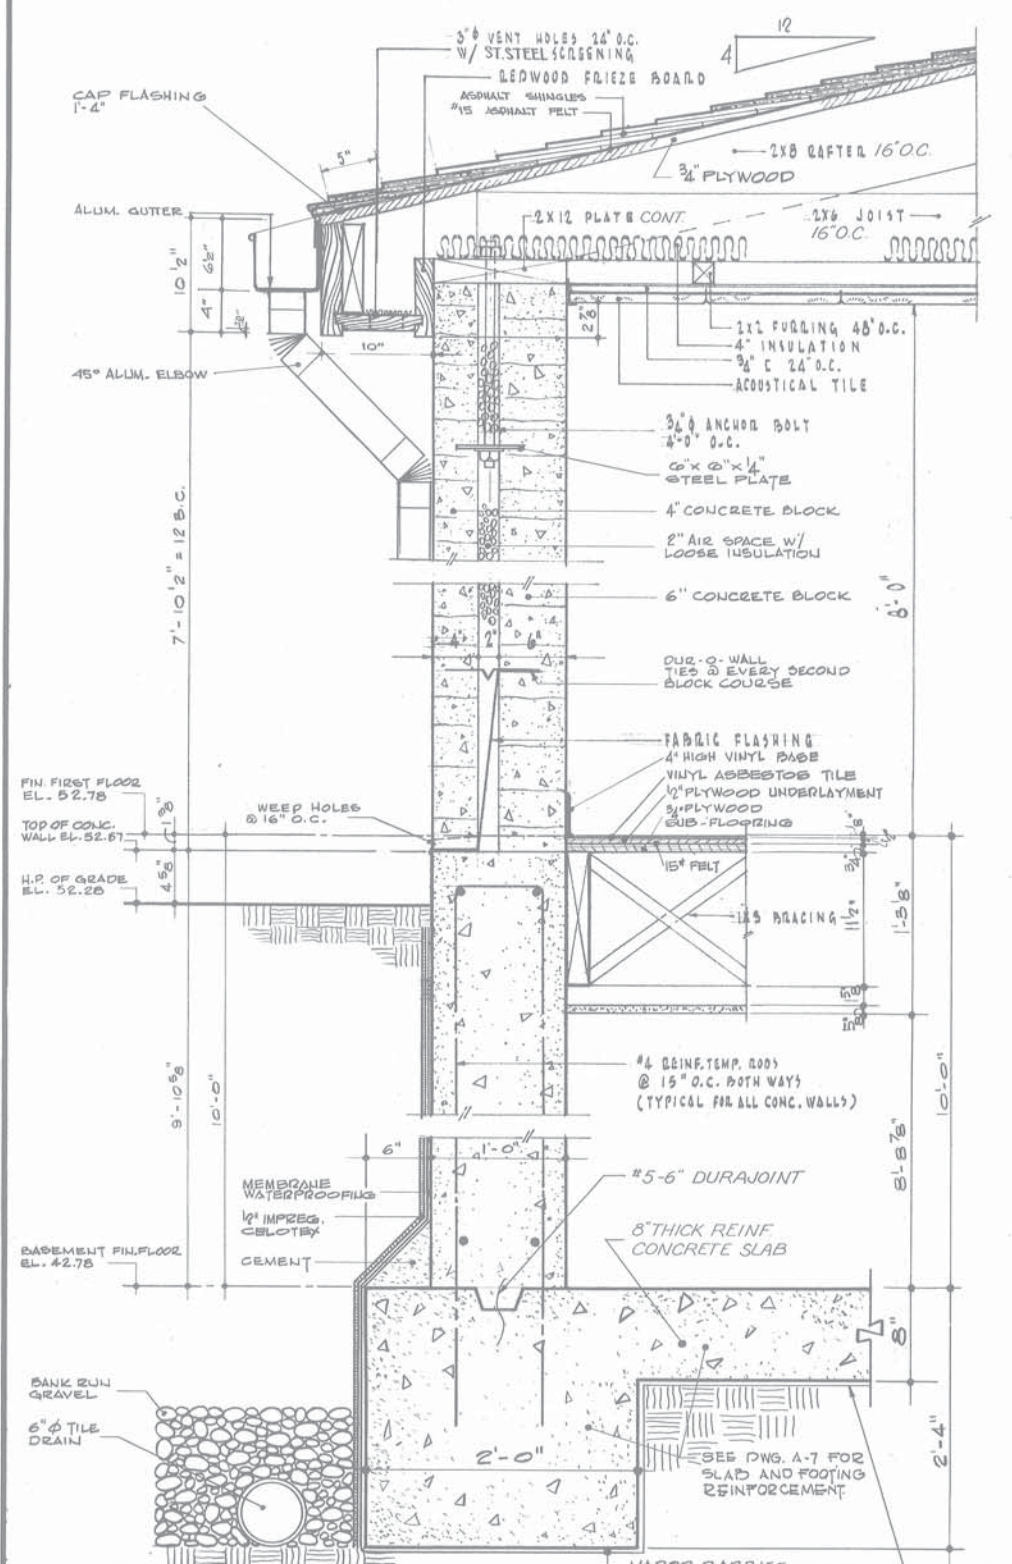

1 TYPICAL CAVITY WALL SECTION
SCALE: 1 1/2" = 1'-0"

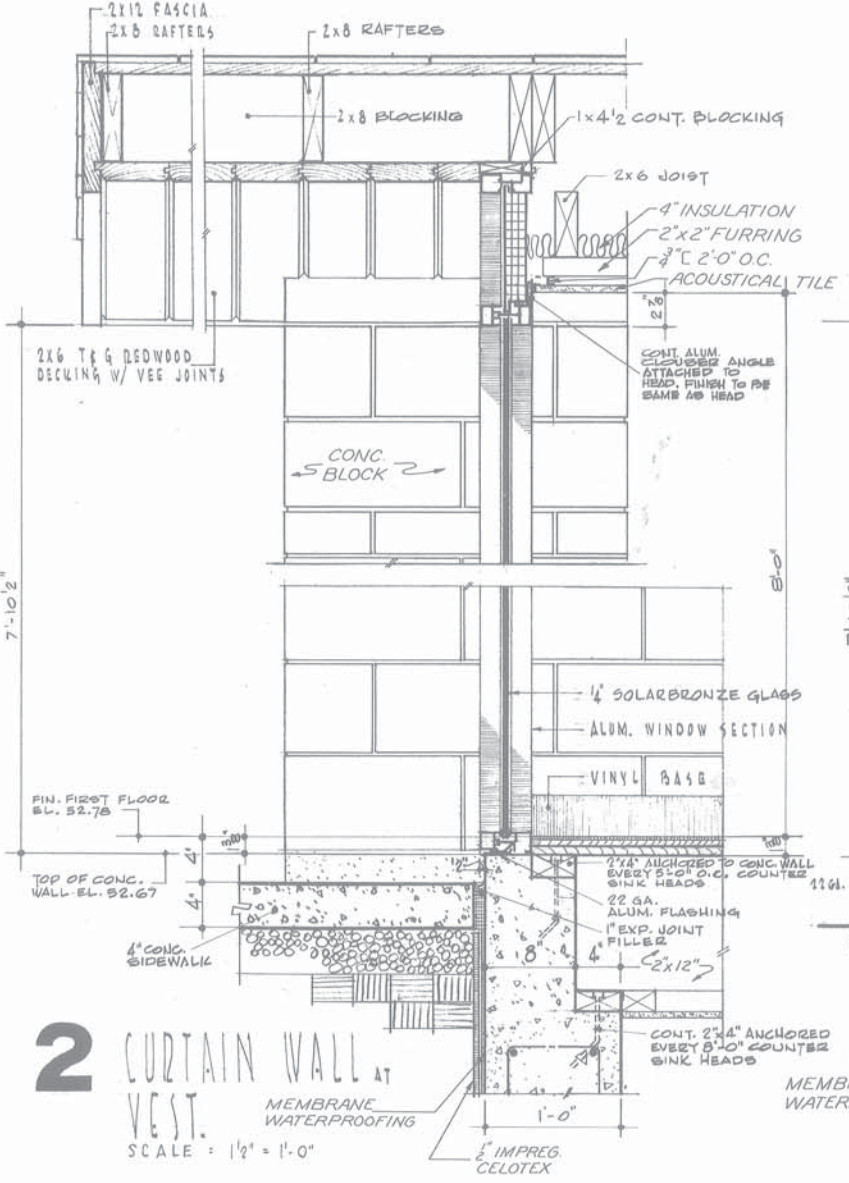

2 CURTAIN WALL AT VEST.
SCALE: 1 1/2" = 1'-0"

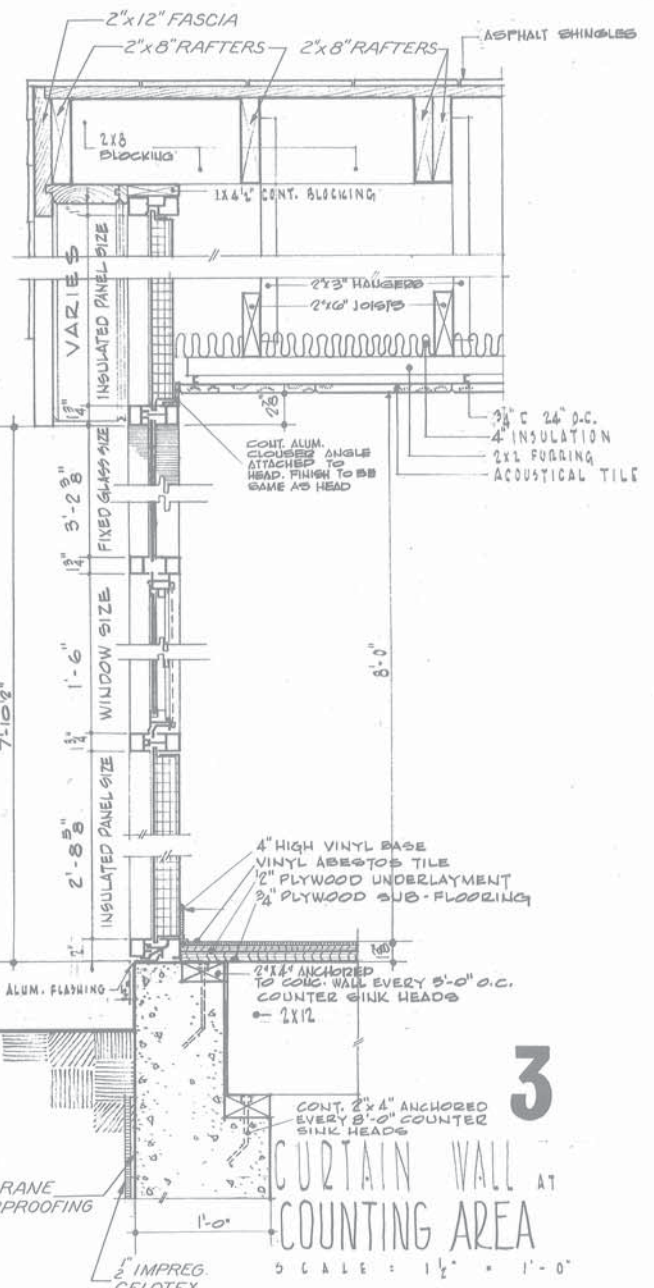

3 CURTAIN WALL AT COUNTING AREA
SCALE: 1 1/2" = 1'-0"





NOTE: Bolted connection for wood trusses to be designed by the Contractor and to be approved by the Engineer.

MAINE STATE HIGHWAY COMMISSION
AUGUSTA, MAINE


UTILITY BUILDING
SECTIONS & DETAILS

HOWARD, NEEDLES, TAMMEN & BERGENDOFF
CONSULTING ENGINEERS

NEW YORK BOSTON KANSAS CITY

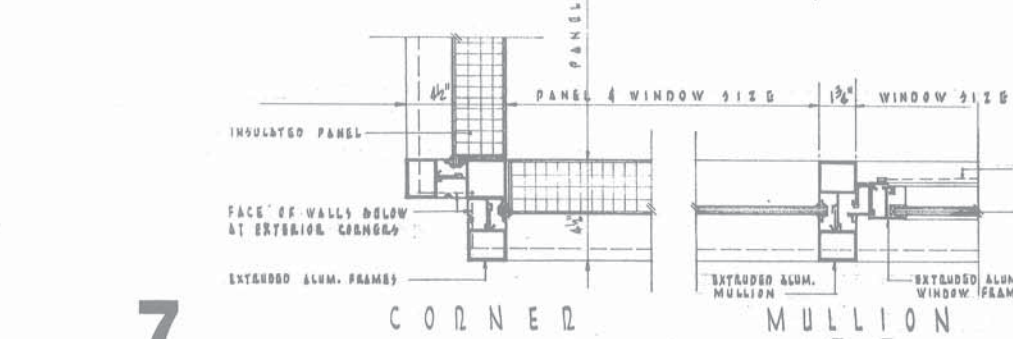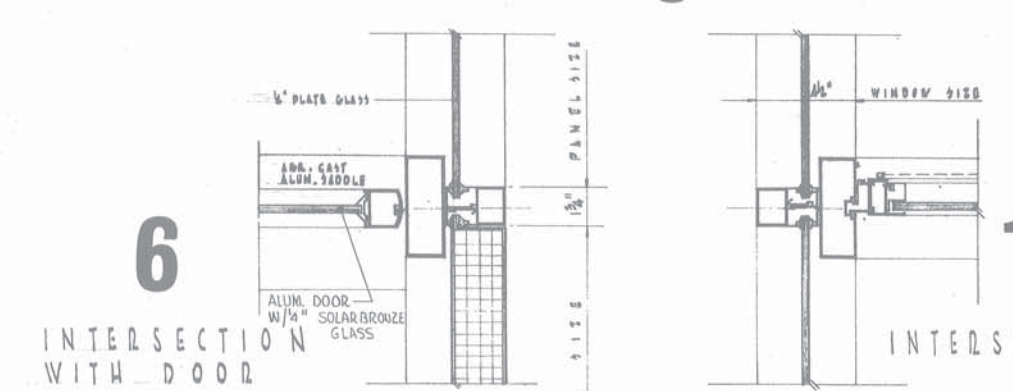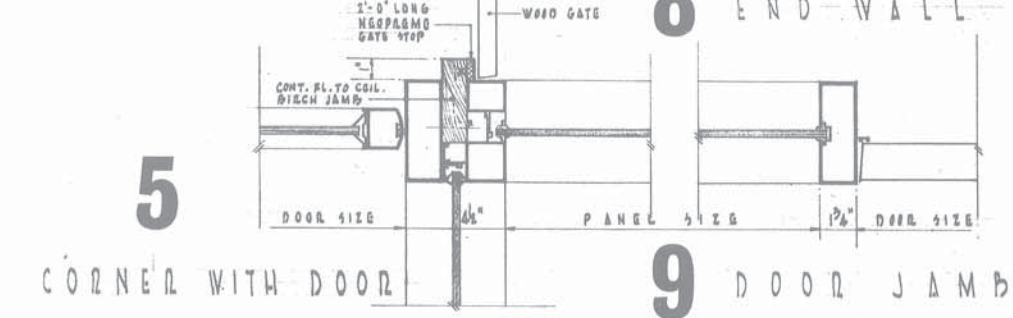
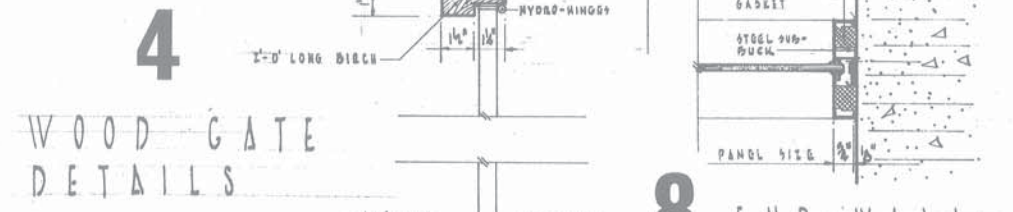


TYPICAL CURTAIN WALL DETAILS
SCALE: 3/4" = 1'-0"

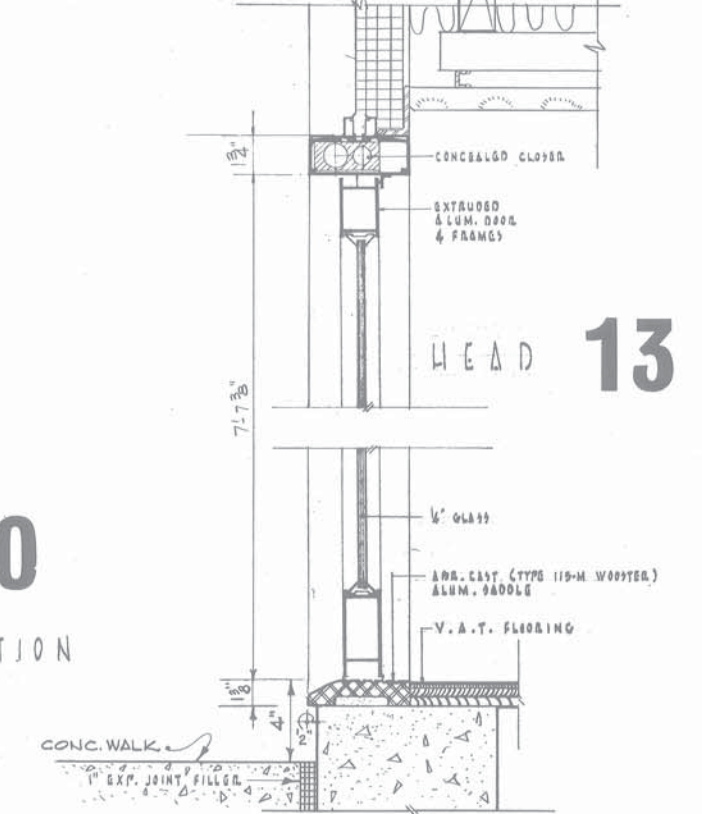

SECTION THRU DOOR

WALL DETAILS

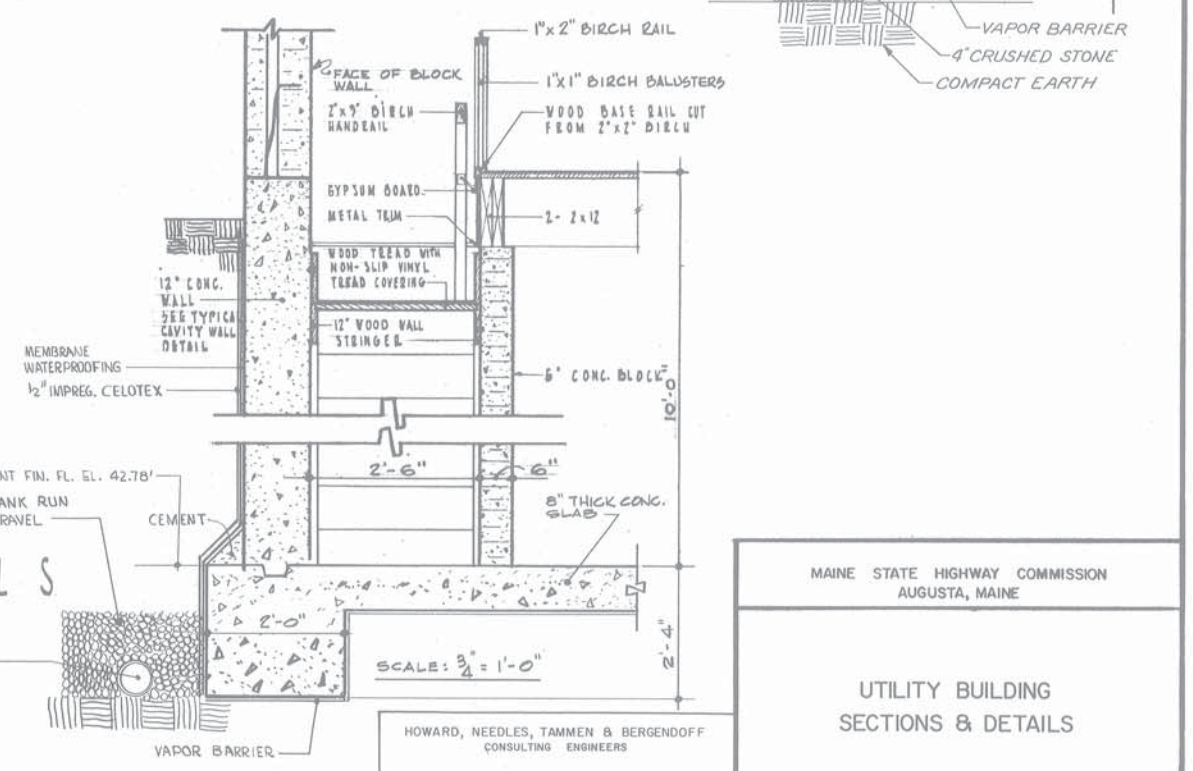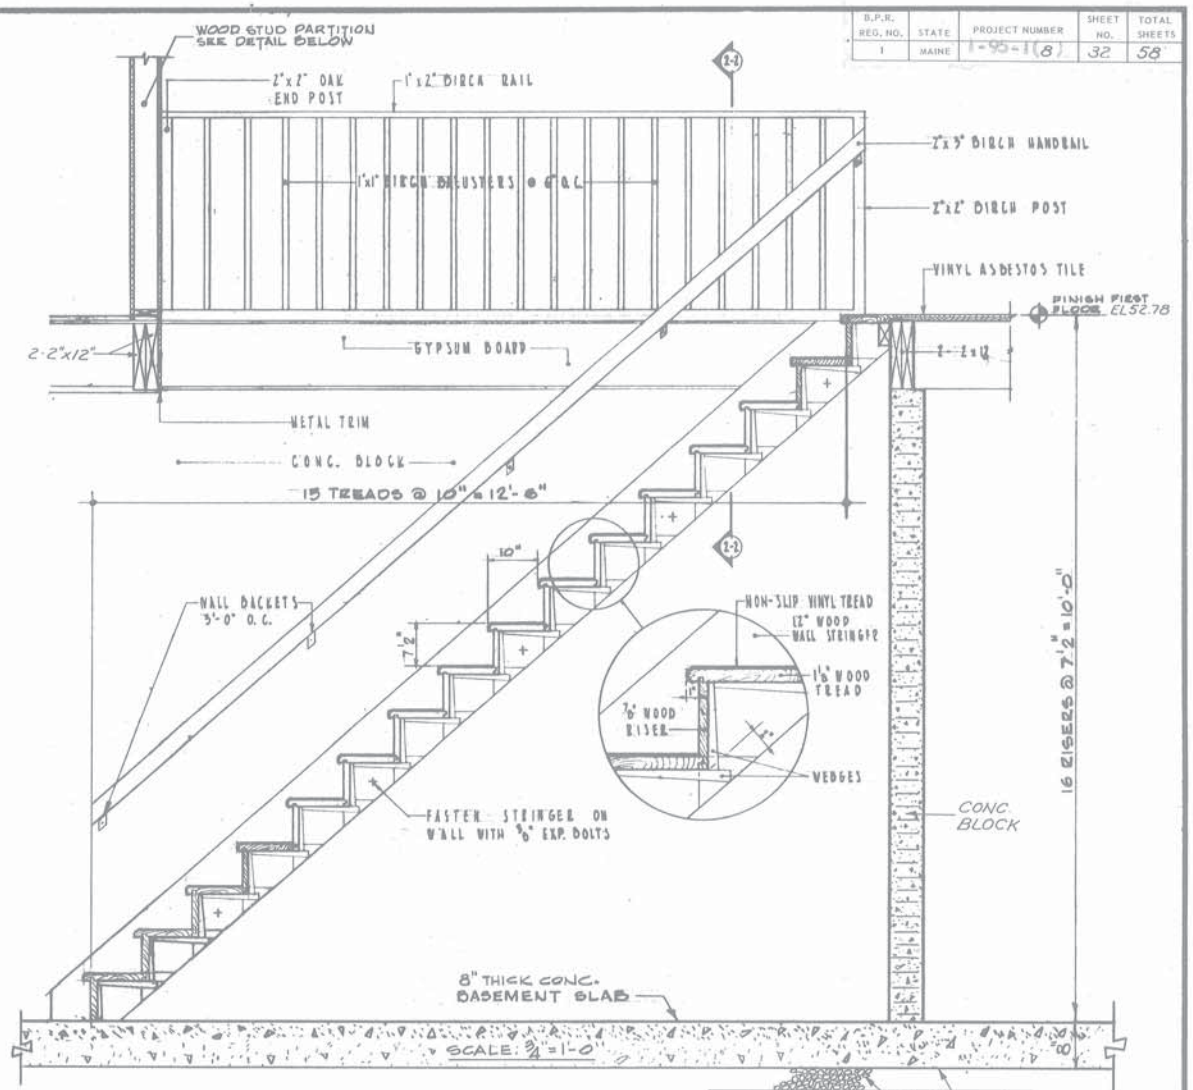







MAINE STATE HIGHWAY COMMISSION
AUGUSTA, MAINE

UTILITY BUILDING
SECTIONS & DETAILS

HOWARD, NEEDLES, TAMMEN & BERGENDOFF
CONSULTING ENGINEERS
NEW YORK BOSTON KANSAS CITY

FINISH SCHEDULE																	
N.O.	NAME	NORTH	WALL	TYPE	SOUTH	WALL	TYPE	EAST	WALL	TYPE	WEST	WALL	FLOOR	CEILING	HEIGHT	REMARKS	
1	VEST	GLASS & METAL	-	-	GLASS & METAL	-	-	GLASS & METAL	-	-	VITROGLAZE ON CONC. BL.	-	1	VINYL ASBESTOS	ACOUSTICAL TILE	8'-0"	
2	PASSAGE	DRYWALL	Y	1	GLASS & METAL	-	-	OPEN	-	-	VITROGLAZE ON CONC. BL.	-	1	VINYL ASBESTOS	ACOUSTICAL TILE	8'-0"	
3	PASSAGE	DOOR	-	-	OPEN	-	-	DRYWALL	Y	1	PAINTING	-	-	VINYL ASBESTOS	ACOUSTICAL TILE	8'-0"	
4	SUPERVISOR	GLASS & METAL	-	-	GLASS & METAL	-	-	GLASS & METAL	-	-	GLASS & METAL	-	-	VINYL ASBESTOS	ACOUSTICAL TILE	8'-0"	
5	COUNTING	DRYWALL	Y	1	GLASS & METAL	-	-	VITROGLAZE ON CONC. BL.	-	-	GLASS & METAL	-	1	VINYL ASBESTOS	ACOUSTICAL TILE	8'-0"	
6	VENDING MACHINES AREA	VITROGLAZE ON CONC. BL.	-	-	OPEN	-	-	VITROGLAZE ON CONC. BL.	-	-	DRYWALL	Y	1	VINYL ASBESTOS	ACOUSTICAL TILE	8'-0"	
7	KITCHEN-NETTE	DRYWALL	Y	1	DRYWALL	Y	1	OPEN	-	-	DRYWALL	-	-	VINYL ASBESTOS	DRYWALL		DRYWALL TO BE FIRE CODE 60
8	CLOSET	DOORS	Y	1	DRYWALL	Y	1	DRYWALL	Y	1	DRYWALL	Y	1	VINYL ASBESTOS	DRYWALL	8'-0"	
9	TOILET	CER. TILE ON DRYWALL	-	2	CER. TILE ON DRYWALL	-	2	CER. TILE ON DRYWALL	-	2	CER. TILE ON DRYWALL	-	2	CER. TILE	DRYWALL	8'-0"	WATER PROOF SHEETROCK
10	CLOSET	DRYWALL	Y	1	DRYWALL	Y	1	DRYWALL	Y	1	DOOR	-	-	VINYL ASBESTOS	DRYWALL	8'-0"	
11	JAN. CLOSET	DRYWALL	Y	2	DRYWALL	Y	2	DRYWALL	Y	2	DRYWALL	Y	2	CER. TILE	DRYWALL	8'-0"	2 1/2" x 10" WIDE PINE SHELVES PAINTED WATER PROOF SHEETROCK & CER. TILE 4'-0" HIGH
12	STORAGE	CONC. BLOCK	Y	1	DRYWALL	Y	1	DRYWALL	Y	1	CONC. BLOCK	Y	1	VINYL ASBESTOS	DRYWALL	8'-0"	
13	COAT RM.	CONC. BLOCK	Y	1	DRYWALL	Y	1	DRYWALL	Y	1	DRYWALL	Y	1	VINYL ASBESTOS	DRYWALL	8'-0"	
14	BOILER ROOM	CONCRETE	Y	3	CONCRETE & BLOCK	Y	3	CONCRETE & BLOCK	Y	3	CONC. BLOCK	Y	3	CONC. #	DRYWALL	8'-0"	* TROWEL FIN. SLAB, PAINTED SEE NOTE ON THIS SHEET + FIRE CODE 60
15	AUXILIARY GENERATOR	CONCRETE	Y	3	CONC. BLOCK	Y	3	CONCRETE	Y	3	CONC. BLOCK	Y	3	CONC. #	DRYWALL	8'-0"	* TROWEL FIN. SLAB, PAINTED SEE NOTE ON THIS SHEET + FIRE CODE 60
16	STORAGE RM TICKETS	CONC. BLOCK	Y	3	DRYWALL	Y	1	CONC. BLOCK	Y	3	DRYWALL	Y	1	CONC. #	DRYWALL	8'-0"	* TROWEL FIN. SLAB, PAINTED SEE NOTE ON THIS SHEET + FIRE CODE 60

DOOR SCHEDULE													
N.O.	HARDWARE (SEE SPECS)	FRAME TYPE	HEAD	JAMB	SADDLE	LINTEL	DOOR MATERIAL	NOMINAL DOOR SIZE	FRAME MATERIAL	DOOR TYPE	LOUVER	CLOSER	REMARKS
1	*	*	*	*	*	-	ALUM. FRAME W/ 1/2 SOLAR BRONZE GLASS	3'-0" x 3'-0"	ALUM.	B	-	YES	* FOR DETAILS OF MAIN ENTRANCE SEE DWG A-5 DET. 6 & 10 & 14
2	*	*	*	*	*	-	ALUM. FRAME W/ 1/2 SOLAR BRONZE GLASS	3'-0" x 3'-0"	ALUM.	B	-	YES	* FOR DETAILS OF MAIN ENTRANCE SEE DWG A-5 DET. 5 & 13
3	*	*	*	*	-	-	WOOD	2'-10 1/4"	ALUM.	A	-	YES	* FOR DET. SEE DWG A-5
4		A	I	I	-	-	WOOD	2'-6" x 6'-8"	H.M.	A	LOUVER @ FRAME A	-	
5		A	I	I	S-1	-	WOOD	2'-8" x 6'-8"	H.M.	A	LOUVER @ FRAME A	-	
6		A	I	I	-	-	WOOD	2'-8" x 6'-8"	H.M.	A	LOUVER @ FRAME A	-	
7		A	I	I	S-1	-	WOOD	2'-8" x 6'-8"	H.M.	A	LOUVER @ FRAME A	-	
8		C	1A	I	-	-	H.M.	4'-1'-6" x 6'-8" x 1 3/4"	H.M.	C	IN DOOR	-	
9		A	I	I	-	-	WOOD	2'-8" x 6'-8"	H.M.	A	LOUVER @ FRAME A	-	
10		B	2	2	-	5 1/2" x 1 3/8"	H.M.	2'-8" x 7'-8 1/2"	H.M.	A	-	YES	1 1/2 HR. F.P.S.C.
11		B	2	2	-	5 1/2" x 1 3/8"	H.M.	2'-8" x 7'-8 1/2"	H.M.	A	-	-	
12		B	2	2	-	5 1/2" x 1 3/8"	H.M.	2'-8" x 7'-8 1/2"	H.M.	A	-	-	
13		*	-	*	-	-	WOOD	2'-9 1/2" x 2'-6"	WOOD	D	-	-	* SPRING HINGES * FOR DETAILS SEE DWG A-5 DET. 4 & 5
14		B	3	*	+	-	H.M.	6'-5" x 3'-5"	H.M.	A	-	YES	* FOR JAMB DET. SEE HEAD DET. # 3 + ZERO #74 ALUM. SADDLES

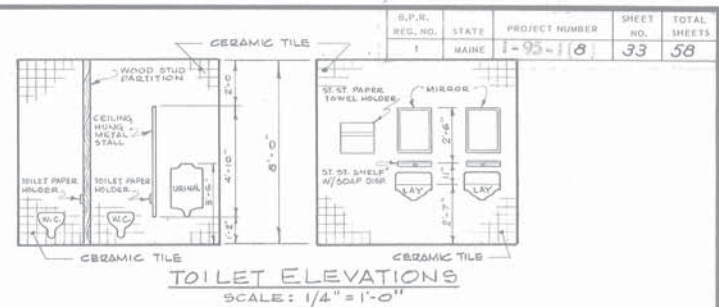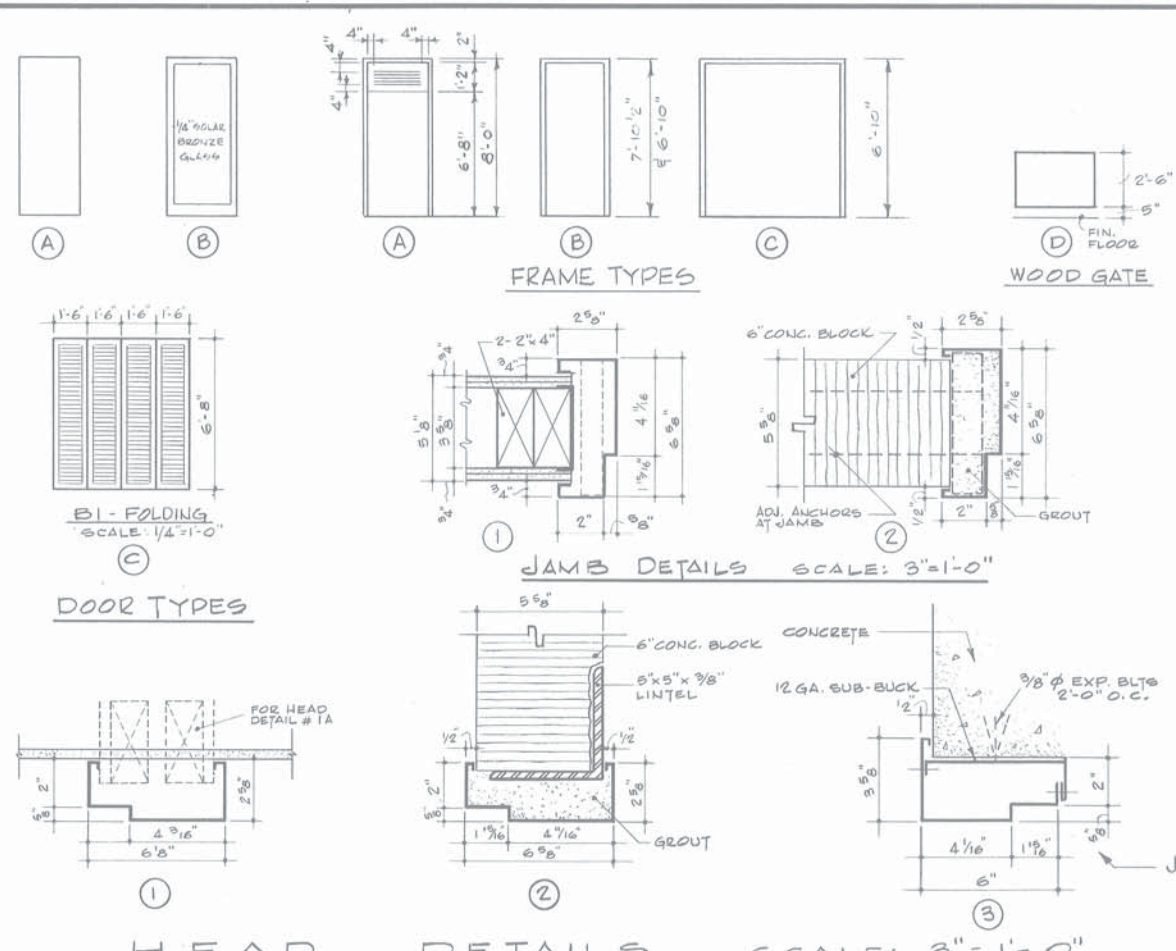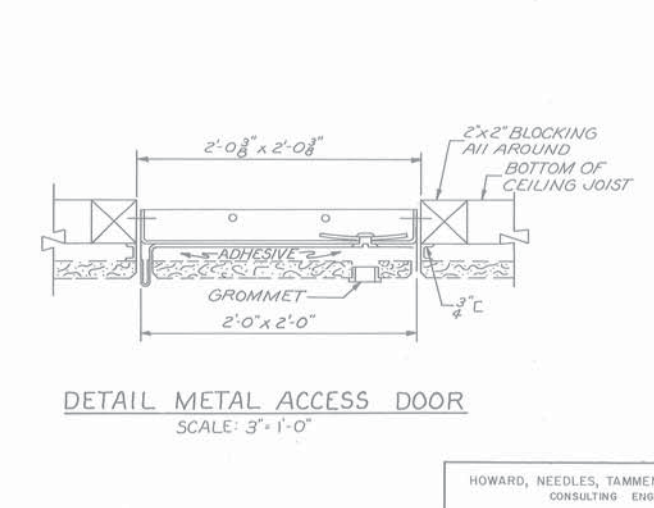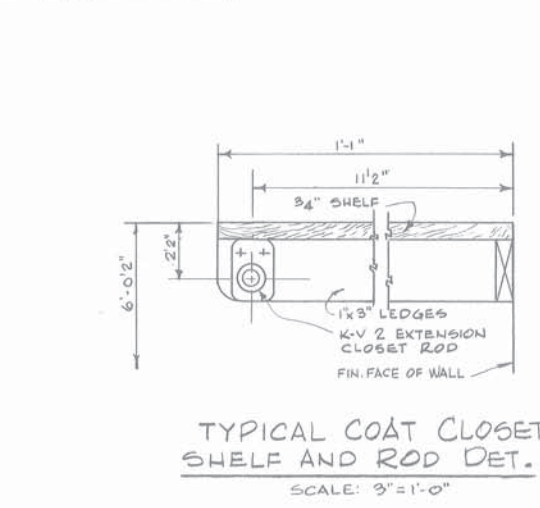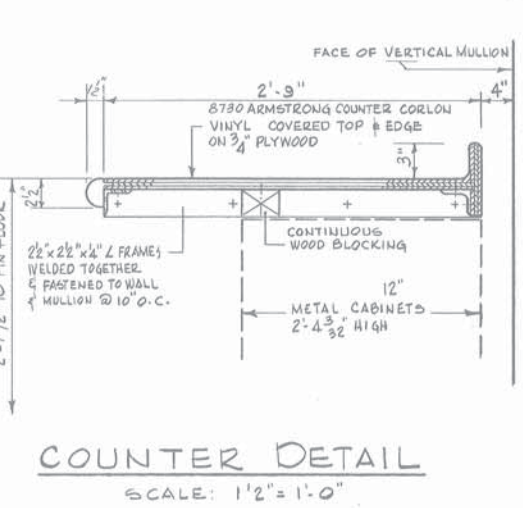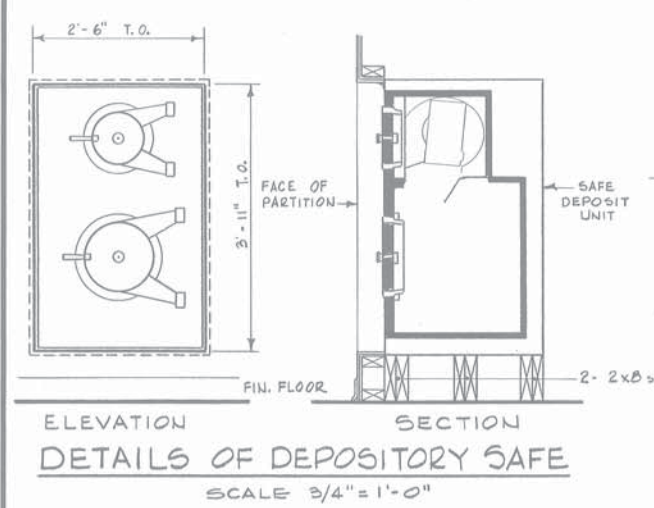








MAINE STATE HIGHWAY COMMISSION
 AUGUSTA, MAINE

UTILITY BUILDING
 FINISH SCHEDULE DOOR SCHEDULE
 & DETAILS

HOWARD, NEEDLES, TAMMEN & BERGENDOFF
 CONSULTING ENGINEERS

NEW YORK BOSTON KANSAS CITY

DWG. A-6

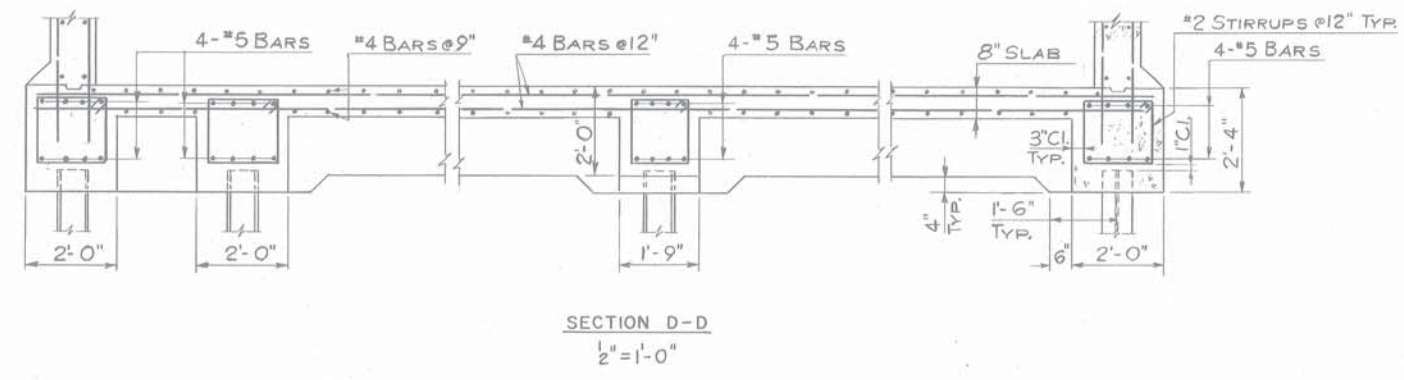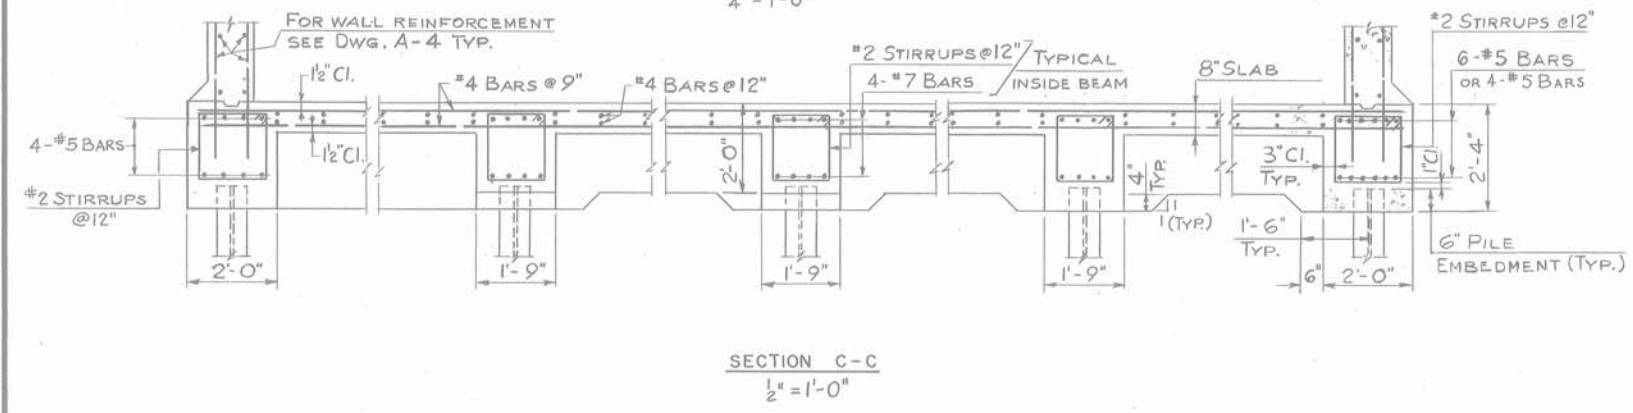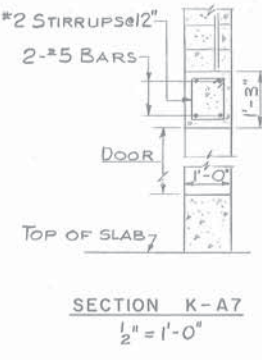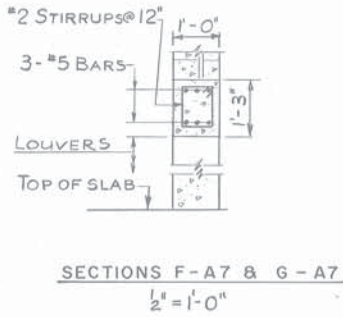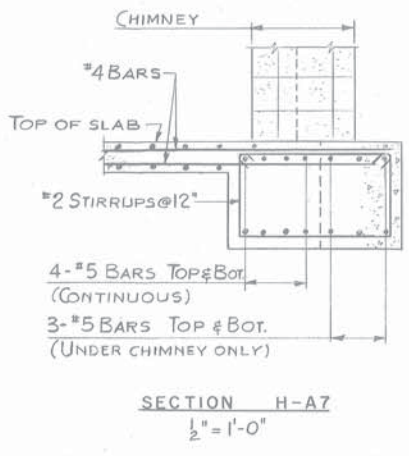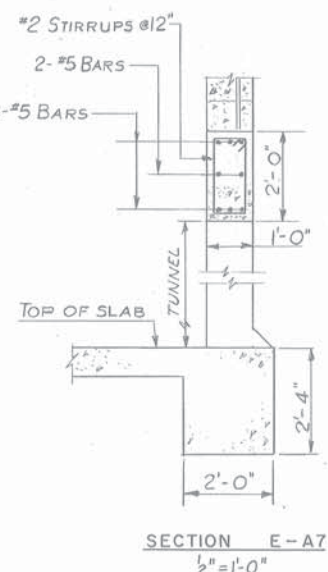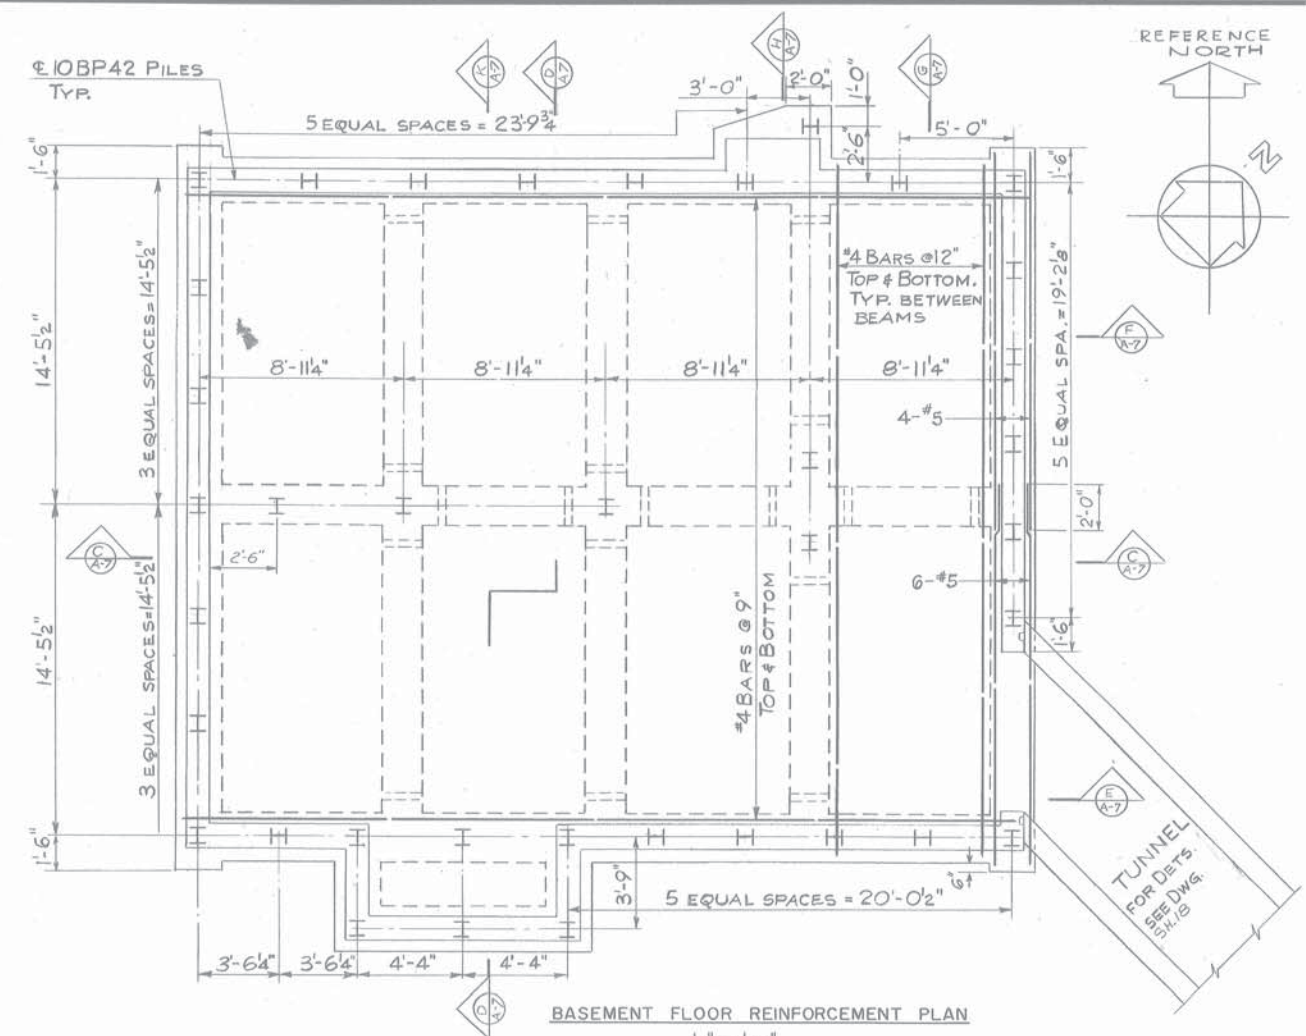

MAINE STATE HIGHWAY COMMISSION
AUGUSTA, MAINE


UTILITY BUILDING
PILE LOCATION PLAN
AND REINFORCEMENT DETAILS

HOWARD, NEEDLES, TAMMEN & BERGENDOFF
CONSULTING ENGINEERS

NEW YORK BOSTON KANSAS CITY


DWG. A-7

THE CONTRACTOR SHALL INSTALL AN EMERGENCY SHUT-OFF SWITCH AT THE TOP OF STAIRS. ASCO FIGURE #1245, BREAK-GLASS SWITCH, (OIL BURNER SHUT-OFF) AND 2 SPARE GLASSES

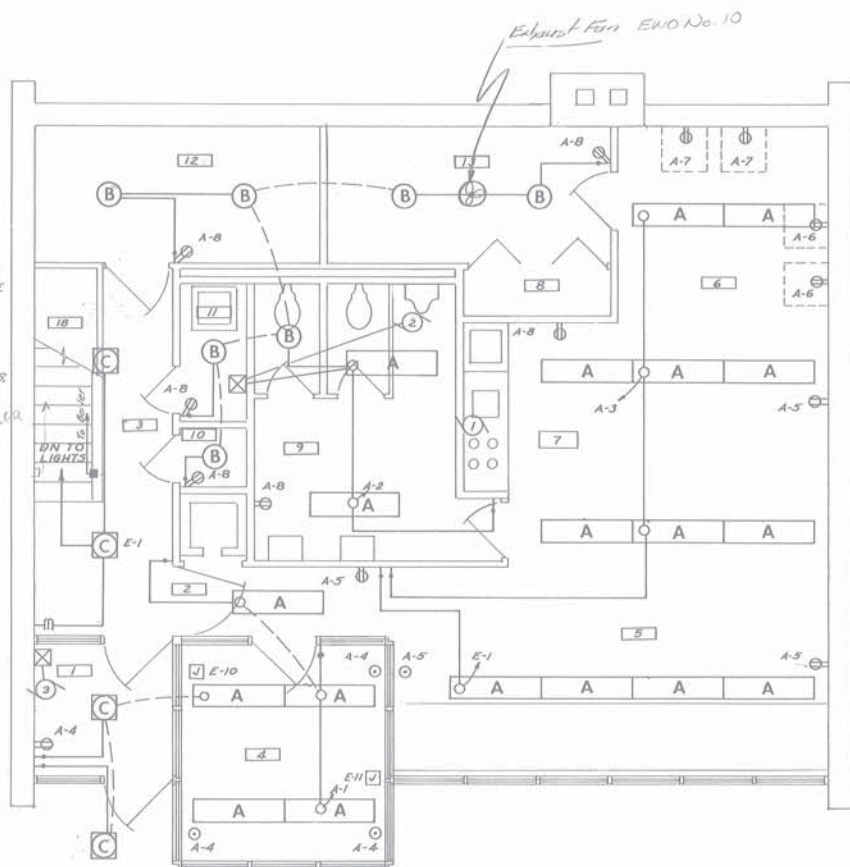

FIRST FLOOR PLAN

SCALE: 1/4" = 1'-0"

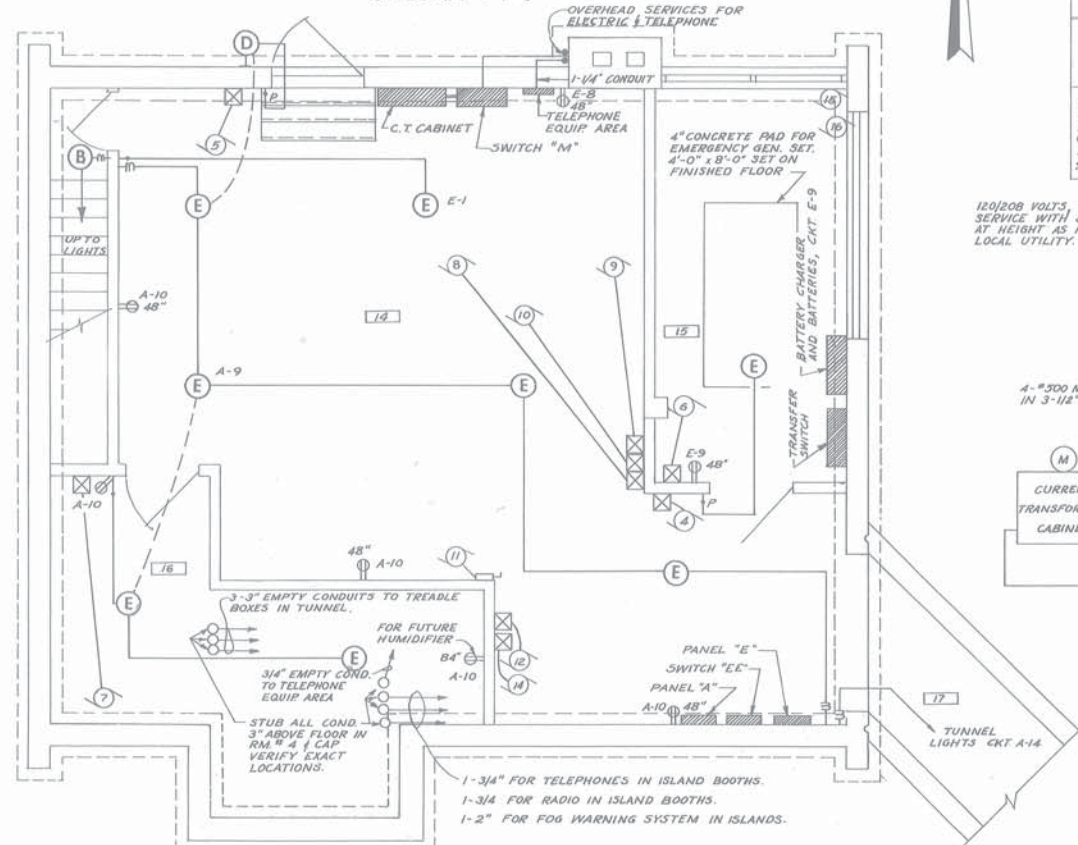

BASEMENT FLOOR PLAN


SCALE: 1/4" = 1'-0"

TYPE	LAMPS		DESCRIPTION	MAKE	CATALOG NO.	SHIELDING	FINISH	REMARKS
	NO.	ORD. ABB.						
A	2	F40 CW	ENCLOSED PLASTIC UNIT	HOLOPHANE	7100-4	ACRYLIC LENS	B.W.E.	SURFACE - CEILING
B	2	60A	10" DRUM UNIT	ART METAL	3379SL	LENS	SATIN	SURFACE - CEILING
C	1	150A	DOWNLIGHT	ART METAL	15-1015 WS	DROP OPAL	WHITE	RECESSED 5"
D	1	150A	WALL BRACKET	ART METAL	3678AH	LENS	ALUMINUM	SURFACE - WALL
E	1	150A	4" PORCELAIN LAMPHOLDER	BRYANT	5228 WG	WIREGUARD	PORCELAIN	OUTLET BOX
F	4	F20TR CW	SURFACE MOUNTED UNIT	ROBERT	4700-4			SEE TOLL BOOTH DRWG.
G	1	F40CW	ENCLOSED PLASTIC UNIT	PARAMOUNT	626H	PLASTIC	B.W.E.	SURFACE IN TUNNEL

MTR. NO.	LOCATION	DESCRIPTION	KW	HP	Ø	VOLTS	CIRC. NO.	BKR OR FUSE POLE	AMP.	STARTER NOMENCLATURE BULLETTIN & FORM NO.	LOCATION	FURN. BY	INTER-LOCKED MOTOR	ACTUATING MOTOR	REMARKS
2	RM. 9	EXHAUST FAN #EF-1		1/12	1	120	A-2			600 TAX 216	RM. 11	T.C.C.			CONNECT TO LIGHT SWITCH / CIRCUIT
3	RM. 1	CAB. UNIT HEATER		1/20	1	120	A-12	1	20	SEE HYG. SPEC.	NEAR UNIT	T.C.C.			
4	RM. 14	UNIT HEATER #UH-1		1/45	1	120	A-12			600 TAX 4					
5	RM. 14	UNIT HEATER #UH-2		1/45	1	120	A-12								
6	RM. 15	UNIT HEATER #UH-3		1/45	1	120	A-12								
7	RM. 16	UNIT HEATER #UH-4		1/45	1	120	A-12								
8	RM. 14	CIRCULATOR #CIR-1		1/4	1	120	E-2	1	20	709 TAD #0-A					
9	RM. 14	CIRCULATOR #CIR-2		3/4	3	208	E-3	3	20						
10	RM. 14	BOILER		1/2	3	208	E-4	3	20						
11	RM. 14	HOT WATER HEATER		5.0			A-13	2	30						DISCONNECT SW.
12	RM. 14	SUMP PUMP		3/4	3	208	E-5	3	20	709 TAD #0-A					FLOAT SWITCH & MECH. ALTERNATOR
13	TOLL BOOTHS	UNIT HEATERS		1/15	1	120	SEE PLAN	1	20	600 TAX 4					
14	RM. 14	SUMP PUMP		3/4	3	208	E-6	3	20	709 TAD #0-A					FLOAT SWITCH & MECH. ALTERNATOR
15	RM. 15	MOTORIZED LOUVER			1	120	E-7	1	20						SEE NOTE #1
16	RM. 16	MOTORIZED LOUVER			1	120	E-7								SEE NOTE #1
17	TUNNEL	UNIT HEATER		1/30	1	120	SEE PLAN	1	20	600 TAX 4	NEAR UNIT	T.C.C.			
18	WELL	WELL PUMP		2	3	208	E-12	3	20	AB712 PWRM 3, 2	BOILER RM.				SUPPLY STARTER WITH OL-RELAY & 120V COIL


NOTE #1: CONNECT CIRCUIT E-7 VIA AUXILIARY CONTACTS IN EMERGENCY SWITCH.

NO.	BKR. OR FUSE NO.	POLE	AMP.	MAIN BUS AMP.	TYPE	MAKE	CATALOG NO.	MOUNTING	LOCATION	REMARKS	NO.	BKR. OR FUSE NO.	POLE	AMP.	MAIN BUS AMP.	TYPE	MAKE	CATALOG NO.	MOUNTING	LOCATION	REMARKS	
																						A
	1	2	30	100	3#4W	SQUARE D	NG0B-4AB	SURFACE	RM. 14		E	5	3	20	200	3#4W	SQUARE D	NG0B-4L	SURFACE	RM. 14		
	1	2	50								EE	1	3	200	200	3#4W	SQUARE D	H324H	SURFACE	RM. 14	PROVIDE FUSES AS REQUIRED	
	9	1	20								M	1	3	400	400	3#4W	SQUARE D	H325H	SURFACE	RM. 14	PROVIDE FUSES AS REQUIRED	

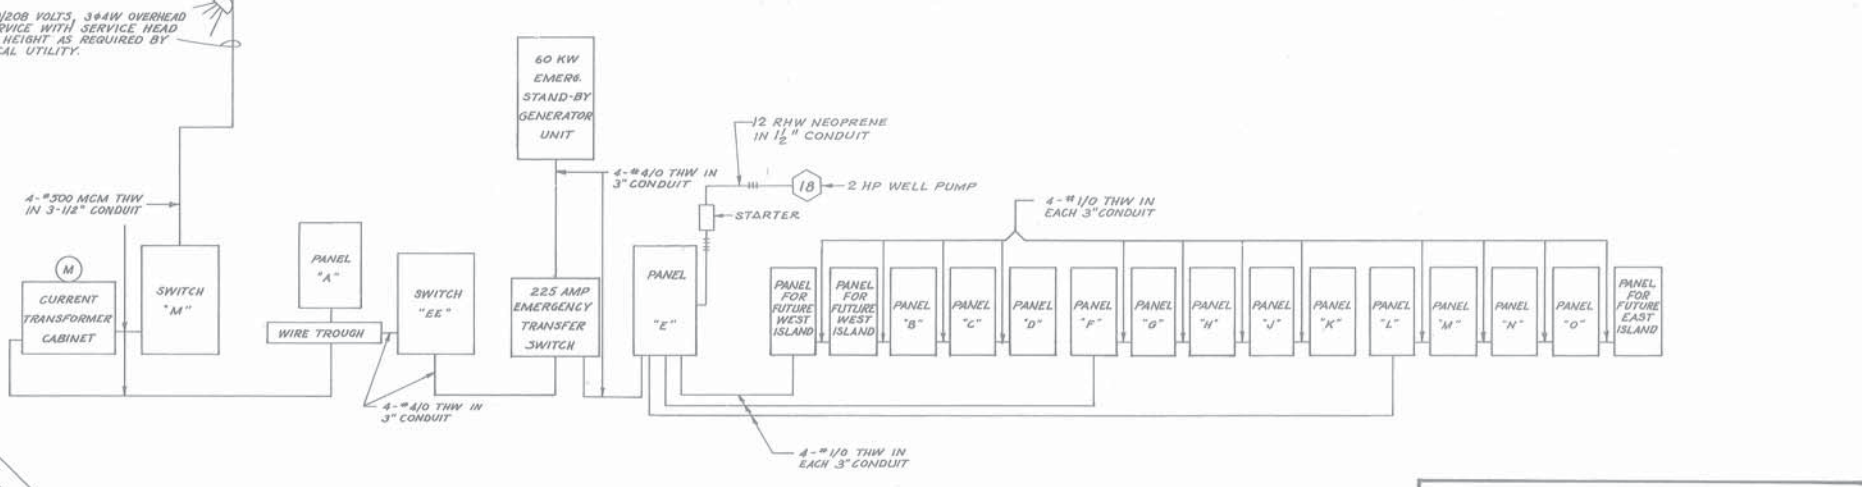

SERVICE RISER

NOT TO SCALE

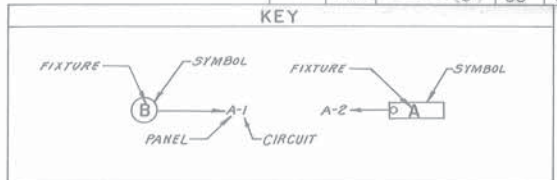



ELECTRICAL SYMBOLS	
[Symbol]	FLOUORESCENT LIGHTING FIXTURE
[Symbol]	RECESSED INCANDESCENT LIGHTING FIXTURE
[Symbol]	INCANDESCENT LIGHTING FIXTURE - SURFACE
[Symbol]	SINGLE POLE SWITCH
[Symbol]	THREE WAY SWITCH
[Symbol]	SWITCH & DUPLEX RECEPTACLE IN SAME OUTLET BOX
[Symbol]	DUPLEX RECEPTACLE
[Symbol]	DUPLEX FLOOR RECEPTACLE (LEW # 6325B-DFB)
[Symbol]	INCANDESCENT WALL MTD. LIGHTING FIXTURE
[Symbol]	SWITCHED CIRCUIT
[Symbol]	BRANCH CIRCUIT
[Symbol]	MOTOR OR SPECIAL OUTLET
[Symbol]	TELEPHONE FLOOR OUTLET
[Symbol]	DISCONNECT SWITCH
[Symbol]	JUNCTION BOX
[Symbol]	DOOR SWITCH
[Symbol]	SWITCH WITH PILOT LIGHT
[Symbol]	MOTOR CONTROLLER
[Symbol]	OIL BURNER EMERGENCY SHUT OFF SWITCH

MAINE STATE HIGHWAY COMMISSION
 AUGUSTA, MAINE

UTILITY BUILDING
 ELECTRICAL DETAILS

HOWARD, NEEDLES, TAMMEN & BERGENDOFF
 CONSULTING ENGINEERS

NEW YORK BOSTON KANSAS CITY

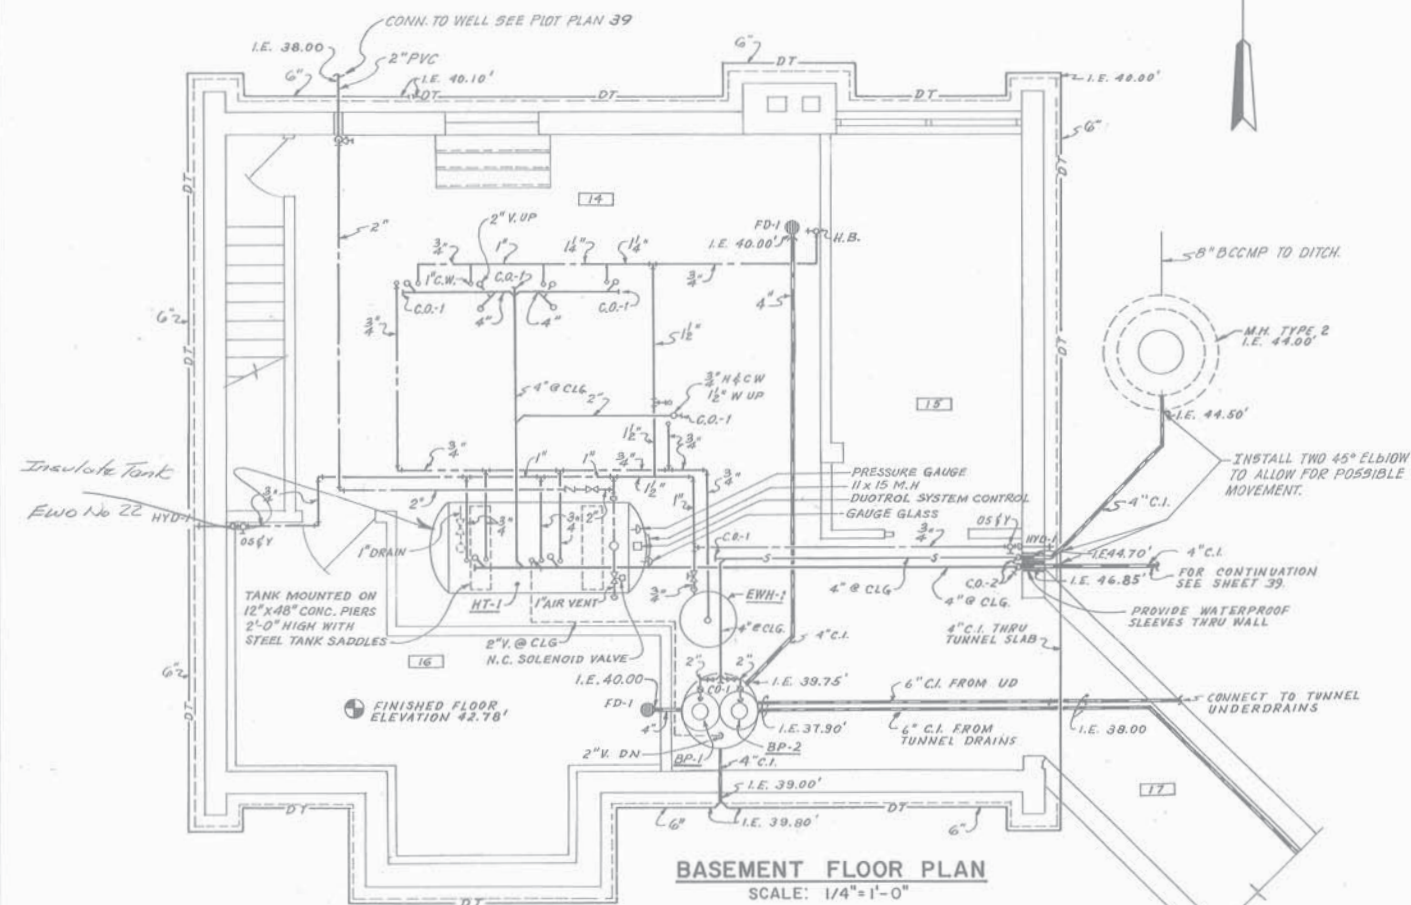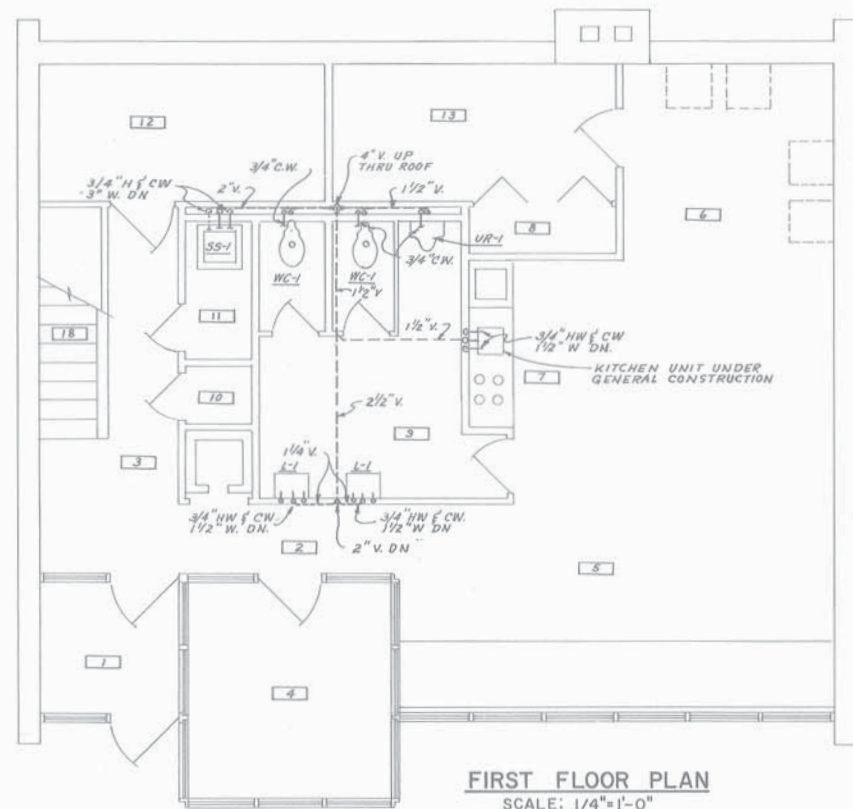

INSIDE SERVICES MATERIAL SCHEDULE

SERVICES	MATERIAL SYMBOL	DESCRIPTION	SPECIFICATION	REMARKS
STORM & SANITARY SEWERS (BELOW FLOOR)	C-11	EXTRA HEAVY SOIL PIPE	CS-188 COATED	LEAD & OAKUM JOINTS
	V.C.P.	VITRIFIED CLAY PIPE	EXTRA STRENGTH ASTM-C-200	ASTM C-425 FACTORY APPLIED JOINTS
	R.C.P.	REINFORCED CONCRETE PIPE	C-76	RUBBER GASKET JOINTS C-443
SOIL, WASTES & VENTS (ABOVE FLOOR)	NONE	EXTRA HEAVY SOIL PIPE	CS-188 COATED	LEAD & OAKUM JOINTS
	NONE	STEEL PIPE	SCHEDULE 40-ASTM A53-GALVANIZED	CONTRACTORS OPTION FOR 3" ONLY
WASTES & VENTS (3" & SMALLER) (ABOVE FLOOR)	NONE	EXTRA HEAVY SOIL PIPE	CS-188 COATED	CONTRACTORS OPTION FOR 3" ONLY
	NONE	STEEL PIPE	SCHEDULE 40-ASTM A53-GALVANIZED	CONTRACTORS OPTION FOR 3" ONLY
CONDUCTORS	NONE	EXTRA HEAVY SOIL PIPE	CS-188 COATED	CONTRACTORS OPTION FOR 3" ONLY
	NONE	STEEL PIPE	SCHEDULE 40-ASTM A53-GALVANIZED	CONTRACTORS OPTION FOR 3" ONLY
WATER PIPING ABOVE GROUND	NONE	EXTRA HEAVY SOIL PIPE	CS-188 COATED	CONTRACTORS OPTION FOR 3" ONLY
	NONE	STEEL PIPE	SCHEDULE 40-ASTM A53-GALVANIZED	CONTRACTORS OPTION FOR 3" ONLY
WATER PIPING UNDERGROUND	NONE	COPPER TUBE	TYPE K-ASTM B-88 HARD	IPS BRASS PIPE, FITTINGS & HIPPLES FOR ALL BESEVED CONNECTIONS
	NONE	VITRIFIED CLAY PIPE & FITTINGS	STANDARD STRENGTH ASTM-C-13	OPEN JOINTS CONCENTRICALLY ALIGNED WITH BROKEN V.T.
DRAIN TILE	NONE	VITRIFIED CLAY PIPE & FITTINGS	STANDARD STRENGTH ASTM-C-13	OPEN JOINTS CONCENTRICALLY ALIGNED WITH BROKEN V.T.
	NONE	DRAIN TILE	ASTM C-4 WITH C-13 FITTINGS	OAKUM & CEMENT JOINTS AT ALL JOINTS, FITTINGS, BRANCHES, ETC.

INSIDE SERVICES MATERIAL SCHEDULE

FITTINGS	MATERIAL SYMBOL	DESCRIPTION	SPECIFICATION	REMARKS
SOIL	NONE	EXTRA HEAVY SOIL	CS-188 COATED	
	NONE	CAST IRON DRAINAGE PATTERN	ASA-B-16.12 COATED	
WASTES	NONE	CAST IRON	ASA-B-16.4 BLACK	
	NONE	CAST IRON DRAINAGE PATTERN	ASA-B-16.12 COATED	
CONDUCTORS	NONE	EXTRA HEAVY SOIL	CS-188 COATED	
	NONE	2" DN. MALLEABLE	ASA-B-16.2 GALVANIZED	
WATER LINES	NONE	3/2" UP CAST IRON	ASA-B-16.1 GALVANIZED	
	NONE	WROUGHT COPPER SOLDED	ASA-B-16.22	FLARE TYPE FOR UNDERGROUND
SCREWED UNIONS & FLANGES	NONE	2" DN. MALLEABLE	WALWORTH #7716 OR #7750	BLACK OR GALVANIZED TO MATCH PIPING
	NONE	2 1/2" UP-CAST IRON	ASA-B-16.1 125# COMP FLANGES	BLACK OR GALVANIZED TO MATCH PIPING
COPPER UNIONS & FLANGES	NONE	2" DN. GROUND JOINT	WISCO-SERIES 783 OR EQUAL	BRASS MACHINE BOLTS
	NONE	2 1/2" UP-COMPANION	WISCO-SERIES 741 OR EQUAL	BRASS MACHINE BOLTS
INSULATING UNIONS	NONE	2" DN.-DIELECTRIC	EPCC-37-C-PIPS OR EQUAL	REQUIRED FOR ALL CONNECTIONS OF COPPER TUBE TO FERROUS PIPING OR EQUIPMENT
	NONE	2 1/2" UP-DIELECTRIC	EPCC-37-C-PIPS OR EQUAL	REQUIRED FOR ALL CONNECTIONS OF COPPER TUBE TO FERROUS PIPING OR EQUIPMENT
HIPPLES	NONE	CLOSE SHOULDER SHORT	SCHEDULE 80	BLACK OR GALVANIZED TO MATCH PIPE
	NONE	LONG	SAME SCHEDULE AS PIPE	BLACK OR GALVANIZED TO MATCH PIPE

OUTSIDE SERVICES MATERIAL SCHEDULE

SERVICES	MATERIAL SYMBOL	DESCRIPTION	SPECIFICATION	REMARKS
STORM & SANITARY	V.C.P.	VITRIFIED CLAY PIPE & FITTINGS	ASTM C-13	ASTM C-425 FACTORY APPLIED JOINTS
	V.C.P.	VITRIFIED CLAY PIPE & FITTINGS	ASTM C-200 EXCEPT FULL INSIDE DIAMETER	ASTM C-425 FACTORY APPLIED JOINTS (WEDGE LOCK)
	C-11	EXTRA HEAVY SOIL PIPE & FITTINGS	CS-188 COATED	OAKUM & LEAD JOINTS
WATER	R.C.P.	REINFORCED CONCRETE PIPE TONGUE & GROOVE	ASTM C76	C-443 NEOPRENE GASKET JOINTS
	C-11	CAST IRON B & S	ASA-A21.6 CLASS 24	LEAD & JUTE JOINTS
FITTINGS	W	FITTINGS B & S	ASA-A21.6 250# W.P.	LEAD & JUTE JOINTS
	P.V.C.	POLYVINYL CHLORIDE PLASTIC PIPE	TYPE I GRADE 2	N.S.E. APPROVED & LABEL
FITTINGS - SOCKET	W	FITTINGS - SOCKET	ASA-A21.6 250# W.P.	LEAD & JUTE JOINTS
	P.V.C.	POLYVINYL CHLORIDE PLASTIC PIPE	TYPE I GRADE 2	N.S.E. APPROVED & LABEL

PLUMBING ABBREVIATIONS

ABBREV.	DESCRIPTION
S.S.	SOIL STACK
S	SOIL
W	WASTE
V	VENT
V.S	VENT STACK
V.T.R	VENT THRU ROOF
T.R.	THRU ROOF
D.I.	DISE-IRON
V.C.P.	VITRIFIED CLAY PIPE
C-11	EXTRA HEAVY SOIL PIPE
D.T.	DRAIN TILE
C.W.	COLD WATER
H.W.	HOT WATER
L	LAVATORY
W.C.	WATER CLOSET
U	URINAL
S.S.	SERVICE SINK
F.D.	FLOOR DRAIN
C.O.	CLEAN OUT
M.H.	MANHOLE
HYD.	HYDRANT
G.A.V.	GATE VALVE
I.E.	INVERT ELEVATION (FLOW LINE)
ELEV.	ELEVATION
CLS.	CEILING
TYP.	TYPICAL
CONN.	CONNECTION

PLUMBING SYMBOLS

SYMBOL	DESCRIPTION
---	UNDERGROUND SANITARY SEWER
---	UNDERGROUND STORM SEWER
---	UNDERGROUND VENT
---	SOIL, WASTE ABOVE GROUND
---	STORM ABOVE GROUND
---	VENT ABOVE GROUND
DT	DRAIN TILE
---	COLD WATER
---	HOT WATER
---	CLEAN OUT IN FLOOR
---	CLEAN OUT IN EISEL
---	GATE VALVE
---	CHECK VALVE
---	WALL HYDRANT
---	HOSE BIBB
FD	FLOOR DRAIN

ELECTRIC HOT WATER HEATER SCHEDULE MARK NO: EWH-

MARK NO.	LOCATION	MFR.	RECOVERY	STORAGE	ELEMENT	CURRENT	LINING	RELIEF VALVE	THERM. SETTING	REMARKS
EWH-1	BOILER RM	RHEEM	20 @ 100°	30	2500 2500	208/1/60	GLASS	ASME	120°F	IMPERIAL ELEMENTS WIRED FOR SIMULTANEOUS OPERATION

BILGE PUMP SCHEDULE MARK NO: BP-

MARK NO.	LOCATION	MFR.	MODEL	TYPE	MOTOR			GPM	HEAD FT. H2O	BASIN			VENT	AUTOMATIC ALTERNATOR	HIGH WATER ALARM	REMARKS	
					H.P.	R.P.M.	CURRENT			NO.	DEPTH	DIA.					TYPE
BP-1	BOILER RM.	CHICAGO PUMP	LGL-2	VERT.	3/4	1750	208/3/60	12	80	18	8'0"	36"	C.I.	C.I.	2"	MECHANICAL	YES
BP-2	BOILER RM.	CHICAGO PUMP	LGL-2	VERT.	3/4	1750	208/3/60	14	80	18							

FLOOR DRAIN SCHEDULE MARK NO: FD-


MARK NO.	MANUFACTURER	MODEL NUMBER	REMARKS
FD-1	JOSAM	SERIES 7724	

CLEANOUT SCHEDULE MARK NO: CO-


MARK NO.	MANUFACTURER	MODEL NUMBER	REMARKS
CO-1	JOSAM	SERIES Y40	
CO-2	JOSAM	SERIES Y150	

HOWARD, NEEDLES, TAMMEN & BERGENDOFF
 CONSULTING ENGINEERS
 NEW YORK BOSTON KANSAS CITY


MAINE STATE HIGHWAY COMMISSION
 AUGUSTA, MAINE
UTILITY BUILDING
PLUMBING DETAILS

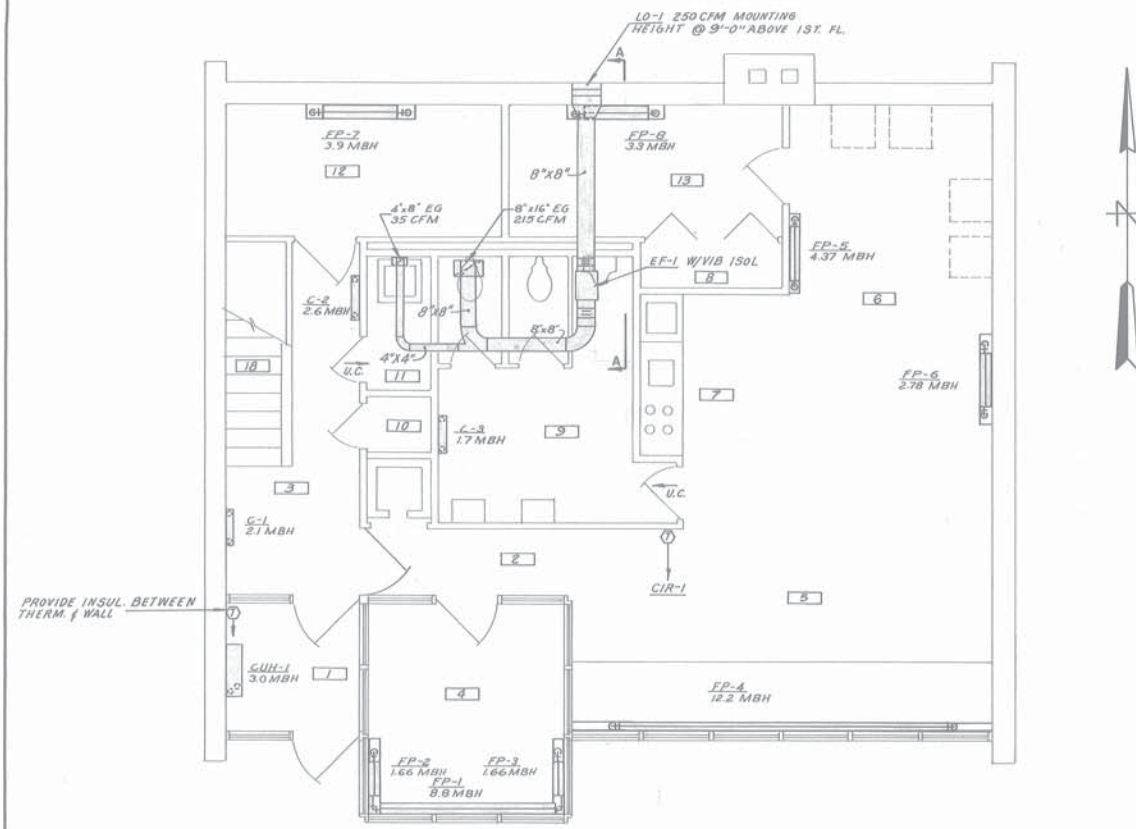



FLOOR PLAN
SCALE: 1/4" = 1'-0"

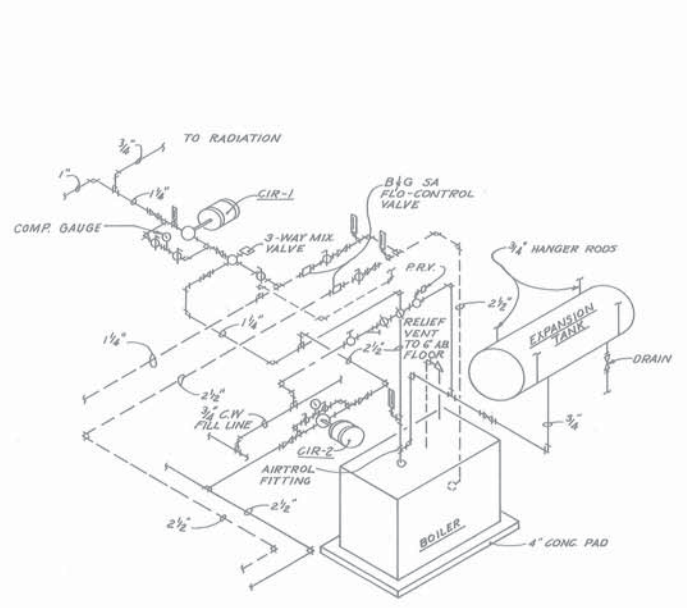


BOILER PIPING ISOMETRIC
NO SCALE

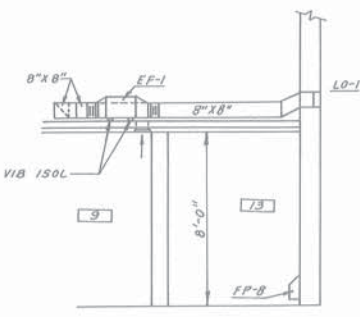

SECTION A-A
SCALE: 1/4" = 1'-0"

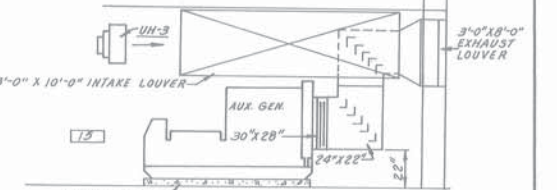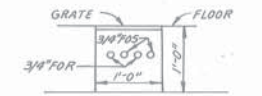


SECTION C-C
SCALE: 3/4" = 1'-0"

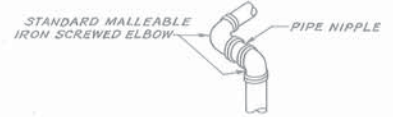


TYPICAL CLOSE COUPLE SWING JOINTS
NO SCALE

SWING JOINTS TO BE USED AT TANK AND OUTSIDE FACE OF BUILDING FOR ALL PRODUCT AND VENT LINES.

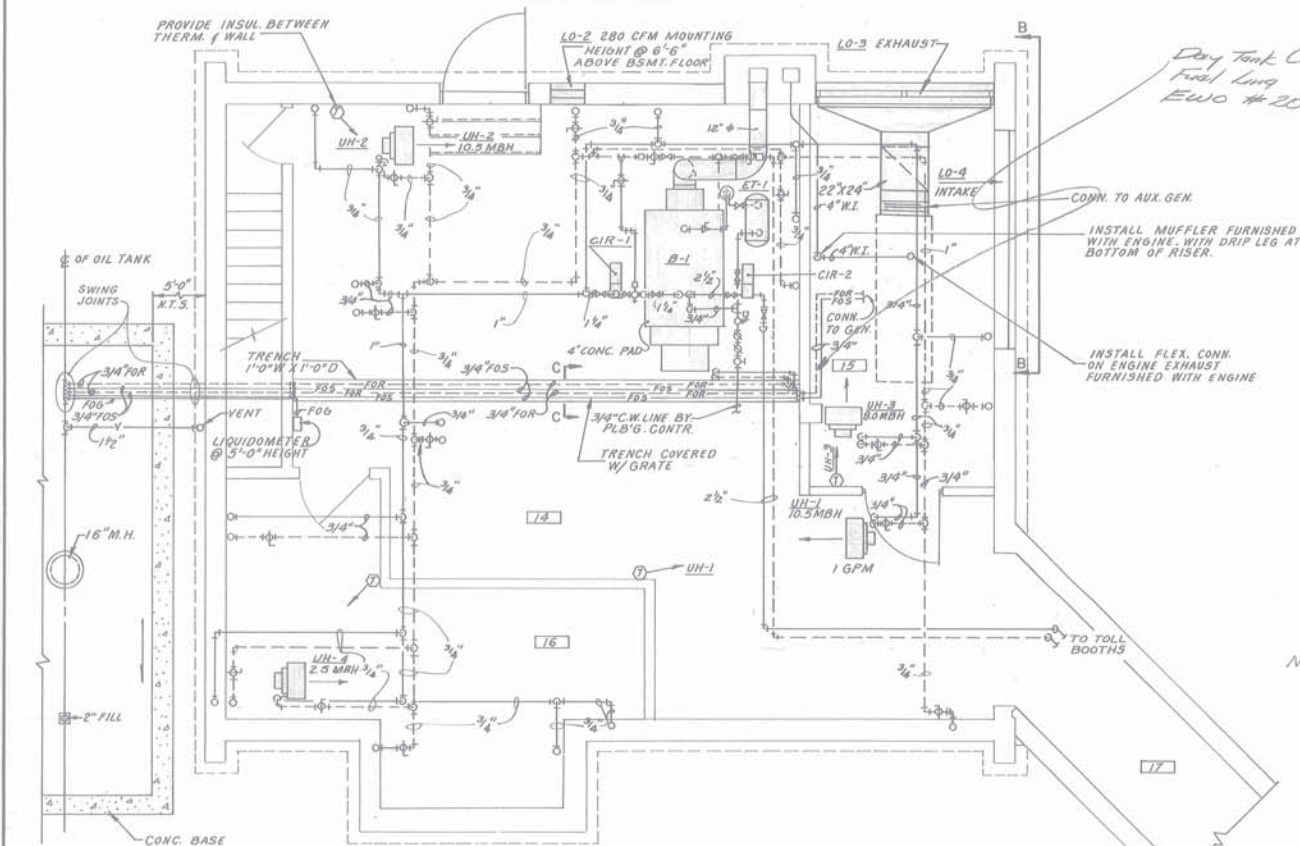

BASEMENT FLOOR PLAN
SCALE: 1/4" = 1'-0"

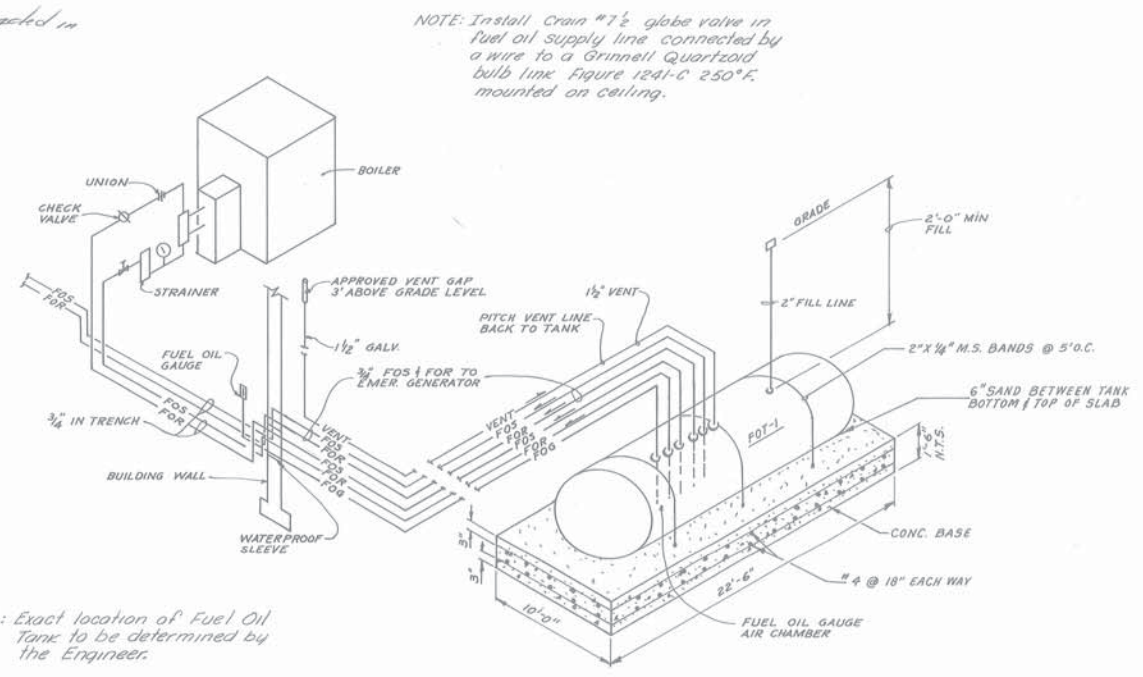

FUEL OIL PIPING SCHEMATIC
NO SCALE


Note: Exact location of Fuel Oil Tank to be determined by the Engineer.

NOTE: Install Crain #7 1/2 globe valve in fuel oil supply line connected by a wire to a Grinnell Quartzoid bulb line Figure 1241-C 250°F. mounted on ceiling.


MAINE STATE HIGHWAY COMMISSION
AUGUSTA, MAINE

UTILITY BUILDING
HEATING & VENTILATING PLAN


HOWARD, NEEDLES, TAMMEN & BERGENDOFF
CONSULTING ENGINEERS
NEW YORK BOSTON KANSAS CITY

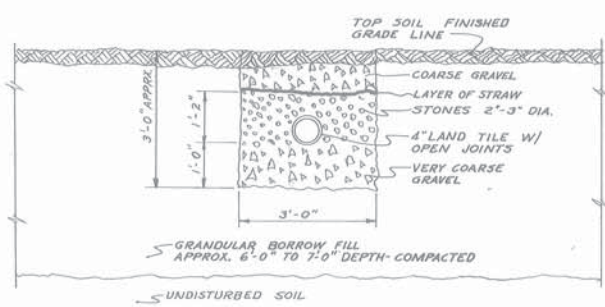


SECTION A-A
NO SCALE

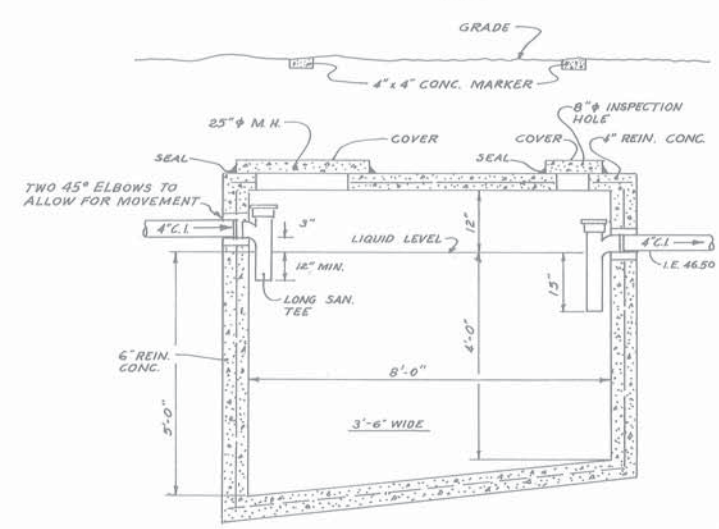

SECTION B-B
NO SCALE

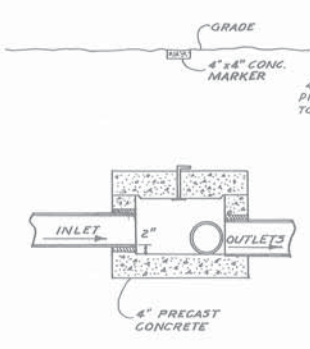

DISTRIBUTION BOX
NO SCALE

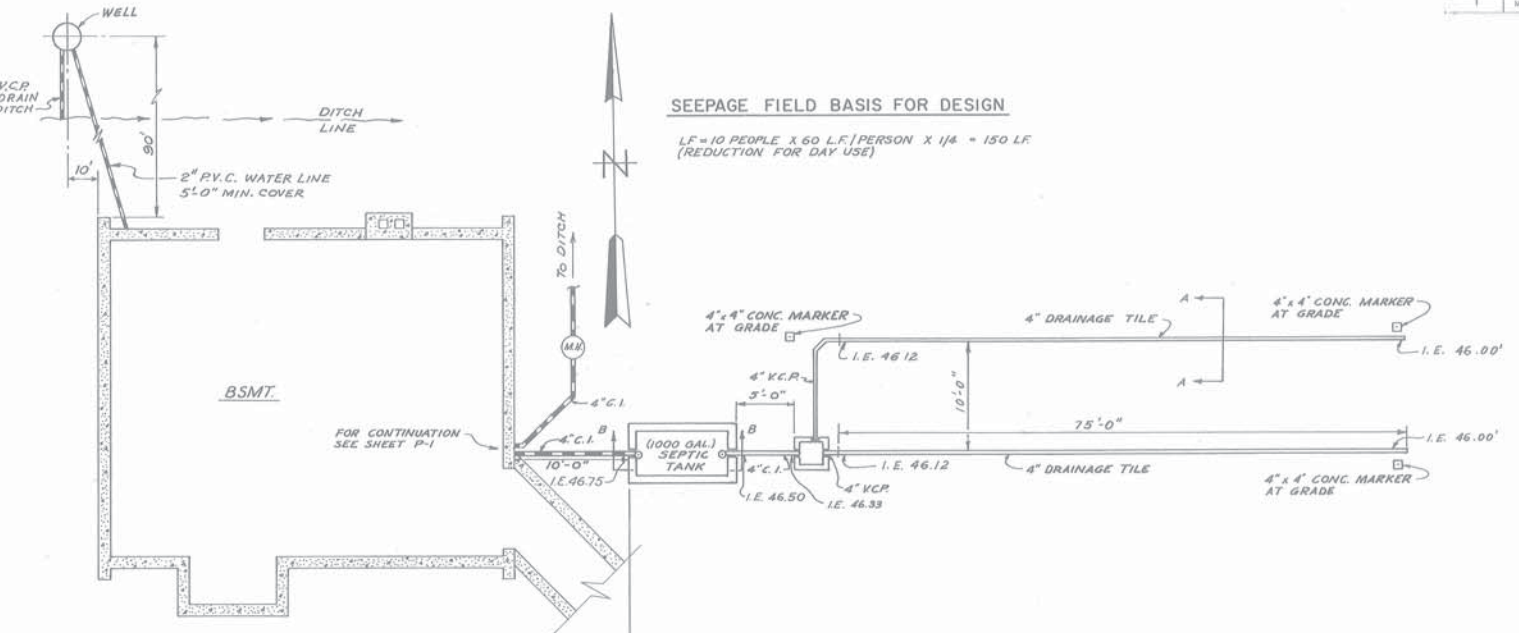


SEEPAGE FIELD BASIS FOR DESIGN

LF = 10 PEOPLE X 60 L.F./PERSON X 1/4 = 150 LF
(REDUCTION FOR DAY USE)

PAY ITEM 916.04 UTIL. BLDG & MECHANICAL WORK
PAY ITEM 316.06 SEPTIC TANK AND FILTER BED

PLUMBING PLOT PLAN
NOT TO SCALE

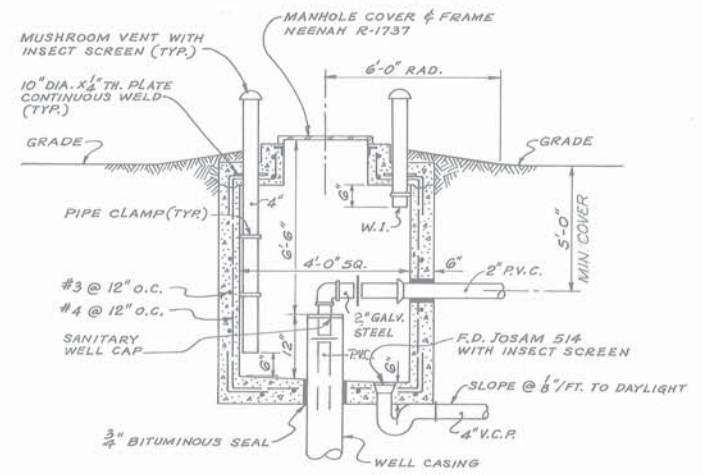


NOTE:
BOTTOM & SIDEWALLS OF WELL PIT TO BE MADE IN ONE CONTINUOUS CONCRETE POUR.

DEEP WELL PUMP PIT
NO SCALE



MAINE STATE HIGHWAY COMMISSION
AUGUSTA, MAINE

PLUMBING & WELL DETAILS

HOWARD, NEEDLES, TAMMEN & BERGENDOFF
CONSULTING ENGINEERS
NEW YORK BOSTON KANSAS CITY

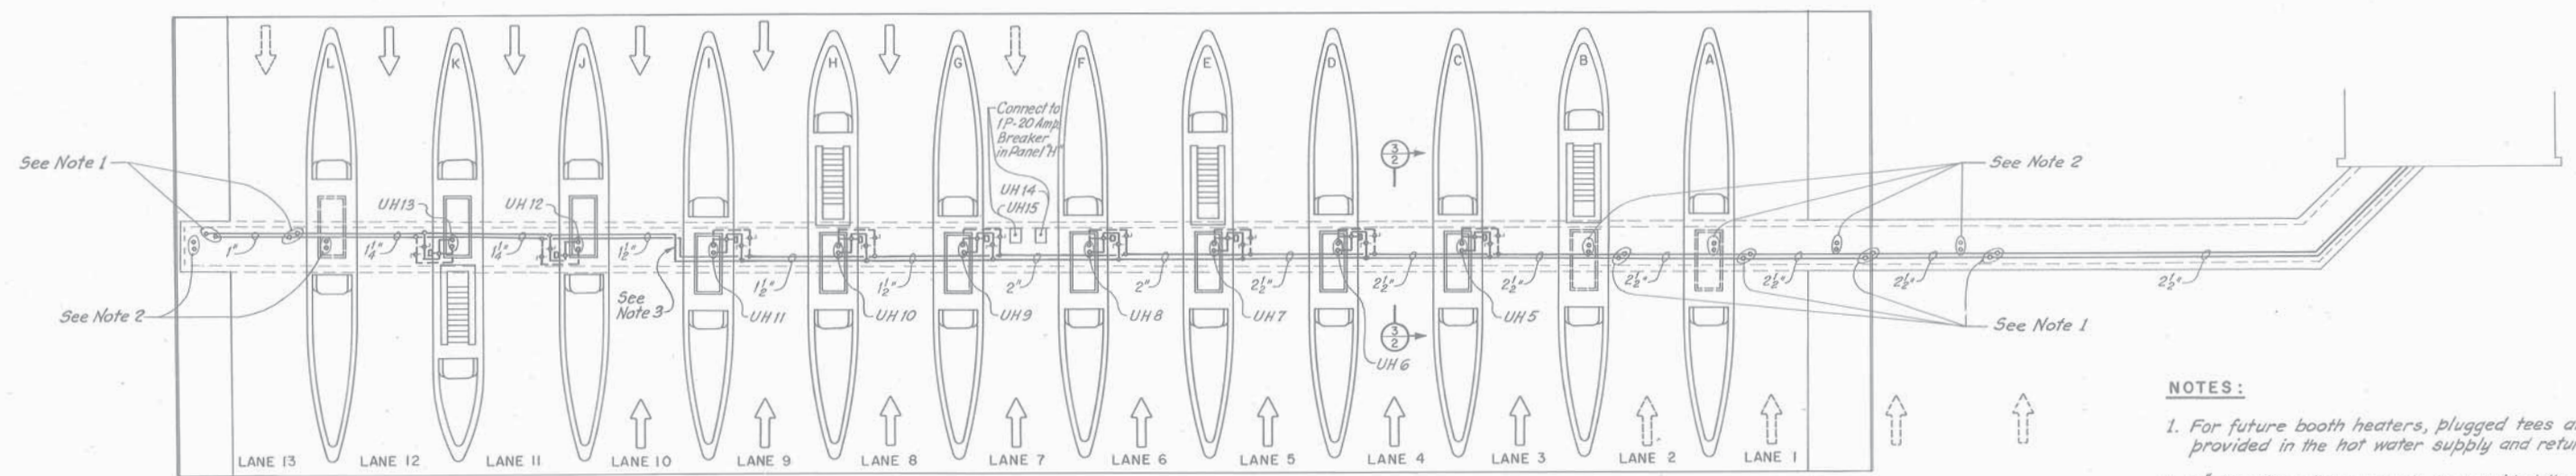

- NOTES:**
1. For future booth heaters, plugged tees are to be provided in the hot water supply and return lines.
 2. 2" dia. pipe sleeves are to be provided through tunnel roof slab and capped flush with concrete for future toll booth heaters.
 3. Piping for booth heaters to switch from NE tunnel wall to SW tunnel wall between Island "I" and "J" by going across ceiling.
 4. Piping to tunnel space heaters UH 14 & UH 15 to be the same as for booth heaters.

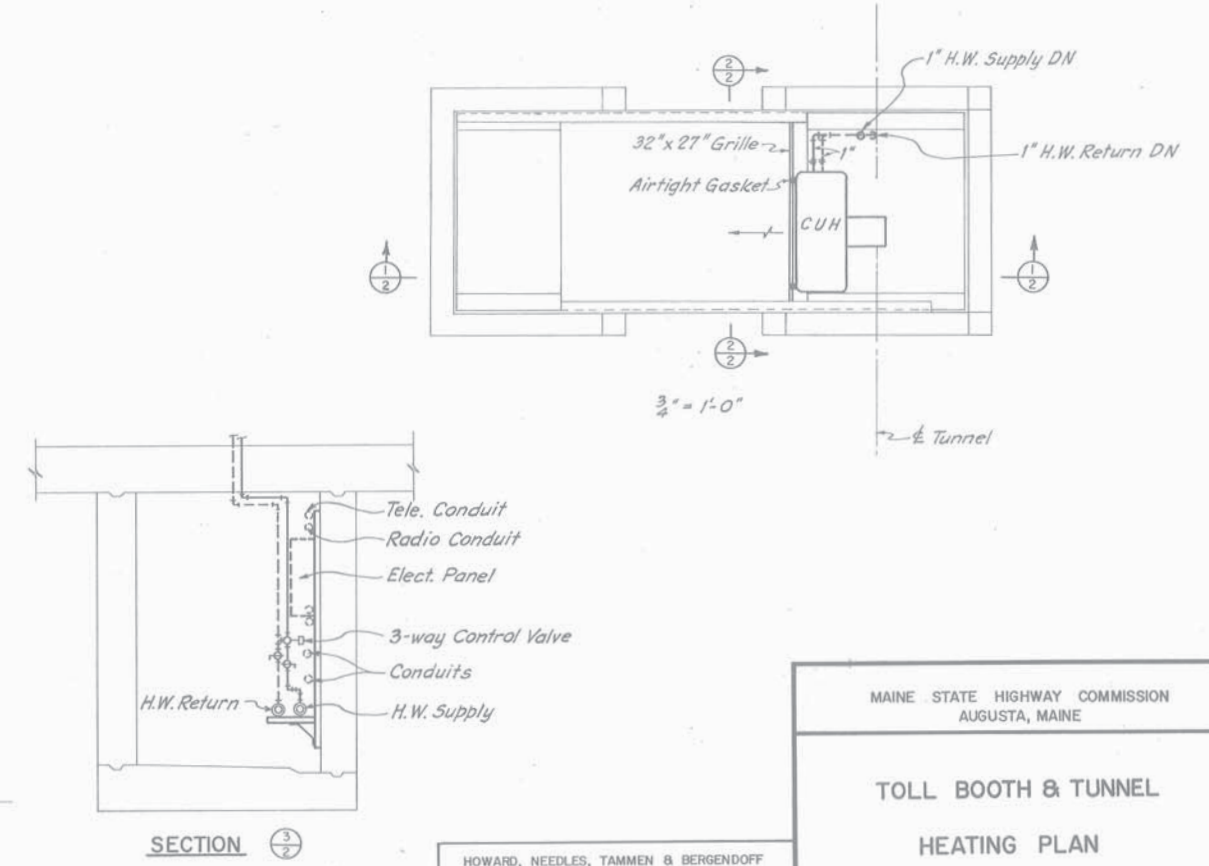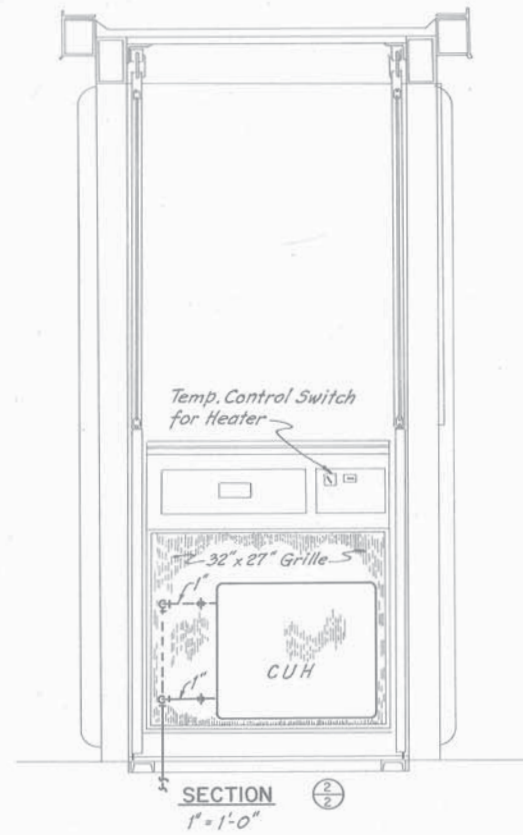

MAINE STATE HIGHWAY COMMISSION
AUGUSTA, MAINE

**TOLL BOOTH & TUNNEL
HEATING PLAN**

HOWARD, NEEDLES, TAMMEN & BERGENDOFF
CONSULTING ENGINEERS
NEW YORK BOSTON KANSAS CITY

LIGHTING

LEGEND

- Light Standard (400 Watt)
- ◆ Light Standard (1000 Watt)
- Junction Box
- Conduit

NOTES:

1. All light standards shall use 15' arms.
2. Mounting height to be 40'.


Turnpike Curve Data

P.I. Sta. 276+15.57
 $\Delta = 42^{\circ} 06' 30''$ Lt.
 $D = 1' 00' 00''$
 $T = 2205.60'$
 $L = 4210.83'$
 $R = 5729.59'$
 $E = 409.70'$

Access Road Curve Data

$\Delta = 39^{\circ} 15'$ Lt.
 $D = 38^{\circ} 12'$
 $T = 53.48'$
 $L = 102.74'$
 $R = 150.00'$

Sta 53+05' to Sta 54+05' Rt. (Chases Pond Rd)
 Remove existing guard rail. Payment for removal shall be considered incidental to the various contract items.

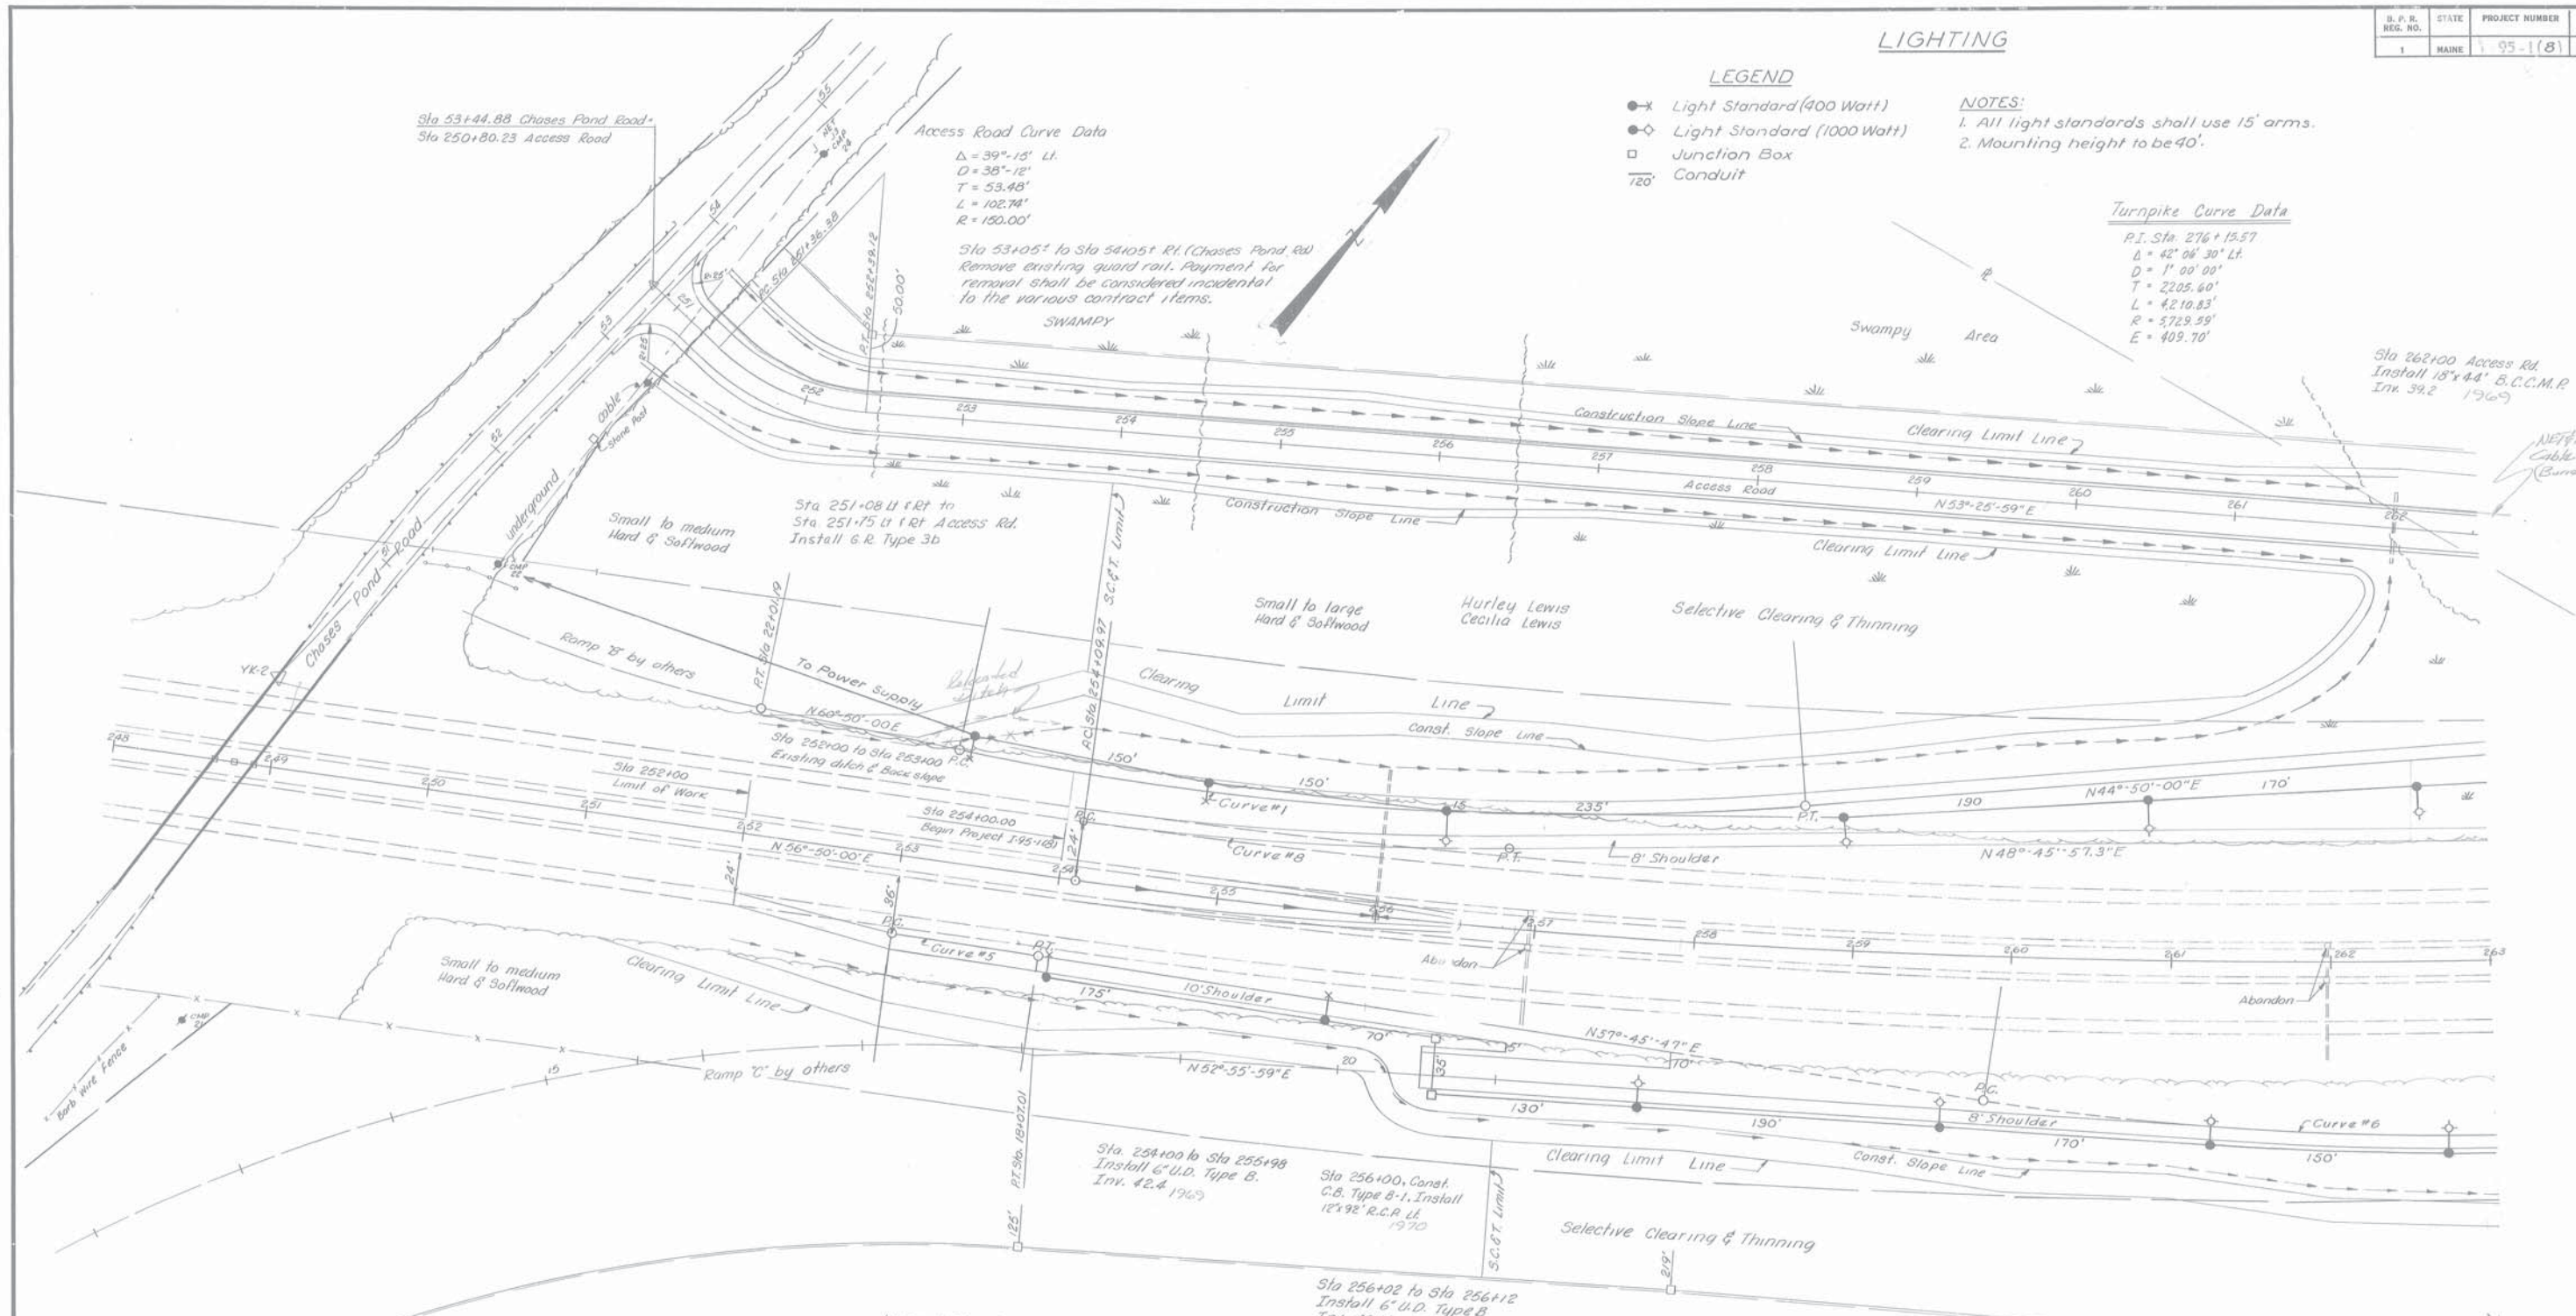

Clearing
 Sta 251+27 to Sta 263+00 Mainline
 Sta 251+22 to Sta 261+85 Access Rd

Selective Clearing and Thinning
 Sta 254+00 to Sta 263+00 Mainline

Bracing Assembly - Metal Posts
 Sta 260+42 Rt. 1/2" Type II
 Sta 251+25 Lt. Access Rd Type I
 Sta 252+39.12 Lt. Access Rd Type II
 Sta 256+22 Lt. Access Rd Type II
 Sta 18+07.01 Rt. Ramp C' Type I

Curve No.	Δ°	D°	R'	T'	L'	E'
1	16°-00'-00" Lt.	3°-00'-00"	1909.86	268.41	533.33	18.77
2	1°-05'-58.9" Rt.	2°-00'-00"	2864.79	27.49	54.99	0.13
3	1°-35'-51.1" Rt.	1°-00'-00"	5729.58	79.88	159.75	0.56
4	13°-35'-51.1" Lt.	3°-00'-00"	1909.86	227.70	453.25	13.53
5	0°-55'-46.9" Rt.	1°-00'-00"	5729.58	46.49	92.97	0.19
6	11°-49'-48.1" Lt.	3°-00'-00"	1909.86	197.87	394.33	10.22
7	12°-00'-00" Lt.	3°-30'-00"	1637.02	172.06	342.86	9.02
8	8°-04'-02.6" Lt.	3°-00'-00"	1909.86	134.68	268.91	4.74
9	10°-36'-23.7" Lt.	1°-30'-00"	3819.72	354.57	707.11	16.42

Right of Way Monuments
 Sta 258+00 219' Rt. M
 Sta 252+39.12 50' Lt. Access Rd
 Sta 18+07.01 125' Rt. Ramp C'

Woven Wire Fence - Metal Posts
 Sta 18+07.01 125' Rt. Ramp C' to Sta 263+00 250' Rt. M
 Sta 251+25 63' Lt. Access Rd to Sta 263+00 318' Lt. M

B.P.R. PARTICIPATION LIMITS ON MAIN LINE PAVEMENT & GRADING PAVEMENT
 10 LANES (APPROX. 158.5' WIDE) & 8' PAVED SHOULDER, LT. & RT.
GRADING LIMITS LEFT
 FROM THE OUTSIDE EDGE OF SHOULDER, OF THE 10 LANE PAVING, ON A 4:1 FILL SLOPE TO OLD GROUND.
 THE SLOPE LIMIT, IN THE AREA OF THE UTILITY BUILDING, SHALL BE EXTENDED TO INCLUDE THE GRADING AROUND THE BUILDING, OUTSIDE OF THE GRADING LIMITS REQUIRED TO BE DONE UNDER THE UTILITY BUILDING ITEM.
 PAVEMENT AN BASE, BEYOND THE OUTSIDE EDGE OF THE PAVED SHOULDER, WILL BE NON-PARTICIPATING.
GRADING LIMITS RIGHT
 FROM THE THEORETICAL OUTSIDE EDGE OF SHOULDER, OF THE 10 LANE PAVING, ON A 4:1 FILL SLOPE TO OLD GROUND.
OTHER WORK
 THE GRADING BEYOND THE 4:1 SLOPE, ADJACENT TO THE MAIN-LINE CONST. SHALL BE CONSIDERED AS NON-PARTIC.

MAINE STATE HIGHWAY COMMISSION
 AUGUSTA, MAINE

PLAN
 STA 248+00 TO STA 263+00


HOWARD, NEEDLES, TAMMEN & BERGENDOFF
 CONSULTING ENGINEERS
 NEW YORK BOSTON KANSAS CITY

Access Road Curve Data

Δ = 84°-00'-00" Rt.
 D = 142°-12'
 T = 36.06'
 L = 58.65'
 R = 40.00'

Turnpike Curve Data

P.I. Sta 276+15.57
 Δ = 42°-06'-30" Lt.
 D = 1°-00'-00"
 T = 2205.60'
 L = 4210.33'
 R = 5729.59'
 E = 409.70'

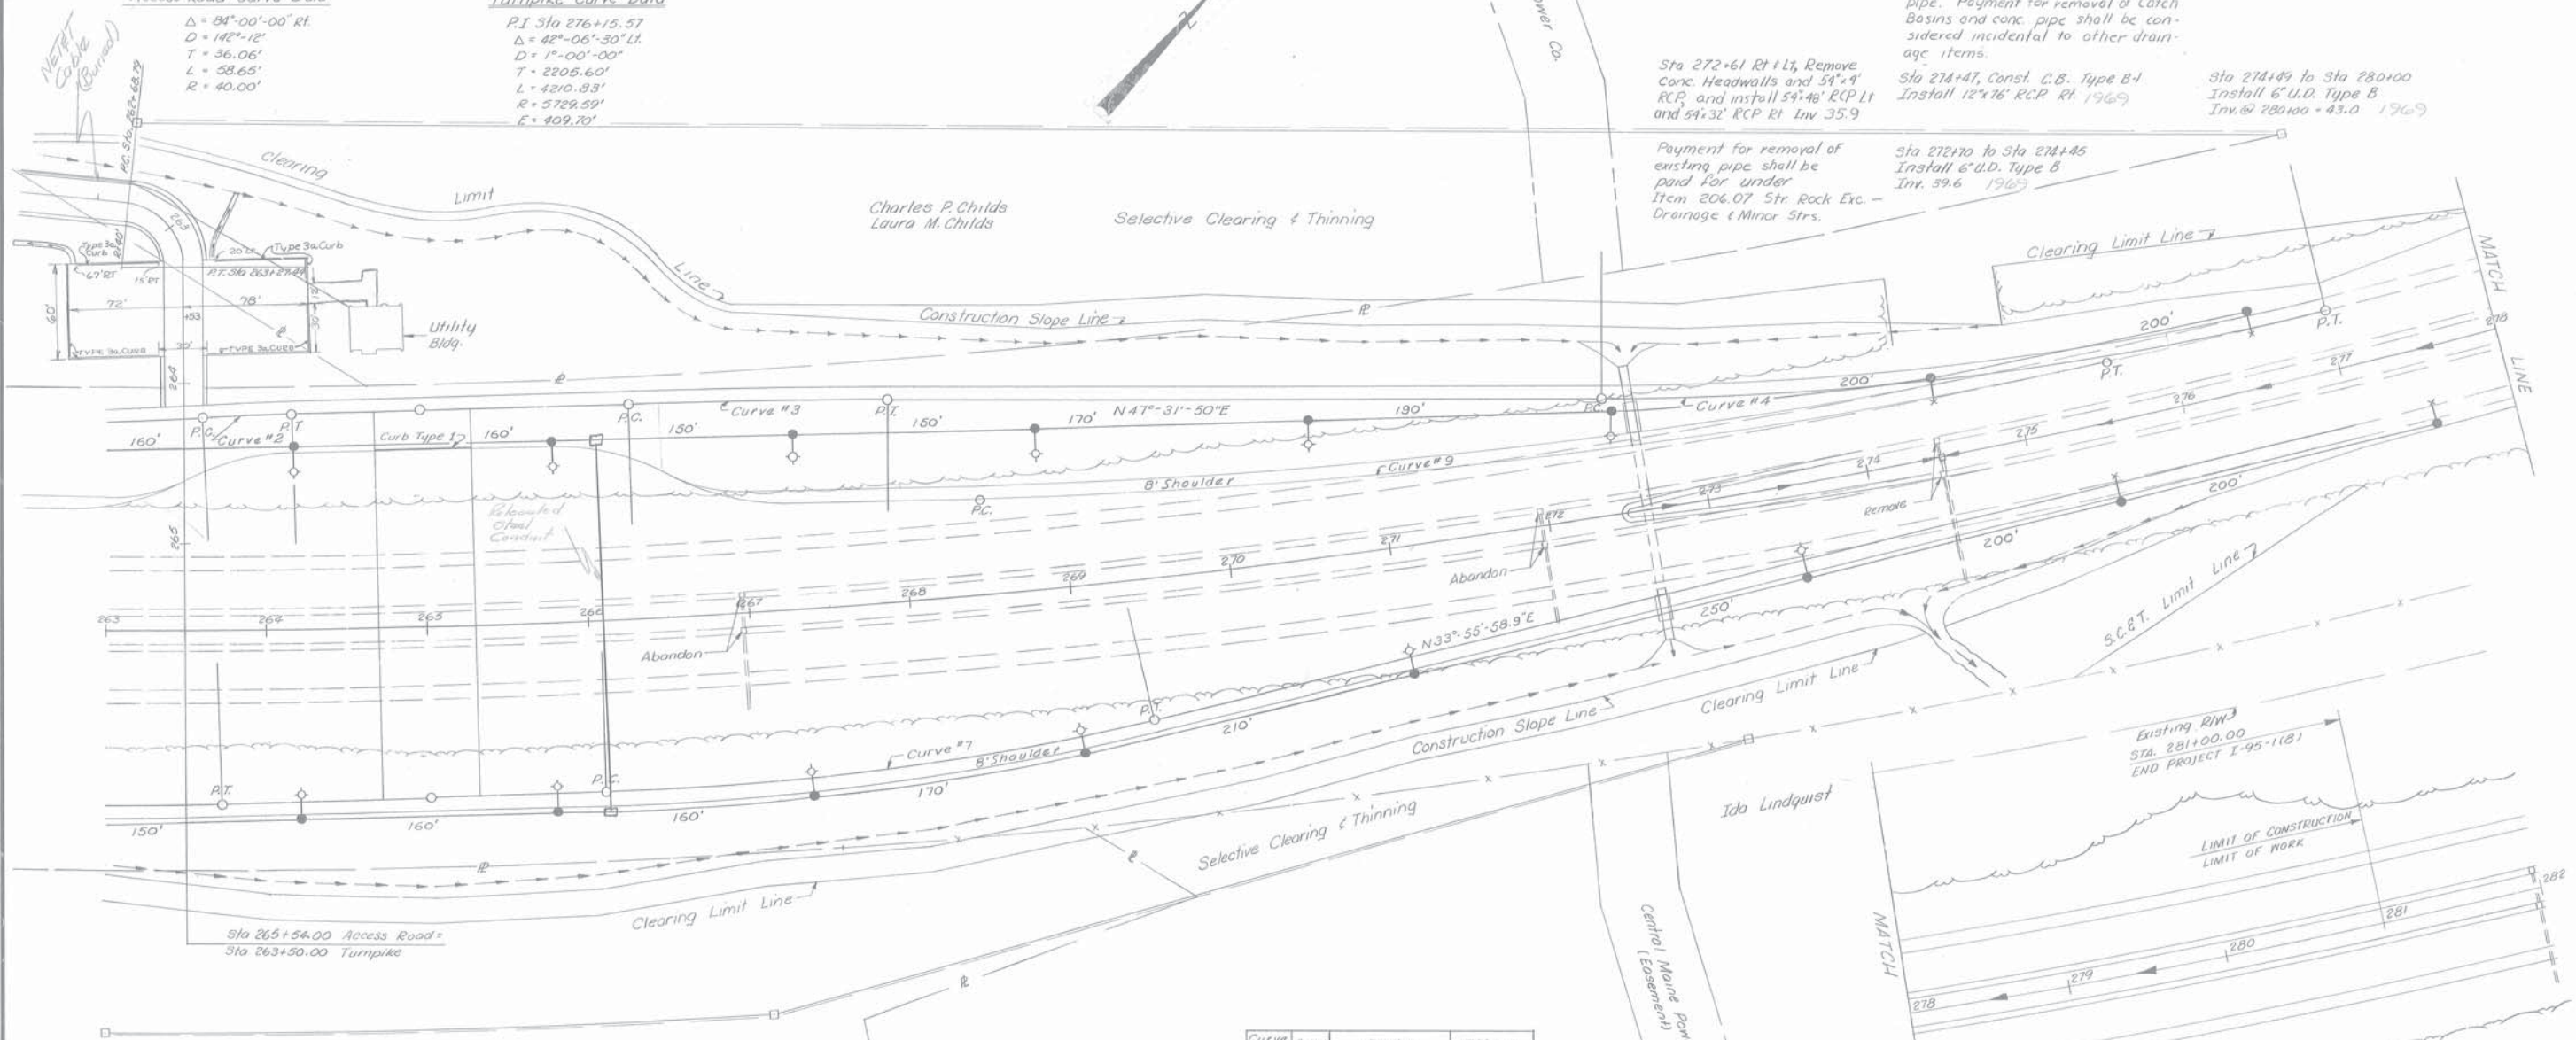

Sta 274+47, 9' Lt & 11' Rt. Remove existing Catch Basins and concrete pipe. Payment for removal of Catch Basins and conc. pipe shall be considered incidental to other drainage items.
 Sta 274+47, Const. C.B. Type B-1 Install 12"x16" RCP Rt. 1969
 Sta 274+49 to Sta 280+00 Install 6" U.D. Type B Inv. @ 280+00 = 43.0 1969
 Sta 272+61 Rt & Lt, Remove conc. Headwalls and 54"x4" RCP and install 54"x4" RCP Lt and 54"x32" RCP Rt Inv 35.9
 Sta 272+70 to Sta 274+45 Install 6" U.D. Type B Inv. 39.6 1969
 Payment for removal of existing pipe shall be paid for under Item 206.07 Str. Rock Exc. - Drainage & Minor Strs.


Clearing
 Sta 263+00 to Sta 278+00 M

Selective Clearing and Thinning
 Sta 263+00 to Sta 278+00 M

Right of Way Monuments
 Sta 263+00 250' Rt M
 Sta 267+00 250' Rt M
 Sta 273+00 150' Rt M
 Sta 277+00 150' Lt M

Woven Wire Fence - Metal Posts
 Sta 263+00 250' Rt to Sta 273+00 150' Rt M
 Sta 263+00 318' Lt to Sta 277+00 150' Lt M

Sodded Downspouts - Access Rd.
 Sta. 263+23 18" Lt
 Sta. 263+23 6" Rt.

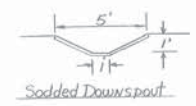

Bracing Assembly - Metal Posts
 Sta 263+36 Lt M Type II
 Sta 266+71 Rt M Type II
 Sta 270+28 Lt M Type II
 Sta 273+00 Rt M Type I
 Sta 277+00 Lt M Type I

Reflectorization of Brit Concrete
 On the first 10' of Type 3a Curb Lt & Rt of Entrances

Curb Type 3a - Access Rd

Sta. 263+24	20' Lt. to 78' Lt.	58
Sta. 263+24	15' Rt. to 67' Rt.	52
Sta. 263+24 to Sta. 263+41	77' Lt.	17
Sta. 263+23 to Sta. 263+83	71' Rt.	60
Sta. 263+53 to Sta. 263+82	77' Lt.	29
Sta. 263+82	15' Lt. to 78' Lt.	63
Sta. 263+82	15' Rt. to 71' Rt.	56

Curve No.	Point	Station	Offset
1	P.C.	253+26.79	71.13 Lt.
	P.T.	255+96.19	49.41 Lt.
	P.T.	258+64.75	90.46 Lt.
2	P.C.	263+61.80	132.84 Lt.
	P.T.	263+89.93	133.97 Lt.
3	P.C.	264+18.07	134.43 Lt.
	P.T.	266+33.17	133.49 Lt.
4	P.I.	267+14.84	131.06 Lt.
	P.T.	267+96.34	125.28 Lt.
	P.C.	272+44.74	72.68 Lt.
5	P.I.	274+70.95	32.45 Lt.
	P.T.	277+00.00	37.00 Lt.
	P.C.	253+00.00	49.00 Rt.
6	P.I.	253+46.49	49.00 Rt.
	P.T.	253+92.97	49.75 Rt.
	P.C.	259+85.74	88.86 Rt.
7	P.I.	261+78.42	115.20 Rt.
	P.T.	263+72.38	107.45 Rt.
	P.C.	266+07.41	107.03 Rt.
8	P.I.	267+76.14	112.78 Rt.
	P.T.	269+43.44	87.64 Rt.
	P.C.	254+09.97	37.00 Lt.
9	P.I.	255+45.50	35.41 Lt.
	P.T.	256+80.44	49.57 Lt.
	P.C.	268+48.50	58.51 Lt.
9	P.I.	272+04.25	25.97 Lt.
	P.T.	275+60.66	37.00 Lt.



MAINE STATE HIGHWAY COMMISSION
 AUGUSTA, MAINE

PLAN

STA 263+00 TO STA 278+00

HOWARD, NEEDLES, TAMMEN & BERGENDOFF
 CONSULTING ENGINEERS

NEW YORK BOSTON KANSAS CITY

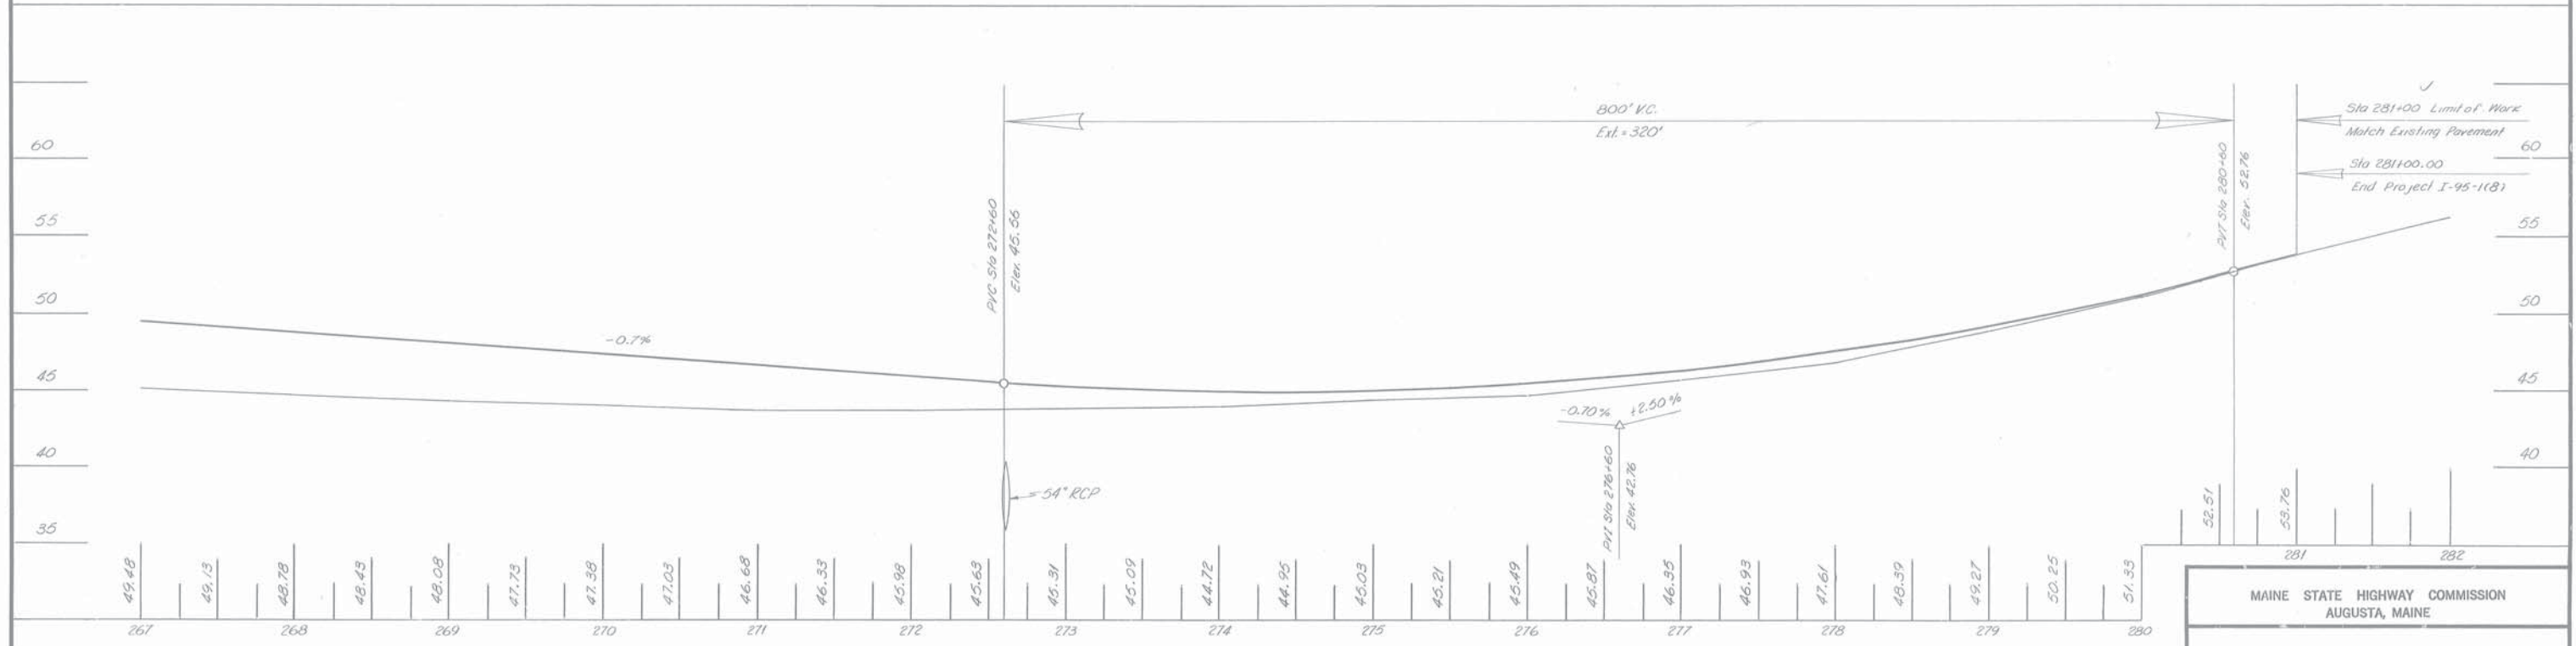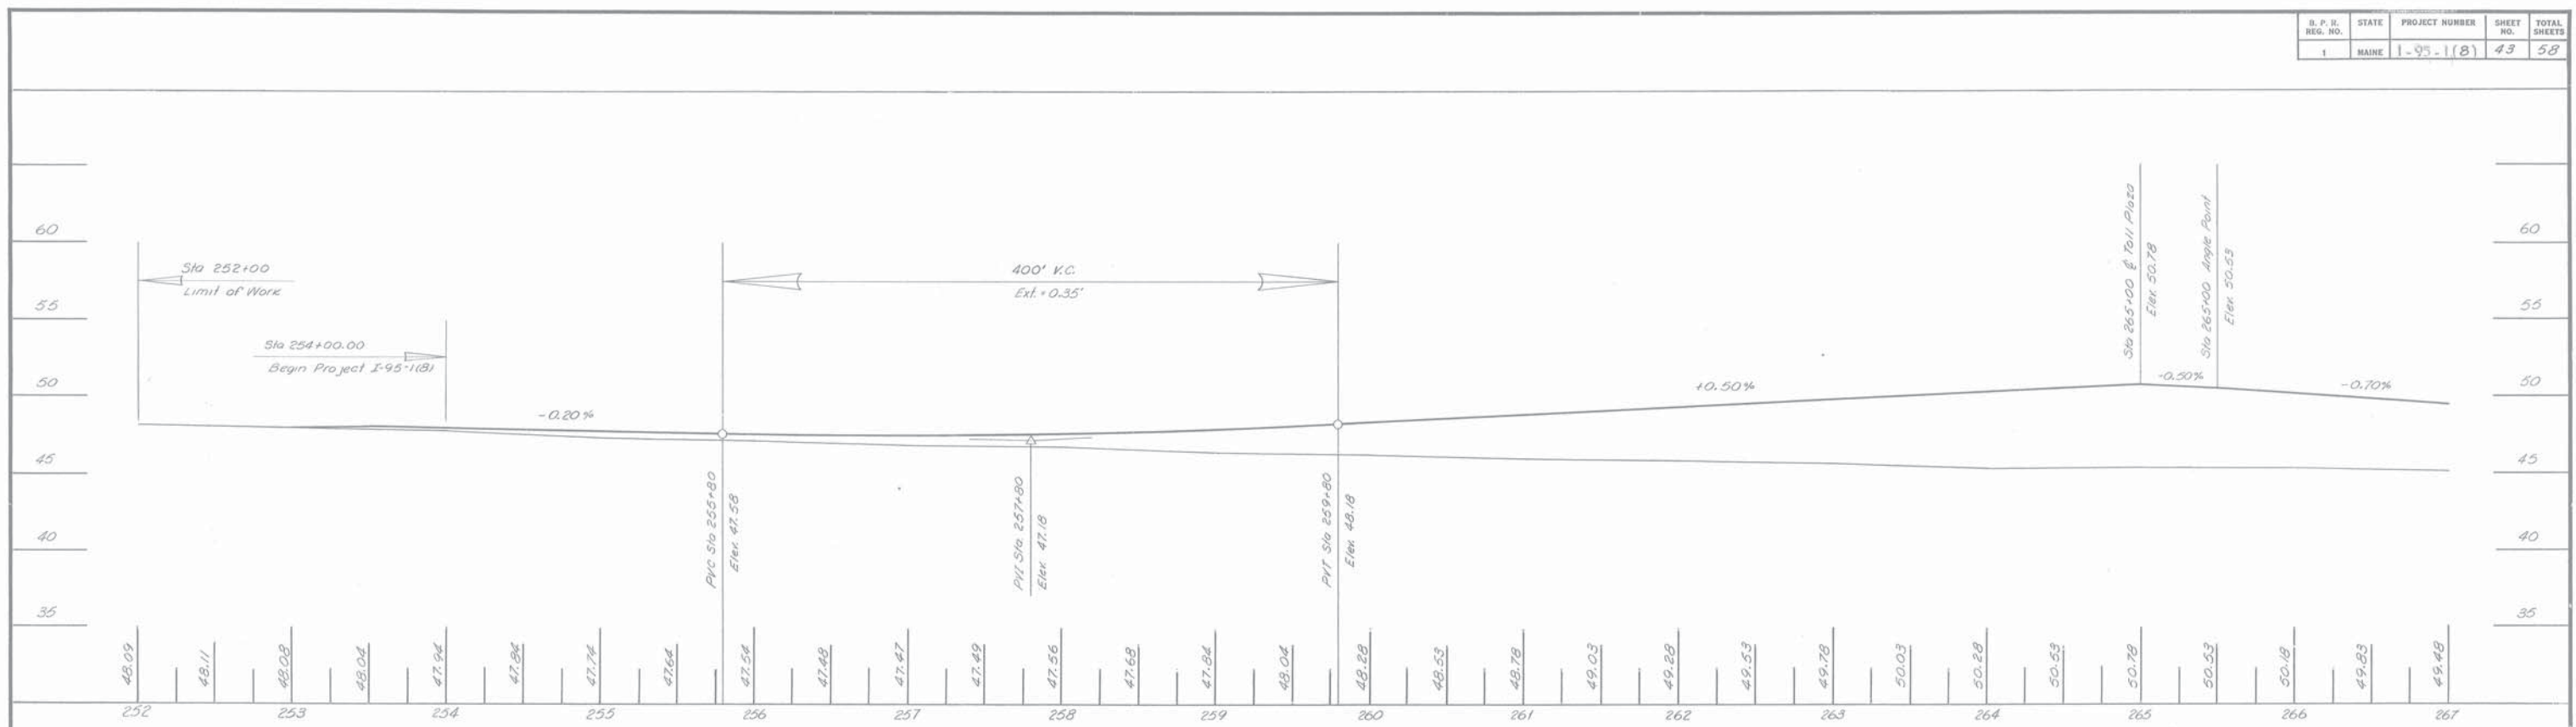

Grubbing
Sta 252+00 to 281+00


MAINE STATE HIGHWAY COMMISSION
AUGUSTA, MAINE

PROFILE
STA 252+00 TO STA 282+00

HOWARD, NEEDLES, TAMMEN & BERGENDOFF
CONSULTING ENGINEERS
NEW YORK BOSTON KANSAS CITY

FINAL SURVEY
 DATE: _____
 BY: _____
 SURVEYED: _____
 TECH. DATE: _____
 NOTE BOOK AREA: _____
 AREA CHECKED: _____
 NO. _____

ORIGINAL SURVEY
 DATE: _____
 BY: _____
 SURVEYED: _____
 TECH. DATE: _____
 NOTE BOOK AREA: _____
 AREA CHECKED: _____
 NO. _____

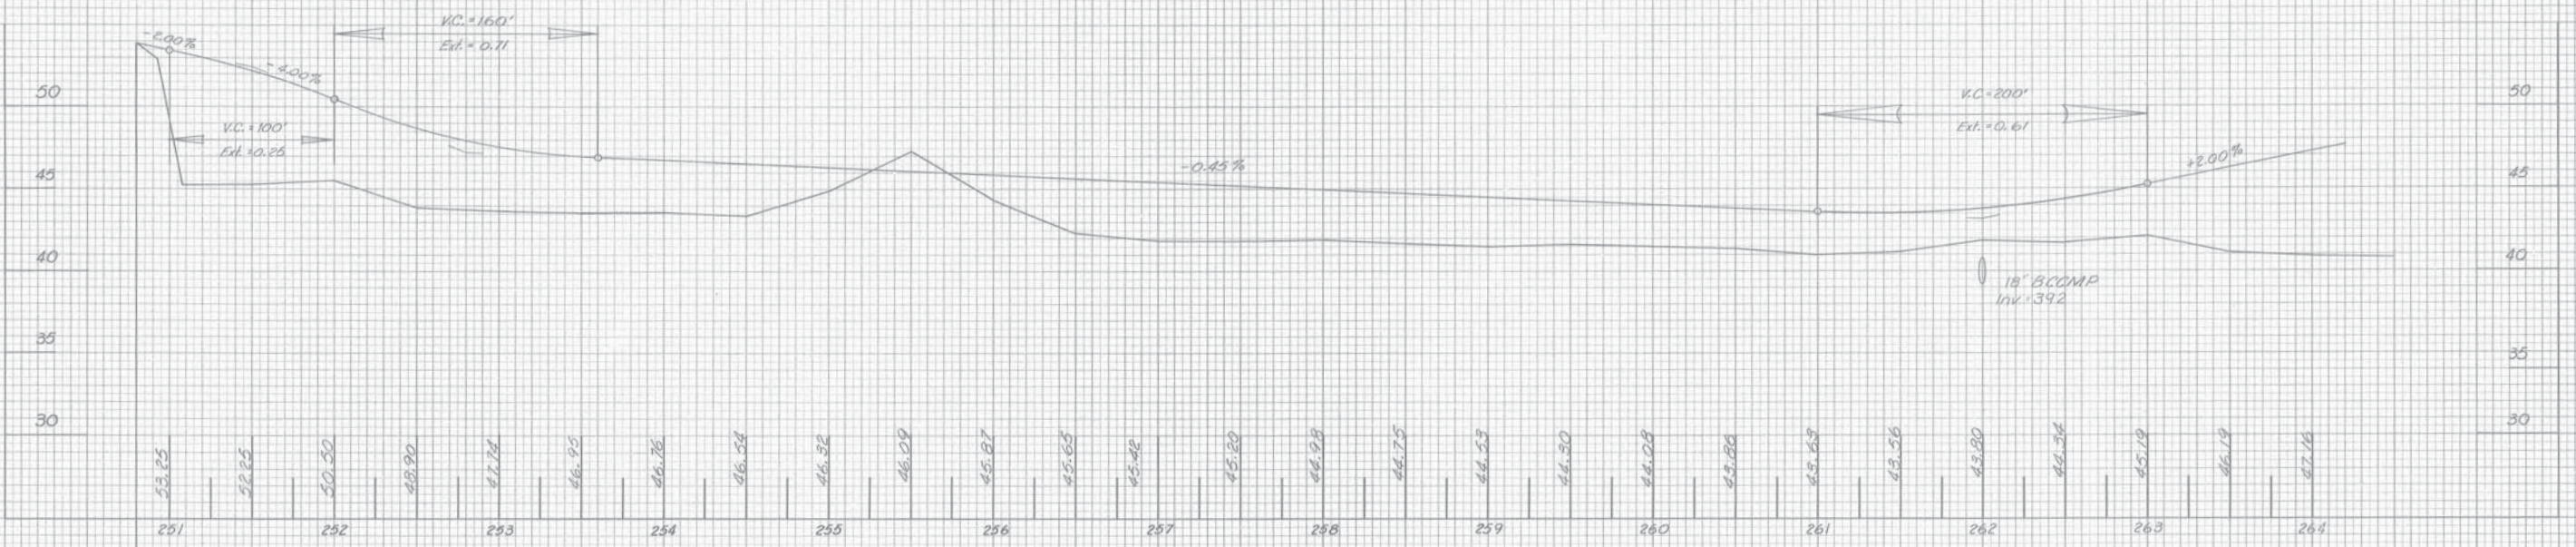


Sta 250+80.28 Access Rd.
 @ Chasid Pond Rd.

Grubbing
 Sta 250+93 to Sta 263+00 Access Rd

Access Road Profile
 York Fall Plaza

B. P. R. REG. NO.	STATE	PROJECT NUMBER	SHEET NO.	TOTAL SHEETS
1	MAINE	1-55-1 (8)	47	58

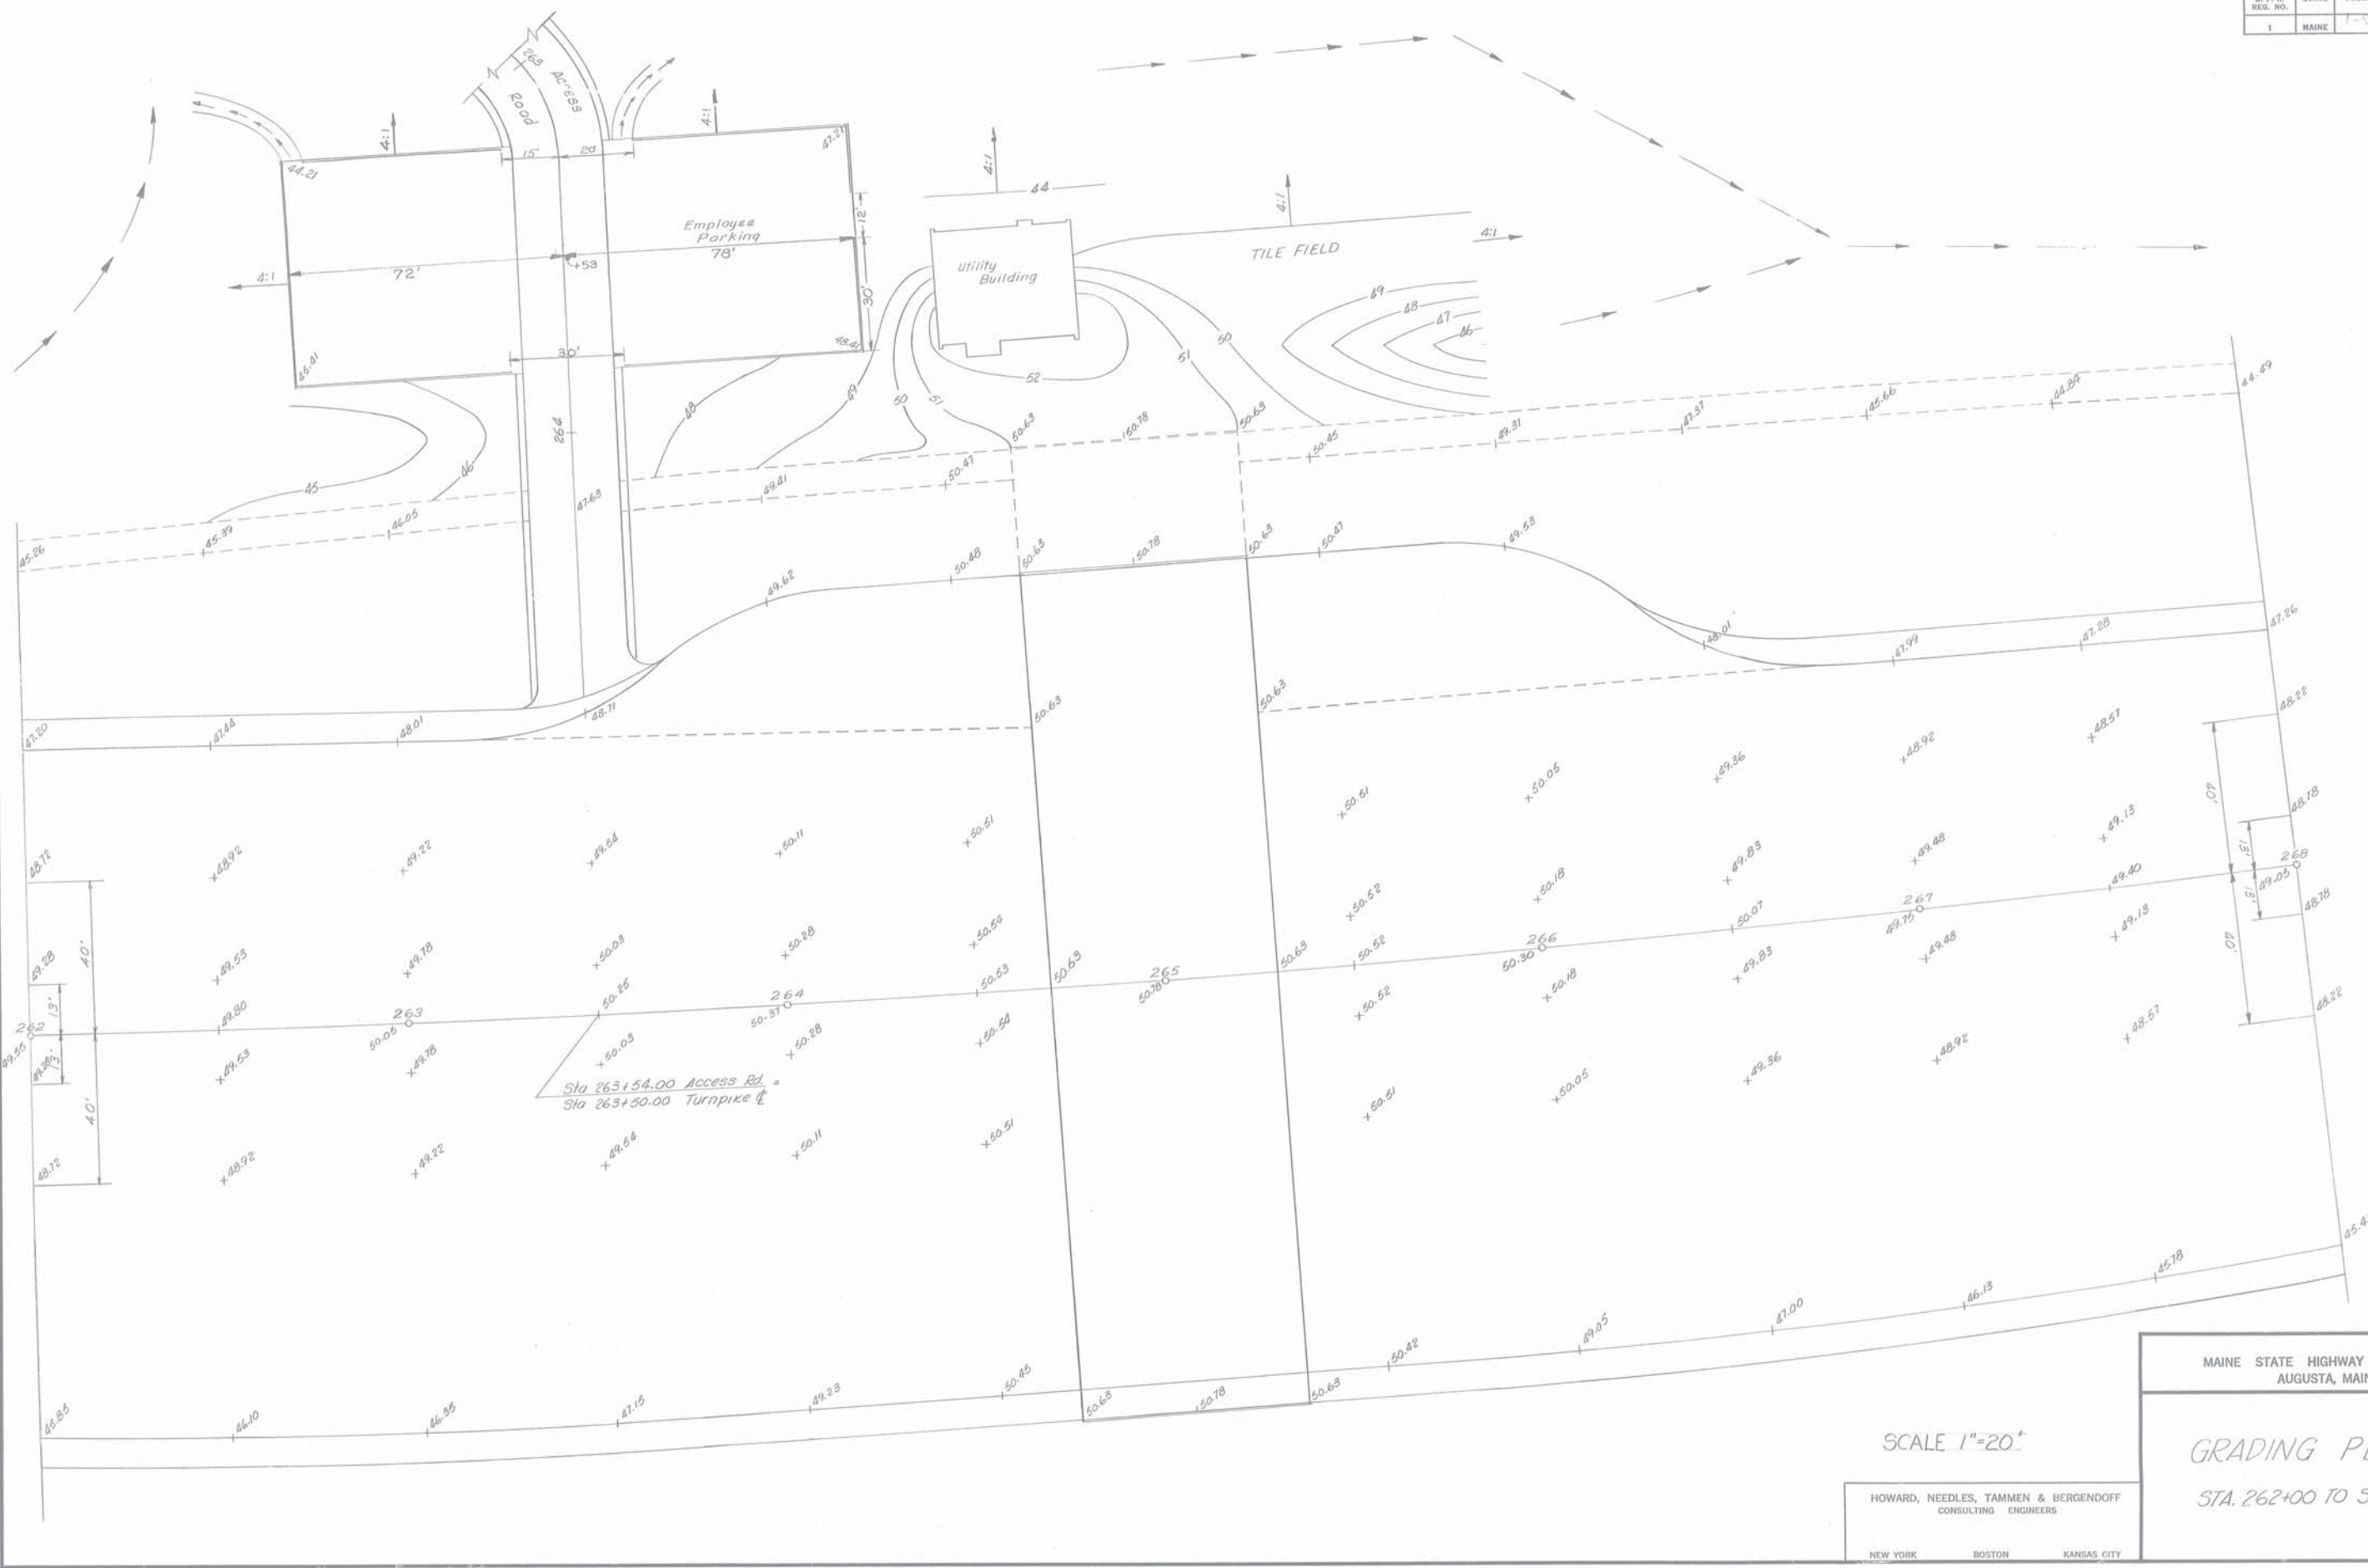

SCALE 1"=20'

HOWARD, NEEDLES, TAMMEN & BERGENDOFF
CONSULTING ENGINEERS
NEW YORK BOSTON KANSAS CITY

MAINE STATE HIGHWAY COMMISSION
AUGUSTA, MAINE

GRADING PLAN
STA. 262+00 TO STA 268+00

MAINE TURNPIKE AUTHORITY

MAINE TURNPIKE




JULIAN R. COLES, CHAIRMAN
 DEBORAH H. SHELTON, VICE CHAIR
 PATRICK F. BUTLER, MEMBER
 LUCIEN B. GOSSELIN, MEMBER
 JOHN G. MELROSE, MEMBER EX-OFFICIO
 PAUL E. VIOLETTE, EXECUTIVE DIRECTOR

INDEX OF SHEETS

1	TITLE SHEET
2	GENERAL NOTES
3	QUANTITIES
4-7	TYPICAL SECTIONS AND MISCELLANEOUS DETAILS
8-11	STANDARD DETAILS
12	SITE PLAN
13	UTILITY PLAN
14	TYPICAL LANE MODIFICATION DETAILS
15	CANOPY SIGNS
16	SIGN STANDARD DETAILS
17	SIGN POST DETAILS
18-19	BREAKAWAY SUPPORTS
20	TRAFFIC MAINTENANCE PLAN
21-38	CROSS SECTIONS
39	OVERHEAD SUPPORT
40	OVERHEAD SUPPORT DETAIL
41	ELECTRICAL PLAN
42	ELECTRICAL DETAILS

CONTRACT 99.4 TOLL PLAZA MODIFICATIONS YORK TOLL PLAZA MM 5.76

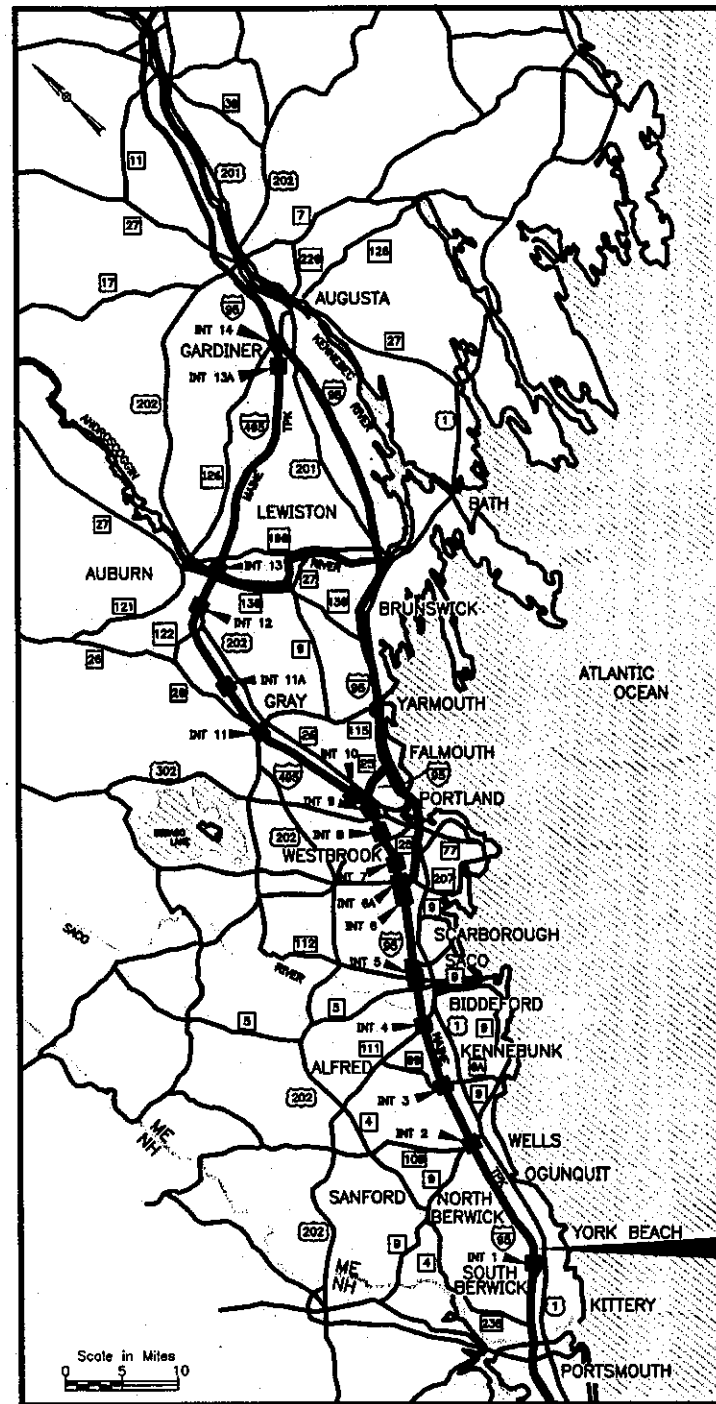

CONTRACT 99.4
 YORK
 TOLL PLAZA

LOCATION MAP

STATE OF MAINE
 DEPARTMENT OF TRANSPORTATION

COMMISSIONER _____ DATE _____
 BUREAU DIRECTOR AND CHIEF ENGINEER _____ DATE _____



ARCHITECTS ENGINEERS PLANNERS



Roland A. Lavalley
 ROLAND A. LAVALLEE P.E., P.L.S.
 VICE PRESIDENT
 DIRECTOR OF OPERATIONS

3/14/99
 DATE

APPROVED: MAINE TURNPIKE AUTHORITY


 CHAIRMAN
 EXECUTIVE DIRECTOR

DATE _____

(METPK\BDR-01)

GENERAL NOTES


1. THE SEVEN EXISTING BELL ATLANTIC TELEPHONE BOOTHS SHALL BE REMOVED BY THE TELEPHONE COMPANY. THE REINFORCED CONCRETE SLABS SHALL BE REMOVED BY THE CONTRACTOR AND SHALL BE CONSIDERED INCIDENTAL TO ITEM 203.20 -- COMMON EXCAVATION.
2. CLEARING LIMITS SHALL BE 5' BEYOND AND PARALLEL TO THE CONSTRUCTION SLOPE LINES OR AS SHOWN ON THE PLANS UNLESS OTHERWISE AUTHORIZED BY THE ENGINEER.
3. THE CLEARING LINES SHOWN ON THE PLANS ARE FOR ESTIMATING PURPOSES ONLY. THE ACTUAL LINES FOR PAYMENT SHALL BE ESTABLISHED IN THE FIELD BY THE ENGINEER.
4. ALL DITCH ELEVATIONS AND OFFSETS SHOWN ON THE CROSS SECTIONS ARE FOR THE FINISHED DITCH FLOW LINE.
5. REQUIRED EROSION AND SEDIMENTATION CONTROL SHOWN ON THE PLANS IS FOR ESTIMATING PURPOSE ONLY. ACTUAL TYPE AND LOCATION OF DEVICES SHALL BE DETERMINED IN THE FIELD BY THE ENGINEER.
6. TWO GUARDRAIL DELINEATOR POSTS SHALL BE INSTALLED AT EACH 350 SRT AND ONE GUARDRAIL DELINEATOR POST SHALL BE INSTALLED AT EACH GUARDRAIL TERMINAL END.
7. SRT 350 TERMINAL SHALL BE INSTALLED CONCURRENTLY WITH THE PLACEMENT OF EACH SECTION OF BEAM GUARDRAIL, UNLESS OTHER APPROVED TEMPORARY PROTECTION HAS BEEN AUTHORIZED.
8. 4" LOAM HAS BEEN ESTIMATED FOR 100% OF THE DISTURBED SLOPE AREA. ACTUAL PLACEMENT OF THE LOAM SHALL BE AS DESIGNATED BY THE ENGINEER.
9. UNLESS OTHERWISE NOTED, SEEDING METHOD NO. 1 SHALL BE UTILIZED ON ALL LAWNS AND DEVELOPED AREAS; SEEDING METHOD NO. 2 SHALL BE UTILIZED ON ALL NON-GUARDRAIL FORESLOPES FROM THE EDGE OF SHOULDER TO THE DITCH LINE OR TOE OF FILL; SEEDING METHOD NO. 3 SHALL BE UTILIZED ON ALL BACKSLOPES AND ON ALL GUARDRAIL FILL SLOPES.
10. MULCH SHALL BE APPLIED IN AREAS SEEDED BY SEEDING METHODS NO. 1, 2 AND 3.
11. THE UTILITIES ON THIS CONTRACT ARE:
CENTRAL MAINE POWER COMPANY
BELL ATLANTIC
12. SURPLUS MATERIAL SHALL NOT BE PLACED WITHIN 10' OF THE OUTSIDE OF A CULVERT.
13. WHERE HOT BITUMINOUS PAVEMENT GRADING C IS TO MEET EXISTING PAVEMENT A BUTT JOINT WILL BE REQUIRED. SEE PAVEMENT TRANSITION DETAILS.
14. THE CONTRACTOR SHALL COMPLY WITH ALL CONDITIONS CONTAINED IN THE STATE OF MAINE'S NATURAL RESOURCES PROTECTION ACT TIER I PERMIT AND WITH SECTION 404, PROGRAMMATIC GENERAL PERMIT FOR THE STATE OF MAINE (GENERAL PERMIT-39) AS PROMULGATED BY THE U.S. ARMY CORPS OF ENGINEERS. THE CONTRACTOR SHALL COMPLY WITH ALL CONDITIONS CONTAINED IN THE MAINE DEPARTMENT OF ENVIRONMENTAL PROTECTION PERMIT AND THE U.S. ARMY CORPS OF ENGINEERS PERMIT.
15. EXCAVATIONS ACCOMPLISHED AS PART OF THIS PROJECT SHALL BE CONSTRUCTED IN ACCORDANCE WITH OSHA SUBPART P OF 29 CFR PART 1926.650-652 (CONSTRUCTION STANDARDS FOR EXCAVATIONS).
16. WASTE MATERIALS SHALL BE DISPOSED OF, OFF THE PROJECT SITE, IN ACCORDANCE WITH CHAPTER 404, DEPARTMENT OF ENVIRONMENTAL PROTECTION SOLID WASTE MANAGEMENT RULES.
17. EXISTING UTILITIES ON THESE PLANS WERE COMPILED FROM FIELD SURVEY AND VARIOUS OTHER SOURCES. LOCATIONS ARE NOT GUARANTEED TO BE ACCURATE NOR IS IT GUARANTEED THAT ALL UTILITIES ARE SHOWN. NO SEPARATE OR ADDITIONAL COMPENSATION WILL BE ALLOWED TO THE CONTRACTOR DUE TO ANY VARIANCE BETWEEN THE DATA SHOWN ON THE PLANS AND THE ACTUAL FIELD CONDITIONS ENCOUNTERED. NO WORK SHALL BE STARTED UNTIL THE OWNERS OF THE VARIOUS UTILITIES ARE NOTIFIED BY THE CONTRACTOR OF THE PROPOSED CONSTRUCTION. THE CONTRACTOR IS ALSO REQUIRED TO CALL DIG SAFE AT 1-800-DIG-SAFE PRIOR TO THE START OF THE WORK.
18. THE CONTRACTOR SHALL CONSTRUCT A REINFORCED CONCRETE TELEPHONE PAD (18' L x 6' W x 8' D) ON CHASES POND ROAD. THE PAD SHALL BE LOCATED 25 FEET WEST OF THE FENCE ON THE EAST END OF THE EXISTING COMMUTER PARKING LOT. TWO 2" NON-METALLIC CONDUITS SHALL BE INSTALLED UNDERGROUND FROM THE SLAB TO AND UP THE UTILITY POLE, APPROXIMATELY 15 FEET UNDERGROUND AND 20 FEET VERTICAL UP THE POLE (70 LF). ALL WORK REQUIRED SHALL MEET ALL REQUIREMENTS OF BELL ATLANTIC TELEPHONE COMPANY. BELL ATLANTIC SHALL BE NOTIFIED 48 HOURS PRIOR TO THE CONTRACTOR UNDERTAKING ANY WORK WHICH MAY AFFECT THEIR UTILITY.

Maine Turnpike Authority Maine Turnpike	
	YORK TOLL PLAZA TOLL PLAZA MODIFICATIONS GENERAL NOTES
HNTB ARCHITECTS ENGINEERS PLANNERS	
Contract 99.4	Sheet No. GN-1 2 of 42

No.	Revision	By	Date	In Charge Of





ESTIMATED QUANTITIES			
ITEM NO.	DESCRIPTION	QUANTITY	UNIT
202.1211	REMOVE EXISTING ANTENNA SUPPORT FOUNDATION - NB	1	LS
202.1212	REMOVE EXISTING ANTENNA SUPPORT FOUNDATION - SB	1	LS
202.1213	REMOVE EXISTING FLAGPOLE FOUNDATION	1	LS
203.20	COMMON EXCAVATION	4,200	CY
203.24	COMMON BORROW	100	CY
304.091	AGGREGATE BASE COURSE - CRUSHED (TYPE A)	600	CY
304.10	AGGREGATE SUBBASE COURSE - GRAVEL	3,500	CY
403.07	HOT BITUMINOUS PAVEMENT, GRADING B	2,100	TON
403.08	HOT BITUMINOUS PAVEMENT, GRADING C	1,150	TON
419.30	SAWING BITUMINOUS PAVEMENT	2,700	LF
504.80	STRUCTURAL STEEL ANTENNA SUPPORT - NB	1	LS
504.81	STRUCTURAL STEEL ANTENNA SUPPORT - SB	1	LS
603.155	12" REINFORCED CONCRETE PIPE - CLASS III	263	LF
604.09	CATCH BASIN TYPE B1	4	EA
606.24	GUARDRAIL TYPE 3d-SINGLE RAIL	2,338.5	LF
606.265	TERMINAL END-SINGLE RAIL-GALVANIZED STEEL	8	EA
606.35	GUARDRAIL DELINEATOR POST	7	EA
606.363	GUARDRAIL REMOVE AND DISPOSE	187.5	LF
606.3691	GUARDRAIL REMOVE AND STACK, SINGLE RAIL	141	LF
606.754	WIDEN SHOULDER FOR GUARDRAIL 350 FLARED TERMINAL	2	EA
606.79	GUARDRAIL 350 FLARED TERMINAL	2	EA
608.08	REINFORCED CONCRETE SIDEWALK	205	SY
609.11	VERTICAL CURB TYPE I	858	LF
609.12	VERTICAL CURB TYPE I - CIRCULAR	28	LF
609.13	VERTICAL BRIDGE CURB TYPE I	14	LF
609.31	CURB TYPE 3	30	LF
613.399	TEMPORARY EROSION CONTROL BLANKET	4,530	SY
615.07	LOAM	575	CY
618.13	SEEDING - METHOD NO.1	3	UNIT
618.15	SEEDING - METHOD NO. 3	41	UNIT
619.12	MULCH	44	UNIT
626.11	PRECAST CONCRETE JUNCTION BOX	1	EA
626.131	12" X 12" PLASTIC JUNCTION BOX	2	EA
626.132	24" X 20" PLASTIC JUNCTION BOX	2	EA
626.2115	1" METALLIC CONDUIT	500	LF
626.212	2" METALLIC CONDUIT	70	LF
626.2201	3/4" NON-METALLIC CONDUIT	200	LF
626.2203	1" NON-METALLIC CONDUIT	600	LF
626.2204	1 1/4" NON-METALLIC CONDUIT	50	LF
626.2207	2" NON-METALLIC CONDUIT	70	LF
626.23	PRE-WIRED CONDUIT - SECONDARY WIRING	2,900	LF
626.32	24 INCH FOUNDATION	24	EA

ESTIMATED QUANTITIES			
ITEM NO.	DESCRIPTION	QUANTITY	UNIT
626.361	REMOVE AND STACK CONCRETE FOUNDATION	7	EA
626.362	REMOVE AND DISPOSE CONCRETE FOUNDATION	7	EA
626.371	ANTENNA SUPPORT FOUNDATION - NB	1	LS
626.372	ANTENNA SUPPORT FOUNDATION - SB	1	LS
626.40	FLAGPOLE FOUNDATION	1	EA
629.05	HAND LABOR - STRAIGHT TIME	80	HR
631.12	ALL PURPOSE EXCAVATOR (INCLUDING OPERATOR)	50	HR
631.171	TRUCK-SMALL (INCLUDING OPERATOR)	50	HR
631.36	FOREMAN	25	HR
634.208	REMOVE AND RESET LIGHT STANDARD	14	EA
639.19	FIELD OFFICE TYPE B	1	EA
645.105	REMOVE & STACK REGULATORY, WARNING & ROUTE MARKER ASSEMBLY SIGNS	7	EA
645.109	REMOVE AND RESET SIGN	1	EA
645.162	BREAKAWAY DEVICE MULTI POLE	8	EA
645.251	ROADSIDE GUIDE SIGNS, TYPE I	190	SF
645.254	REMOVE & RESET CANOPY GUIDE SIGN	4	EA
645.257	CANOPY SIGN SUPPORT STRUCTURE	2	EA
645.271	REGULATORY, WARNING, CONFIRMATION AND ROUTE ASSEMBLY SIGNS, TYPE I	459	SF
645.289	STEEL H-BEAM POLES	2,852	LBS
645.292	REMOVE AND RESET GUIDE SIGN, TYPE II	1	EA
652.30	FLASHING ARROW BOARD	2	EA
652.32	BATTERY OPERATED LIGHT	42	EA
652.33	DRUM	120	EA
652.35	CONSTRUCTION SIGNS	252	SF
652.361	MAINTENANCE OF TRAFFIC CONTROL DEVICES	1	LS
656.50	BALED HAY, IN PLACE	50	EA
656.632	30" TEMPORARY SILT FENCE	2,400	LF
659.10	MOBILIZATION	1	LS
670.01	FLAGPOLE	1	EA
671.01	BOLLARD	12	EA
672.01	TREADLE	2	EA
675.01	ELECTRICAL WORK - CANOPY SIGN - NB	1	LS
675.02	ELECTRICAL WORK - CANOPY SIGN - SB	1	LS
675.03	ELECTRICAL WORK - ETC	1	LS

Maine Turnpike Authority Maine Turnpike	
YORK TOLL PLAZA TOLL PLAZA MODIFICATIONS ESTIMATED QUANTITIES	
	CNTB ARCHITECTS ENGINEERS PLANNERS
Contract 99.4	Sheet No. EQ-1 3 of 42

	By	Date
Designed	WEF	3/99
Drawn	WEF	3/99
Checked	RWB	3/99
No.	Revision	By Date In Charge of: RAL

(METPK BDR-01)

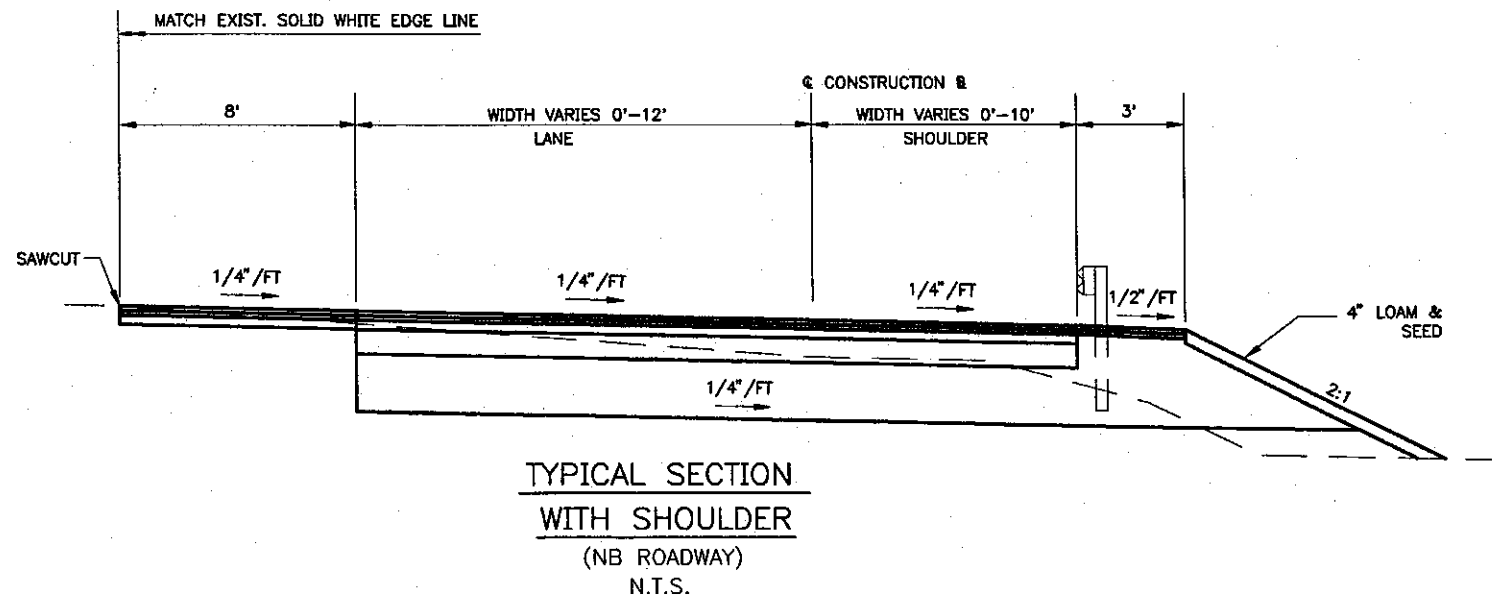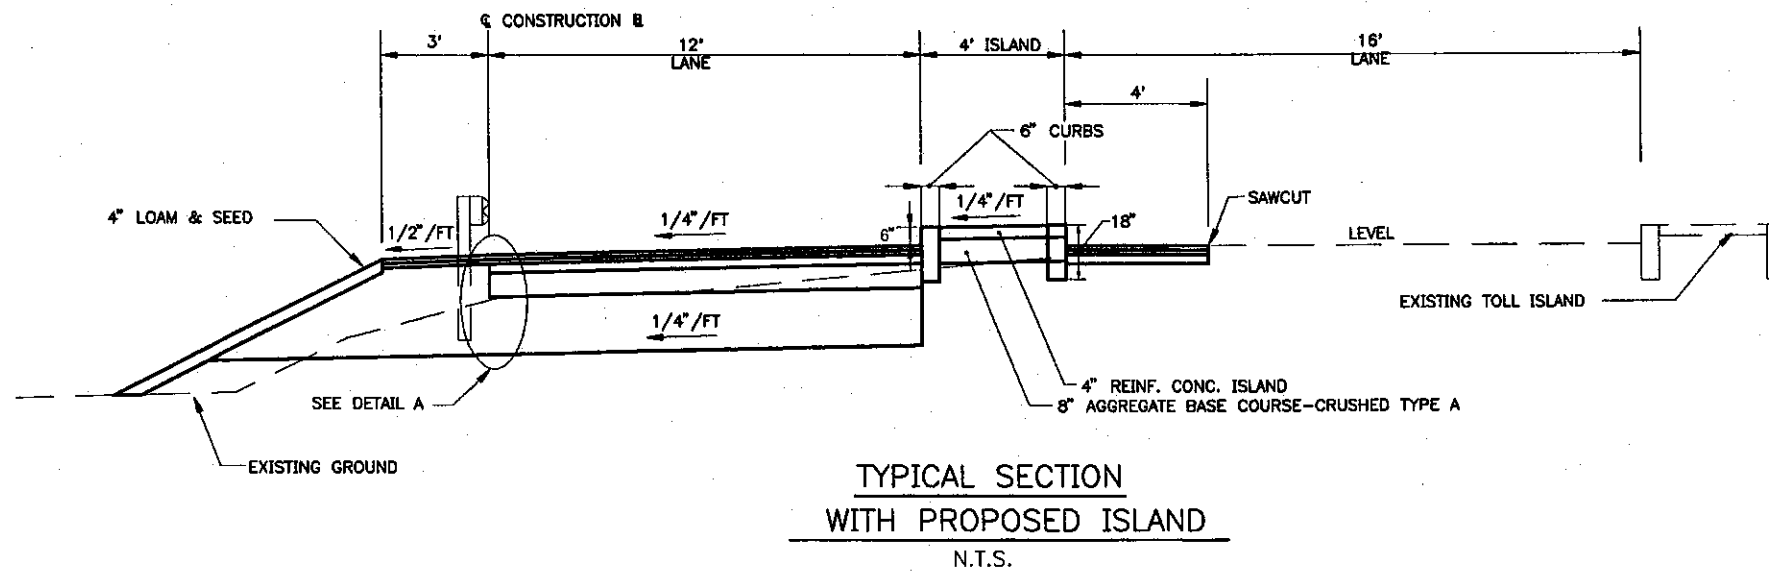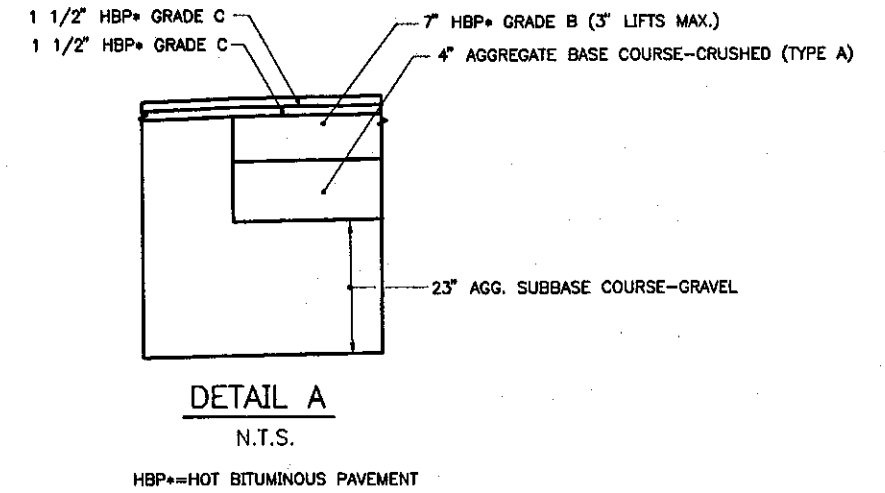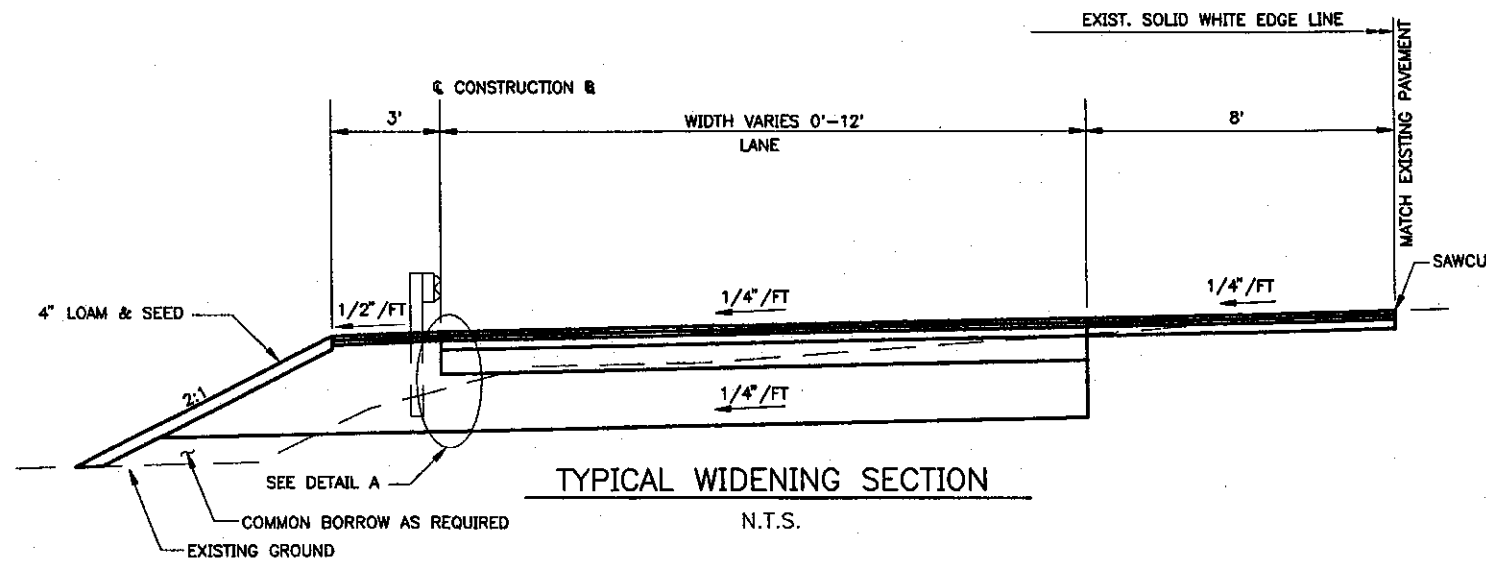

Maine Turnpike Authority
Maine Turnpike
 YORK TOLL PLAZA
 TOLL PLAZA MODIFICATIONS
 TYPICAL SECTIONS


Transpass
 ARCHITECTS ENGINEERS PLANNERS

Contract 99.4
 Sheet No. TS-1
 4 of 42

No.	Revision	By	Date	In Charge Of	RAL

Designed: RWB 2/99
 Drawn: WEF 2/99
 Checked: JVC 2/99
 In Charge Of: RAL

USE MANUFACTURERS INSTALLATION GUIDELINES FOR FLARE OFFSET

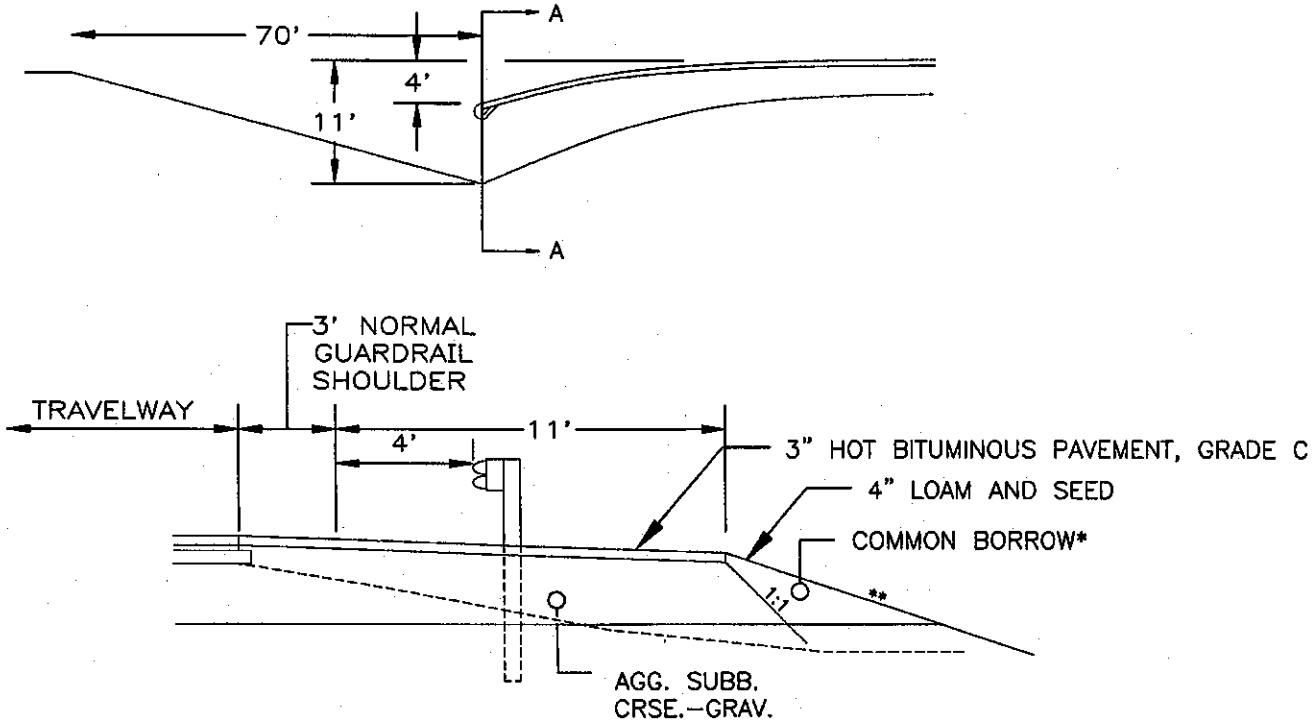


SECTION A-A

* ADJACENT OR AVAILABLE EXCAVATION SHALL BE USED INSTEAD OF COMMON BORROW UNLESS OTHERWISE DIRECTED BY THE ENGINEER.

** THIS SHALL BE A 4:1 SLOPE IN AREAS THAT ARE PRESENTLY 6:1. THE STEEPEST SLOPE SHALL BE 3:1 IN ALL OTHER AREAS.

WIDEN SHOULDER FOR GUARDRAIL 350 TERMINAL
NOT TO SCALE

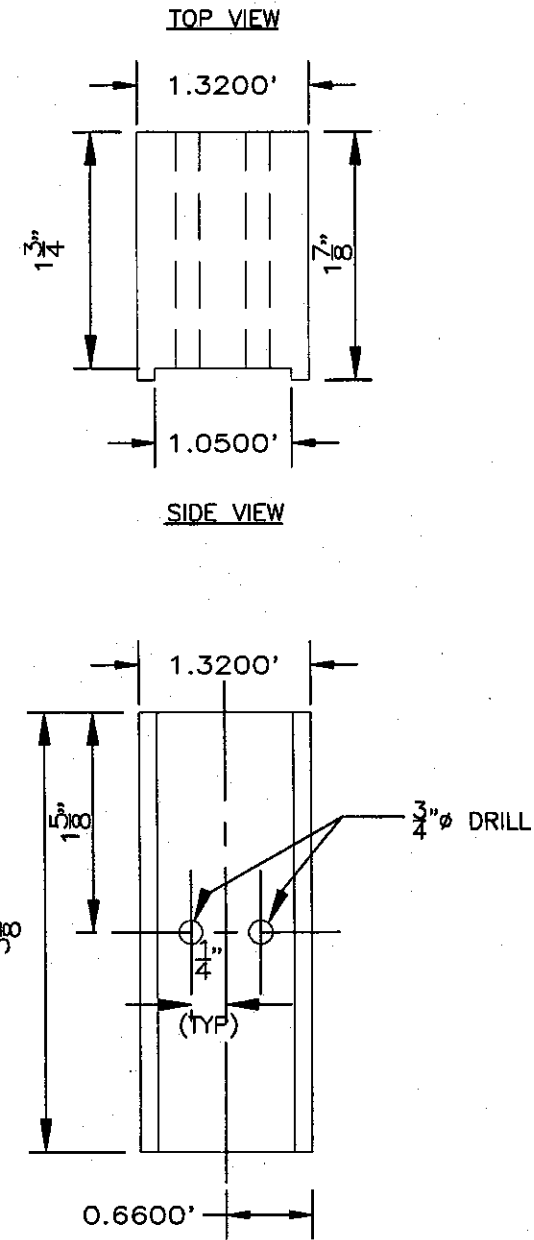

WOOD BLOCK DETAIL FOR STEEL POST
NOT TO SCALE

Maine Turnpike Authority
Maine Turnpike










YORK TOLL PLAZA
TOLL PLAZA MODIFICATIONS
MISCELLANEOUS DETAILS
SHEET 1

Transpass

HNTB
ARCHITECTS ENGINEERS PLANNERS

Contract 99.4 Sheet No. MD-1
5 of 42

No.	Revision	By	Date	In Charge Of

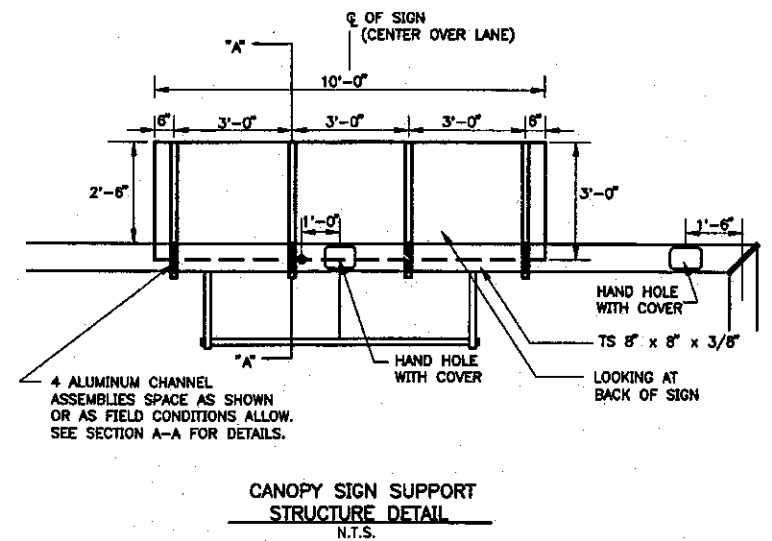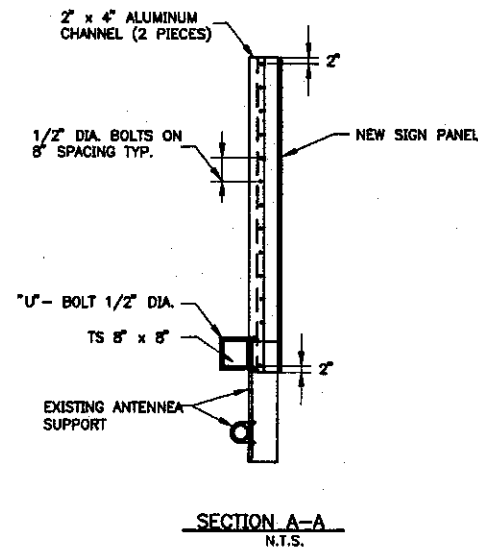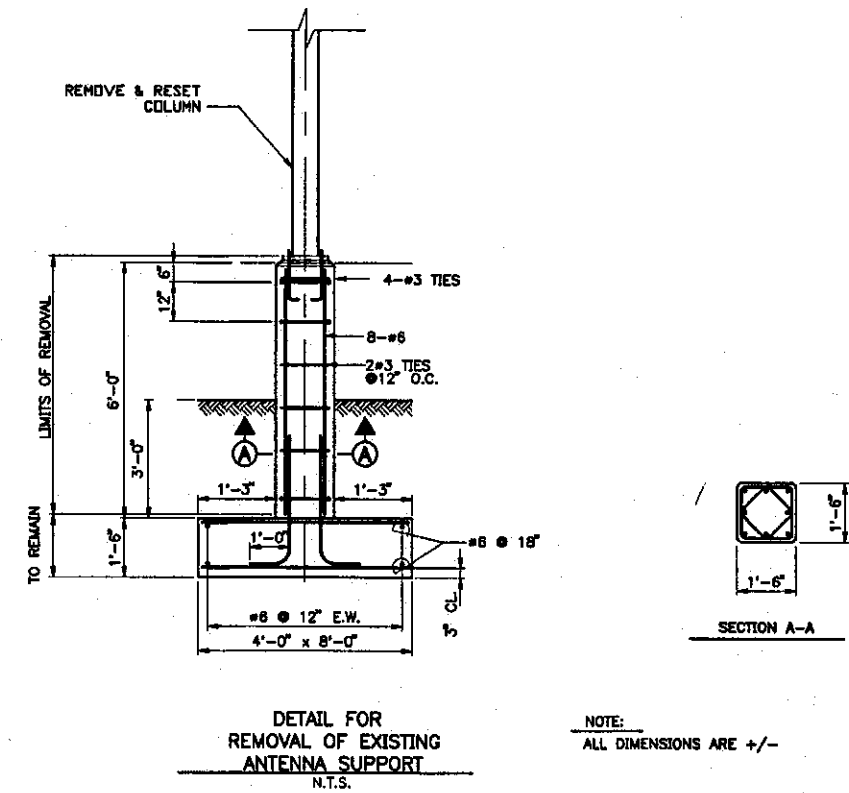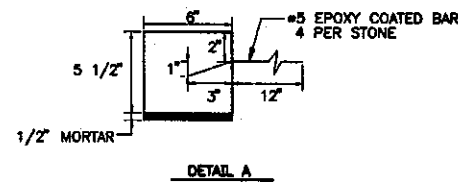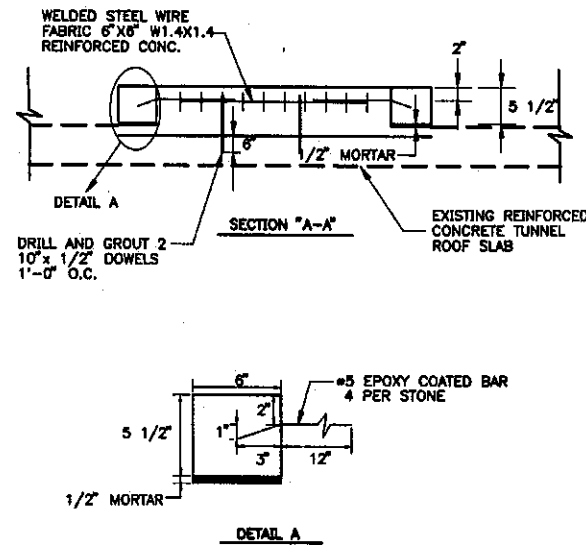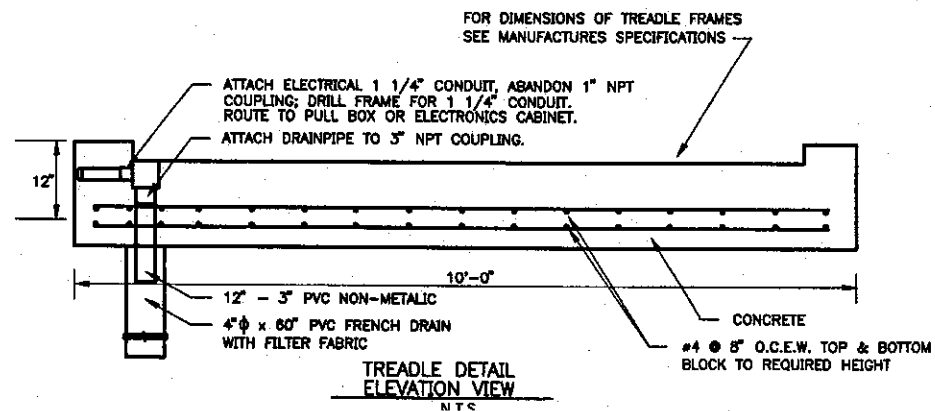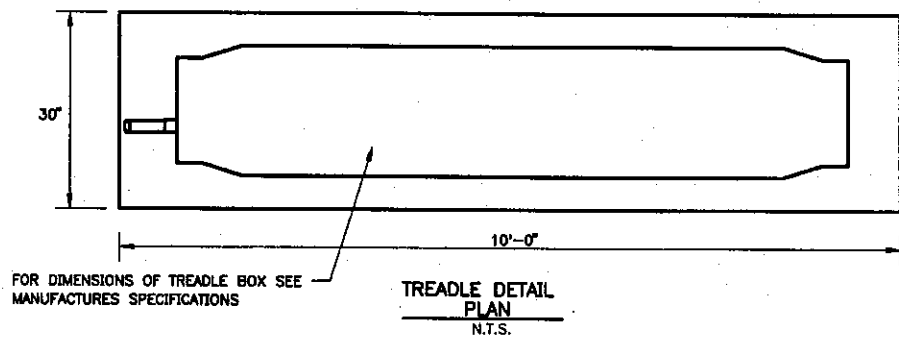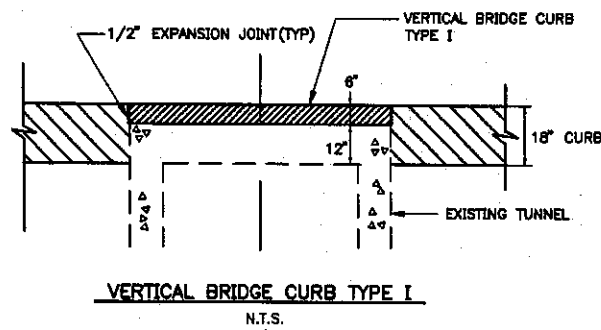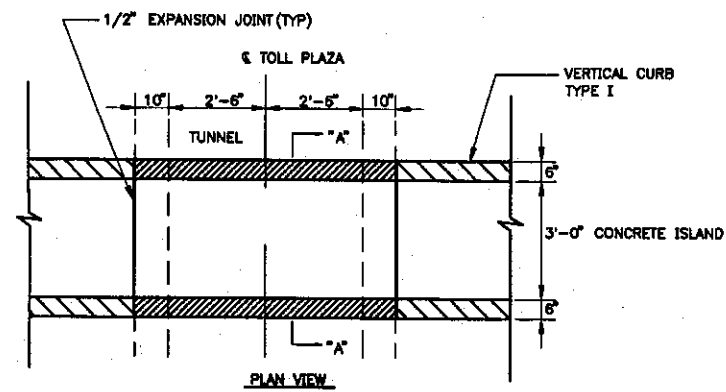

NOTES
 1. TREADLE FRAME TO BE SUPPLIED AND INSTALLED BY CONTRACTOR AS PER SPECS AND MANUFACTURES INSTALLATION INSTRUCTIONS.

NOTE: SIGN LIGHTING SHOWN ON SHEET E-1.


Maine Turnpike Authority
Maine Turnpike
 YORK TOLL PLAZA
 TOLL PLAZA MODIFICATIONS
 MISCELLANEOUS DETAILS
 SHEET 2

HNTB
 ARCHITECTS ENGINEERS PLANNERS


Contract 99.4
 Sheet No. MD-2
 6 of 42

No.	Revision	By	Date	In Charge Of
		Designed	RWB 2/99	
		Drawn	WEF 2/99	
		Checked	RWB 2/99	
				RAL


LIGHT STANDARDS ON WHICH BREAKAWAY COUPLINGS SHALL BE INSTALLED
ALL LIGHT STANDARD ON EAST SIDE OF TOLL PLAZA

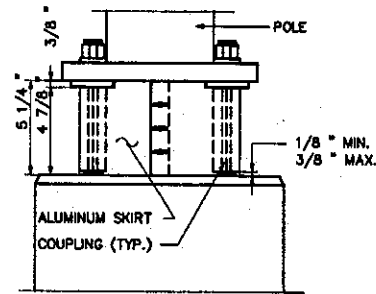


BREAKAWAY COUPLINGS AND SKIRT DETAIL
NOT TO SCALE

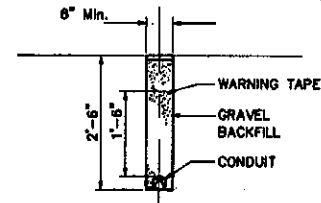


TRENCH CROSS SECTION
NOT TO SCALE

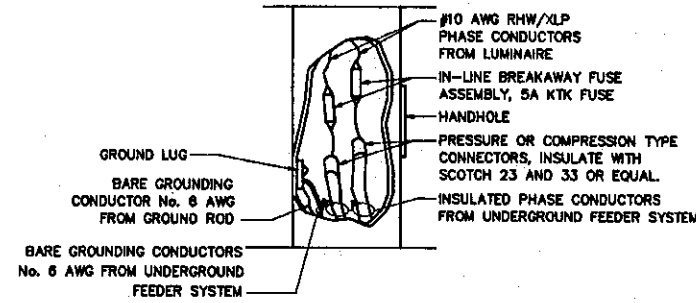

TYPICAL POLE WIRING DETAIL
NOT TO SCALE

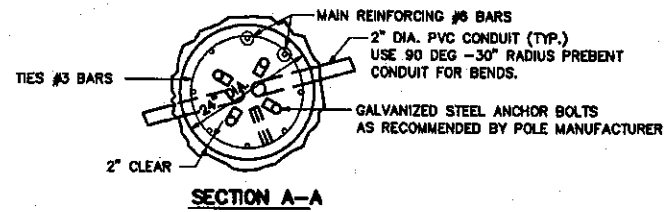


SECTION A-A

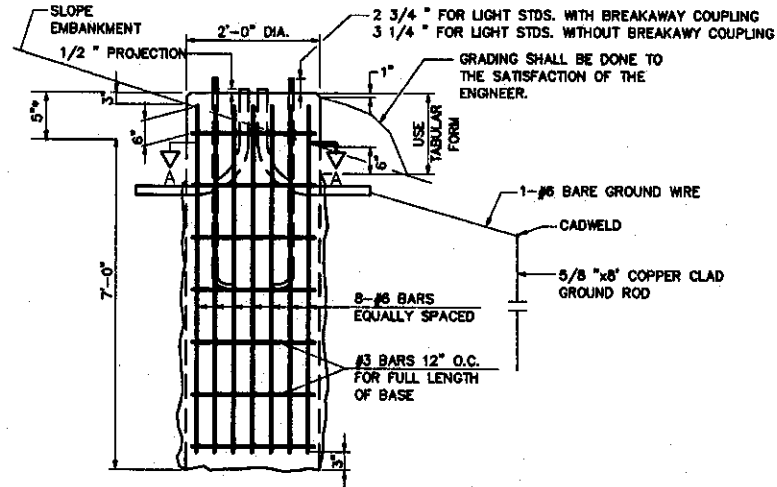


24 INCH FOUNDATION
NOT TO SCALE


NOTE:
SPICES IN BOX SHALL BE MADE WITH APPROPRIATE CONNECTORS AND TAPED WITH "SCOTCH 23 AND 33" OR EQUAL. PROVIDE ENOUGH SLACK IN THE WIRE TO ALLOW REMOVAL OF SPICES AND NEATLY ARRANGE WIRE IN BOX.

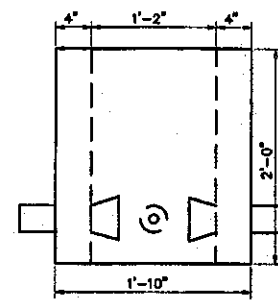


ELEVATION

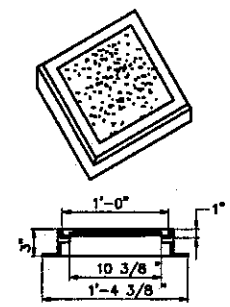

ELECTRICAL PULL BOX COVER

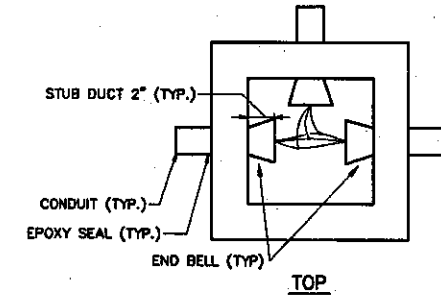


TOP

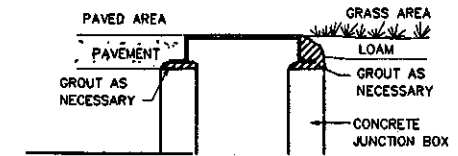


JUNCTION BOX COVER & FRAME

NOTE:
INSTALL JUNCTION BOXES ON GRADE, GROUT AS NECESSARY AS SHOWN ABOVE.

PRECAST CONCRETE JUNCTION BOX - PAY ITEM 626.11
NOT TO SCALE

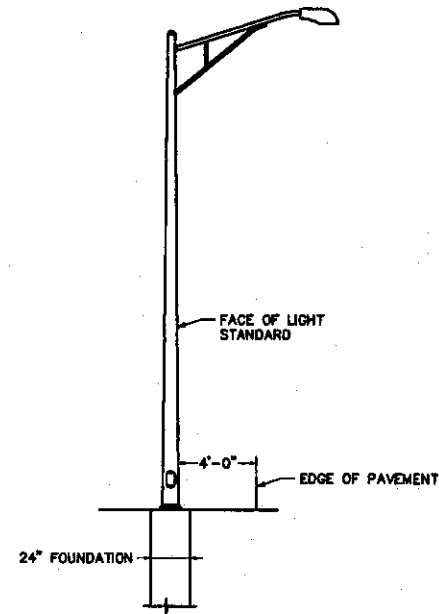

PLACEMENT OF LIGHT STANDARD BEHIND EDGE OF PAVEMENT

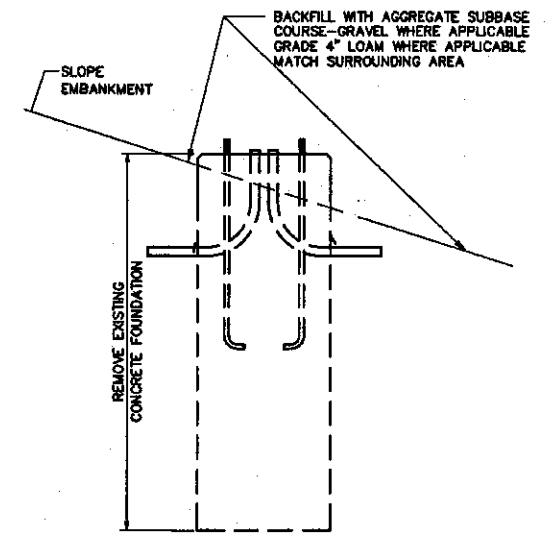

REMOVAL OF CONCRETE FOUNDATION
NOT TO SCALE

Maine Turnpike Authority
Maine Turnpike

YORK TOLL PLAZA
TOLL PLAZA MODIFICATIONS
MISCELLANEOUS DETAILS
SHEET 3





Transpass

HNTB
ARCHITECTS ENGINEERS PLANNERS

Contract 99.4 Sheet No. MD-3
7 of 42

By	Date
Designed RWB	2/99
Drawn WEF	2/99
Checked RWB	2/99
In Charge Of RAL	

(METPK) BDR-01

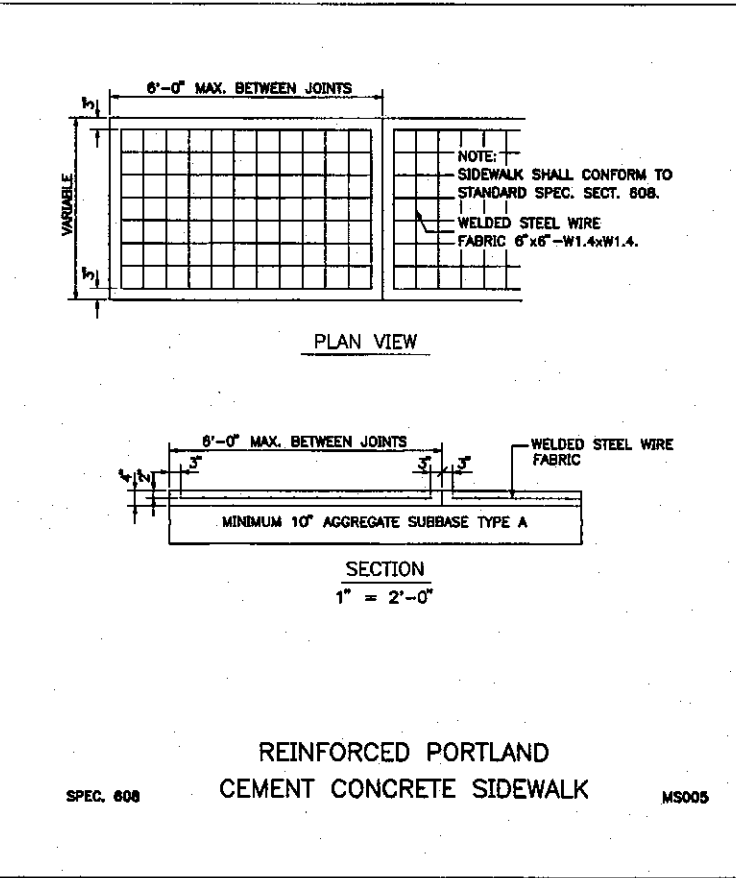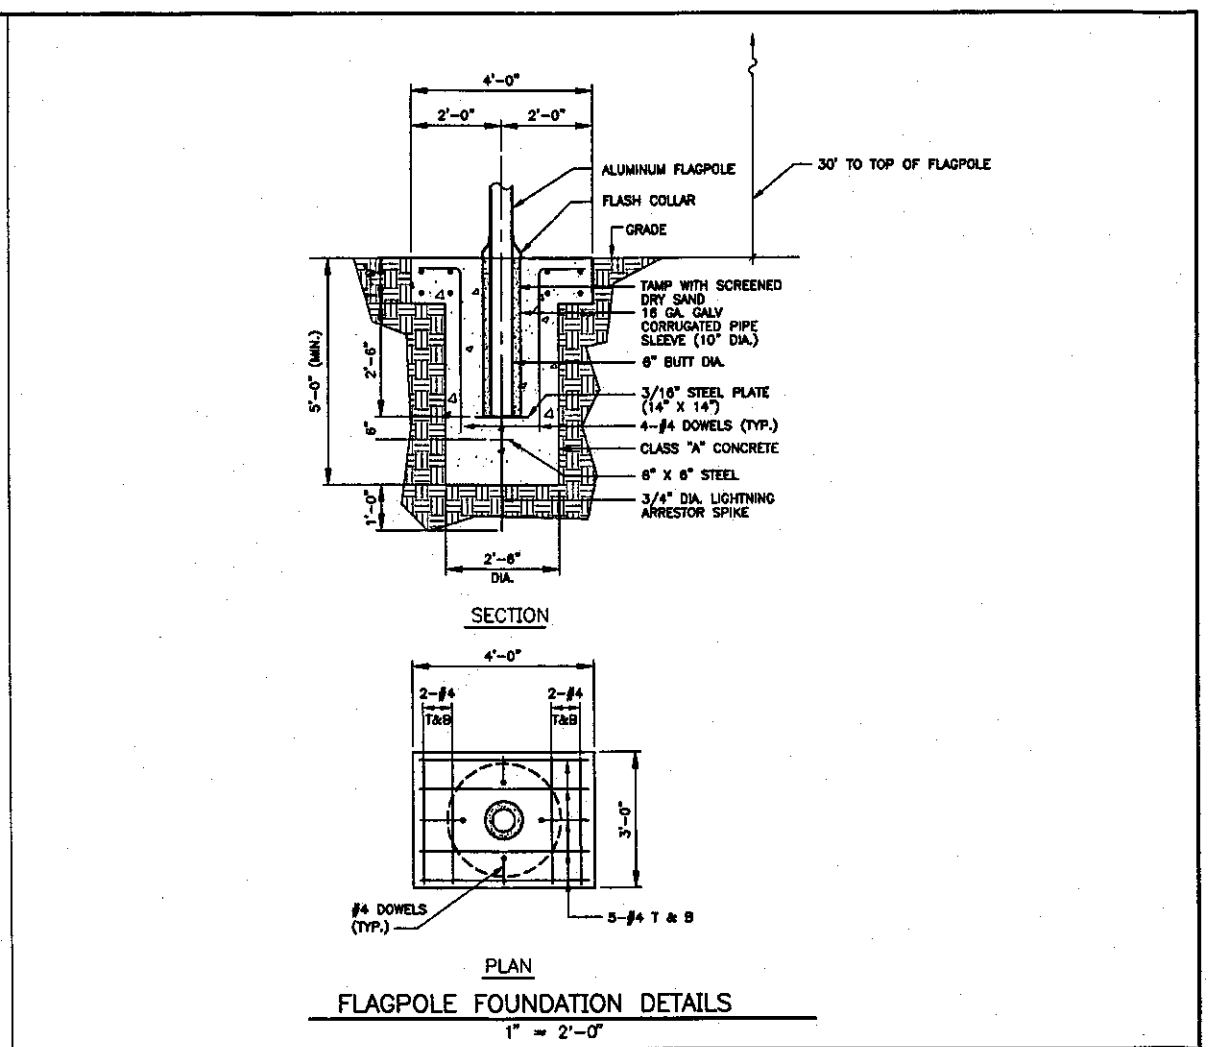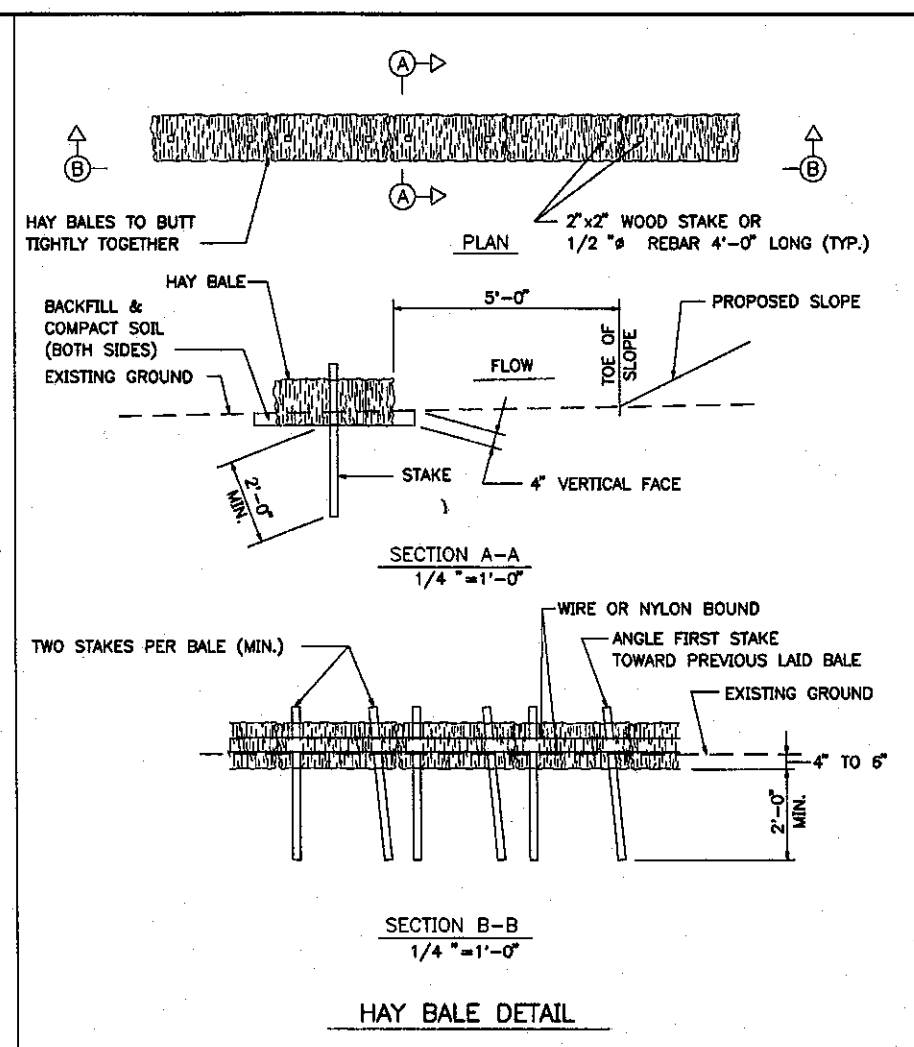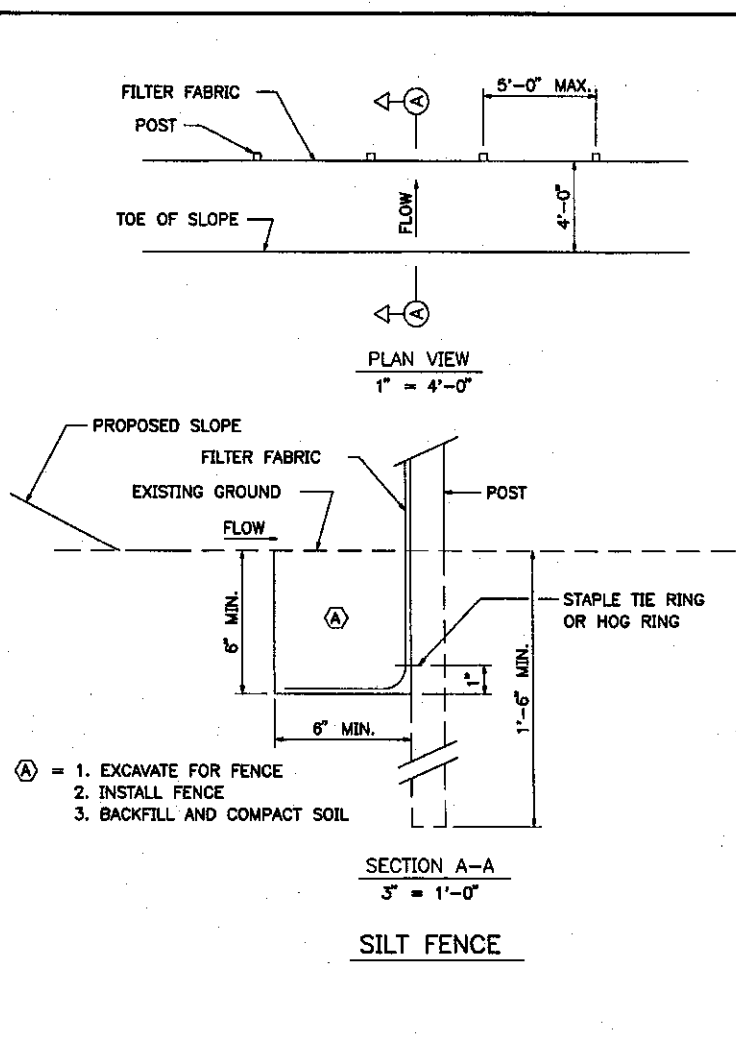

CURB TYPES 1 & 5 ON CURVES


TYP	RADIUS OF CURVE	LENGTH	PAID FOR AS	STONE IS CUT OR CAST
1	0' TO 60' INCL.	4' MIN.	CIRCULAR	ARC TO FIT CURVE
	OVER 60' TO 160'	4' TO 6'	STRAIGHT	STRAIGHT PIECES
5	0' TO 8' INCL.	2' MIN.	CIRCULAR	TO FIT CURVE
	OVER 8' TO 30' INCL	12' MIN. CHORD CIRCULAR	CIRCULAR	STR. PIECES, RADIAL ENDS
	OVER 30' & UNDER 180'	2' TO 3'	STRAIGHT	STRAIGHT PIECES
	180' AND OVER	3' TO 6'	STRAIGHT	STRAIGHT PIECES

TERMINAL SECTION TYPE "1"

TERMINAL SECTION TYPE "5"
(USE WHEN SHOWN ON PLANS ONLY)


TERMINAL CURB SECTION

SPEC. 609 CU001

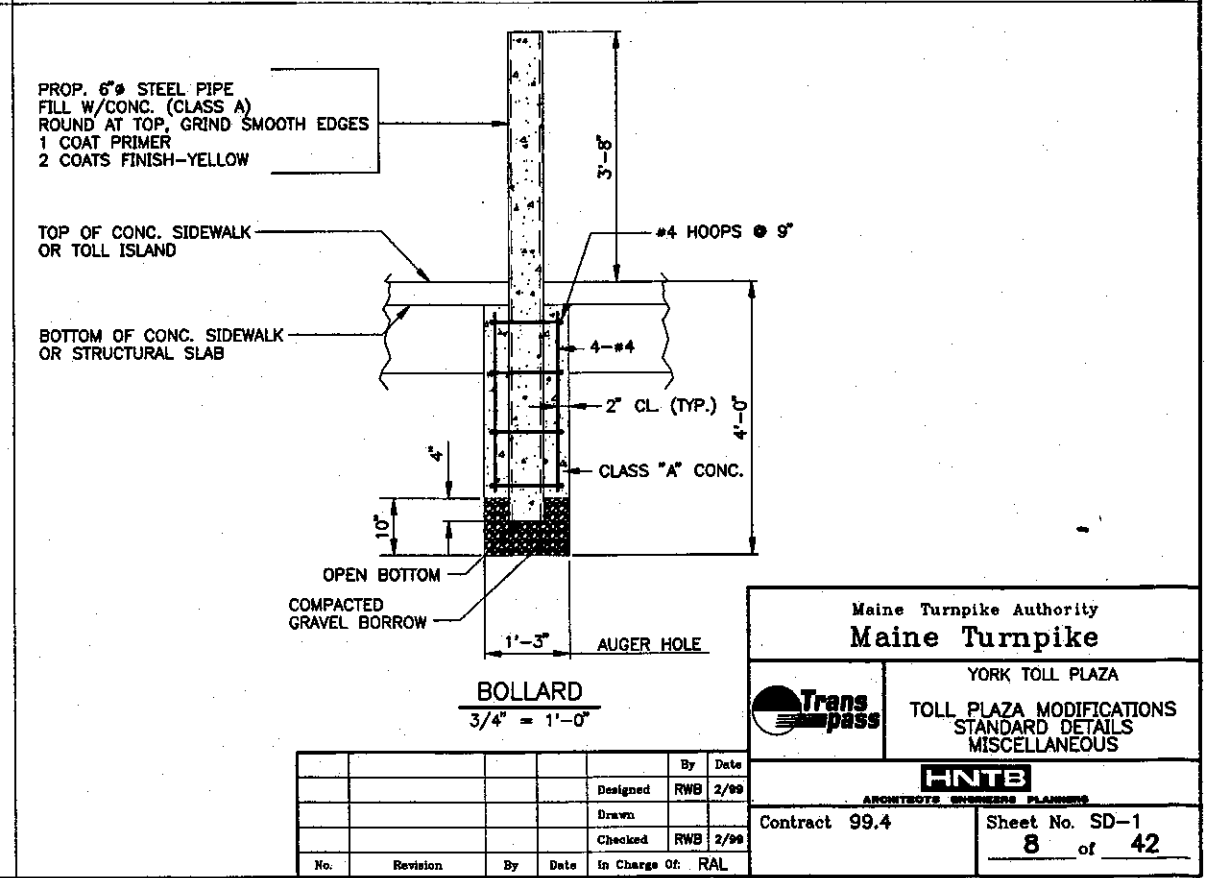

GENERAL NOTES

1. CATCH BASINS IN EXCESS OF 8' IN DEPTH SHALL, IF DIRECTED, BE PROVIDED WITH STEPS SIMILAR TO THOSE DETAILED FOR MANHOLES.
2. DRAIN HOLES IN PRECAST SUMPS SHALL BE NOT OVER 3" IN DIAMETER AND SHALL BE PLUGGED WITH MORTAR WHEN CONSTRUCTED.
3. ALL PRECAST SECTIONS OF LESS THAN 8" WALL THICKNESS SHALL HAVE TONGUE AND GROOVE JOINTS.
4. CONE AND RING SECTIONS SHALL HAVE A WALL THICKNESS OF 4" MINIMUM TO 8" MAXIMUM.
5. MINIMUM WALL THICKNESS AT THE SUMP SHALL BE 4" AS SPECIFIED IN A.S.T.M. C-478.
6. THE WALL AROUND INLET AND OUTLET PIPES SHALL BE A PRECAST RING WITH AN OPENING 2" LARGER THAN THE OUTSIDE DIAMETER OF THE PIPE.
7. LIFT HOLES SHALL BE PROVIDED.

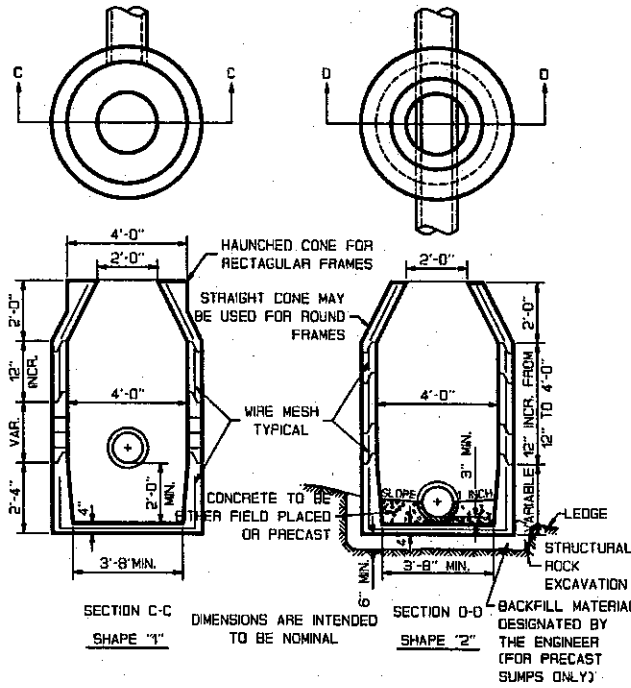



CATCH BASINS (PRECAST UNITS)

SPEC. 604

DR001

SPEC. 604


DR002

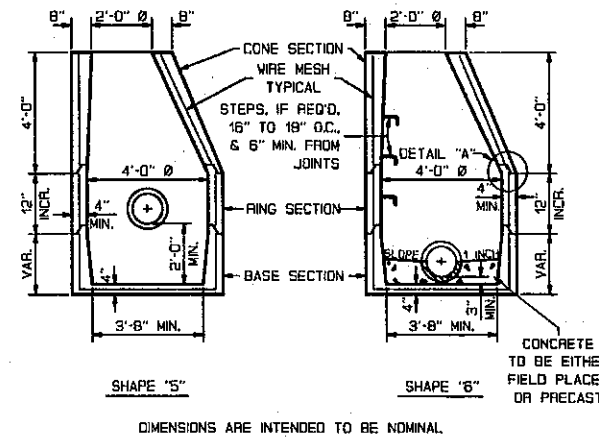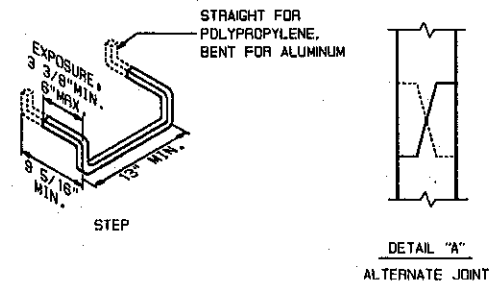

CATCH BASIN OR MANHOLE

SPEC. 604


DR003

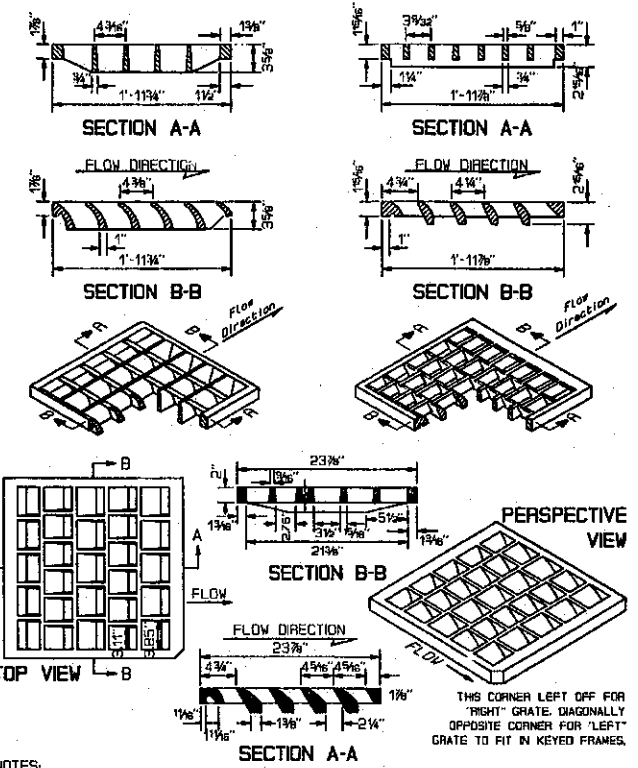

"CASCADE-TYPE" GRATES

SPEC. 604


DR004

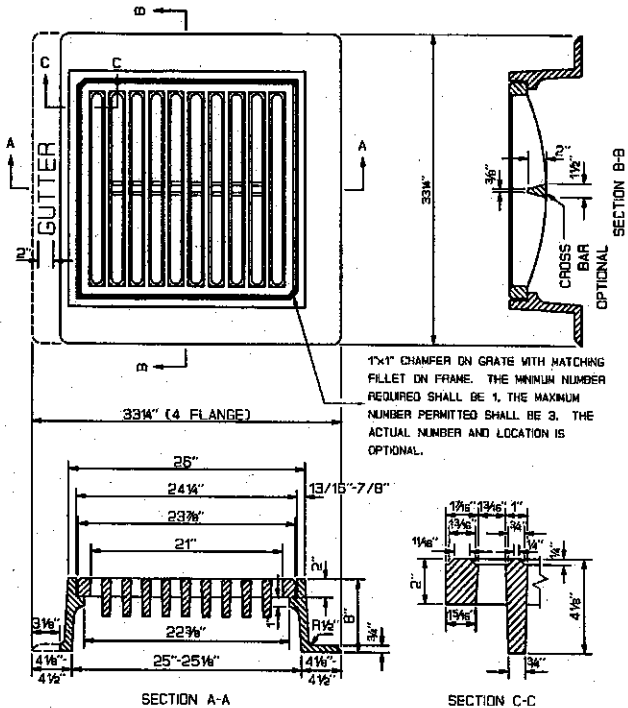

- NOTES:
1. TYPE "A" FRAMES ARE TO HAVE 3 FLANGES.
 2. TYPE "B" FRAMES ARE TO HAVE 4 FLANGES.
 3. THE WORD "GUTTER" IS TO BE MOLDED INTO THE BACK FLANGE-TYPE "B" ONLY.
 4. FRAMES AND GRATES ARE TO BE OF GRAY CAST IRON CONFORMING TO AASHTO M205, CLASS 50.
 5. DIMENSIONS ARE NOMINAL.

TYPE "A" & "B" CATCH BASIN TOPS

MEPK01A

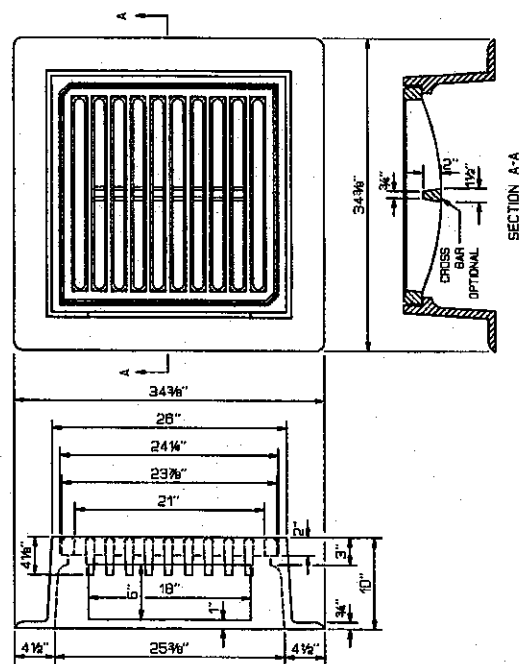


- NOTES:
1. OPEN THROAT SHALL BE CONSTRUCTED ON THE SIDE AWAY FROM THE DIRECTION OF TRAFFIC. ALL OTHER SIDES SHALL BE GRADED FLUSH WITH THE TOP OF THE CATCH BASIN GRATE.
 2. THE FRAME SHALL BE GRAY CAST IRON.
 3. THE GRATE SHALL BE THE SAME AS TYPES "A" AND "B".
 4. DIMENSIONS ARE INTENDED TO BE NOMINAL.

TYPE "C" CATCH BASIN TOPS

SPEC. 604

DR005

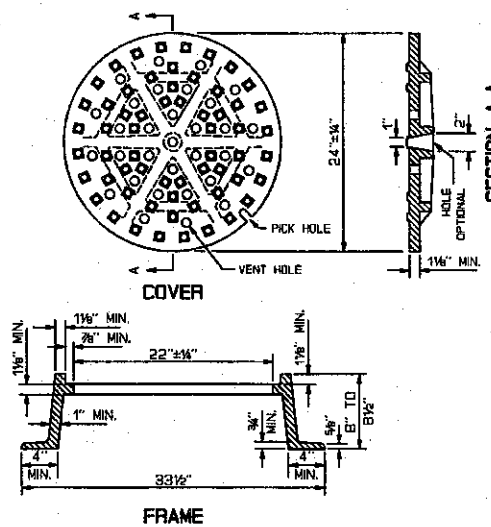


- NOTES:
1. MANHOLE FRAMES AND COVERS ARE TO BE MACHINED TO A SMOOTH FIT AND SHALL BE OF GRAY CAST IRON.
 2. DIAMOND TOP SURFACE IS OPTIONAL.

MANHOLE TOP "D"

SPEC. 604

DR007

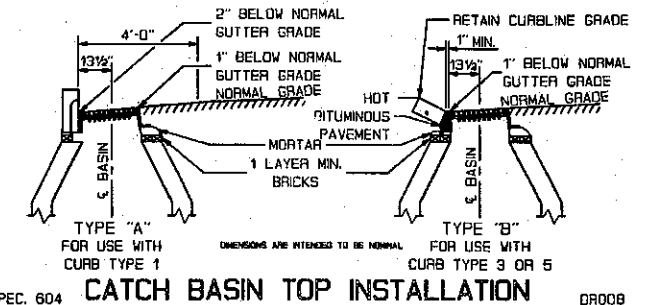

- NOTES:
1. THESE DETAILS COPIED FROM MAINE DEPARTMENT OF TRANSPORTATION STANDARD DETAILS SHEETS.
 2. USE ONLY THOSE ITEMS CALLED FOR ON THE DESIGN DRAWINGS.
 3. IN CASE OF CONFLICT BETWEEN THESE STANDARD DETAILS AND THE DESIGN DRAWINGS, THE REQUIREMENTS OF THE DESIGN DRAWINGS SHALL BE FOLLOWED.

CATCH BASIN TOP INSTALLATION

SPEC. 604

DR008

Maine Turnpike Authority
Maine Turnpike



STANDARD DETAILS
TYPE A, B & C CATCH BASINS
AND MANHOLES




Contract 99.4

Sheet No. SD-2


9 of 42

By: _____	Date: _____
Designed _____	
Drawn _____	
Checked _____	
In charge of: _____	

CURB TYPES 1 & 5 ON CURVES				
TYPE	RADIUS OF CURVE	LENGTH	PAID FOR AS	STONE IS CUT OR CAST
1	0' TO 60' INCL.	4' MIN.	CIRCULAR	ARC TO FIT CURVE
2	OVER 60' TO 160'	4' TO 6'	STRAIGHT	STRAIGHT PIECES
5	0' TO 8' INCL.	2' MIN.	CIRCULAR	TO FIT CURVE
	OVER 8' TO 30' INCL.	12" MIN. CHORD	CIRCULAR	STR. PIECES, RADIAL ENDS
	OVER 30' & UNDER 160'	2' TO 3'	STRAIGHT	STRAIGHT PIECES
	160' AND OVER	3' TO 6'	STRAIGHT	STRAIGHT PIECES

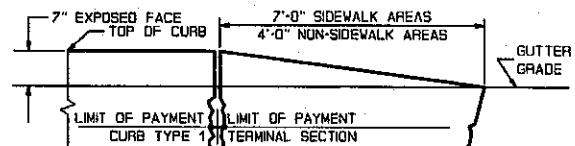


TERMINAL SECTION TYPE "1"

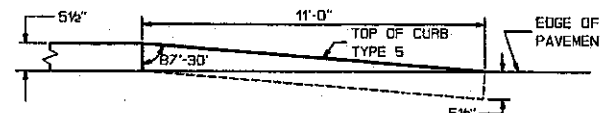


TERMINAL SECTION TYPE "5"
(USE WHEN SHOWN ON PLANS ONLY)

SPEC. 609 TERMINAL CURB SECTION CU001

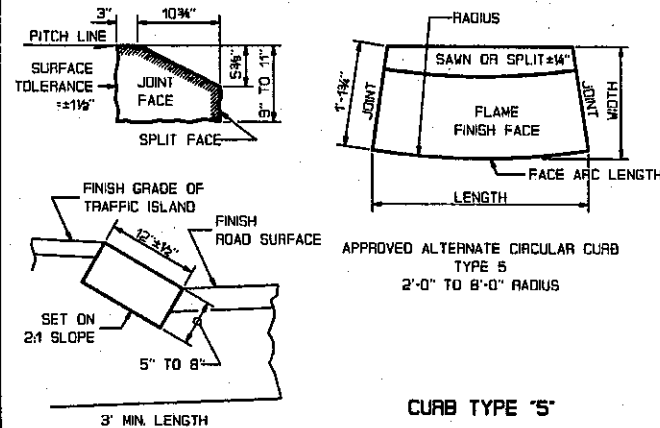


CURB TYPE "5"

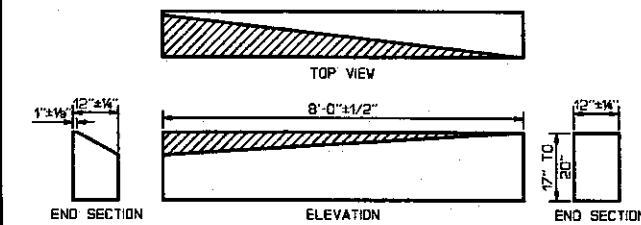


TRANSITION SECTION "B"
CURB TYPE "5" TO VERTICAL CURB TYPE "1"



SPEC. 609 CURB TRANSITION CU002

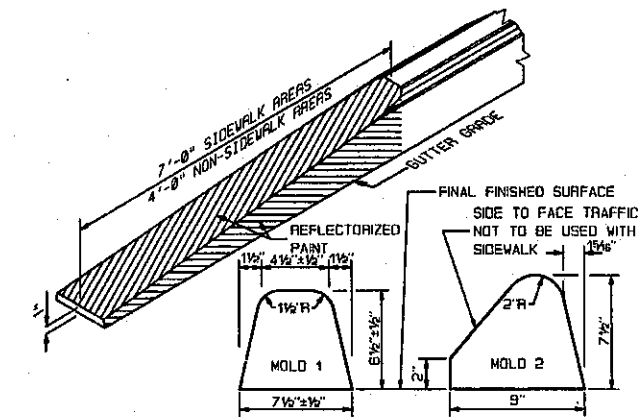

CURB MOLD 2 WILL BE USED IN ALL SITUATIONS EXCEPT FOR WHERE THE CURB FORMS THE EDGE OF THE SIDEWALK. MOLD 1 SHALL BE USED IN CONJUNCTION WITH SIDEWALKS OR WHERE THERE IS A POTENTIAL FOR SIDEWALKS.

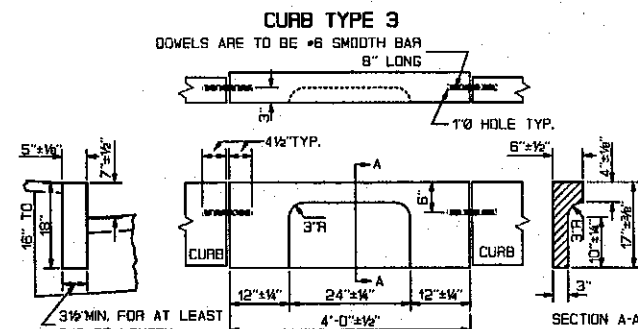


SPEC. 609 CURB CU003

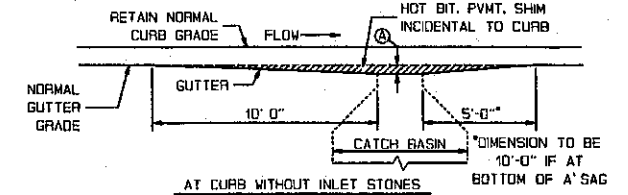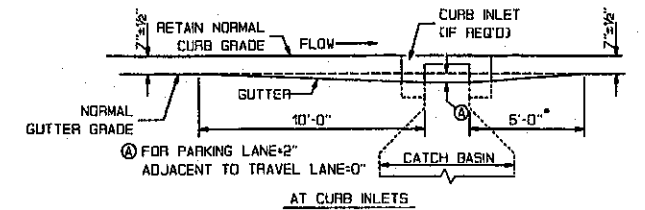


NOTE: GRATES SHALL BE INSTALLED ON GRADIENT OF THE GUTTER AND BE DEPRESSED 2" BELOW THE NORMAL GUTTER GRADE UNLESS THIS DEPRESSION INTERFERES WITH TRAFFIC.

SPEC. 609 GUTTER GRADE TRANSITION AT CATCH BASIN CU004

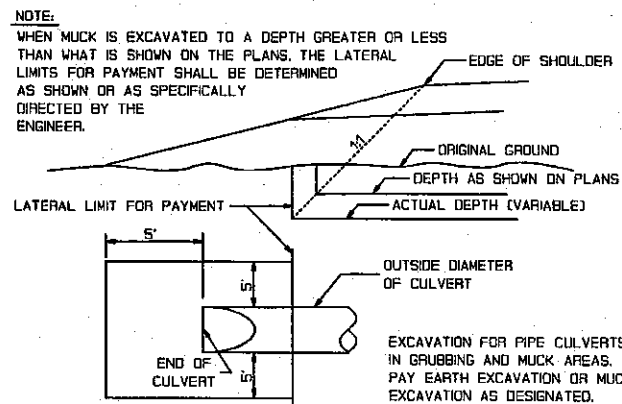


MUCK EXCAVATION PAY LIMITS

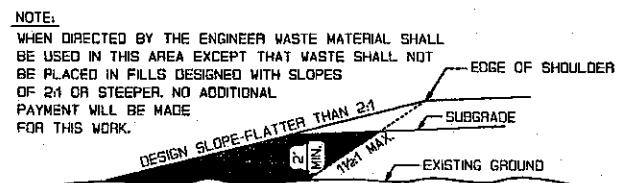

DISPOSAL OF WASTE MATERIALS
(WASTE STORAGE AREA)


SPEC. 209 MUCK EXCAVATION AND WASTE DISPOSAL MS001

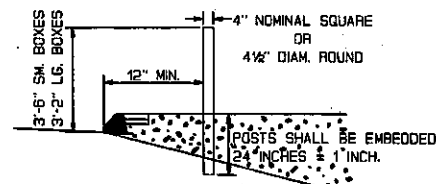

SINGLE WOOD POST
MAILBOX POSTS


SPEC. 606 MS003

- NOTES:
- THESE DETAILS COPIED FROM MAINE DEPARTMENT OF TRANSPORTATION STANDARD DETAILS SHEETS.
 - USE ONLY THOSE ITEMS CALLED FOR ON THE DESIGN DRAWINGS.
 - IN CASE OF CONFLICT BETWEEN THESE STANDARD DETAILS AND THE DESIGN DRAWINGS, THE REQUIREMENTS OF THE DESIGN DRAWINGS SHALL BE FOLLOWED.

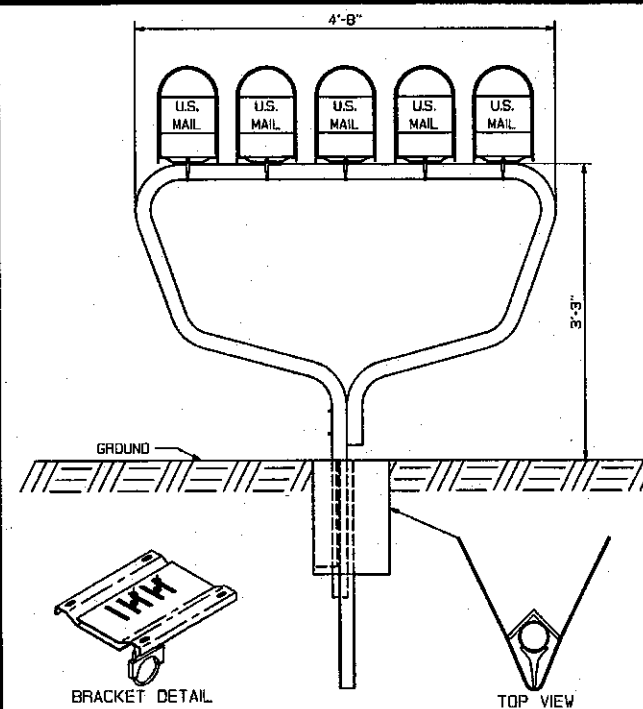

ITEM NO. 60651
MULTIPLE MAILBOX SUPPORT

MS004

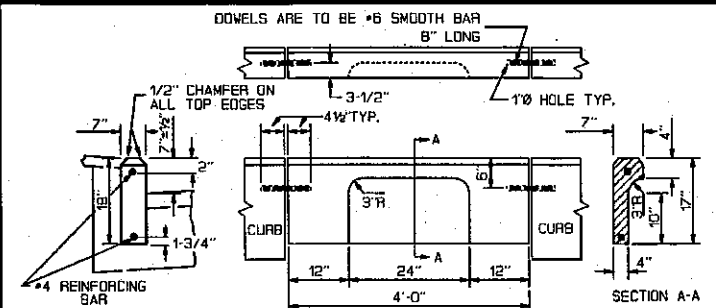

SPEC. 609 VERTICAL CURB TYPE 2 CURB CU006

Maine Turnpike Authority
Maine Turnpike


STANDARD DETAILS
CURBING, MUCK EXCAVATION
AND WASTE DISPOSAL
& MAILBOX POST ASSEMBLIES

Contract 99.4 Sheet No. SD-3
10 of 42


ARCHITECTS ENGINEERS PLANNERS

No.	Revision	By:	Date:	In charge of:
		Designed		
		Drawn		
		Checked		

(METPK BDR-01)

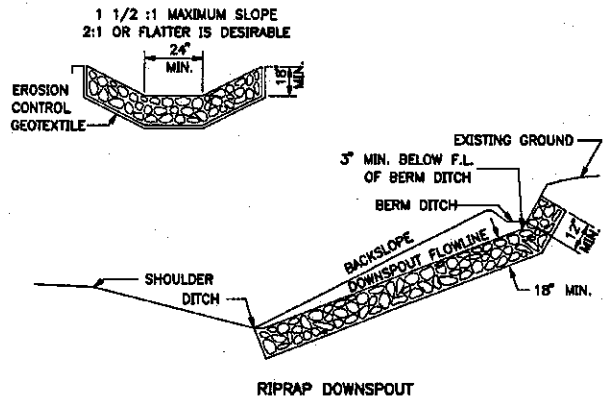

RIPRAP DOWNSPOUT

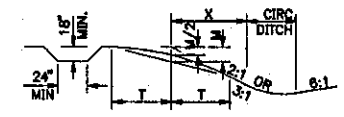

BERM DITCH

CONSTRUCT BERM DITCH AS SHOWN ON THE PLANS OR AS DIRECTED BY THE ENGINEER. WHERE A 2:1 SLOPE IS NOT PRACTICAL, USE A 1-1/2:1 SLOPE.



WHERE "X"=5 OR LESS, "T"=X, OTHERWISE "T"=5. TO AVOID PROPERTY DAMAGE AND TO SAVE SHADE TREES, THIS FORMULA MAY BE MODIFIED BY THE ENGINEER.

FOR ALL SECTIONS, THE DEPTH OF DITCH DEPENDS ON LOCAL CONDITIONS.

RIPRAP DOWNSPOUTS AND BERM DITCHES

SPEC. 610



ER001

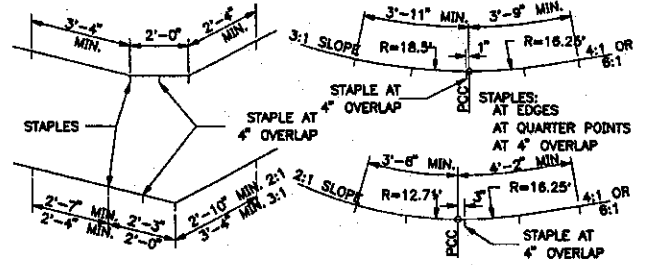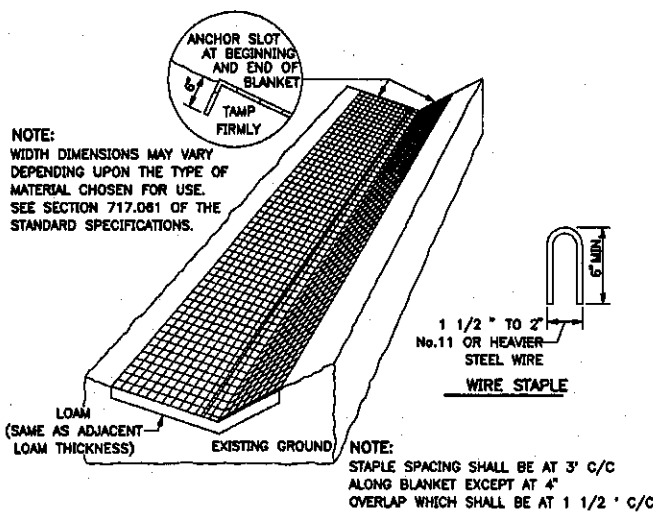

TEMPORARY EROSION CONTROL BLANKET

SPEC. 613



ER002

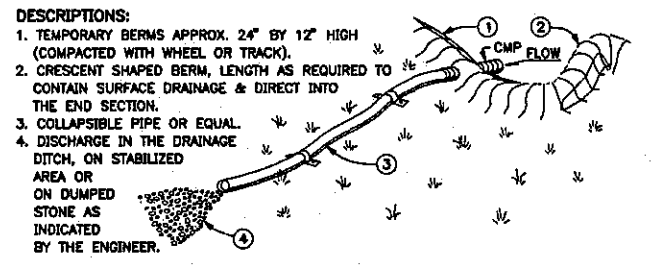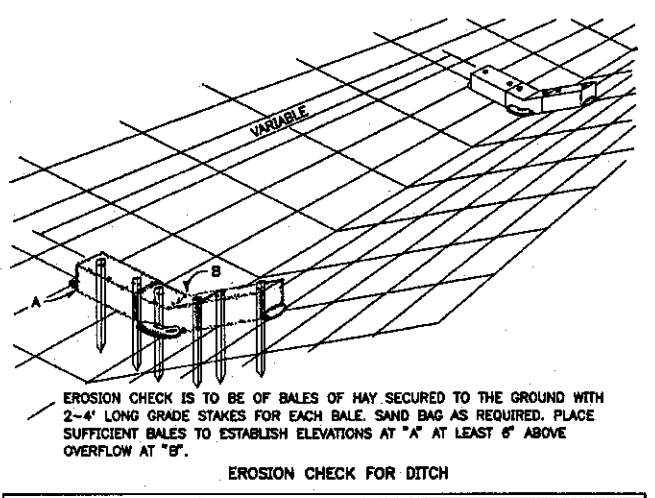

TEMPORARY BERM AND SLOPE DRAIN

SPEC. 656


ER003

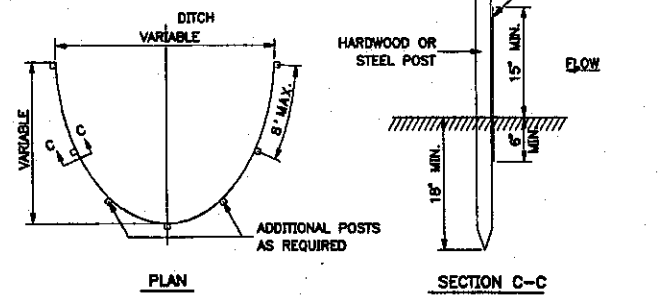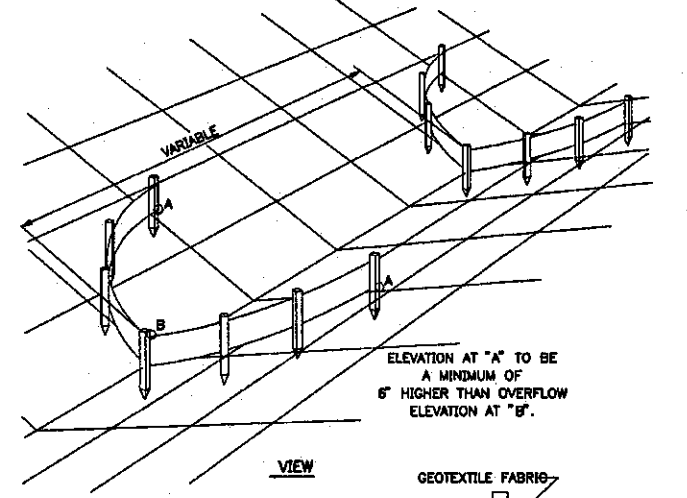

TEMPORARY SILT FENCE


SPEC. 658

ER004

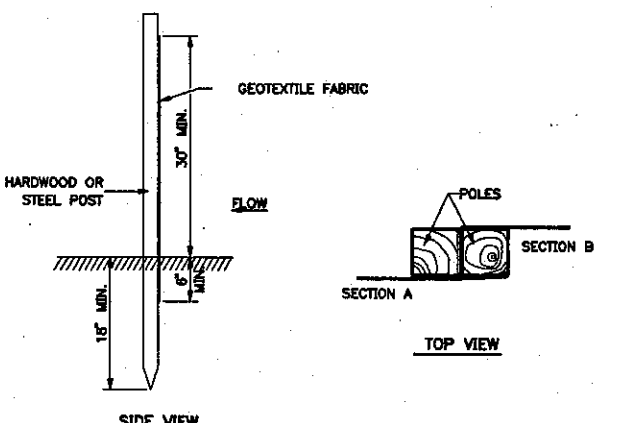

DEPENDENT UPON CONFIGURATION, ATTACH GEOTEXTILE TO WIRE MESH WITH HOG RINGS, TO STEEL POSTS WITH TIE WIRES, AND TO WOOD POSTS WITH STAPLES.

POSTS MAY BE WIRED TOGETHER WHEN JOINING SECTIONS.

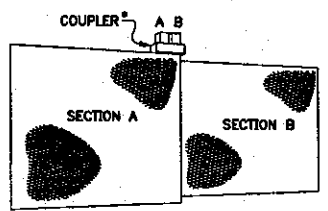


THE COUPLER CAN BE ANY ACCEPTABLE DEVICE USED TO TIE THE POLES TOGETHER.

TEMPORARY SILT FENCE

SPEC. 656

ER005

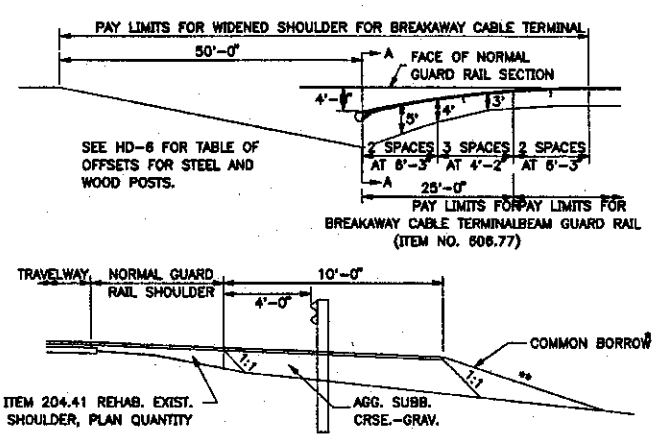

ADJACENT OR AVAILABLE EXCAVATION SHALL BE USED INSTEAD OF COMMON BORROW UNLESS OTHERWISE DIRECTED BY THE ENGINEER.


THIS SHALL BE A 4:1 SLOPE IN AREAS THAT ARE PRESENTLY 6:1. THE STEEPEST SLOPE SHALL BE 3:1 IN ALL OTHER AREAS.

NOTE: WIDENED SHOULDER FOR BREAKAWAY CABLE TERMINAL, WHEN REQUIRED, WILL BE PAID FOR UNDER ITEM 606.751 COMPLETE IN PLACE WHICH PRICE SHALL BE FULL PAYMENT FOR FURNISHING AND PLACING, GRADING AND COMPACTION OF AGGREGATE SUBBASE, COMMON BORROW, SEED AND MULCH. THE HOT BITUMINOUS PAVEMENT WILL BE PAID FOR UNDER THE APPLICABLE PAVEMENT ITEM.

ITEM NO. 606.751
DETAIL OF WIDENED SHOULDER FOR BREAKAWAY CABLE TERMINAL

SPEC. 606

GR001

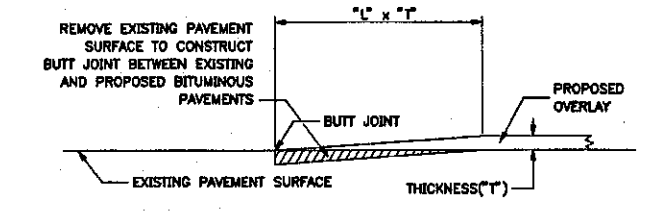

DESIGN OR POSTED SPEED=	65	55	50	45	40	35	30	25
"L" IN FEET/INCH OF THICKNESS=	65	55	50	45	40	35	30	25

NOTES: 1. THE ABOVE LENGTHS ARE INTENDED FOR PROFILE GRADES OF 2% OR LESS. WHEN PROFILE GRADES ARE GREATER THAN 2% "L" MAY BE ADJUSTED TO SUIT FIELD CONDITIONS WHEN DIRECTED BY THE ENGINEER.

2. WHEN CONSTRUCTING BUTT JOINTS AT INTERSECTIONS OR RAMP "L" SHALL BE 15/16 INCH OF THICKNESS UNLESS OTHERWISE DIRECTED BY THE ENGINEER.

3. SPECIAL ATTENTION SHALL BE PAID TO CURB SECTIONS TO ASSURE PROPER DRAINAGE AND THAT THERE ARE NO FLAT AREAS. "L" MAY BE ADJUSTED TO SUIT FIELD CONDITIONS WHEN DIRECTED BY THE ENGINEER.

PAVEMENT OVERLAY
BUTT JOINT DETAIL (ROADWAYS)

SPEC. 202

PV001

NOTES:

- THESE DETAILS COPIED FROM MAINE DEPARTMENT OF TRANSPORTATION STANDARD DETAILS SHEETS.
- USE ONLY THOSE ITEMS CALLED FOR ON THE DESIGN DRAWINGS.
- IN CASE OF CONFLICT BETWEEN THESE STANDARD DETAILS AND THE DESIGN DRAWINGS, THE REQUIREMENTS OF THE DESIGN DRAWINGS SHALL BE FOLLOWED.

Maine Turnpike Authority
Maine Turnpike

YORK TOLL PLAZA
TOLL PLAZA MODIFICATIONS
STANDARD DETAILS
MISCELLANEOUS

Transpass


HNTB
ARCHITECTS ENGINEERS PLANNERS

Contract 99.4

Sheet No. SD-4
11 of 42

By	Date
Designed JVC	2/99
Drawn JVC	2/99
Checked RWB	3/99
In Charge Of RAL	

(METPK)BDR-01

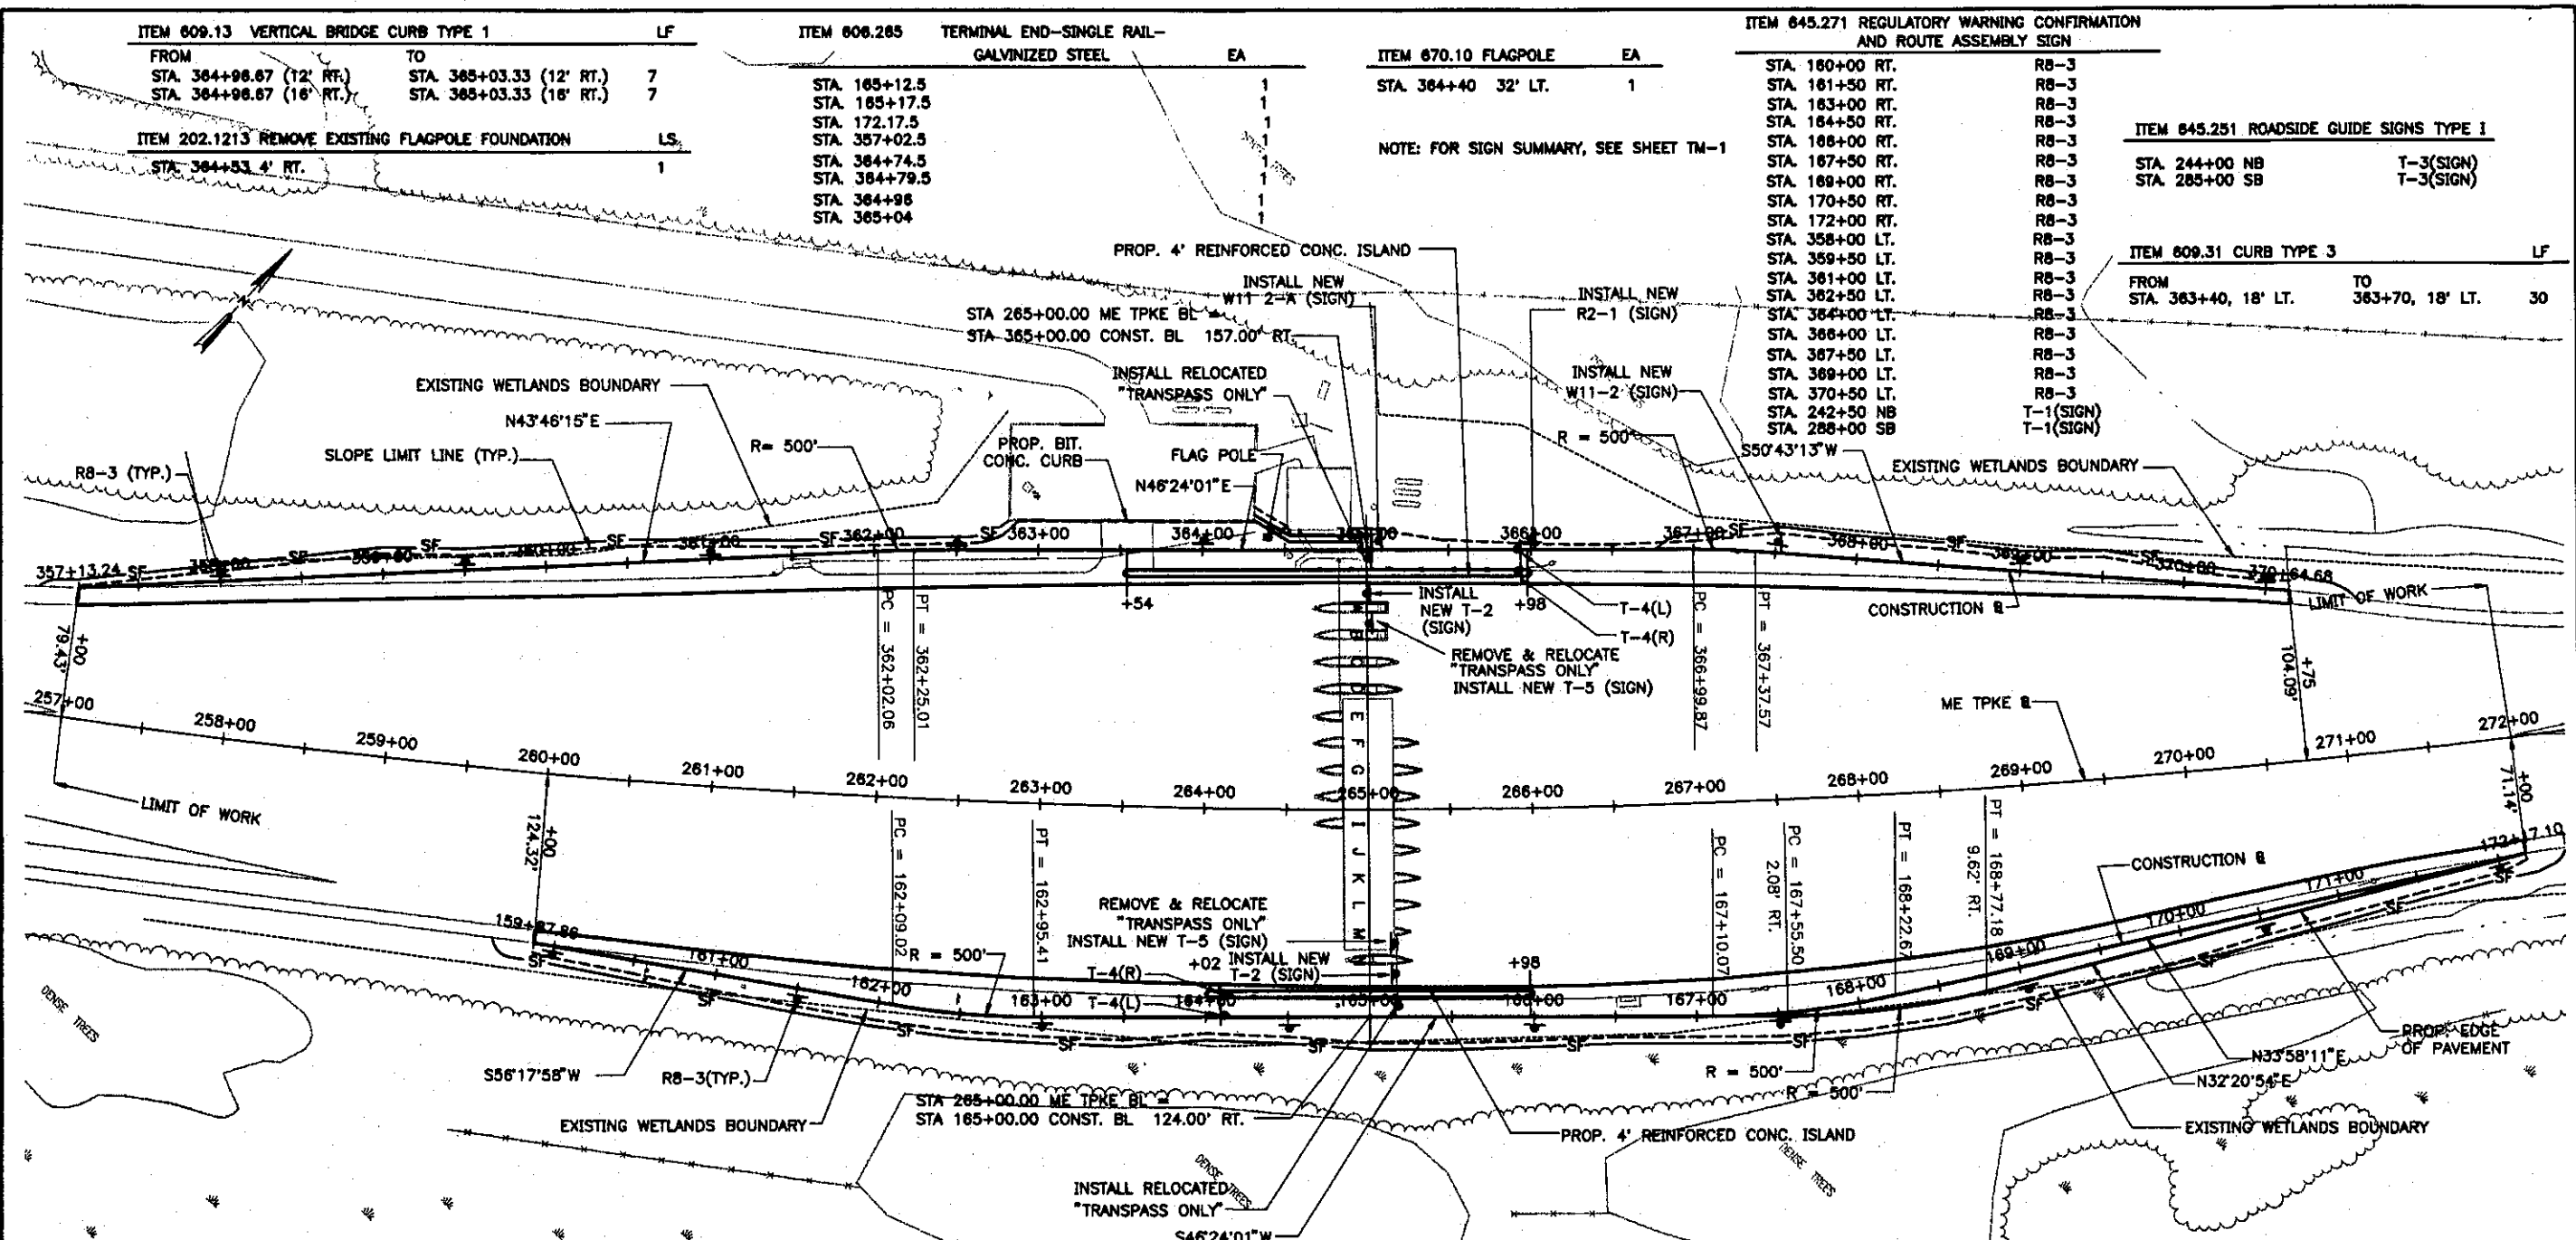

ITEM 609.13 VERTICAL BRIDGE CURB TYPE 1			LF
FROM	TO		
STA. 364+96.67 (12' RT.)	STA. 365+03.33 (12' RT.)	7	
STA. 364+96.67 (16' RT.)	STA. 365+03.33 (16' RT.)	7	

ITEM 606.265 TERMINAL END-SINGLE RAIL-GALVANIZED STEEL			EA
STA. 165+12.5			1
STA. 185+17.5			1
STA. 172+17.5			1
STA. 357+02.5			1
STA. 364+74.5			1
STA. 364+79.5			1
STA. 364+96			1
STA. 365+04			1

ITEM 670.10 FLAGPOLE			EA
STA. 364+40	32' LT.		1

ITEM 645.271 REGULATORY WARNING CONFIRMATION AND ROUTE ASSEMBLY SIGN			
STA. 180+00 RT.			R8-3
STA. 181+50 RT.			R8-3
STA. 183+00 RT.			R8-3
STA. 184+50 RT.			R8-3
STA. 186+00 RT.			R8-3
STA. 187+50 RT.			R8-3
STA. 189+00 RT.			R8-3
STA. 170+50 RT.			R8-3
STA. 172+00 RT.			R8-3
STA. 358+00 LT.			R8-3
STA. 359+50 LT.			R8-3
STA. 361+00 LT.			R8-3
STA. 362+50 LT.			R8-3
STA. 364+00 LT.			R8-3
STA. 364+00 LT.			R8-3
STA. 366+00 LT.			R8-3
STA. 367+50 LT.			R8-3
STA. 369+00 LT.			R8-3
STA. 370+50 LT.			R8-3
STA. 242+50 NB			T-1(SIGN)
STA. 288+00 SB			T-1(SIGN)

ITEM 645.251 ROADSIDE GUIDE SIGNS TYPE 1		
STA. 244+00 NB		T-3(SIGN)
STA. 285+00 SB		T-3(SIGN)

ITEM 609.31 CURB TYPE 3			LF
FROM STA. 363+40, 18' LT.	TO STA. 363+70, 18' LT.		30

ITEM 606.24 GUARDRAIL TYPE 36-SINGLE RAIL			LF
STA. 160+12.5	STA. 165+12.5		500
STA. 165+17.5	STA. 172+17.5		700
STA. 357+02.5	STA. 364+74.5		772
STA. 364+79.5	STA. 364+96		16.5
STA. 365+04	STA. 370+54		550

ITEM 609.12 VERTICAL CURB TYPE T-CIRCULAR			LF
STA. 164+02 (12' LT.)	STA. 164+02 (18' LT.)		7
STA. 165+98 (12' LT.)	STA. 165+98 (18' LT.)		7
STA. 363+54 (12' RT.)	STA. 363+54 (18' RT.)		7
STA. 365+98 (12' RT.)	STA. 365+98 (18' RT.)		7

ITEM 606.3691 GUARDRAIL REMOVED AND STACKED			LF
STA. 364+84.5 LT.	STA. 364+77 LT.		12.5
STA. 364+80 LT.	STA. 364+96 LT.		16
STA. 365+04 LT.	STA. 366+16.5 LT.		112.5

ITEM 606.363 GUARDRAIL REMOVED AND DISPOSED			LF
STA. 163+80.2 RT.	STA. 165+17.5 RT.		137.5
STA. 165+20.5 RT.	STA. 165+33 RT.		12.5
STA. 165+79	LIGHT POLE		12.5
STA. 167+40	LIGHT POLE		12.5
STA. 171+22	LIGHT POLE		12.5


ITEM 606.79 GUARDRAIL 350 FLARED TERMINAL			EA
STA. 370+54	STA. 370+91.5		1
STA. 159+75	STA. 160+12.5		1

ITEM 656.632 30' TEMPORARY SILT FENCE			LF
STA. 159+05 (10' RT.)	STA. 172+42 (10' RT.)		1337
STA. 356+88 (10' LT.)	STA. 362+82 (18' LT.)		584
STA. 366+75 (16' LT.)	STA. 371+65 (10' LT.)		490

ITEM 645.105 REMOVE AND STACK REGULATORY WARNING AND ROUTE MARKER ASSEMBLY SIGNS			EA
STA. 363+75 13' LT.			1
STA. 363+75 5' RT.			1
STA. 364+08 5' RT.			1
STA. 162+50 7' LT.			1

ITEM 609.11 VERTICAL CURB TYPE 1			LF
STA. 164+02 (12' LT.)	STA. 164+96.67 (12' LT.)		95
STA. 165+03.33 (12' LT.)	STA. 155+98 (12' LT.)		95
STA. 164+02 (16' LT.)	STA. 164+96.67 (16' LT.)		95
STA. 165+03.33 (16' LT.)	STA. 155+98 (16' LT.)		95
STA. 363+54 (12' RT.)	STA. 364+96.67 (12' RT.)		144
STA. 365+03.33 (12' RT.)	STA. 365+98 (12' RT.)		95
STA. 363+54 (16' RT.)	STA. 364+96.67 (16' RT.)		144
STA. 365+03.33 (16' RT.)	STA. 365+98 (16' RT.)		95

ITEM 645.292 REMOVE AND RESET GUIDE SIGN TYPE II			EA
REMOVE STA. 160+58 RT.	RESET STA. 159+00 RT.		1

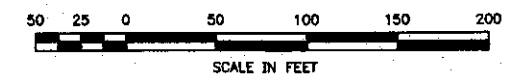

No.	Revision	By	Date	In Charge Of
		Designed	RWB 2/99	
		Drawn	WEF 2/99	
		Checked	RWB 2/99	
				RAL


Maine Turnpike Authority
Maine Turnpike

YORK TOLL PLAZA
TOLL PLAZA MODIFICATIONS
SITE PLAN

HNTE

Contract 99.4 Sheet No. 12 of 42

(METPK BDR-01)

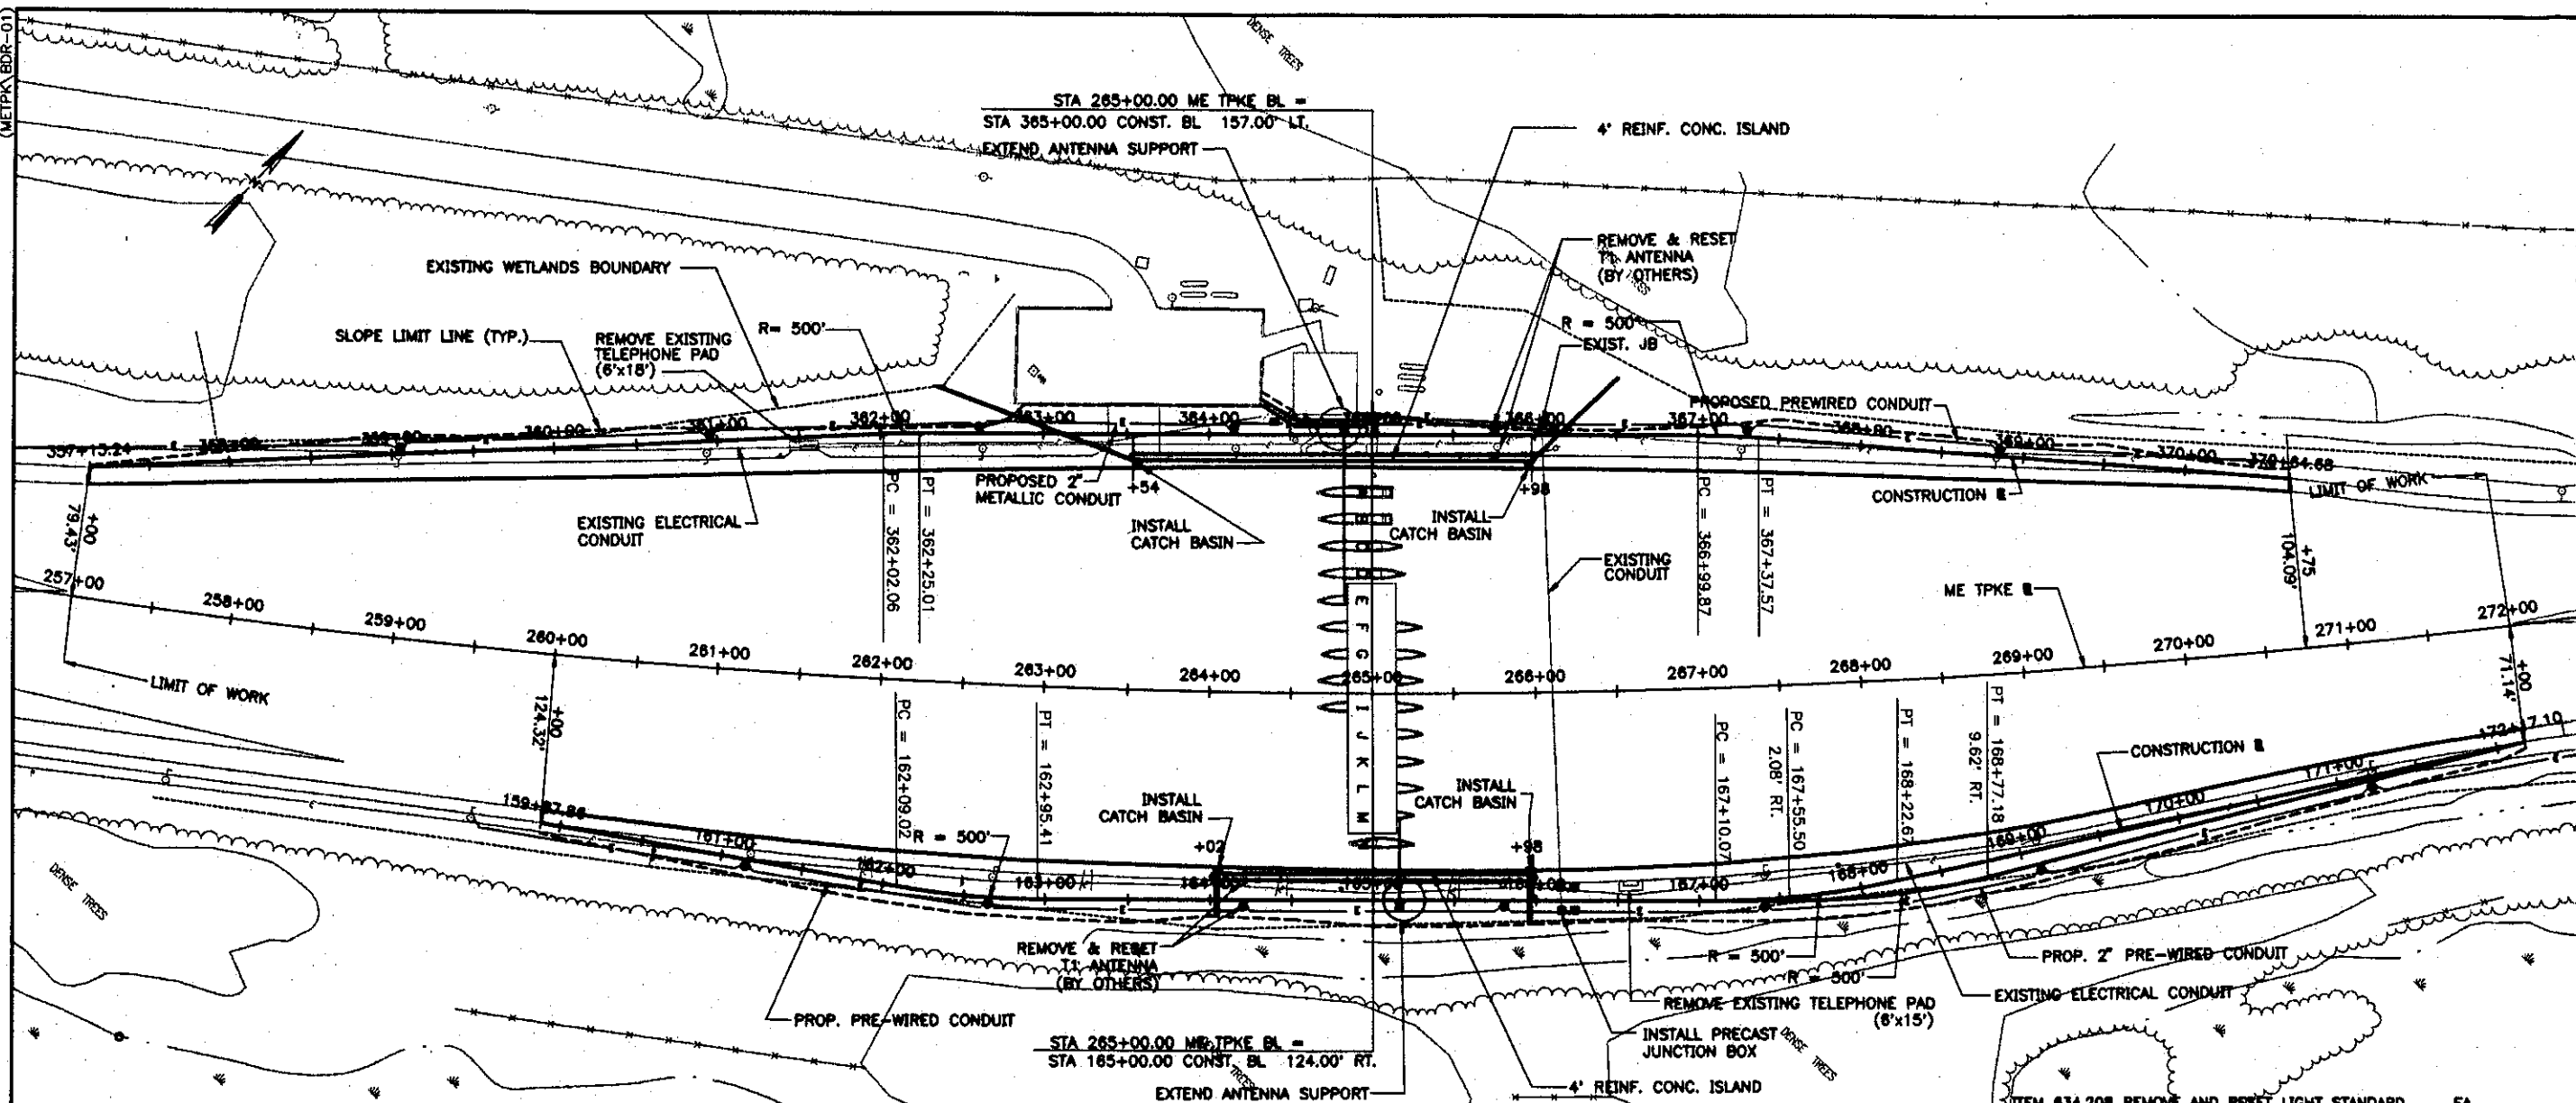

ITEM 603.155 12" REINFORCED CONCRETE PIPE - CLASS III		LF
FROM	TO	
STA. 363+56 (16' RT.)	STA. 362+35 (29' LT.)	130
STA. 365+96 (18' RT.)	STA. 360+50 (35' LT.)	76
STA. 164+04 (16' LT.)	STA. 164+04 (13' RT.)	29
STA. 165+96 (16' LT.)	STA. 165+96 (12' RT.)	28

ITEM 604.09 CATCH BASIN TYPE B-1	EA
STA. 363+56 (18' RT.)	1
STA. 365+96 (18' RT.)	1
STA. 164+04 (18' LT.)	1
STA. 165+96 (18' LT.)	1

ITEM 626.11 PRECAST JUNCTION BOX	EA
STA. 166+15 (4' RT.)	1

ITEM 626.212 2" METALLIC CONDUIT		LF
FROM	TO	
STA. 164+92 (8' LT.)	STA. 164+97 (4' RT.)	20
STA. 364+92 (8' LT.)	STA. 364+97 (4' RT.)	20

ITEM 626.23 PRE-WIRED ELECTRICAL CONDUIT		LF
FROM	TO	
STA. 159+45 (3' RT.)	STA. 161+15 (4' RT.)	170
STA. 161+15 (4' RT.)	STA. 162+65 (4' RT.)	150
STA. 162+65 (4' RT.)	STA. 164+20 (4' RT.)	155
STA. 164+20 (4' RT.)	STA. 165+80 (4' RT.)	160
STA. 165+80 (4' RT.)	STA. 166+15 (4' RT.)	35
STA. 166+15 (4' RT.)	STA. 167+40 (4' RT.)	125
STA. 167+40 (4' RT.)	STA. 169+10 (14' RT.)	170
STA. 169+10 (14' RT.)	STA. 171+20 (4' RT.)	210
STA. 171+20 (4' RT.)	STA. 173+88 (3' RT.)	266
STA. 356+50 (3' LT.)	STA. 359+05 (4' LT.)	255
STA. 359+05 (4' LT.)	STA. 359+95 (4' LT.)	90
STA. 359+95 (4' LT.)	STA. 362+80 (4' LT.)	285
STA. 362+80 (4' LT.)	STA. 364+15 (4' LT.)	155
STA. 364+15 (4' LT.)	STA. 365+75 (4' LT.)	160
STA. 365+75 (4' LT.)	STA. 366+02 (6' LT.)	27
STA. 366+02 (6' LT.)	STA. 367+30 (4' LT.)	128
STA. 367+30 (4' LT.)	STA. 368+85 (4' LT.)	155
STA. 368+85 (4' LT.)	STA. 370+67 (7' LT.)	182


ITEM 626.32 24" FOUNDATION	EA
STA. 161+15 (4' RT.)	1
STA. 162+85 (4' RT.)	1
STA. 164+20 (4' RT.)	1
STA. 165+80 (4' RT.)	1
STA. 167+40 (4' RT.)	1
STA. 169+10 (14' RT.)	1
STA. 171+20 (4' RT.)	1
STA. 359+05 (4' LT.)	1
STA. 359+95 (4' LT.)	1
STA. 362+80 (4' LT.)	1
STA. 364+15 (4' LT.)	1
STA. 365+75 (4' LT.)	1
STA. 367+30 (4' LT.)	1
STA. 368+85 (4' LT.)	1

ITEM 626.361 REMOVE AND STACK CONCRETE FOUNDATION	EA
* REMOVE AND STACK CONCRETE FOUNDATION	7

ITEM 626.362 REMOVE AND DISPOSE CONCRETE FOUNDATION	EA
** REMOVE AND DISPOSE CONCRETE FOUNDATION	7

ITEM 634.208 REMOVE AND RESET LIGHT STANDARD		EA
REMOVE FROM	RESET TO	
STA. 161+17 (LT.) **	STA. 161+15 (4' RT.)	1
STA. 162+67 (LT.) **	STA. 162+85 (4' RT.)	1
STA. 164+20 (LT.) **	STA. 164+20 (4' RT.) #1	1
STA. 165+79 (LT.) **	STA. 165+80 (4' RT.)	1
STA. 167+40 (LT.) **	STA. 167+40 (4' RT.)	1
STA. 169+11 (LT.) **	STA. 169+10 (14' RT.)	1
STA. 171+22 (LT.) **	STA. 171+20 (5' RT.)	1
STA. 359+04 (RT.) *	STA. 359+05 (4' LT.)	1
STA. 360+93 (RT.) *	STA. 359+95 (4' LT.)	1
STA. 362+83 (RT.) *	STA. 362+80 (4' LT.)	1
STA. 364+17 (RT.) *	STA. 364+15 (4' LT.)	1
STA. 365+75 (RT.) *	STA. 365+75 (4' LT.)	1
STA. 367+27 (RT.) *	STA. 367+30 (4' LT.)	1
STA. 368+83 (RT.) *	STA. 368+85 (4' LT.)	1

#1 = INCLUDING FLOOD LIGHTS

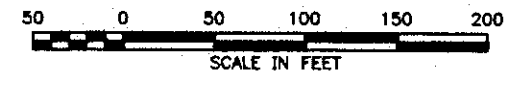




Maine Turnpike Authority
Maine Turnpike
 YORK TOLL PLAZA
 TOLL PLAZA MODIFICATIONS
 UTILITY PLAN

Contract 99.4
 Sheet No. UP-1
 13 of 42



Designed	RWB	2/99
Drawn	WEF	2/99
Checked	RWB	2/99

Contract 99.4
 Sheet No. UP-1
 13 of 42

(METPK BDR-01)

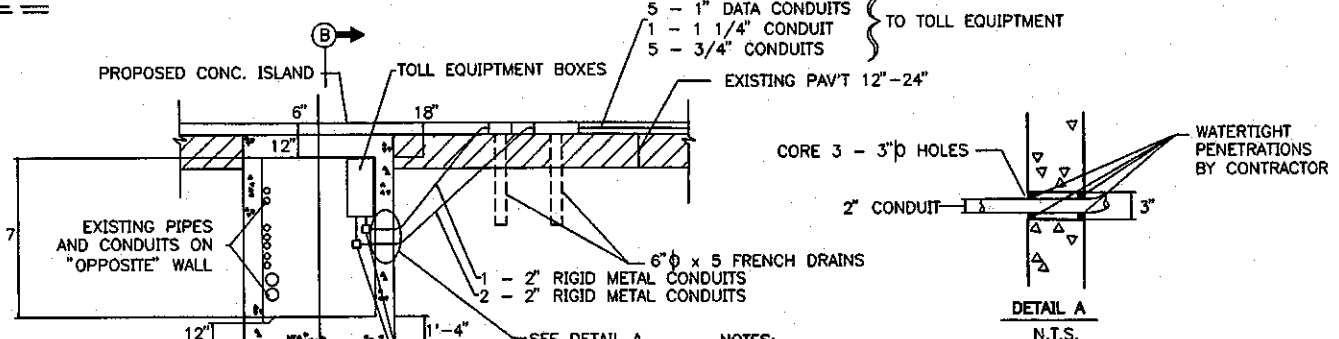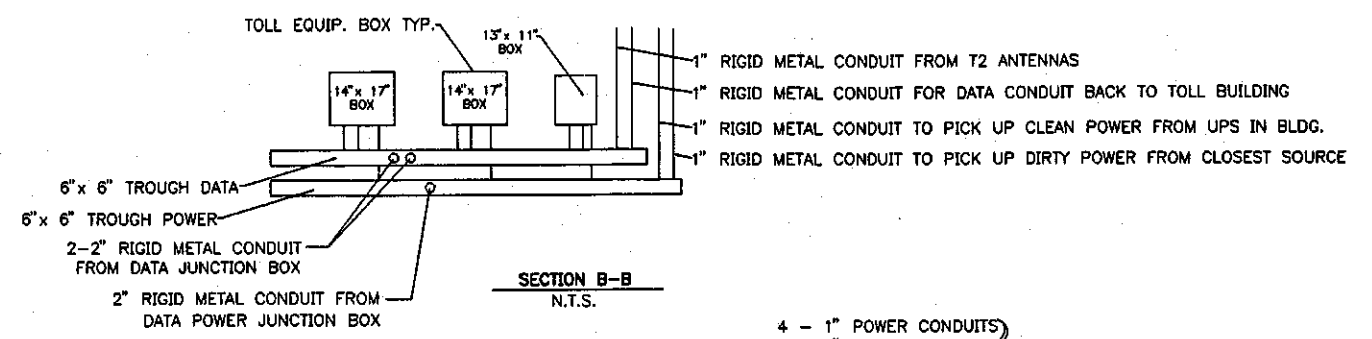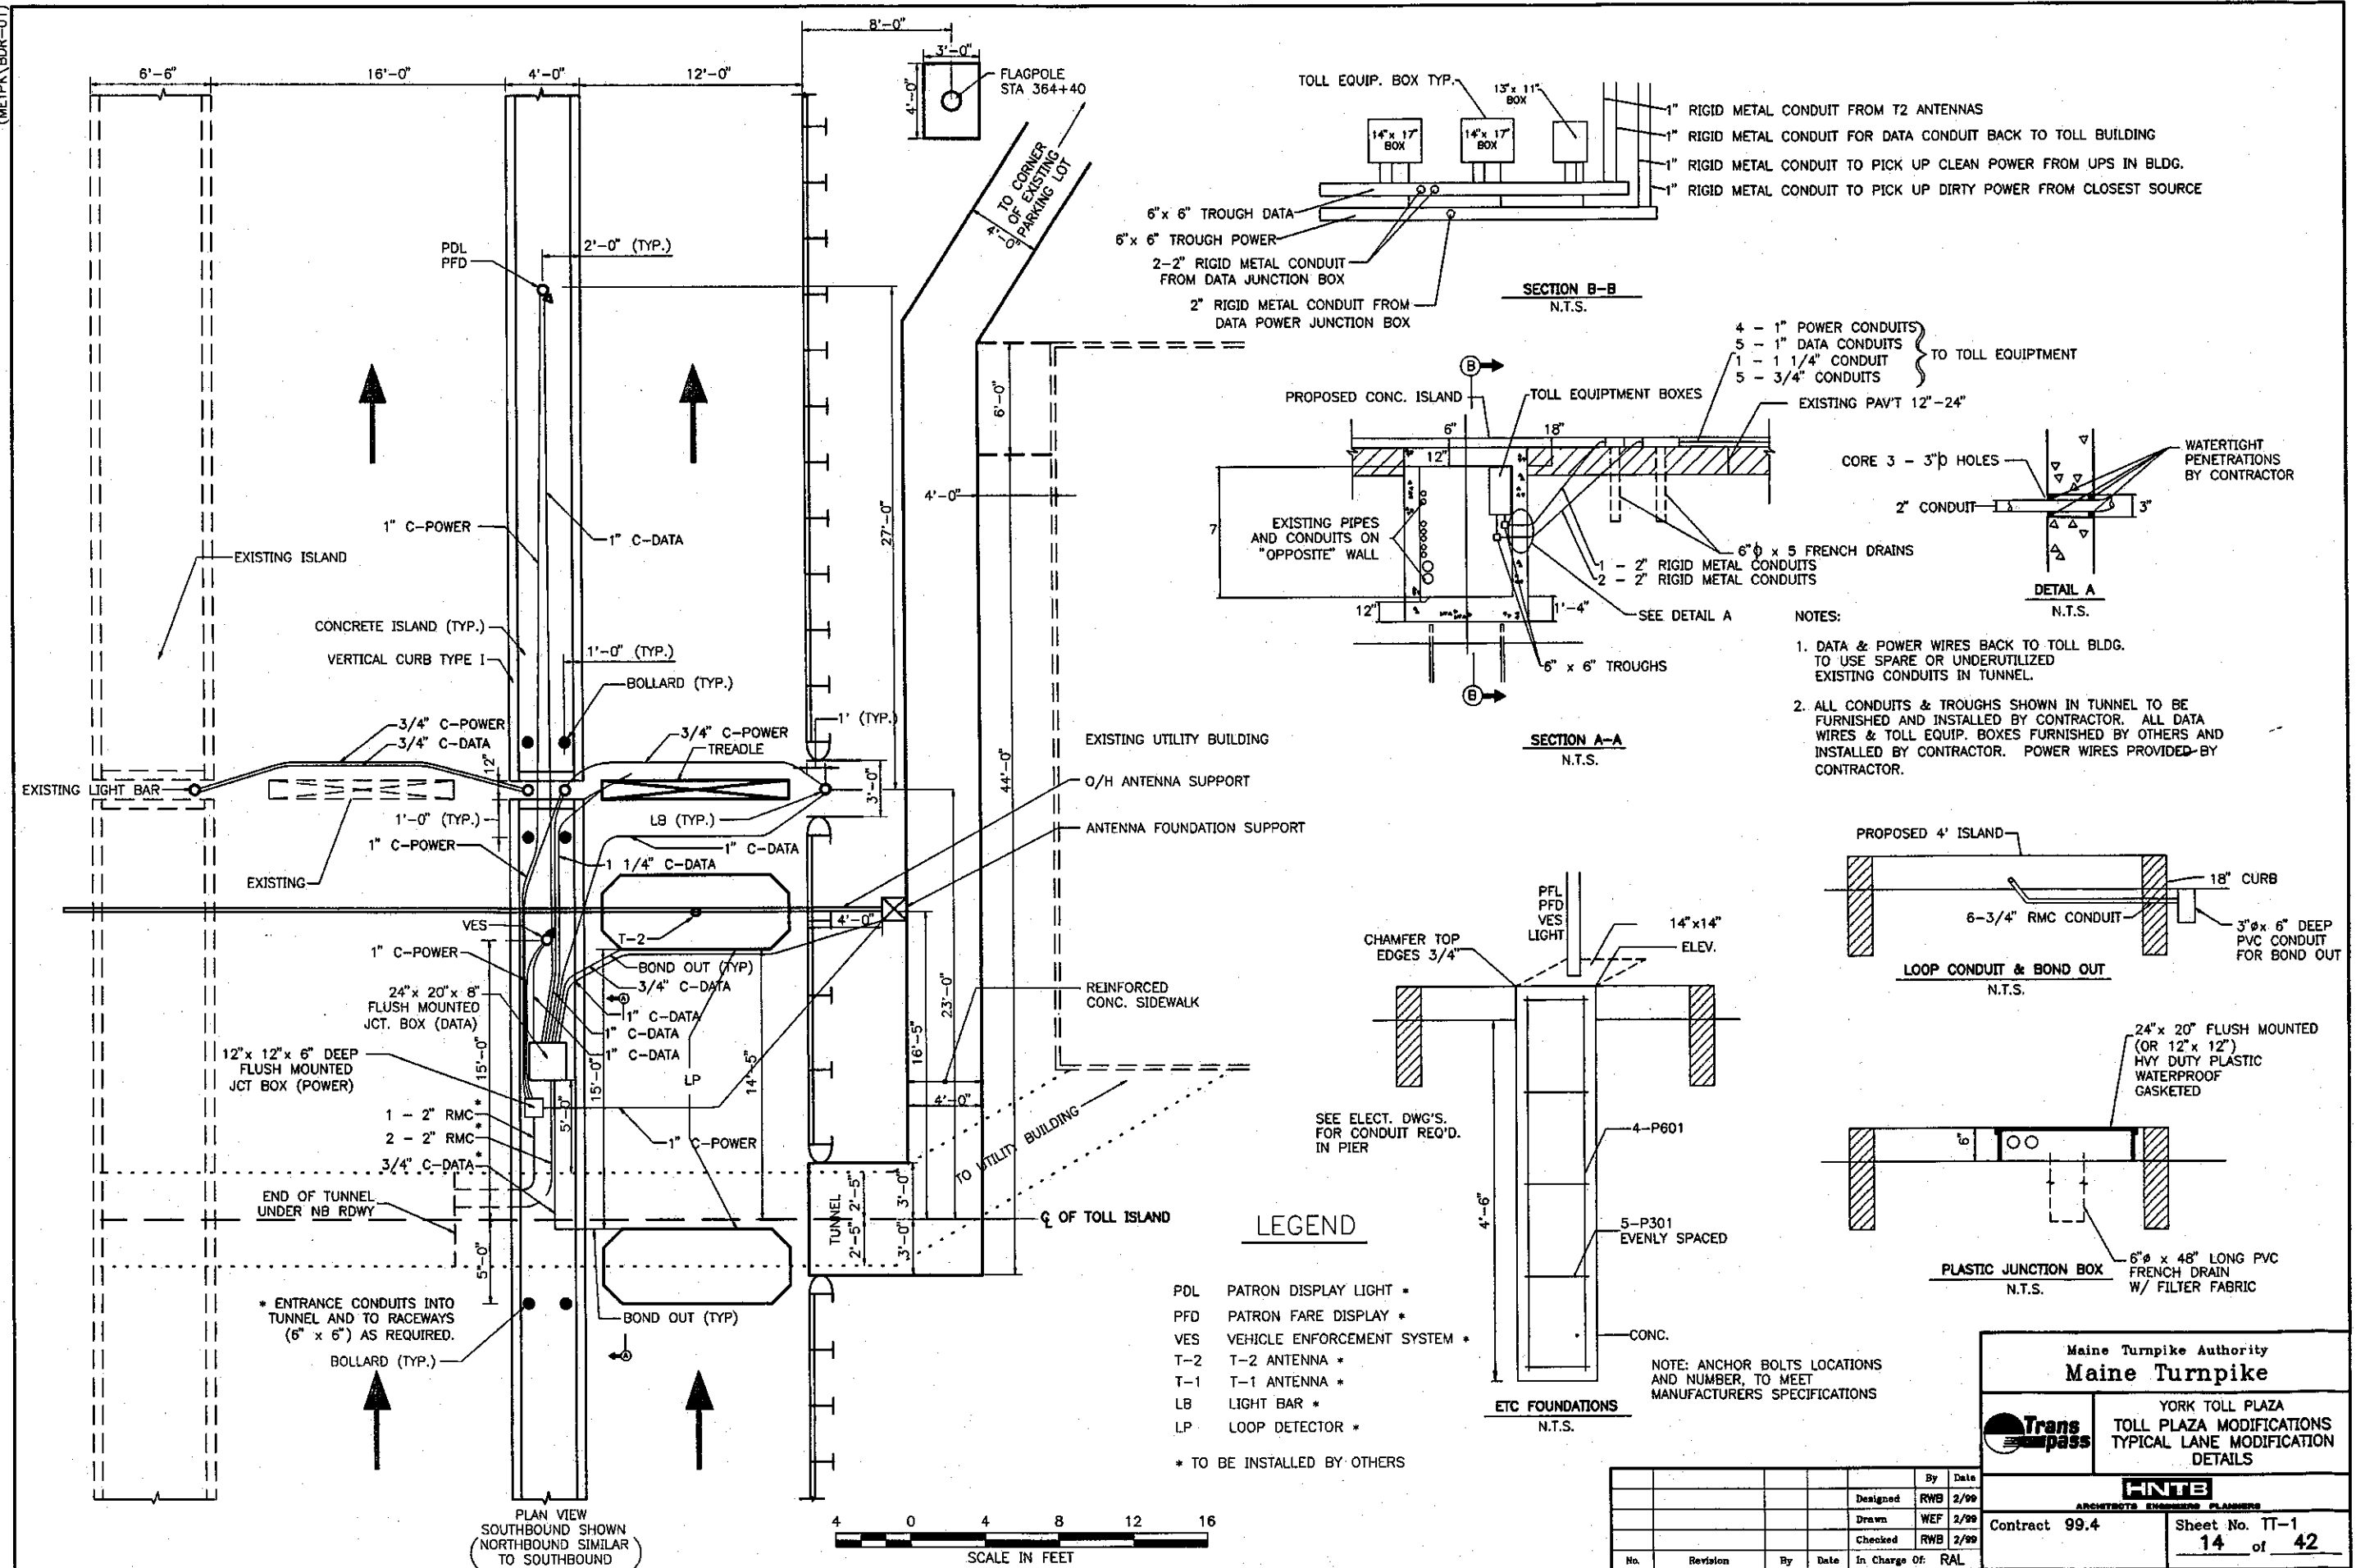


- NOTES:
1. DATA & POWER WIRES BACK TO TOLL BLDG. TO USE SPARE OR UNDERUTILIZED EXISTING CONDUITS IN TUNNEL.
 2. ALL CONDUITS & TROUGHS SHOWN IN TUNNEL TO BE FURNISHED AND INSTALLED BY CONTRACTOR. ALL DATA WIRES & TOLL EQUIP. BOXES FURNISHED BY OTHERS AND INSTALLED BY CONTRACTOR. POWER WIRES PROVIDED BY CONTRACTOR.

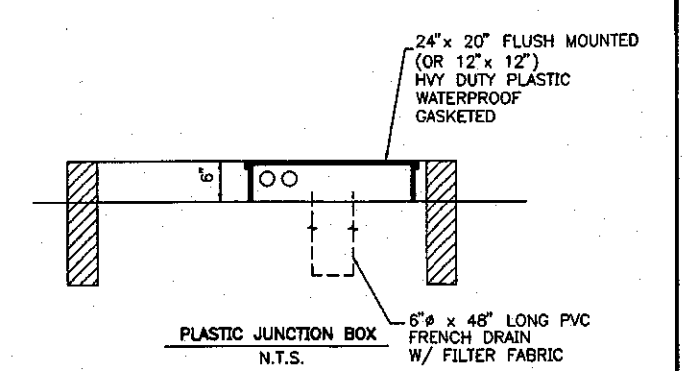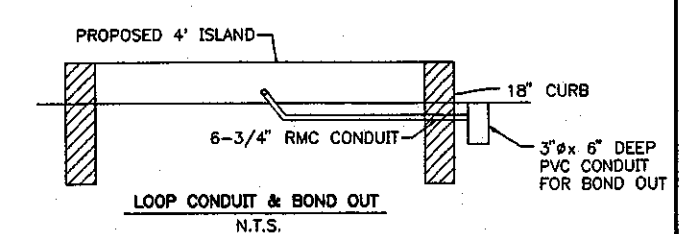

LEGEND

- PDL PATRON DISPLAY LIGHT *
 - PFD PATRON FARE DISPLAY *
 - VES VEHICLE ENFORCEMENT SYSTEM *
 - T-2 T-2 ANTENNA *
 - T-1 T-1 ANTENNA *
 - LB LIGHT BAR *
 - LP LOOP DETECTOR *
- * TO BE INSTALLED BY OTHERS

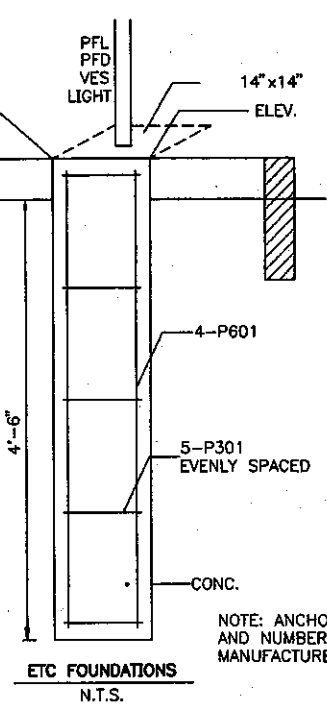

NOTE: ANCHOR BOLTS LOCATIONS AND NUMBER, TO MEET MANUFACTURERS SPECIFICATIONS

No.	Revision	By	Date	In Charge Of
	Designed	RWB	2/99	
	Drawn	WEF	2/99	
	Checked	RWB	2/99	
	In Charge Of	RAL		


Maine Turnpike Authority
Maine Turnpike

YORK TOLL PLAZA
TOLL PLAZA MODIFICATIONS
TYPICAL LANE MODIFICATION
DETAILS


HNTB
ARCHITECTS ENGINEERS PLANNERS

Contract 99.4 Sheet No. TT-1
14 of 42


(METPK BDR-01)

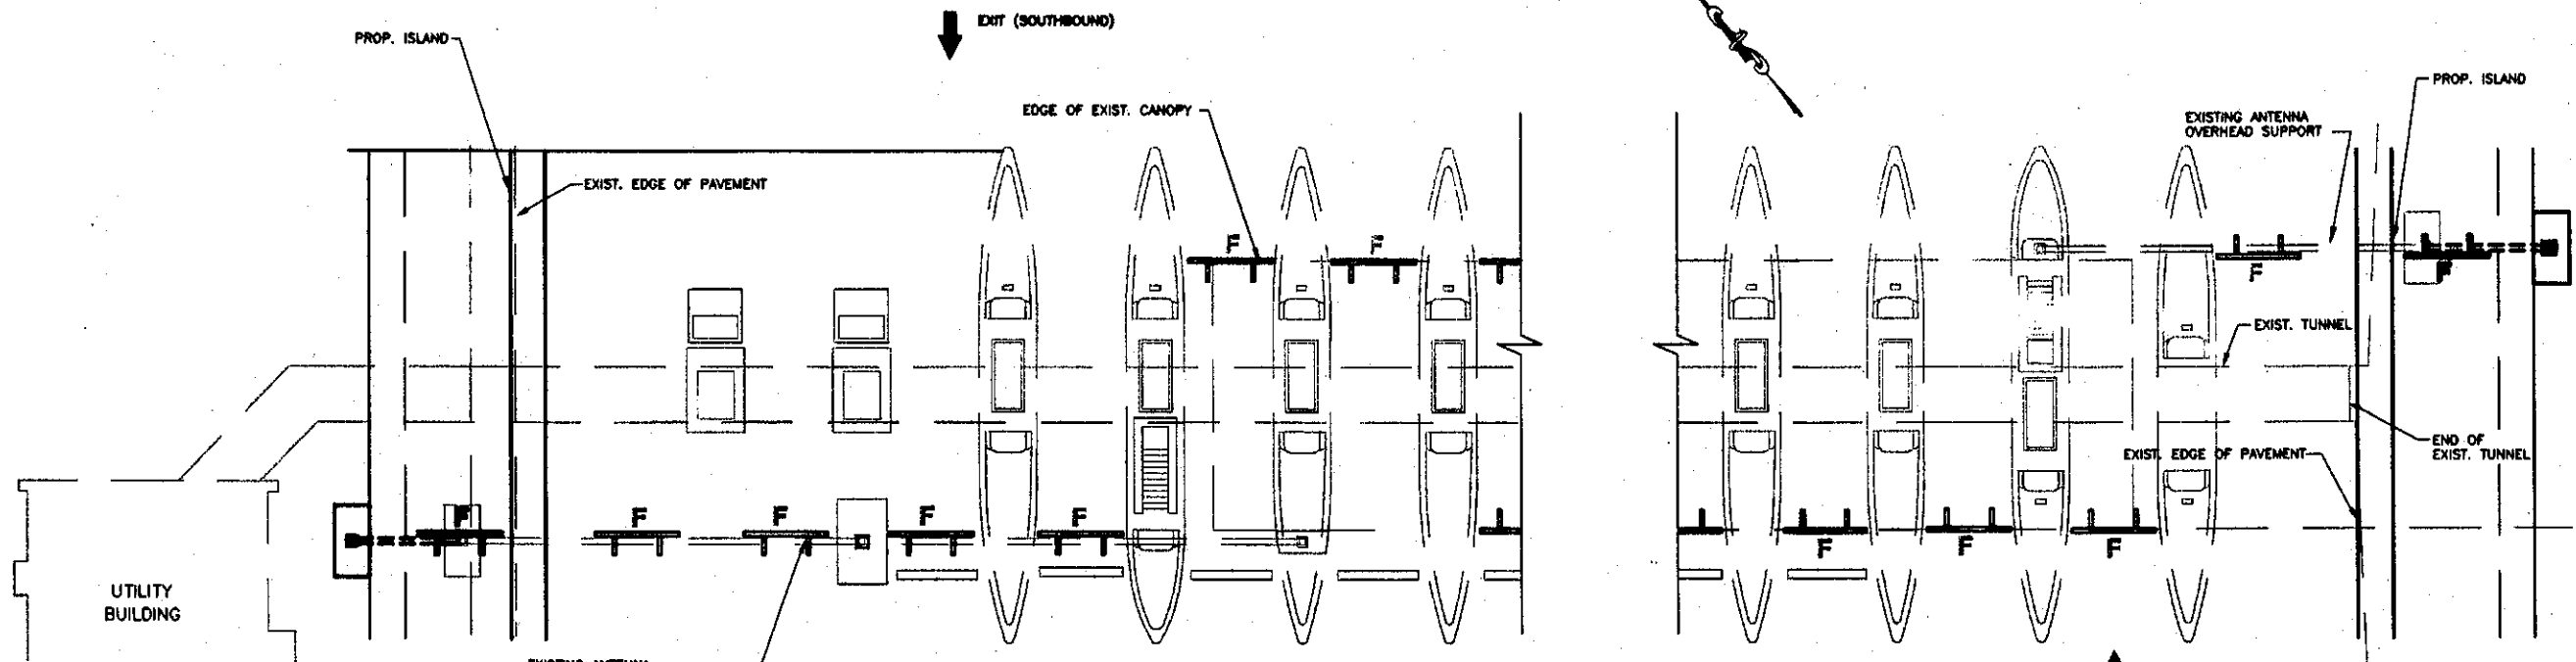

PLAN
N.T.S.

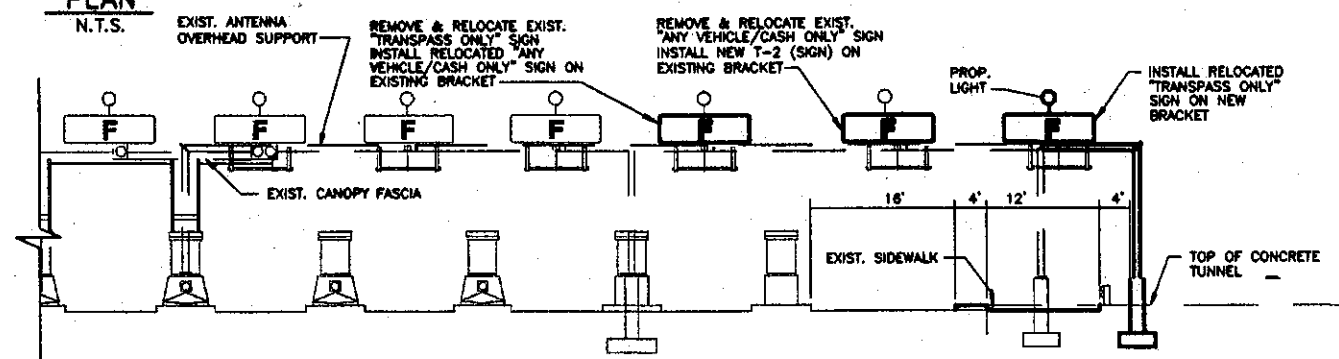

ELEVATION - SOUTHBOUND
N.T.S.

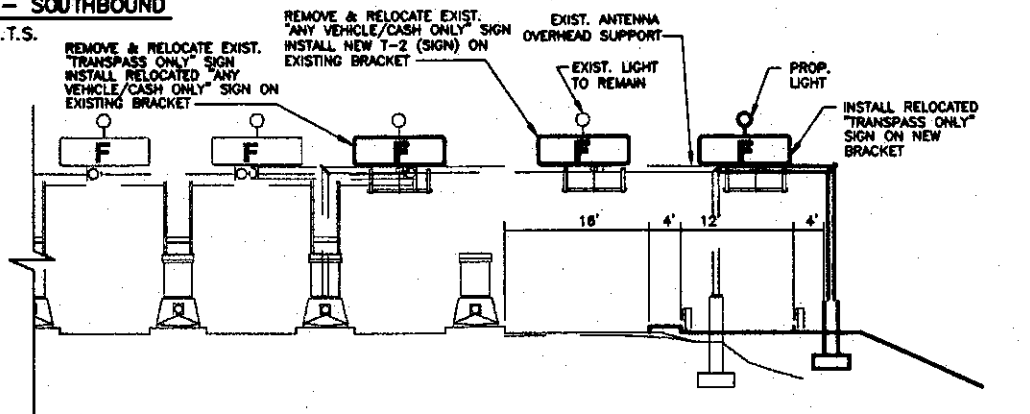

ELEVATION - NORTHBOUND
N.T.S.

- LEGEND**
- EXISTING TOLL CANOPY SUPPORT MOUNTED SIGN
 - F** FIXED SIGN
 - R** ROTATING SIGN

No.	Revision	By	Date	In Charge of	RAL
		Designed	WEF 2/98		
		Drawn	BDH 2/98		
		Checked	RWB 2/98		

Maine Turnpike Authority
Maine Turnpike

YORK TOLL PLAZA
TOLL PLAZA MODIFICATIONS
CANOPY SIGNS

ENTB
ARCHITECT'S ENGINEERING PLANNING



Contract 99.4

Sheet No. CS-1
15 of 42


(METPK) BDR-01

TYPE I GUIDE SIGNS


ITEM NO. 645.251

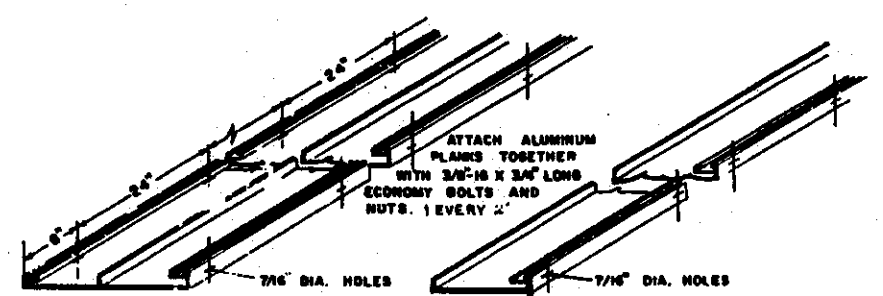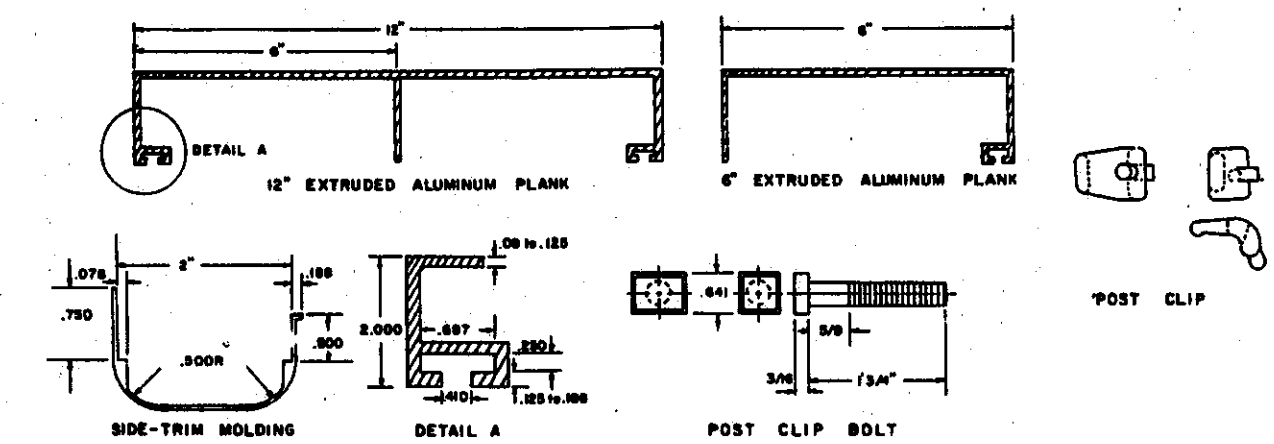


BOLT HOLE PUNCHING LOCATION PLAN FOR ROADSIDE AND OVERHEAD SIGNS

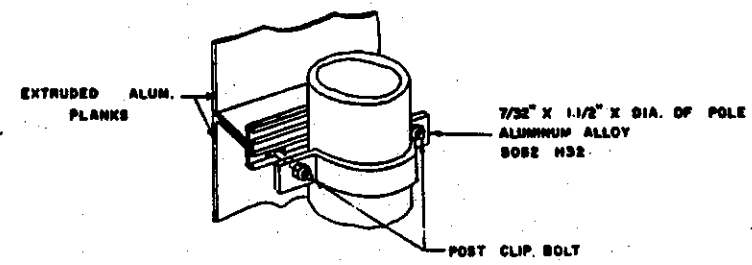

SUGGESTED POST CLAMP DETAILS FOR TYPE I GUIDE SIGNS

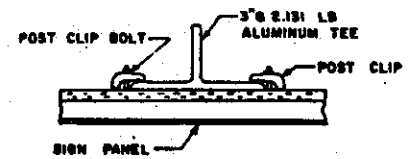

DETAIL FOR SIGNS REQUIRING NESTED FASTENING ALUMINUM TEE WITH J HOOK

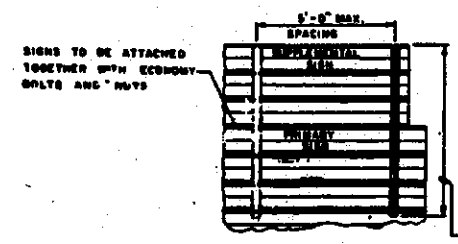

MIN. 2 X HEIGHT OF SUPPLEMENTAL SIGN

NOTE: TYPE I REGULATORY, WARNING AND CONFIRMATION SIGNS SHALL BE INSTALLED A MINIMUM OF 6' TO THE EDGE OF SIGN FROM EDGE OF PAVEMENT OR AS NOTED ON THE PLANS.


TYPE II SIGNS

ITEM NO. 645.291
645.292


NOTES

REFER TO SECTION 645.061 OF STANDARD SPECIFICATIONS TO DETERMINE SIZE OF WOOD POSTS, OR AS NOTED ON SIGN ASSEMBLY SHEET.



ALSO, ALL WOOD & BRACKETS SHALL BE PRESSURE TREATED TO CCA 40.

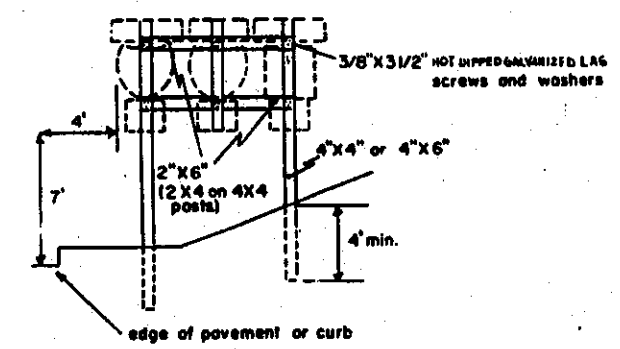

TYPICAL SIGN ASSEMBLY AS SHOWN ON SIGN ASSEMBLY SHEET

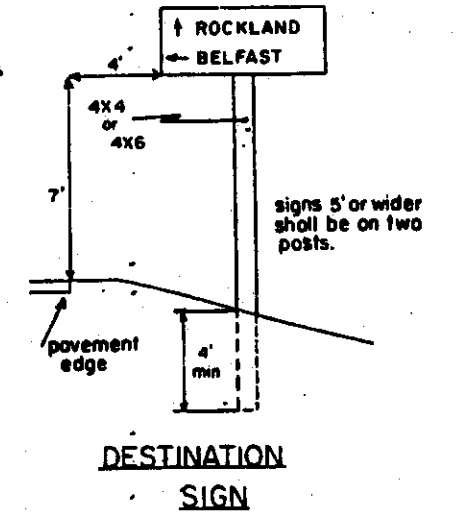

DESTINATION SIGN

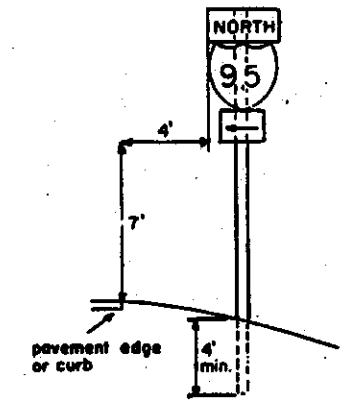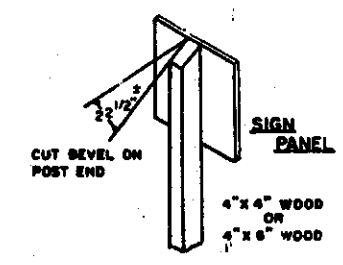

ROUTE MARKER ASSEMBLY

No.	Revision	By	Date	In Charge Of

Maine Turnpike Authority
Maine Turnpike

YORK TOLL PLAZA
TOLL PLAZA MODIFICATIONS
SIGN STANDARD DETAILS

Transpass


HNTB
ARCHITECTS ENGINEERS PLANNERS

Contract 99.4


Sheet No. SPD-1
16 of 42

(METPK BDR-01)


TYPE I REGULATORY, WARNING AND ROUTE MARKER ASSEMBLY SIGNS

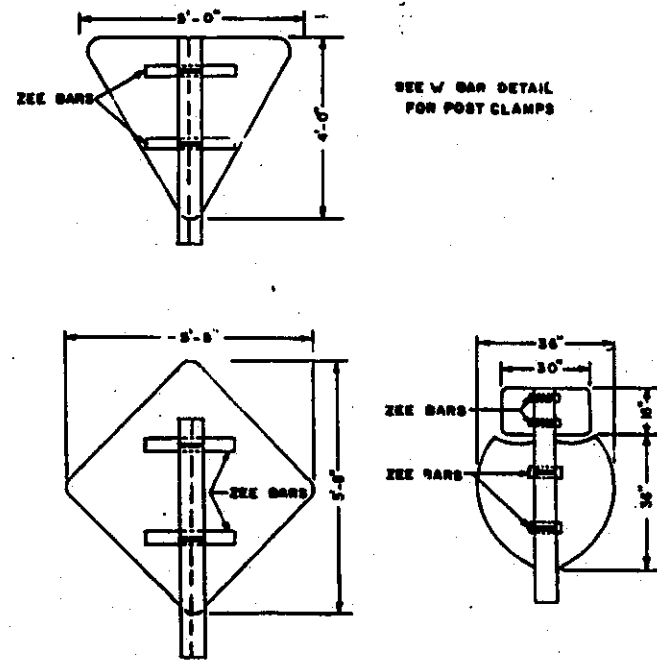

SEE V BAR DETAIL FOR POST CLAMPS

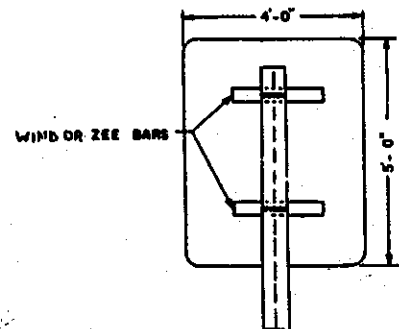


NOTE:
BOLT HOLES IN SIGN PANELS SHALL BE LOCATED ACCORDING TO THE "BLANK STANDARDS" SECTION OF STANDARD HIGHWAY SIGNS.

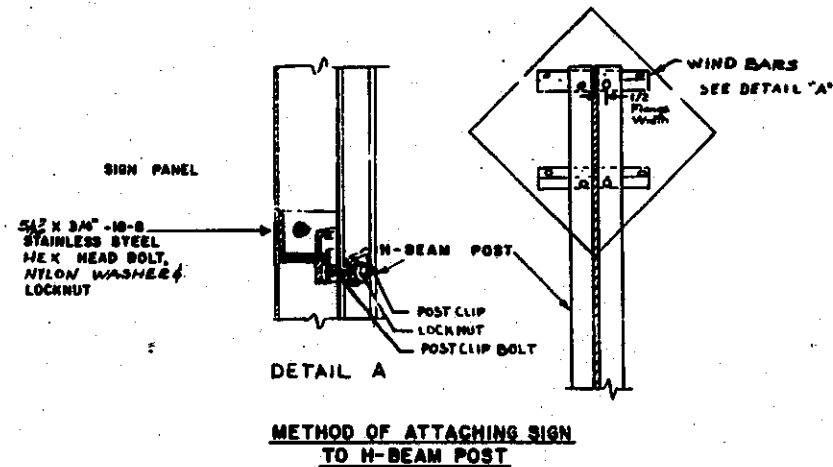


METHOD OF ATTACHING SIGN TO H-BEAM POST

DELINEATORS

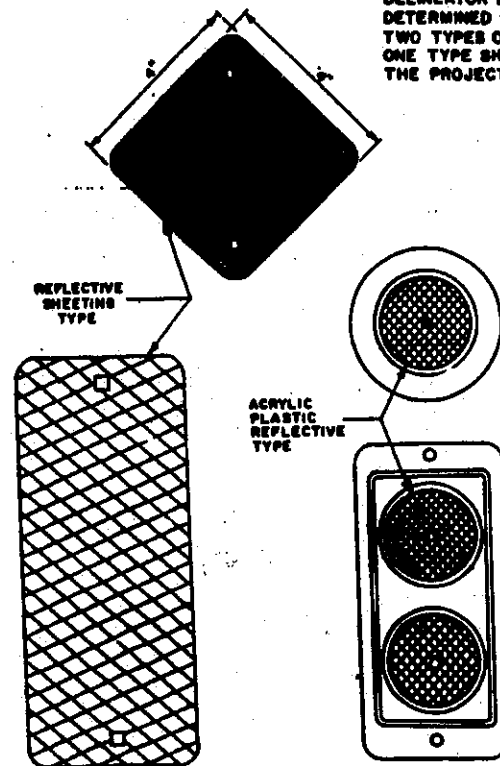


NOTE:
DELINEATOR LOCATION TO BE DETERMINED BY THE ENGINEER. TWO TYPES OF DELINEATORS ARE SHOWN. ONE TYPE SHALL BE USED THROUGHOUT THE PROJECT.

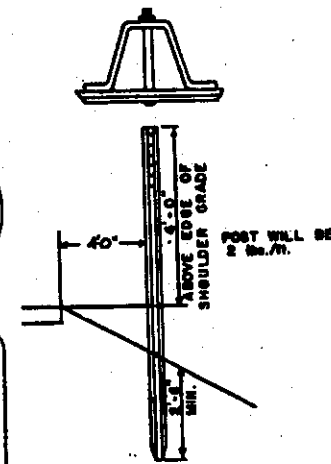


TO BE PLACED 4 FEET FROM SHOULDER EDGE 4 FEET FROM FACE OF CURB SECTIONS.

U-CHANNEL POSTS

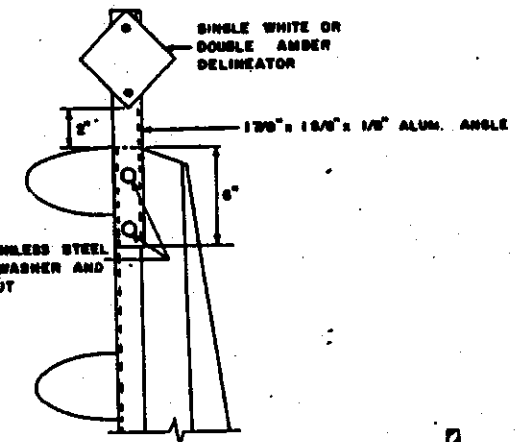

BRIDGE RAIL MOUNTING

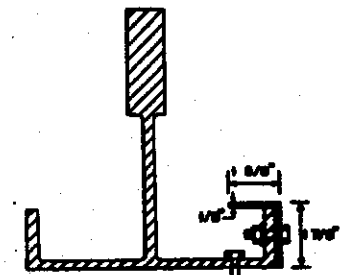


POST SECTION

BRIDGE RAIL MOUNTING


STANDARD H-BEAM POSTS

SINGLE SUPPORT SIGNS								
Foundation Diameter	Sign Area (A)	Sign Width (W)	Post Size	Base P-316 (1) (3)	Material	Anchor Bolts (2)	Bolt Circle	Maximum Mounting Height
	0-21 ft ²		Wood Post 6" x 6"					
18"	21CA ≤ 28ft ²	W = 6'-0" Max.	WB x 18	12" x 12" x 1' 41 lbs.	A36	1" x 3'-0"	12"	12 Feet To Sign Center
24"	25C A ≤ 36ft ²	W = 6'-0" Max.	WB x 24	14" x 14" x 1' 85 lbs.	A36	1 1/2" x 3'-0"	14"	

MULTIPLE SUPPORT SIGNS								
24"	10-80ft ² /Post		WB x 18	14" x 14" x 1' 23 lbs.	A36	1 1/4" x 3'-0"	14"	20 Feet To Sign Center
24"	60-85ft ² /Post		WB x 22	12" x 11" x 1' 72 lbs.	A36	1 1/4" x 3'-0"	15"	
30"	85-110ft ² /Post		W12 x 26	13" x 13" x 1' 87 lbs.	A36	1 1/2" x 4'-0"	17"	
30"	110-135ft ² /Post		W14 x 30	14" x 21" x 1' 104 lbs.	A36	1 1/2" x 4'-0"	19"	

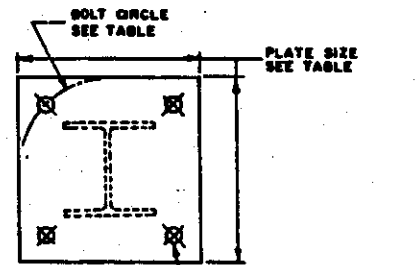

ANCHOR BOLT LAYOUT
(W6 x 9, W6 x 12, W8 x 18, W8 x 24)

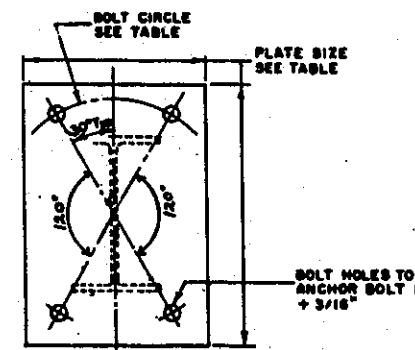

ANCHOR BOLT LAYOUT
(W10 x 22, W12 x 26, W14 x 30)

- NOTE:**
- FOR BOLT LAYOUT SEE BOLT LAYOUT PLANS LEFT.
 - BOLTS TO HAVE 80,000 P.S.I. MINIMUM YIELD STRENGTH.
 - POST TO BASE PLATE WELD SHALL BE 3/16" FILLET WELD.
 - BASE PLATES AND H-BEAMS SHALL BE HOT DIPPED GALVANIZED AFTER FABRICATION IN ACCORDANCE WITH SECTION 720.06.
 - PAYMENT FOR THE WEIGHT OF BASE PLATES SHALL BE INCIDENTAL TO ITEM No. 645.289.
 - ON H-BEAM POSTS TO BE EQUIPPED WITH BREAKAWAY DEVICES SHALL BE DRILLED BEFORE THE POST IS GALVANIZED, IN ACCORDANCE WITH SECTION 720.06.

No.	Revision	By	Date	In Charge Of
		Designed		
		Drawn		
		Checked	RWB 3/99	
				RAL


Maine Turnpike Authority
Maine Turnpike
YORK TOLL PLAZA
TOLL PLAZA MODIFICATIONS
SIGN POST DETAILS

Transpass

HNTB
ARCHITECTS ENGINEERS PLANNERS

Contract 99.4
Sheet No. SPD-2
17 of 42

(METPK\BDR-01)

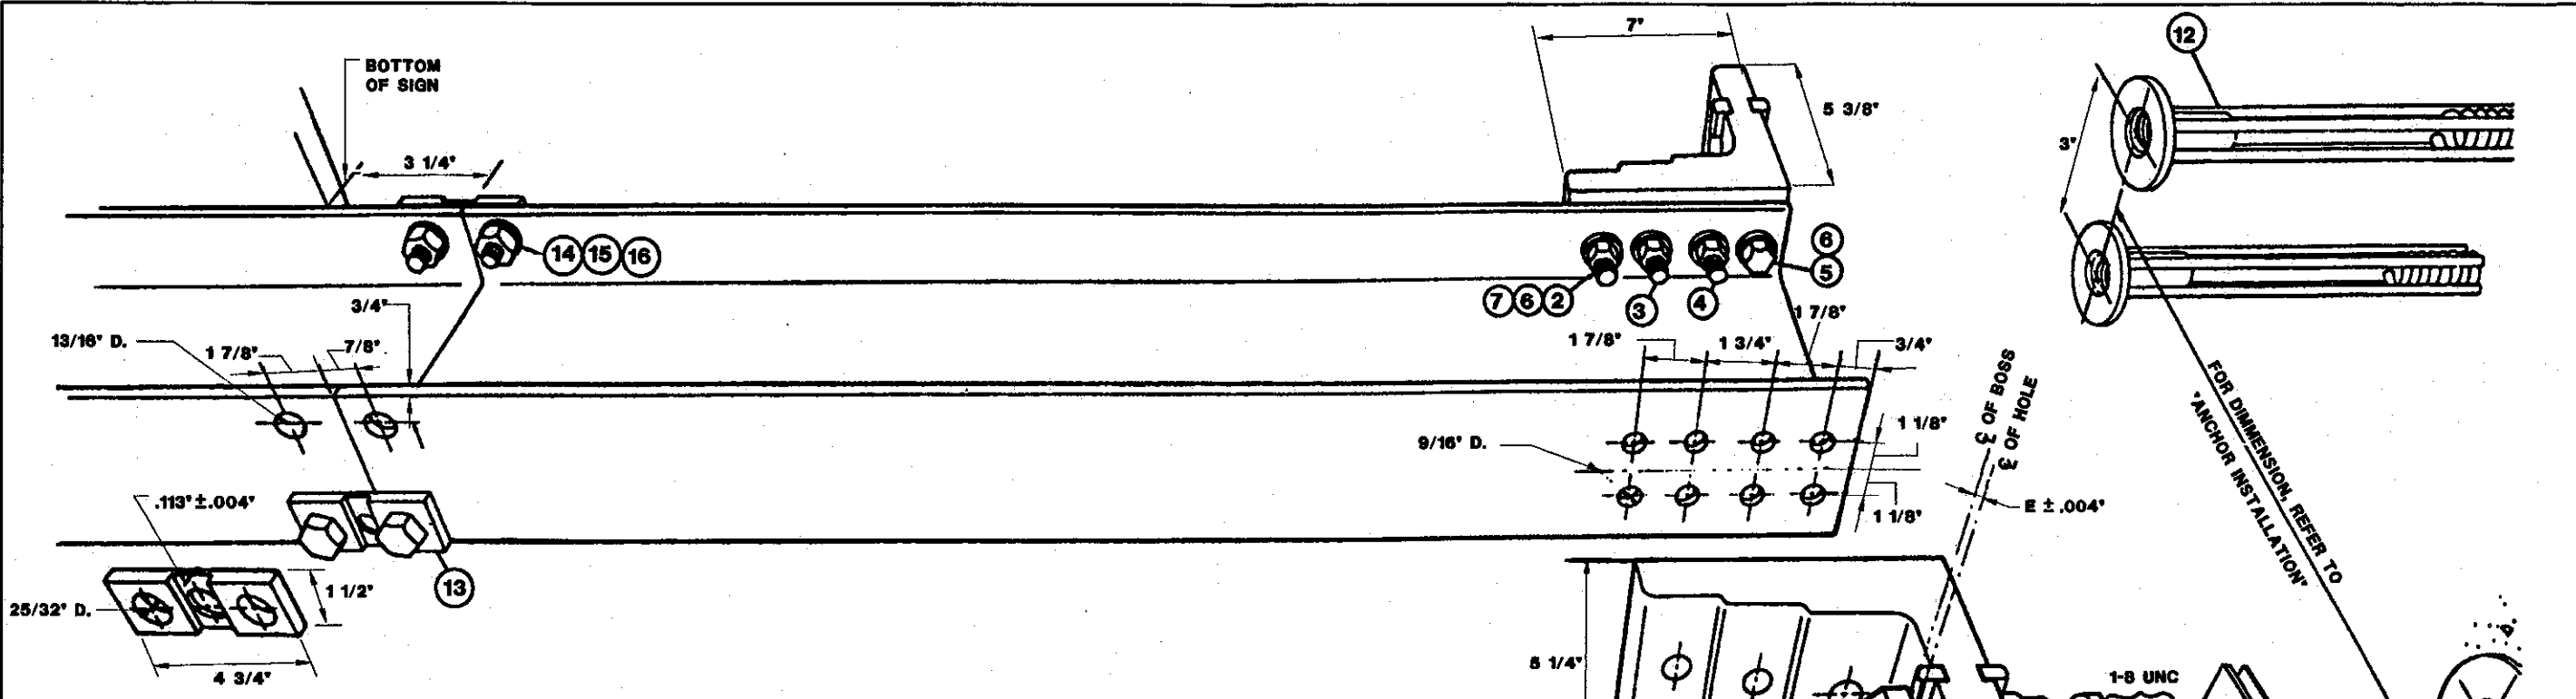

INSTALLATION NOTES

Wrench sizes required: 9/16", 7/8", 1-1/16", 1-1/4", 1-7/16", 1-5/8".

BRACKET ASSEMBLY

Assemble brackets to post with bolts provided. Square and tighten. (Items 1, 2, 3, 4, 5, 6 and 7)

ANCHOR ASSEMBLY

Assemble coupling anchors (12) to installation template (not shown). Lower entire anchor assembly into fresh concrete and vibrate into position so that the tops of the individual anchors (12) are flush with the finished top surface of the footings.

COUPLING ASSEMBLY

Suspend post over footing and insert special bolts (8) through brackets (1). Below bracket, thread couplings (9) into anchors (12) but leave loose. Lower post with special bolts (8) onto loose couplings (9) and thread special bolts into couplings. Thread couplings all the way into anchors (12).

Tighten special bolts (8) with 1-5/8" wrench. NOTE! Do not place torque across necked down portion of coupling - wrench flats are provided on either side for proper tightening.

If post is not plumb, insert shims (10) and (11) between couplings (9) and anchors (12).

HINGE ASSEMBLY

Butt upper and lower posts together on flat surface. Place hinge plates (13) on outer flanges and secure with 3/4-UNC bolts (14, 15) and (16) - snug but do not tighten. Make sure upper and lower posts are in alignment; then tighten all nuts (16) to proof load - 1/2 of a turn beyond snug.

GENERAL NOTES

- Meets all AASHTO "Standard specifications for structural supports for highway signs, luminaires and traffic signals".
- All hardware is to be hot dip galvanized per ASTM A153 or mechanically galvanized per ASTM B695.
- Fasteners, except for special bolt and coupling, are installed with lockwashers or locknuts and do not have specific torque requirements. Fasteners should be made as tight as possible with conventional wrenches unless noted otherwise.
- Square and level individual components to minimize need for shimming.
- No more than two shims underneath any one coupling and no more than three shims underneath any two couplings.
- Structural steel to be hot dip galvanized per ASTM A123 after fabrication.

All brackets to be permanently labeled with the appropriate bracket type and bracket selection number. Select correct bracket number by locating the intersection of sign height and post length in the bracket selection matrix. The intersection will be either Zone 1, 2, or 3 which corresponds to bracket numbers 1, 2, or 3.

6" POST

POST LENGTH	10	11	12	13	14	15	16	17	18	19	20	21	22	23	24	25
3																
4																
5																
6																
7																
8																
9																
10																
11																
12																
13																
14																
15																

8" POST

POST LENGTH	10	11	12	13	14	15	16	17	18	19	20	21	22	23	24	25
3																
4																
5																
6																
7																
8																
9																
10																
11																
12																
13																
14																
15																

BRACKET TABLES


BILL OF MATERIALS

ITEM	DESCRIPTION	QTY	PART NO.
1	Bracket 6061 T6 Aluminum (See Bracket Selection Table)	2	SBBK525-1A,-2A,-3A
2	Bolt Top, 1/2" - 13UNCx2-1/2" Hex Hd., ASTM A325, Galv. ASTM A153	4	S325BG5250
3	Bolt Middle, 1/2" - 13UNCx2-3/4", Hex Hd., ASTM A325, Galv. ASTM A153	4	S325BG5275
4	Bolt Bottom, 1/2" - 13UNCx3", Hex Hd., ASTM A325, Galv. ASTM A153	4	S325BG5300
5	Cap Screw Bracket, 1/2"-13UNCx1-1/4", Hex Hd., ASTM A307, Galv. ASTM A153	4	S3075G5125
6	Lockwasher 1/2", ANSI B18-21-1, Galv. ASTM A153	16	S100WGS150
7	Nut 1/2"-13UNC, Heavy Hex, ASTM A563 GR, DH, Galv. ASTM A153	12	S563NGH50D
8	Special Bolt 1"-8UNC, ASTM A325, Galv. ASTM B695/ASTM A153	4	SBCSBB
9	Coupling 1"-8UNC, LP., AMS 6378D*, Galv. ASTM A153, Polyester Coat.**	4	SBCB1B
10	Shim 1" Horseshoe, 18 Gauge, Galv. Steel Sheet	2	S100WGS118
11	Shim 1" Horseshoe, 14 Gauge, Galv. Steel Sheet	2	S100WGS114
12	Anchor 1"-8UNC, 304 Stainless Steel Ferrule, AISI 1038 Rod & AISI 1008 Coil	4	SBABP
13	Hinge Plate Type B525, AISI 4130, Galv. ASTM A123	4	SBH1B
14	Bolt Hinge, 3/4"-10UNCx2-1/4", Hex Hd., ASTM A325, Galv. ASTM A153	8	S325BG7225
15	Lockwasher 3/4", ANSI B18-21-1, Galv. ASTM A153	8	S100WGS170
16	Nut 3/4"-10UNC, Heavy Hex, ASTM A563, GR, DH, Galv. ASTM A153	8	S563NGH70D

* With exception to decarburization and macrostructure clauses.
** 1-3 Mil. thick Morton Powder Coatings' 20-7037 polyester powder coat.

Maine Turnpike Authority
Maine Turnpike
 YORK TOLL PLAZA
 TOLL PLAZA MODIFICATIONS
 BREAKAWAY SUPPORTS
 B-525-LP
 Contract 99.4
 Sheet No. SP-3
 18 of 42

(METPK BDR-01)

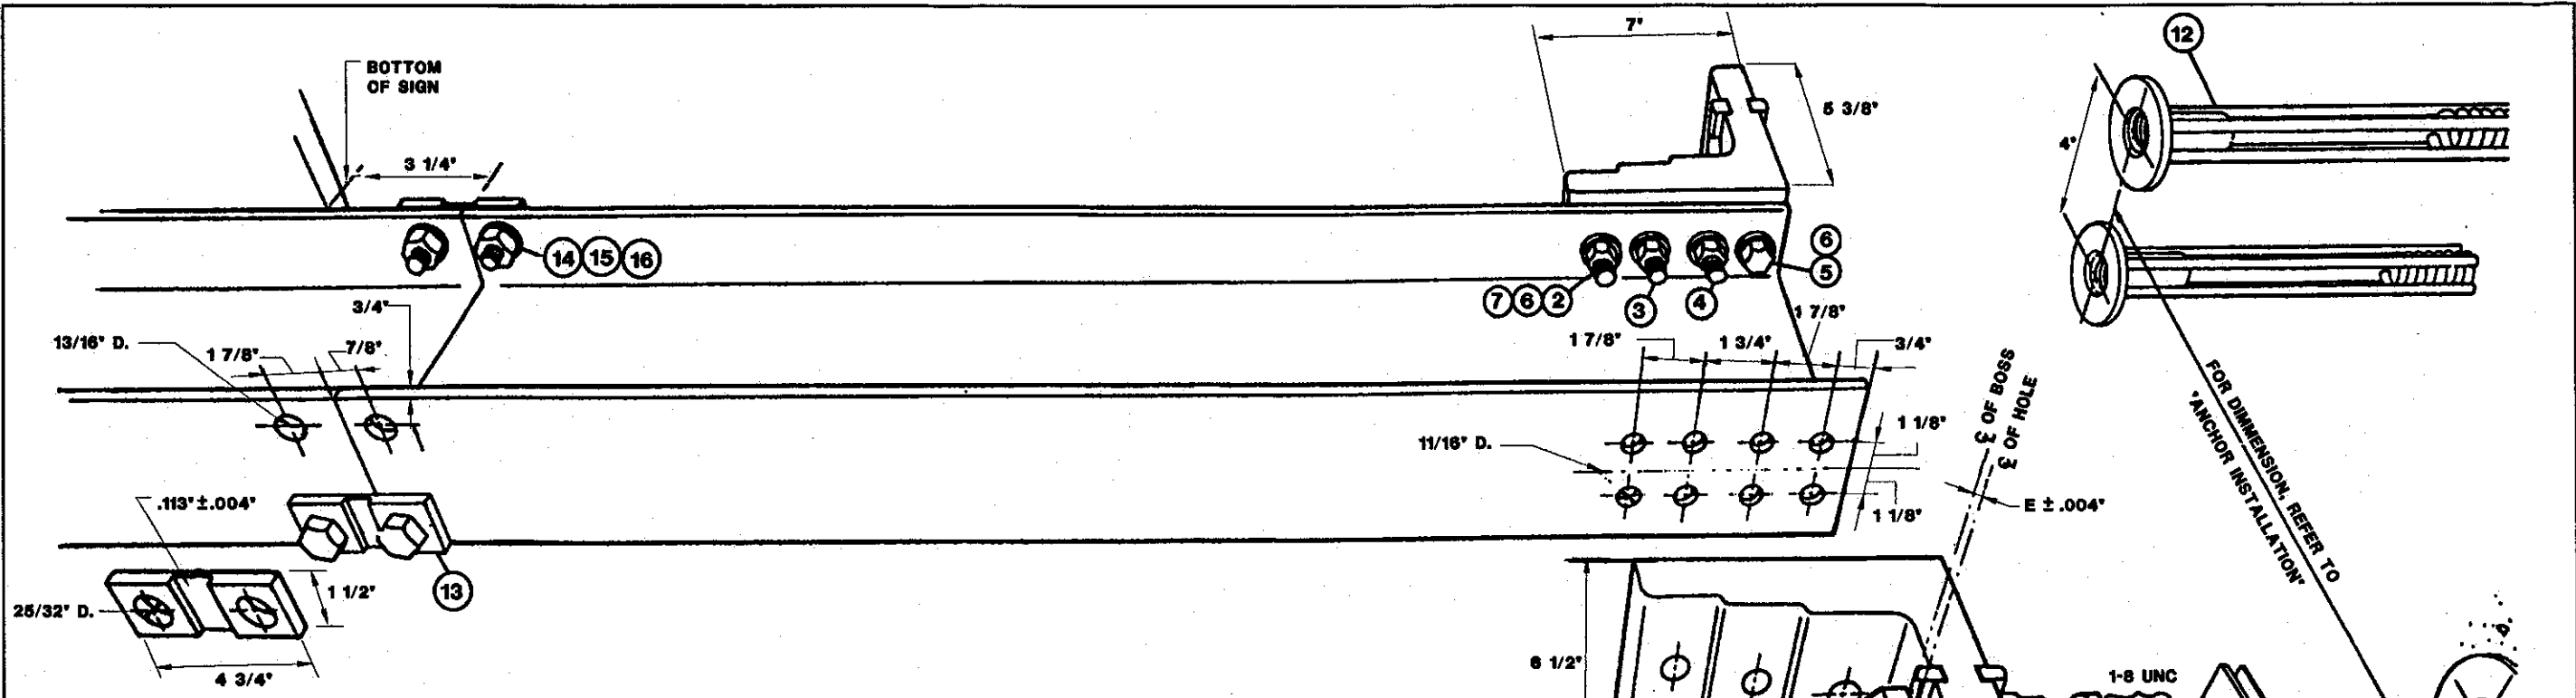

INSTALLATION NOTES

Wrench sizes required: 9/16", 7/8", 1-1/16", 1-1/4", 1-7/16", 1-5/8".

BRACKET ASSEMBLY

Assemble brackets to post with bolts provided. Square and tighten. (Items 1, 2, 3, 4, 5, 6 and 7)

ANCHOR ASSEMBLY

Assemble coupling anchors (12) to installation template (not shown).

Lower entire anchor assembly into fresh concrete and vibrate into position so that the tops of the individual anchors (12) are flush with the finished top surface of the footings.

COUPLING ASSEMBLY

Suspend post over footing and insert special bolts (8) through brackets (1).

Below bracket, thread couplings (9) into anchors (12) but leave loose.

Lower post with special bolts (8) onto loose couplings (9) and thread special bolts into couplings. Thread couplings all the way into anchors (12).

Tighten special bolts (8) with 1-5/8" wrench. NOTE! Do not place torque across necked down portion of coupling - wrench flats are provided on either side for proper tightening.

If post is not plumb, insert shims (10) and (11) between couplings (9) and anchors (12).

HINGE ASSEMBLY

Butt upper and lower posts together on flat surface.

Place hinge plates (13) on outer flanges and secure with 3/4-UNC bolts (14, 15) and (16) - snug but do not tighten.

Make sure upper and lower posts are in alignment; then tighten all nuts (16) to proof load - 1/2 of a turn beyond snug.

GENERAL NOTES

Meets all AASHTO "Standard specifications for structural supports for highway signs, luminaires and traffic signals".

All hardware is to be hot dip galvanized per ASTM A153 or mechanically galvanized per ASTM B695.

Fasteners, except for special bolt and coupling, are installed with lockwashers or locknuts and do not have specific torque requirements. Fasteners should be made as tight as possible with conventional wrenches unless noted otherwise.




Square and level individual components to minimize need for shimming.

No more than two shims underneath any one coupling and no more than three shims underneath any two couplings.

Structural steel to be hot dip galvanized per ASTM A123 after fabrication.

All brackets to be permanently labeled with the appropriate bracket type and bracket selection number.

Select correct bracket number by locating the intersection of sign height and post length in the bracket selection matrix. The intersection will be either Zone 1, 2, or 3 which corresponds to bracket numbers 1, 2, or 3.

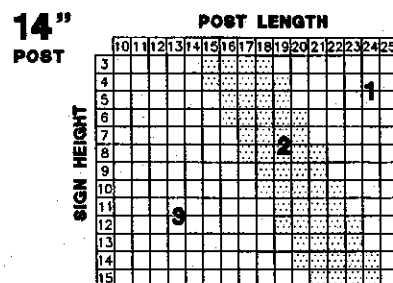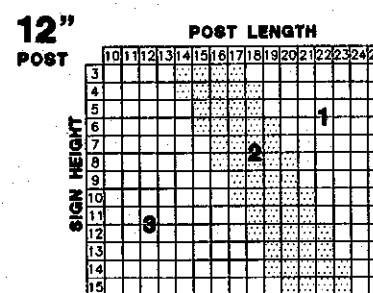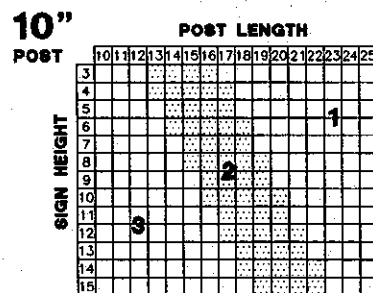

BRACKET TABLES

BILL OF MATERIALS

ITEM	DESCRIPTION	QTY POST	PART NO.
1	Bracket 6061 T6 Aluminum (See Bracket Selection Table)	2	SBBK650-1A,-2A,-3A
2	Bolt Top, 5/8" - 11UNCx2-3/4" Hex Hd., ASTM A325, Galv. ASTM A153	4	S325BG6275
3	Bolt Middle, 5/8" - 11UNCx3" Hex Hd., ASTM A325, Galv. ASTM A153	4	S325BG6300
4	Bolt Bottom, 5/8" - 11UNCx3-1/4" Hex Hd., ASTM A325, Galv. ASTM A153	4	S325BG6325
5	Cap Screw Bracket, 5/82"-11UNCx1-1/4", Hex Hd., ASTM A307, Galv. ASTM A153	4	S307SG6125
6	Lockwasher 5/8", ANSI B18-21-1, Galv. ASTM A153	16	S100WGS160
7	Nut 5/8"-11UNC, Heavy Hex, ASTM A563 GR, DH, Galv. ASTM A153	12	S563NGH60D
8	Special Bolt 1"-8UNC, ASTM A325, Galv. ASTM B695/ASTM A153	4	SBCSBB
9	Coupling 1"-8UNC, LP., AMS 6378D*, Galv. ASTM A153, Polyester Coat.**	4	SBCB1B
10	Shim 1" Horseshoe, 18 Gauge, Galv. Steel Sheet	2	S100WGS18
11	Shim 1" Horseshoe, 14 Gauge, Galv. Steel Sheet	2	S100WGS14
12	Anchor 1"-8UNC, 304 Stainless Steel Ferrule, AISI 1038 Rod & AISI 1008 Coil	4	SBABP
13	Hinge Plate Type B650, AISI 4130, Galv. ASTM A123	4	SBHB2B
14	Bolt Hinge, 3/4"-10UNCx2-1/4", Hex Hd., ASTM A325, Galv. ASTM A153	8	S325BG7225
15	Lockwasher 3/4", ANSI B18-21-1, Galv. ASTM A153	8	S100WGS170
16	Nut 3/4"-10UNC, Heavy Hex, ASTM A563, GR, DH, Galv. ASTM A153	8	S563NGH70D

* With exception to decarburization and macrostructure clauses.
** 1-3 Mil. thick Morton Powder Coatings' 20-7037 polyester powder coat.


No.	Revision	By	Date	In Charge Of
		Designed	KPD 3/97	
		Drawn	KPD 3/97	
		Checked	PTG 3/97	
		In Charge Of	RAL	

Maine Turnpike Authority
Maine Turnpike

YORK TOLL PLAZA
TOLL PLAZA MODIFICATIONS
BREAKAWAY SUPPORTS
B-650-LP

Contract 99.4 Sheet No. SP-3
19 of 42

(METPK) BDR-01

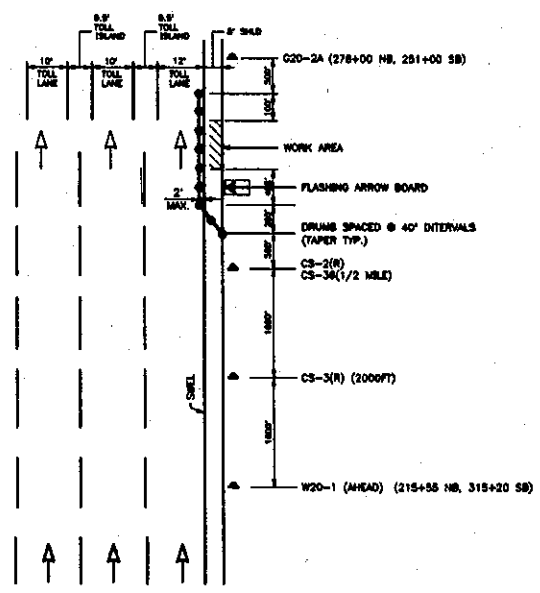

NOTE:
ALL SIGNS ARE TO BE MOUNTED ON POSTS.


SITE PLAN SIGN SUMMARY

IDENTIFICATION NUMBER	SIZE OF SIGN *		TEXT	TEXT DIMENSIONS (INCHES)			NUMBER OF SIGNS REQUIRED	COLOR		TOTAL AREA IN SQUARE FEET/SIGN
	WIDTH (IN.)	HEIGHT (IN.)		LETTER HEIGHT	VERTICAL SPACING	ARROW STEM MKR.		BACK-GROUND	LEGEND BORDER	
R2-1	24	30		5" C 5" C 5" C	5"		1	WHITE BLACK	5.00 (5)	
W11-2-A	36	36		5" C 5" C	2"		1	YELLOW BLACK	9.0 (9)	
W11-2	36	36		5" C 5" C	2"		1	YELLOW BLACK	9.0 (9)	
R8-3	36	48					17	WHITE RED	12.00 (204)	

PROPOSED TRAFFIC SIGN SUMMARY

IDENTIFICATION NUMBER	SIZE OF SIGN *		TEXT	TEXT DIMENSIONS (INCHES)			NUMBER OF SIGNS REQUIRED	COLOR		TOTAL AREA IN SQUARE FEET/SIGN
	WIDTH (IN.)	HEIGHT (IN.)		LETTER HEIGHT	VERTICAL SPACING	ARROW STEM MKR.		BACK-GROUND	LEGEND BORDER	
CS-2R	48	48		5" C 5" C 5" C	5"		4	ORANGE BLACK	16.00 (64)	
CS-36	24	18		5" C 5" C	2"		4		3.0 (12)	
CS-3(R)	48	48		5" C 5" C 5" C	5"		4		16.00 (64)	
G20-2A	48	24		TEXT DIMENSIONS SHALL CONFORM TO "STANDARD HIGHWAY SIGNS" - 1979			4		8.00 (32)	
W20-1 (XXX)	48	48					5	ORANGE BLACK	16.00 (80)	

NOTE:
*SIGN TEXT SHALL CONFORM TO M.U.T.C.D.

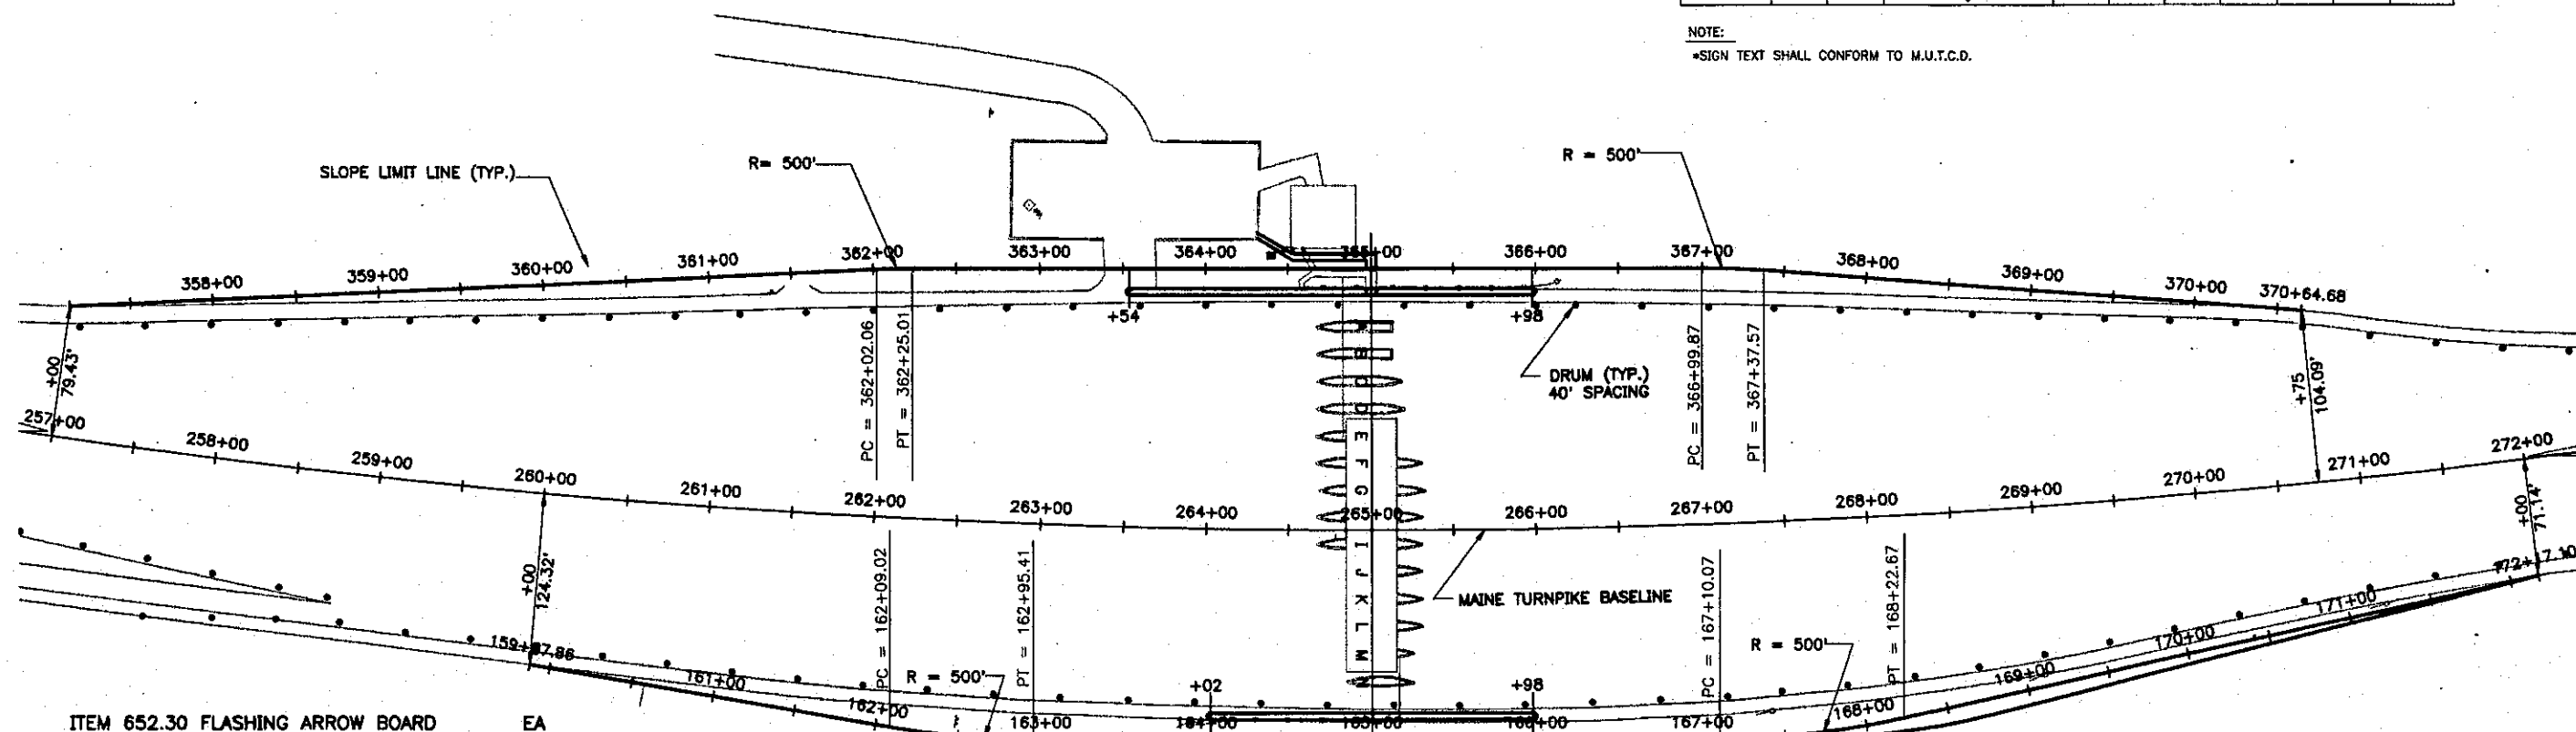

ITEM 652.30 FLASHING ARROW BOARD EA


SOUTHBOUND	1
STA. 275+80	
NORTHBOUND	1
STA. 255+15	

ITEM 652.33 DRUM EA

SOUTHBOUND	60
STA. 278+20 TO STA. 256+00	
NORTHBOUND	60
STA. 252+55 TO STA. 273+00	

NOTES

- ON THE NORTHBOUND SIDE OF THE TURNPIKE, PLACE THE TWO W20-1 SIGNS (ONE ON EACH SIDE OF THE NORTHBOUND ROADWAY AS SHOWN) AT STA. 215+55 (MAINE TURNPIKE BASELINE)
- ON THE SOUTHBOUND SIDE OF THE TURNPIKE, PLACE THE TWO W20-1 SIGNS (ONE ON EACH SIDE OF THE SOUTHBOUND ROADWAY AS SHOWN) AT STA. 315+20 (MAINE TURNPIKE BASELINE)
- ON THE NORTHBOUND ON-RAMP FROM CHASES POND ROAD PLACE ONE W20-1 (1000 FT.) SIGN ON RIGHT SIDE OF RAMP. LOCATION TO BE DETERMINED BY THE ENGINEER IN THE FIELD.

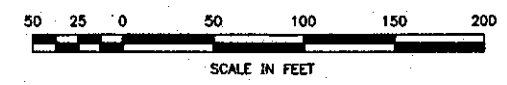

Maine Turnpike Authority
Maine Turnpike





YORK TOLL PLAZA
TOLL PLAZA MODIFICATIONS
TRAFFIC MAINTENANCE

Transpass

Contract 99.4
Sheet No. TM-1
20 of 42




By	Date
Designed DLP	2/99
Drawn DLP	2/99
Checked RWB	2/99
In Charge OF	RAL

(METPK BDR-01)

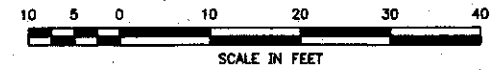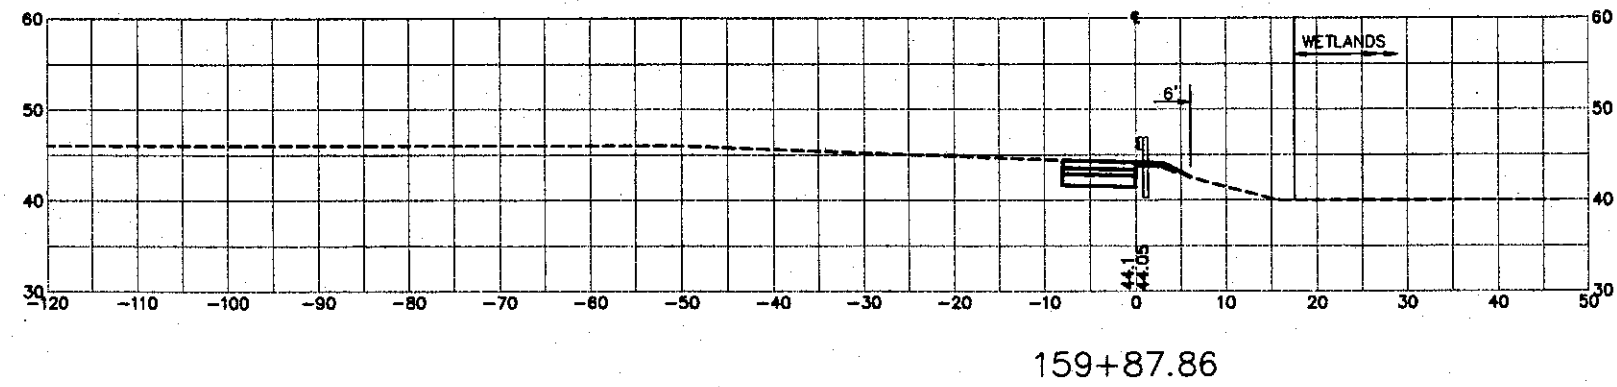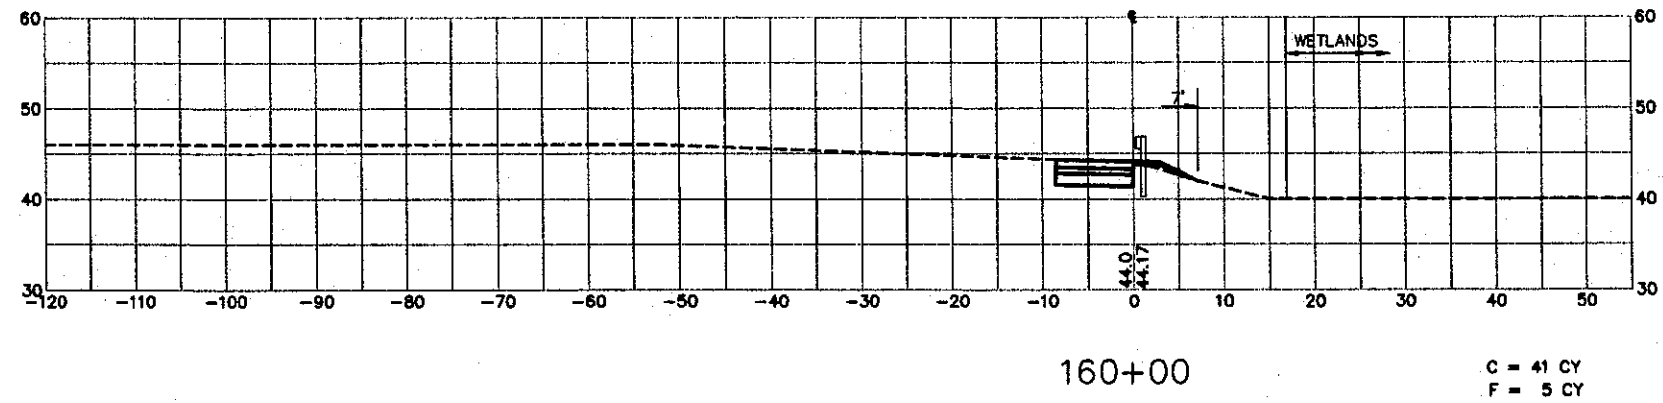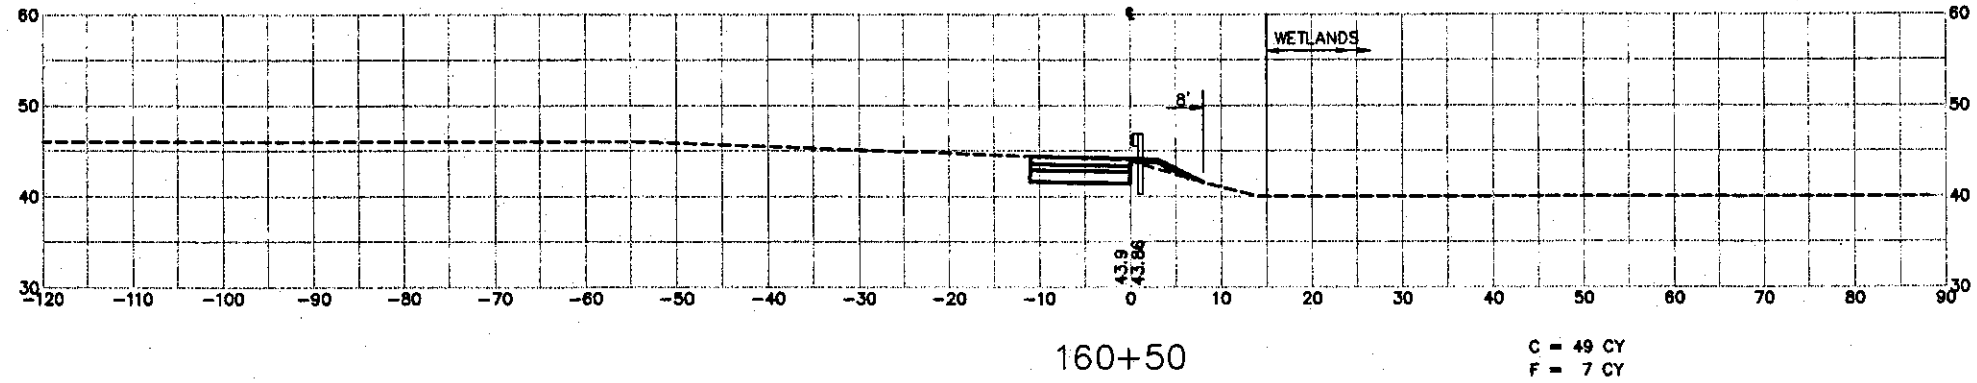

Maine Turnpike Authority Maine Turnpike	
YORK TOLL PLAZA TOLL PLAZA MODIFICATIONS CROSS SECTIONS STA. 159+87.86 TO STA. 160+50	
HNTB ARCHITECTS ENGINEERS PLANNERS	
Contract 99.4	Sheet No. CS-NB 21 of 42

No.	Revision	By	Date	In Charge Of	RAL
		Designed	WEF	1/99	
		Drawn	WEF	1/99	
		Checked	RWB	1/99	

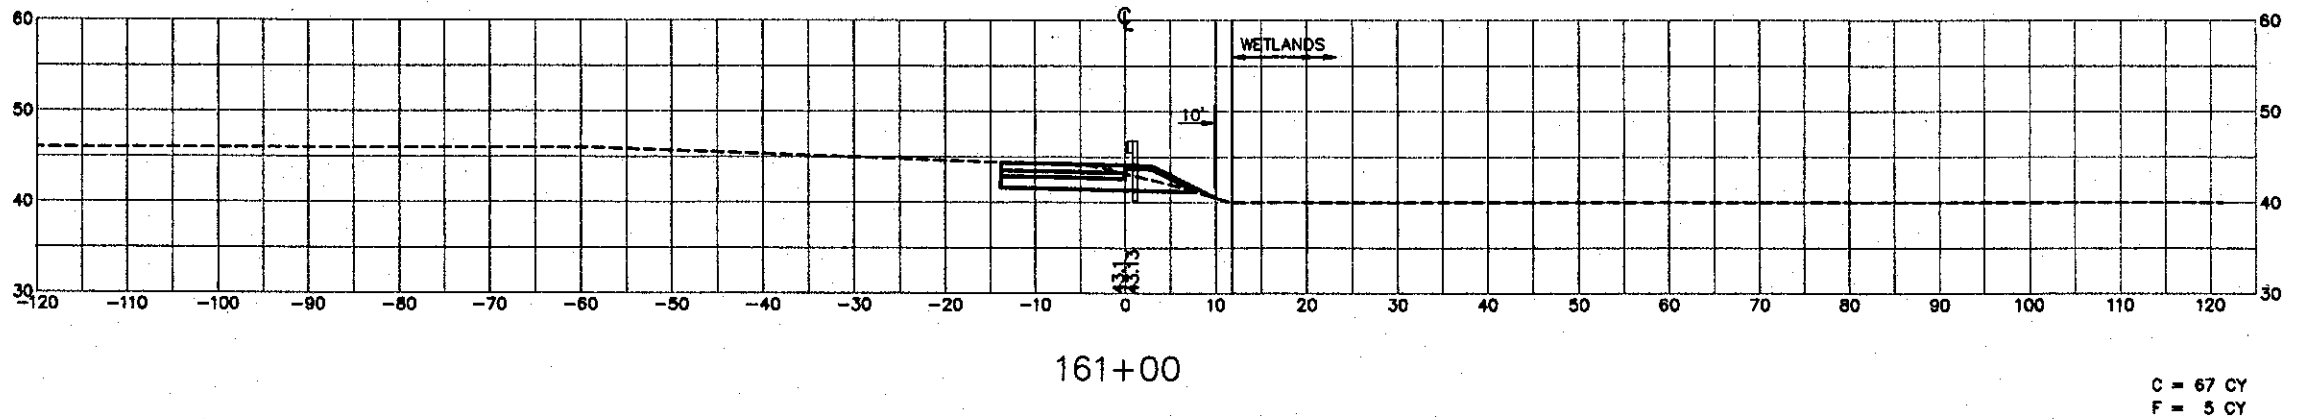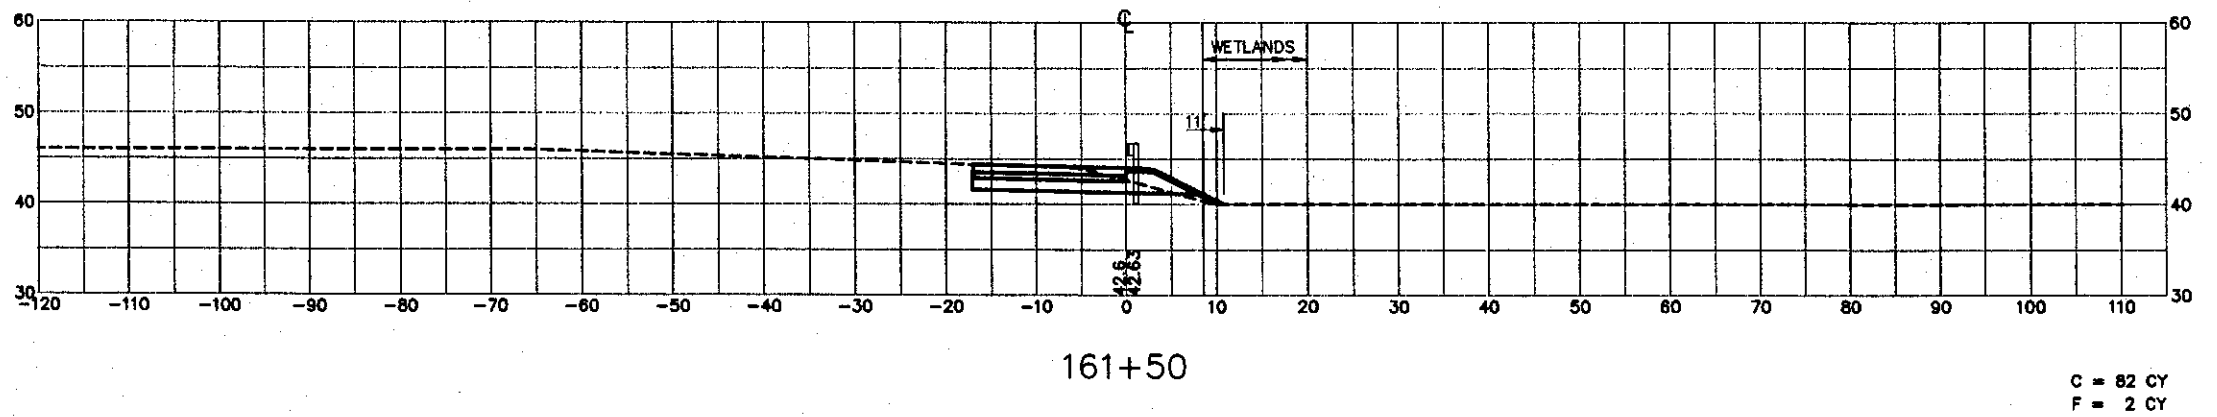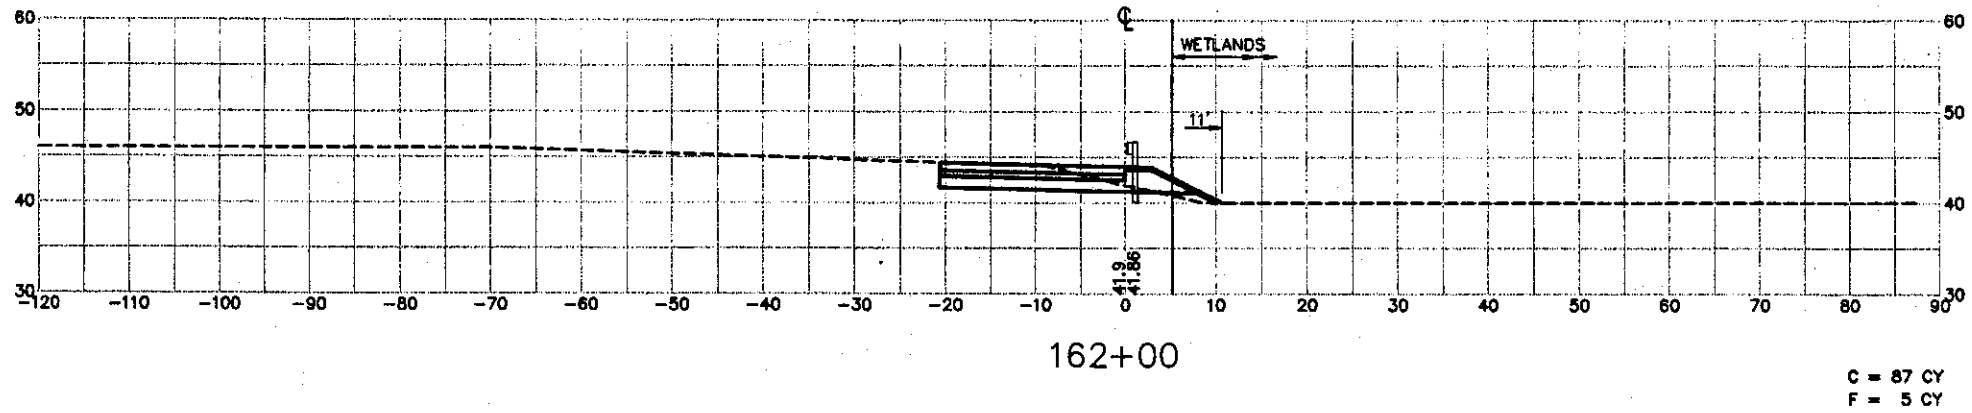

Maine Turnpike Authority
Maine Turnpike




YORK TOLL PLAZA
TOLL PLAZA MODIFICATIONS
CROSS SECTIONS
STA.161+00 TO STA.162+00

HNTB
CONSULTING ENGINEERS

Contract 99.4 Sheet No. CS-NB
22 of 42

No.	Revision	By	Date	In Charge Of	RAL
		Designed	WEF	1/99	
		Drawn	WEF	1/99	
		Checked	RWB	1/99	

(METPK\BDR-01)

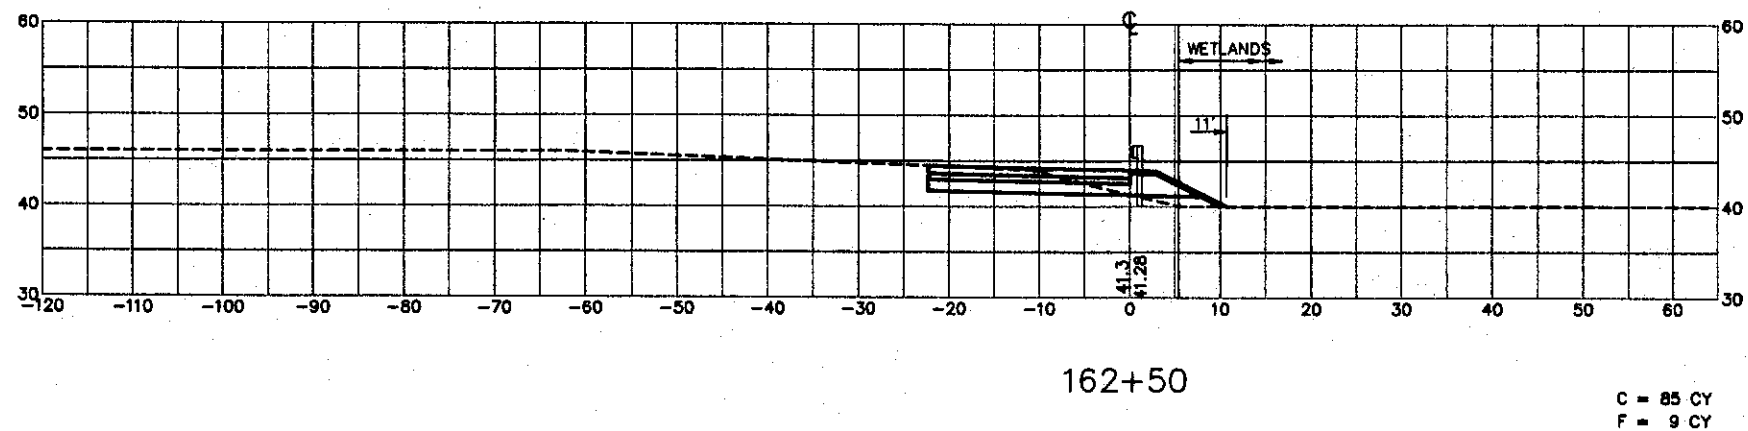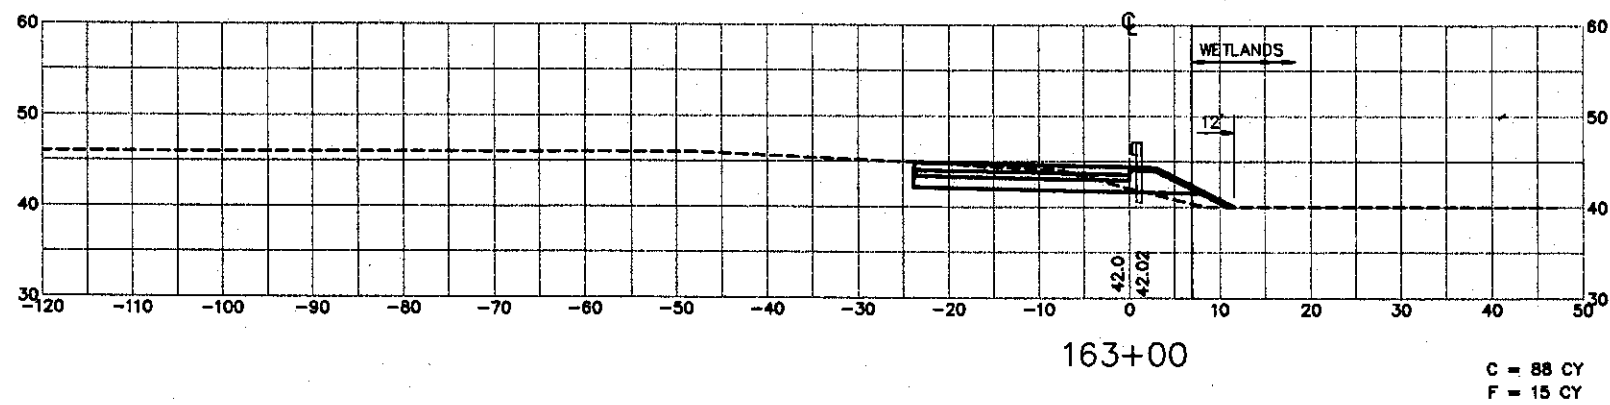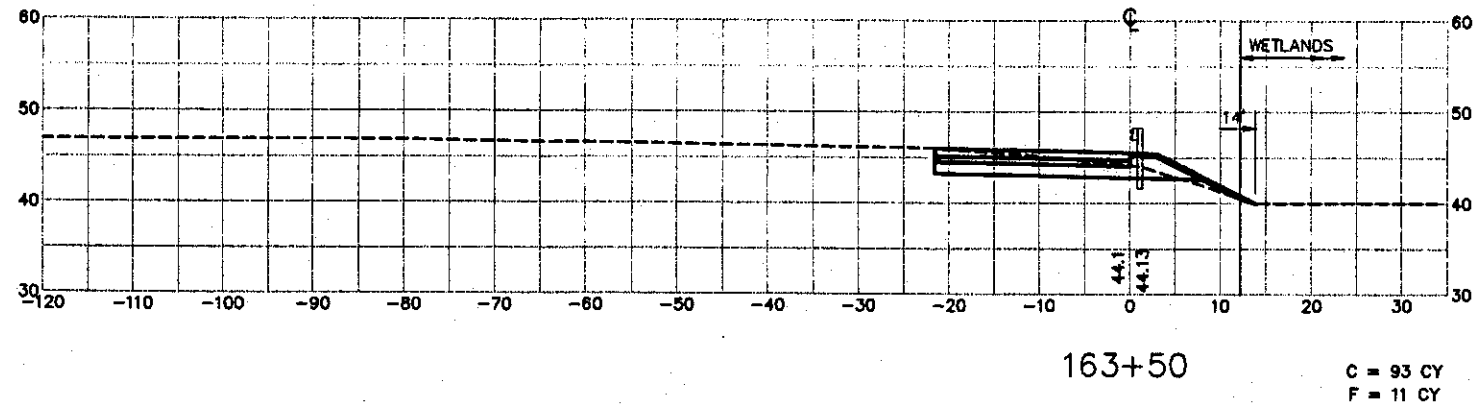

Maine Turnpike Authority
Maine Turnpike

YORK TOLL PLAZA
TOLL PLAZA MODIFICATIONS
CROSS SECTIONS
STA. 162+50 TO STA. 163+50

Trans
pass





HNTB
ARCHITECTS ENGINEERS PLANNERS

Contract 99.4

Sheet No. CS-NB
23 of 42

No.	Revision	By	Date	In Charge Of	RAL
		Designed	WEF	1/99	
		Drawn	WEF	1/99	
		Checked	RWB	1/99	





(METPK)\BDR-01

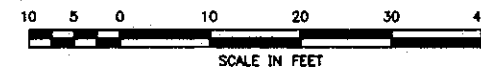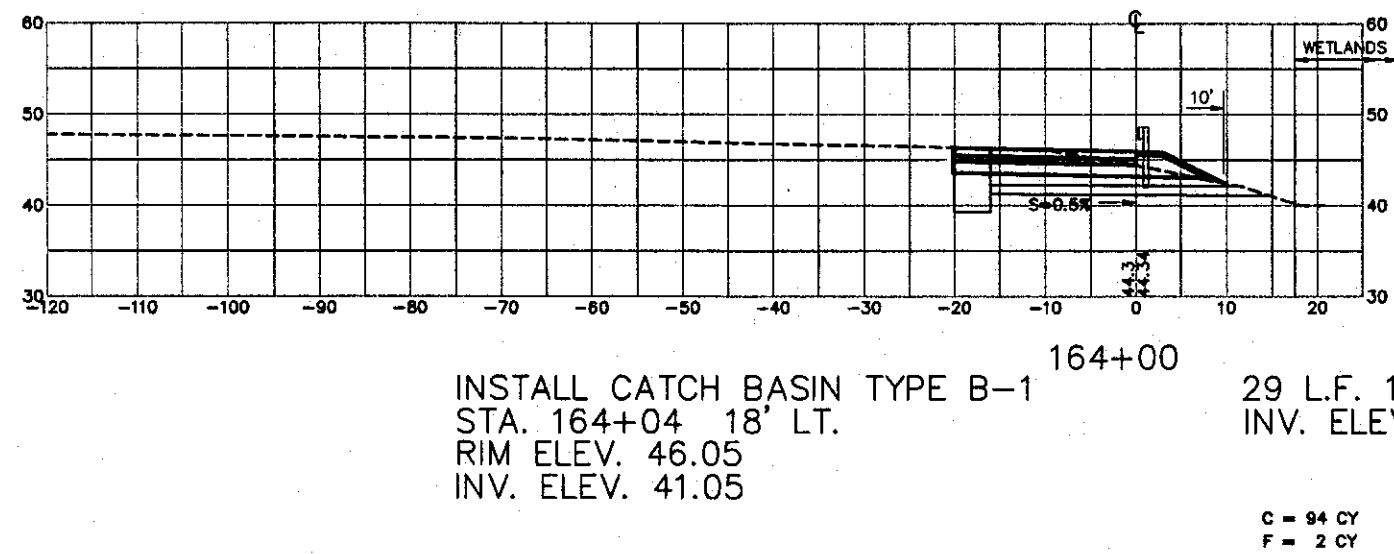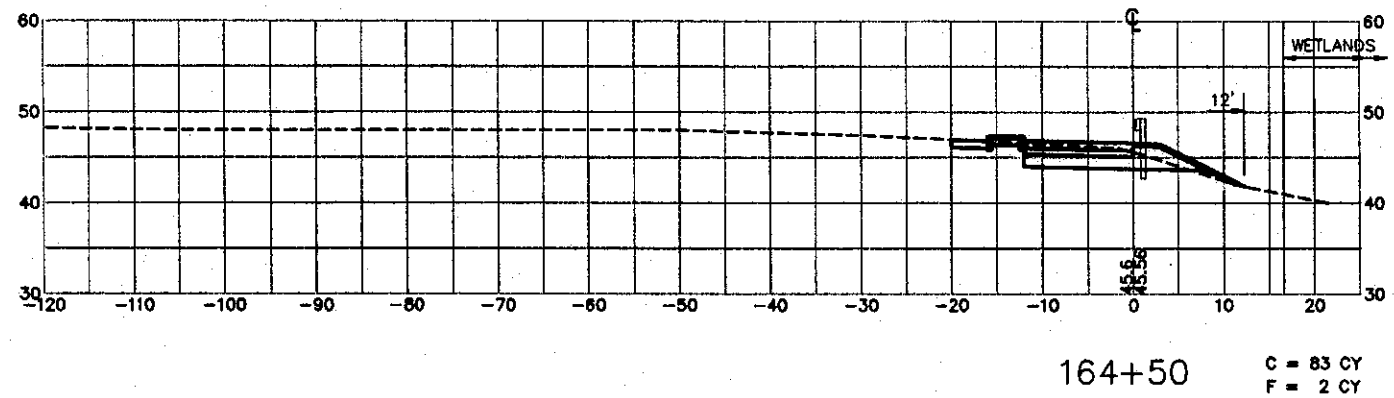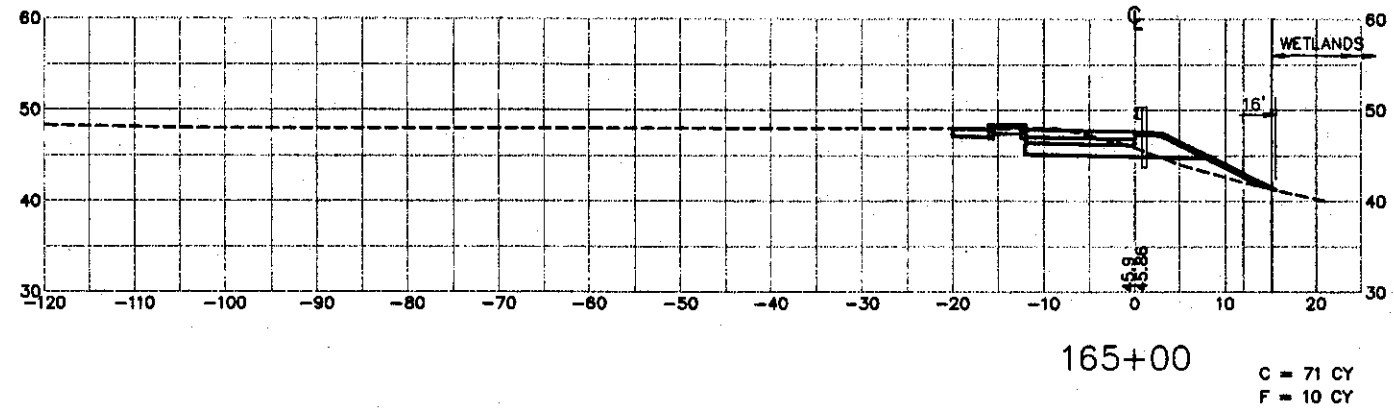

No.	Revision	By	Date	In Charge Of
		Designed	WEF 1/99	
		Drawn	WEF 1/99	
		Checked	RWB 1/99	
		In Charge Of	RAL	

Maine Turnpike Authority Maine Turnpike	
YORK TOLL PLAZA TOLL PLAZA MODIFICATIONS CROSS SECTIONS STA. 164+00 TO STA. 165+00	
HNTE	
Contract 99.4	Sheet No. CS-NB 24 of 42

(METPK\BDR-01)

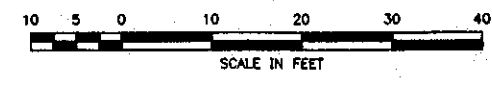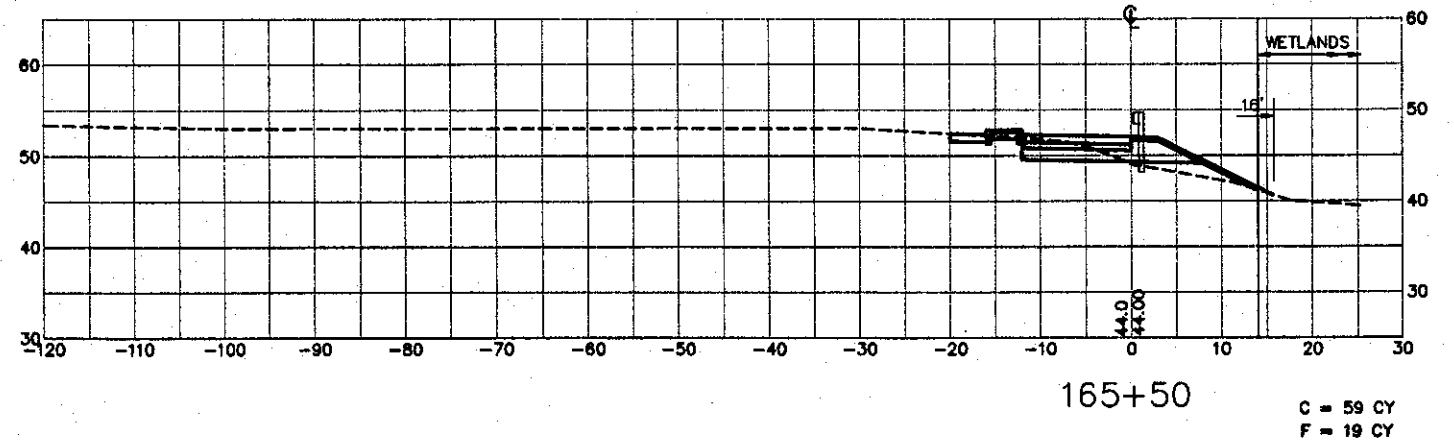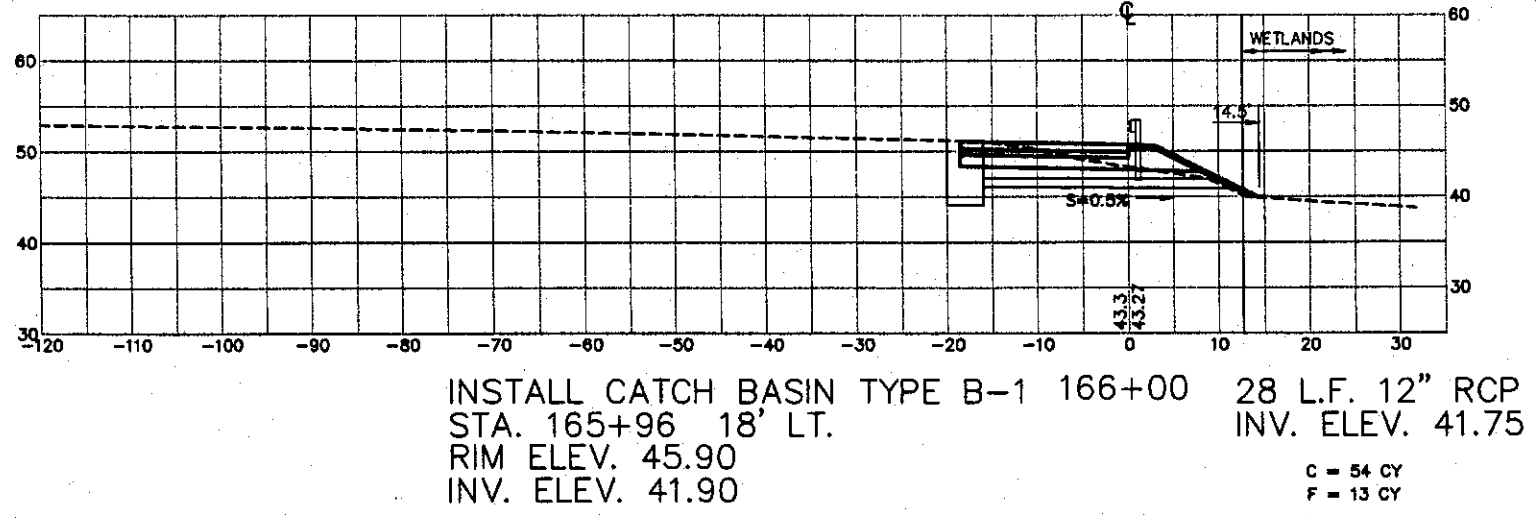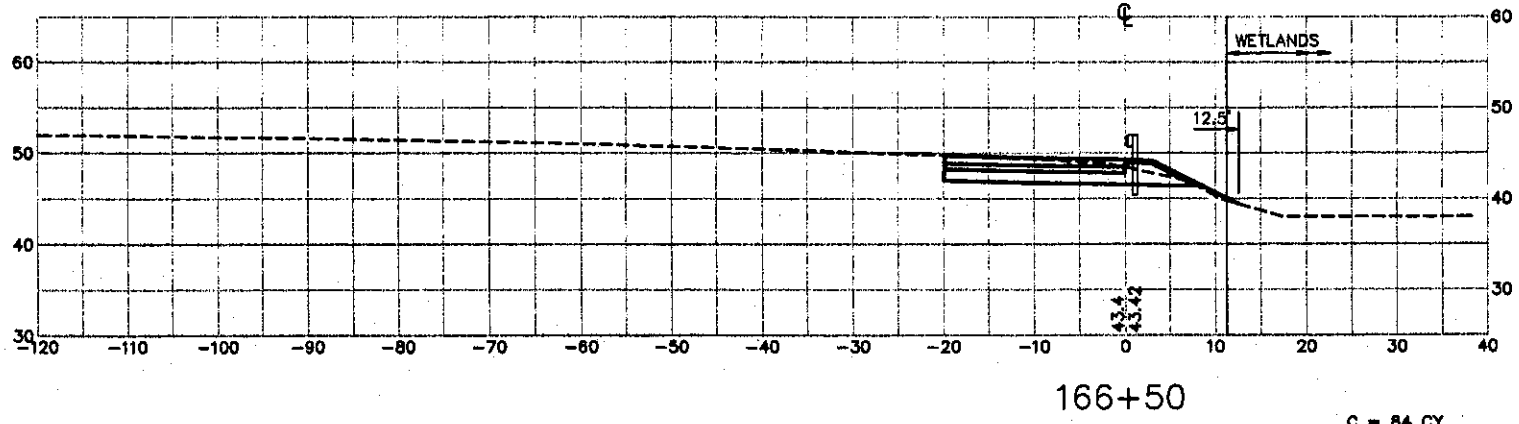


Maine Turnpike Authority
Maine Turnpike

YORK TOLL PLAZA
TOLL PLAZA MODIFICATIONS
CROSS SECTIONS
STA. 165+50 TO STA. 166+50

HNTB
ARCHITECTS ENGINEERS PLANNERS


Contract 99.4 Sheet No. CS-NB
25 of 42

By	Date
Designed WEF	1/99
Drawn WEF	1/99
Checked RWB	1/99
In Charge Of RAL	

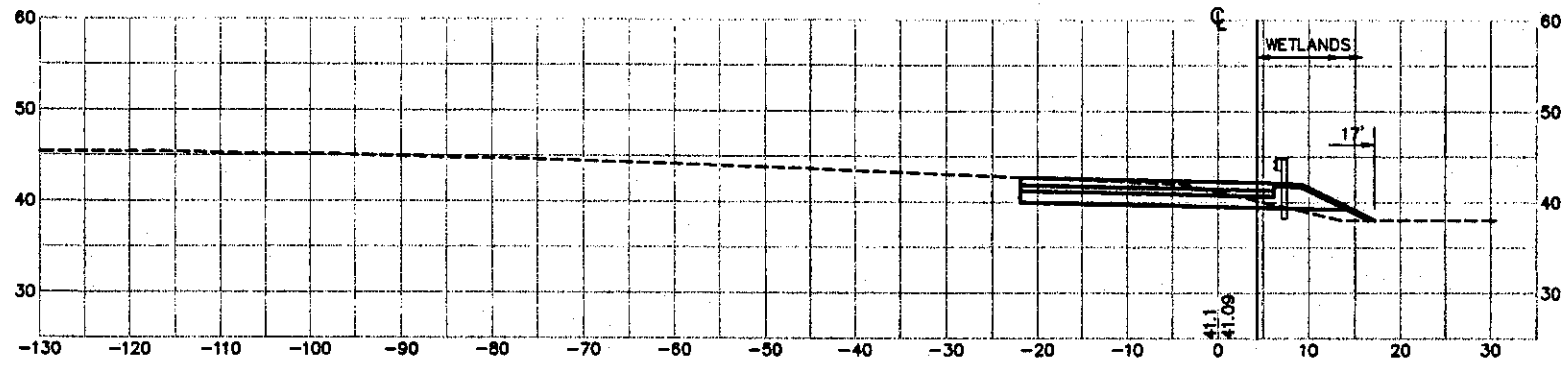


168+00

C = 108 CY
F = 10 CY

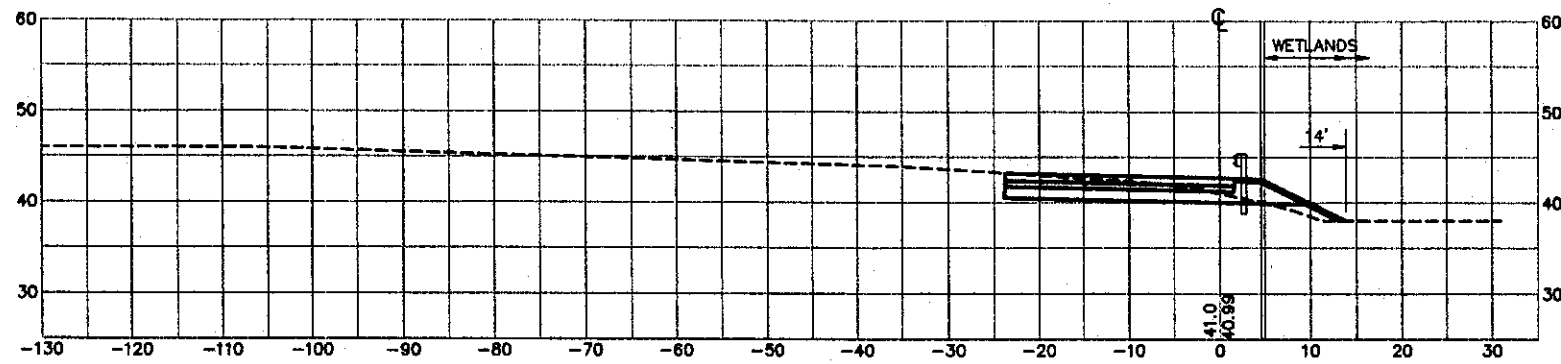


167+50

C = 92 CY
F = 13 CY

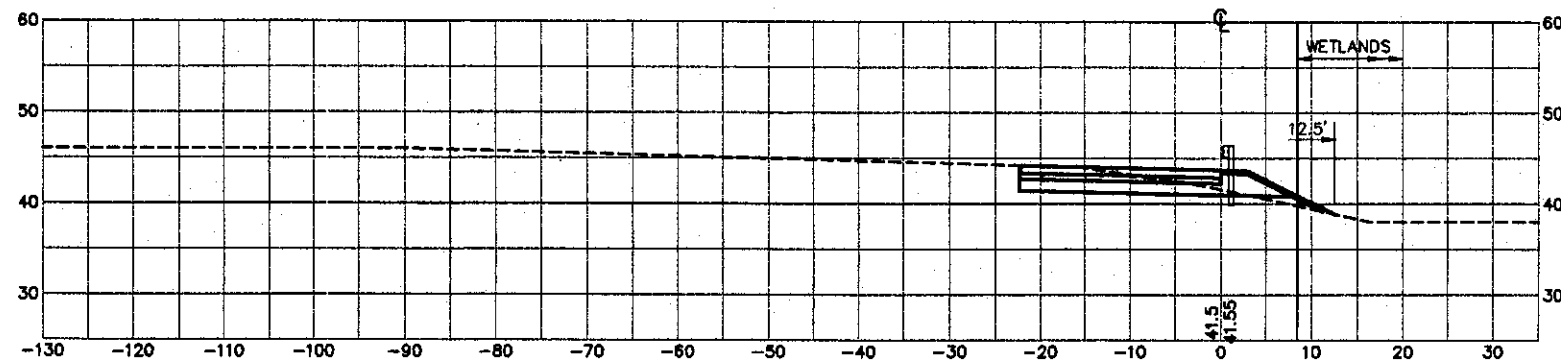

167+00

C = 97 CY
F = 9 CY

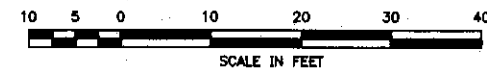

Maine Turnpike Authority
Maine Turnpike


YORK TOLL PLAZA
TOLL PLAZA MODIFICATIONS
CROSS SECTIONS
STA.167+00 TO STA.168+00

Trans
pass

HNTB
ARCHITECTURAL ENGINEERS PLANNERS


Contract 99.4 Sheet No. CS-NB
26 of 42

No.	Revision	By	Date	In Charge Of:
		Designed	WEF	1/99
		Drawn	WEF	1/99
		Checked	RWB	1/99
				RAL

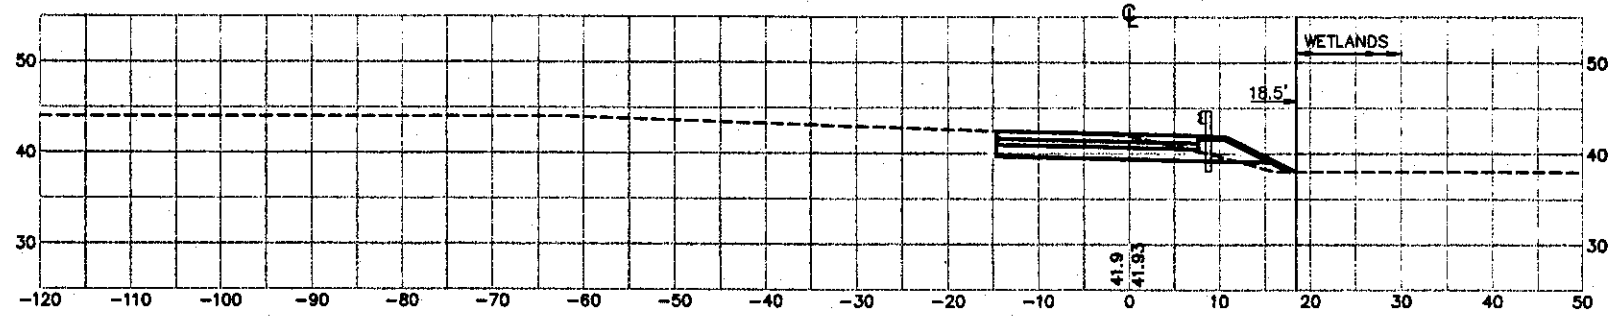


169+50

C = 103 CY
F = 7 CY

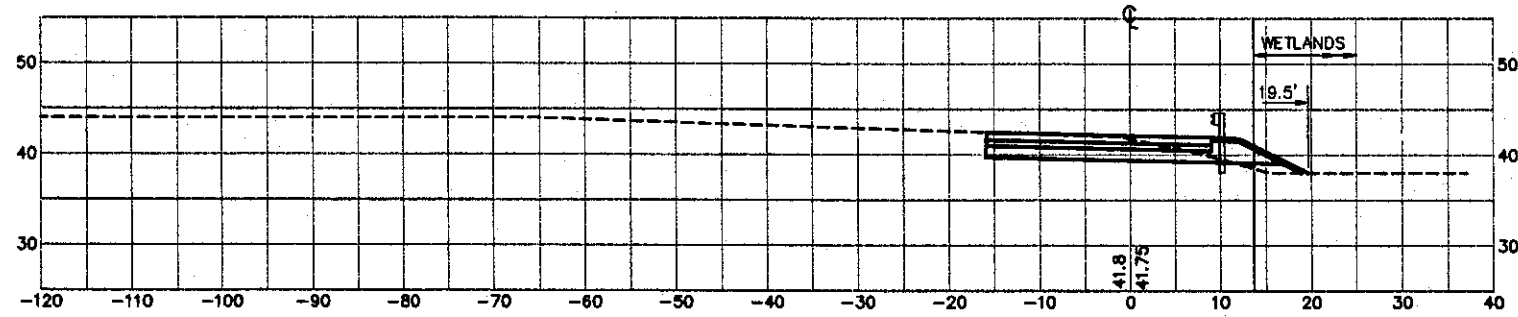


169+00

C = 112 CY
F = 9 CY

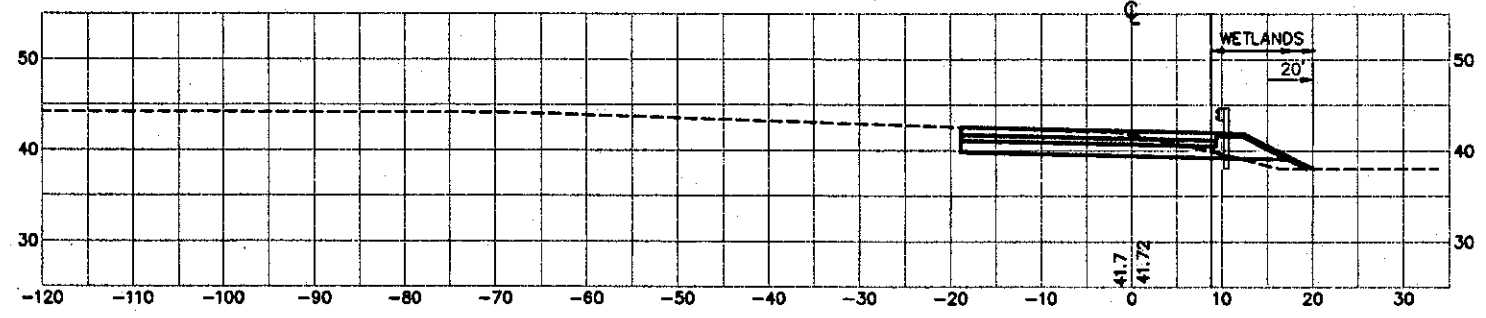

168+50

C = 116 CY
F = 10 CY

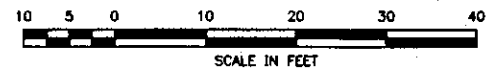

Maine Turnpike Authority
Maine Turnpike

YORK TOLL PLAZA
TOLL PLAZA MODIFICATIONS
CROSS SECTIONS
STA.168+50 TO STA.169+50

Trans
Express





HNTB
CONSULTING ENGINEERS

Contract 99.4

Sheet No. CS-NB
27 of 42

No.	Revision	By	Date	In Charge Of	RAL


(METPK\BDR-01)

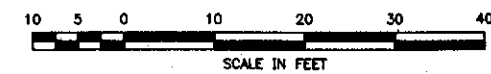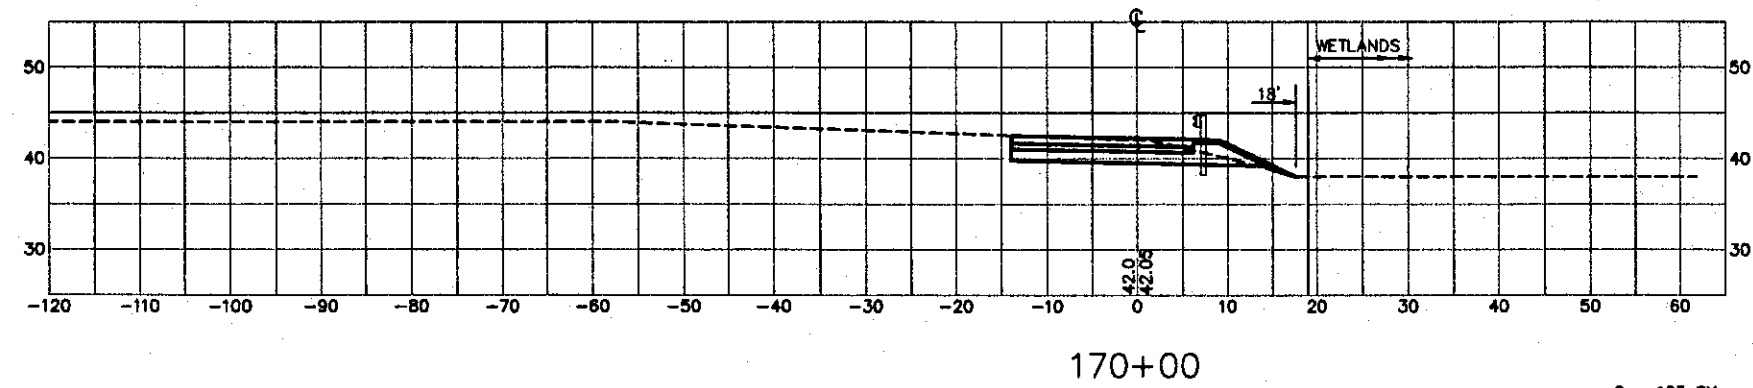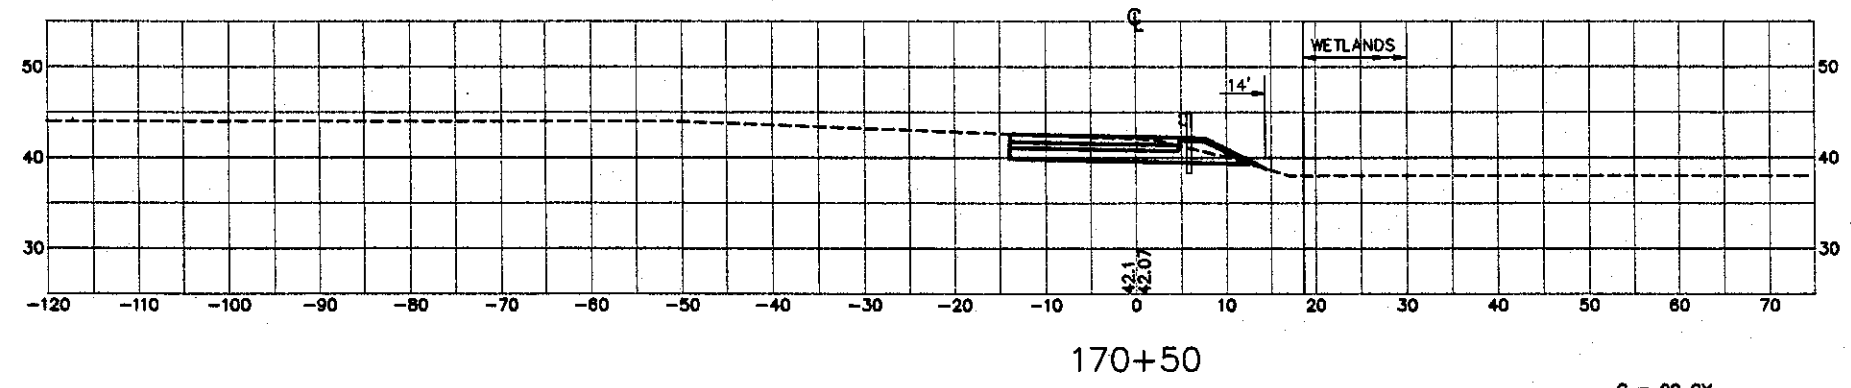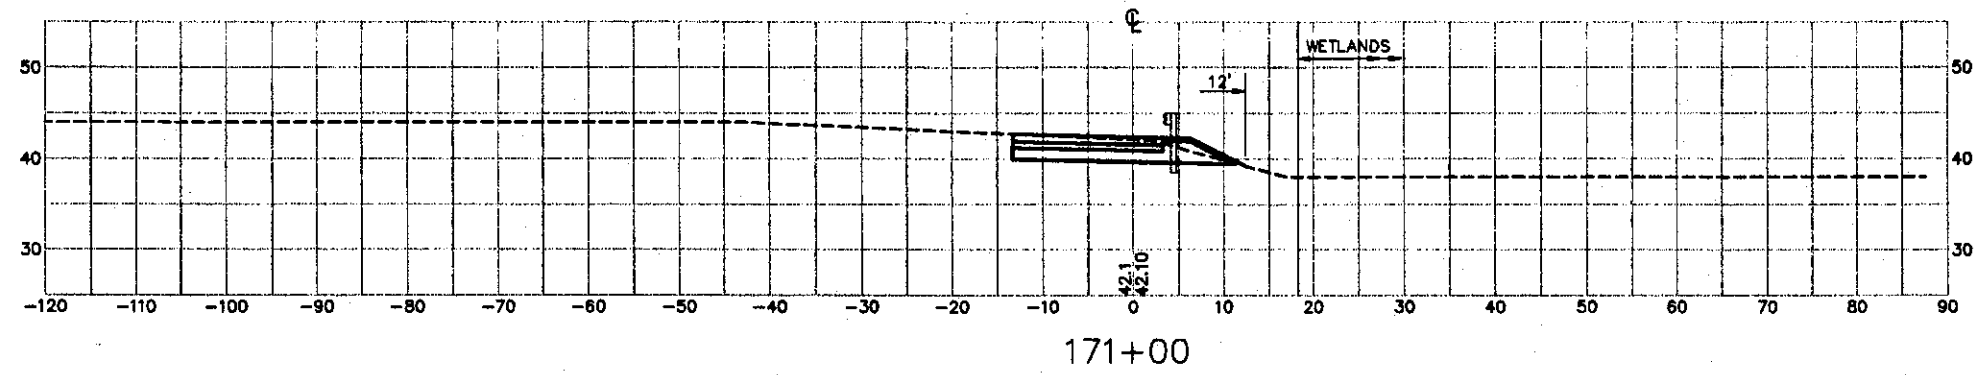

Maine Turnpike Authority
Maine Turnpike
 YORK TOLL PLAZA
 TOLL PLAZA MODIFICATIONS
 CROSS SECTIONS
 STA.170+00 TO STA.171+00


Contract 99.4 Sheet No. CS-NB
 28 of 42

No.	Revision	By	Date	In Charge Of
		Designed	WEF 1/99	
		Drawn	WEF 1/99	
		Checked	RWB 1/99	
		In Charge Of	RAL	

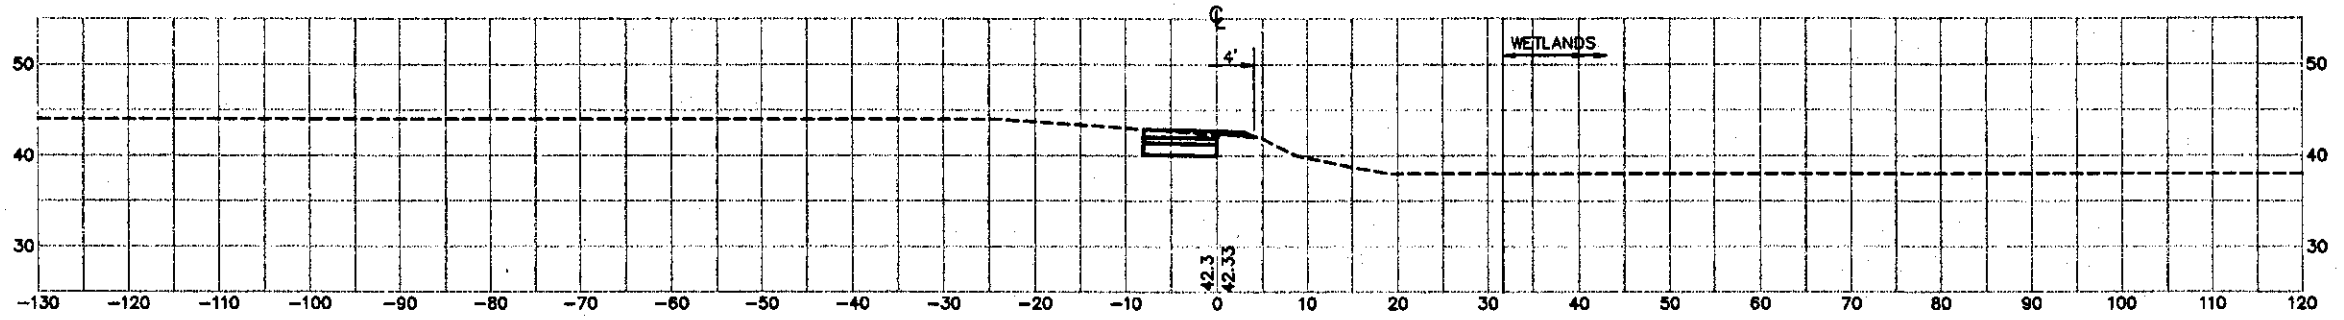


172+17.10

C = 43 CY
F = 5 CY

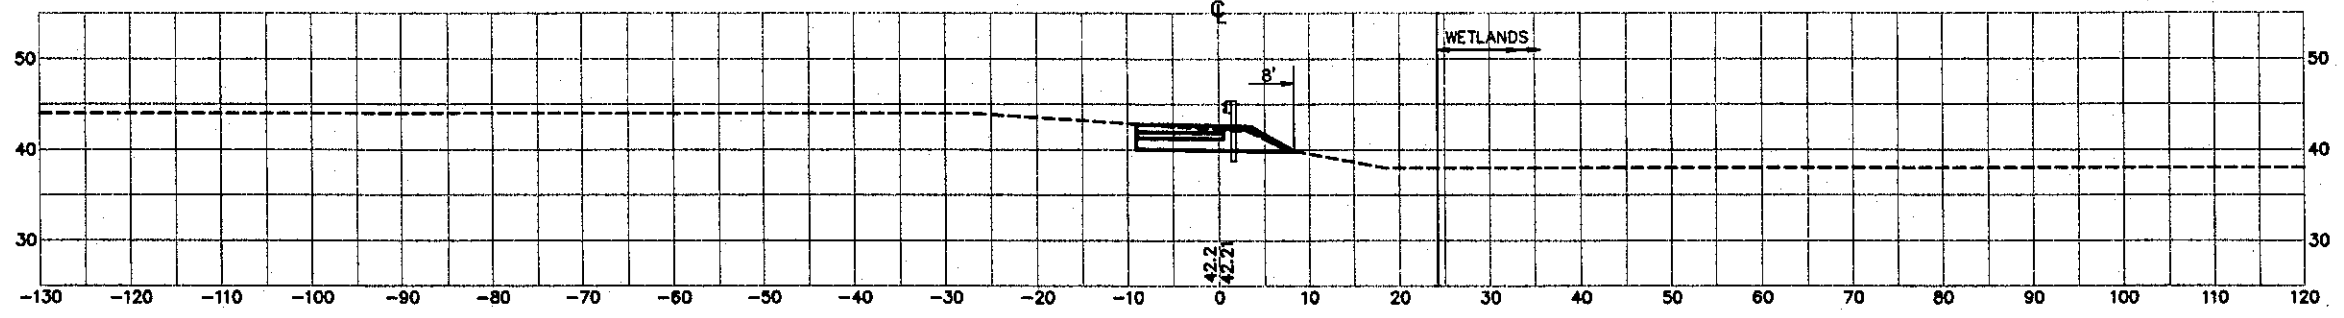


172+00


C = 54 CY
F = 8 CY

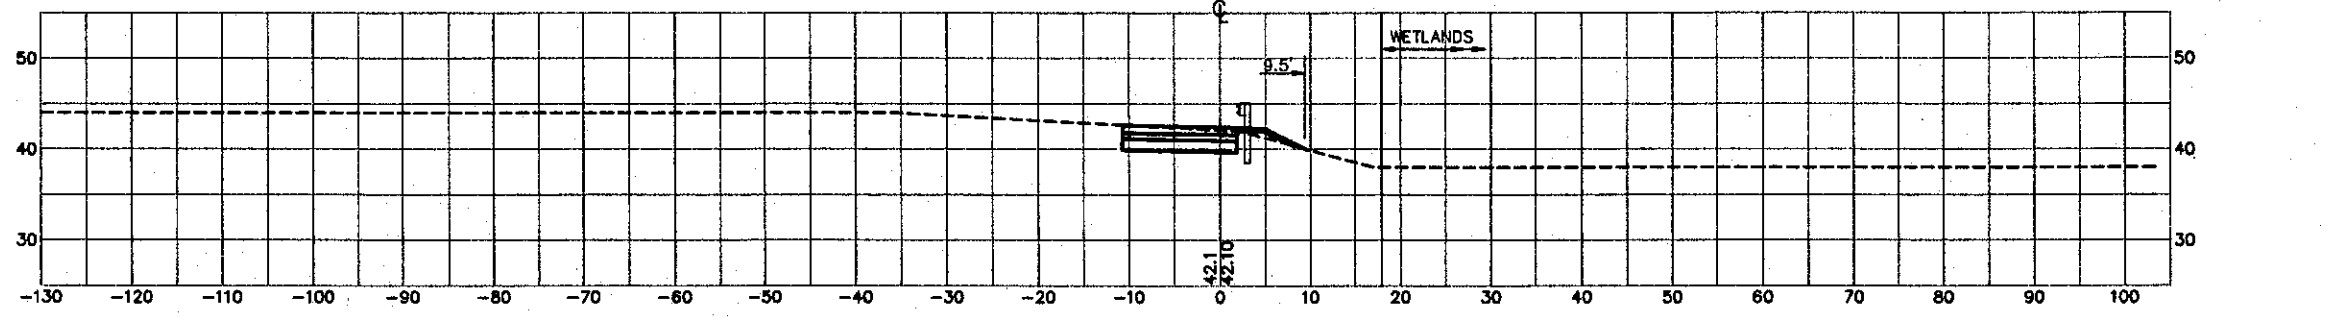

171+50


C = 69 CY
F = 5 CY

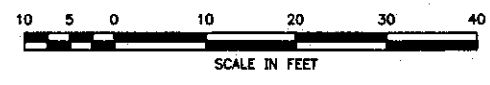

Maine Turnpike Authority	
Maine Turnpike	
	YORK TOLL PLAZA
	TOLL PLAZA MODIFICATIONS CROSS SECTIONS STA. 171+50 TO STA. 172+17.10
HNTB	
<small>REGISTERED PROFESSIONAL ENGINEERS</small>	
Contract 99.4	Sheet No. CS-NB 29 of 42


No.	Revision	By	Date	In Charge Of
		Designed	WEF 1/99	
		Drawn	WEF 1/99	
		Checked	RWB 1/99	
		In Charge Of	RAL	

(METPK\BDR-01)

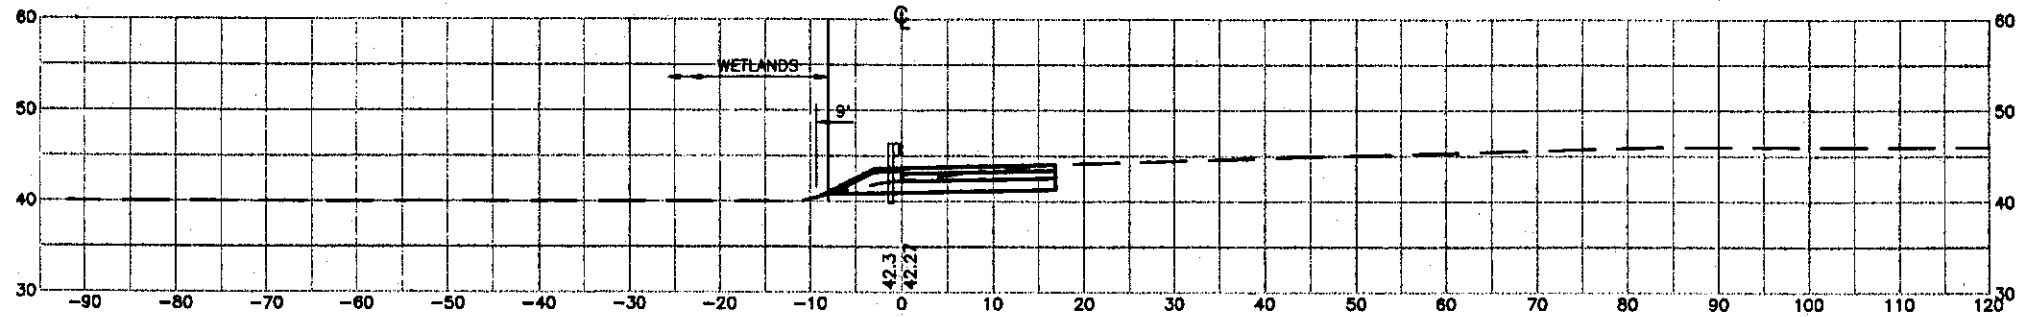


359+50

C = 81 CY
F = 0 CY

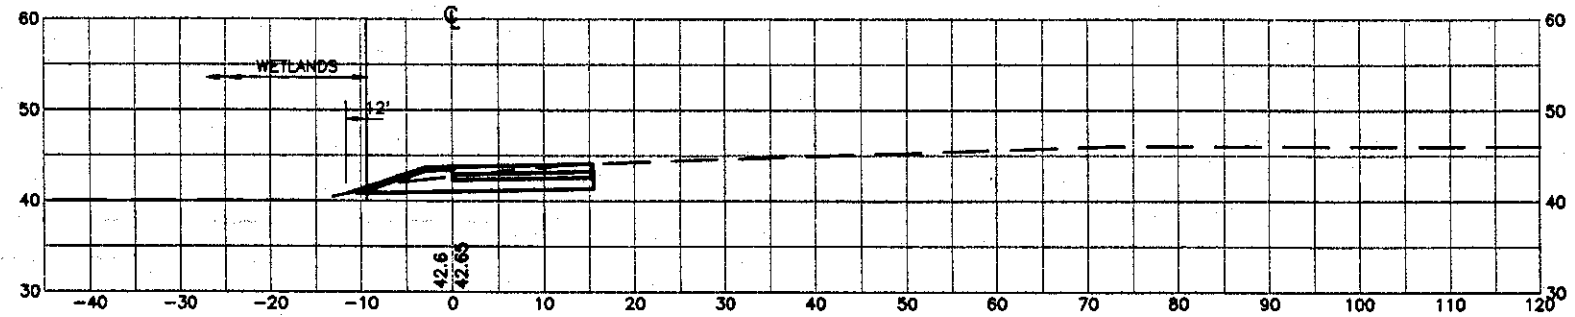

359+00

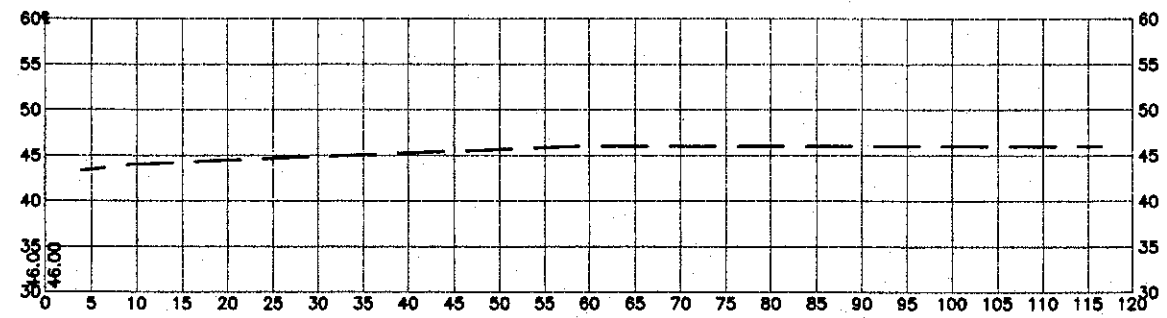

358+50


358+50



Maine Turnpike Authority Maine Turnpike	
YORK TOLL PLAZA TOLL PLAZA MODIFICATIONS CROSS SECTIONS STA.358+50 TO STA.359+50	
HNTB ARCHITECTS ENGINEERS PLANNERS	
Contract 99.4	Sheet No. CS-SB 30 of 42


No.	Revision	By	Date	In Charge Of
		Designed	WEF 1/99	
		Drawn	WEF 1/99	
		Checked	RWB 1/99	
				RAL

(METPK BDR-01)

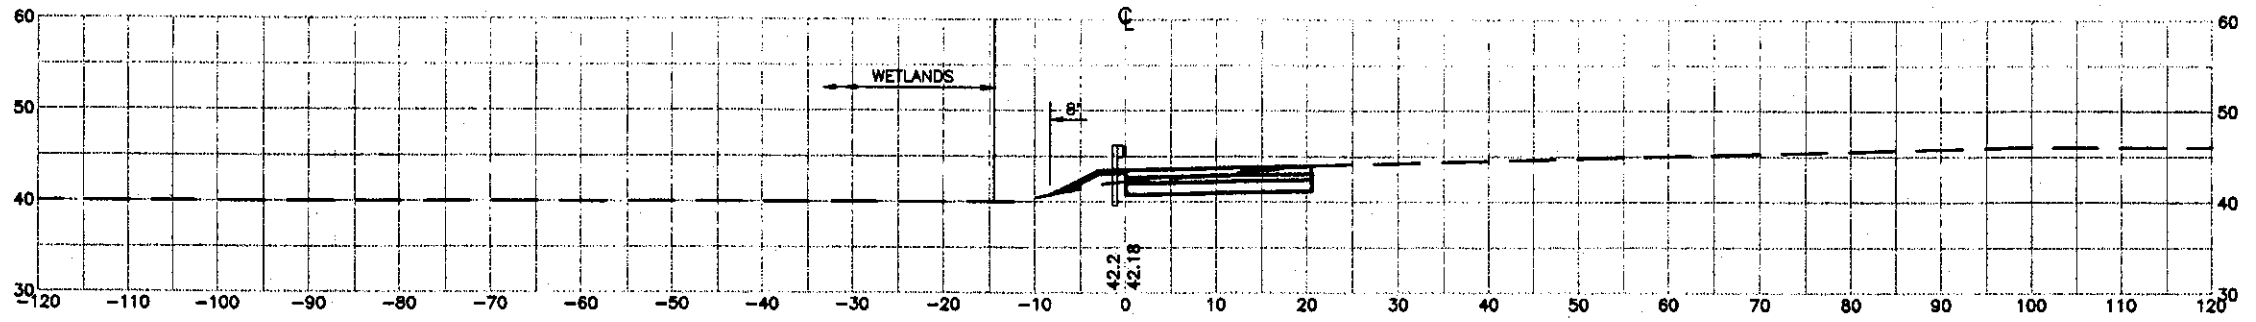


361+00

C = 80 CY
F = 7 CY

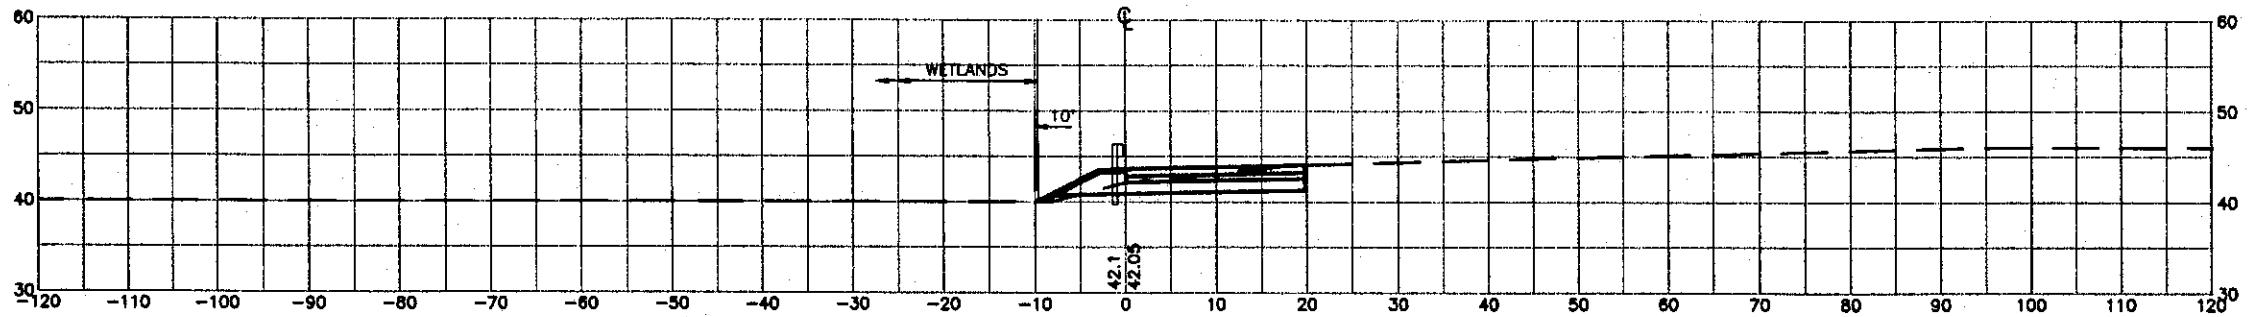


360+50

C = 78 CY
F = 3 CY

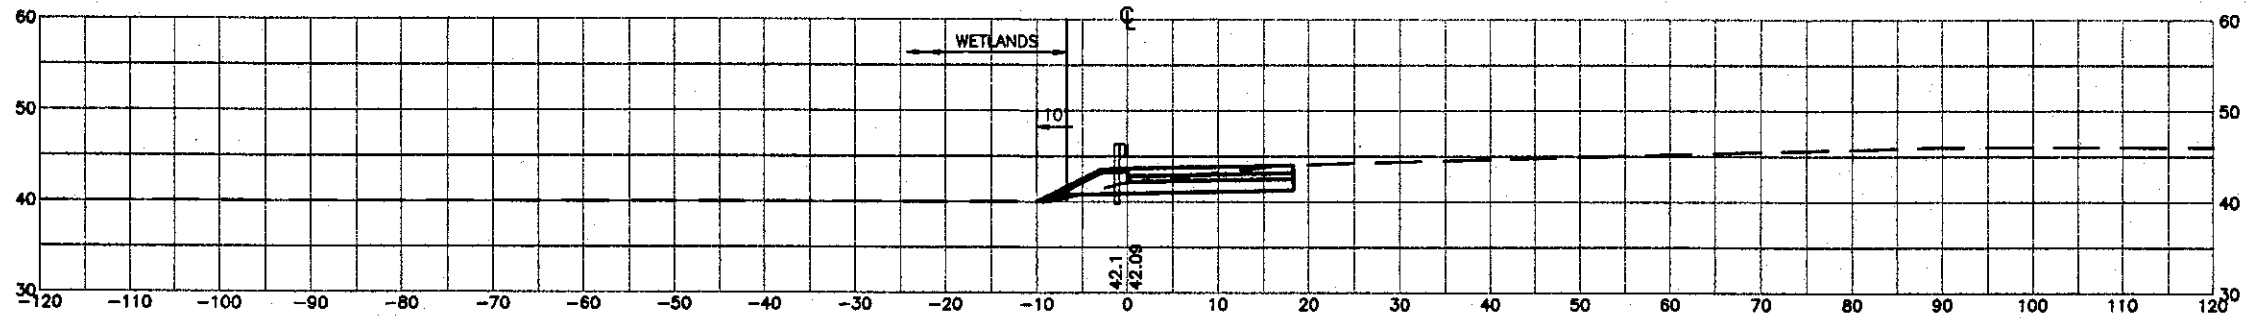

360+00

C = 76 CY
F = 2 CY

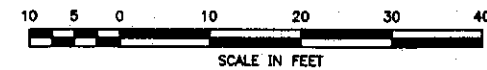


Maine Turnpike Authority
Maine Turnpike
 YORK TOLL PLAZA
 TOLL PLAZA MODIFICATIONS
 CROSS SECTIONS
 STA.360+00 TO STA.361+00

HNTB
 ARCHITECTS ENGINEERS PLANNERS
 Contract 99.4
 Sheet No. CS-SB
 31 of 42


No.	Revision	By	Date	In Charge Of
		Designed	WEF 1/99	
		Drawn	WEF 1/99	
		Checked	RWB 1/99	
				RAL

(METPK/BDR-01)

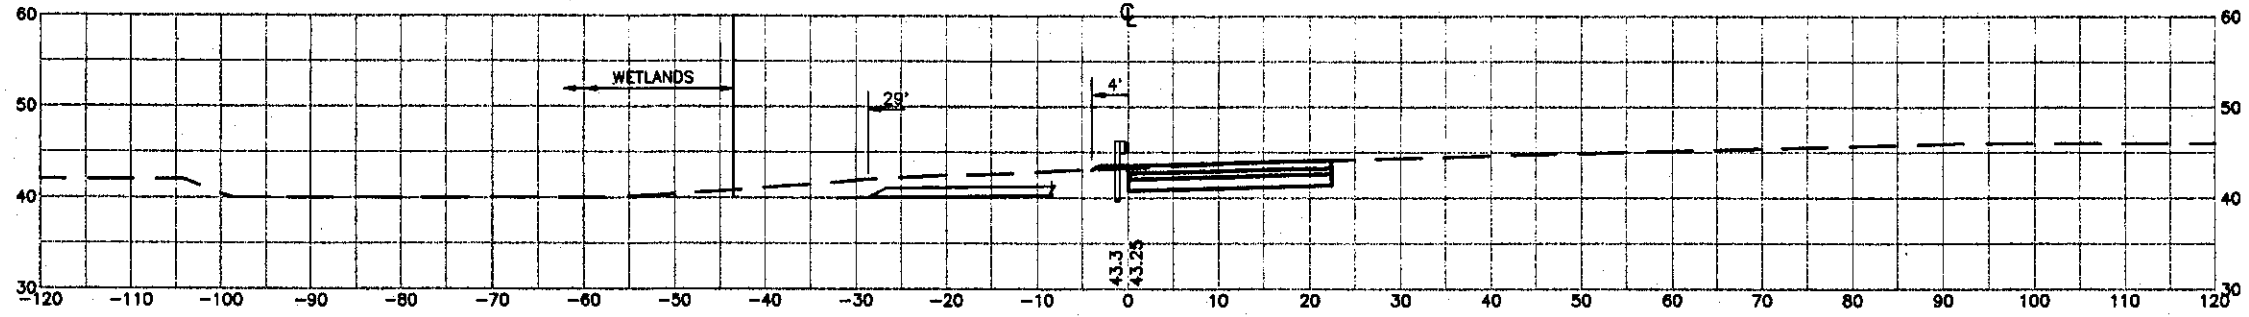


STA. 362+35 29' LT 362+50
 130 L.F. 12" RCP
 INV. ELEV. 40.25

C = 102 CY
 F = 5 CY

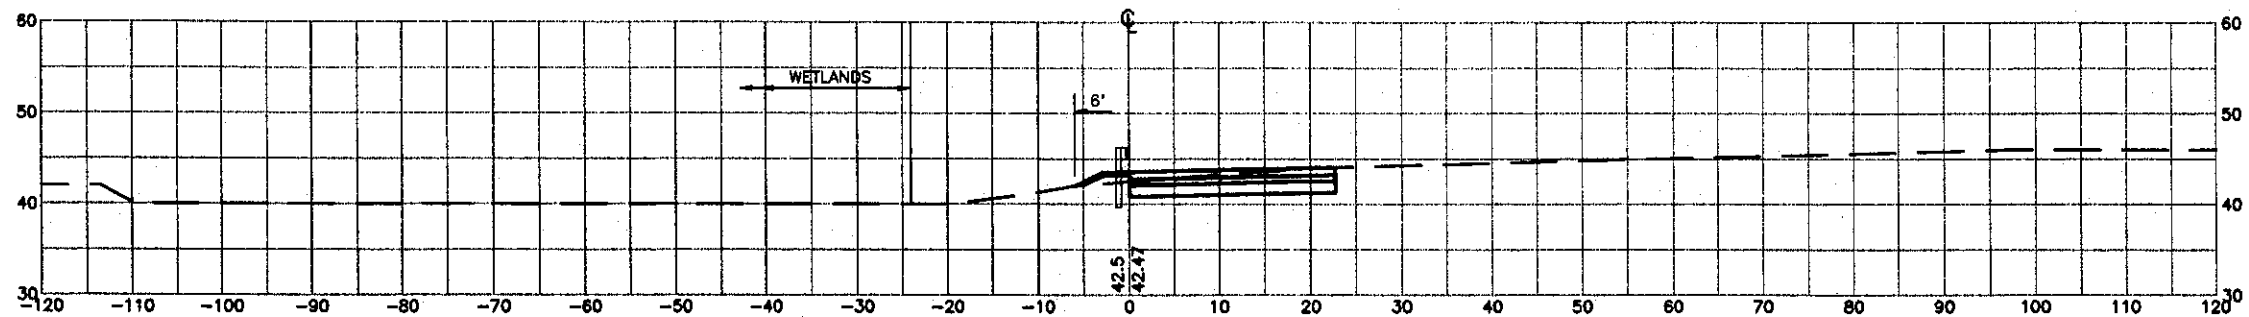


362+00

C = 93 CY
 F = 6 CY

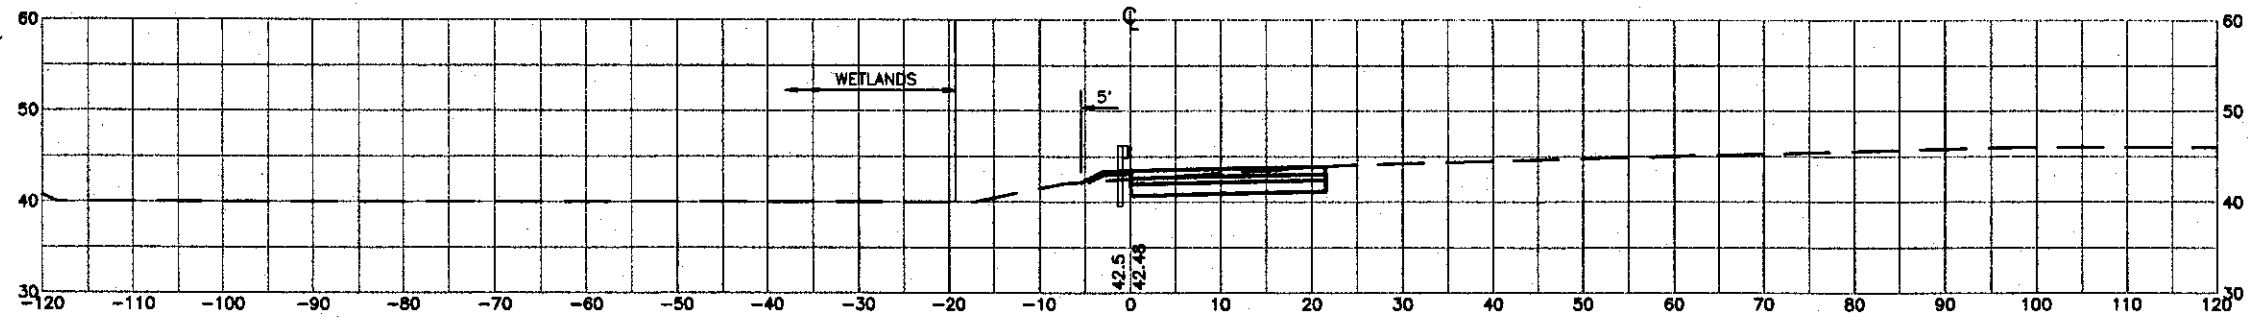

361+50

C = 85 CY
 F = 8 CY

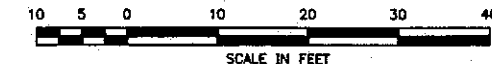

SCALE IN FEET

Maine Turnpike Authority
Maine Turnpike


Trans
 YORK TOLL PLAZA
 TOLL PLAZA MODIFICATIONS
 CROSS SECTIONS
 STA.361+50 TO STA.362+50

HNTB
 ARCHITECTS ENGINEERS PLANNERS

Contract 99.4 Sheet No. CS-SB
 32 of 42


No.	Revision	By	Date	In Charge Of
		Designed	WEF 1/98	
		Drawn	WEF 1/98	
		Checked	RWB 1/98	
				RAL

(METPK BOR-01)

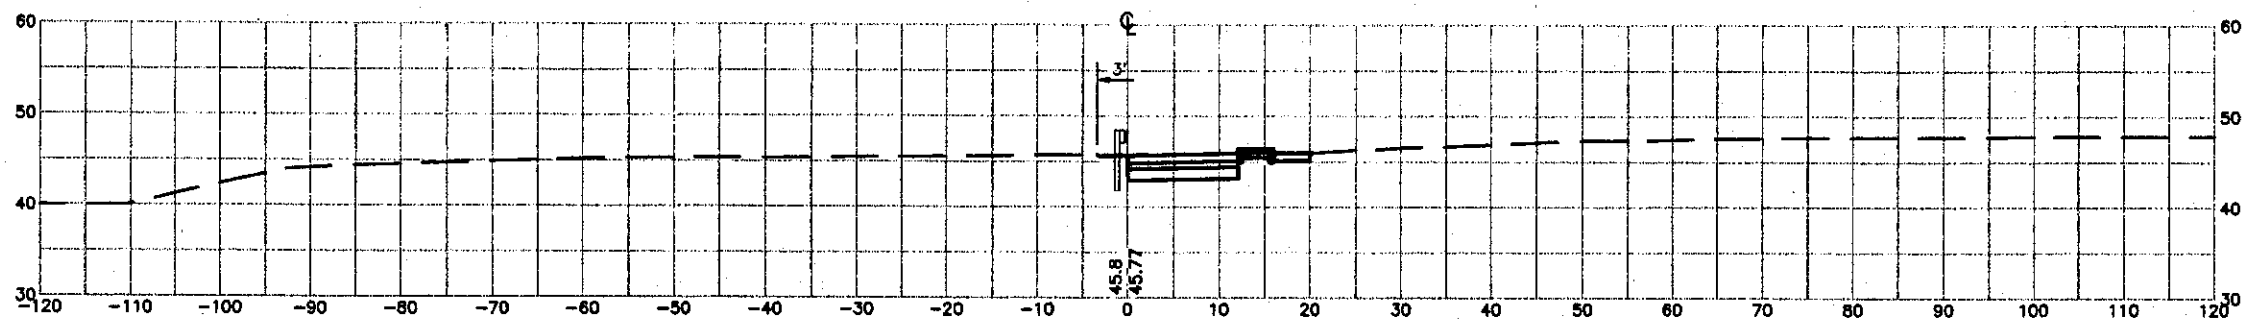


INSTALL CATCH BASIN TYPE B-1
 STA. 363+56 18' RT. 364+00
 RIM ELEV. 45.32
 INV. ELEV. 40.24

C = 132 CY
 F = 0 CY

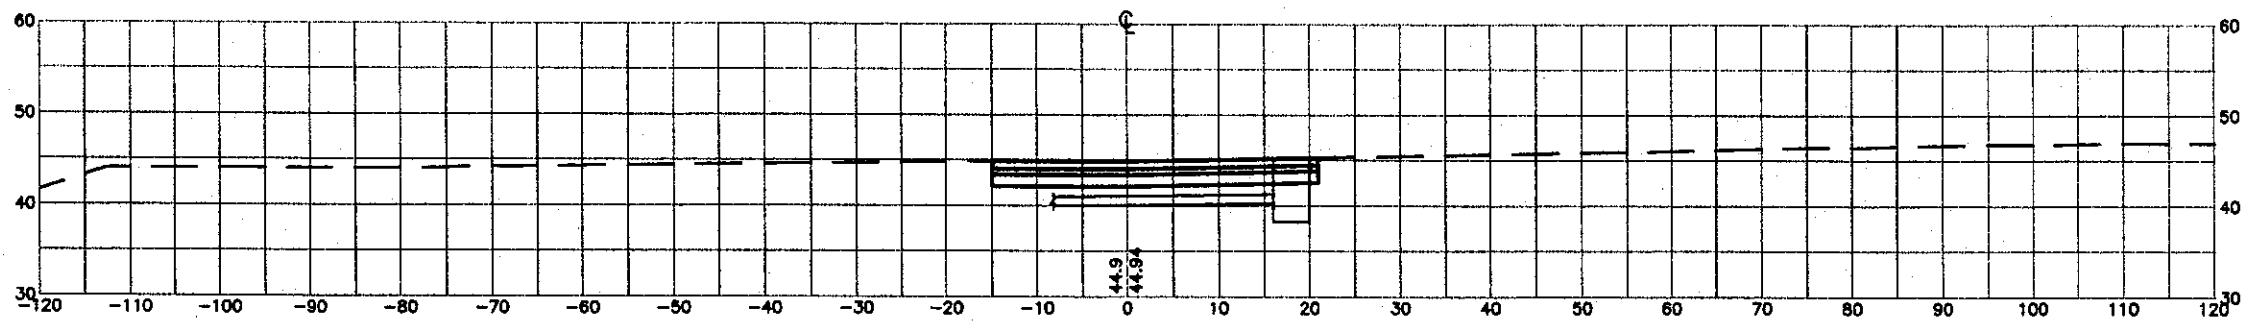


363+50

C = 150 CY
 F = 1 CY

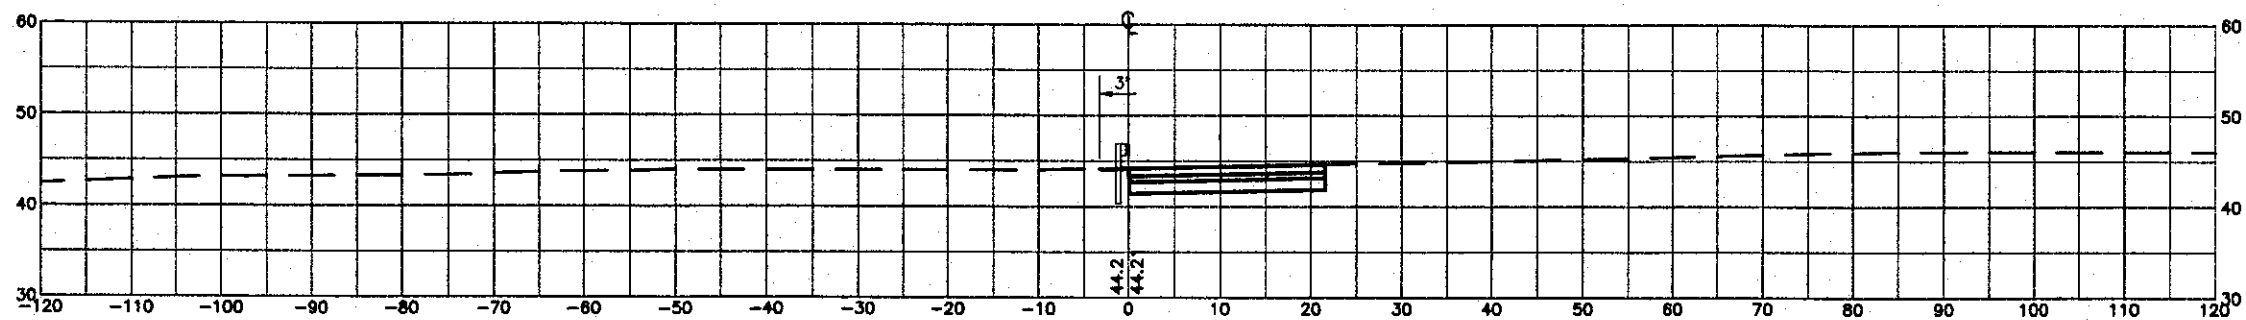

363+00

C = 110 CY
 F = 2 CY

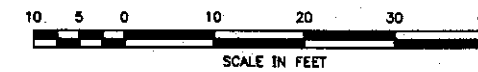

Maine Turnpike Authority
Maine Turnpike

Trans
pass

YORK TOLL PLAZA
 TOLL PLAZA MODIFICATIONS
 CROSS SECTIONS
 STA. 363+00 TO STA. 364+00


HNTB
 ARCHITECT/ENGINEER/PLANNER

Contract 99.4

Sheet No. CS-SB
 33 of 42


No.	Revision	By	Date	In Charge Of

(METPK)\BDR-01

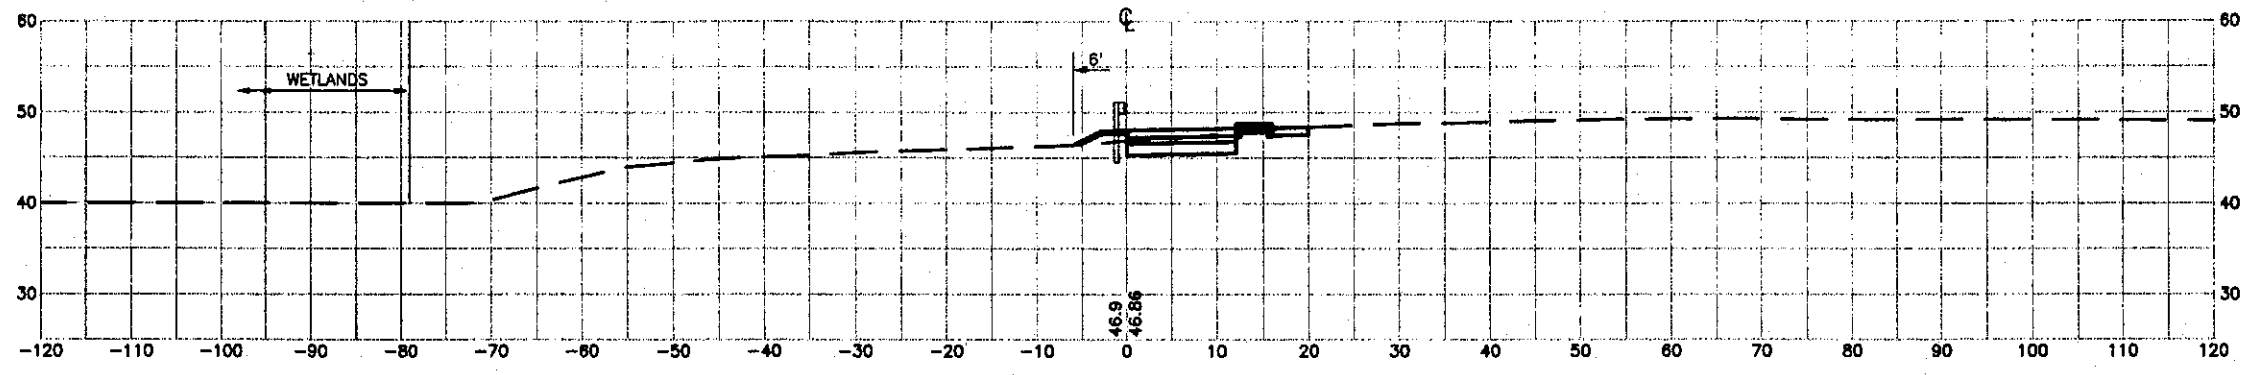


365+50

C = 65 CY
F = 4 CY

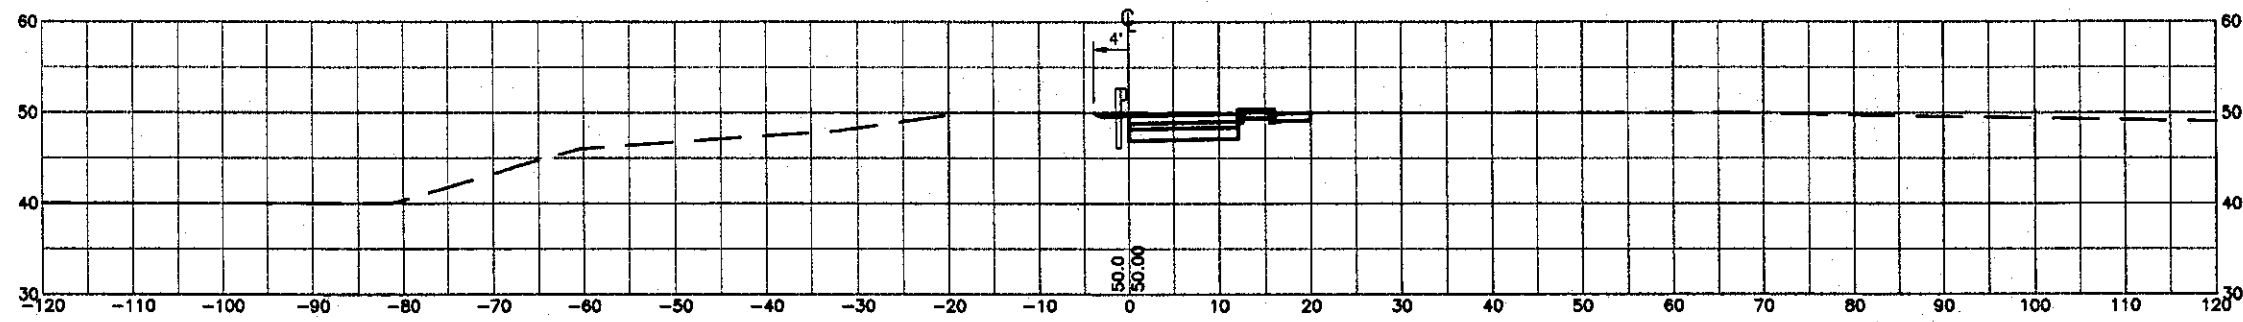


365+00

C = 73 CY
F = 0 CY

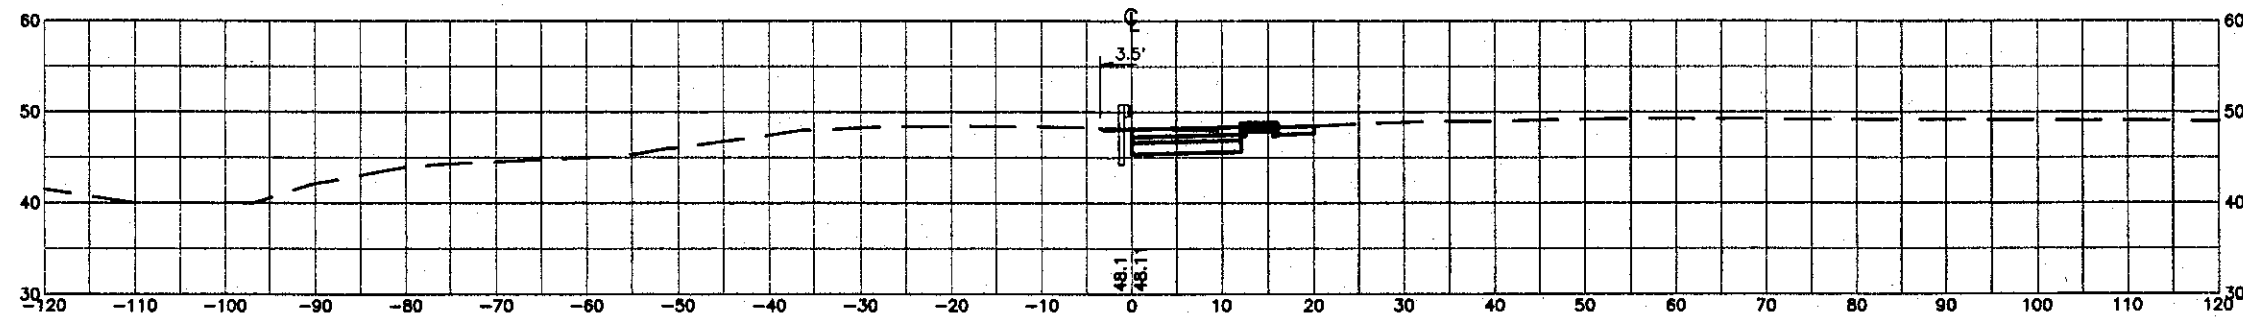

364+50

C = 71 CY
F = 0 CY

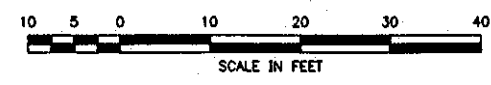


Maine Turnpike Authority
Maine Turnpike
 YORK TOLL PLAZA
 TOLL PLAZA MODIFICATIONS
 CROSS SECTIONS
 STA.364+50 TO STA.365+50

Contract 99.4 Sheet No. CS-SB
 34 of 42


By	Date
Designed	WEF 1/99
Drawn	WEF 1/99
Checked	RWB 1/99
In Charge Of	RAL

(METPK BDR-01)

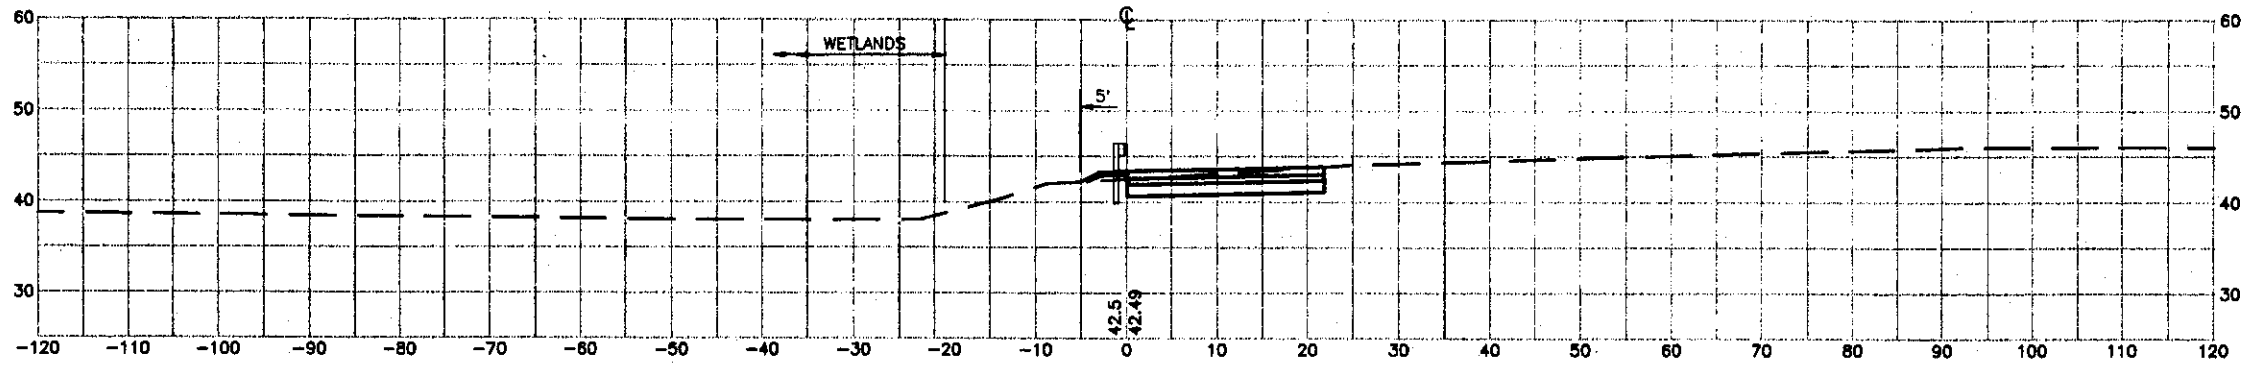

367+00


C = 99 CY
F = 4 CY

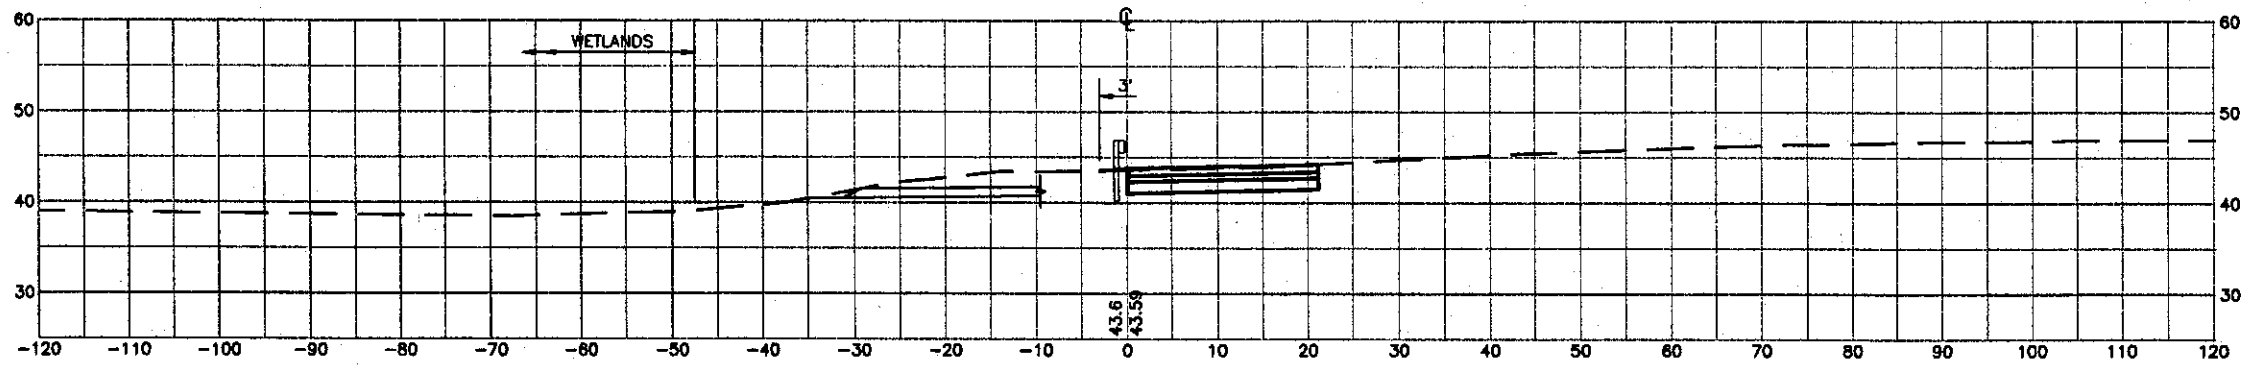

76' L.F. 12" RCP
INV. ELEV. 40.46
STA. 366+50 35' LT.

366+50

C = 100 CY
F = 2 CY

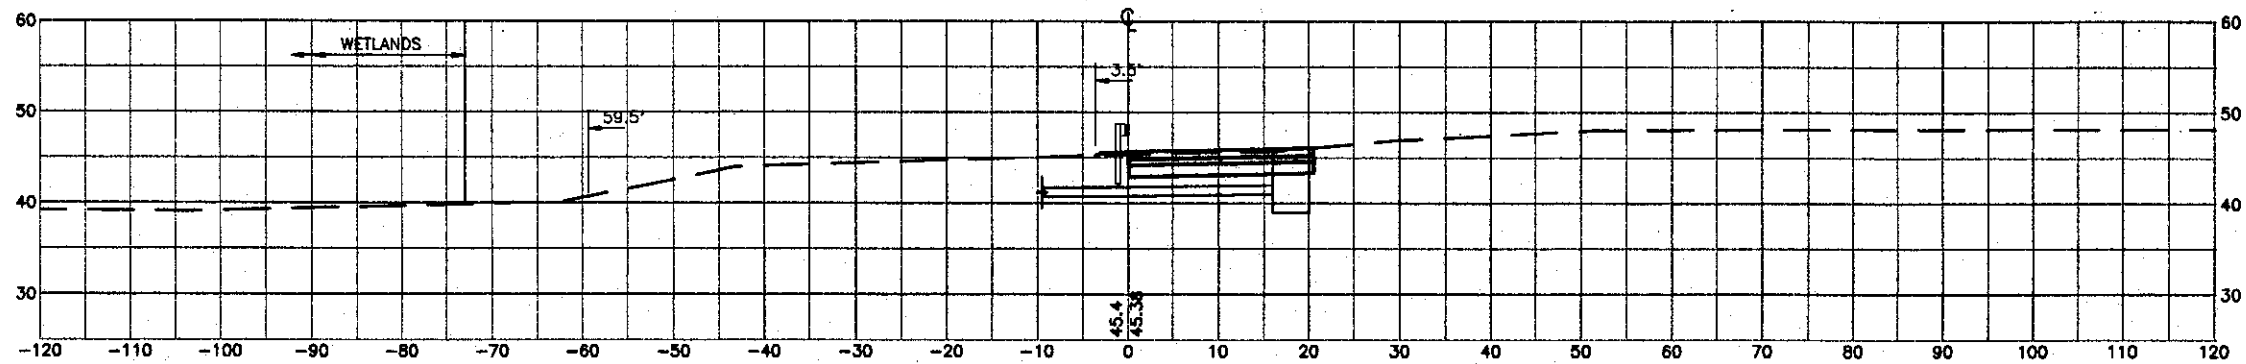

366+00 INSTALL CATCH BASIN TYPE B-1
STA. 365+96 18' RT.
RIM ELEV. 45.85
INV. ELEV. 40.85

C = 73 CY
F = 5 CY



No.	Revision	By	Date	In Charge	Of	RAL
		Designed	WEF	1/99		
		Drawn	WEF	1/99		
		Checked	RWB	1/99		

Maine Turnpike Authority
Maine Turnpike


Transpass

YORK TOLL PLAZA
TOLL PLAZA MODIFICATIONS
CROSS SECTIONS
STA. 366+00 TO STA. 367+00

HNTB


Contract 99.4

Sheet No. CS-SB
35 of 42

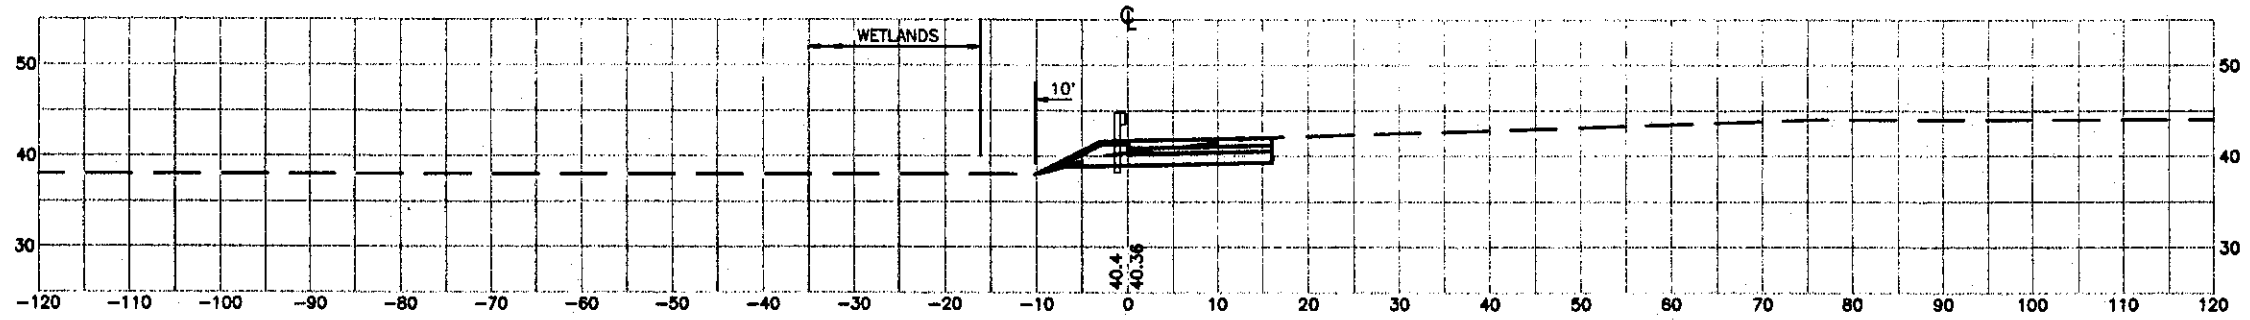


368+50

C = 76 CY
F = 1 CY

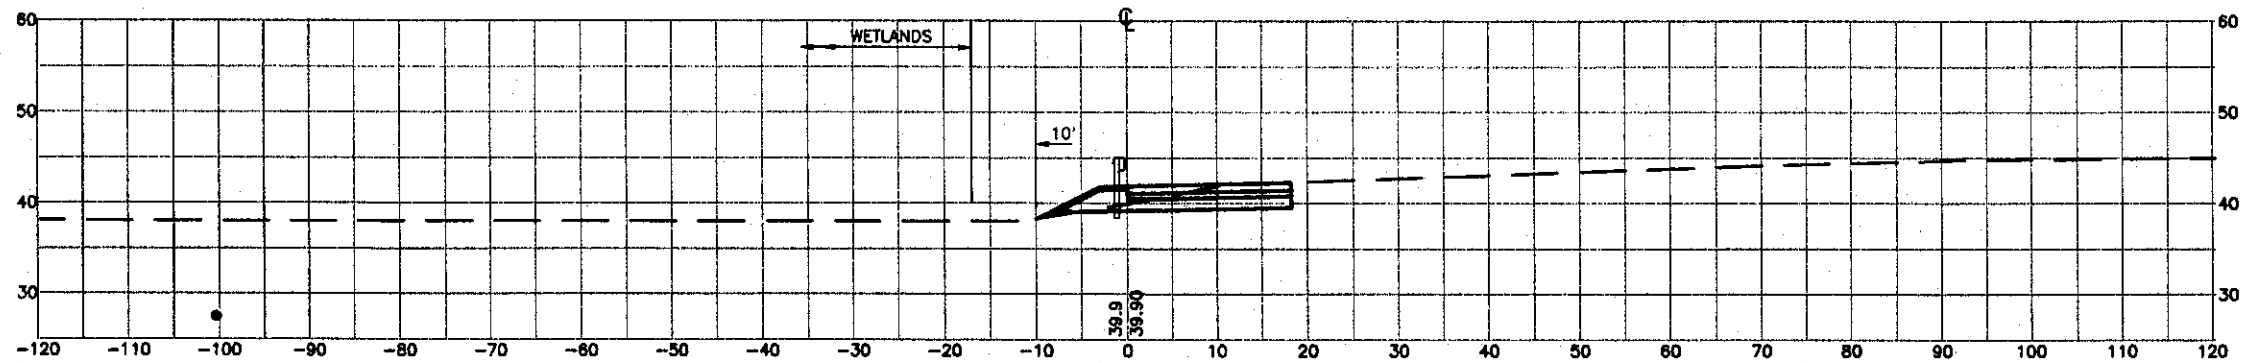


368+00

C = 84 CY
F = 4 CY

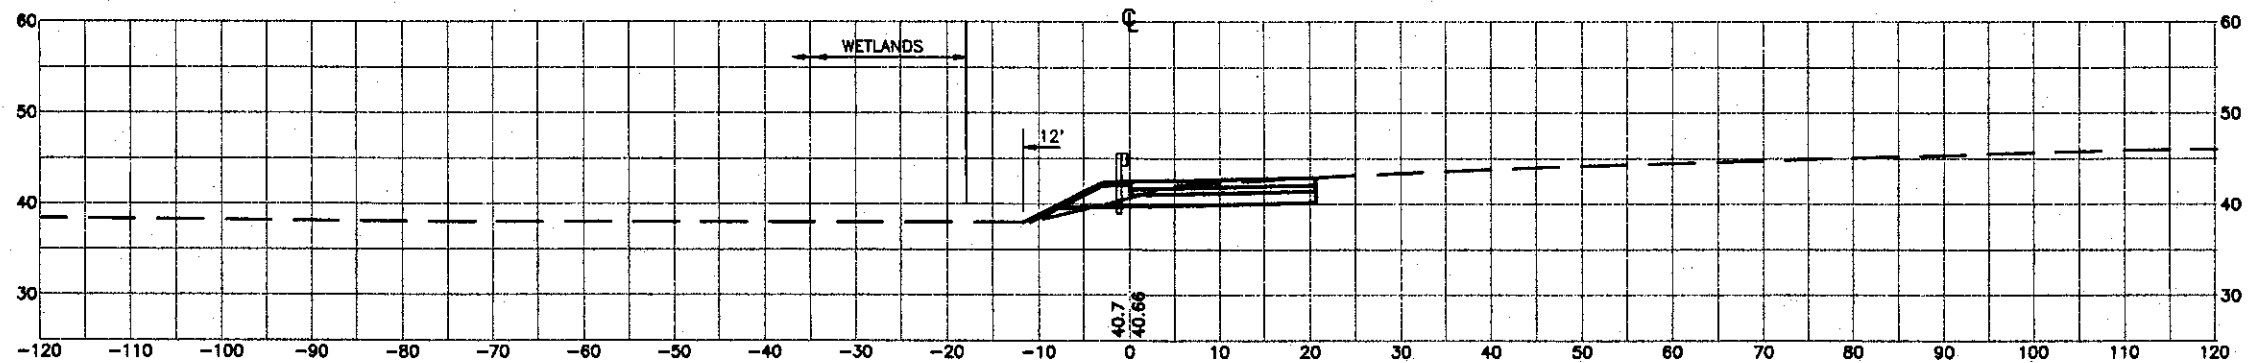

367+50

C = 92 CY
F = 7 CY

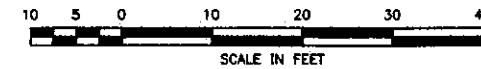

Maine Turnpike Authority
Maine Turnpike


YORK TOLL PLAZA
TOLL PLAZA MODIFICATIONS
CROSS SECTIONS
STA.367+50 TO STA.368+50

HNTB
ARCHITECTS ENGINEERS PLANNERS

Contract 99.4 Sheet No. CS-SB
36 of 42


By	Date
Designed WEF	1/99
Drawn WEF	1/99
Checked RWB	1/99
In Charge Of RAL	

(METPK\BDR-01)

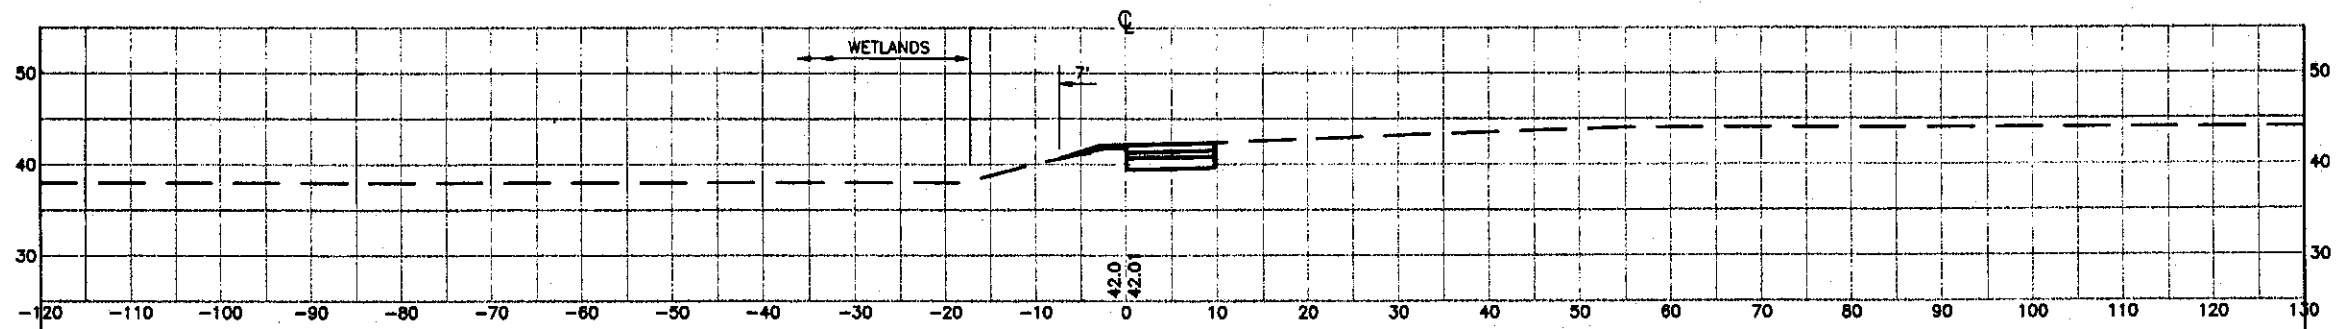


370+00

C = 53 CY
F = 10 CY

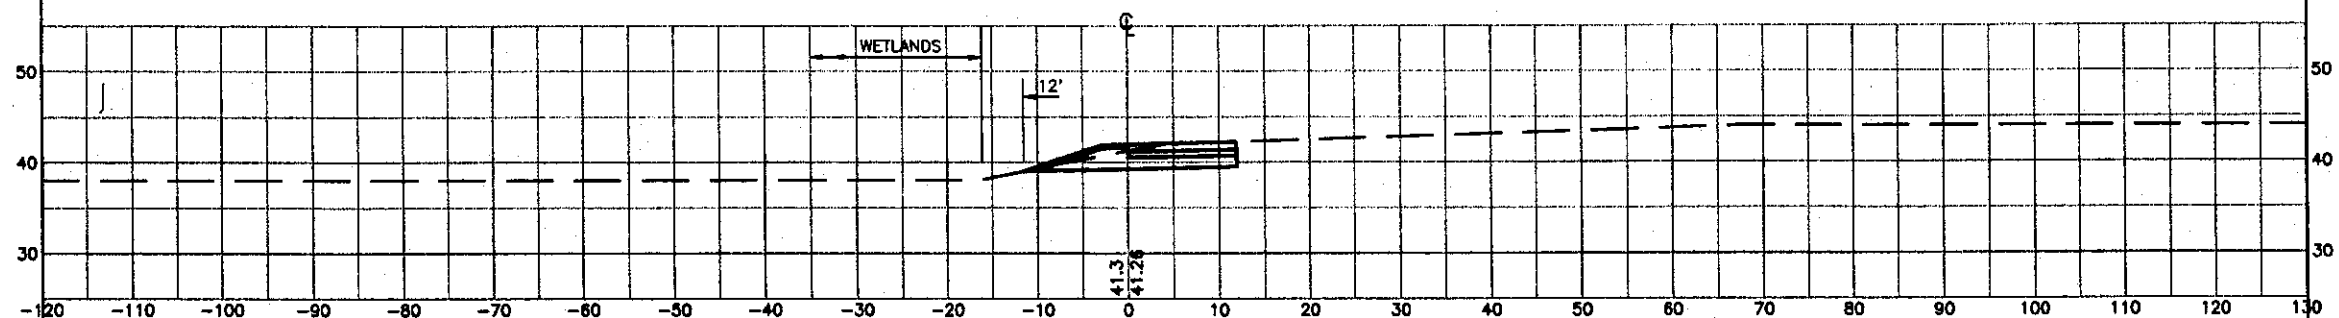


369+50

C = 60 CY
F = 14 CY

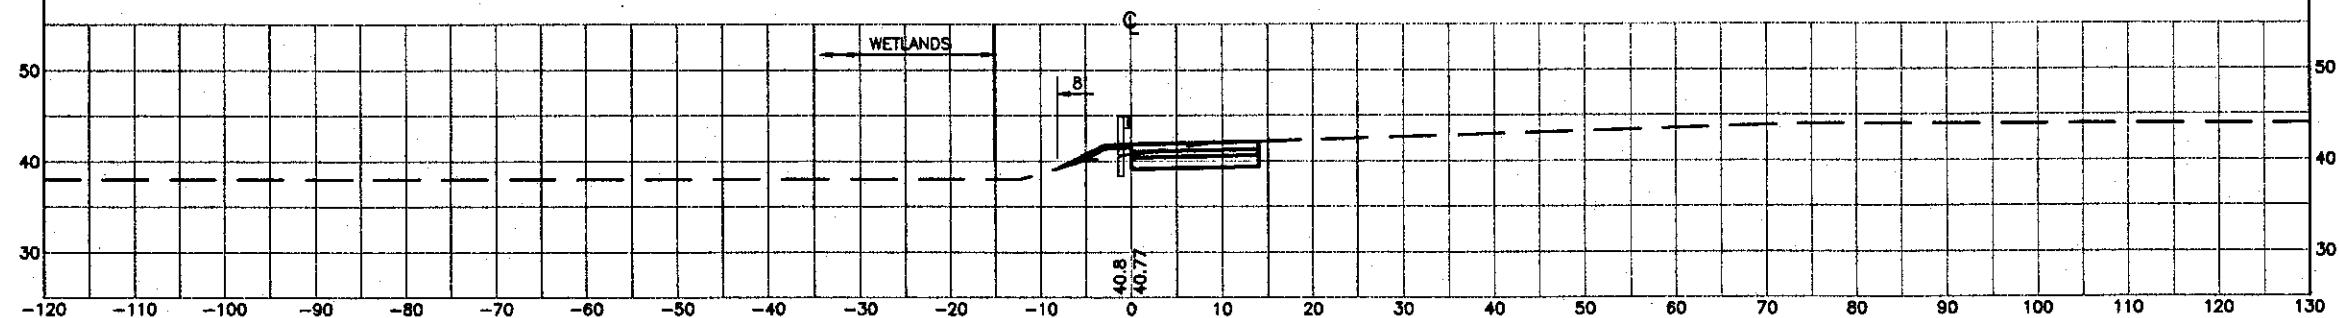

369+00

C = 68 CY
F = 7 CY

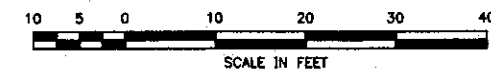

Maine Turnpike Authority
Maine Turnpike

YORK TOLL PLAZA
TOLL PLAZA MODIFICATIONS
CROSS SECTIONS
STA.369+00 TO STA.370+00


HNTB
CONSULTING ENGINEERS PLANNERS

Contract 99.4

Sheet No. CS-SB
37 of 42


No.	Revision	By	Date	In Charge Of

(METPK)\BDR-01

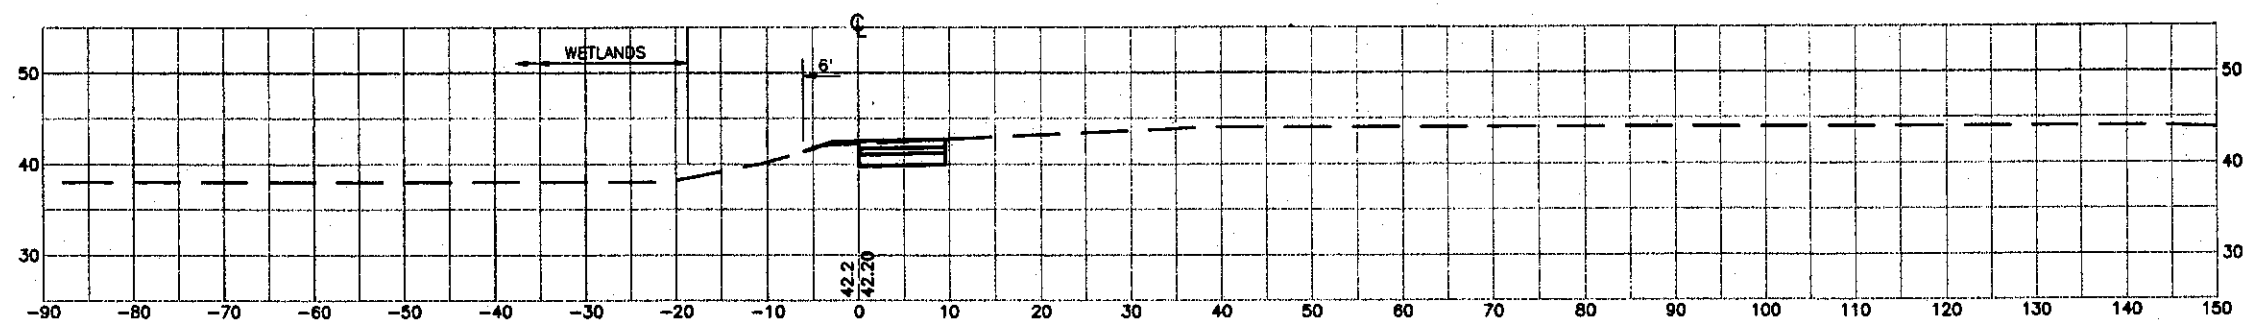


370+64.68

C = 46 CY
F = 2 CY

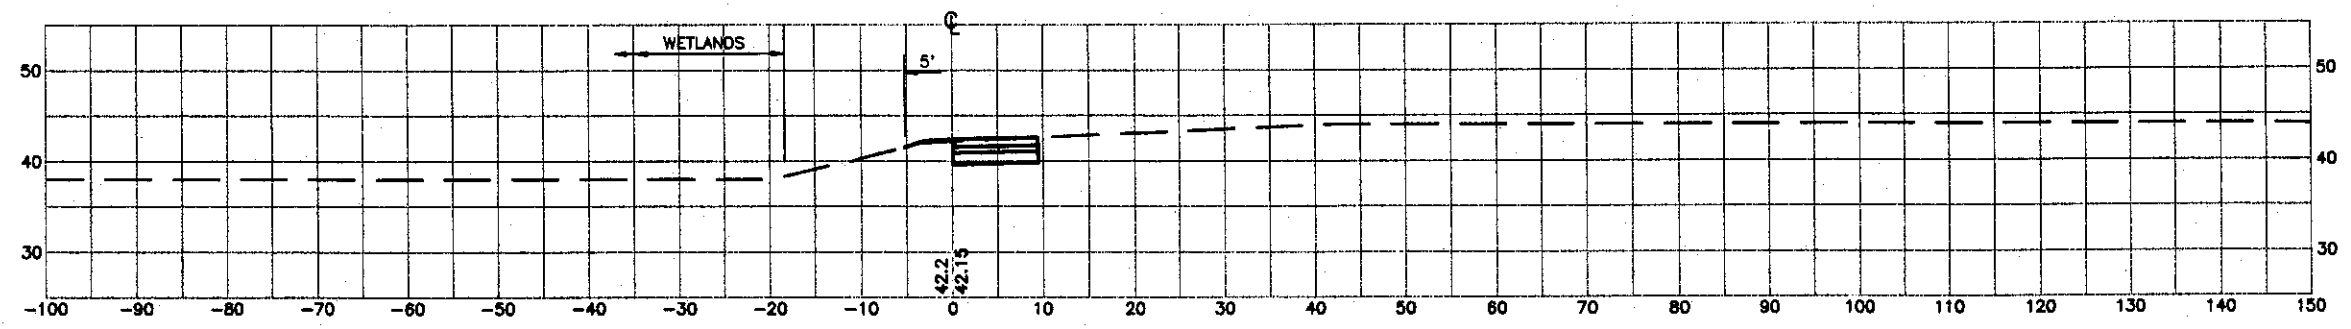

370+50

C = 47 CY
F = 4 CY


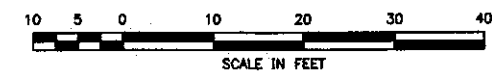


Maine Turnpike Authority
Maine Turnpike
 YORK TOLL PLAZA
 TOLL PLAZA MODIFICATIONS
 CROSS SECTIONS
 STA. 370+50 TO STA. 370+64.68



HNTB
 ASSISTANTS ENGINEER PLANNING
 Contract 99.4
 Sheet No. CS-SB
 38 of 42

No.	Revision	By	Date	In Charge Of	RAL

(METPK) BDR-01

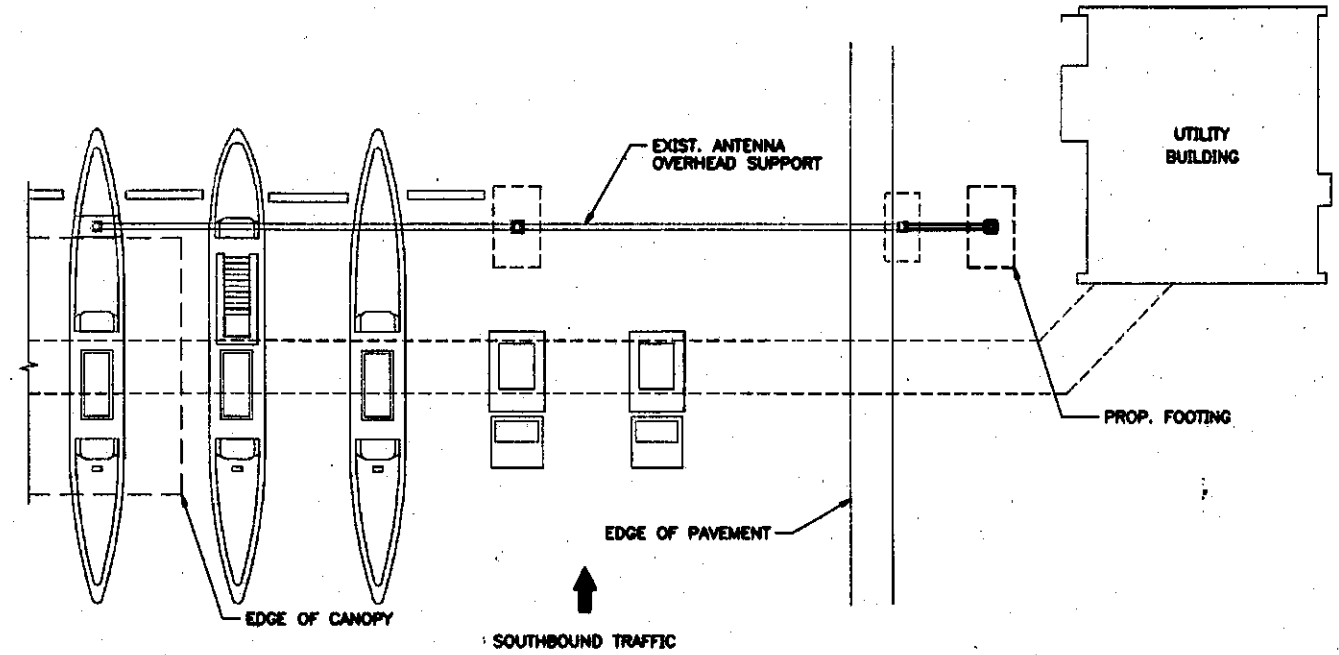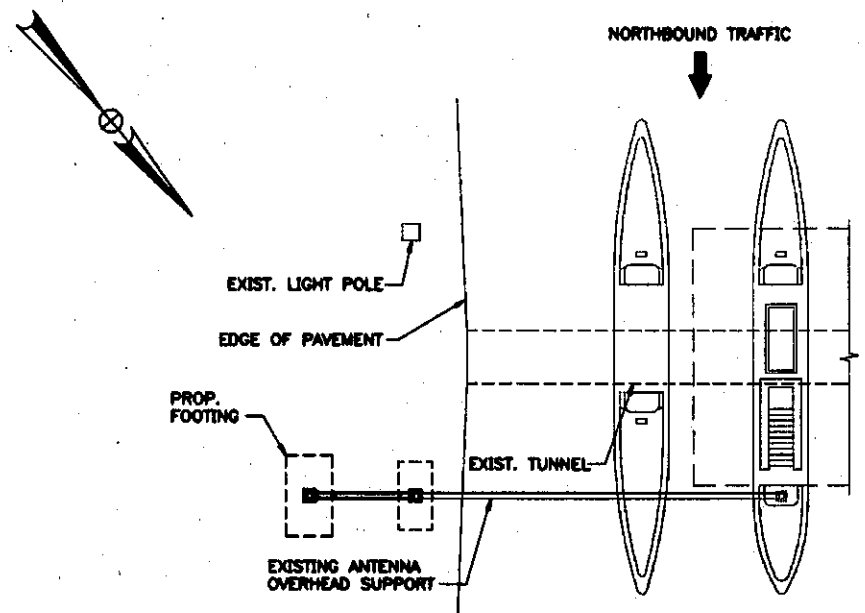



PLAN
3/32" = 1'-0"

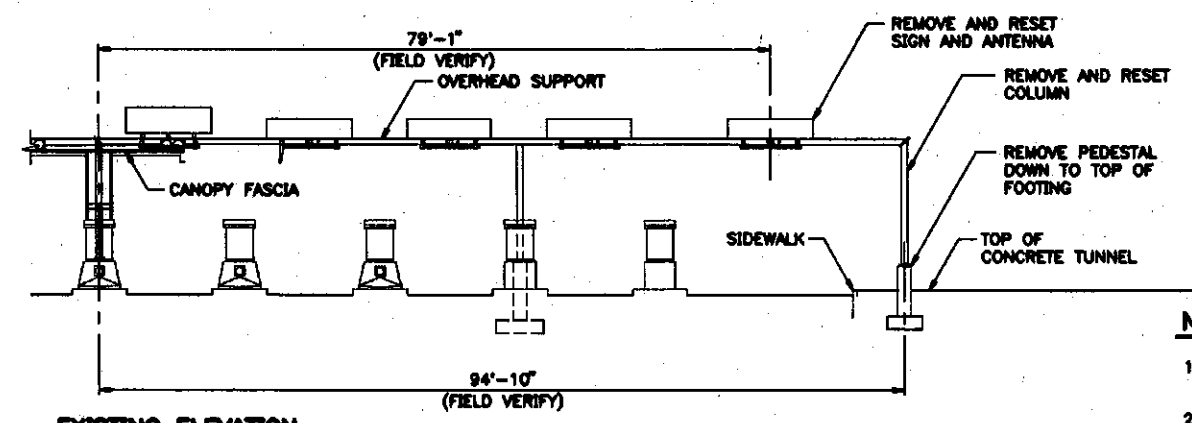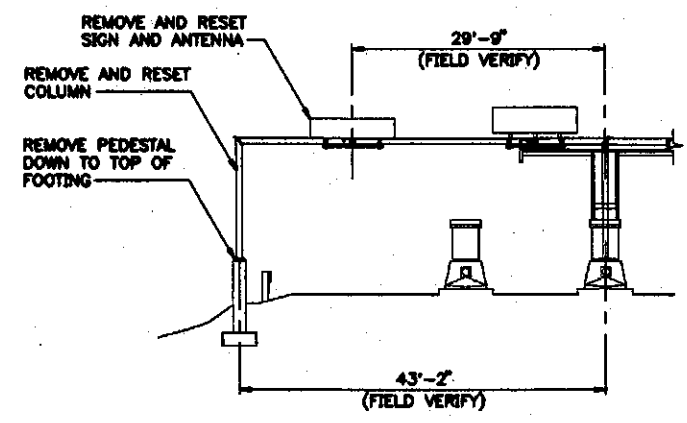

EXISTING ELEVATION
3/32" = 1'-0"

NOTES

1. THE CONTRACTOR SHALL FIELD VERIFY EXISTING CONDITIONS AND DIMENSIONS PRIOR TO FABRICATION.
2. ALL REINFORCING STEEL SHALL BE EPOXY COATED.
3. FOR ADDITIONAL DETAILS SEE SHEET S-2.
4. FOR ADDITIONAL REQUIREMENTS SEE SPECIAL PROVISIONS.

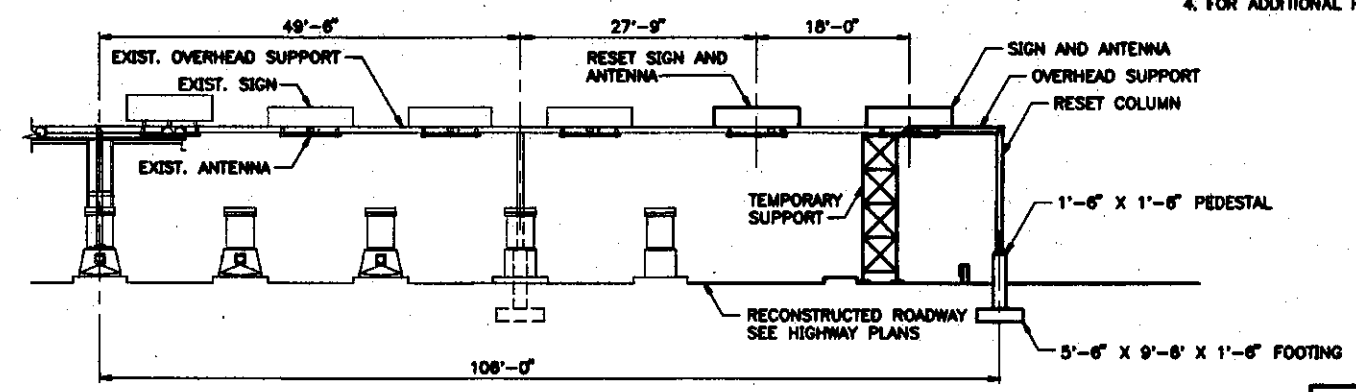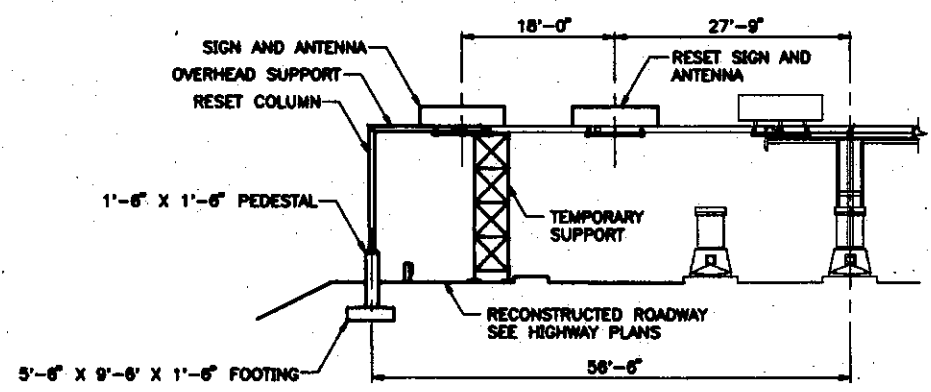

PROPOSED ELEVATION
3/32" = 1'-0"

Maine Turnpike Authority
Maine Turnpike

YORK TOLL PLAZA
TOLL PLAZA MODIFICATIONS
OVERHEAD SUPPORT





HNTB

Contract 99.4


Sheet No. S-1
39 of 42

Designed	JFW	2/98			
Drawn	SHR	2/98			
Checked	DWR	2/98			
No.	Revision	By	Date	In Charge Of	RAL



(METPK BOR-01)

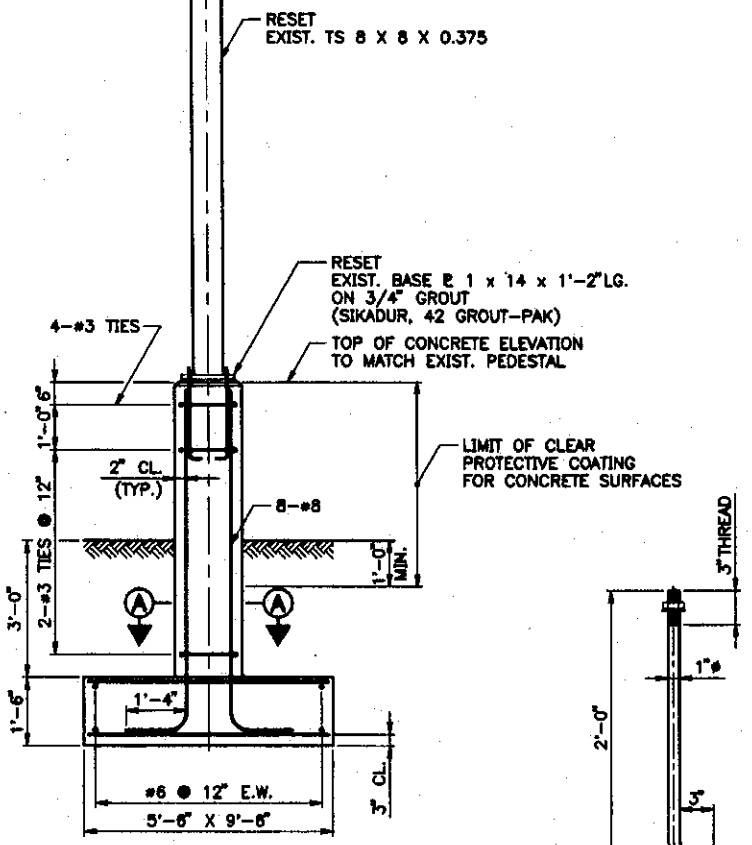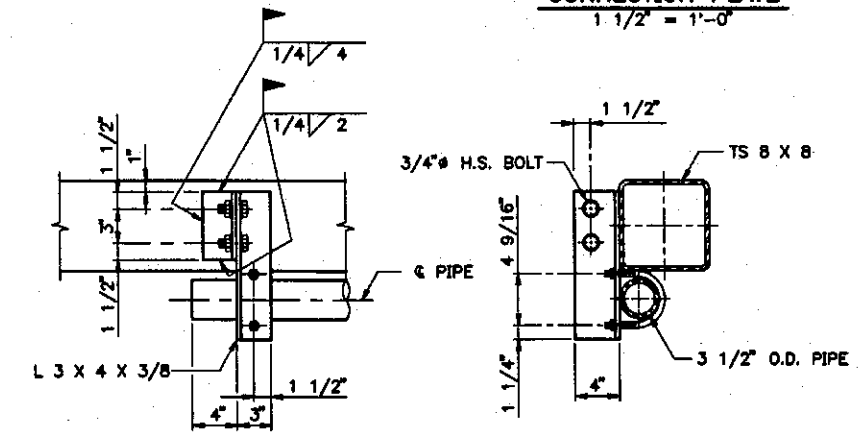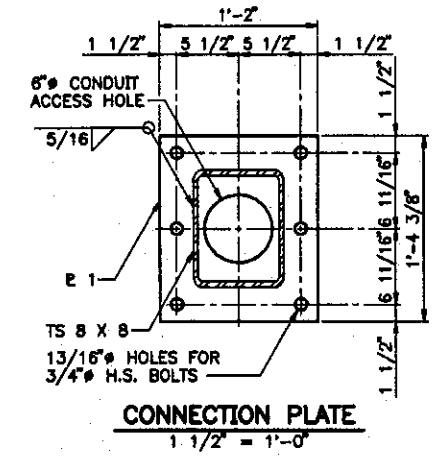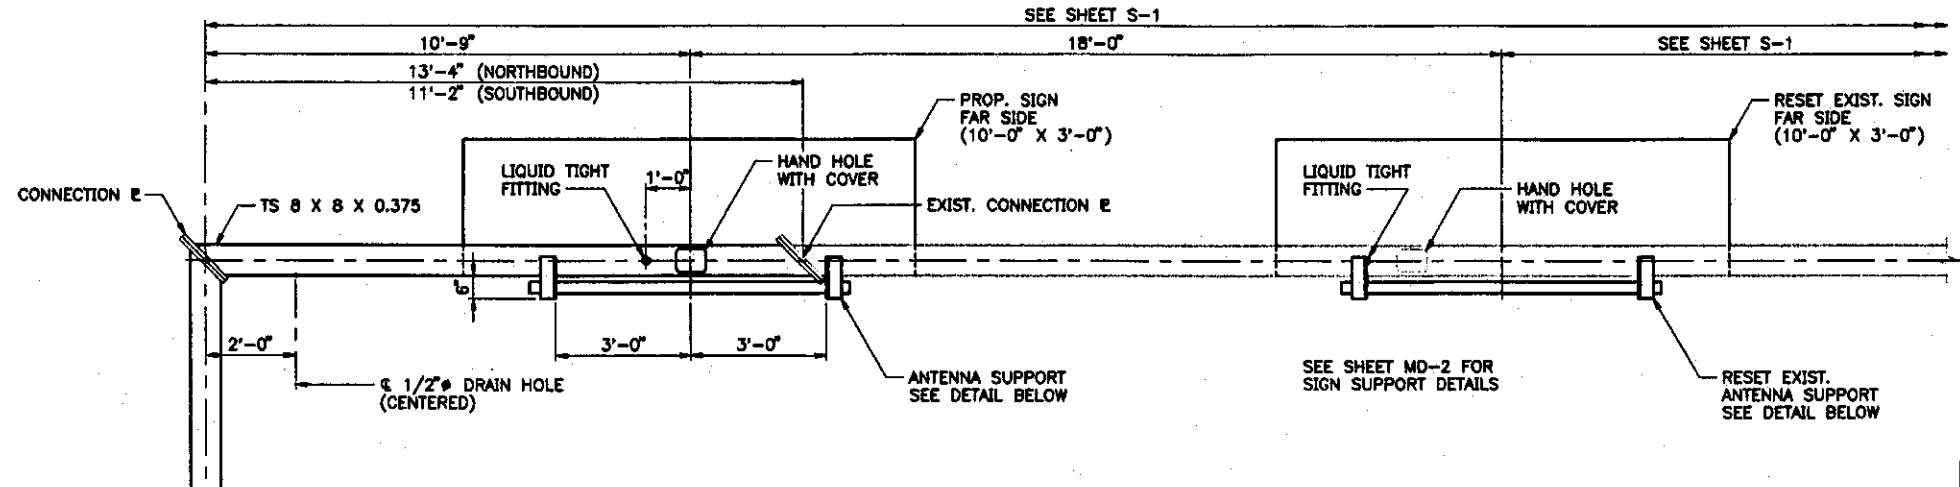

FRAME ELEVATION
1/2" = 1'-0"

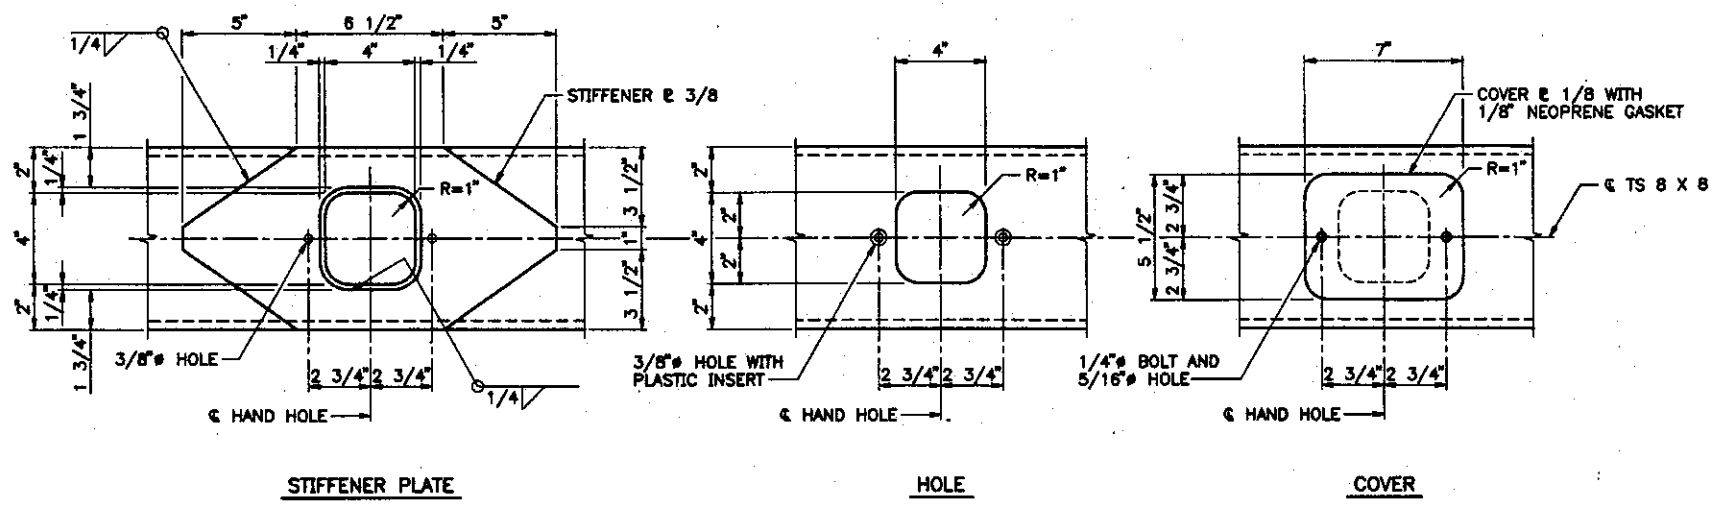

NOTE
VERIFY DIMENSIONS FOR ANCHOR BOLT LAYOUT.

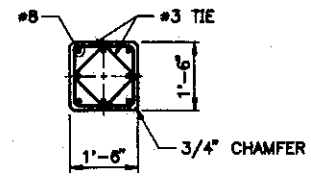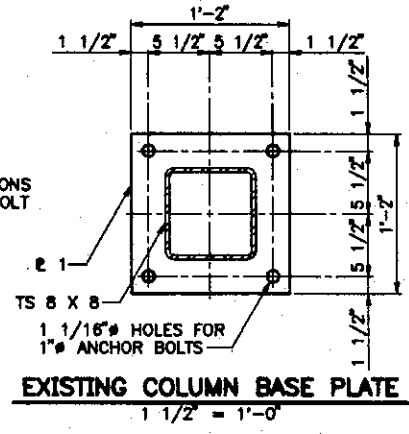


Maine Turnpike Authority
Maine Turnpike

YORK TOLL PLAZA
TOLL PLAZA MODIFICATIONS
OVERHEAD SUPPORT DETAILS

HNTE
ARCHITECTS ENGINEERS PLANNERS


By	Date
Designed JFW	2/99
Drawn SHR	2/99
Checked DWR	2/99

Contract 99.4
Sheet No. S-2
40 of 42

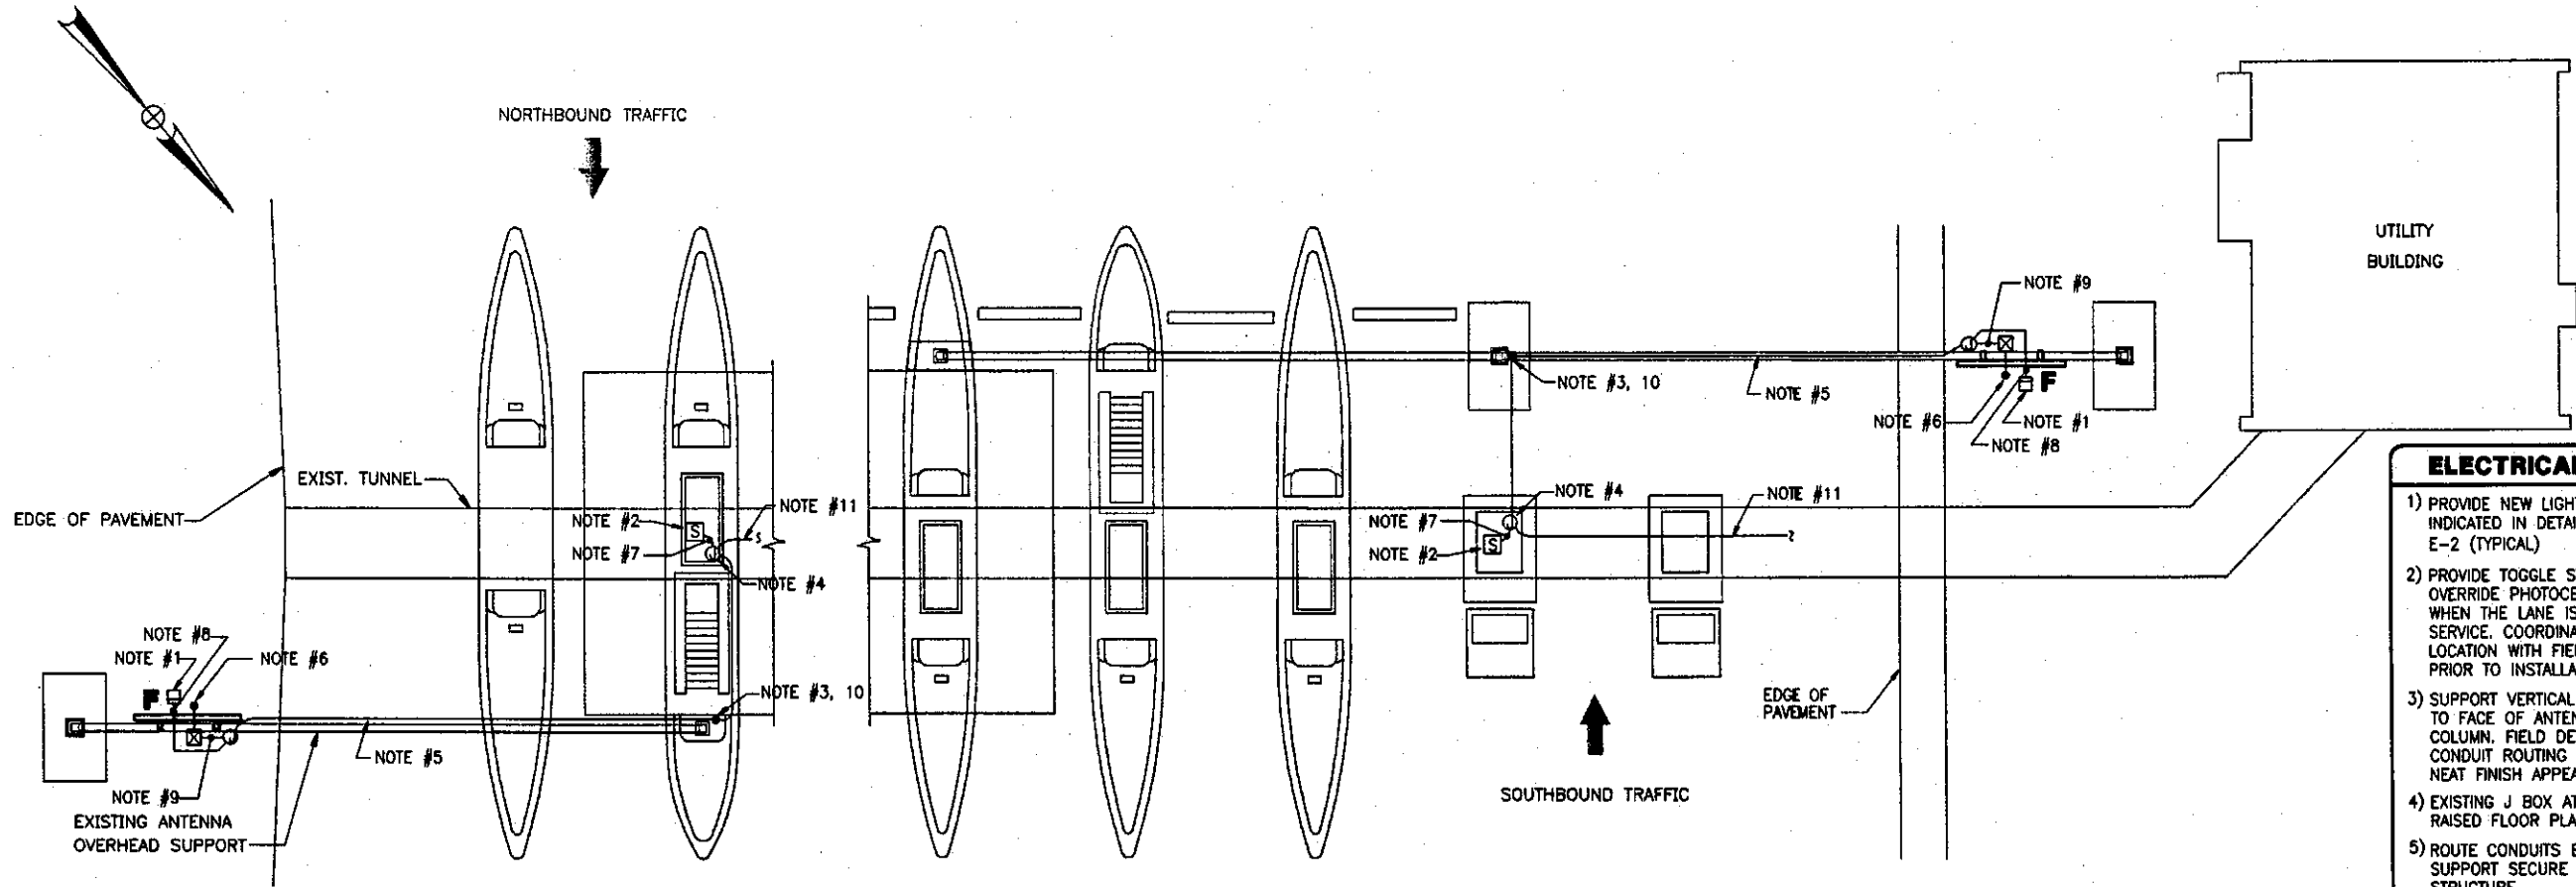

NORTHBOUND PLAN
1/8"=1'-0"

SOUTHBOUND PLAN
1/8"=1'-0"

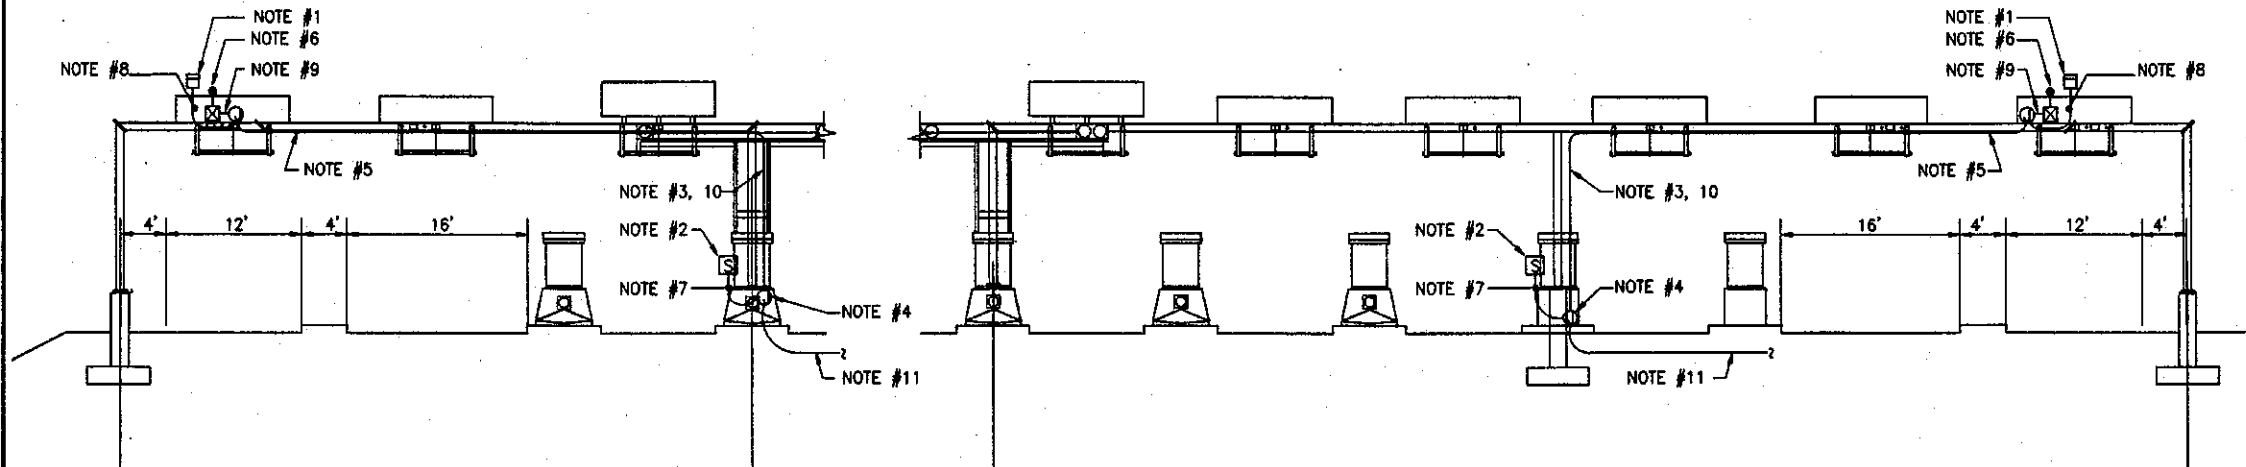

NORTHBOUND ELEVATION
1/8"=1'-0"

SOUTHBOUND ELEVATION
1/8"=1'-0"

ELECTRICAL NOTES:

- 1) PROVIDE NEW LIGHT FIXTURE AS INDICATED IN DETAILS ON SHEET E-2 (TYPICAL)
- 2) PROVIDE TOGGLE SWITCH TO OVERRIDE PHOTOCELL CONTROL WHEN THE LANE IS NOT IN SERVICE. COORDINATE EXACT LOCATION WITH FIELD ENGINEER PRIOR TO INSTALLATION
- 3) SUPPORT VERTICAL CONDUIT RUNS TO FACE OF ANTENNA SUPPORT COLUMN. FIELD DETERMINE EXACT CONDUIT ROUTING TO PRODUCE NEAT FINISH APPEARANCE
- 4) EXISTING J BOX AT BOOTH UNDER RAISED FLOOR PLATFORM
- 5) ROUTE CONDUITS BELOW ANTENNA SUPPORT SECURE TIGHT TO ROOF STRUCTURE.
- 6) PROVIDE PHOTOCELL BEHIND SIGN AS INDICATED ON SHEET E-2
- 7) 2#12 AND 1#12 GND IN 3/4" CONDUIT
- 8) 2#12 AND 1#12 GND IN 2" CONDUIT
- 9) 3#12 AND 1#12 GND IN 2" CONDUIT
- 10) 4#12 AND 1#12 GND IN 3/4" CONDUIT
- 11) RUN 2#12 + 1#12 GND CONDUCTORS IN EXISTING CONDUIT TO EXISTING PANEL IN UTILITY BUILDING. USE AVAILABLE 1 POLE 20 AMP SPARE IN EXISTING PANEL. FOR NEW LIGHTING

LEGEND

- NEW TOLL CANOPY SIGN AND LIGHTING FIXTURE ASSEMBLY
- NEW PHOTOCELL CONTROL
- NEW ON / OFF CONTROL SWITCH
- NEW JUNCTION BOX
- NEW CONDUIT


Maine Turnpike Authority
Maine Turnpike

 YORK TOLL PLAZA
 TOLL PLAZA MODIFICATIONS
 CANOPY SIGNS
 ELECTRICAL PLAN


Contract 99.4		Sheet No. E-1	
		41 of 42	

No.	Revision	By	Date	In Charge Of	RAL


(MTPK BDR-01)

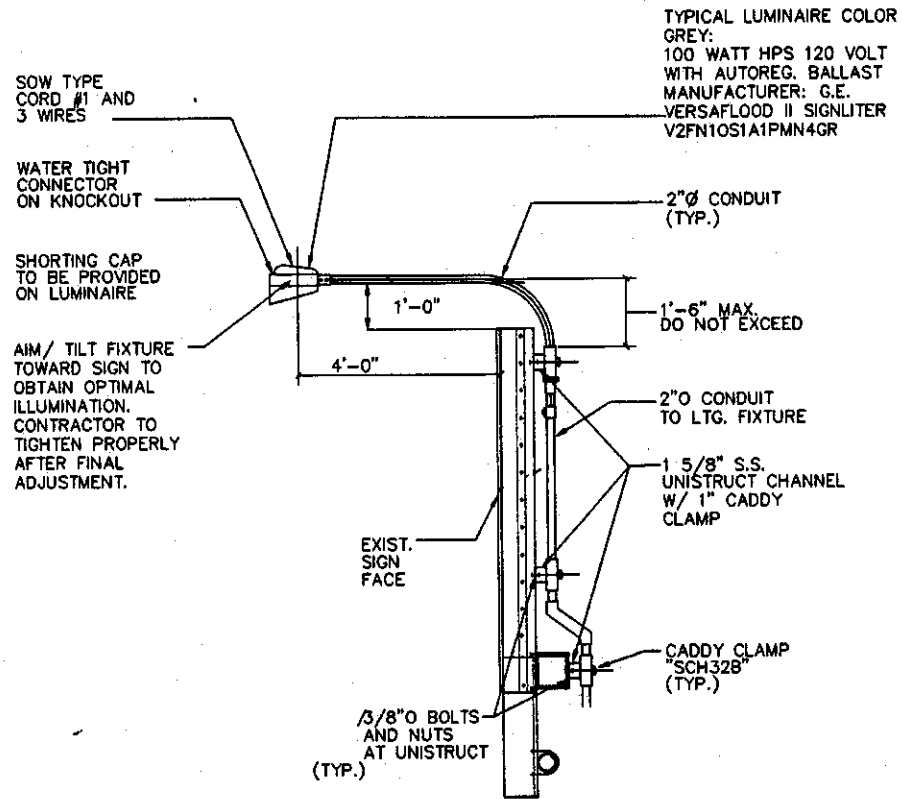

LIGHT FIXTURE DETAIL
N.T.S.

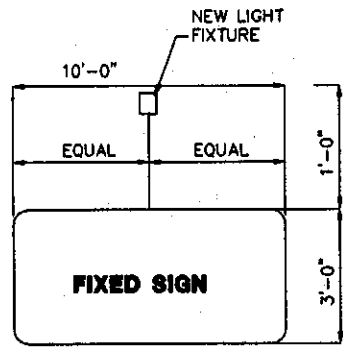

FIXTURE LOCATION FOR 10'-00" WIDE SIGN
N.T.S.

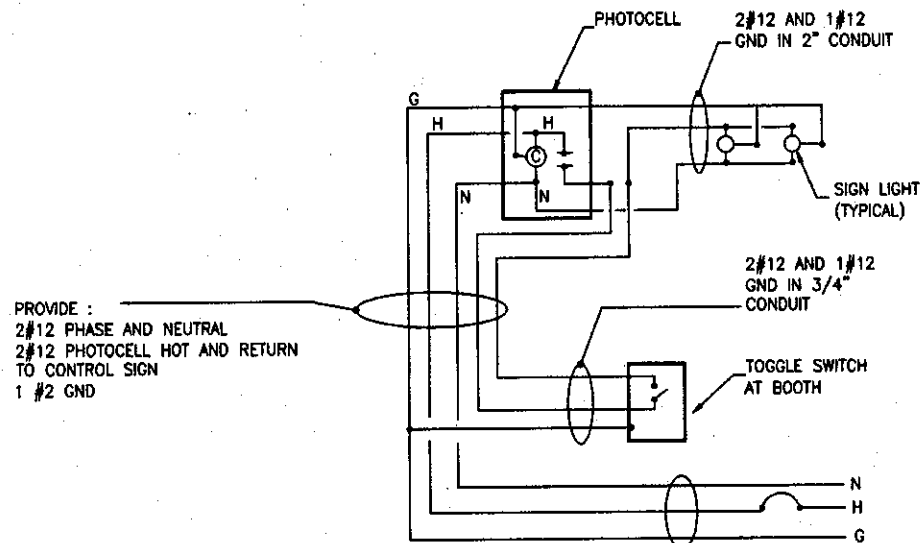

PROVIDE :
2#12 PHASE AND NEUTRAL
2#12 PHOTOCELL HOT AND RETURN TO CONTROL SIGN
1 #2 GND

RUN 2#12 + 1#12 GND CONDUCTORS IN EXISTING CONDUIT TO EXISTING PANEL. USE AVAILABLE 1 POLE 20 AMP SPARE IN DESIGNATED PANEL FOR NEW SIGN LIGHTING

WIRING DIAGRAM
NOT TO SCALE

Maine Turnpike Authority
Maine Turnpike
 YORK TOLL PLAZA
 TOLL PLAZA MODIFICATIONS
 CANOPY SIGNS
 ELECTRICAL DETAILS

Contract 99.4		Sheet No. E-2 42 of 42	

No.	Revision	By	Date	In Charge Of
		Designed	FM	3/99
		Drawn	AP	3/99
		Checked	VMA	3/99
				RAL

MAINE TURNPIKE AUTHORITY


MAINE TURNPIKE



JULIAN R. COLES, CHAIRMAN
 DEBORAH H. SHELTON, VICE CHAIR
 PATRICK F. BUTLER, MEMBER
 LUCIEN B. GOSSELIN, MEMBER
 JOHN G. MELROSE, MEMBER EX-OFFICIO
 PAUL E. VIOLETTE, EXECUTIVE DIRECTOR

CONTRACT 99.7 BUILDING RENOVATION AND EXPANSION YORK TOLL PLAZA MM 5.76

INDEX OF SHEETS		
SHEET NUMBER	DRAWING NUMBER	DESCRIPTION
1 OF 38		COVER SHEET
2 OF 38	C-1	SITE PLAN
3 OF 38	C-2	MISCELLANEOUS DETAILS
4 OF 38	C-3	WALKWAY LAYOUT
5 OF 38	D1.1	BASEMENT DEMOLITION PLAN
6 OF 38	D1.2	FIRST FLOOR DEMOLITION PLAN
7 OF 38	D2.1	DEMOLITION ELEVATIONS
8 OF 38	D4.1	DEMOLITION SECTIONS
9 OF 38	A1.1	BASEMENT FLOOR PLAN
10 OF 38	A1.2	FIRST FLOOR PLAN
11 OF 38	A1.3	ROOF PLAN
12 OF 38	A2.1	EXTERIOR ELEVATIONS
13 OF 38	A2.2	EXTERIOR ELEVATIONS
14 OF 38	A3.1	INTERIOR ELEVATIONS
15 OF 38	A4.1	BUILDING SECTIONS
16 OF 38	A4.2	STAIR SECTIONS
17 OF 38	A5.1	DETAILS
18 OF 38	A5.2	DETAILS
19 OF 38	A5.3	DETAILS
20 OF 38	A5.4	DETAILS
21 OF 38	A5.5	DETAILS
22 OF 38	A5.6	DETAILS
23 OF 38	A5.7	DETAILS
24 OF 38	A6.1	SCHEDULES
25 OF 38	S0	STRUCTURAL NOTES
26 OF 38	S1	FOUNDATION PLAN
27 OF 38	S1.1	FOUNDATION DETAILS
28 OF 38	S1.2	FOUNDATION DETAILS
29 OF 38	S2	FIRST FLOOR FRAMING PLAN
30 OF 38	S3	ROOF FRAMING PLAN
31 OF 38	S4	FRAMING DETAILS
32 OF 38	P1.1	BASEMENT PLUMBING PLAN
33 OF 38	P1.2	FIRST FLOOR PLUMBING PLAN
34 OF 38	M1.1	BASEMENT MECHANICAL PLAN
35 OF 38	M1.2	FIRST FLOOR MECHANICAL PLAN
36 OF 38	E1	ELECTRICAL DEMOLITION PLAN
37 OF 38	E2	BASEMENT ELECTRICAL PLAN AND NOTES
38 OF 38	E3	FIRST FLOOR ELECTRICAL PLAN

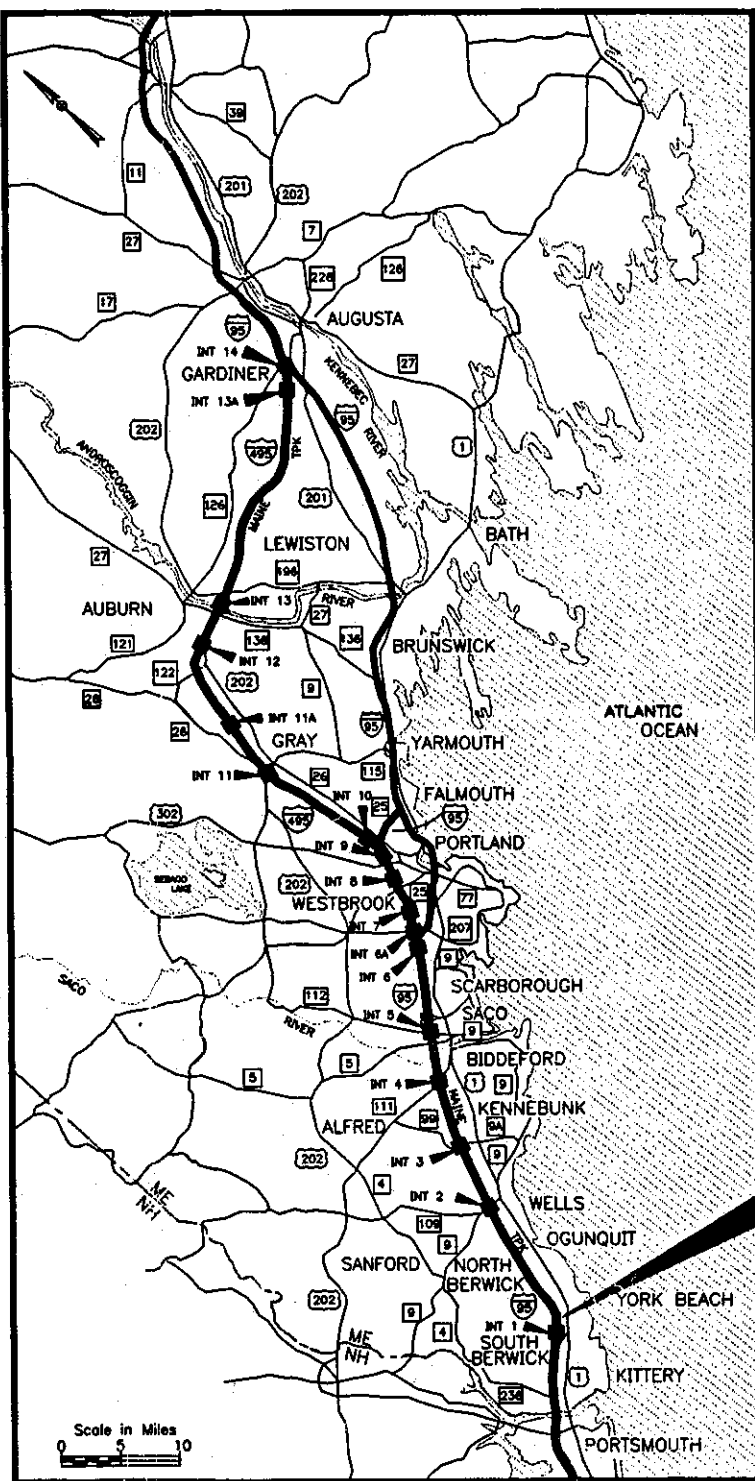

LOCATION MAP

STATE OF MAINE
 DEPARTMENT OF TRANSPORTATION

COMMISSIONER _____ DATE _____
 BUREAU DIRECTOR AND CHIEF ENGINEER _____ DATE _____

JSN ASSOCIATES, INC.



LASSEL ARCHITECTS



HNTB
 ARCHITECTS ENGINEERS PLANNERS



Roland A. Lavallee
 ROLAND A. LAVALLEE P.E., P.L.S.
 VICE PRESIDENT
 DIRECTOR OF OPERATIONS

BENNETT ENGINEERING



APPROVED:

MAINE TURNPIKE AUTHORITY

CHAIRMAN


EXECUTIVE DIRECTOR

DATE _____

PROPOSED TRAFFIC SIGN SUMMARY

IDENTIFICATION NUMBER	SIZE OF SIGN *		TEXT	TEXT DIMENSIONS (INCHES)			NUMBER OF SIGNS REQUIRED	COLOR **		BORDER RADIUS	POST SIZE AND NUMBER REQUIRED	AREA IN SQUARE FEET
	WIDTH	HEIGHT		LETTER HEIGHT	VERTICAL SPACING	ARROW RTE. MKR.		BACK-GROUND	LEGEND BORDER			
D9-6	24"	24"		SEE STANDARD HIGHWAY SIGNS			1	SEE STANDARD HIGHWAY SIGNS			U-CHANNEL POST 1	4.00 (4.00)

* DIMENSION IN INCHES. SIGN TEXT SHALL CONFORM TO M.U.T.C.D. ** THE LEGEND BORDER AND BACKGROUND SHALL BE HIGH INTENSITY REFLECTIVE SHEETING

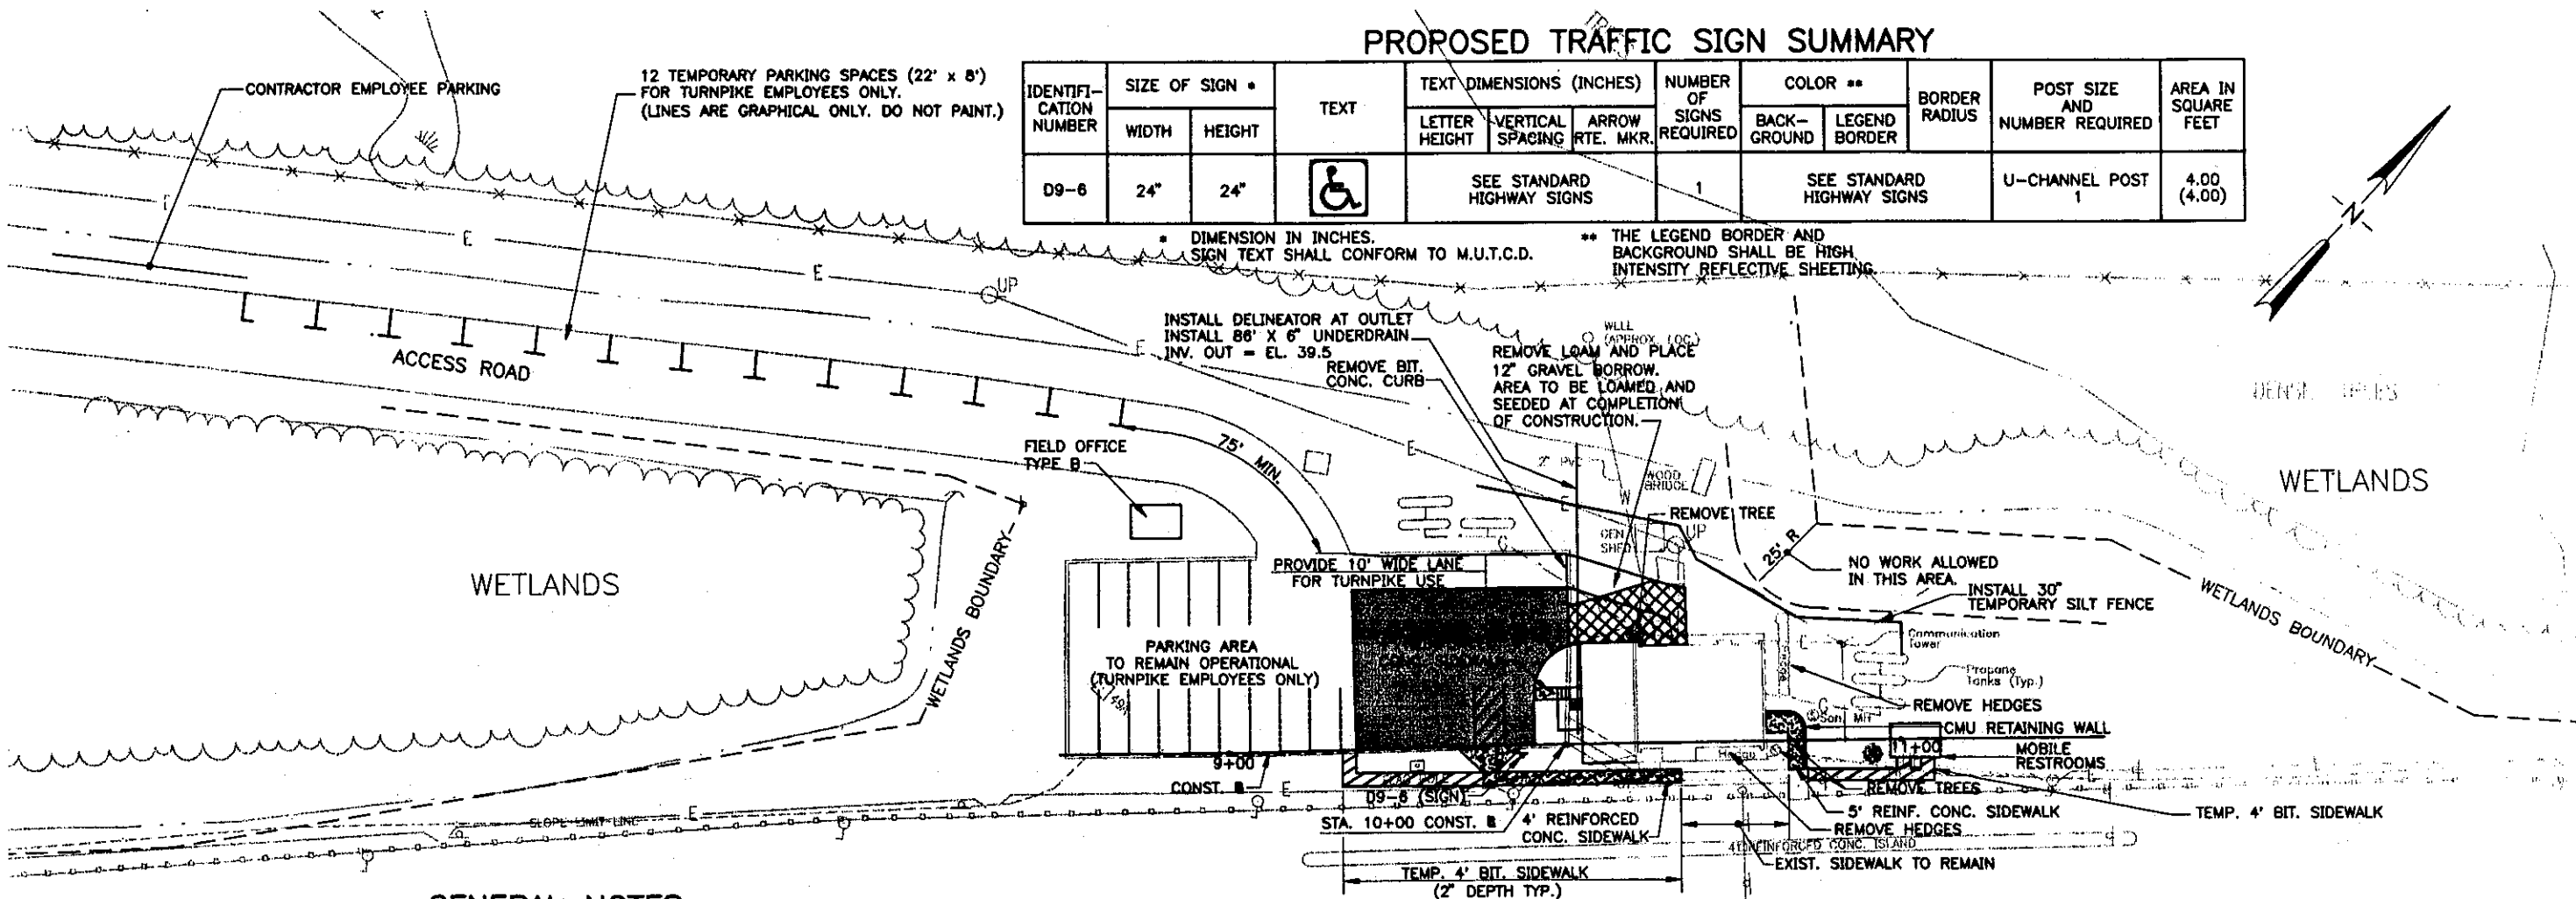

GENERAL NOTES

- EXISTING UTILITIES ON THESE PLANS WERE COMPILED FROM FIELD SURVEY AND VARIOUS OTHER SOURCES. LOCATIONS ARE NOT GUARANTEED TO BE ACCURATE NOR IS IT GUARANTEED THAT ALL UTILITIES ARE SHOWN. NO SEPARATE OR ADDITIONAL COMPENSATION WILL BE ALLOWED TO THE CONTRACTOR DUE TO ANY VARIANCE BETWEEN THE DATA SHOWN ON THE PLANS AND THE ACTUAL FIELD CONDITIONS ENCOUNTERED. NO WORK SHALL BE STARTED UNTIL THE OWNERS OF THE VARIOUS UTILITIES ARE NOTIFIED BY THE CONTRACTOR OF THE PROPOSED CONSTRUCTION. THE CONTRACTOR IS ALSO REQUIRED TO CALL DIG SAFE AT 1-800-DIG-SAFE PRIOR TO THE START OF THE WORK.
- THE UTILITIES ON THIS CONTRACT ARE:
CENTRAL MAINE POWER COMPANY
BELL ATLANTIC
- REQUIRED EROSION AND SEDIMENTATION CONTROL SHOWN ON THE PLANS IS FOR ESTIMATING PURPOSE ONLY. ACTUAL TYPE AND LOCATION OF DEVICES SHALL BE DETERMINED IN THE FIELD BY THE ENGINEER.
- WASTE MATERIALS SHALL BE DISPOSED OF, OFF THE PROJECT SITE, IN ACCORDANCE WITH CHAPTER 404, DEPARTMENT OF ENVIRONMENTAL PROTECTION SOLID WASTE MANAGEMENT RULES.
- CONTRACTOR SHALL PLACE 4" LOAM ON ALL DISTURBED SLOPE AREA. ACTUAL PLACEMENT OF THE LOAM SHALL BE AS DESIGNATED BY THE ENGINEER.
- SEEDING METHOD NO. 1 SHALL BE UTILIZED ON ALL GRASS AREAS.
- MULCH SHALL BE APPLIED IN AREAS SEEDED BY SEEDING METHOD NO. 1.
- 4" PAINTED PAVEMENT MARKINGS WILL BE INSTALLED BY THE CONTRACTOR. (SEE SHEET C-3.)

VERTICAL CURB TYPE 1					
FROM STA.	OFFSET	TO STA.	OFFSET		LF
STA. 9+91.0	0'	STA. 9+91.0	18' LT.		4

TERMINAL CURB TYPE 2					
FROM STA.	OFFSET	TO STA.	OFFSET		LF
STA. 9+88.5	0'	STA. 9+75.5	0'	TRANSITION	7
STA. 9+79.5	0'	STA. 9+86.5	0'	TRANSITION	7

CURB TYPE 3 MOLD 1					
FROM STA.	OFFSET	TO STA.	OFFSET		LF
STA. 9+86.5	0'	STA. 9+91.0	0'		5
STA. 9+91.0	0' LT.	STA. 9+91.0	14' LT.		14
STA. 9+91.0	18' LT.	STA. 10+04.0	30' LT.	13' RADIUS	20
STA. 10+04.0	30' LT.	STA. 10+06.0	30' LT.		2
STA. 10+00.0	41' LT.	STA. 10+00.0	57' LT.		16

REINFORCED CONCRETE SIDEWALK					
FROM STA.	OFFSET	TO STA.	OFFSET		SY
STA. 9+75.5	12' RT.	STA. 10+34.0	12' RT.	4'	26
STA. 9+77.5	0'	STA. 9+77.5	8' RT.	RAMP	10
STA. 10+67.0	9' RT.	STA. 10+67.0	9' LT.	5'	10
STA. 10+60.0	9' LT.	STA. 10+67.0	9' LT.	8'	5
STA. 9+91.0	14' LT.	STA. 9+98.0	14' LT.	4'	3

30" TEMPORARY SILT FENCE					
FROM STA.	OFFSET	TO STA.	OFFSET		LF
STA. 9+75.0	78' LT.	STA. 10+35.0	65' LT.		60
STA. 10+35.0	65' LT.	STA. 10+40.0	55' LT.		10
STA. 10+40.0	55' LT.	STA. 10+70.0	45' LT.		35
STA. 10+70.0	37' LT.	STA. 11+00.0	35' LT.		30
STA. 11+00.0	35' LT.	STA. 11+00.0	25' LT.		10


REGULATORY WARNING CONFIRMATION AND ROUTE ASSEMBLY SIGN					
FROM STA.	OFFSET	I.D. NO.	SF		
STA. 9+86.0	4' RT.	D9-6	4		

LEGEND

- STAGING AREA
- 4" HOT BITUMINOUS PAVEMENT GRADE "D" SIDEWALKS, DRIVES AND INCIDENTALS. (AT COMPLETION OF CONSTRUCTION.)

6 INCH UNDERDRAIN					
FROM STA.	OFFSET	TO STA.	OFFSET		LF
STA. 10+03.5	1.5' LT.	STA. 10+03.5	87.5' LT.		86

GUARDRAIL DELINEATOR POST			
FROM STA.	OFFSET	EA	
STA. 10+03.5	87.5' LT.	1	

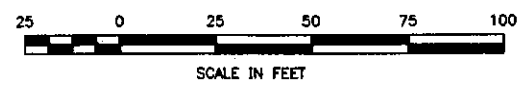

Maine Turnpike Authority
Maine Turnpike


YORK TOLL PLAZA
BUILDING RENOVATION
AND EXPANSION
SITE PLAN

HNTB
ARCHITECTS ENGINEERS PLANNERS


Contract 99.7 Sheet No. C-1
2 of 38

By	Date
Designed	RWB 7/99
Drawn	JBC 7/99
Checked	GWW 7/99
In Charge Of	RAL


METPKA.RUC. H:\H0909XW\005\004\99.7\SP-1.DWG 07/30/99 07:29

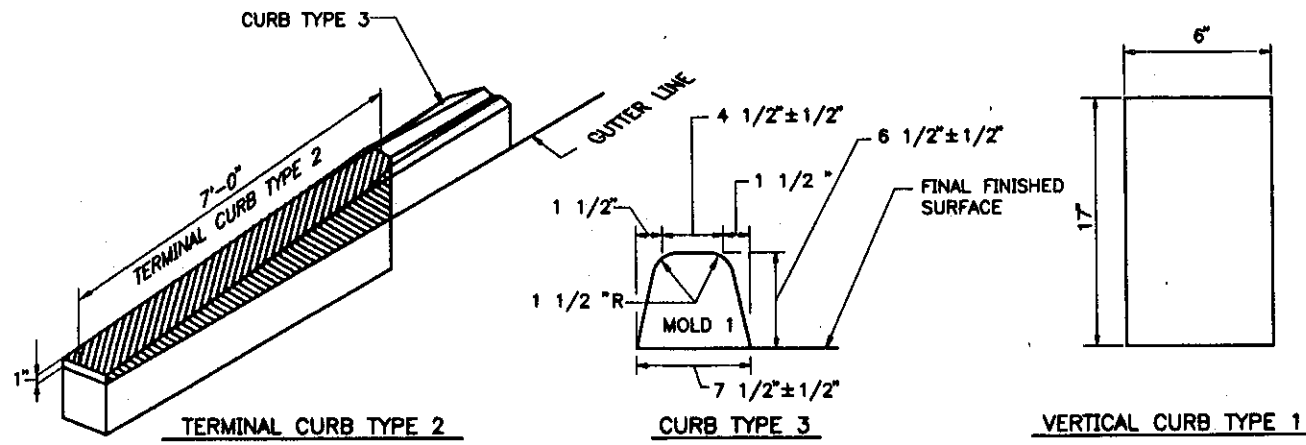


CURBING
N.T.S.

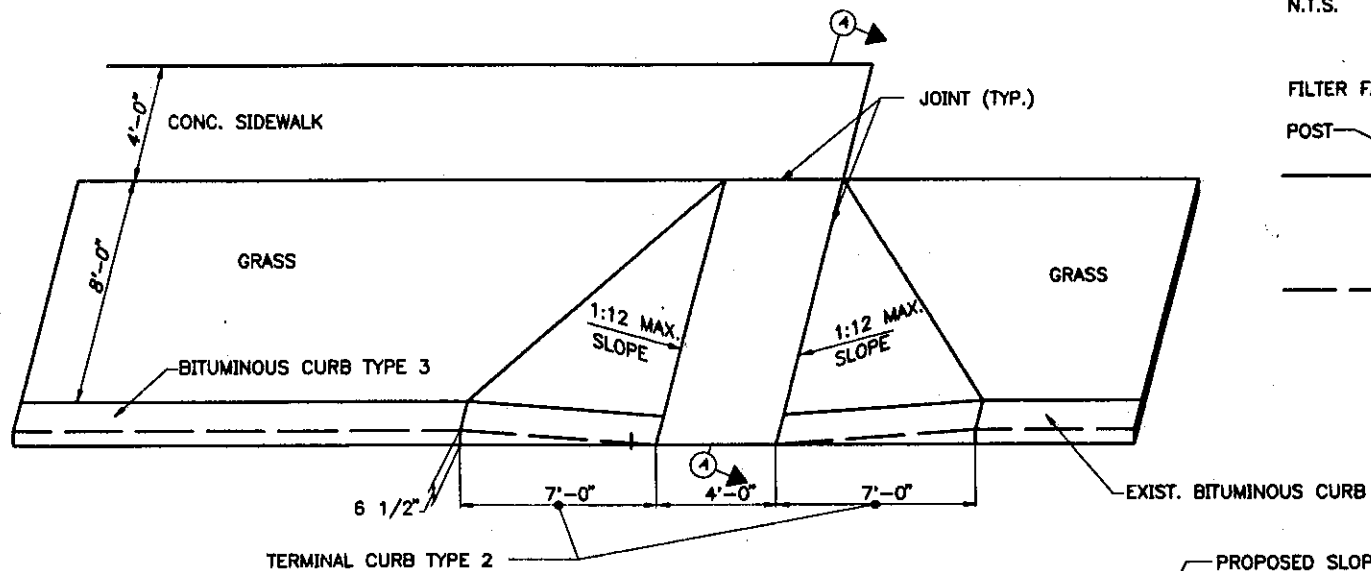


CONC. WHEELCHAIR RAMP
N.T.S.

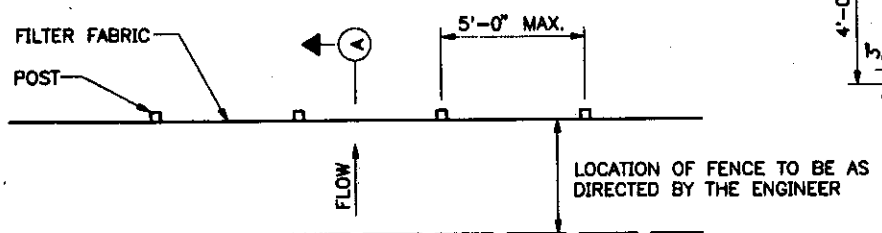

PLAN VIEW
N.T.S.

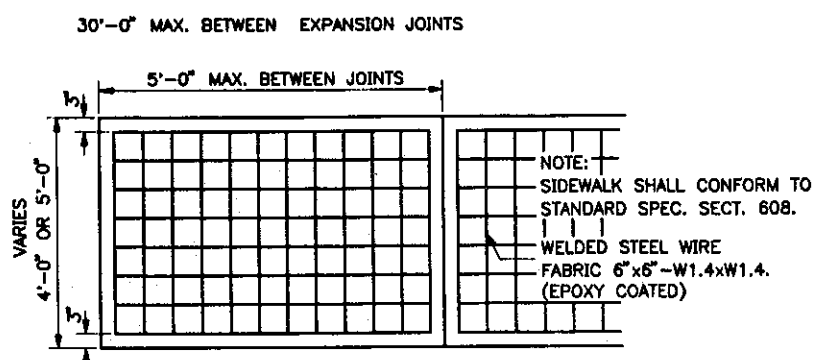


PLAN VIEW
N.T.S.

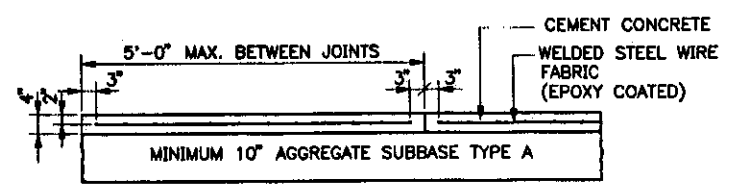


SECTION
N.T.S.

REINFORCED CONCRETE SIDEWALK

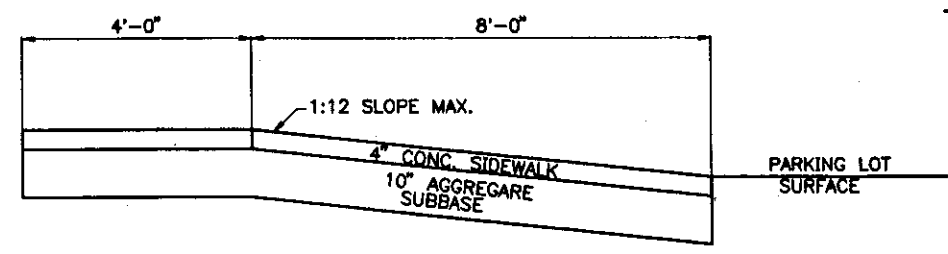

SECTION A-A
N.T.S.

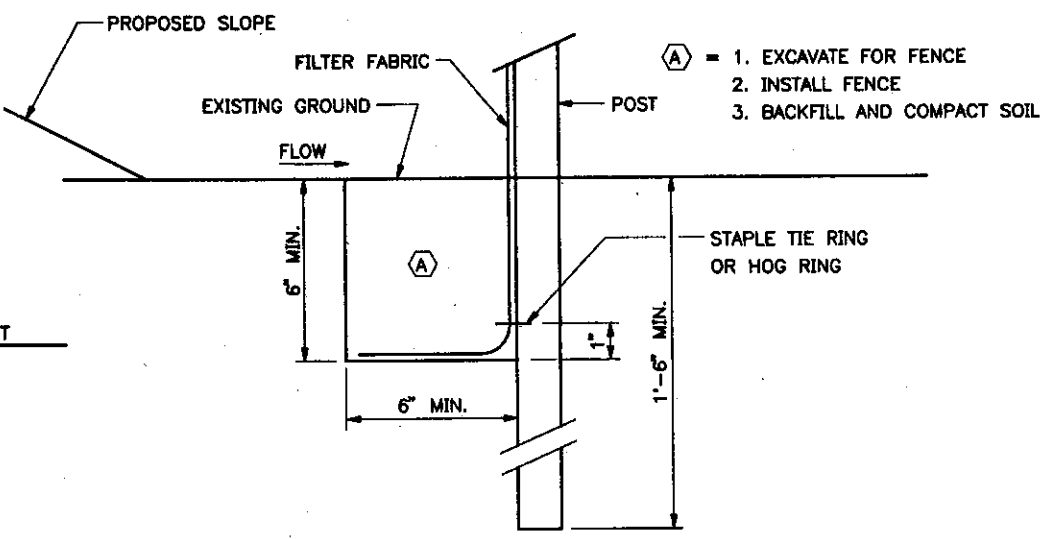

SECTION A-A
N.T.S.

SILT FENCE

Maine Turnpike Authority
Maine Turnpike
 YORK TOLL PLAZA
 BUILDING RENOVATION
 AND EXPANSION
 MISCELLANEOUS DETAILS

HNTB
 ARCHITECTS ENGINEERS PLANNERS
 Contract 99.7
 Sheet No. C-2
 3 of 38

No.	Revision	By	Date	In Charge Of:	RAL

(METPK BDR-01)






INSTALL 86" X 6" UNDERDRAIN
(SEE SHEET C-1 FOR OUTLET)
(INLET CONNECTS TO ROOF DRAIN)

CONCRETE CONDENSER PAD
(SEE SHEET M1. 1 FOR DETAILS)

LEGEND



4" LDAM AND SEED AND SEEDING METHOD NO. 1

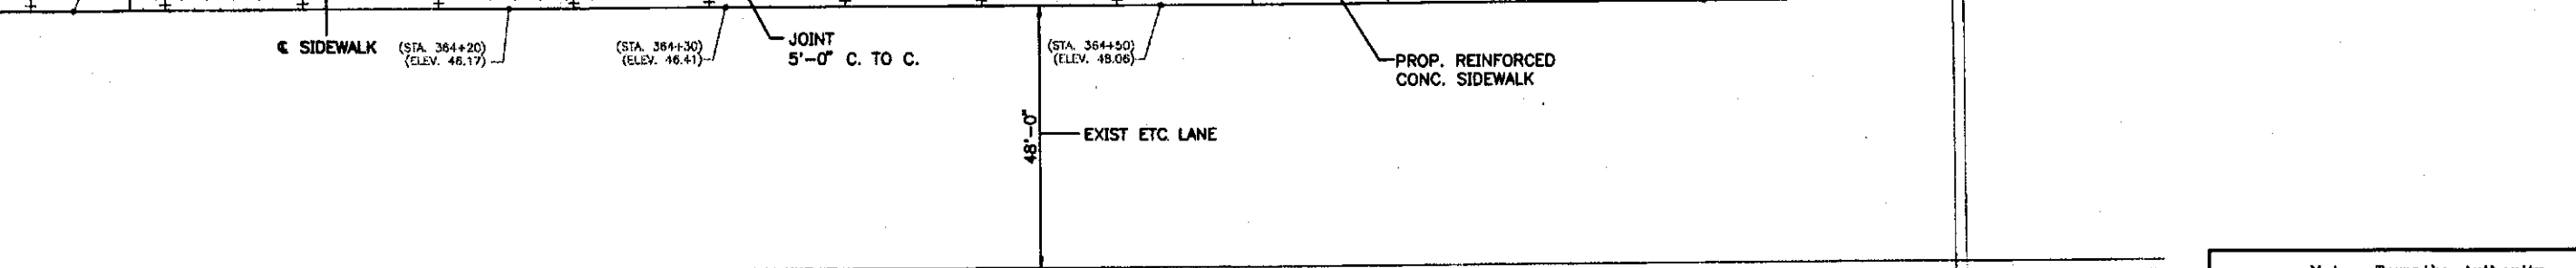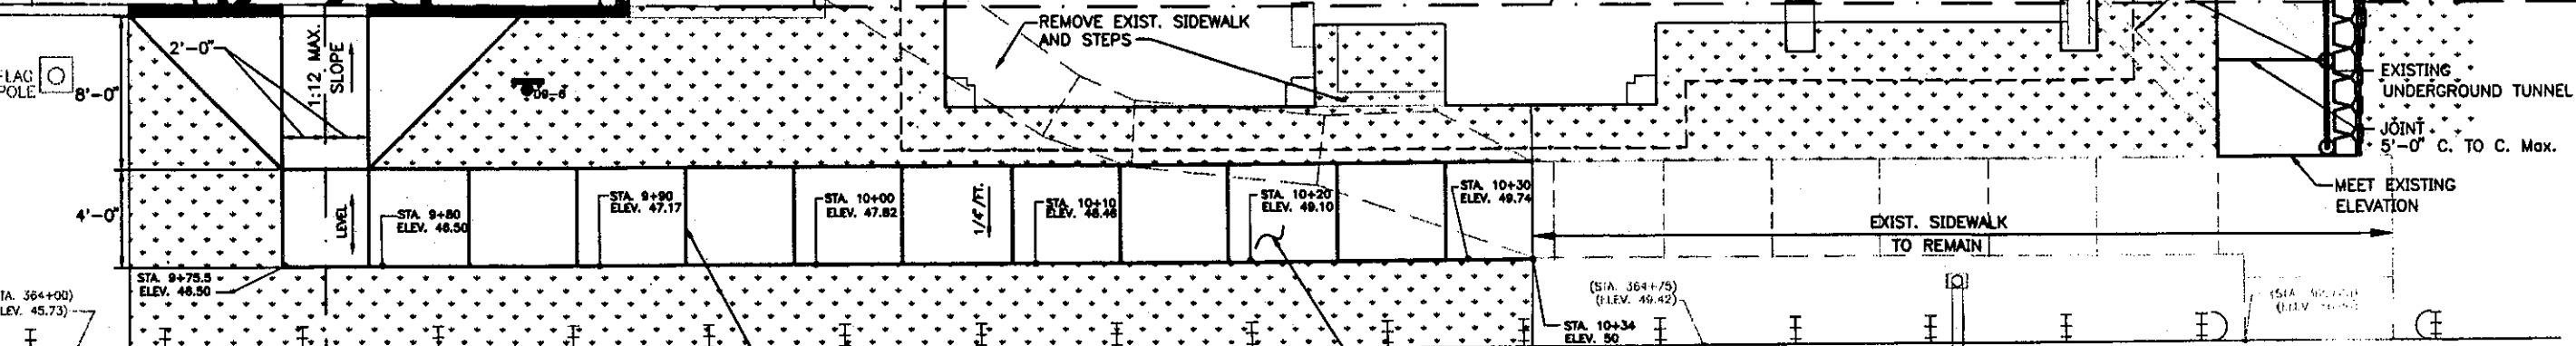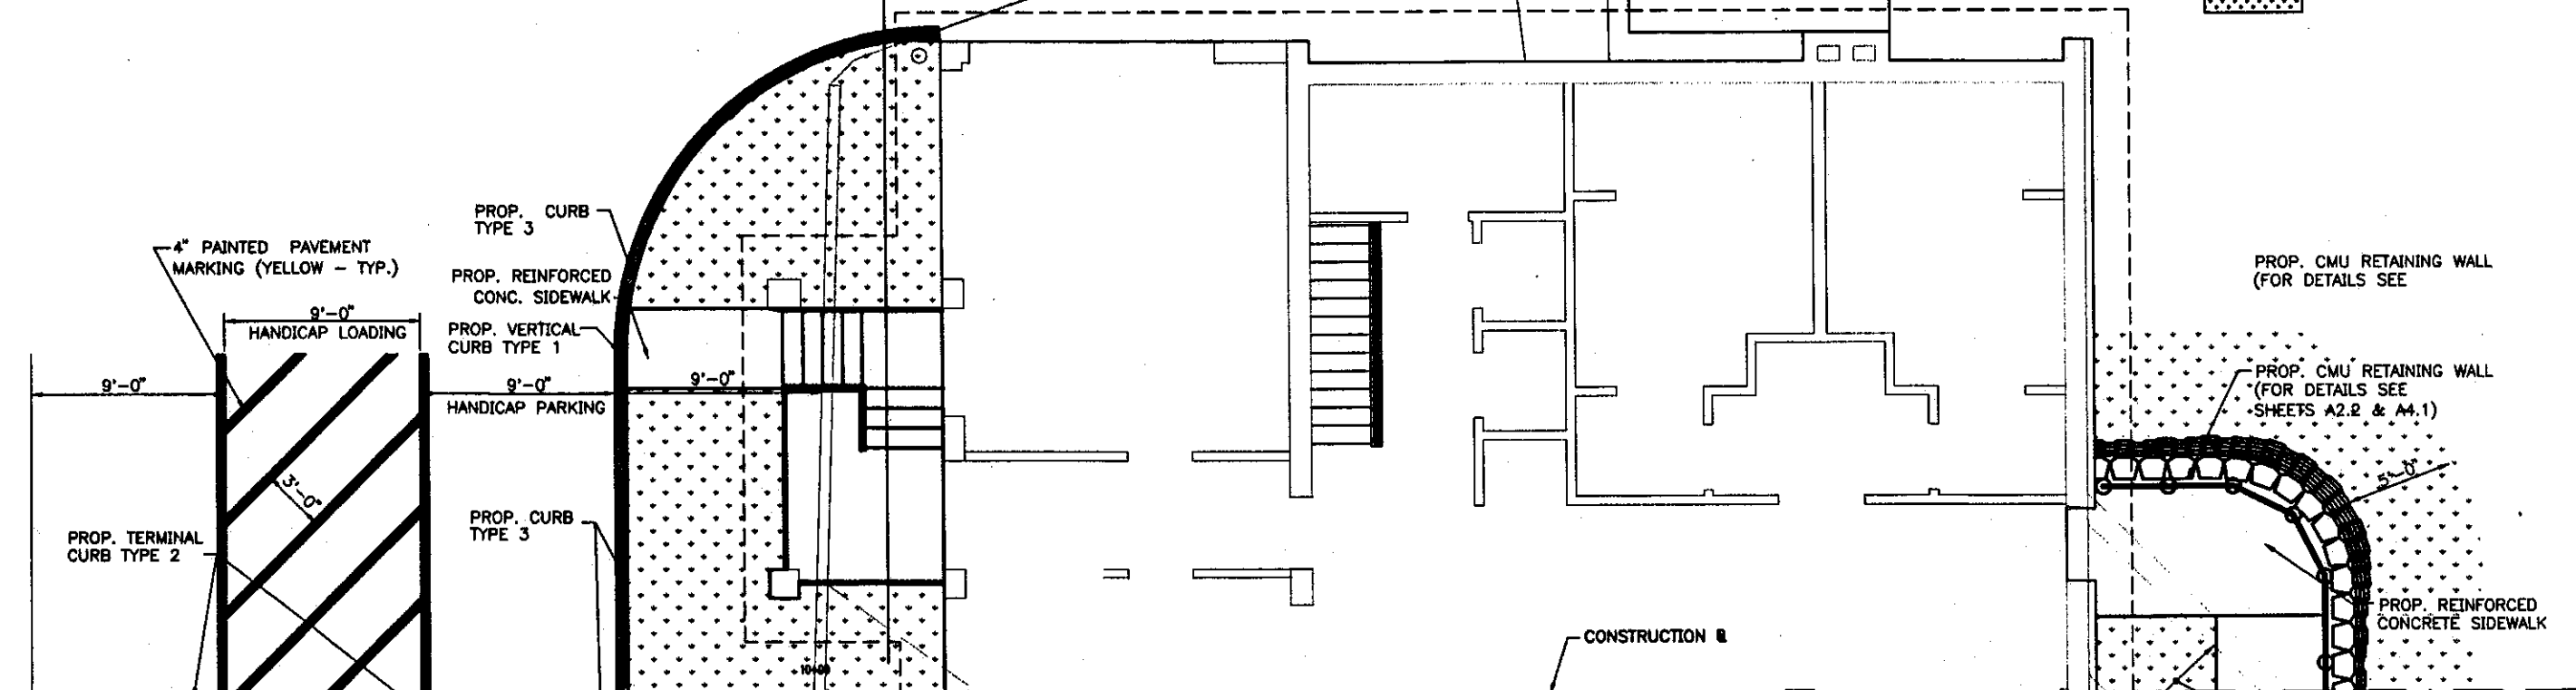

CONC. ISLAND



No.	Revision	By	Date	In Charge Of
		Designed	RWB	6/99
		Drawn	RWB	6/99
		Checked	GWV	7/99
				RAL

Maine Turnpike Authority
Maine Turnpike

Transpass

YORK TOLL PLAZA
BUILDING RECONSTRUCTION
AND EXPANSION
WALKWAY LAYOUT

HNTB
ARCHITECTS ENGINEERS PLANNERS

Contract 99.7 Sheet No. C-3
4 of 38


H:\H09009XW\005\004\99.7\GEN FLOOR PLAN.DWG 07/30/99 07:24



DEMOLITION LEGEND

- EXISTING PLUMBING FIXTURE TO BE REMOVED
- EXISTING DOOR AND FRAME TO BE REMOVED
- EXISTING WALL/CONSTRUCTION TO BE REMOVED
- EXISTING WINDOW TO BE REMOVED
- EXISTING WALL TO REMAIN
- EXISTING DOOR AND FRAME TO REMAIN

NOTE:
COORDINATE WITH LOUVER SHOP
DRAWINGS PRIOR TO CUTTING
CONCRETE

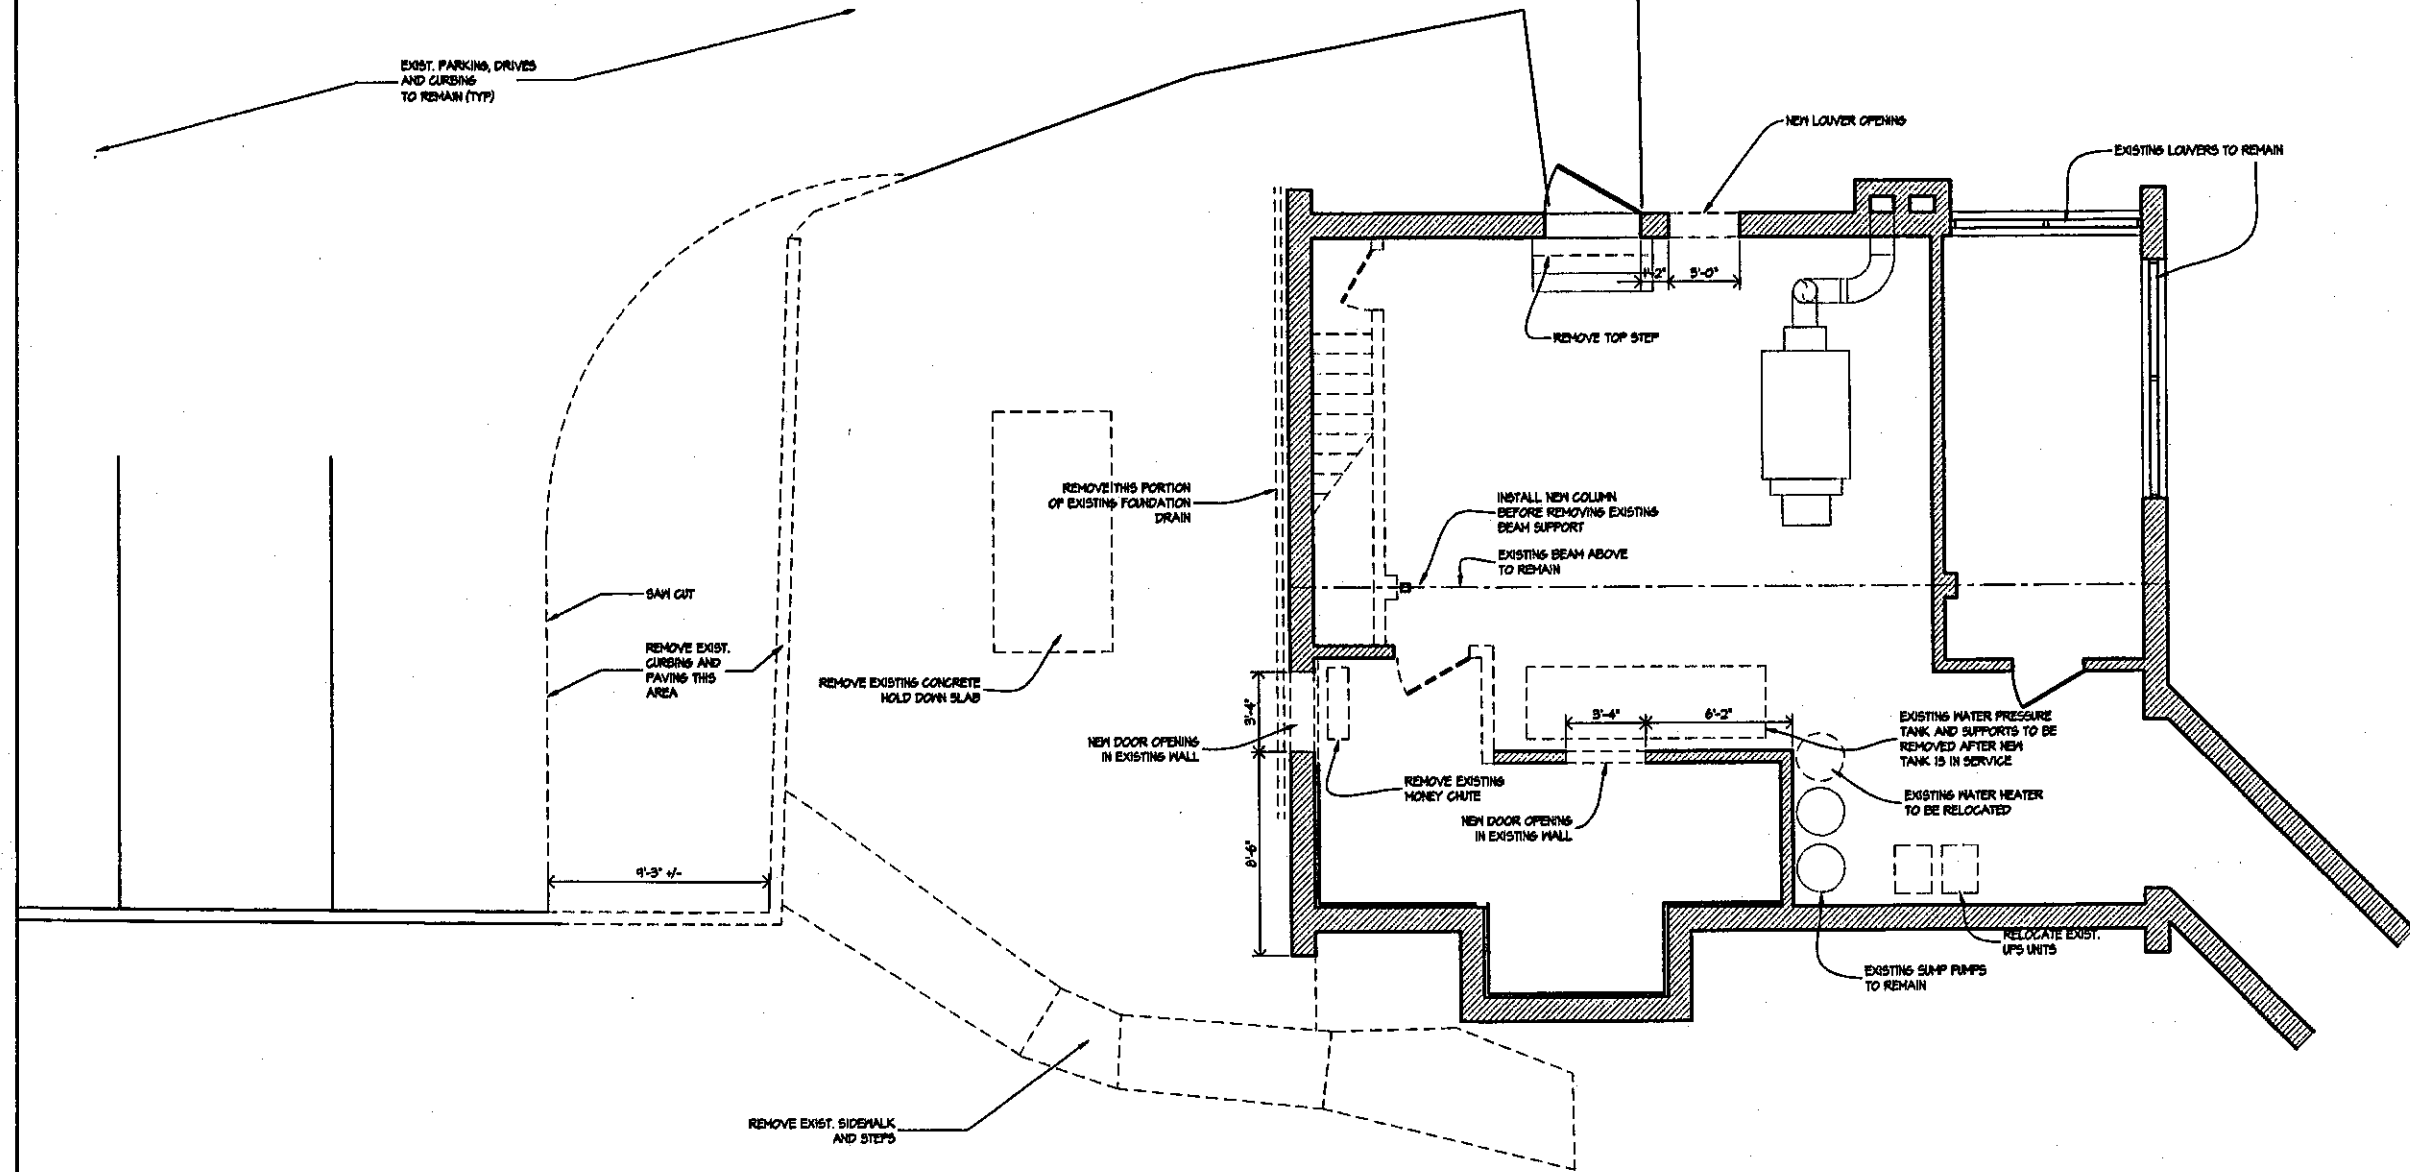

BASEMENT DEMOLITION FLOOR PLAN
SCALE: 1/4" = 1'-0"

BID SET: 6 AUGUST 1999

No.	Revision	By	Date	In Charge Of

Maine Turnpike Authority
Maine Turnpike



**Building Renovation
And Expansion**

BASEMENT DEMOLITION PLAN



ARCHITECTS ENGINEERS PLANNERS

LASSEL ARCHITECTS
64 IRINGLAND AVENUE
SOUTH BERRICH, MAINE 05906-2093

Contract	Sheet No.
YORK TOLL PLAZA - 99.7	5 OF 38 D1.1


(METPK\BDR-01)



DEMOLITION LEGEND

- EXISTING PLUMBING FIXTURE TO BE REMOVED
- EXISTING DOOR AND FRAME TO BE REMOVED
- EXISTING WALL/CONSTRUCTION TO BE REMOVED
- EXISTING WINDOW TO BE REMOVED
- EXISTING WALL TO REMAIN
- EXISTING DOOR AND FRAME TO REMAIN

NOTE:
COORDINATE WITH LOUVER SHOP DRAWINGS PRIOR TO CUTTING CONCRETE

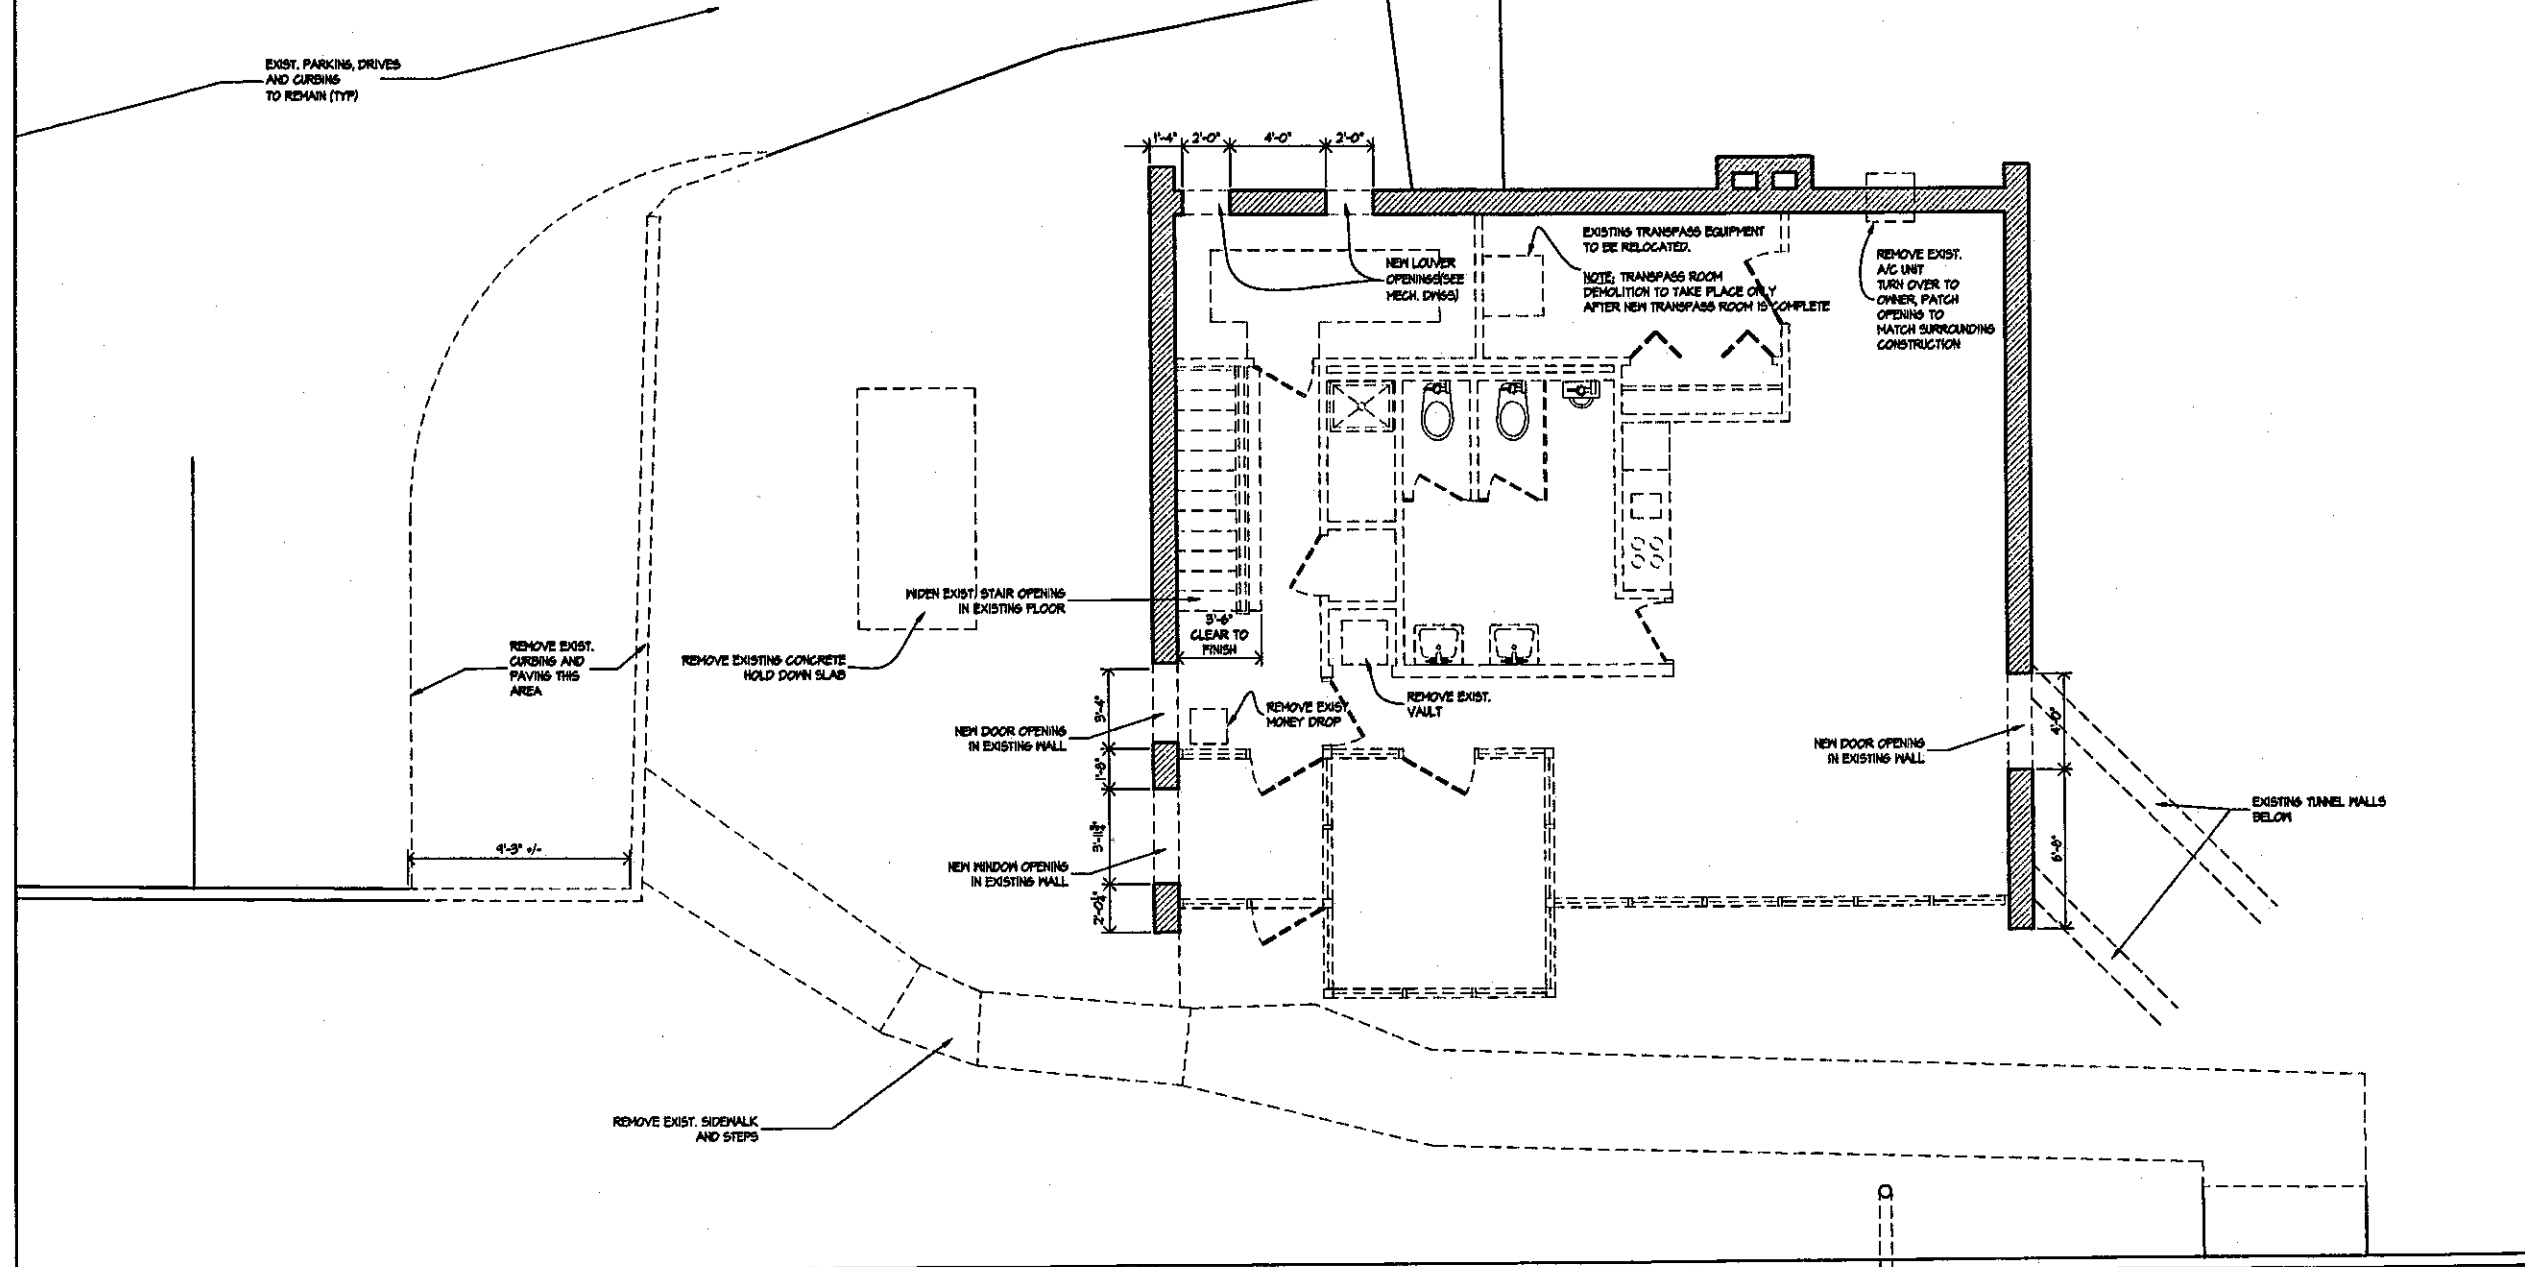

FIRST FLOOR DEMOLITION PLAN
SCALE: 1/4" = 1'-0"

BID SET: 5 AUGUST 1998

				By	Date
				Designed	
				Drawn	
				Checked	
No.	Revision	By	Date	In Charge Of:	

Maine Turnpike Authority
Maine Turnpike

**Building Renovation
And Expansion**


FIRST FLOOR DEMOLITION PLAN

HNTB
ARCHITECTS ENGINEERS PLANNERS


Contract YORK TOLL PLAZA - 99.7 Sheet No. 6 OF 38 **D1.2**

LASSEL ARCHITECTS
64 HIGHLAND AVENUE
SOUTH BERNICK, MAINE 03908 207.384.2040

(METPK)BDR-01

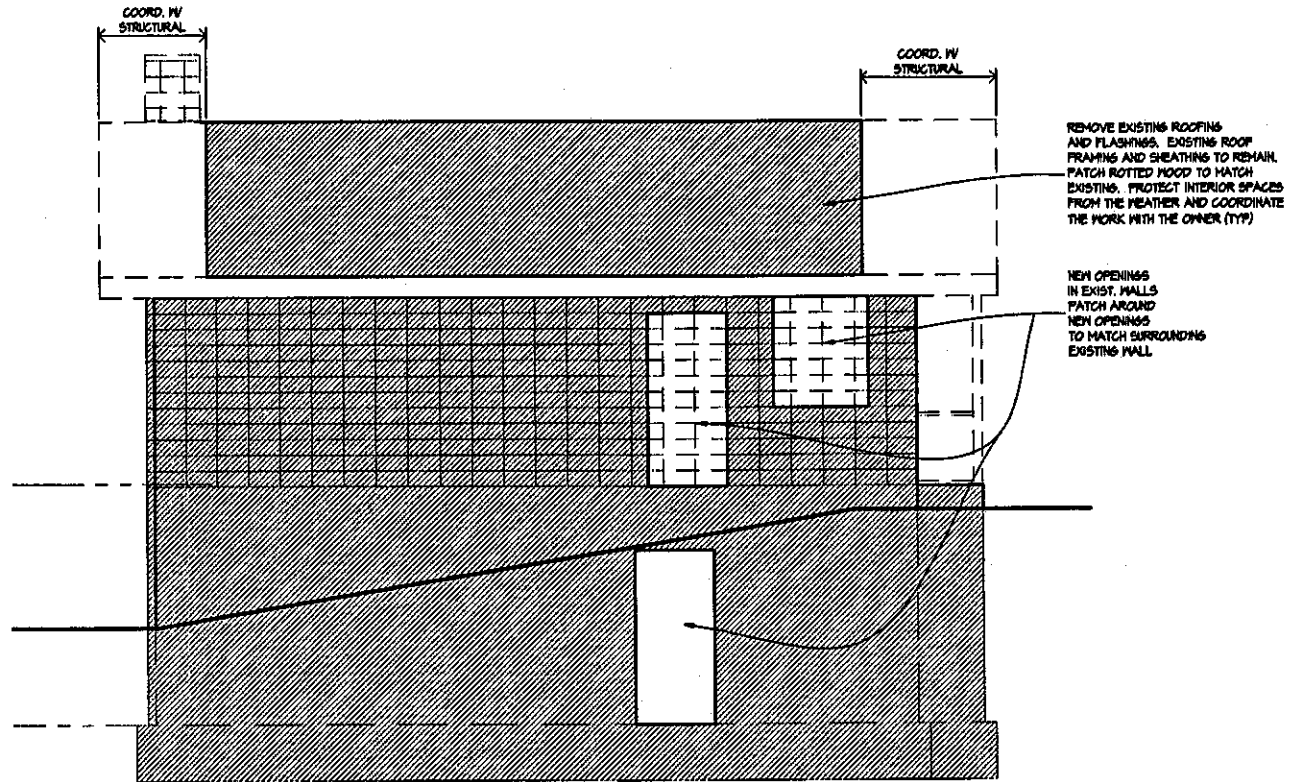


EXISTING SOUTH ELEVATION
SCALE: 1/4" = 1'-0"

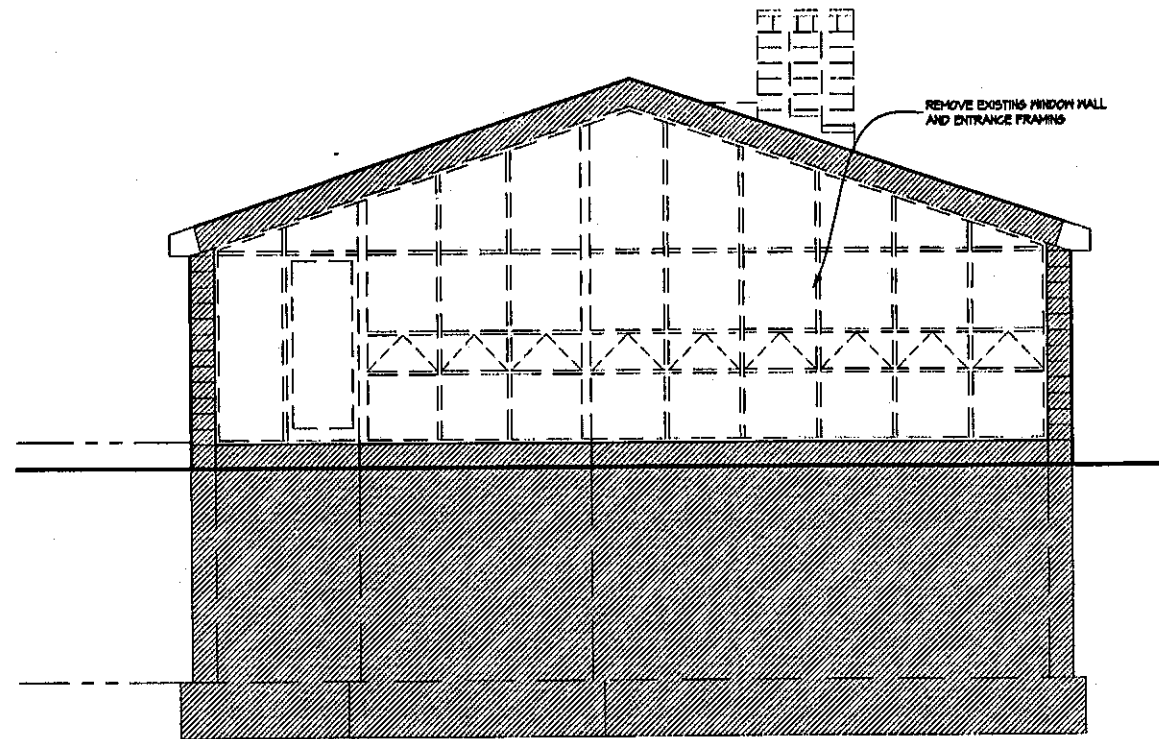


EXISTING EAST ELEVATION
SCALE: 1/4" = 1'-0"

DEMOLITION LEGEND

- EXISTING CONSTRUCTION TO BE REMOVED
- ===== EXISTING CONSTRUCTION TO REMAIN

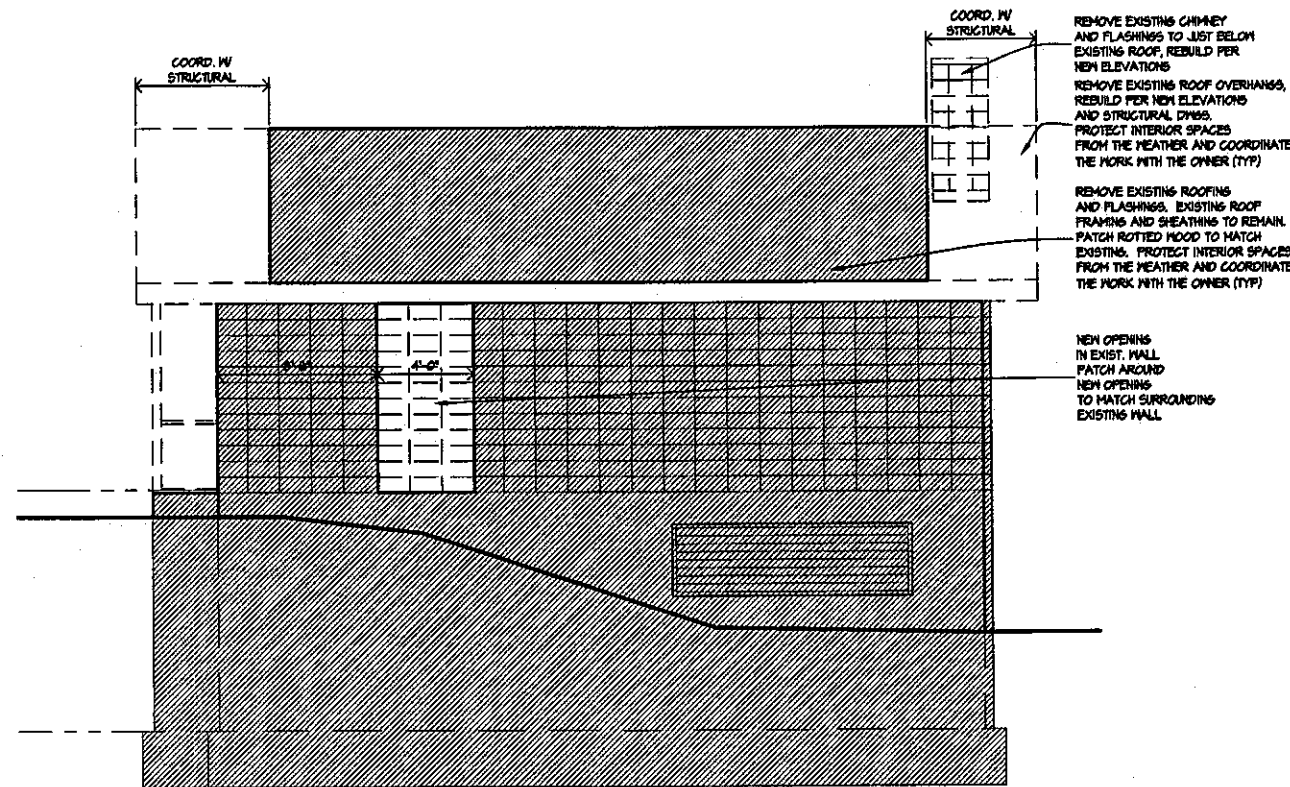

EXISTING NORTH ELEVATION
SCALE: 1/4" = 1'-0"

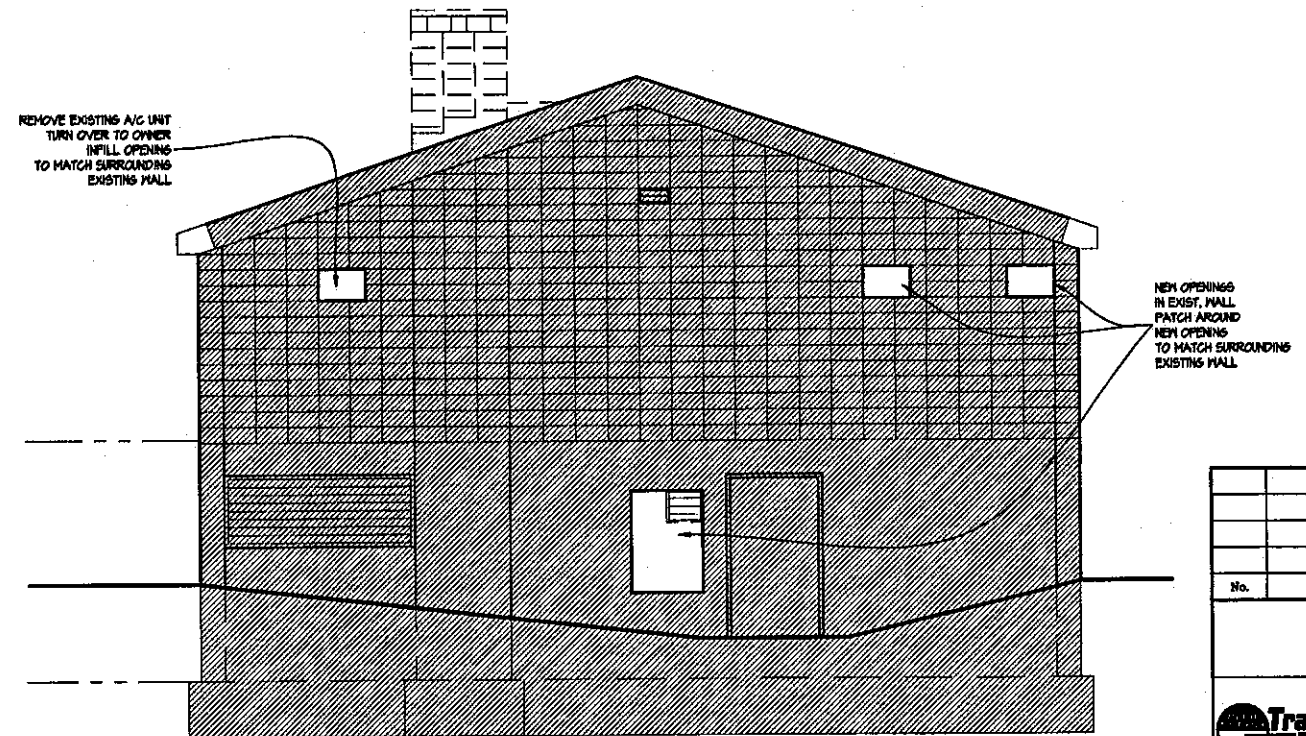

EXISTING WEST ELEVATION
SCALE: 1/4" = 1'-0"

BID SET: 5 AUGUST 1999

No.	Revision	By	Date	In Charge Of	

Maine Turnpike Authority
Maine Turnpike


Building Renovation And Expansion

DEMOLITION ELEVATIONS

HNTB
ARCHITECTS ENGINEERS PLANNERS

Contract YORK TOLL PLAZA - 99.7
Sheet No. 7 OF 38 **D2.1**


LASSEL ARCHITECTS
44 HIGHLAND AVENUE
SOUTH BERNICK, MAINE 03906 207.584.2049

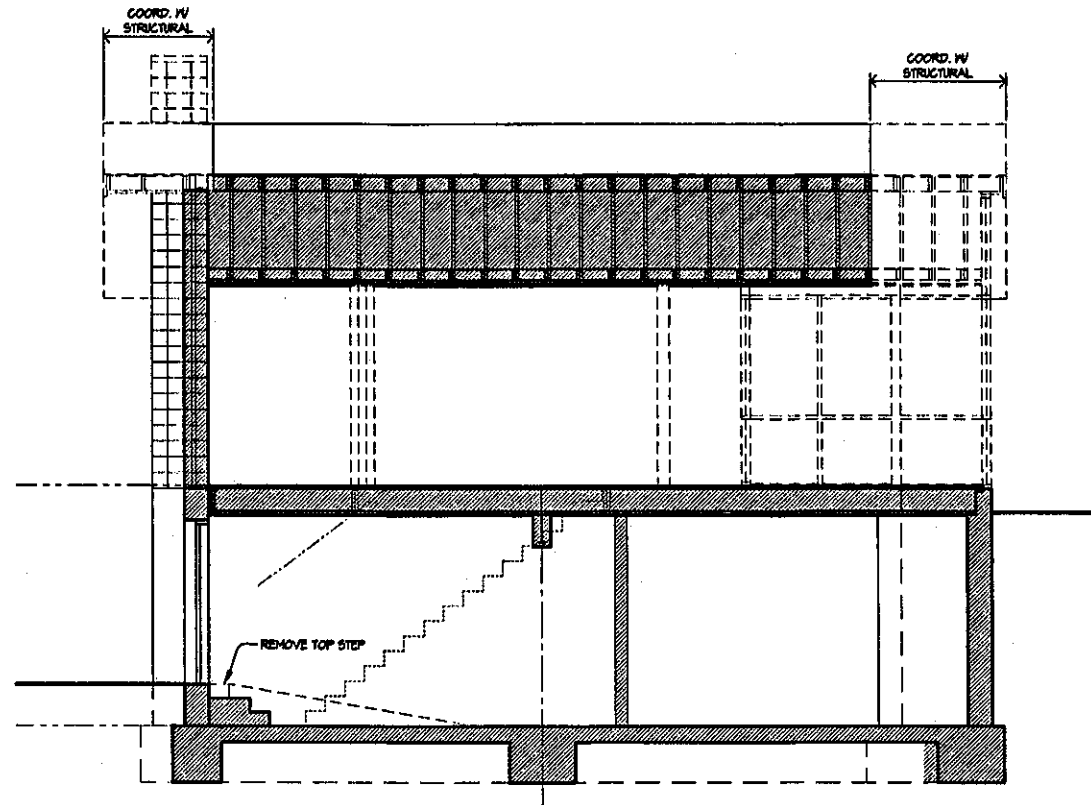

EXISTING EAST/WEST SECTION
SCALE: 1/4" = 1'-0"

DEMOLITION LEGEND

- EXISTING CONSTRUCTION TO BE REMOVED
- ===== EXISTING CONSTRUCTION TO REMAIN

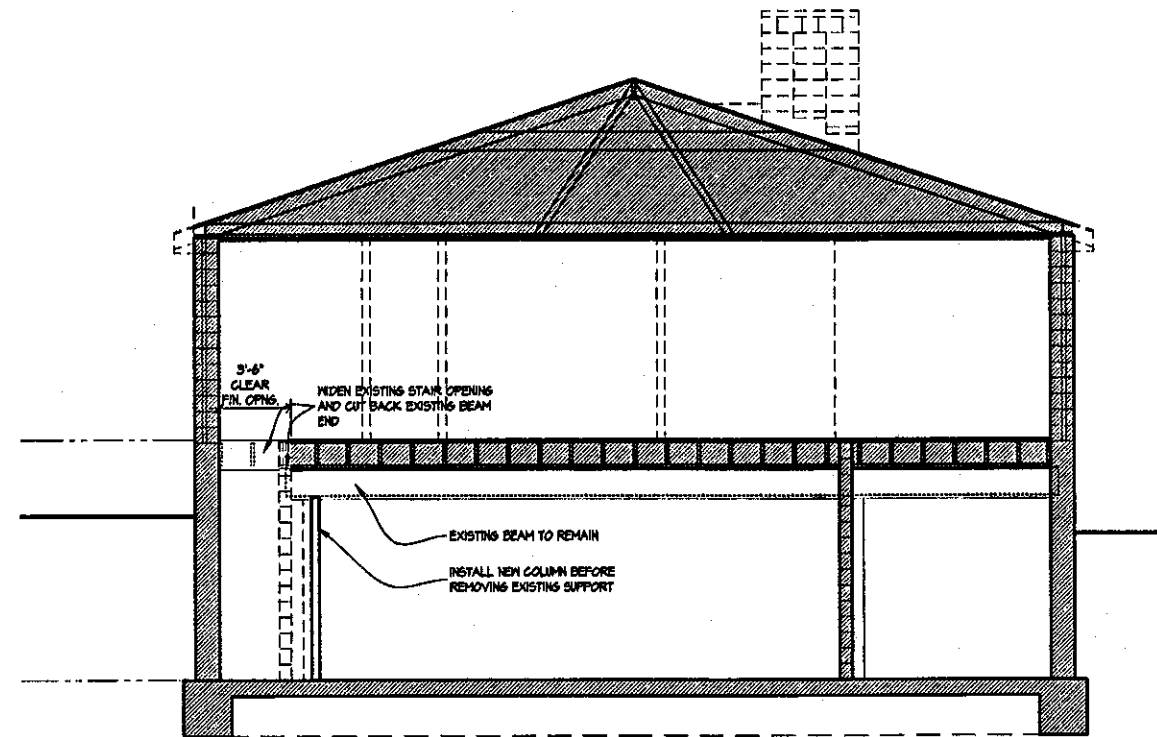

EXISTING NORTH/SOUTH SECTION
SCALE: 1/4" = 1'-0"

BID SET: 5 AUGUST 1998

				By	Date
				Designed	
				Drawn	
				Checked	
No.	Revision	By	Date	In Charge Of:	

Maine Turnpike Authority
Maine Turnpike



**Building Renovation
And Expansion**


DEMOLITION SECTIONS



ARCHITECTS ENGINEERS PLANNERS

LASSEL ARCHITECTS
64 HIGHLAND AVENUE
SOUTH BERRICK, MAINE 03908 207.384.2049

Contract YORK TOLL PLAZA - 99.7	Sheet No. 8 OF 38 D4.1
------------------------------------	----------------------------------

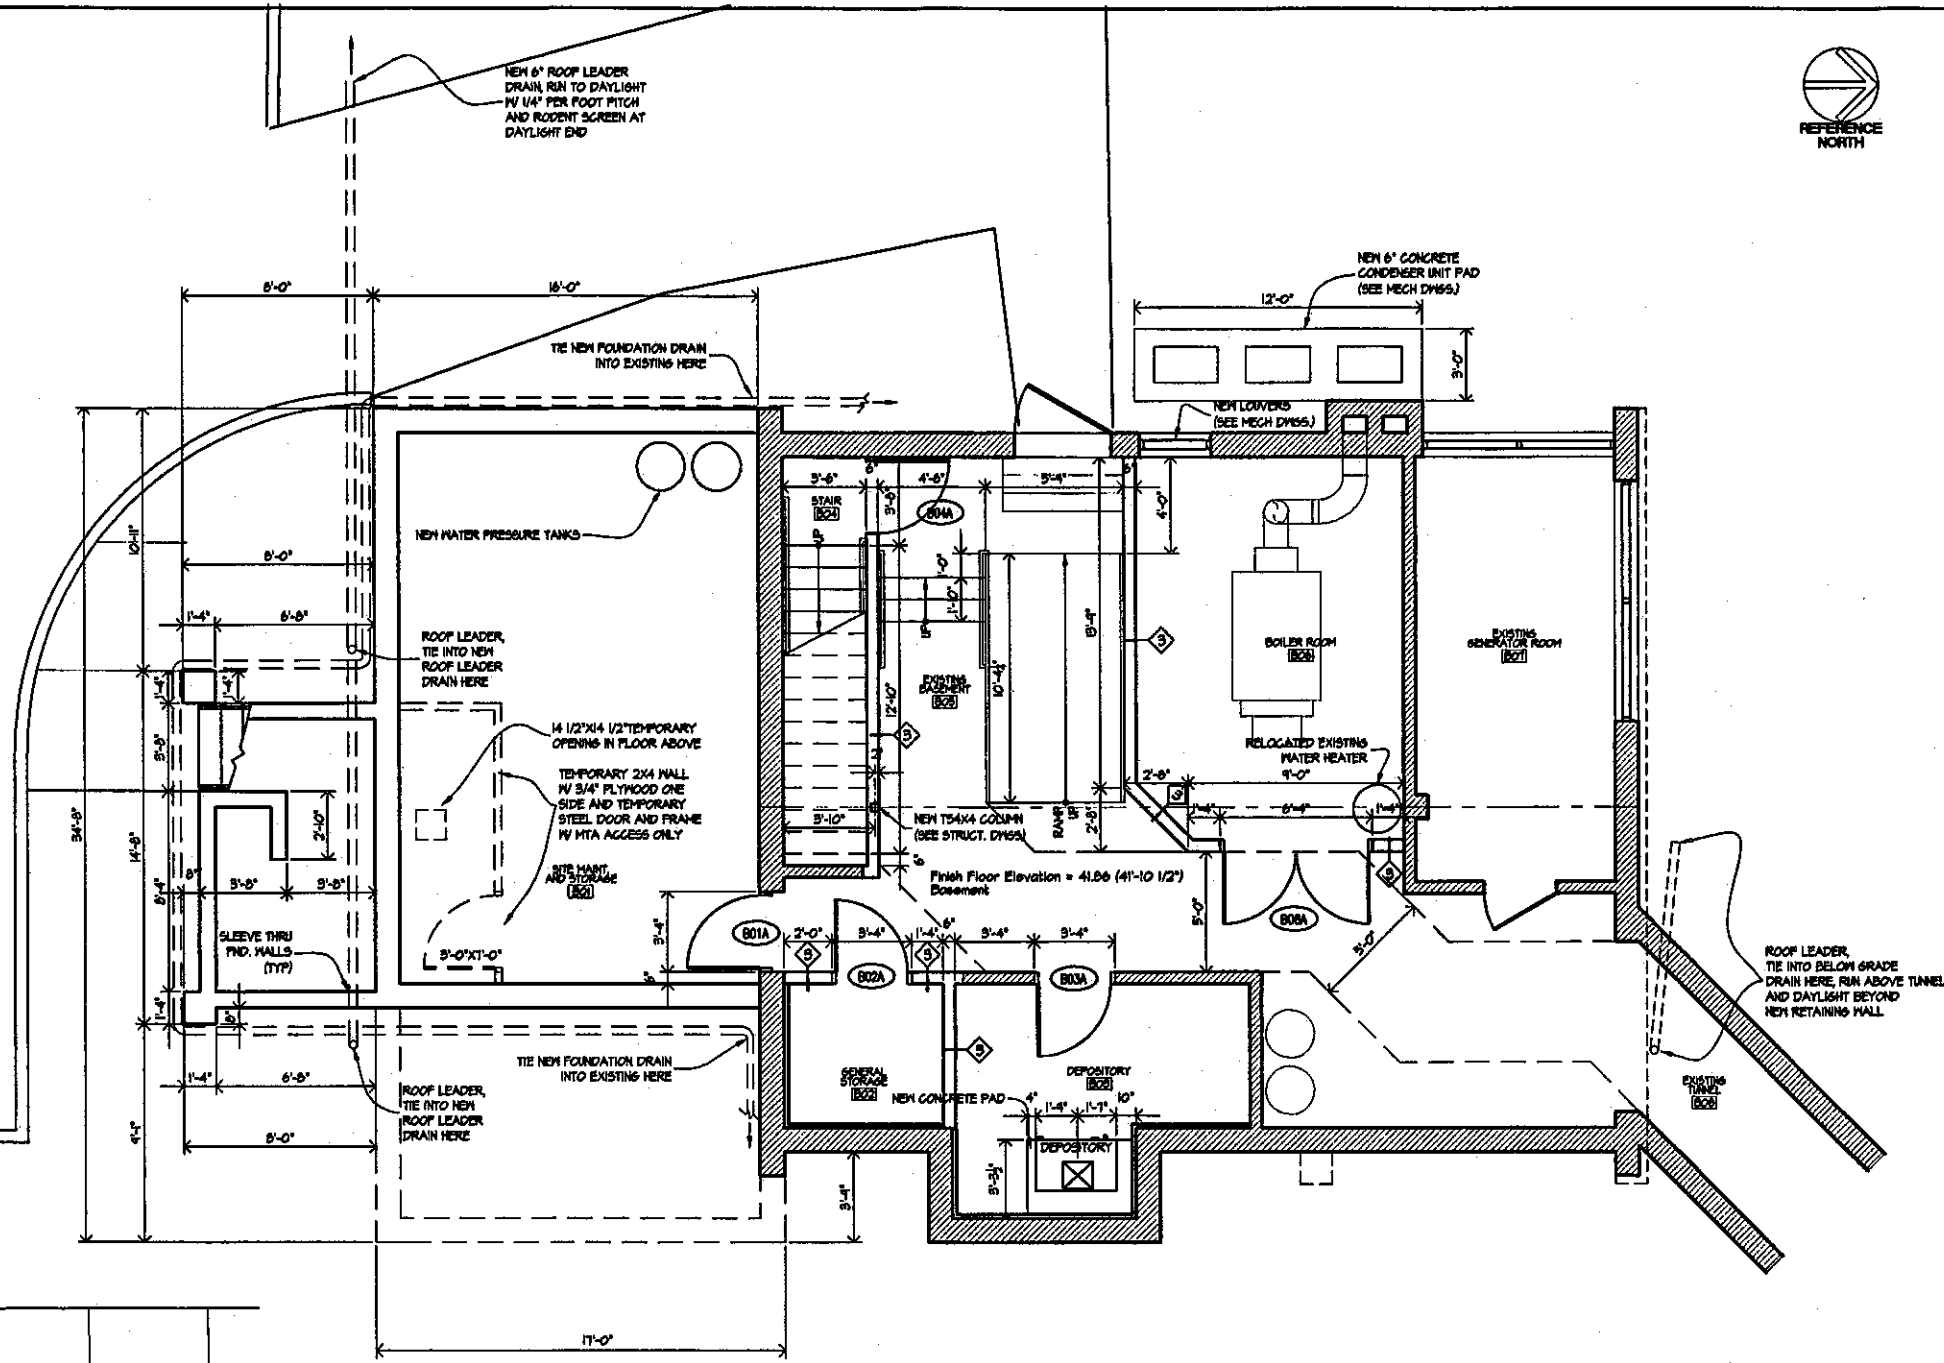

- LEGEND**
- NEW WALLS
 - EXISTING WALLS
 - NEW DOORS
 - EXISTING DOORS
 - INTERIOR ELEVATION KEY
 - DOOR KEY
 - ROOM KEY
 - WINDOW TYPE KEY
 - DETAIL KEY

BASEMENT FLOOR PLAN
SCALE: 1/4" = 1'-0"


BID SET: 5 AUGUST 1998

				By	Date
				Designed	
				Drawn	
				Checked	
No.	Revision	By	Date	In Charge Of	
Maine Turnpike Authority Maine Turnpike					
Building Renovation And Expansion BASEMENT FLOOR PLAN					
ARCHITECTS ENGINEERS PLANNERS					
Contract YORK TOLL PLAZA - 99.7			Sheet No. 9 OF 38 A1.1		

LASSEL ARCHITECTS
64 HIGHLAND AVENUE
SOUTH BERNICK, MAINE 03908 207.584.2049



- LEGEND**
- NEW WALLS
 - EXISTING WALLS
 - NEW DOORS
 - EXISTING DOORS
 - INTERIOR ELEVATION KEY
 - DOOR KEY
 - ROOM KEY
 - WINDOW TYPE KEY
 - DETAIL KEY

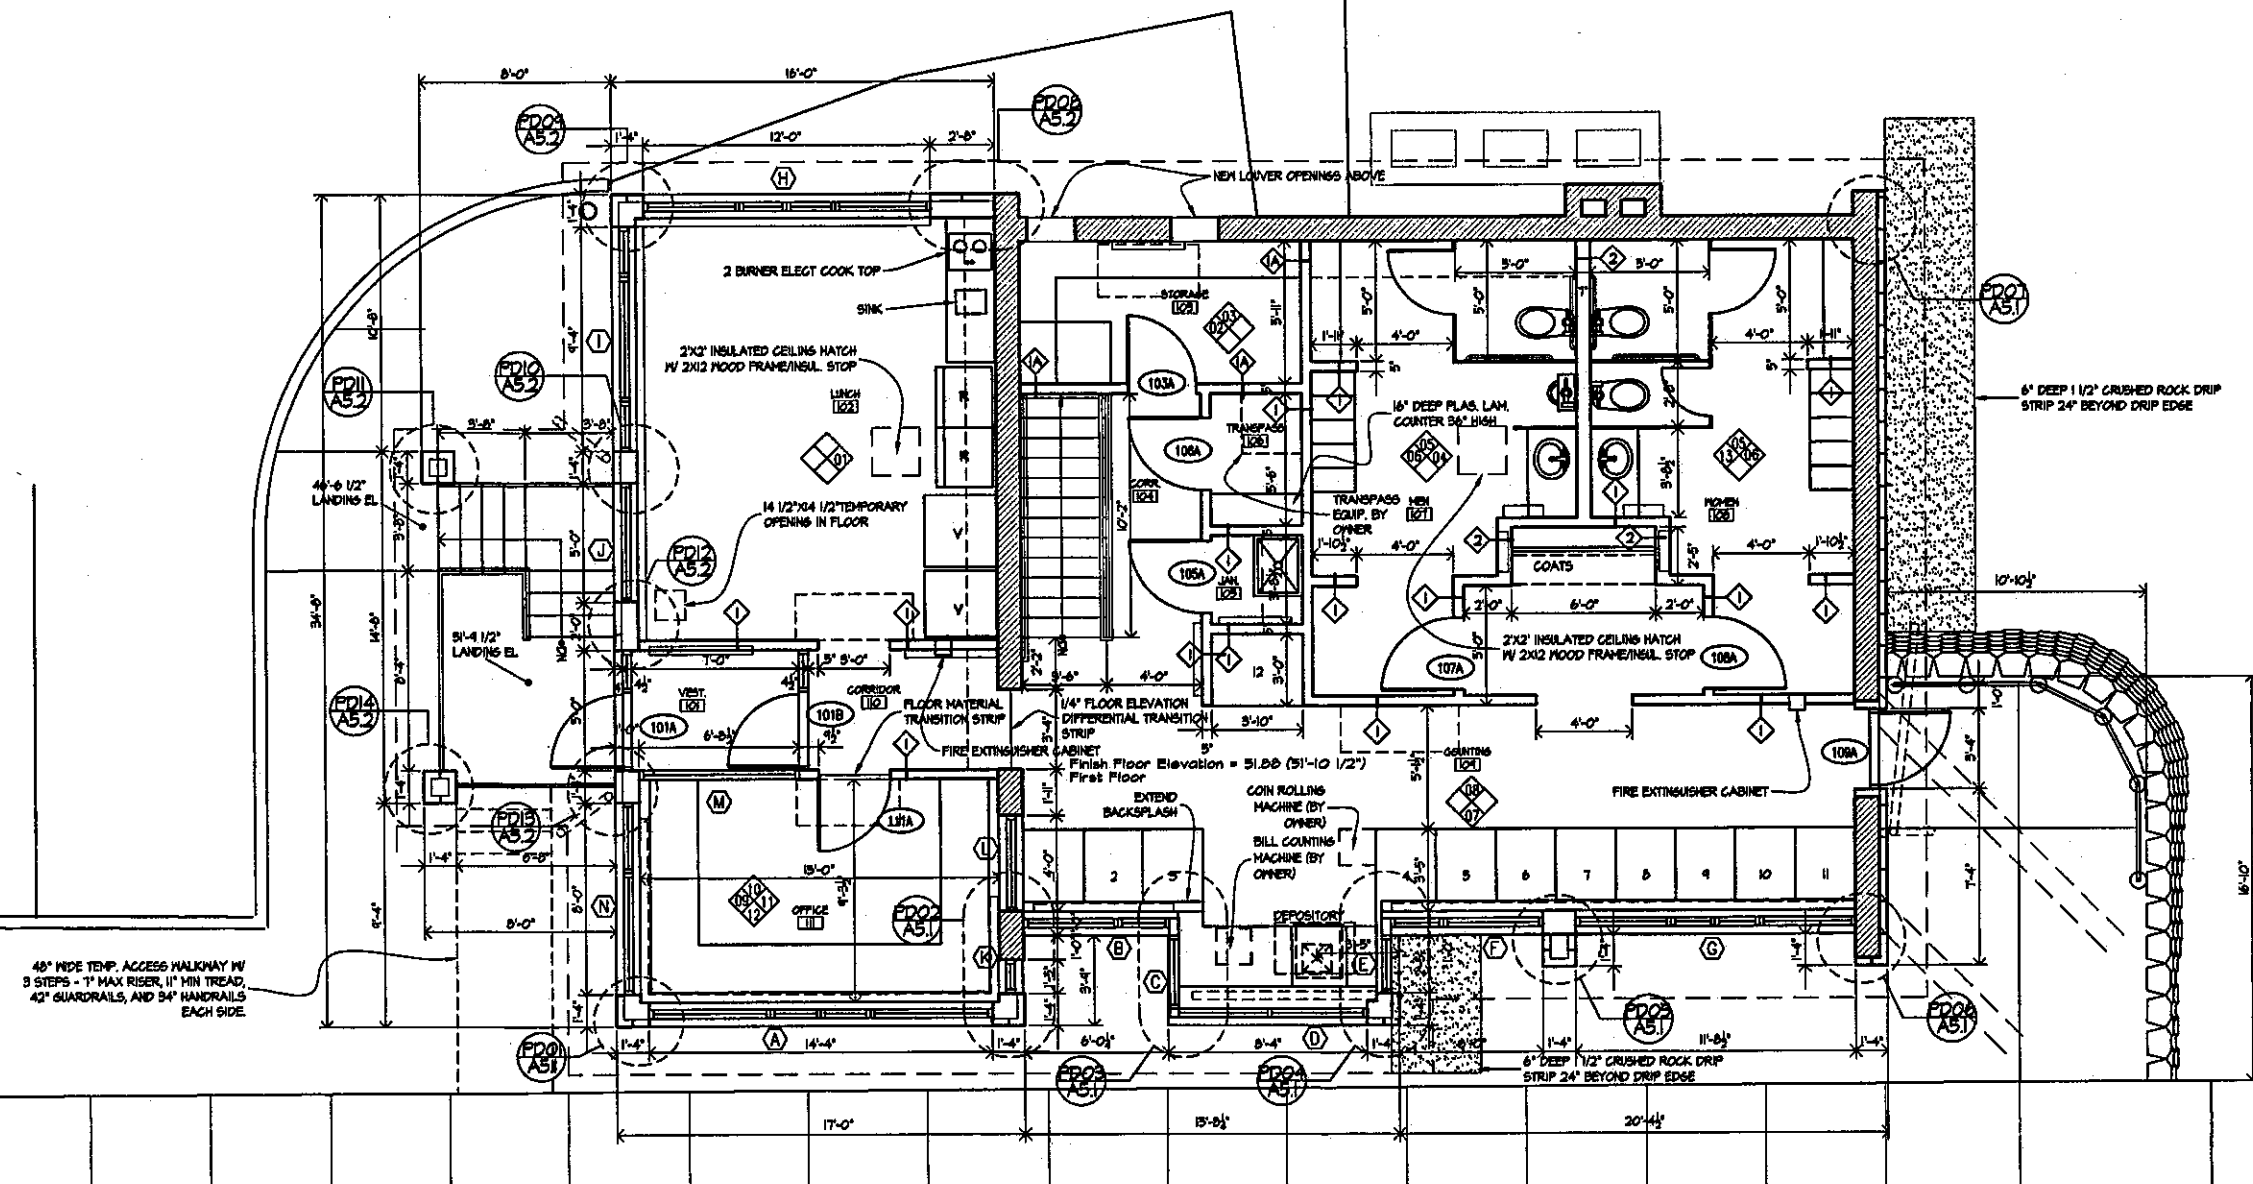

48" WIDE TEMP. ACCESS WALKWAY W/ 3 STEPS - 1" MAX RISER, 11" MIN TREAD, 42" GUARDRAILS, AND 34" HANDRAILS EACH SIDE.

FIRST FLOOR PLAN
SCALE: 1/4" = 1'-0"

BID SET: 5 AUGUST 1999

No.	Revision	By	Date	In Charge Of:


Maine Turnpike Authority
Maine Turnpike

**Building Renovation
And Expansion**

FIRST FLOOR PLAN
 ARCHITECTS ENGINEERS PLANNERS

LASSEL ARCHITECTS
64 HIGHLAND AVENUE
SOUTH BERRICH, MAINE 03908 207.384.2049

Contract YORK TOLL PLAZA - 99.7 Sheet No. 10 OF 38 **A1.2**

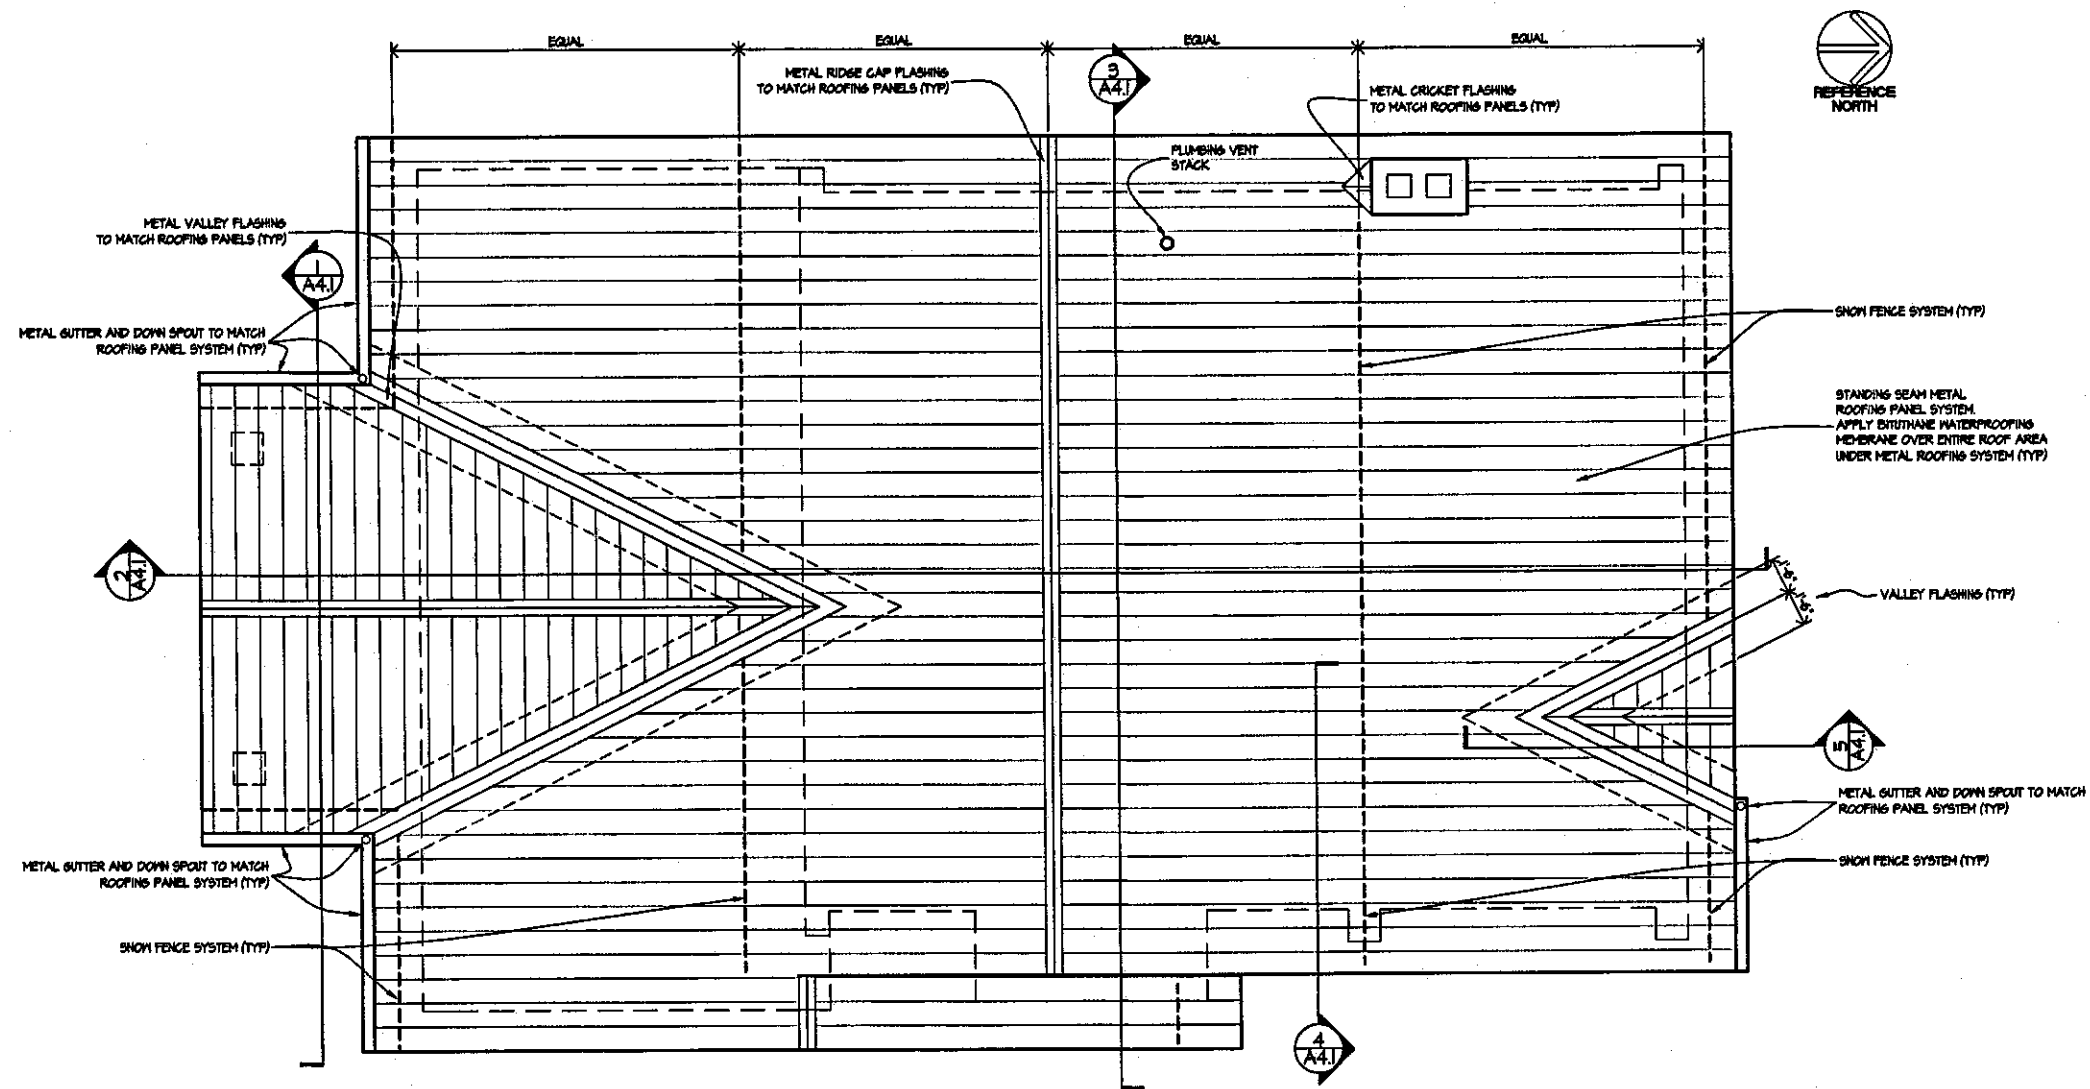

ROOF PLAN
SCALE: 1/4" = 1'-0"

BID SET: 5 AUGUST 1999

				By	Date
				Designed	
				Drawn	
				Checked	
No.	Revision	By	Date	In Charge Of	


Maine Turnpike Authority
Maine Turnpike

Transpass Building Renovation
And Expansion
ROOF PLAN


HNTB
ARCHITECTS ENGINEERS PLANNERS

Contract YORK TOLL PLAZA - 99.7
Sheet No. 11 OF 38 **A1.3**

LASSEL ARCHITECTS
84 HIGHLAND AVENUE
SOUTH BERNICK, MAINE 03908 207.384.2049

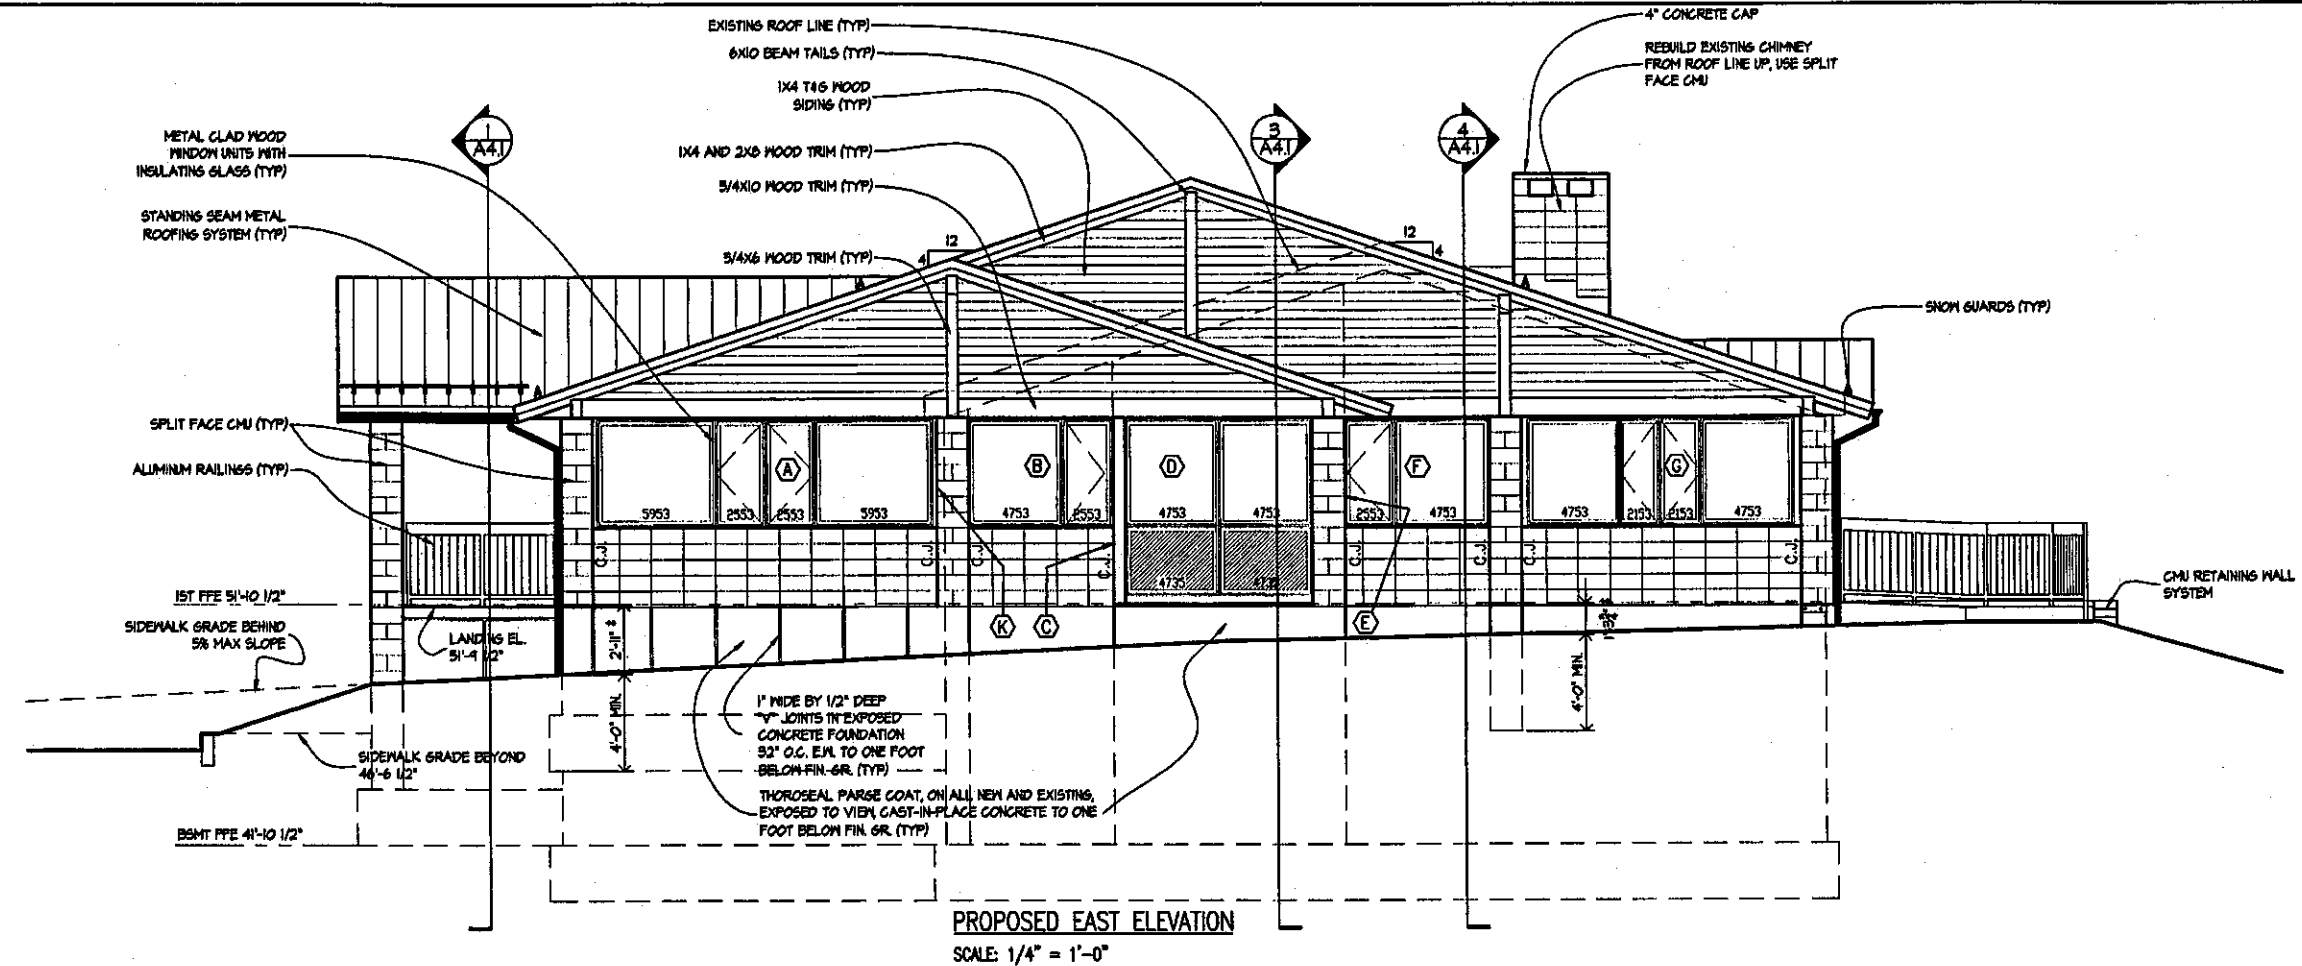

PROPOSED EAST ELEVATION
SCALE: 1/4" = 1'-0"

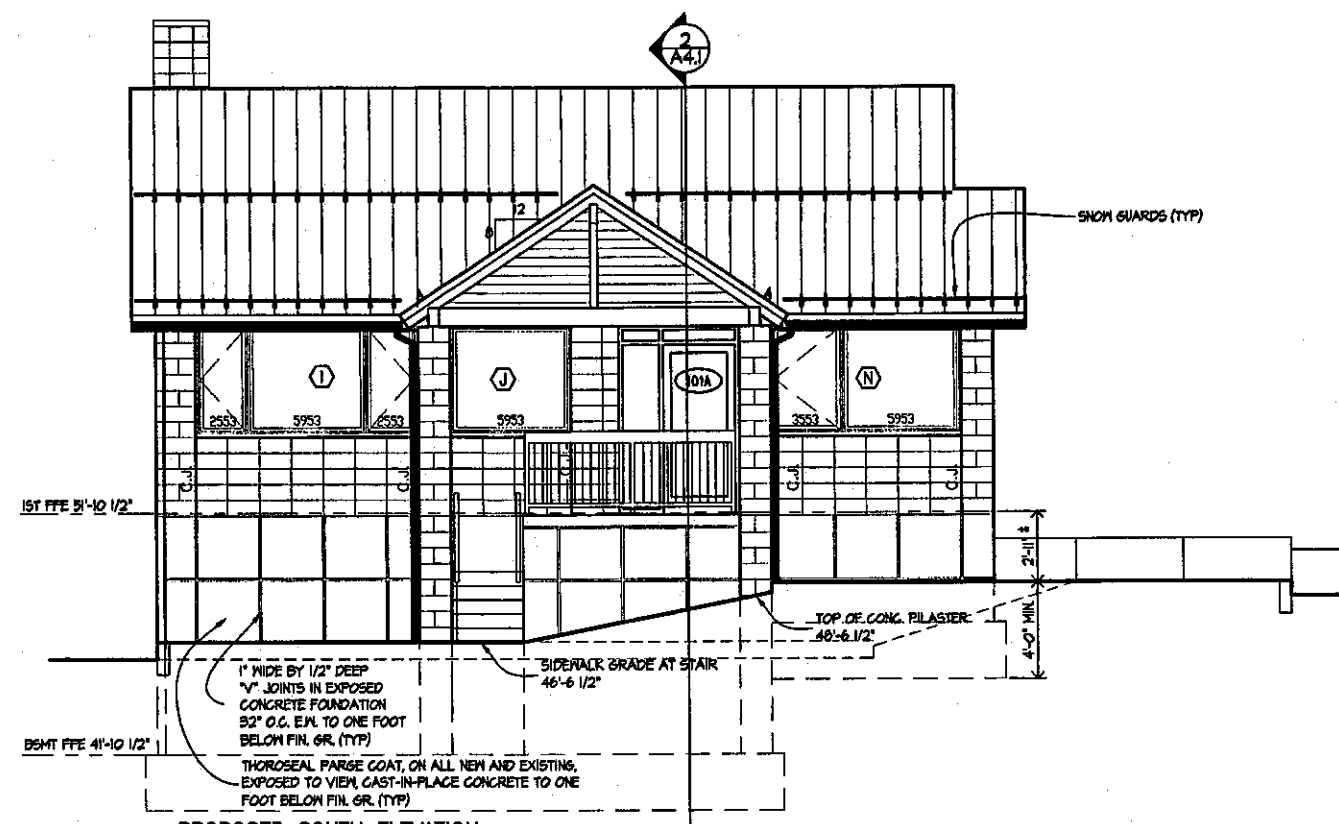

PROPOSED SOUTH ELEVATION
SCALE: 1/4" = 1'-0"


LASSEL ARCHITECTS
84 HIGHLAND AVENUE
SOUTH BERRICK, MAINE 03908 207.384.2049

BID SET: 6 AUGUST 1999


No.	Revision	By	Date	In Charge Of

Maine Turnpike Authority
Maine Turnpike
 Building Renovation
 And Expansion
 EXTERIOR ELEVATIONS
HNTE
 ARCHITECTS ENGINEERS PLANNERS

Contract	Sheet No.
YORK TOLL PLAZA - 99.7	12 OF 38 A2.1

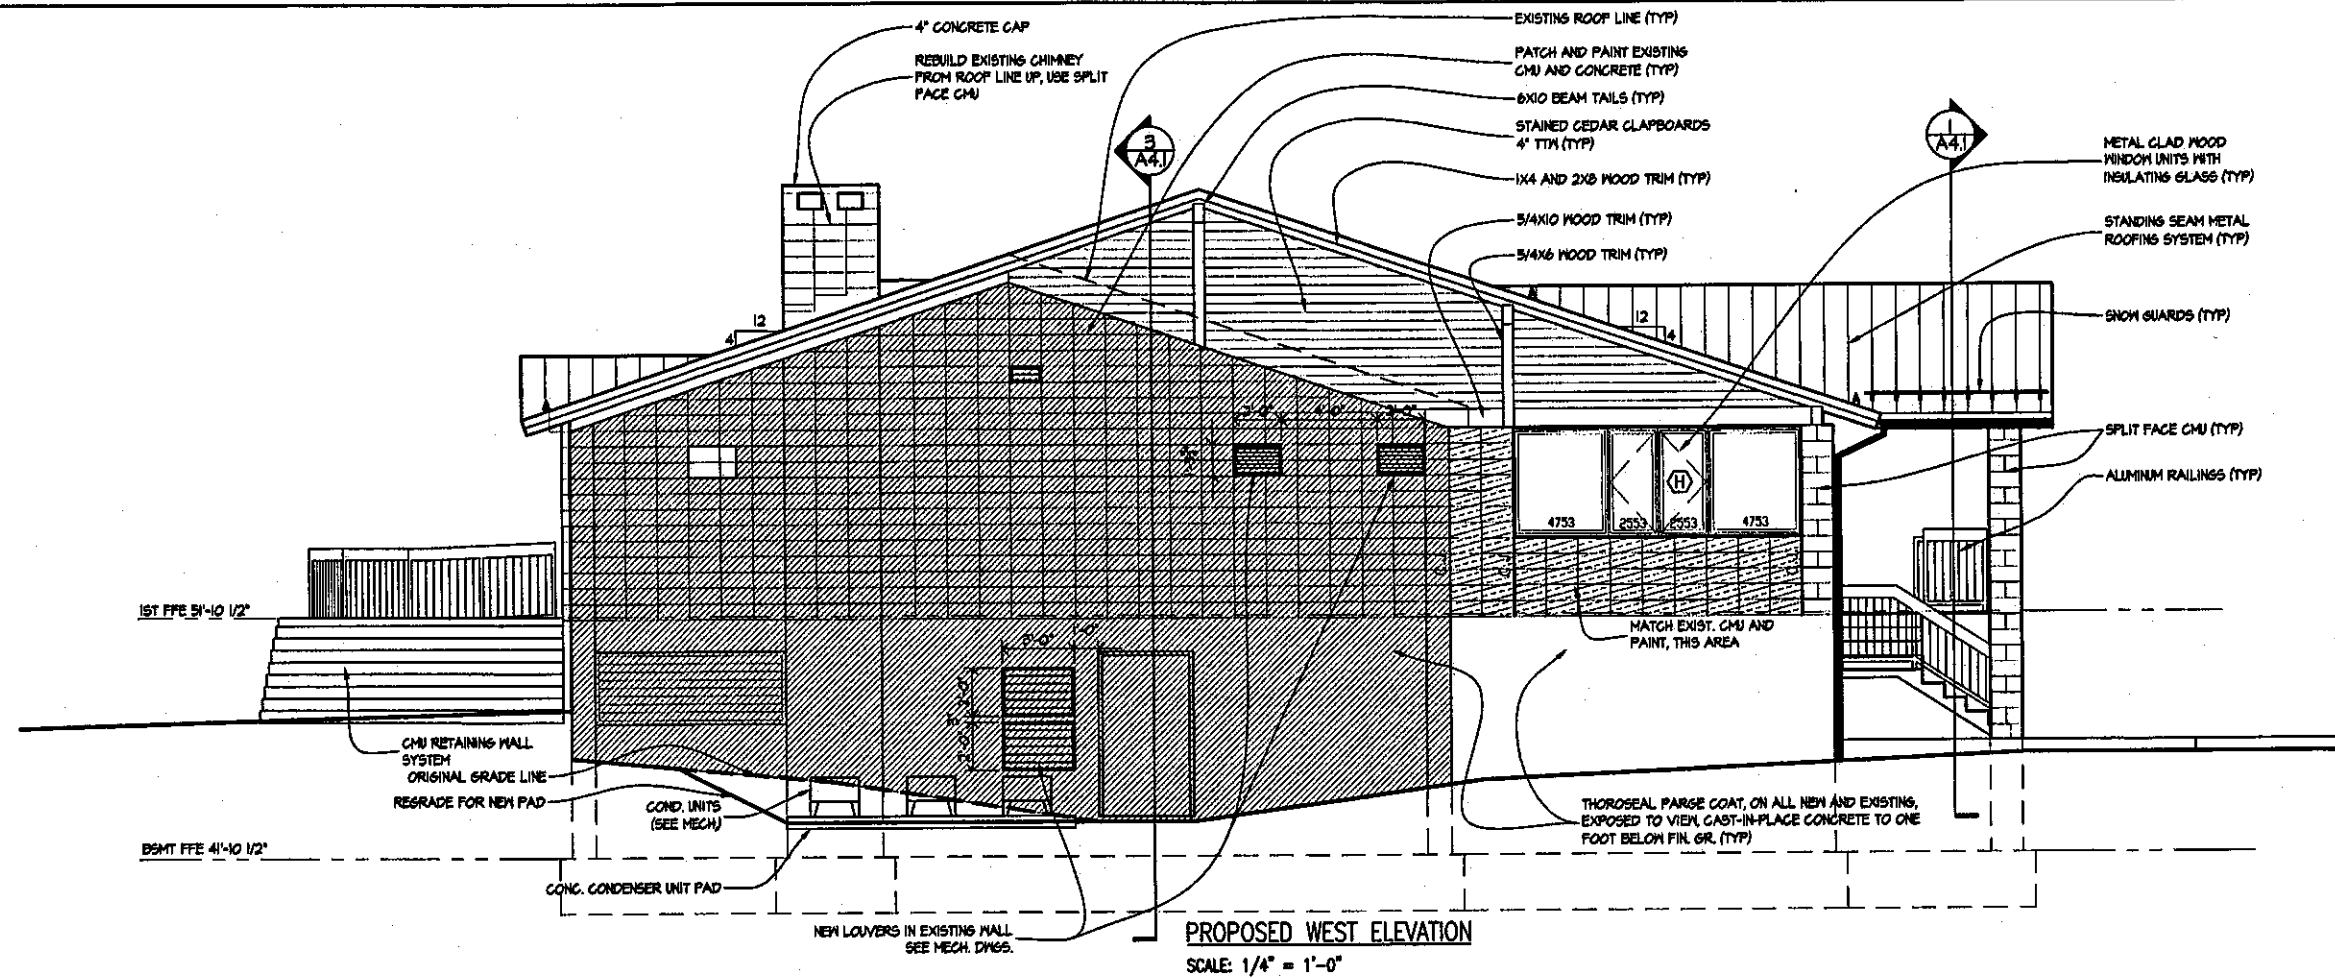

PROPOSED WEST ELEVATION
SCALE: 1/4" = 1'-0"

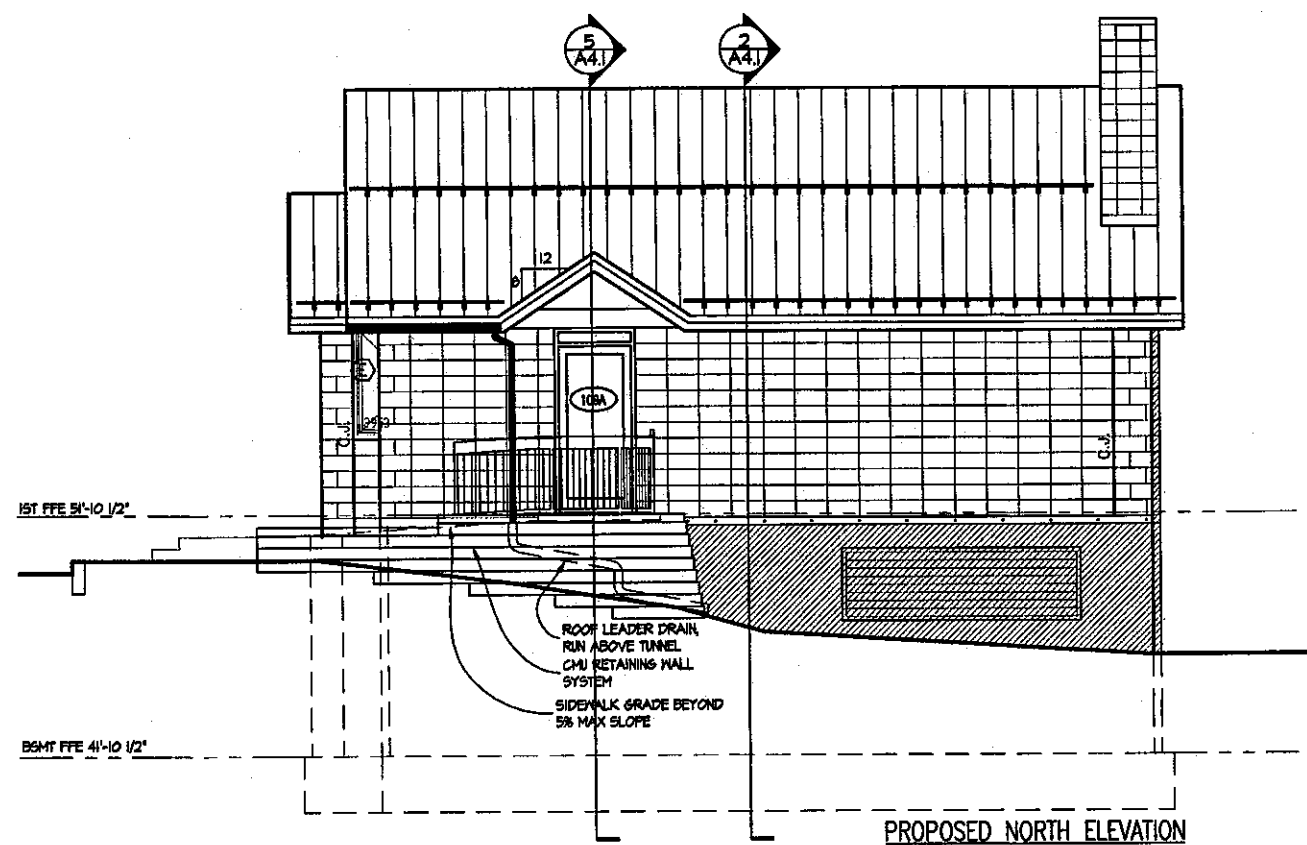

PROPOSED NORTH ELEVATION
SCALE: 1/4" = 1'-0"

BID SET: 5 AUGUST 1999

No.	Revision	By	Date	In Charge Of:

Meine Turnpike Authority
Maine Turnpike

**Building Renovation
And Expansion**









EXTERIOR ELEVATIONS

HNTB
ARCHITECTS ENGINEERS PLANNERS






Contract YORK TOLL PLAZA - 99.7
Sheet No. 13 OF 38 **A2.2**

LASSEL ARCHITECTS
64 HIGHLAND AVENUE
SOUTH BERNICK, MAINE 03908 207.284.2049

(METPK BDR-01)

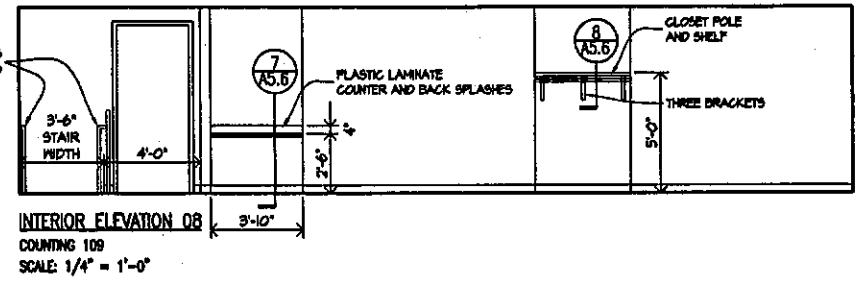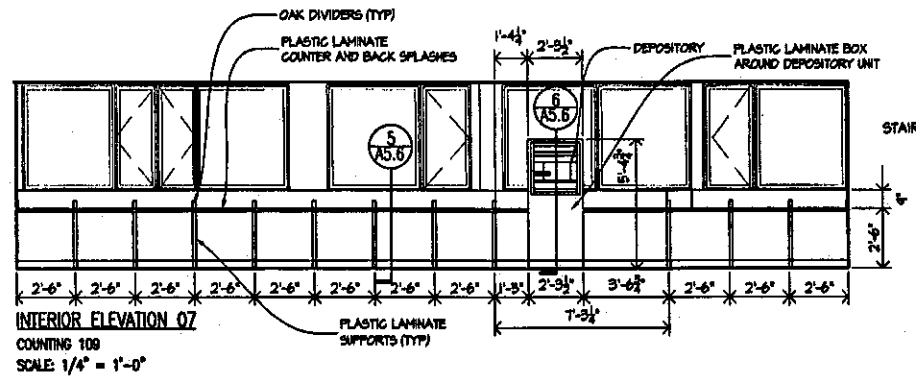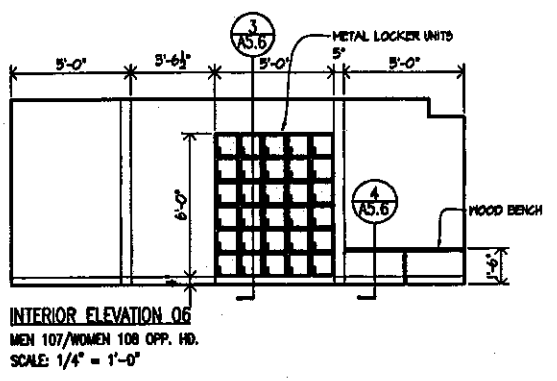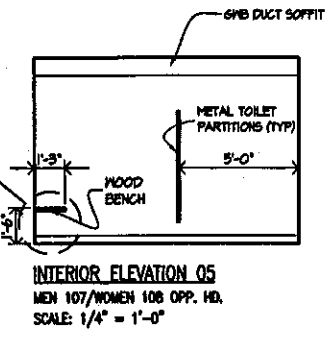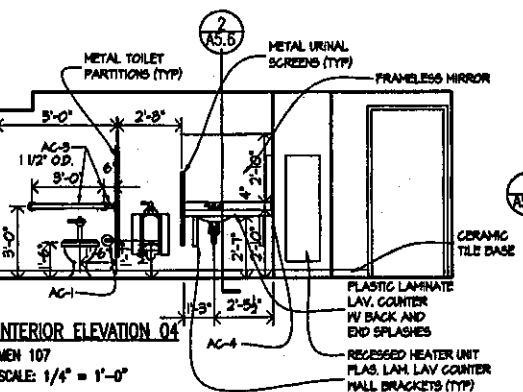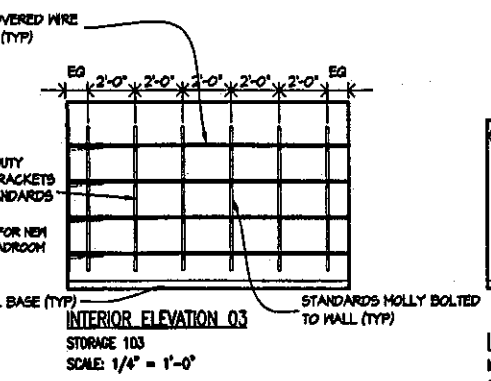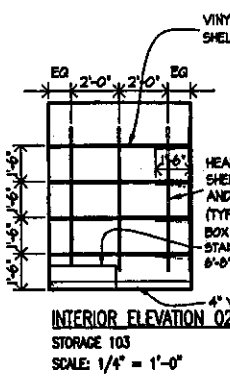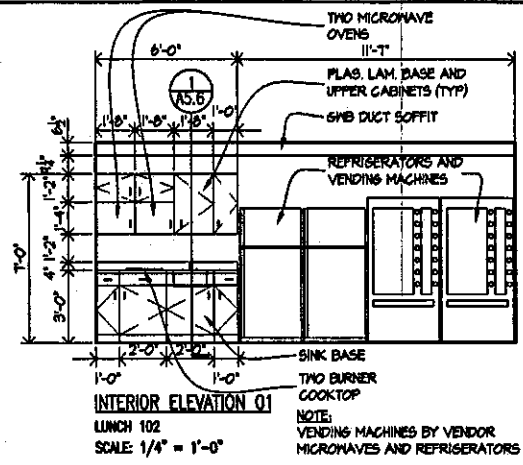

- Toilet Accessories:**
PROVIDE AND INSTALL BLOCKING AS REQUIRED FOR ALL ACCESSORIES
- AC-1 TOILET PAPER HOLDER (BY OWNER)
 - AC-2 FEMINE WIPER DISPENSER (BY OWNER)
 - AC-3 SOAP DISPENSER (BY OWNER)
 - AC-4 PAPER TOWEL DISPENSER (BY OWNER)
 - AC-5 GRAB BARS

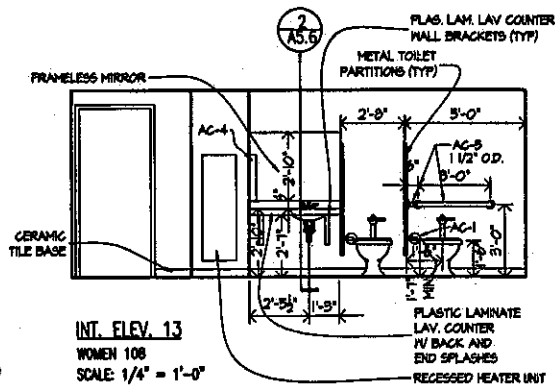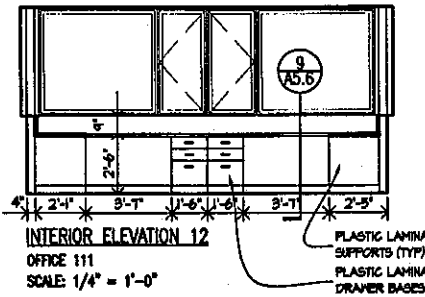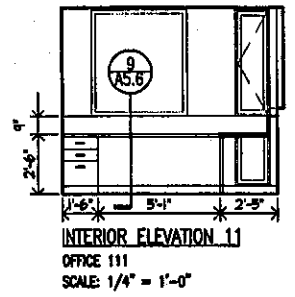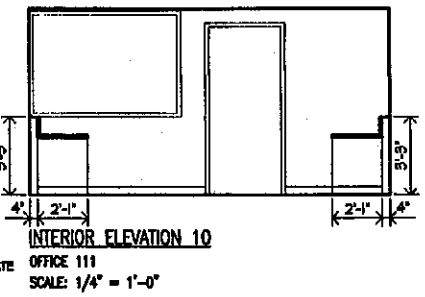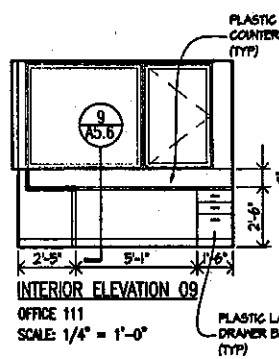

BID SET: 5 AUGUST 1999

No.	Revision	By	Date	In Charge Of

Maine Turnpike Authority
Maine Turnpike


**Building Renovation
And Expansion**

INTERIOR ELEVATIONS

HNTB
ARCHITECTS ENGINEERS PLANNERS


Contract: YORK TOLL PLAZA - 99.7
Sheet No. 14 OF 38 **A3.1**

LASSEL ARCHITECTS
84 HIGHLAND AVENUE
SOUTH BERRY, MAINE 03908 207.364.2049

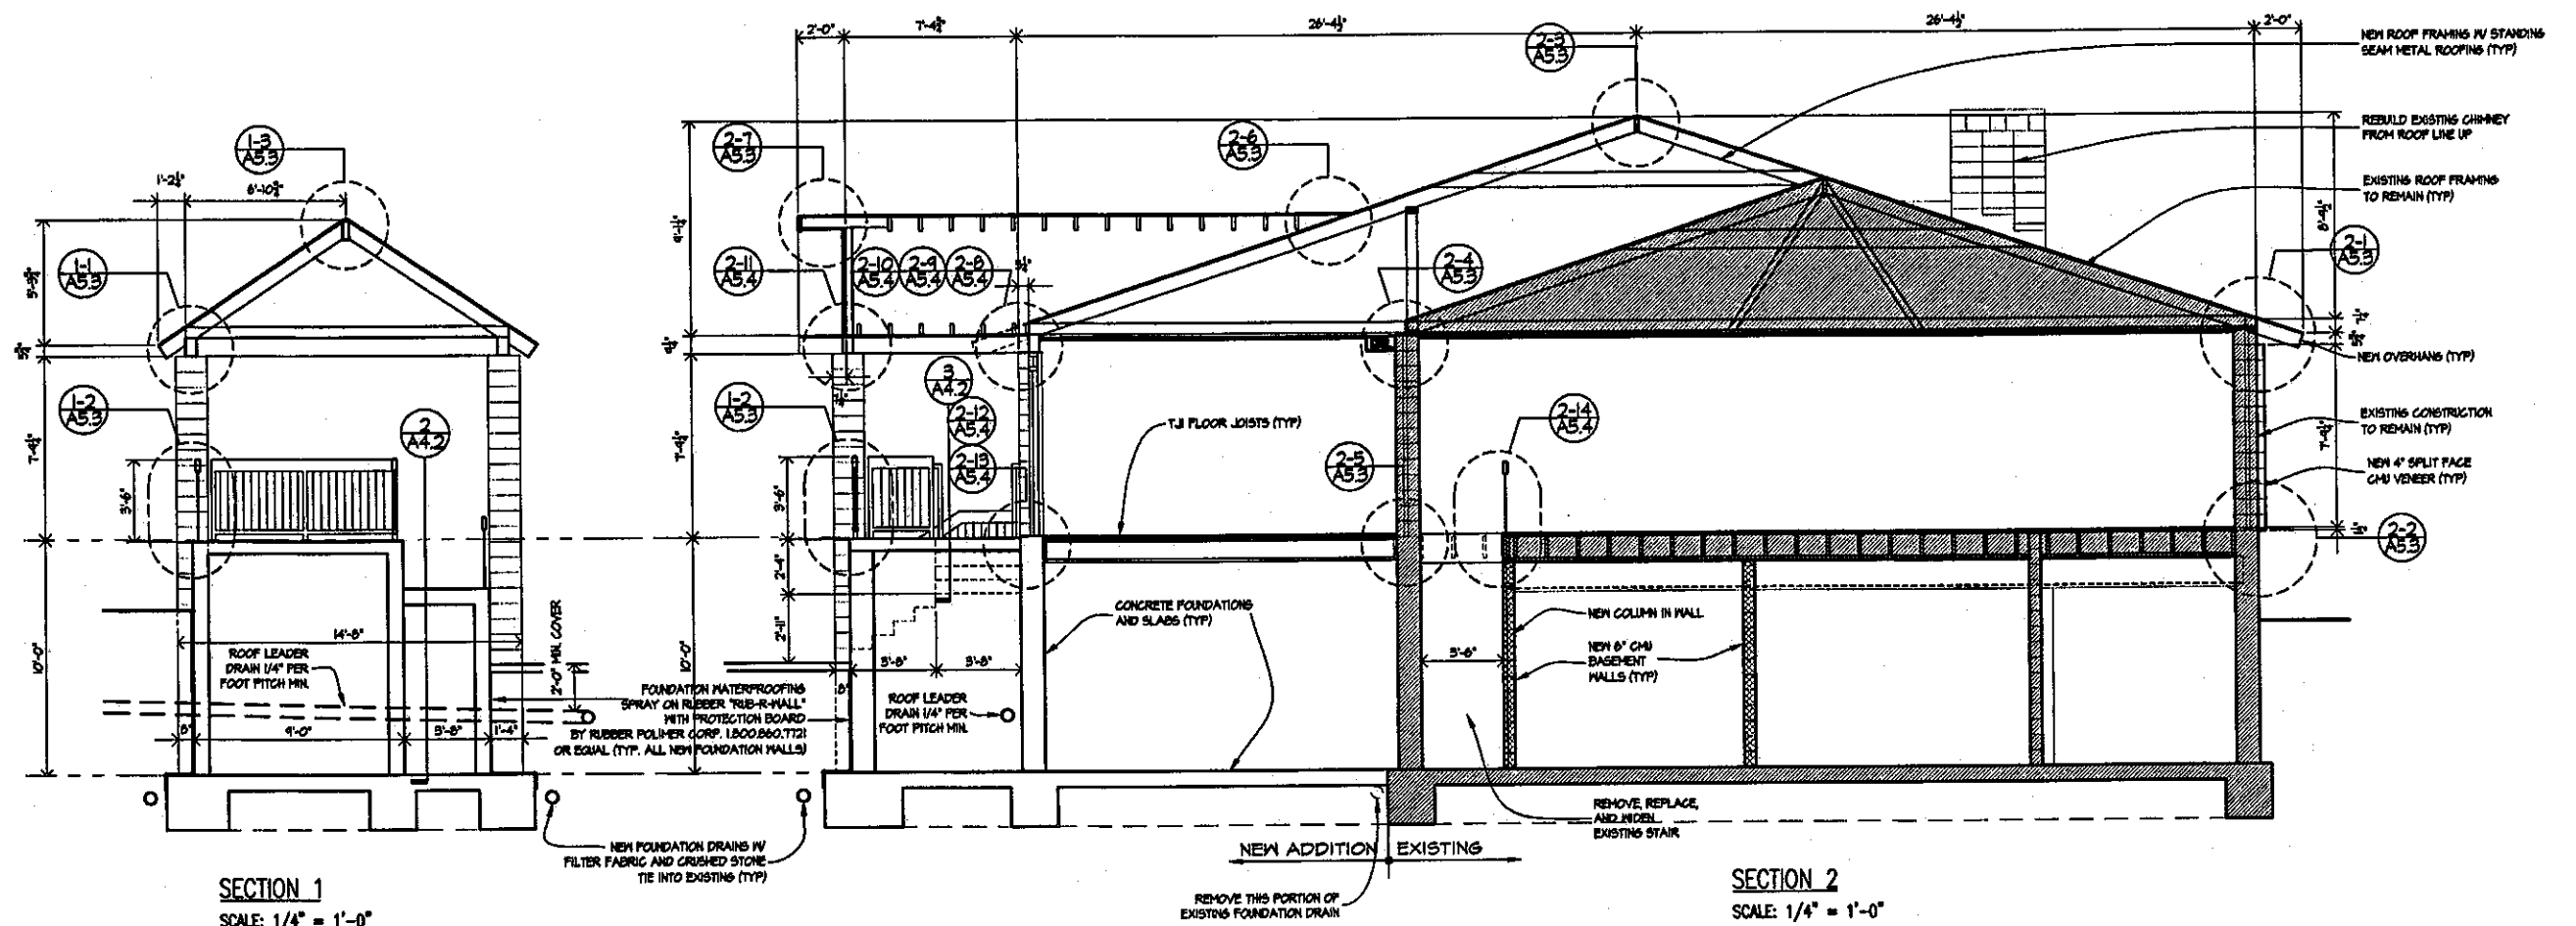


SECTION 1
SCALE: 1/4" = 1'-0"


SECTION 2
SCALE: 1/4" = 1'-0"

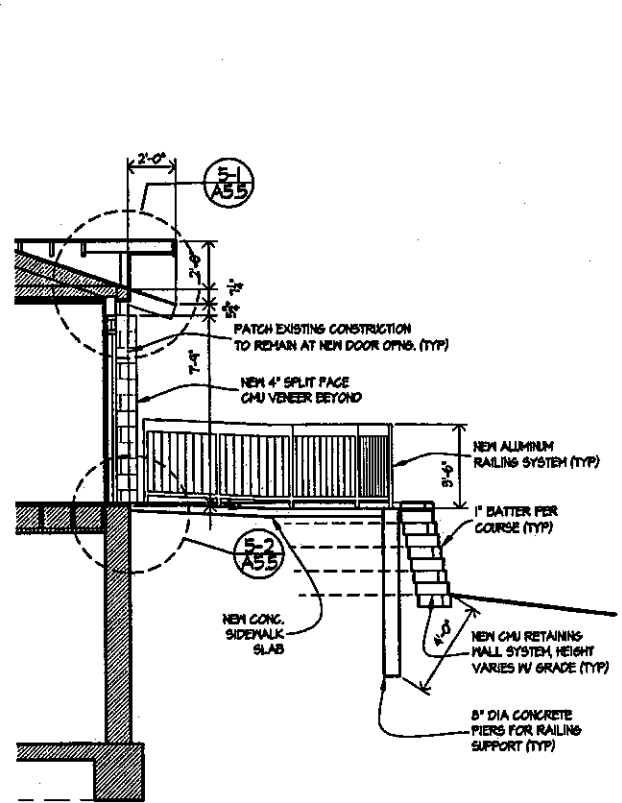

SECTION 5
SCALE: 1/4" = 1'-0"

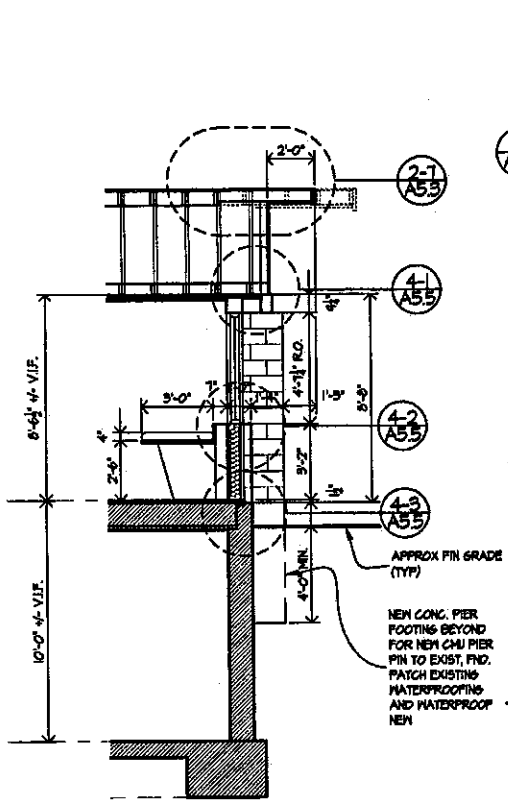

SECTION 4
SCALE: 1/4" = 1'-0"

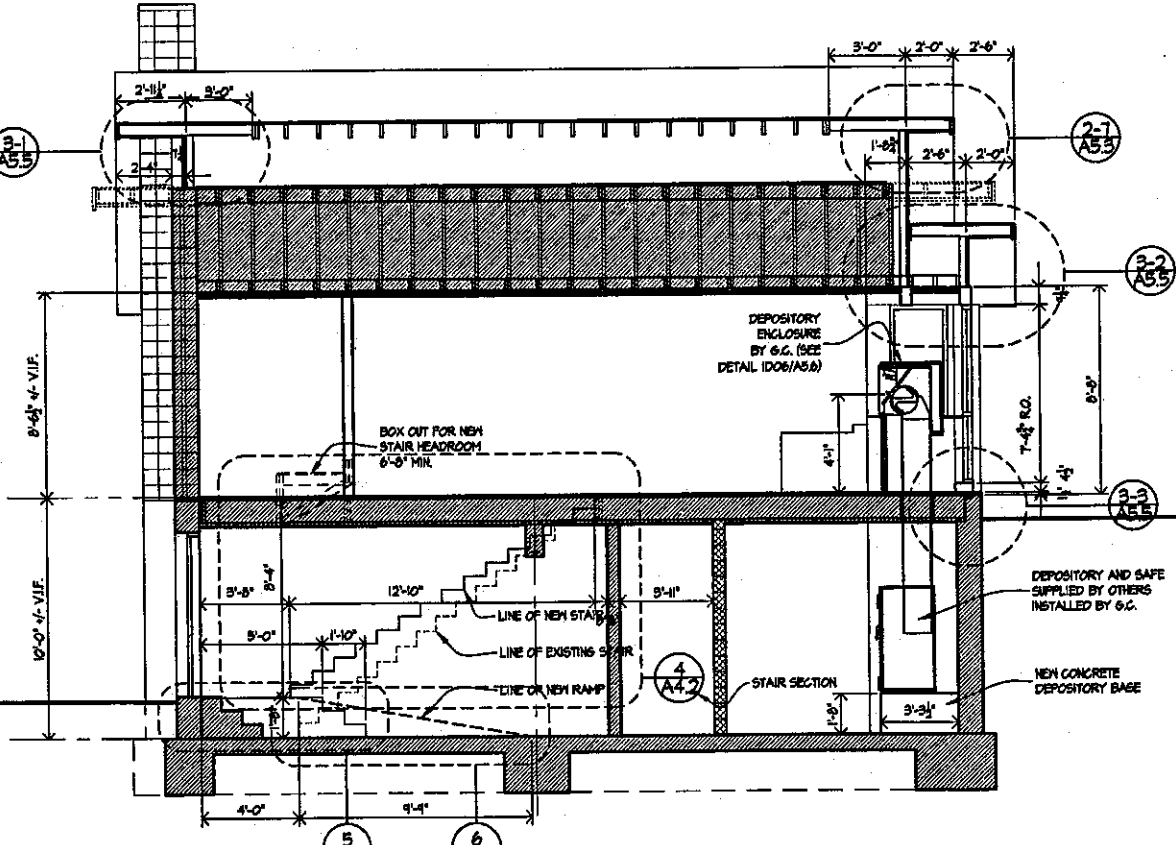

SECTION 3
SCALE: 1/4" = 1'-0"

BID SET: 5 AUGUST 1999

		By	Date	
Designed				
Drawn				
Checked				
No.	Revision	By	Date	In Charge Of


Maine Turnpike Authority
Maine Turnpike

Transpass **Building Renovation And Expansion**
BUILDING SECTIONS


HNTB
ARCHITECTS ENGINEERS PLANNERS

Contract	Sheet No.
YORK TOLL PLAZA - 99.7	15 OF 38 A4.1

LASSEL ARCHITECTS
64 HIGHLAND AVENUE
SOUTH BERWICK, MAINE 03908 207.384.2049

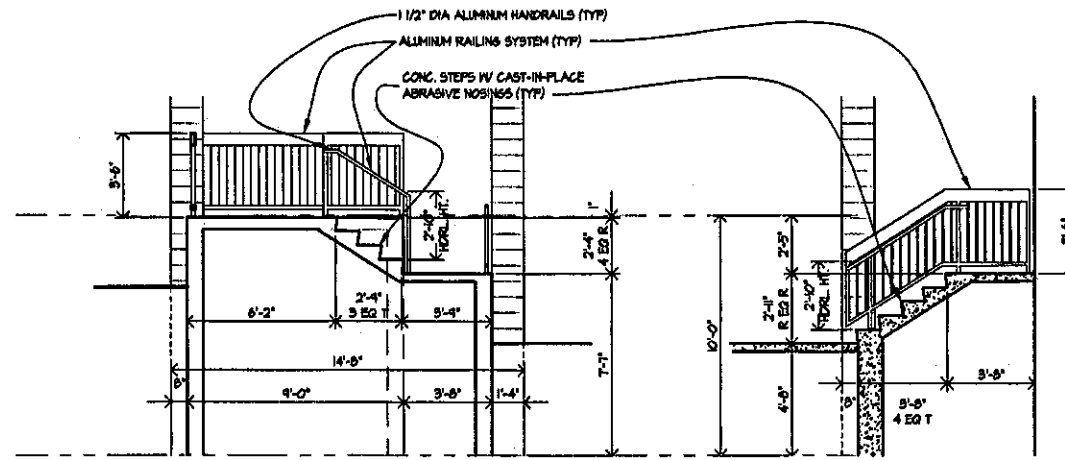


STAIR SECTION 1
UNASSIGNED

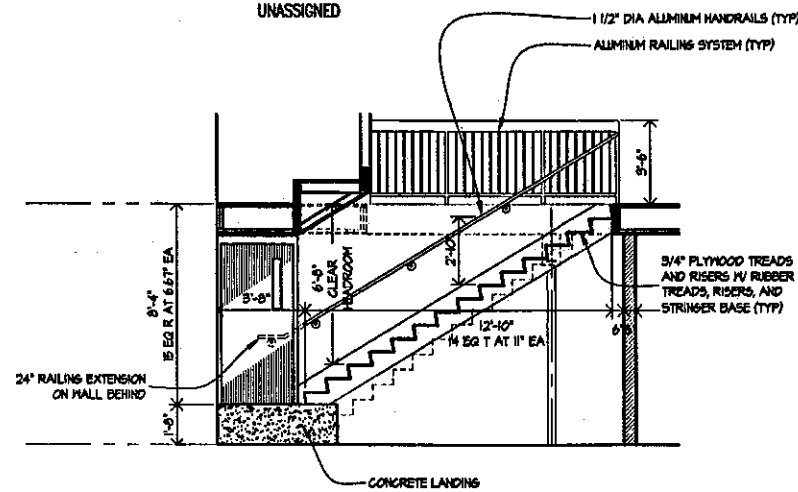


STAIR 1 SECTION 4
SCALE: 1/4" = 1'-0"

ENTRY STAIR SECTION 2
SCALE: 1/4" = 1'-0"

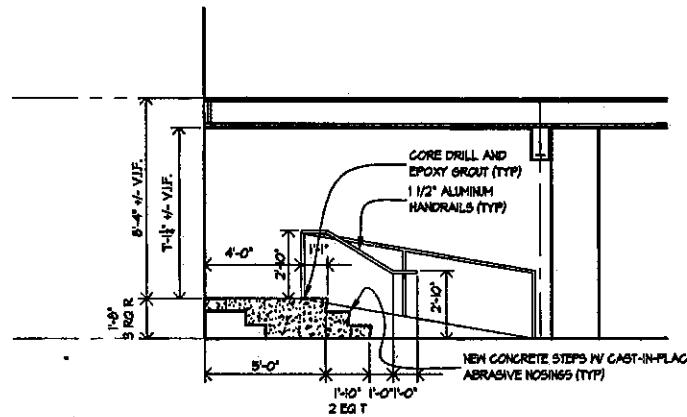

BASEMENT STAIR SECTION 5
SCALE: 1/4" = 1'-0"

ENTRY STAIR SECTION 3
SCALE: 1/4" = 1'-0"

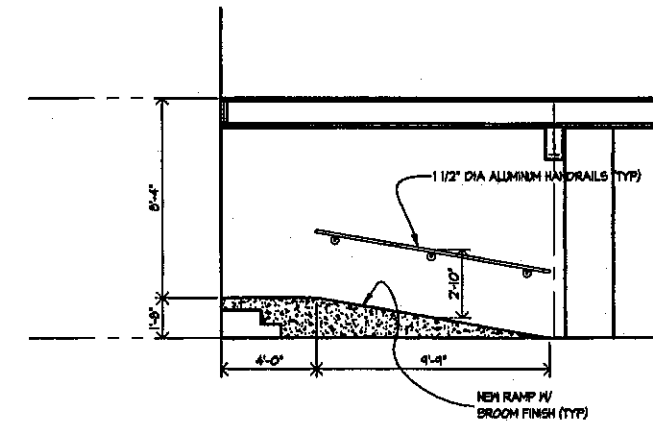

RAMP SECTION 6
SCALE: 1/4" = 1'-0"

BID SET: 6 AUGUST 1999

				By	Date
				Designed	
				Drawn	
				Checked	
No.	Revision	By	Date	In Charge Of	

Maine Turnpike Authority
Maine Turnpike



**Building Renovation
 And Expansion**









STAIR SECTIONS



ARCHITECTS ENGINEERS PLANNERS

LASSEL ARCHITECTS
 64 HIGHLAND AVENUE
 SOUTH BERWICK, MAINE 03908 207.384.2048

Contract	Sheet No.
YORK TOLL PLAZA - 09.7	16 OF 38 A4.2

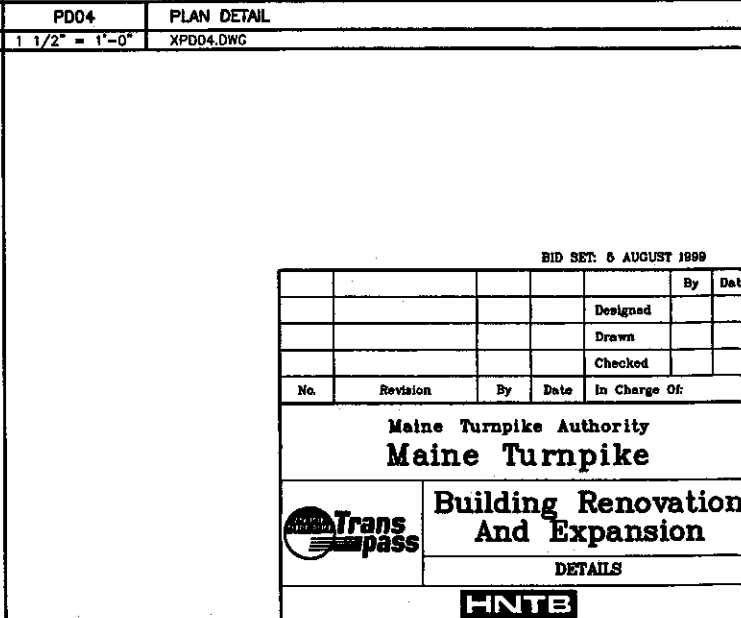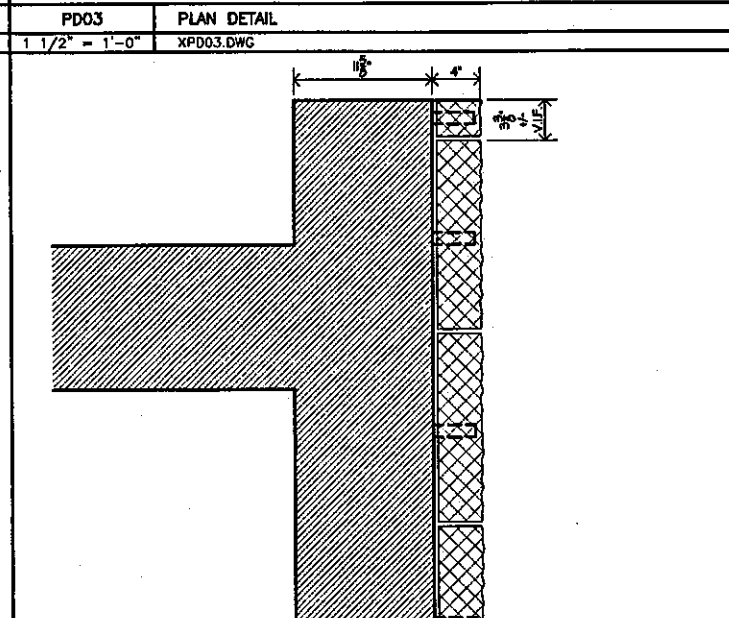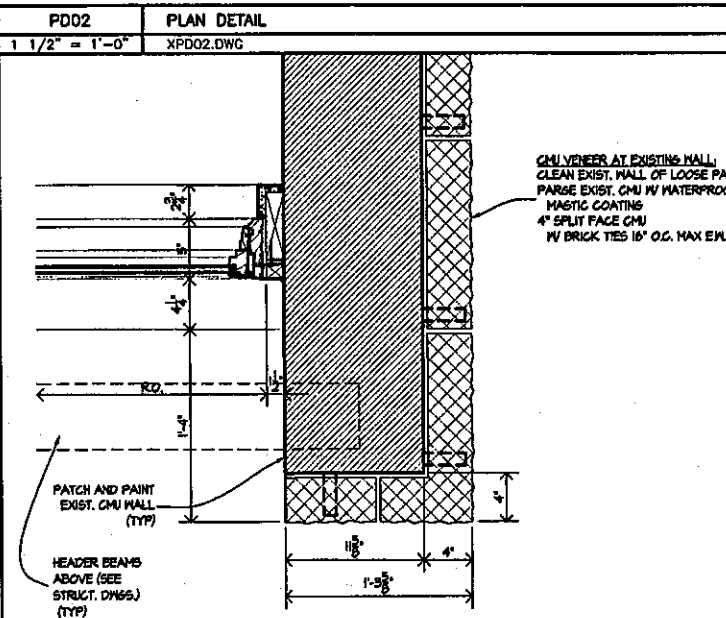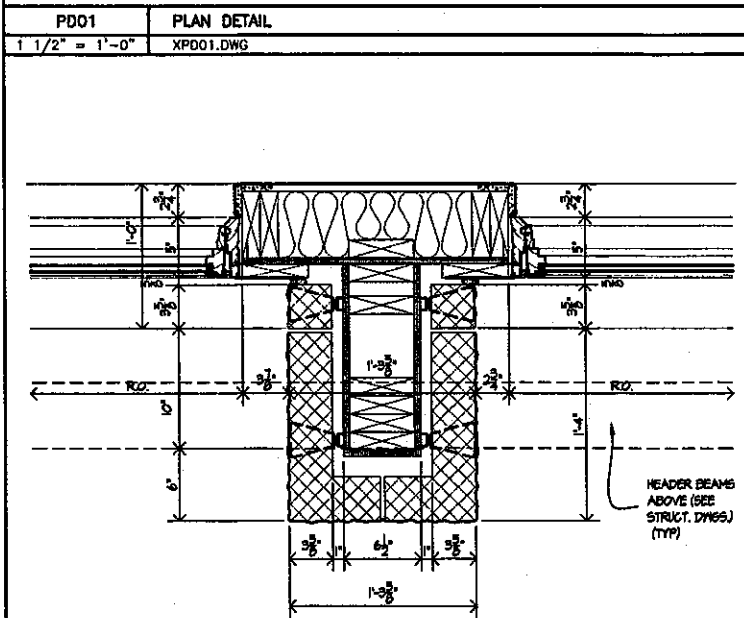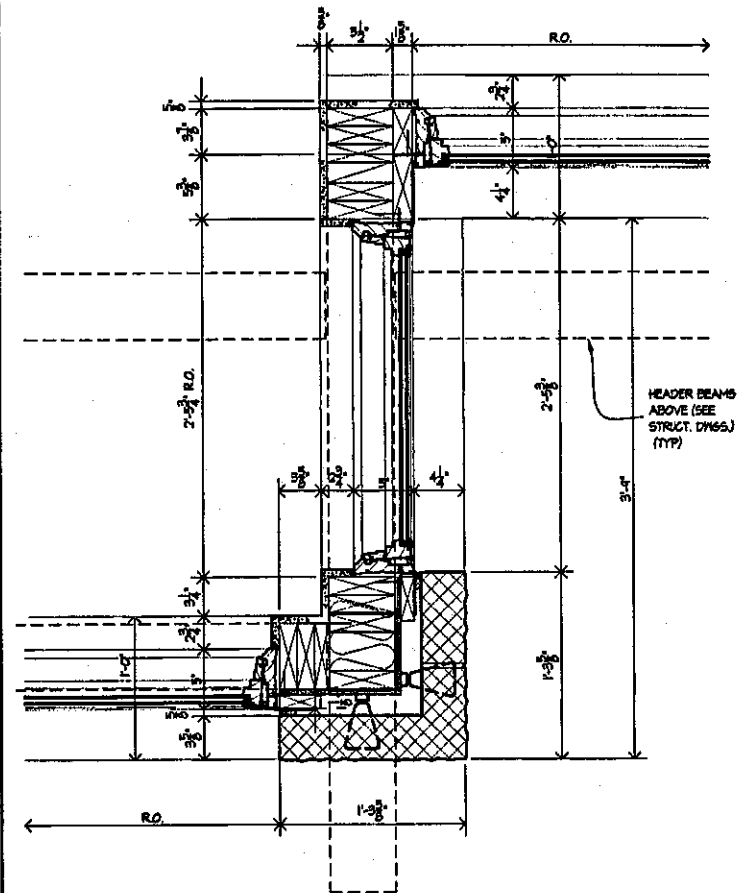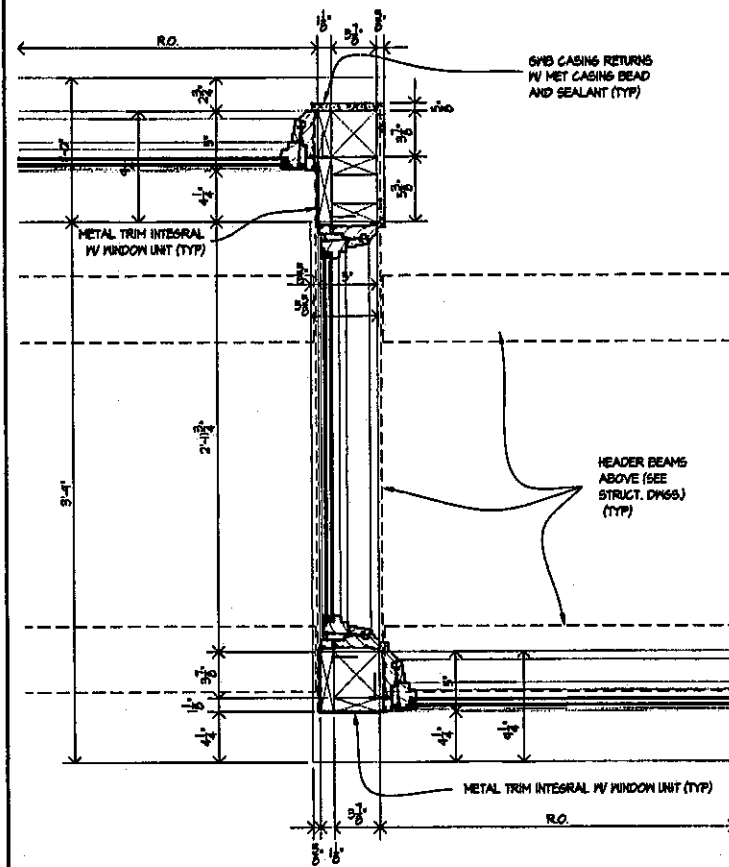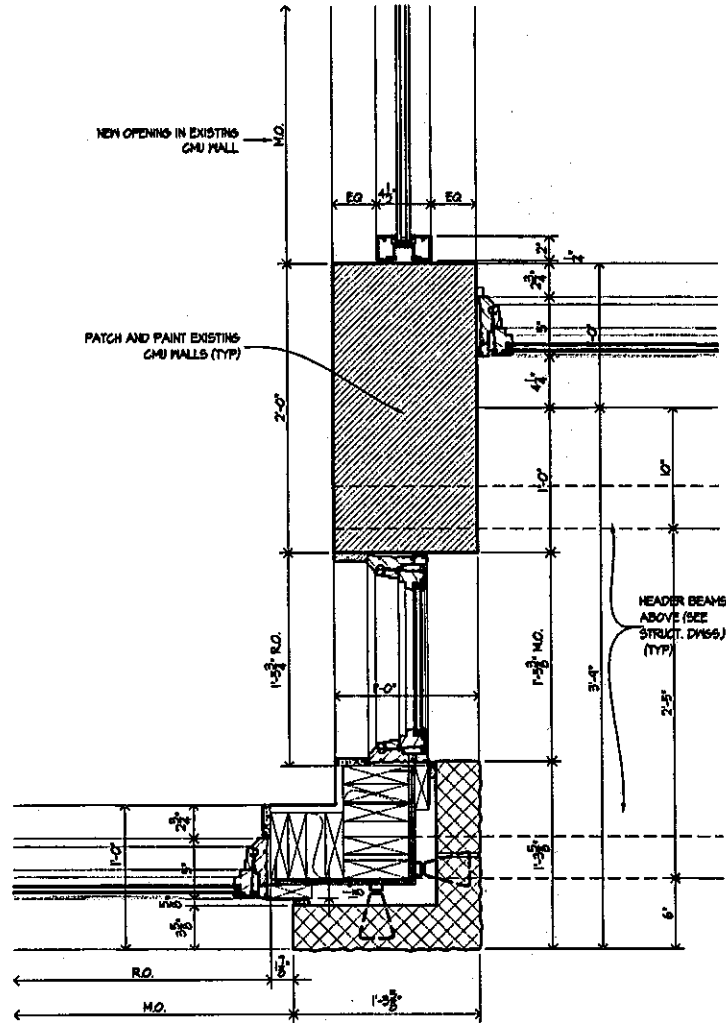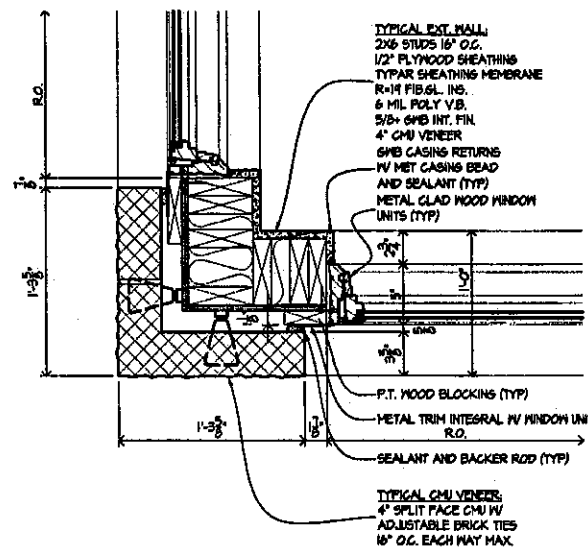

PDD1 PLAN DETAIL
1 1/2" = 1'-0" XPD01.DWG

PDD2 PLAN DETAIL
1 1/2" = 1'-0" XPD02.DWG

PDD3 PLAN DETAIL
1 1/2" = 1'-0" XPD03.DWG

PDD4 PLAN DETAIL
1 1/2" = 1'-0" XPD04.DWG

PDD5 PLAN DETAIL
1 1/2" = 1'-0" XPD05.DWG

PDD6 PLAN DETAIL
1 1/2" = 1'-0" XPD06.DWG

PDD7 PLAN DETAIL
1 1/2" = 1'-0" XPD07.DWG

PDD8 PLAN DETAIL
1 1/2" = 1'-0" XPD08.DWG

BID SET: 5 AUGUST 1999

Designed	By	Date
Drawn		
Checked		

No.	Revision	By	Date	In Charge Of
-----	----------	----	------	--------------

Maine Turnpike Authority
Maine Turnpike


**Building Renovation
And Expansion**

DETAILS
HNTE
ARCHITECTS ENGINEERS PLANNERS


LASSEL ARCHITECTS
84 HIGHLAND AVENUE
SOUTH BERRICK, MAINE 03906 207.384.2048

Contract
YORK TOLL PLAZA - 99.7


Sheet No.
17 OF 38 **A5.1**

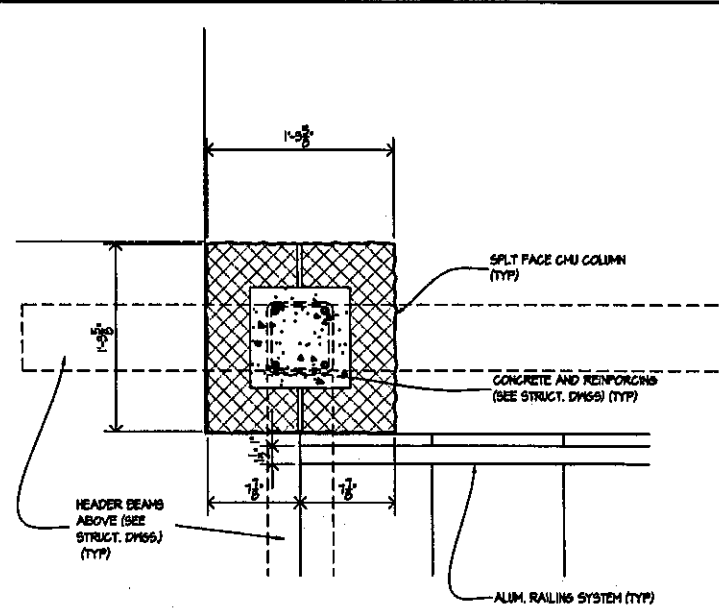


PD11 PLAN DETAIL
1 1/2" = 1'-0" XPD11.DWG

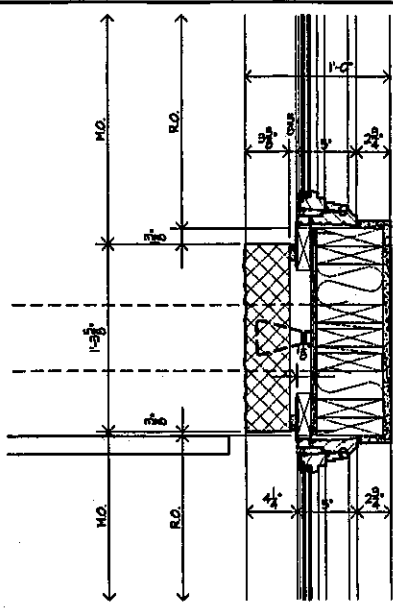


PD10 PLAN DETAIL
1 1/2" = 1'-0" XPD10.DWG

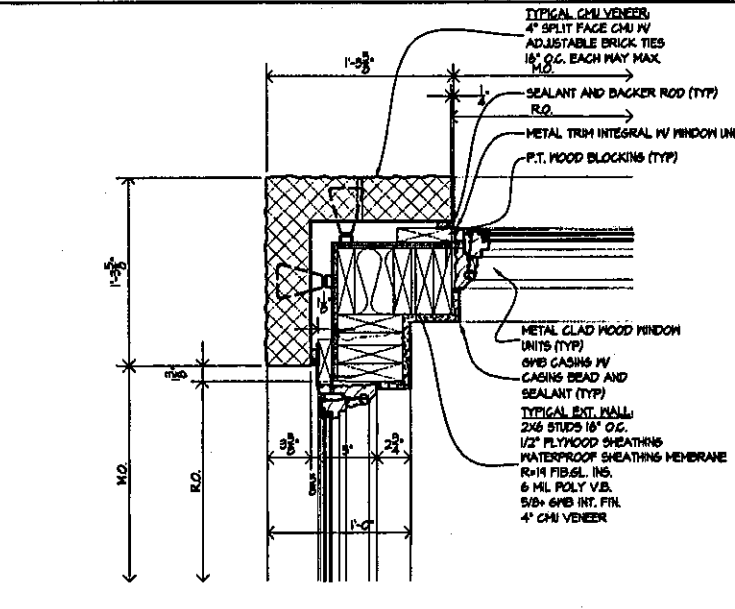


PD09 PLAN DETAIL
1 1/2" = 1'-0" XPD09.DWG

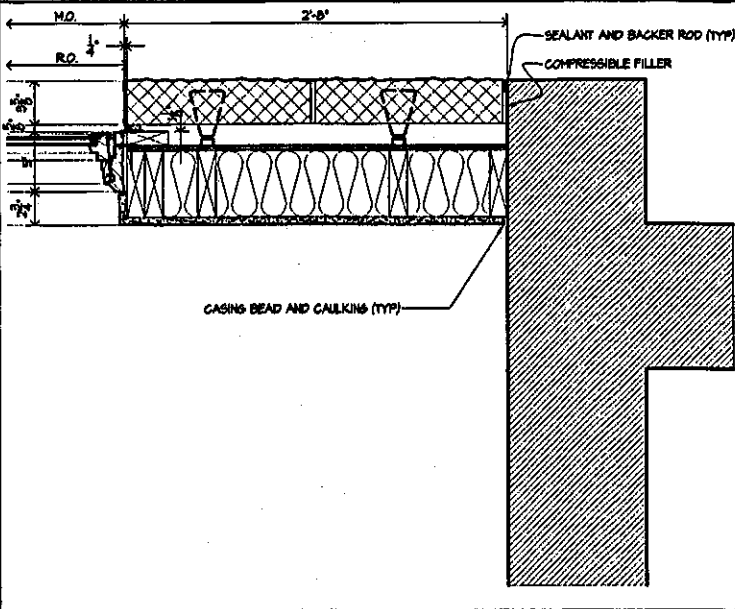


PD08 PLAN DETAIL
1 1/2" = 1'-0" XPD08.DWG

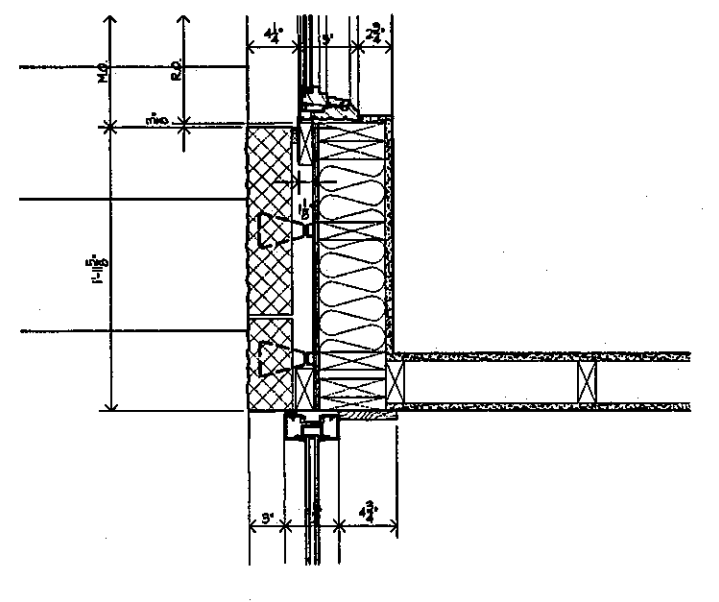

PD12 PLAN DETAIL
1 1/2" = 1'-0" XPD12.DWG

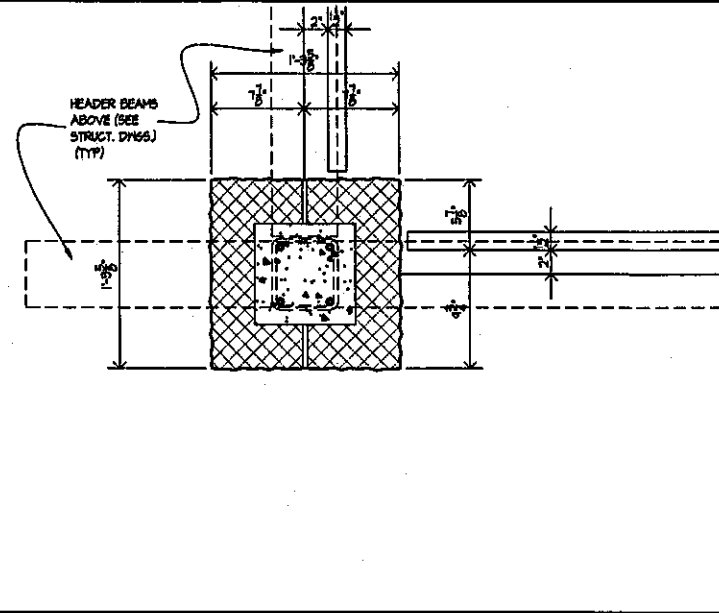

PD14 PLAN DETAIL
1 1/2" = 1'-0" XPD14.DWG

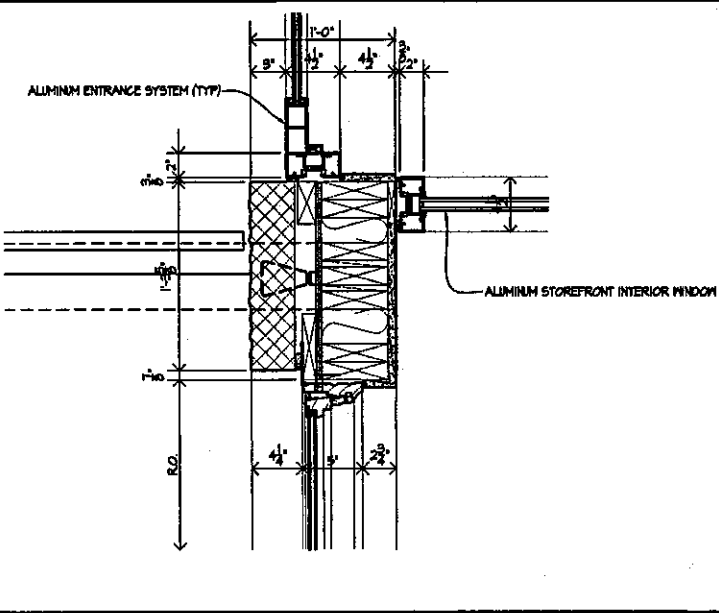


PD13 PLAN DETAIL
1 1/2" = 1'-0" XPD13.DWG


BID SET: 5 AUGUST 1999

No.	Revision	By	Date	In Charge Of
				Designed
				Drawn
				Checked


Maine Turnpike Authority
Maine Turnpike
Building Renovation And Expansion
DETAILS
HNTB
ARCHITECTS ENGINEERS PLANNERS
LASSEL ARCHITECTS
84 HIGHLAND AVENUE SOUTH BERRICK, MAINE 03908 207.384.2049
 Contract YORK TOLL PLAZA - 99.7
 Sheet No. 18 OF 38 **A5.2**

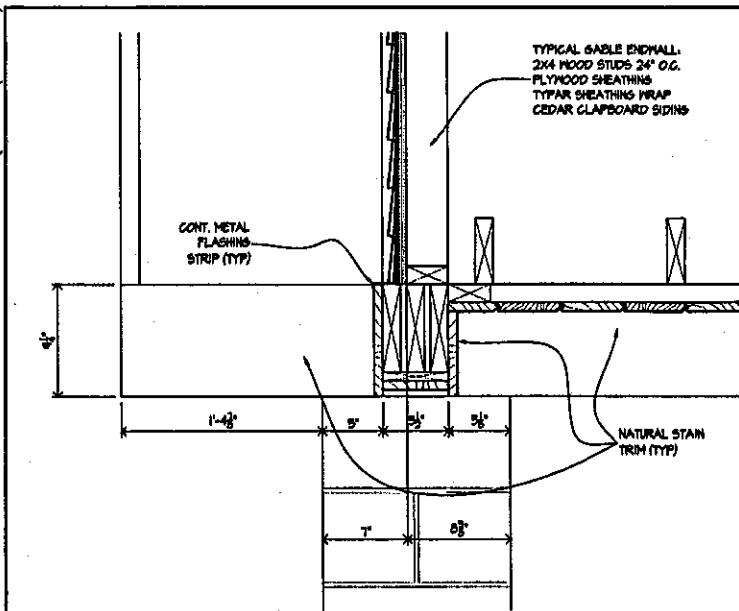


2-11 SECTION DETAIL
1 1/2" = 1'-0" XSD2-11.DWG

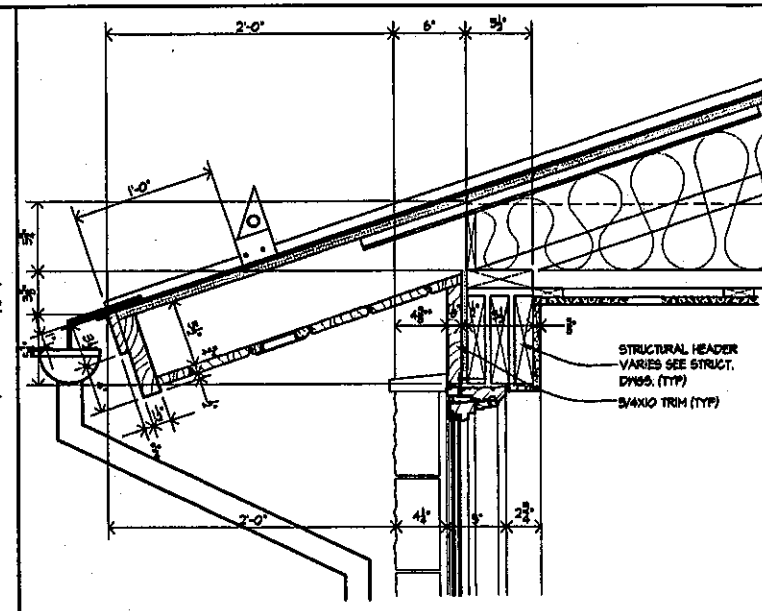

2-10 SECTION DETAIL
1 1/2" = 1'-0" XSD2-10.DWG

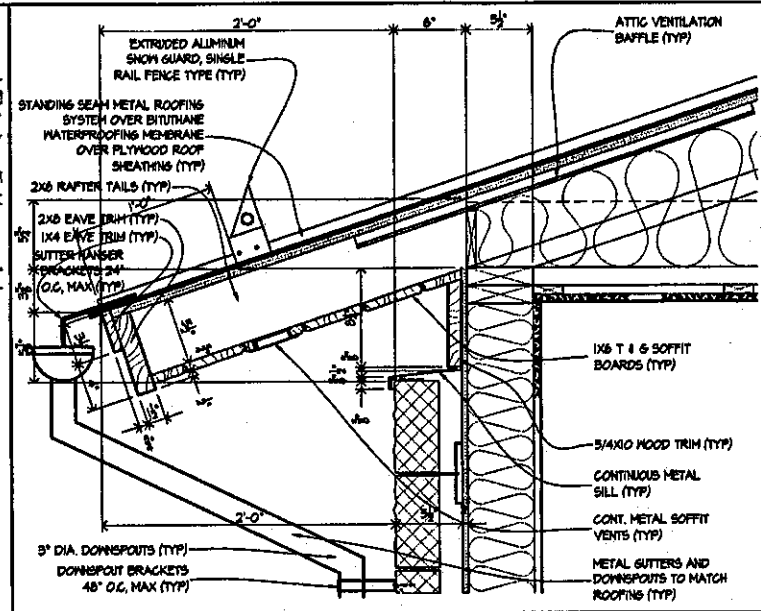


2-9 SECTION DETAIL
1 1/2" = 1'-0" XSD2-9.DWG

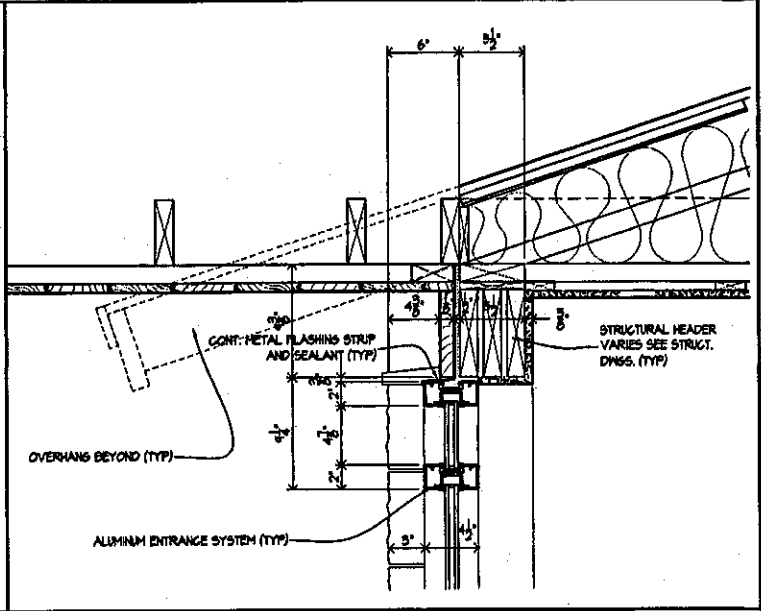


2-8 SECTION DETAIL
1 1/2" = 1'-0" XSD2-8.DWG




2-13 SECTION DETAIL
1 1/2" = 1'-0" XSD2-13.DWG

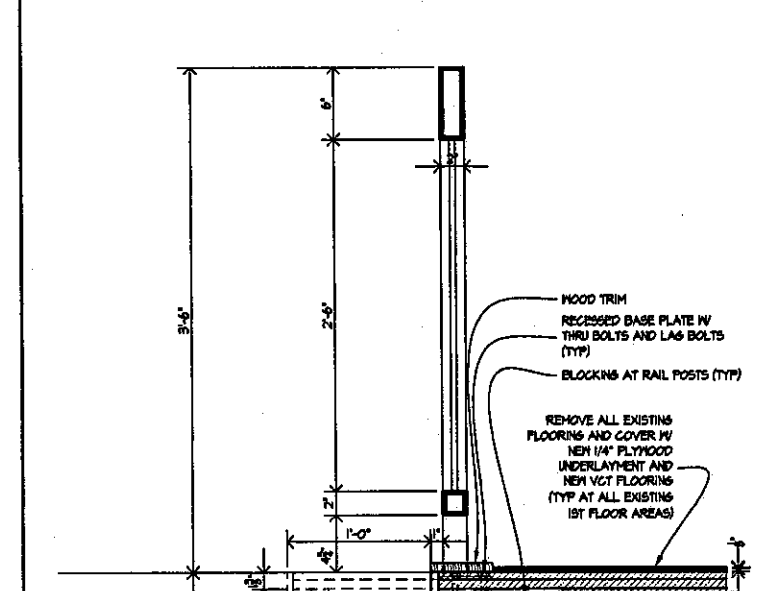

2-12 SECTION DETAIL
1 1/2" = 1'-0" XSD2-12.DWG

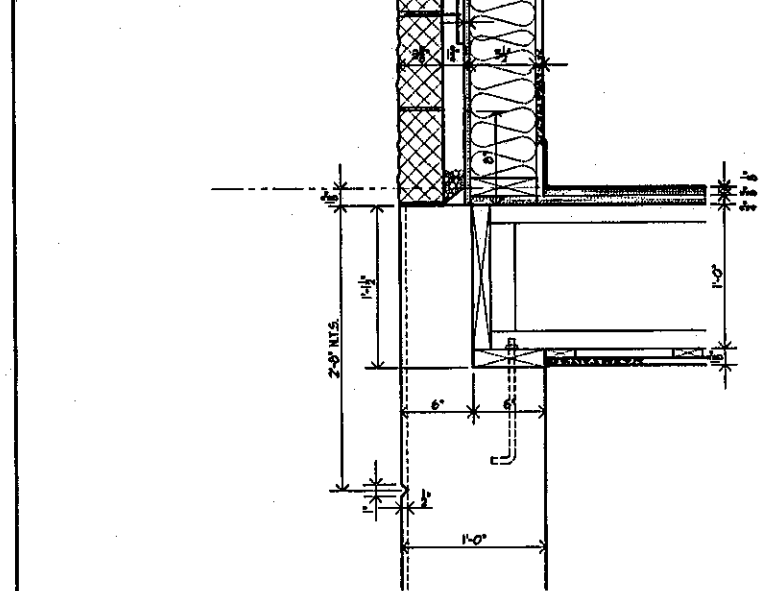

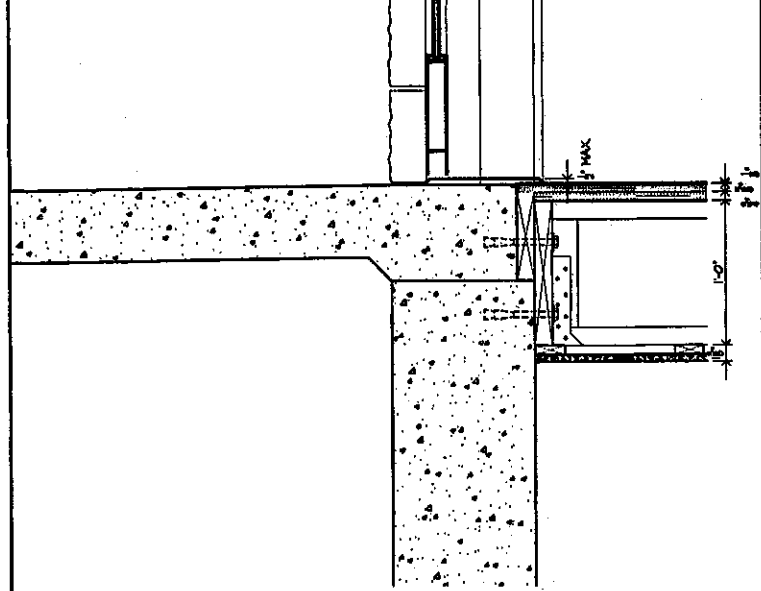

2-14 SECTION DETAIL
1 1/2" = 1'-0" XSD2-14.DWG



2-13 SECTION DETAIL
1 1/2" = 1'-0" XSD2-13.DWG

BID SET: 5 AUGUST 1999


			By	Date
			Designed	
			Drawn	
			Checked	
No.	Revision	By	Date	In Charge Of:

Maine Turnpike Authority
Maine Turnpike

Building Renovation
And Expansion
 DETAILS

 ARCHITECTS ENGINEERS PLANNERS


LASSEL ARCHITECTS
 64 HIGHLAND AVENUE
 SOUTH BERWICK, MAINE 03906 207.384.2049

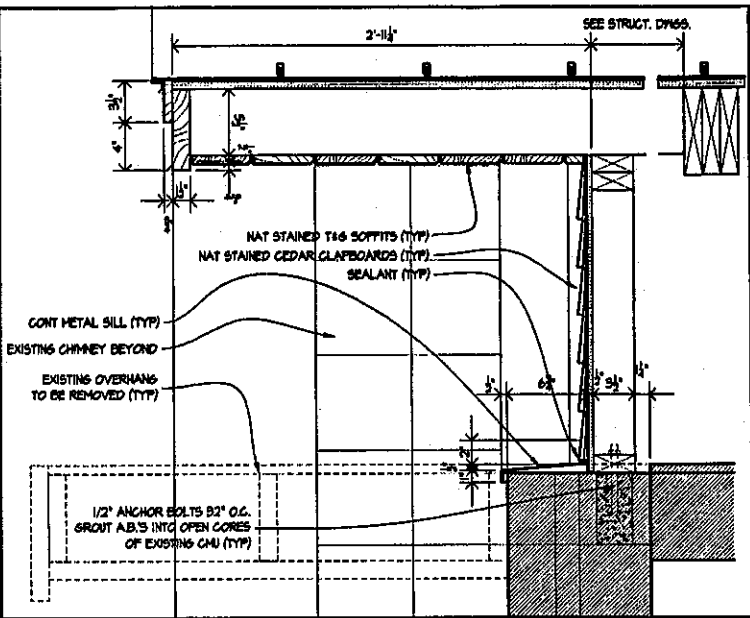Contract	Sheet No.
YORK TOLL PLAZA - 99.7	20 OF 38 A5.4


(METPK\BDR-01)




3-1 SECTION DETAIL
1 1/2" = 1'-0" XSD3-1.DWG

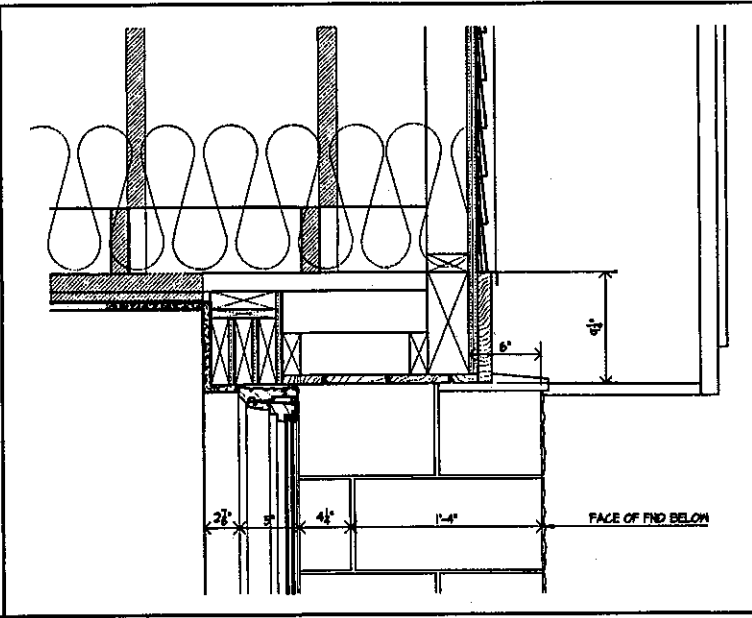


4-1 SECTION DETAIL
1 1/2" = 1'-0" XSD4-1.DWG

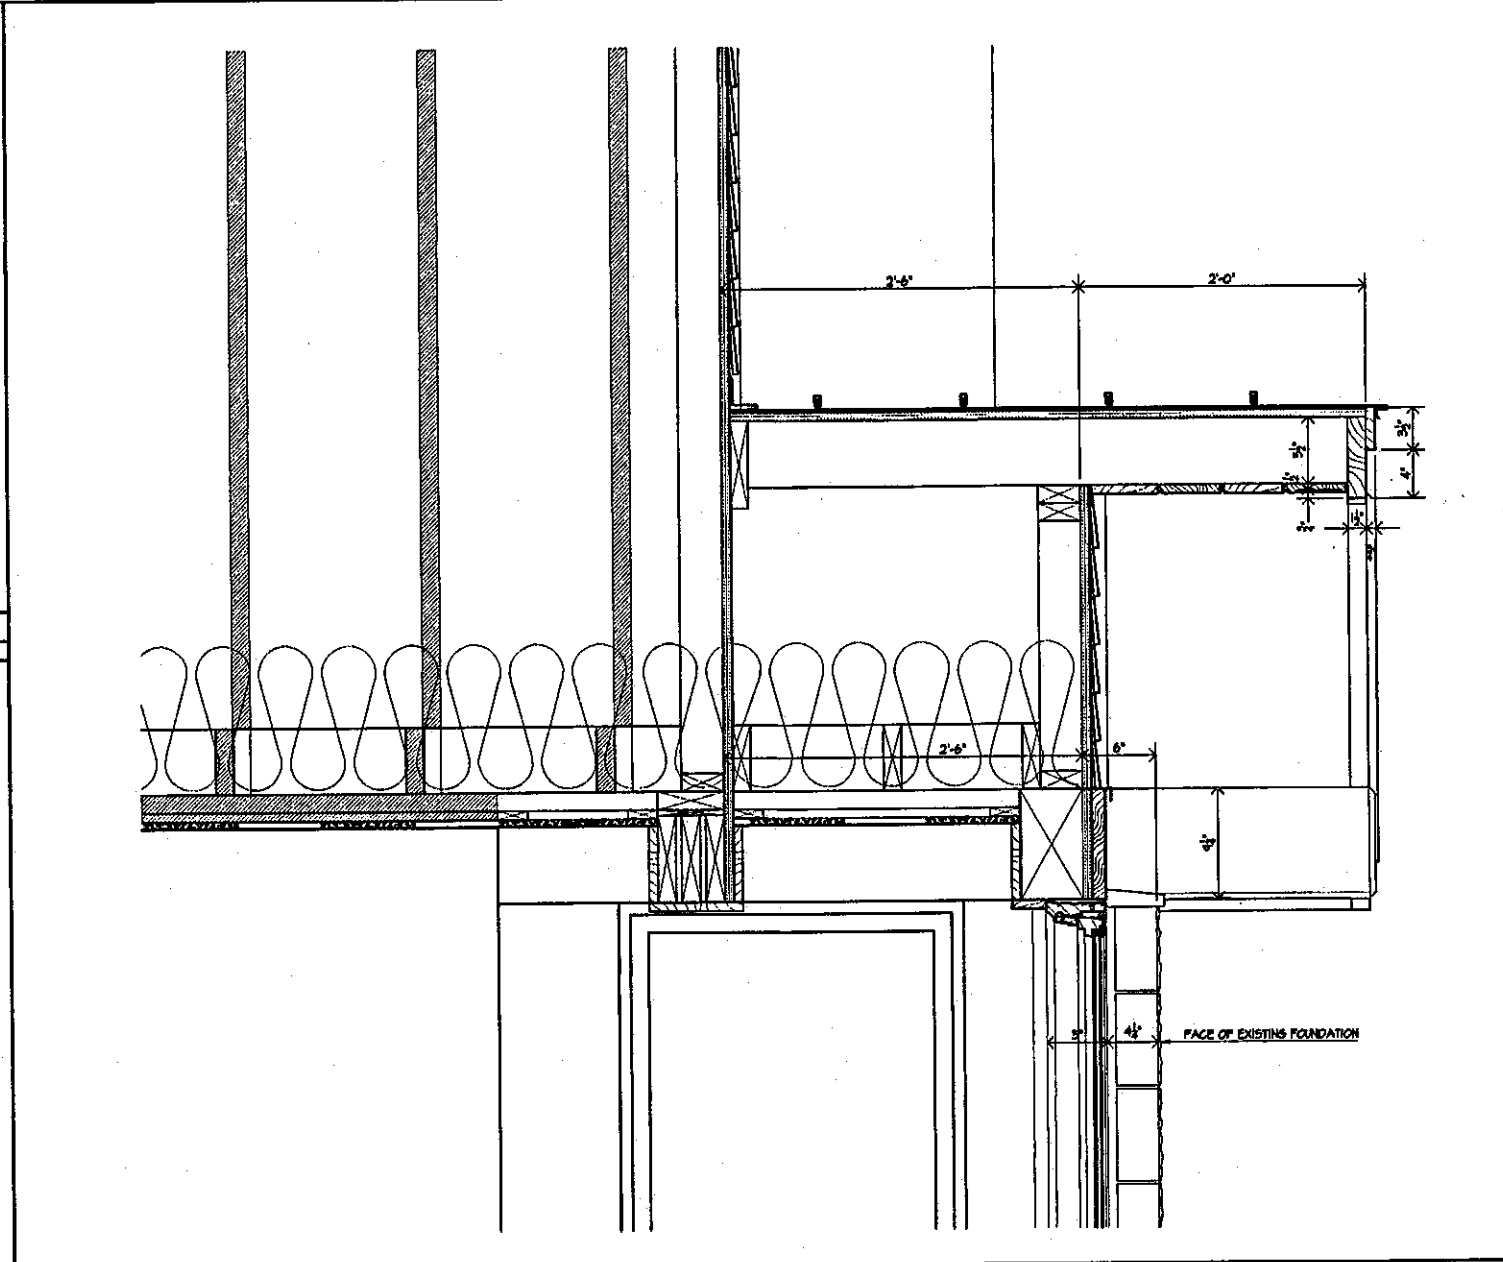


3-2 SECTION DETAIL
1 1/2" = 1'-0" XSD3-2.DWG

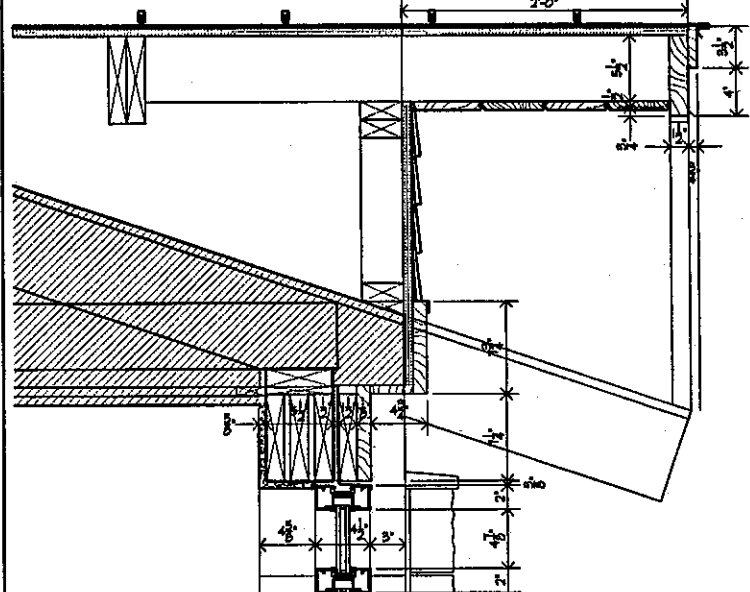


5-1 SECTION DETAIL
1 1/2" = 1'-0" XSD5-1.DWG

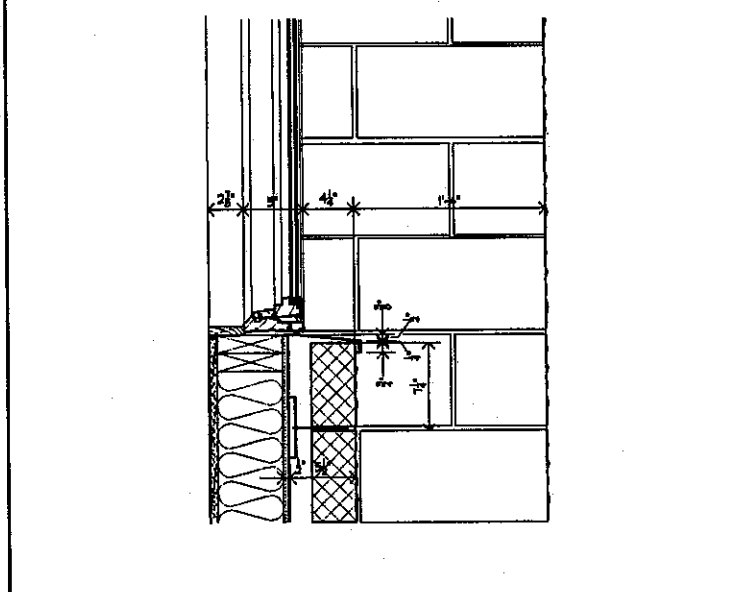


4-2 SECTION DETAIL
1 1/2" = 1'-0" XSD4-2.DWG

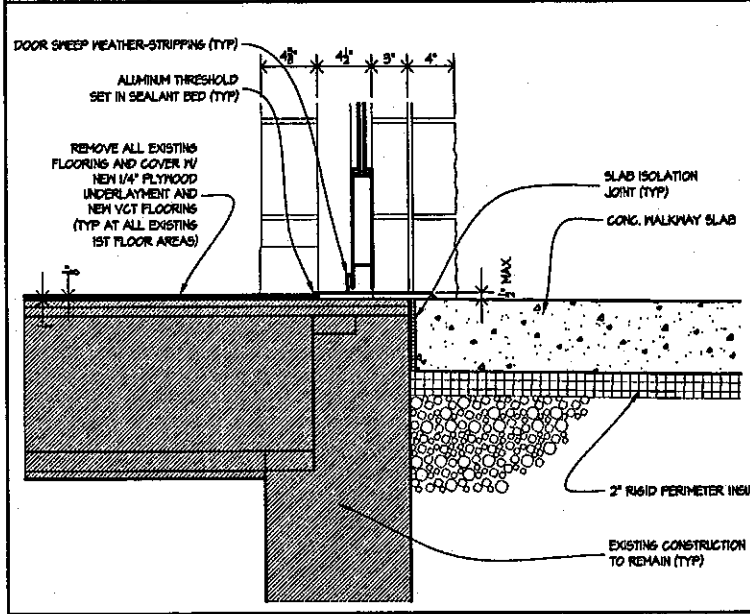

5-2 SECTION DETAIL
1 1/2" = 1'-0" XSD5-2.DWG

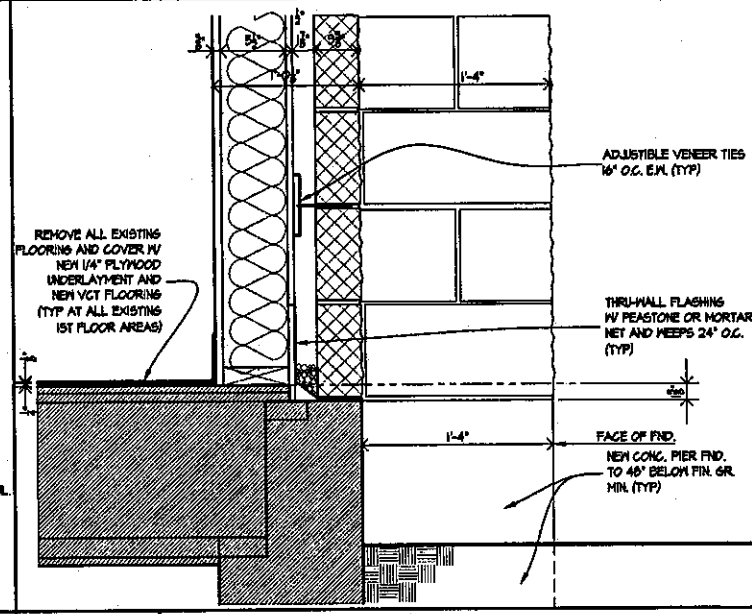

4-3 SECTION DETAIL
1 1/2" = 1'-0" XSD4-3.DWG

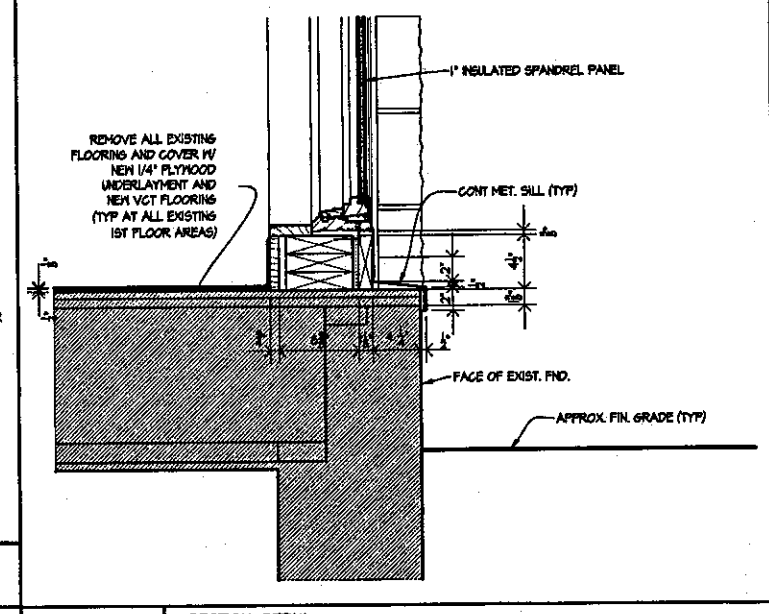

3-3 SECTION DETAIL
1 1/2" = 1'-0" XSD3-3.DWG

BID SET: 5 AUGUST 1999

Designed	By	Date		
Drawn				
Checked				
No.	Revision	By	Date	In Charge Of

Maine Turnpike Authority
Maine Turnpike

Building Renovation And Expansion


DETAILS

HNTE
ARCHITECTS ENGINEERS PLANNERS


LASSEL ARCHITECTS
24 HIGHLAND AVENUE
SOUTH BERRICK, MAINE 03908 207.384.2049

Contract YORK TOLL PLAZA - 99.7
Sheet No. 21 OF 38 **A5.5**


(METPK BDR-01)

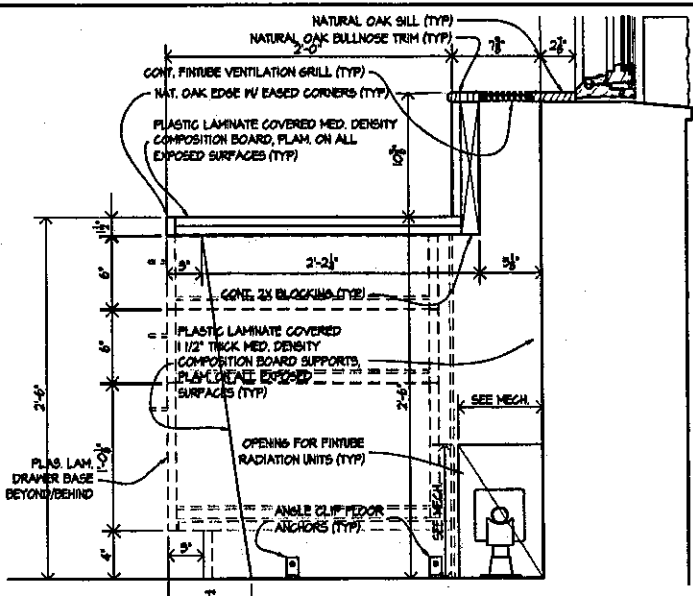



ID09 INTERIOR DETAIL
1 1/2" = 1'-0" XID09.DWG

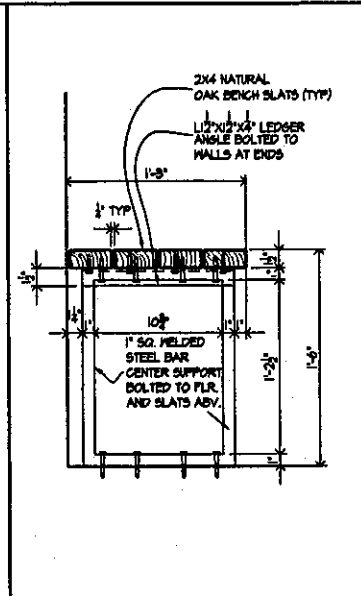


ID04 INTERIOR DETAIL
1 1/2" = 1'-0" XID04.DWG

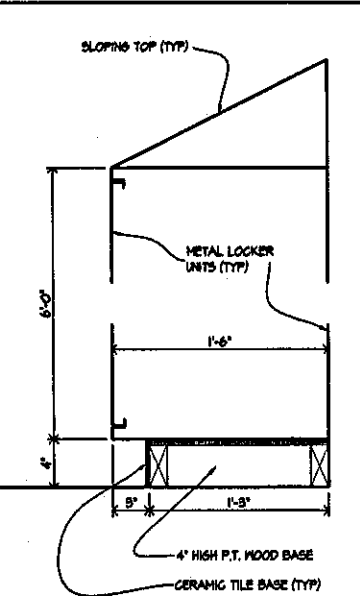


ID03 INTERIOR DETAIL
1 1/2" = 1'-0" XID03.DWG

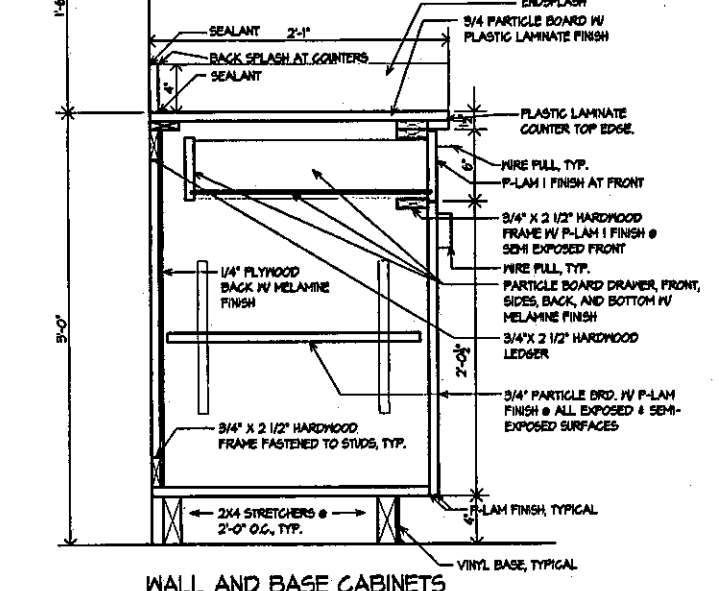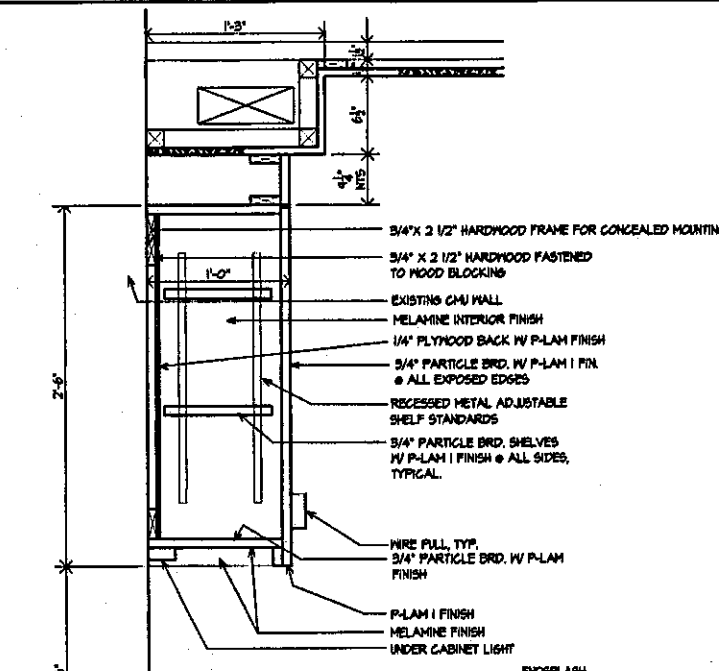



ID01 INTERIOR DETAIL
1 1/2" = 1'-0" XID01.DWG

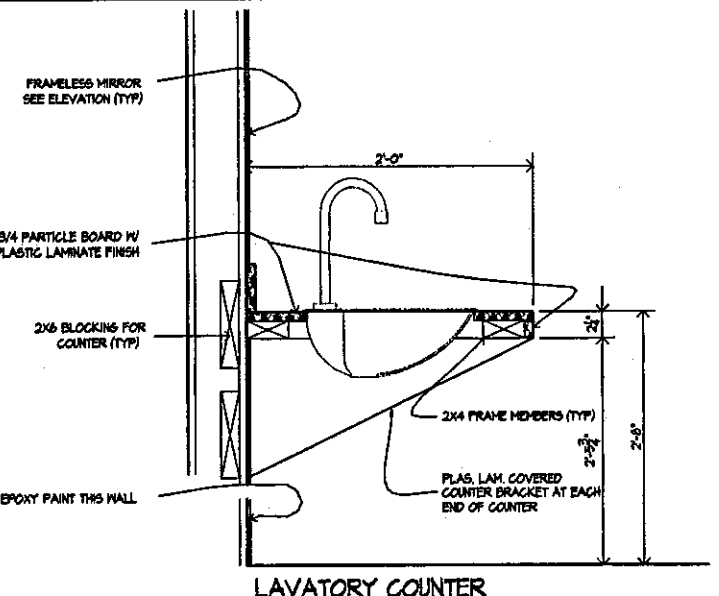



ID02 INTERIOR DETAIL
1 1/2" = 1'-0" XID02.DWG

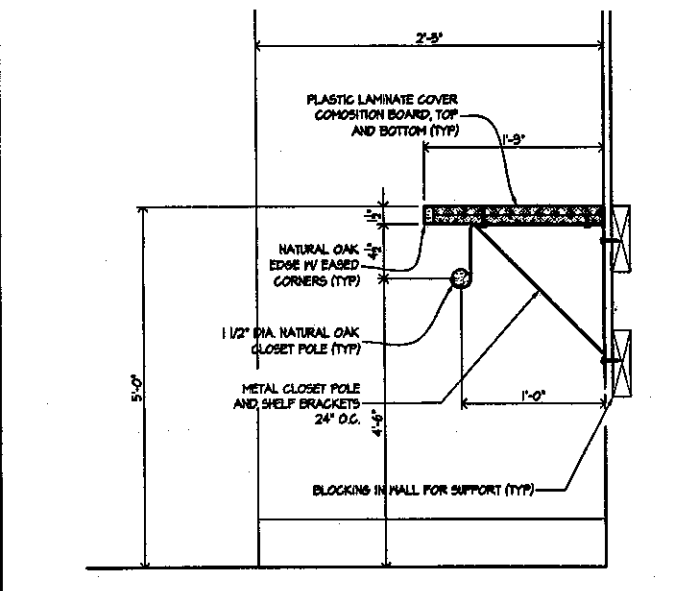



ID08 INTERIOR DETAIL
1 1/2" = 1'-0" XID08.DWG

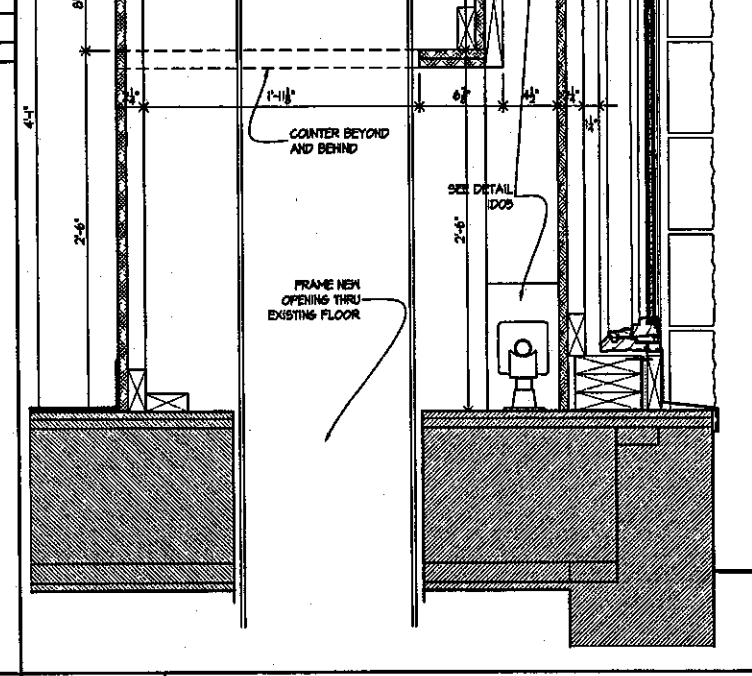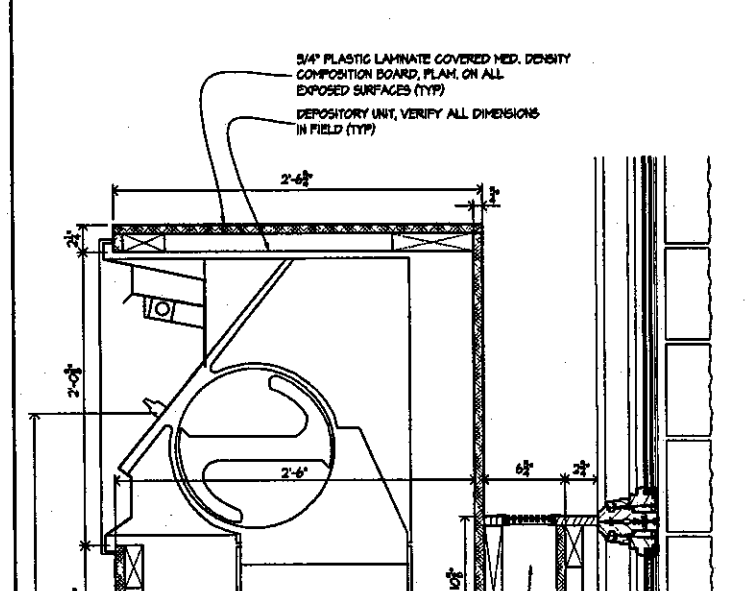

ID06 INTERIOR DETAIL
1 1/2" = 1'-0" XID06.DWG

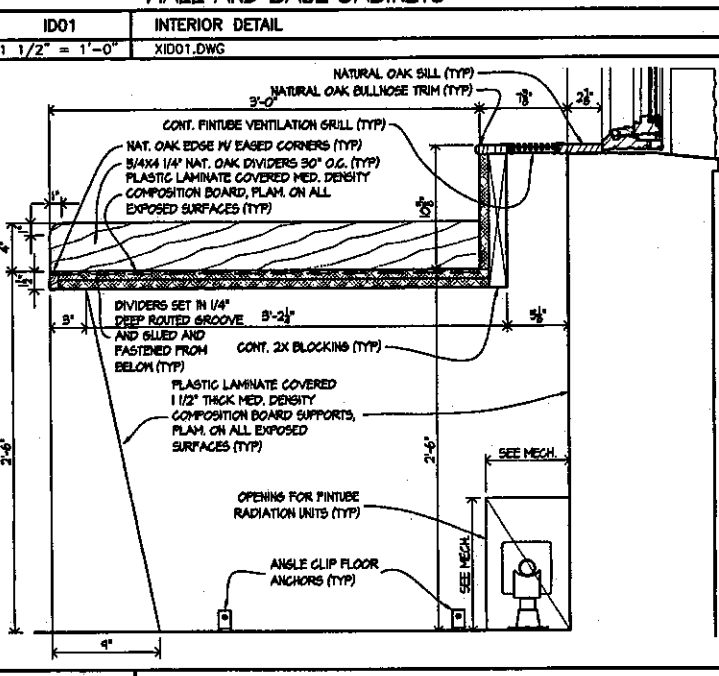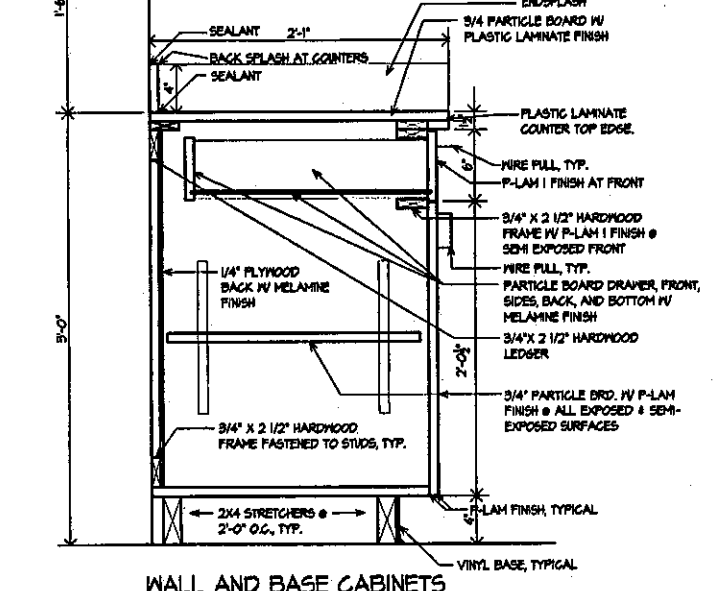

ID05 INTERIOR DETAIL
1 1/2" = 1'-0" XID05.DWG

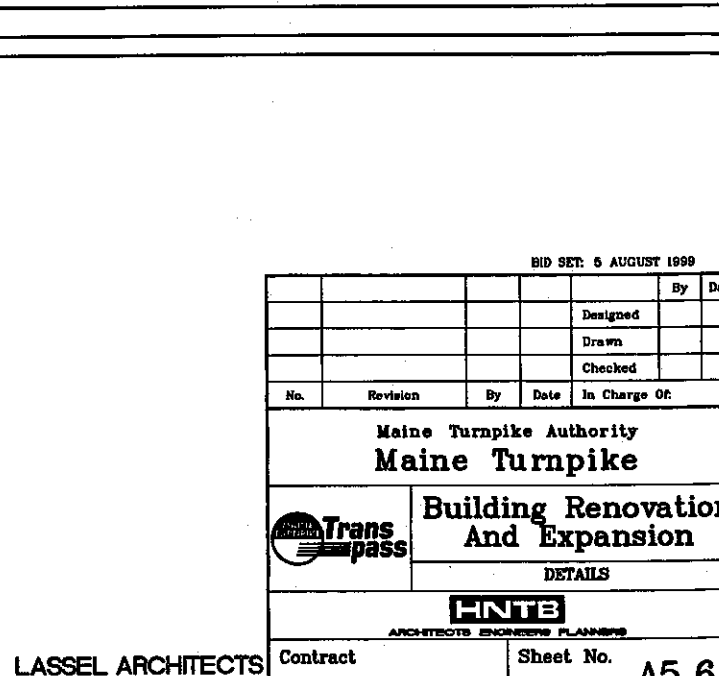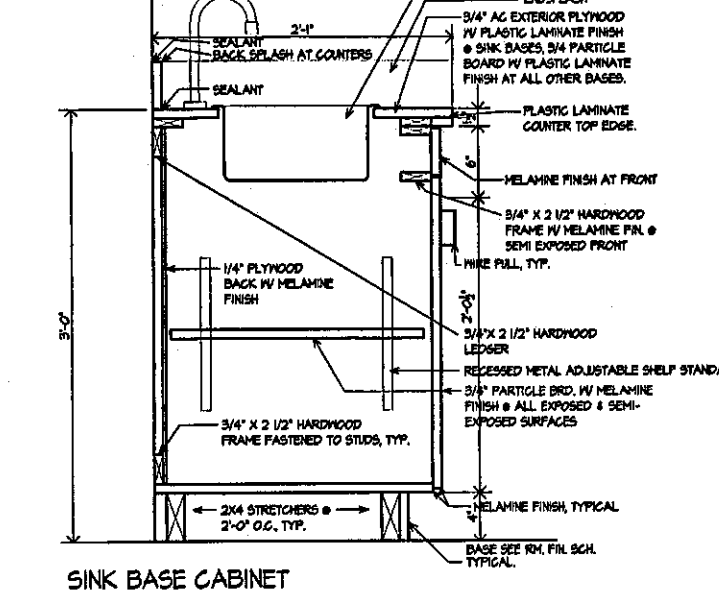

ID07 INTERIOR DETAIL
1 1/2" = 1'-0" XID07.DWG

BID SET: 5 AUGUST 1999

No.	Revision	By	Date	In Charge Of


Designed _____
 Drawn _____
 Checked _____

Maine Turnpike Authority
Maine Turnpike
 Building Renovation
 And Expansion
 DETAILS

HNTB
 ARCHITECTS ENGINEERS PLANNERS



Contract YORK TOLL PLAZA - 99.7
 Sheet No. 22 OF 38 **A5.6**

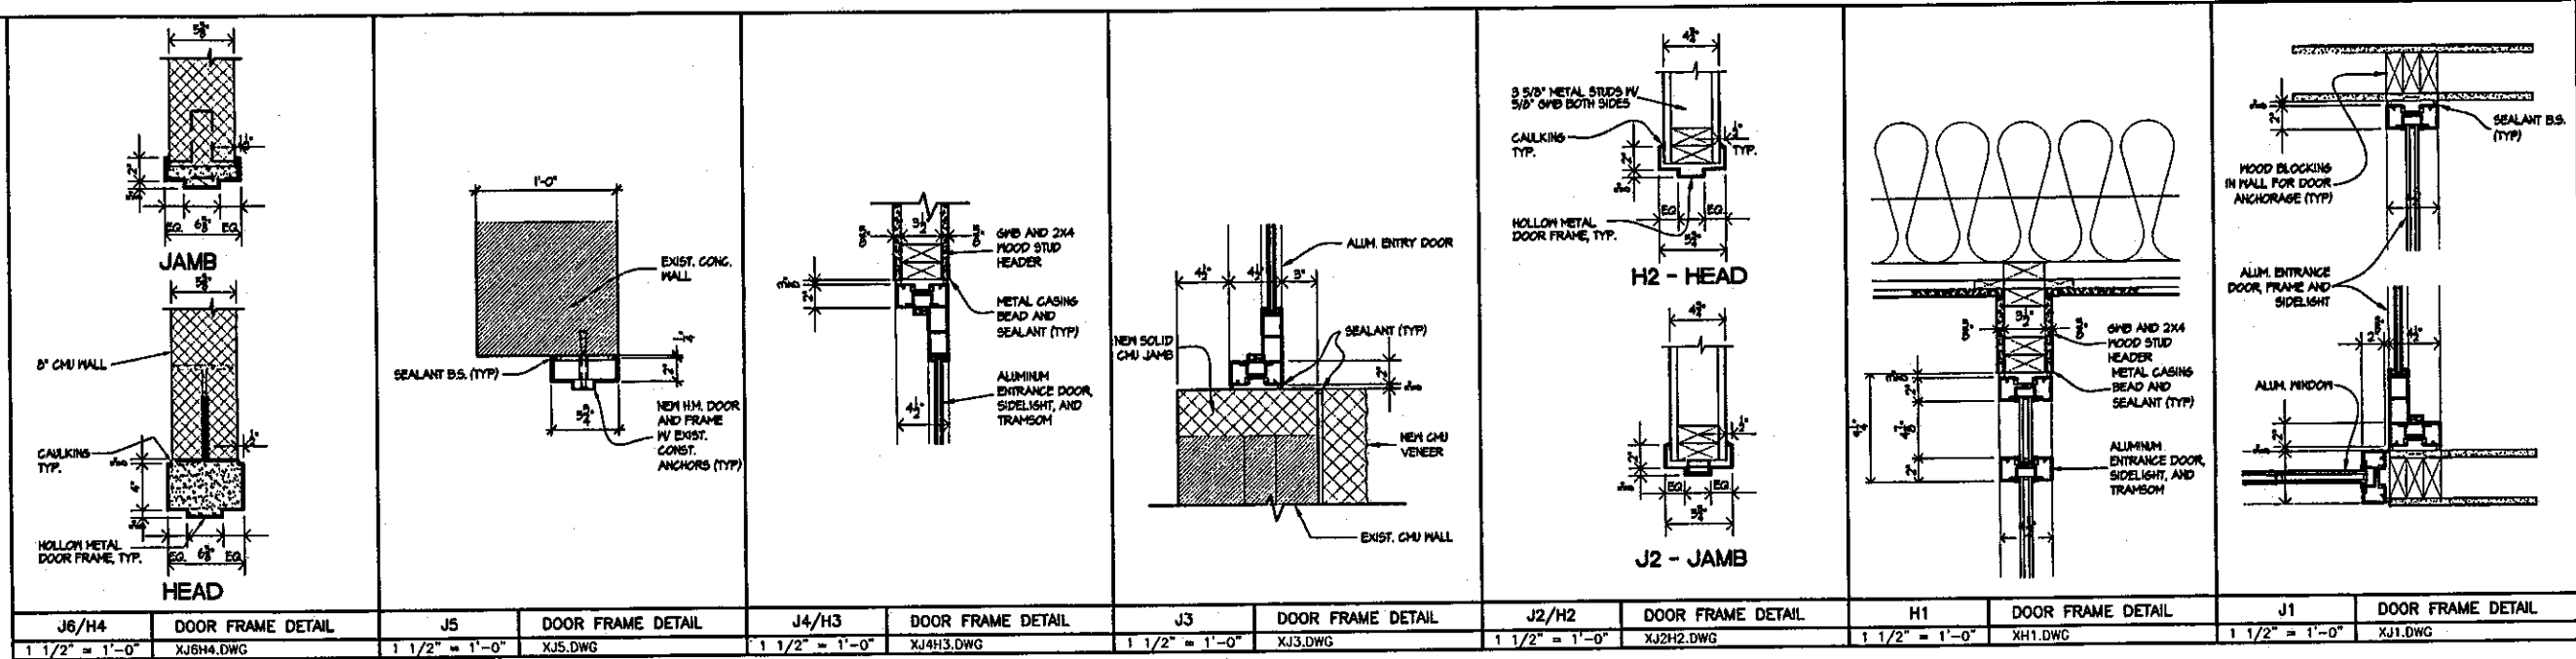LASSEL ARCHITECTS
 84 IRONLAND AVENUE
 SOUTH BERWICK, MAINE 03906 207.384.2049



J6/H4	DOOR FRAME DETAIL	J5	DOOR FRAME DETAIL	J4/H3	DOOR FRAME DETAIL	J3	DOOR FRAME DETAIL	J2/H2	DOOR FRAME DETAIL	H1	DOOR FRAME DETAIL	J1	DOOR FRAME DETAIL
1 1/2" = 1'-0"	XJ6H4.DWG	1 1/2" = 1'-0"	XJ5.DWG	1 1/2" = 1'-0"	XJ4H3.DWG	1 1/2" = 1'-0"	XJ3.DWG	1 1/2" = 1'-0"	XJ2H2.DWG	1 1/2" = 1'-0"	XH1.DWG	1 1/2" = 1'-0"	XJ1.DWG

BID SET: 6 AUGUST 1999

					By	Date
					Designed	
					Drawn	
					Checked	
No.	Revision	By	Date	In Charge Of		
Maine Turnpike Authority Maine Turnpike						
 Building Renovation And Expansion						
DETAILS						
 ARCHITECTS ENGINEERS PLANNERS						
Contract YORK TOLL PLAZA - 99.7				Sheet No. 23 OF 38 A5.7		

LASSEL ARCHITECTS
 64 HIGHLAND AVENUE
 SOUTH BERNICK, MAINE 03908 207.384.2049

(METPK BDR-01)

WALL TYPE SCHEDULE




TYPE	PARTITION	DESCRIPTION	LABEL
1 IA		5/8" GNB PANELS - 2x4 WOOD STUDS 16" O.C. - PANELS APPLIED VERTICAL AND ATTACHED WITH 1" TYPE 5-12 SCREWS 12" O.C. - JOINTS FINISHED - PERIMETER CAULKED - 5" SOUND ATTEN. FIRE BLANKETS 25" WIDE CREASED TO FIT CAVITY - RUN TO UNDERSIDE OF ROOF FRAMING	UL Des U919 1-HR IA
2		5/8" GNB PANELS - 2x6 WOOD STUDS 16" O.C. - PANELS APPLIED VERTICAL AND ATTACHED WITH 1" TYPE 5-12 SCREWS 12" O.C. - JOINTS FINISHED - PERIMETER CAULKED - 5" SOUND ATTEN. FIRE BLANKETS 25" WIDE CREASED TO FIT CAVITY - RUN TO UNDERSIDE OF ROOF FRAMING	
3		6" CONCRETE MASONRY UNITS - BASEMENT SLAB TO UNDERSIDE OF FLOOR DECK ABOVE.	UL Des U777 1-HR

DOOR SCHEDULE

LOC.	NO.	DOOR TYPE	DOOR SIZE	FRAME TYPE	LABEL	DETAILS			NOTES
						HEAD	JAMB	SILL	
BASEMENT	BO1A	D	5'-0"X7'-0"X1/8"	E	60 MIN.	J5	J5		
	BO2A	G	5'-0"X7'-0"X1/8"	E	45 MIN.	H4	J5		
	BO3A	G	5'-0"X7'-0"X1/8"	E	45 MIN.	H4	J5		
	BO4A	D	5'-0"X7'-0"X1/8"	E	60 MIN.	H4	J5		
	BO6A	G	(2) 5'-0"X7'-0"X1/8"	E	45 MIN.	H4	J5		
FIRST FLOOR	101A	A	5'-0"X7'-0"X1/8"	A					* 2-8/A5.4, ** FD12, FD15/A5.5, *** 2-12/A5.4
	101B	A	5'-0"X7'-0"X1/8"	A		H1	J1	S1	
	102A	B	5'-0"X7'-0"X1/8"	D	45 MIN.	H2	J2		
	102A	B	5'-0"X7'-0"X1/8"	D		H2	J2		
	102A	C1	5'-0"X7'-0"X1/8"	D		H2	J2		
	107A	B	5'-0"X7'-0"X1/8"	D		H2	J2		
	108A	B	5'-0"X7'-0"X1/8"	D		H2	J2		
	109A	A	5'-0"X7'-0"X1/8"	B			J5		* 5-1/A5.5, ** 5-2/A5.5
	109A	A	5'-0"X7'-0"X1/8"	B			J5		
	111A	B1	5'-0"X7'-0"X1/8"	D		H2	J2		

ROOM FINISHES

LOCATION	ROOM NUMBER	ROOM NAME	FLOOR	BASE	WALLS		CEILING		SUSPENSION HEIGHT	REMARKS
					MATERIAL	FINISH	MATERIAL	FINISH		
BASEMENT	BO1	SITE MAINT. AND STORAGE	D							
	BO2	GENERAL STORAGE	F							
	BO3	DEPOSITORY	F							
	BO4	STAIR	B							
	BO5	EXISTING BASEMENT	D							
	BO6	BOILER ROOM	F							
	BO7	EXISTING GENERATOR ROOM	F							
	BO8	EXISTING TUNNEL								NO WORK THIS AREA
FIRST FLOOR	101	VEST.	C							
	102	LUNCH	B							
	103	STORAGE	B							
	104	CORR.	B							
	105	JAN.	B							
	106	TRANSPASS	B							
	107	MEN	B							
	108	WOMEN	B							
	109	COUNTING	B							
	110	CORRIDOR	B							
	111	OFFICE	A							

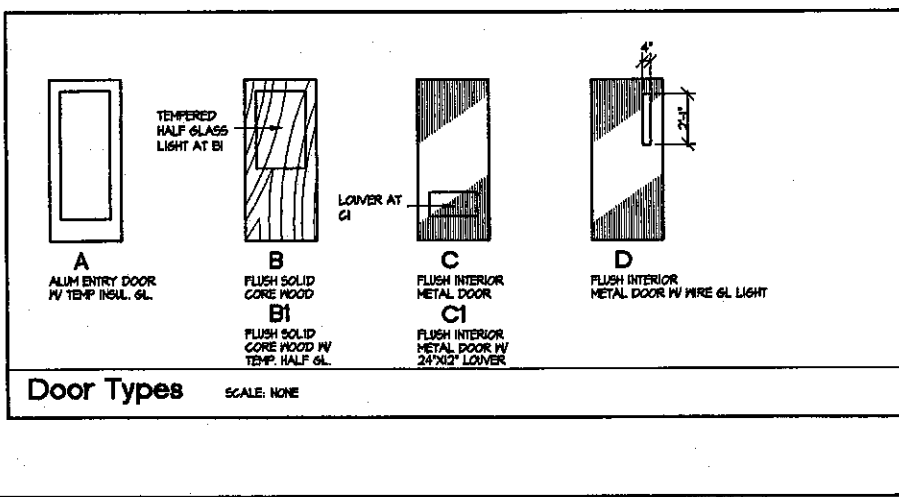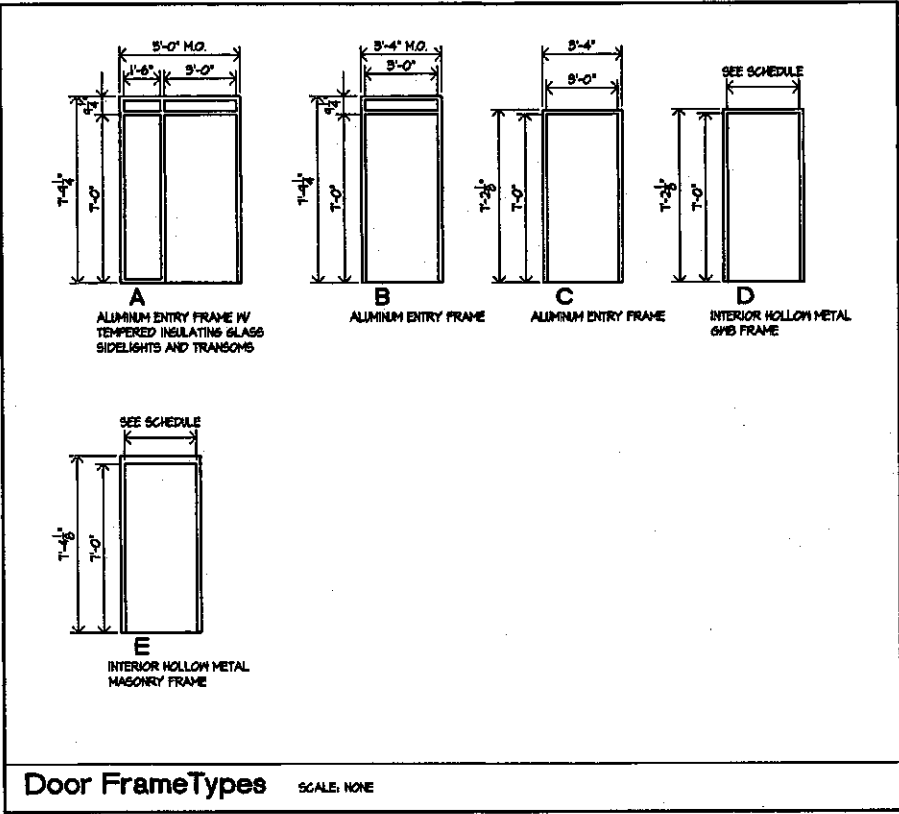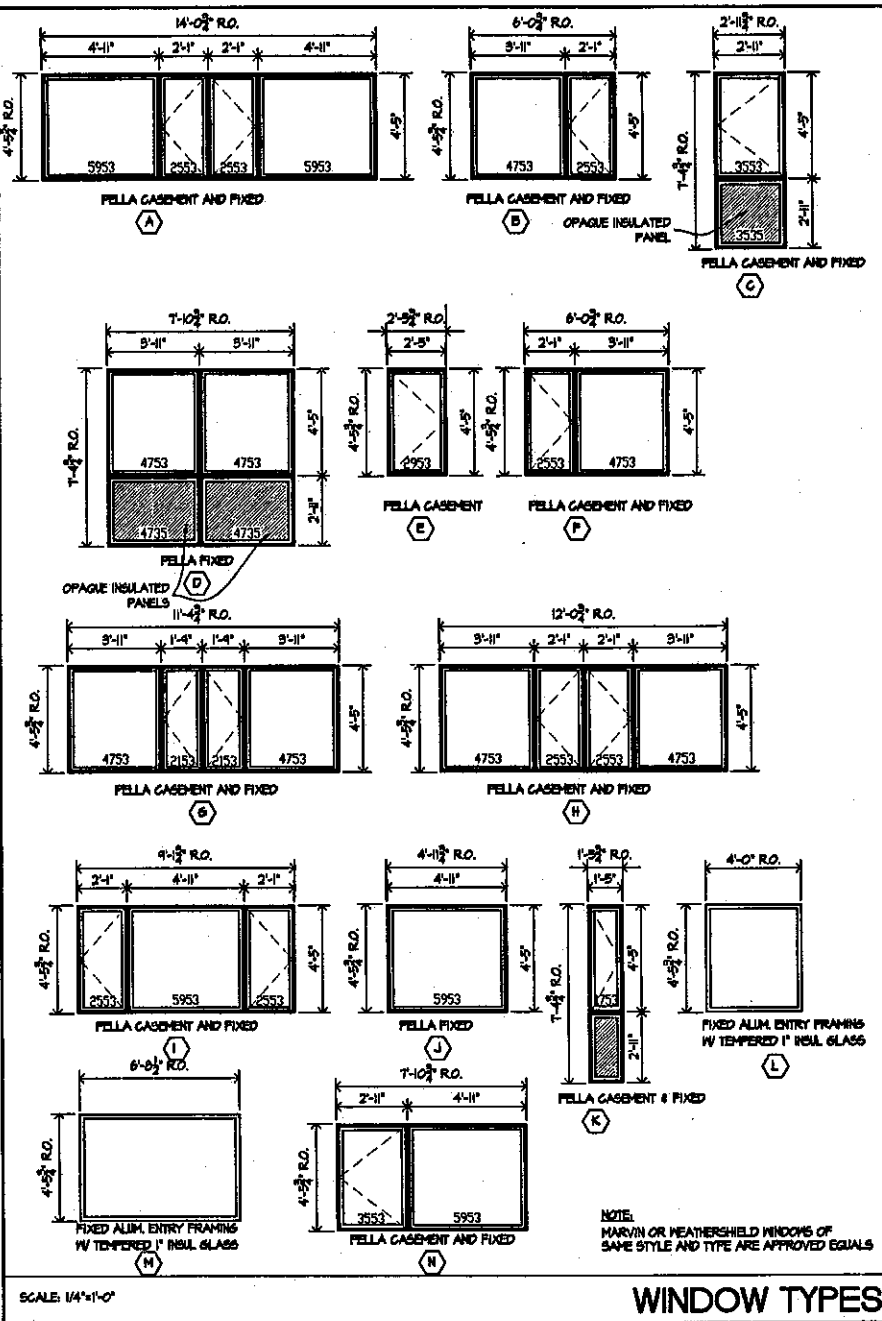

BID SET: 5 AUGUST 1999

Designed	By	Date
Drawn		
Checked		

No. Revision By Date In Charge Of:

Maine Turnpike Authority
Maine Turnpike

Building Renovation And Expansion

SCHEDULES

CITE
ARCHITECTS ENGINEERS PLANNERS

LASSEL ARCHITECTS
64 IRIGLAND AVENUE
SOUTH BERNICE, MAINE 05508 207.384.2049

Contract YORK TOLL PLAZA - 99.7

Sheet No. 24 OF 38 **A6.1**

Notes: See project specifications for additional information

GENERAL

- All Work shall conform to the requirements of all applicable state and local codes, including but not limited to:
BOCA National Building Code 1998
ANSI/ASCE 7-95
ACI 318-95 "Building Code Requirements for Reinforced Concrete"
ACI 301 "Specifications for Structural Concrete for Buildings"
AISC Steel Construction Manual
ANSI/AP&PA NDS 1997
- Any discrepancies between the above listed codes and the Construction Documents shall be brought to the attention of the Engineer for clarification before proceeding with affected Work.
- All Work shall be performed by persons qualified in their trade and licensed to practice such trade in the state in which the project is located.
- These drawings shall be used in conjunction with any Architectural, Mechanical and Electrical drawings in addition to Specifications and any Shop Drawings provided by Subcontractors and Suppliers.
- All dimensions, elevations, and conditions shall be verified in the field by the General Contractor (G.C.) and any discrepancies shall be brought to the attention of the Engineer for clarification before proceeding with the affected part of the work.
- Unless otherwise noted, details, sections, and notes shown on any Drawing shall be considered typical for all similar details.
- These drawings do not show size, location or type of openings in the foundation system for electrical, plumbing or mechanical equipment. The General Contractor shall be responsible for locating of these items.
- All Shop Drawings provided by others shall be submitted to the Engineer for review prior to fabrication of material or the purchase of non-returnable stock. Dimensional review is the Contractor's responsibility.

DESIGN LOADS

- The structure is designed in accordance with BOCA 1998 to carry all Dead Loads of the various structural, architectural, mechanical and other systems and the following minimum Live Loads:

Floor Live Load	50 PSF
Basic Ground Snow Load	50 PSF
Wind Speed & Exposure	90 MPH, Exposure "B"
Seismic	A _s = 0.12, A _v = 0.12

SOIL BEARING

- Structure shall be fully supported by piles and grade beams.
- No grade beams shall be placed in water or on frozen ground. All exterior construction shall be carried down to a minimum of four (4) feet below finished, adjacent exterior grade.
- G.C. shall provide subgrade materials as required by site conditions to perform as a working mat. G.C. shall de-water site as required.

CAST-IN-PLACE CONCRETE

- All concrete work shall conform to "Building Code Requirements for Reinforced Concrete" (ACI 318-95), and "Specifications for Structural Concrete for Buildings" (ACI 301).
- Interior slabs on grade to be of thickness shown on drawings with #4 bars each way at 12" o.c. top and bottom.
- Provide "Moistop" (or 6 mil poly) vapor barrier under all interior slabs on grade. Overlap seams minimum 6" and tape as required to maintain position. (Moistop available @ A.H. Harris)
- Minimum concrete protection for reinforcing steel shall be as follows:
Concrete cast against earth: 3 inches
Formed concrete exposed to earth or weather:
1-1/2 inches for #5 bars and smaller
2 inches for #6 bars and greater
- Calcium chloride is prohibited in any concrete mix.
- Concrete shall be adequately protected from hot or cold weather as required by ACI publications 305 and 308, respectively.
- All concrete for walls, footings, and slabs shall obtain a minimum ultimate compressive strength of 4000 psi at 28 days. Cylinders shall be taken and tested in accordance with ACI recommendations.
- Wall control joints shall be placed as shown on drawings or at a maximum of 40 ft. on center.
- Backfill both sides of the foundation walls simultaneously to the maximum height possible.
- All concrete shall be cured by an approved method as prescribed by ACI.

REINFORCING STEEL

- All reinforcing, except as noted, shall be deformed bars conforming to ASTM A615 Grade 60.
- All reinforcing shall be detailed in accordance with the latest ACI Detailing Manual and Specifications.
- Where continuous bars are called for, indicated or required, they shall run continuously around corners, lapped at necessary splices, splices staggered and hooked at discontinuous ends. Lap lengths shall be as shown, or Min. 36 bar diameters.

WOOD FRAMING

- All rough framing shall be No. 2 or better Spruce-Pine-Fir, unless otherwise specified or shown on the drawings.
- All two (2) inch nominal lumber to be seasoned to 19% maximum moisture content.
- All lumber and sheathing shall be grade-stamped by the appropriate manufacturer's association for the appropriate use.
- All wood in contact with concrete, masonry or earth shall be pressure treated SYP with a CCA-C 040 process.
- All wood framing shall be built plumb, level, square and true with adequate bracing and connection hardware to ensure a rigid structure.
- Rough connections shall be accurately cut and tightly fitted as necessitated by the conditions encountered to provide full bearing without use of shims.
- All sheathing shall be laid with long dimension perpendicular to supports, unless noted otherwise. Stagger all joints.
- All sheathing shall be nailed 6" on center at supported panel edges and @ 10" on center at intermediate supports, unless otherwise shown or noted (specific shear walls & diaphragms).
- All headers over six (6) feet in length shall rest on double stud posts as a minimum, unless otherwise noted on the drawings.
- Simpson construction hardware (or approved equal) shall be fastened according to the manufacturer's specifications and nailing schedule.
- Beams noted as "PSL" shall be "Parallam" as manufactured by Trus-Joist McMillan (E=2,000,000 PSI, Fb=2900 PSI). Parallam products shall be adequately stored and covered at the job site to be protected from water damage prior to installation.
- Unless noted otherwise, minimum fastening of wood members shall conform to Table 2305.2 of BOCA.
- All plywood or OSB shall be APA rated and shall be adequately spaced at joints (1/8" typ) as required by APA for expansion. This includes roofs, walls, and floors.

MASONRY LOOSE LINTEL SCHEDULE (IF APPLICABLE)

- Unless otherwise indicated on the drawings provide one angle, placed with long leg vertical, for each 4" of masonry thickness for all masonry openings in accordance with the following schedule.





Maximum Opening	Lintel
Up to 4'	L3-1/2 x 3-1/2 x 3/8"
3' 1" to 4' 6"	L4 x 3-1/2 x 3/8"
4' 7" to 6' 6"	L5 x 3-1/2 x 3/8"
6' 1" to 8' 6"	L6 x 3-1/2 x 3/8"
8' 1" to 11' 6"	L7 x 4 x 3/8"
- All lintels shall be galvanized.
- Lintels shall be 12" longer than masonry opening and shall have a minimum of 6" bearing on masonry at each end. Where lintel abuts a column provide a structural clip angle connection.

STEEL PILES

- HP piles shall conform to ASTM A36.
- The lateral tolerance for driven piles shall be no greater than 3" in any direction.
- Piles shall be driven to refusal in bedrock at an estimated depth of 80 feet.
- Minimum pile capacity shall be 20 Tons. (SF. = 2.5)



				By	
				Designed	5/95
				Drawn	
				Checked	
No.	Revision	By	Date	In Charge Of	
Maine Turnpike Authority Maine Turnpike					
Building Renovation And Expansion Structural Notes					
HNTB ARCHITECTS ENGINEERS PLANNERS					
Contract					Sheet No.

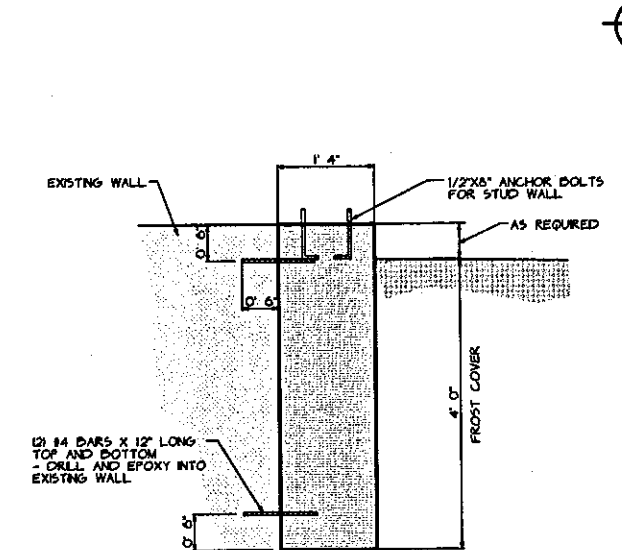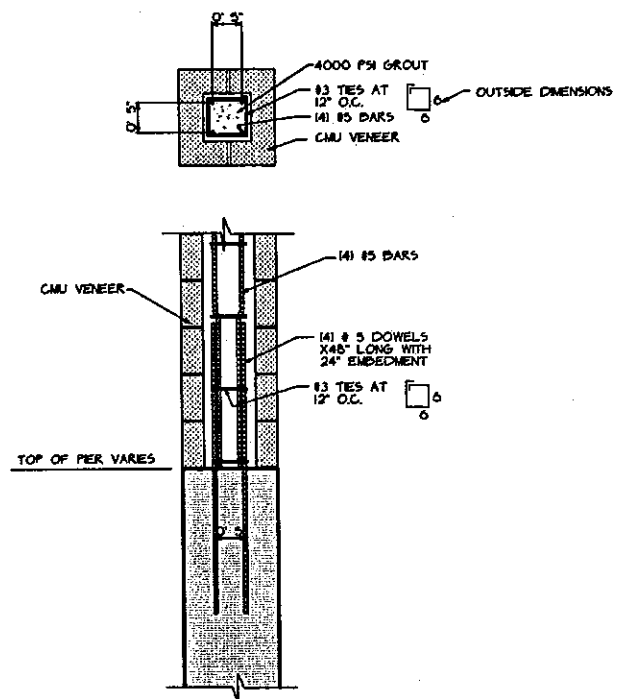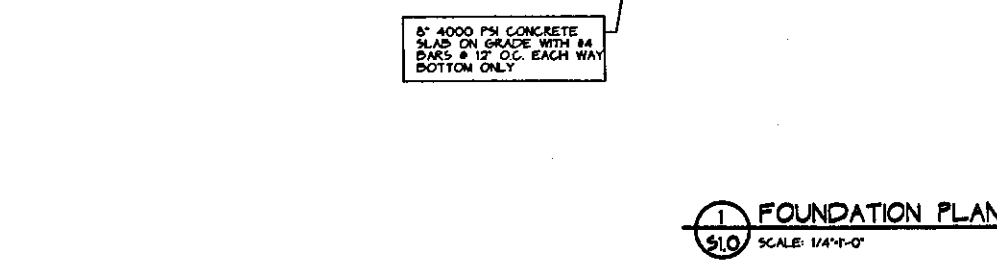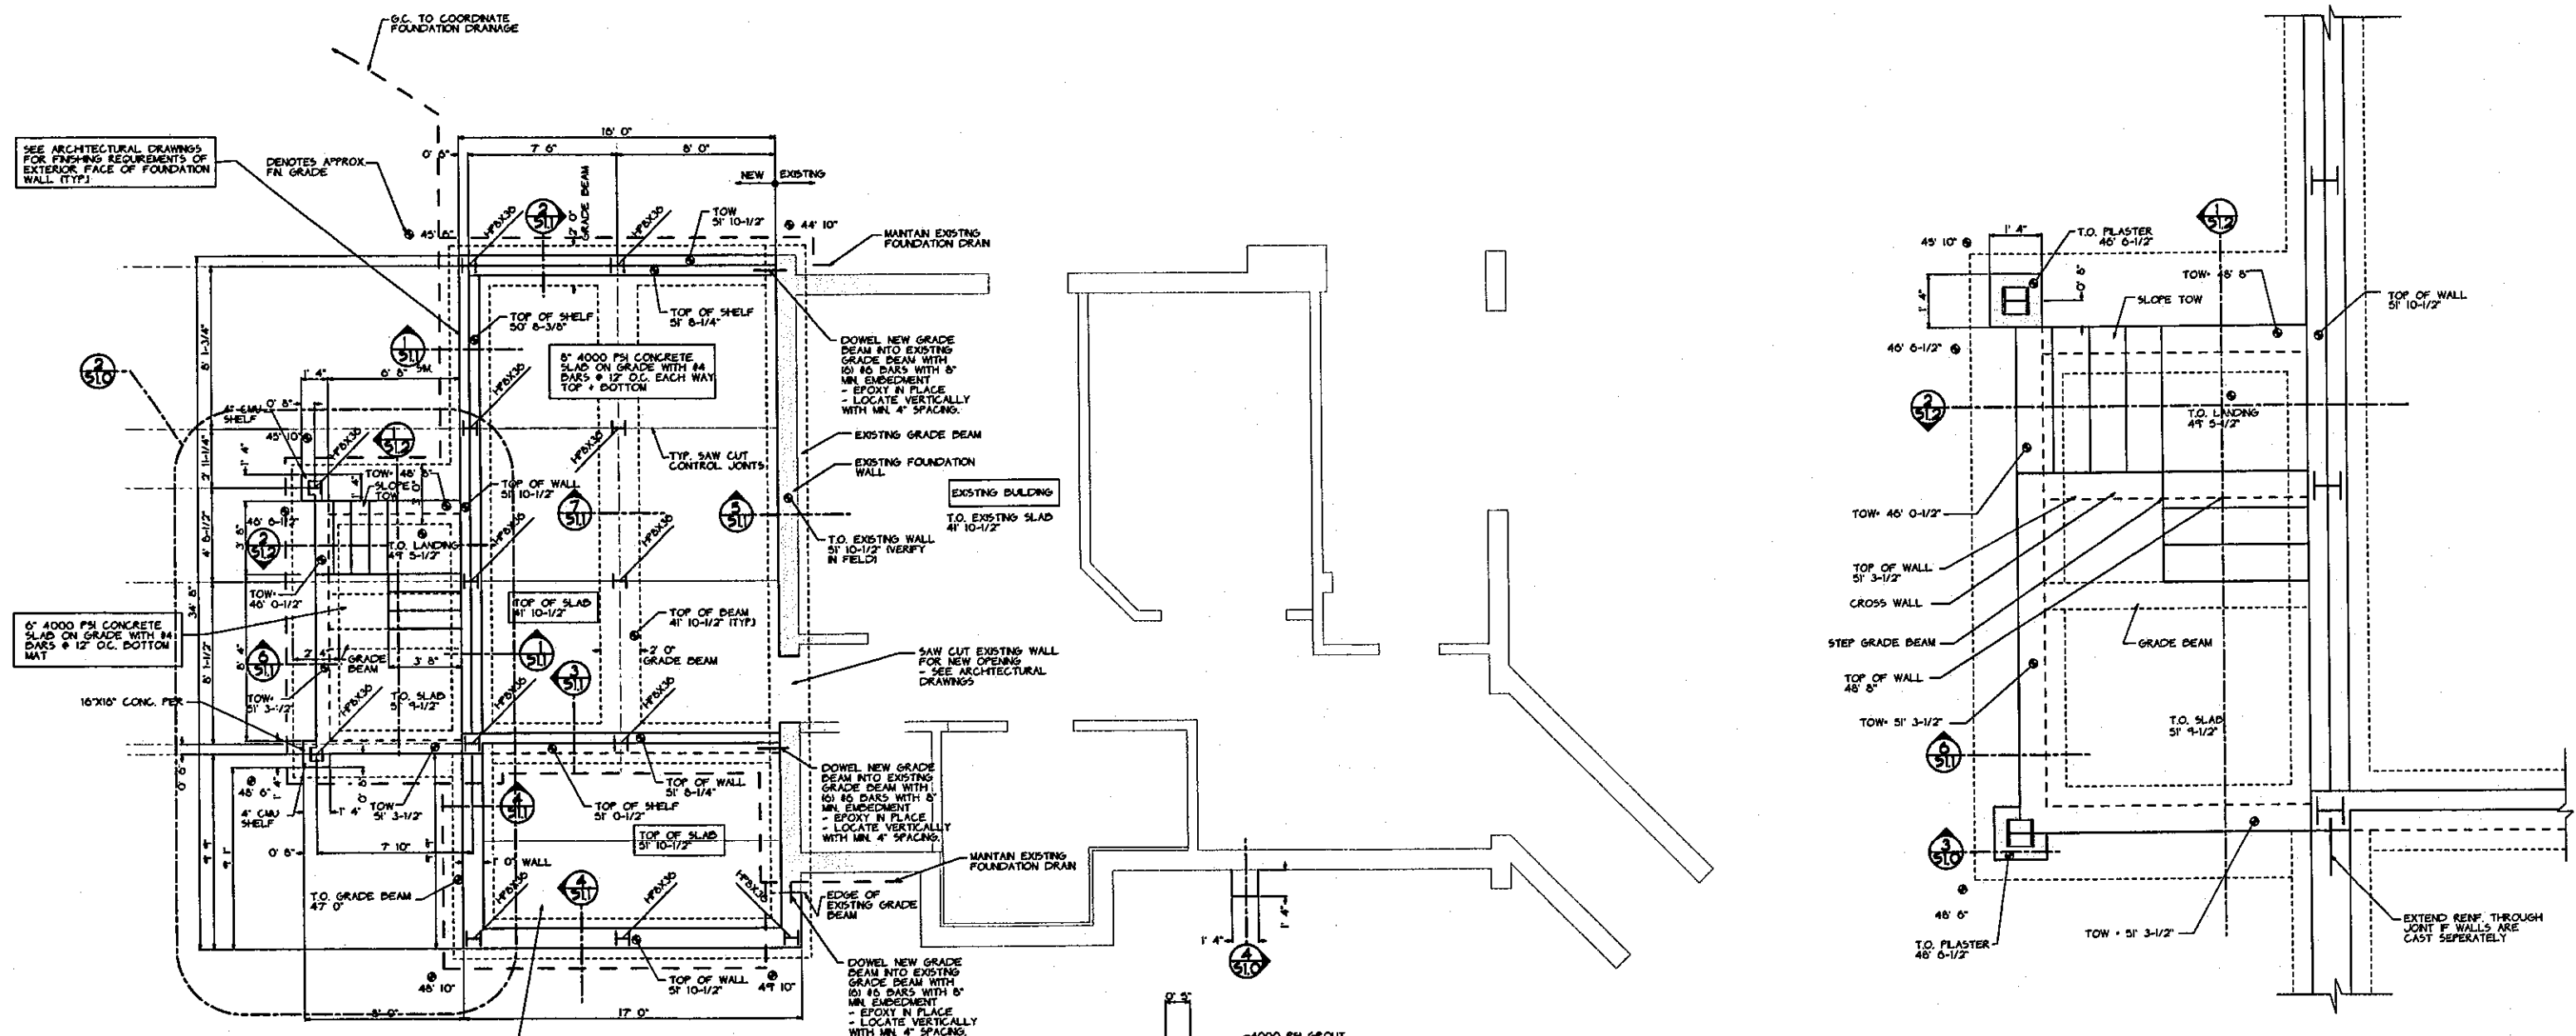


2 ENLARGED STAIR PLAN

SCALE: 1/2"=1'-0"



No.	Revision	By	Date	In Charge On
				Designed By BJS
				Drawn
				Checked
Maine Turnpike Authority				
Building Renovation And Expansion Foundation Plan				
Contract				
Sheet No. 510				

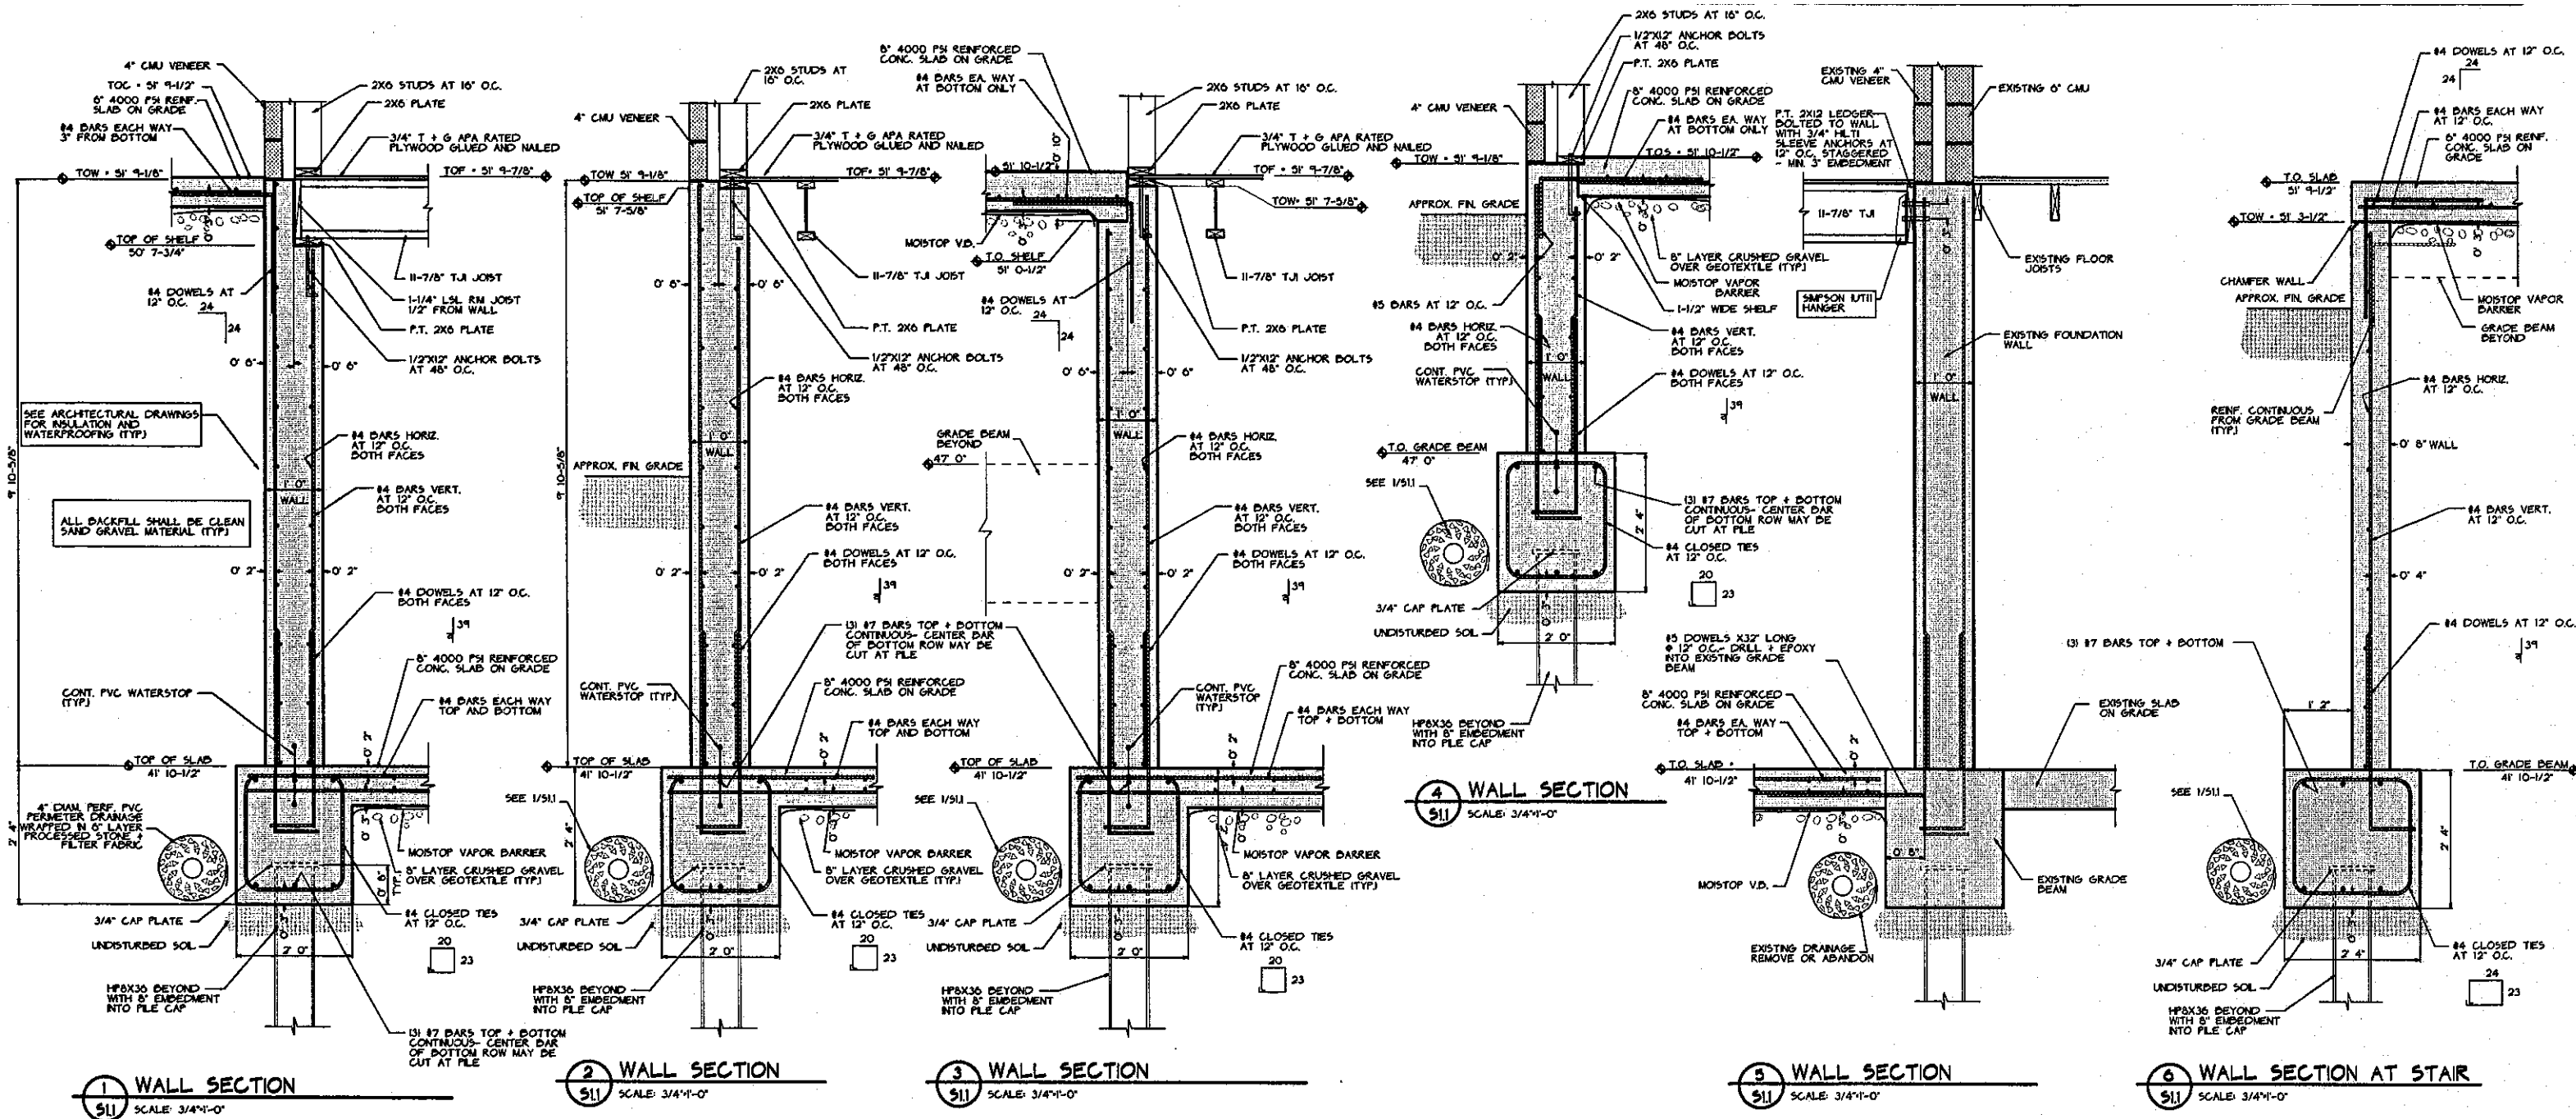


1 WALL SECTION
S11 SCALE: 3/4\"/>

2 WALL SECTION
S11 SCALE: 3/4\"/>


3 WALL SECTION
S11 SCALE: 3/4\"/>

4 WALL SECTION
S11 SCALE: 3/4\"/>


6 WALL SECTION AT STAIR
S11 SCALE: 3/4\"/>

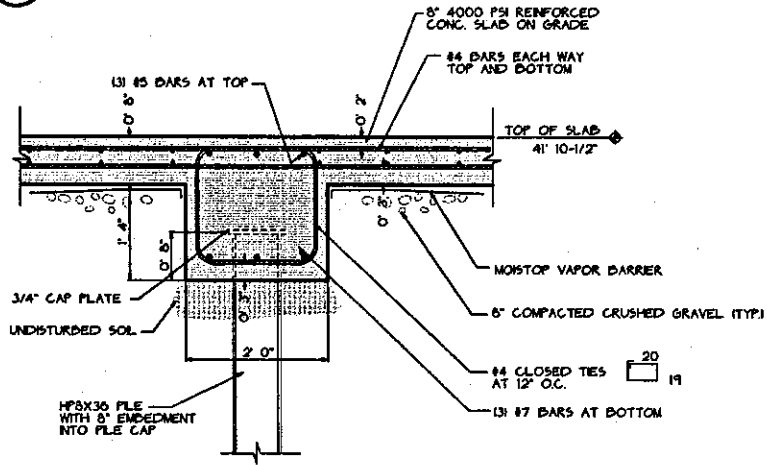


7 SECTION THRU GRADE BEAM
S11 SCALE: 3/4\"/>

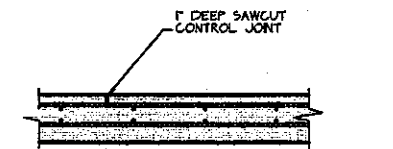


8 SLAB CONTROL JOINT
S11 SCALE: 3/4\"/>

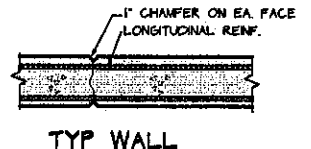


9 TYP WALL CONTROL JOINT
S11 NO SCALE

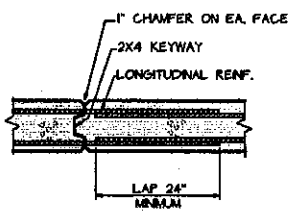

10 TYP WALL CONSTRUCTION JOINT
S11 NO SCALE

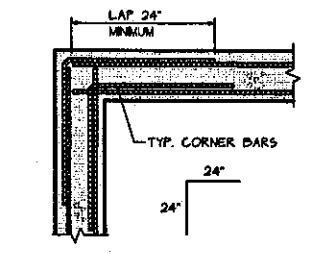

11 TYP WALL REINF. AT CORNERS
S11 NO SCALE

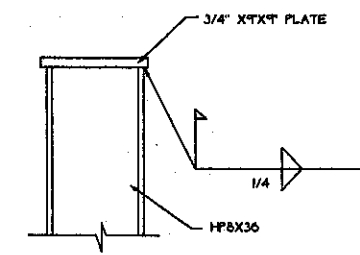


12 PILE CAP PLATE
S11 SCALE: 1/2\"/>




No.	Revision	By	Date	In Charge Of
		Designed	6/5/99	
		Drawn		
		Checked		

Maine Turnpike Authority
Maine Turnpike
Building Renovation
And Expansion
Foundation Details

Contract	York Toll Plaza	Sheet No.	27 of 38	S11
----------	-----------------	-----------	----------	-----

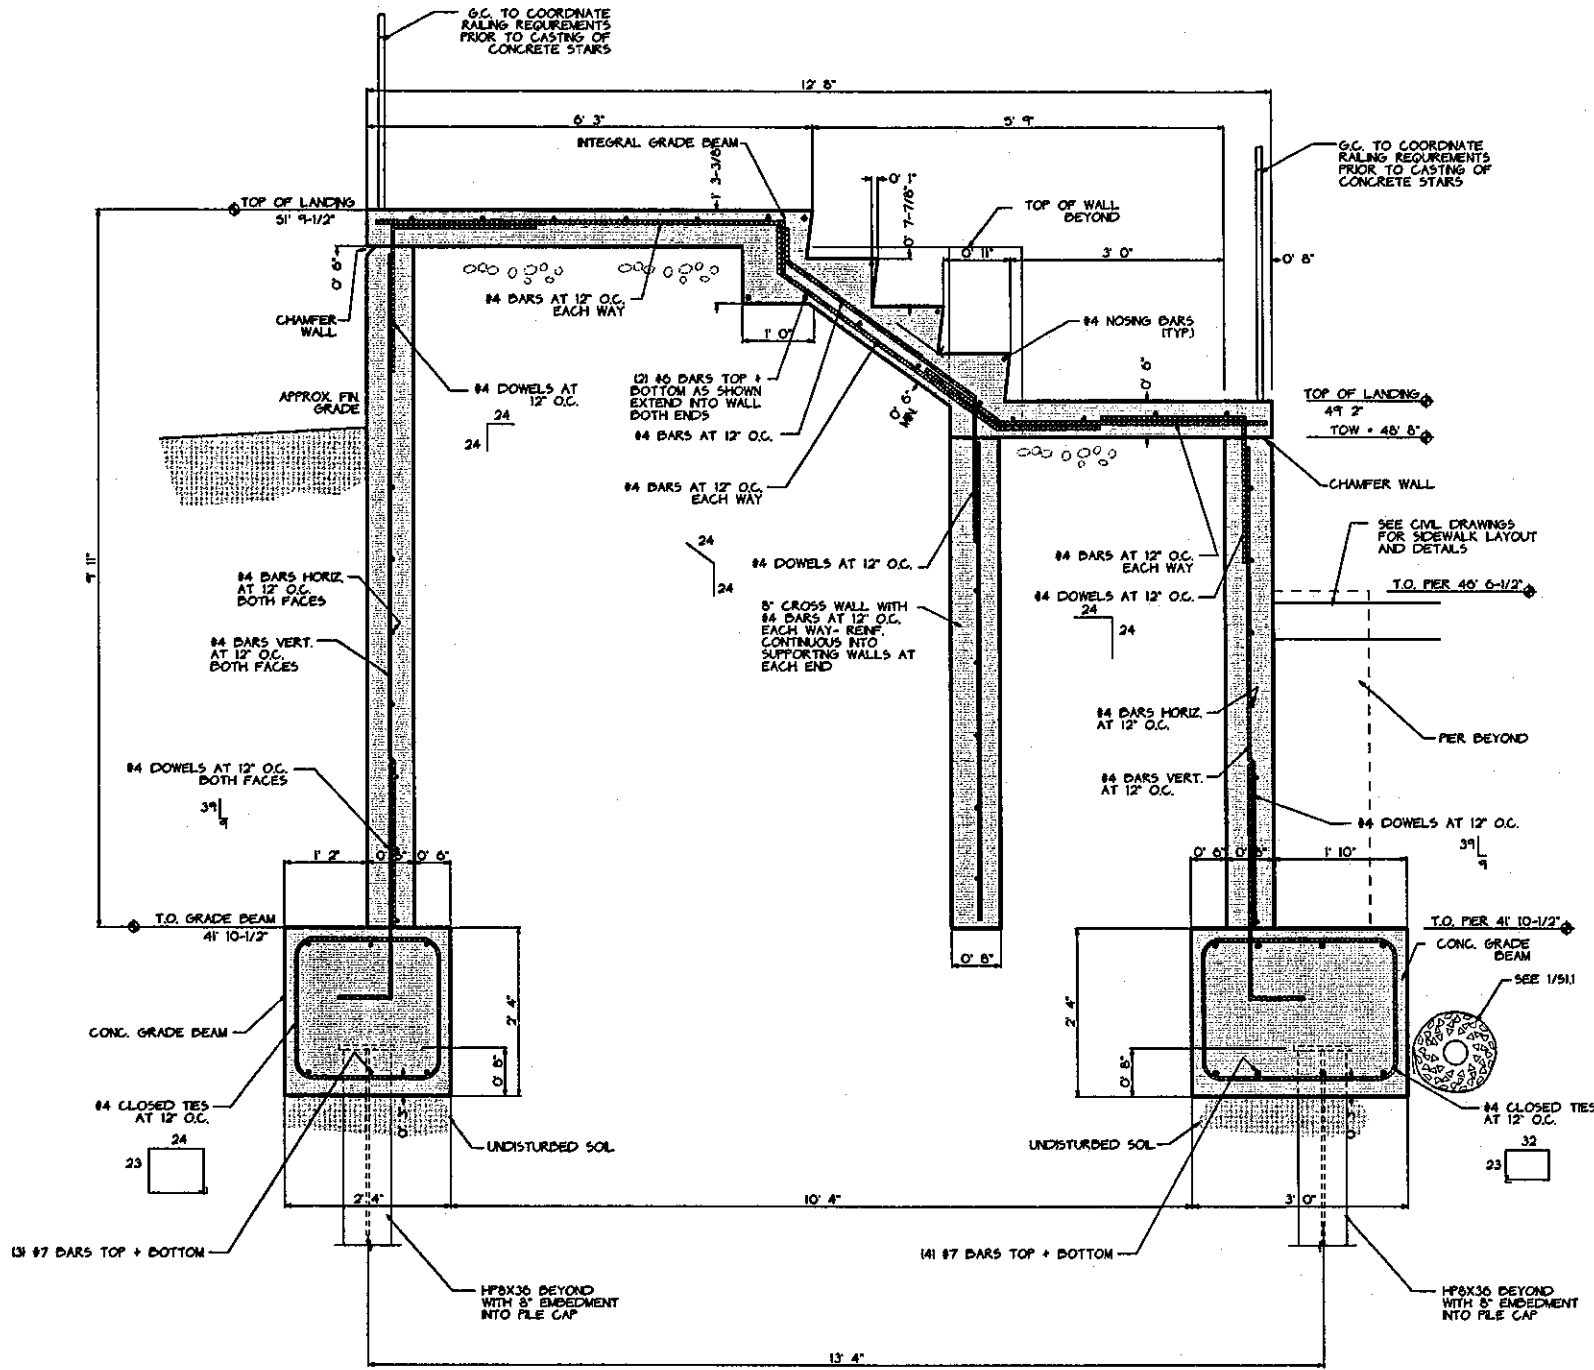

1 CONCRETE STAIR SECTION
 SCALE: 3/4"=1'-0"

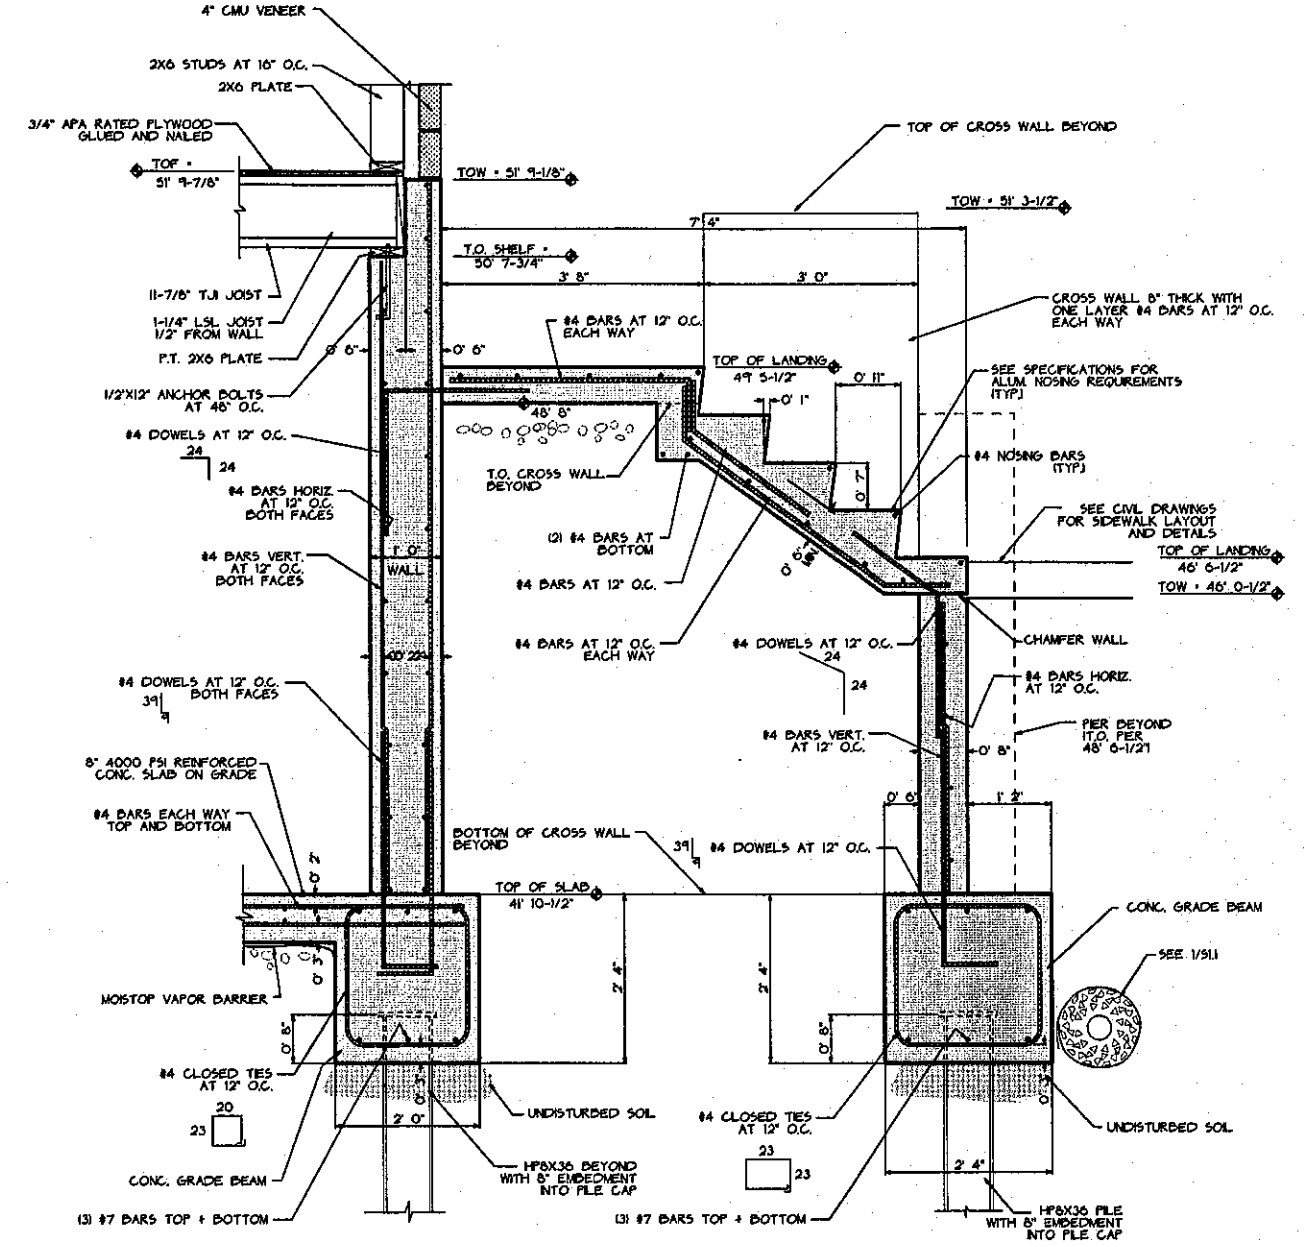


2 CONCRETE STAIR SECTION
 SCALE: 3/4"=1'-0"




By	Date			
Designed	8/5/99			
Drawn				
Checked				
No.	Revision	By	Date	In Charge Of
Maine Turnpike Authority Maine Turnpike				
Building Renovation And Expansion Foundation Details				
HNTE				


Contract	Sheet No.	51.2
York Toll Plaza	28 of 38	

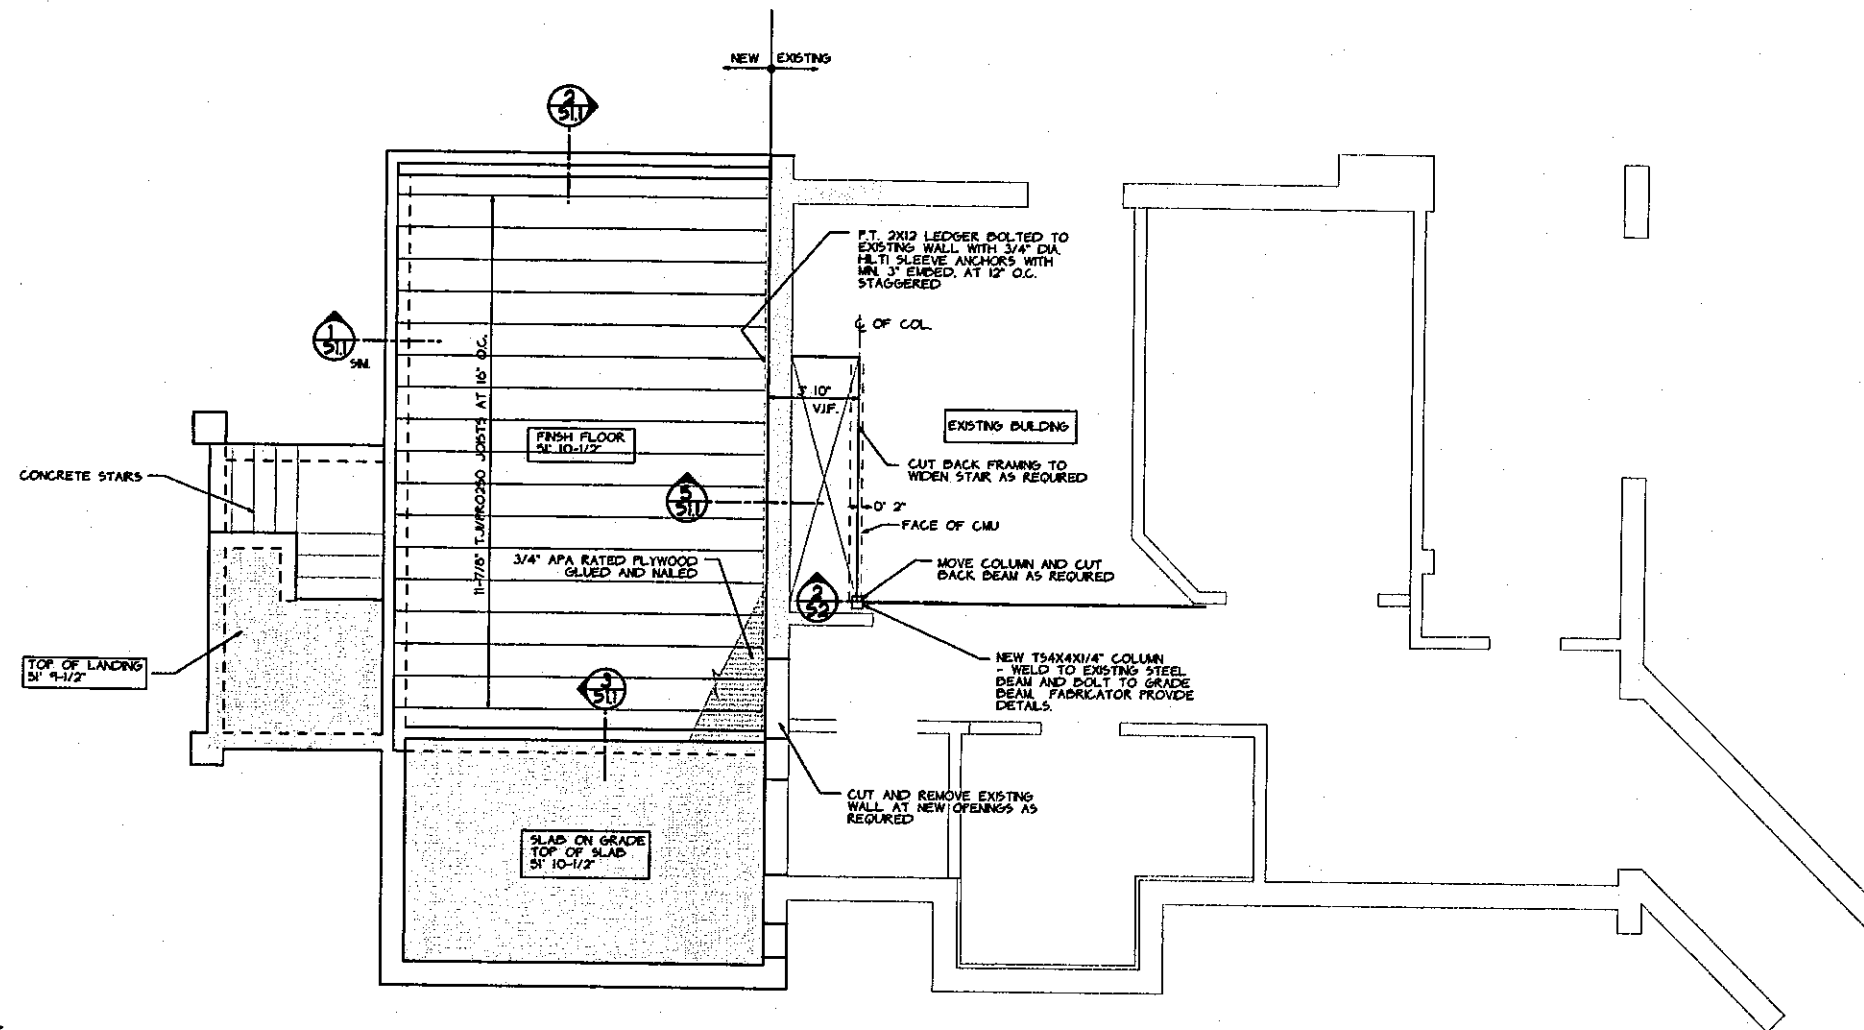

1 FIRST FLOOR FRAMING PLAN
SCALE: 1/4"=1'-0"

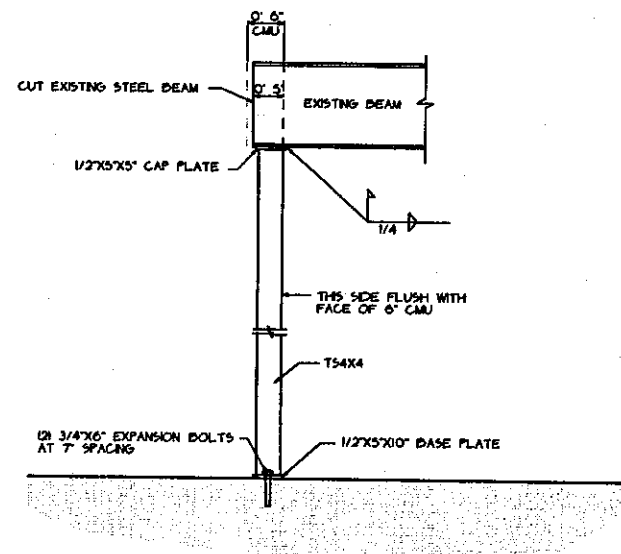

2 STEEL COLUMN
SCALE: 3/4"=1'-0"

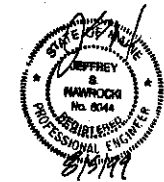


				By	D
				Designed	B/S
				Drawn	
				Checked	
No.	Revision	By	Date	In Charge Of	
Maine Turnpike Authority Maine Turnpike					
		Building Renovation And Expansion			
First Floor Framing Plan					
 REGISTERED ENGINEERS & ARCHITECTS					
Contract			Sheet No.		
Maine Turnpike			52		

NOTE- NEW ROOF FRAMING DOES NOT INCREASE LOADS ON EXISTING ROOF. EXISTING ROOF FRAMING DOES NOT MEET CURRENT DESIGN CRITERIA, BUT WILL REMAIN AS AN EXISTING CONDITION.


NOTE- USE SIMPSON L25-3 HANGERS WHERE TRIPLE 2X6 MEMBERS FLUSH FRAME.

WHERE NEW WOOD BEAMS BEAR ON EXISTING MASONRY WALLS, POCKET AS REQUIRED AND PROVIDE MIN 3" BEARING ONTO 6" CMU WALLS.

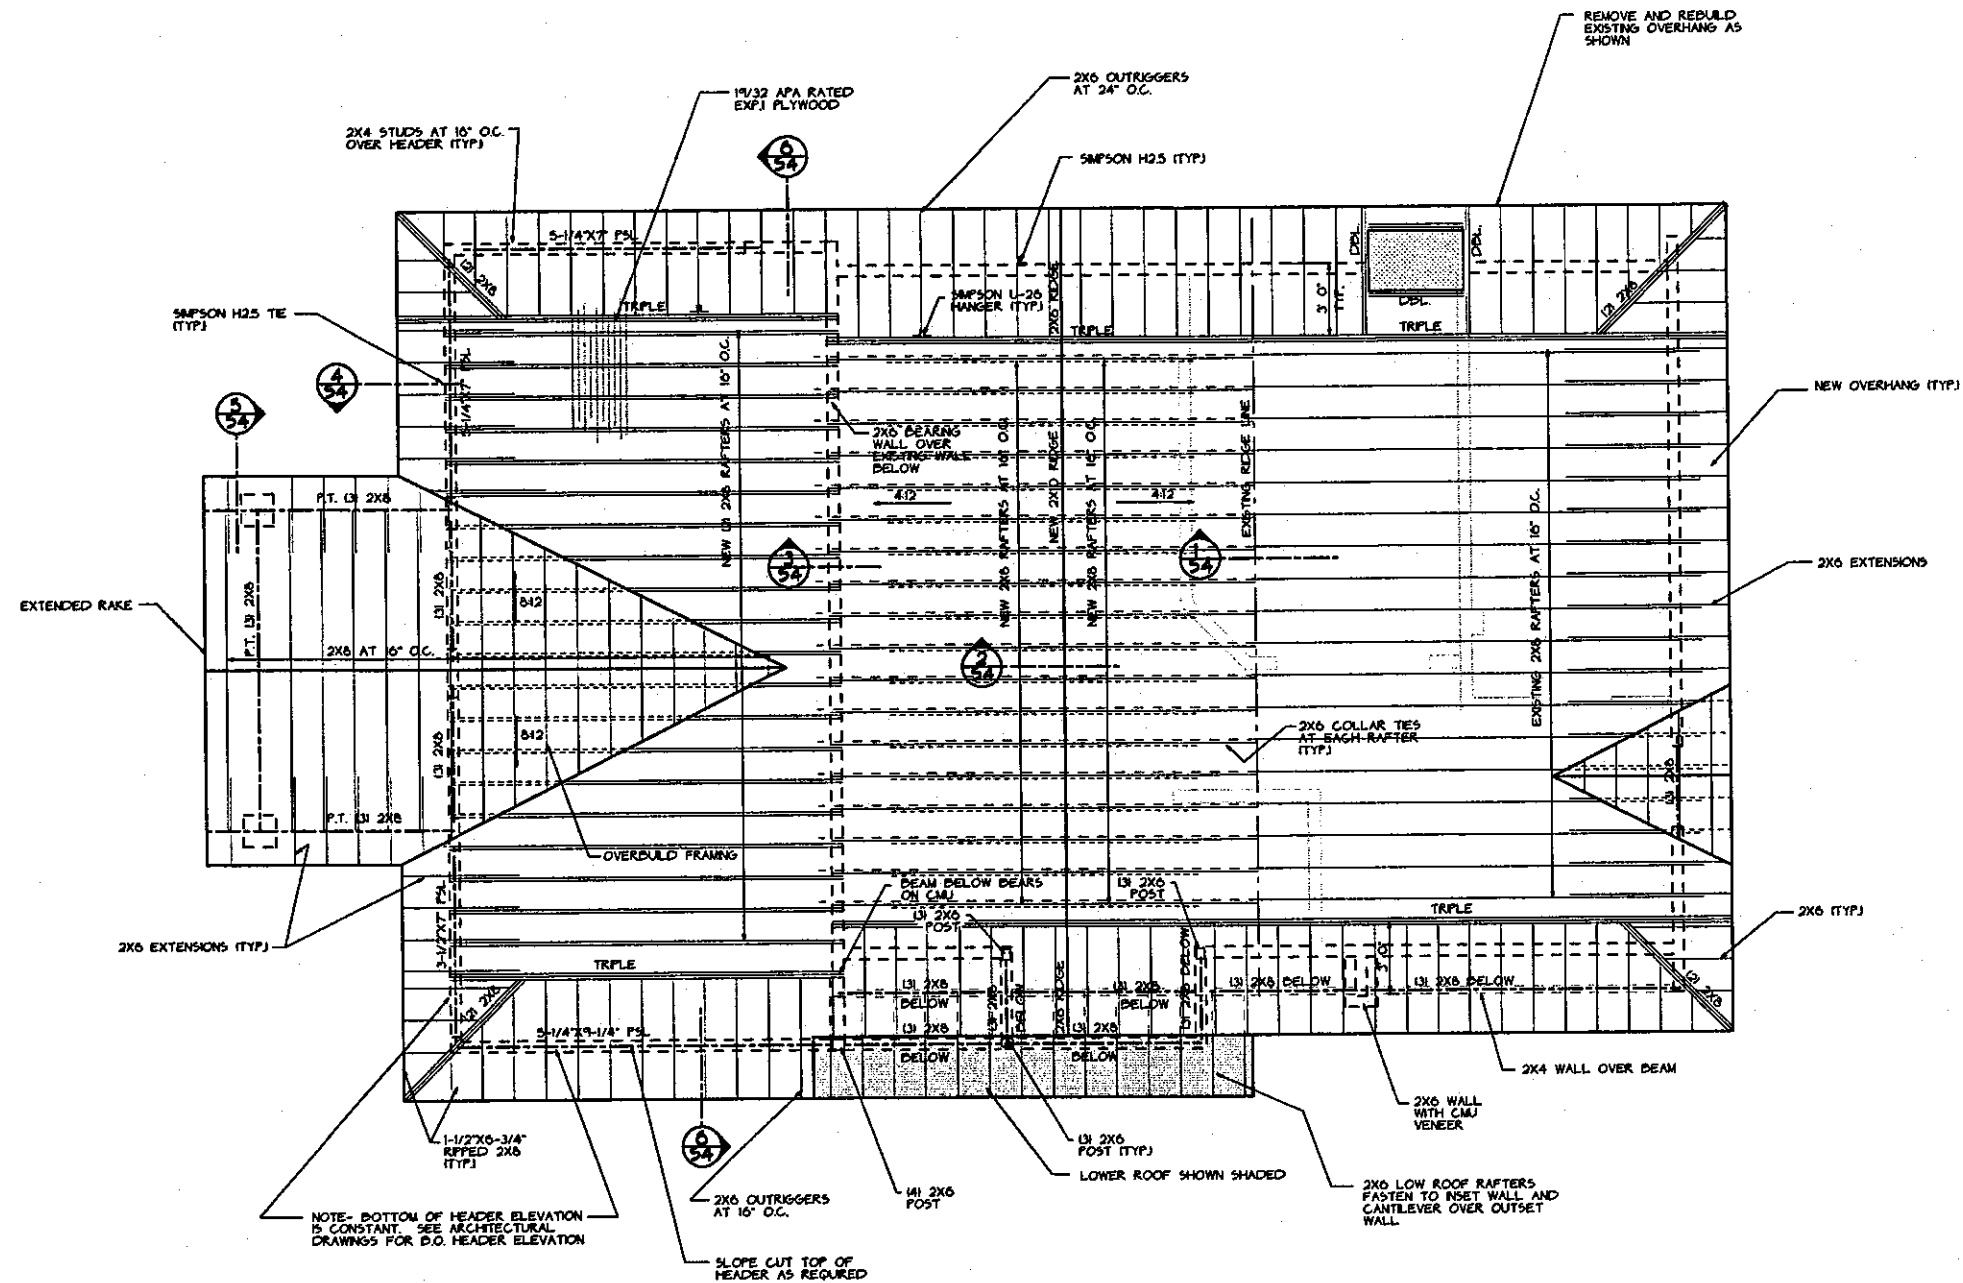

1 ROOF FRAMING PLAN
SCALE: 1/4"=1'-0"

NOTE- ALL HEADERS > 6 FT. REST ON DOUBLE JACK STUD UNLESS NOTED OTHERWISE. EXTEND TRIMMER STUD AND NAIL TO HEADER.

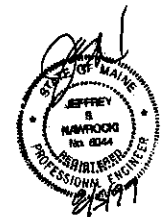

				By	De
				Design	5/5/17
				Draw	
				Checked	
No.	Revision	By	Date	In Charge On	


Maine Turnpike Authority
Maine Turnpike

Transpass Building Renovation And Expansion
Roof Framing Plan


HNTB ARCHITECTS ENGINEERS PLANNERS

Contract York Toll Plaza Sheet No. 53


NOTE- G.C. VERIFY THICKNESS OF EXISTING ROOF SHEATHING. ADJUST NEW RAFTERS IF REQUIRED TO MAINTAIN TOP OF SHEATHING LEVEL.

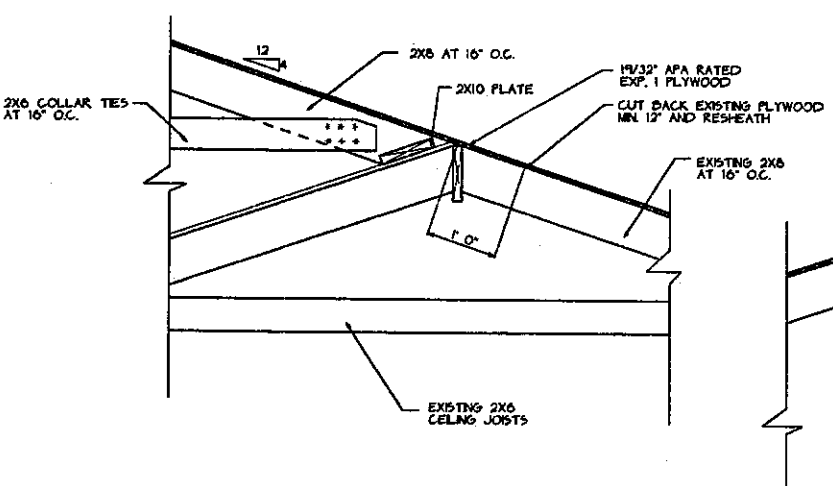


1 DETAIL AT EXISTING RIDGE LINE
54 SCALE: 3/4\"/>

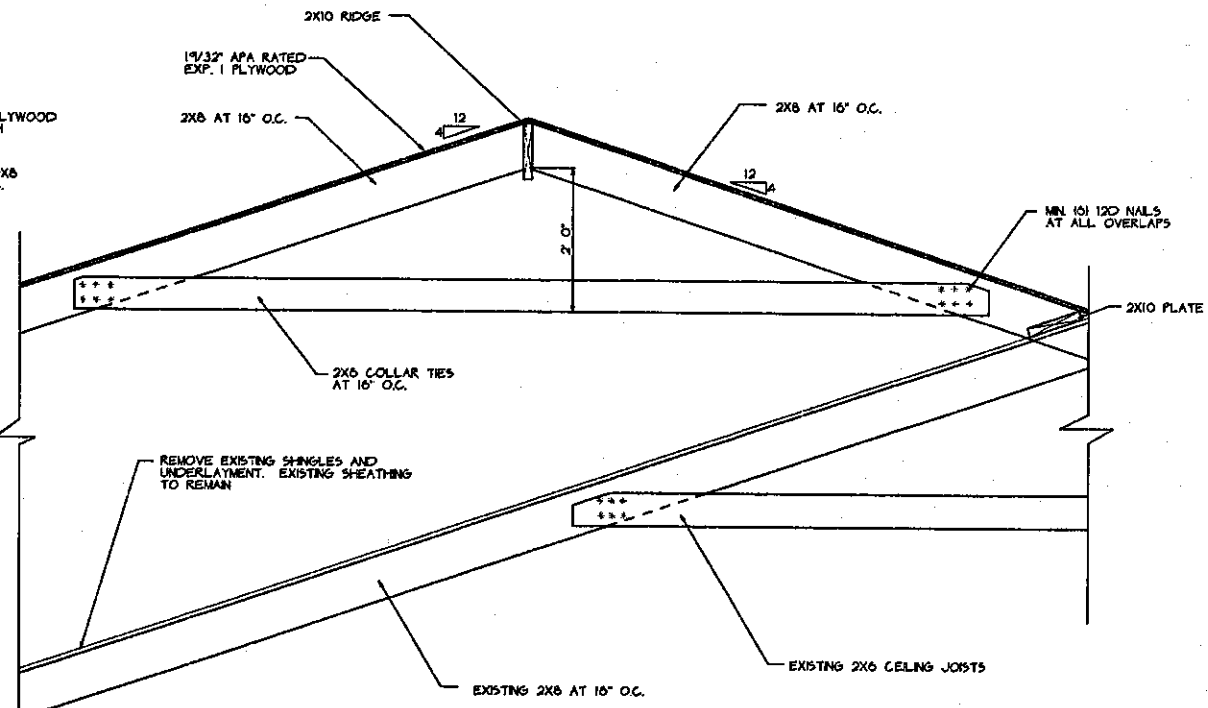


2 DETAIL AT NEW RIDGE LINE
54 SCALE: 3/4\"/>

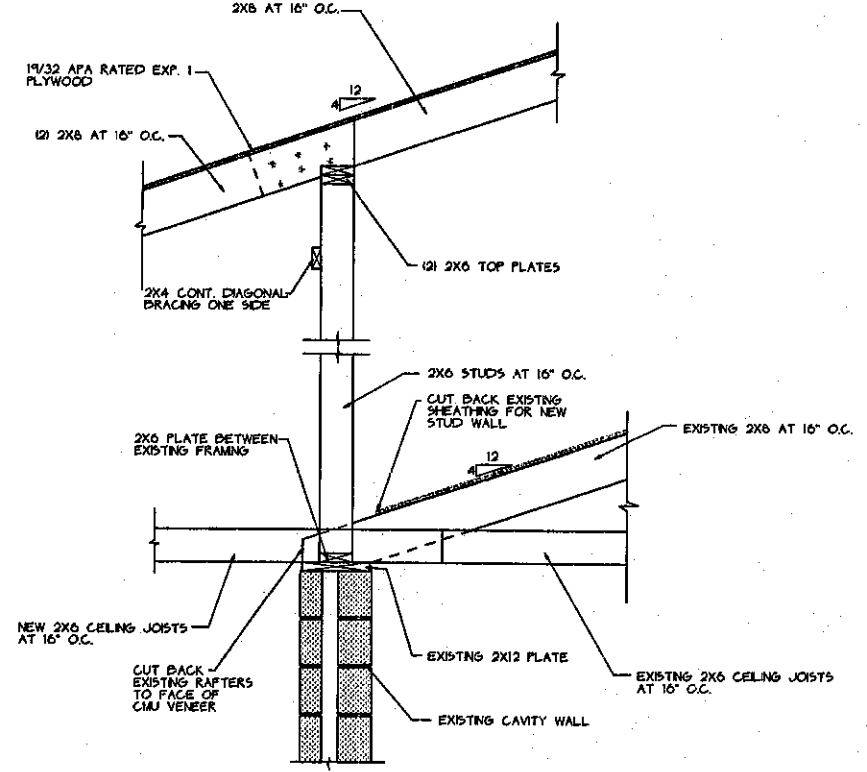


3 DETAIL AT EXISTING ROOF EDGE
54 SCALE: 3/4\"/>

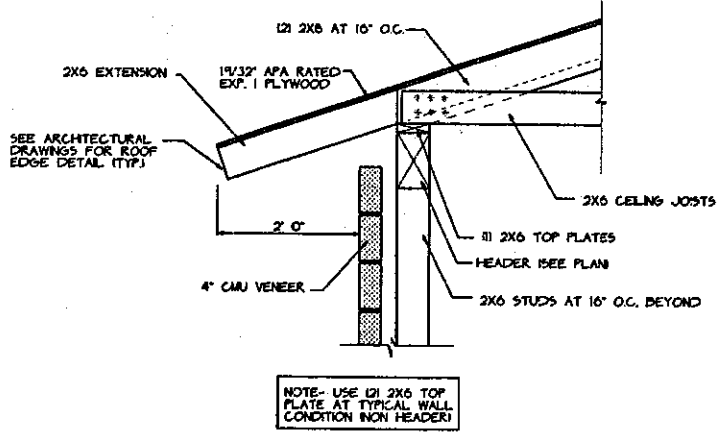


4 ROOF EDGE DETAIL AT HEADER
54 SCALE: 3/4\"/>

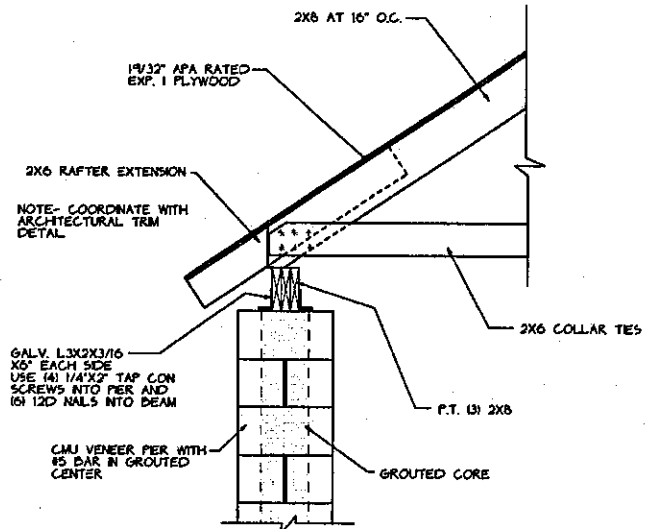

5 ROOF EDGE DETAIL
54 SCALE: 3/4\"/>

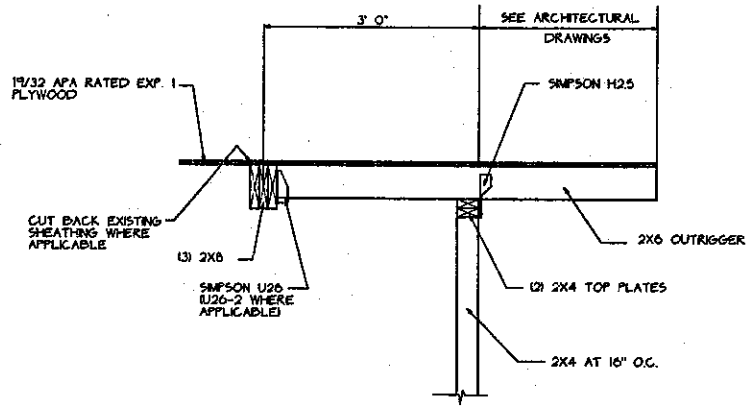

6 ROOF EDGE DETAIL
54 SCALE: 3/4\"/>

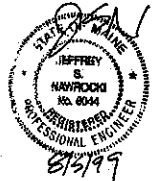





				By	Date
				Designed	8/5/99
				Drawn	
				Checked	
No.	Revision	By	Date	In Charge Of	
Maine Turnpike Authority Maine Turnpike					
Building Renovation And Expansion Framing Details					

Contract	Sheet No.	54
York Toll Plaza	31	38





PRESSURE TANK PERFORMANCE SCHEDULE						
TAG	TYPE	DESIGN	PERFORM	SIZE	BASE OF DESIGN AMTROL	
					MOUNTING	SERVICE MODEL
PT-1	88	23.2	48/80	280 x 47 1/2"	FLOOR	WALL WK-302
PT-2	88	23.2	48/80	280 x 47 1/2"	FLOOR	WALL WK-302

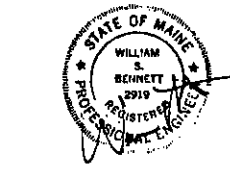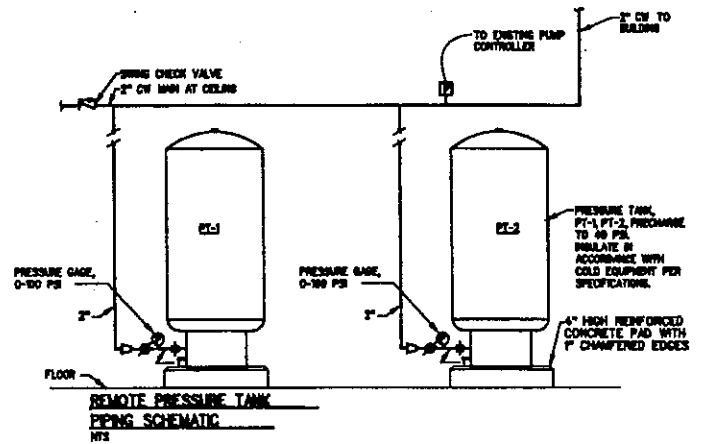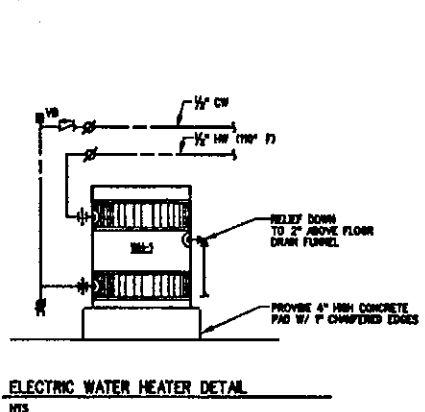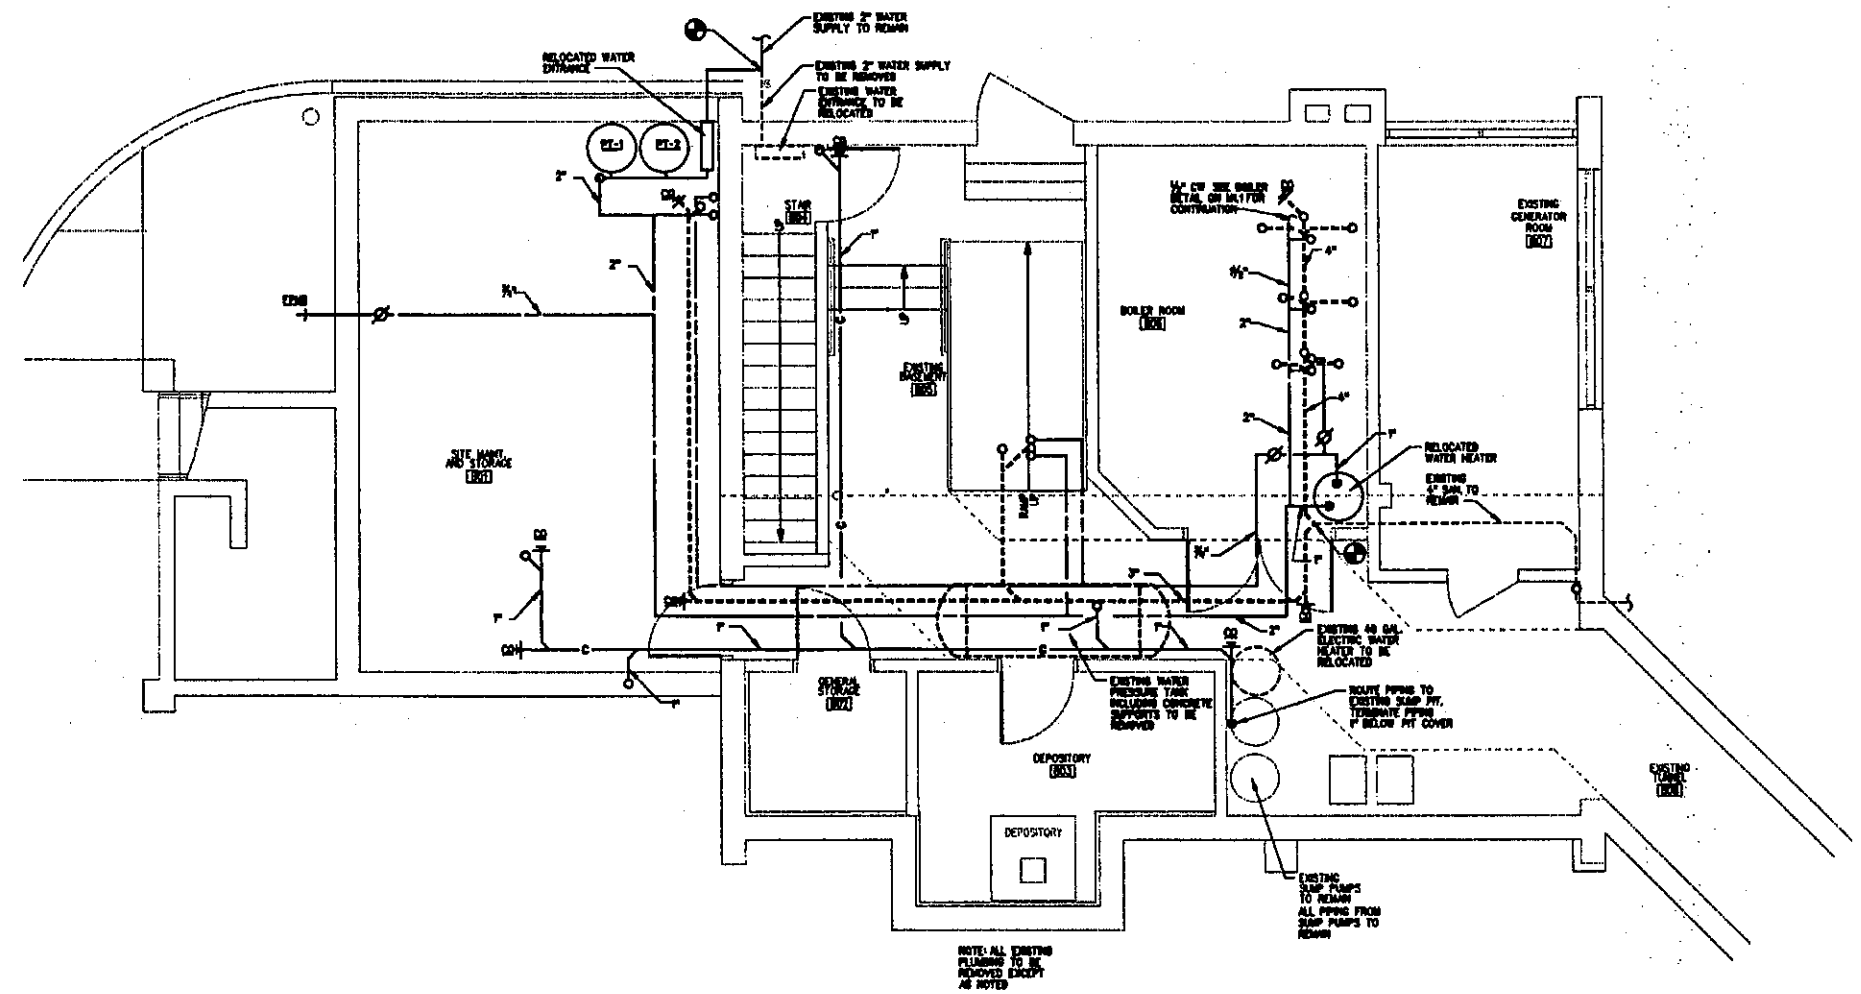


BENNETT ENGINEERING
 CONSULTING ENGINEERS
 BENNETT ROAD P.O. BOX 287
 FREETOWN, MAINE 04032
 (207) 866-9475

No.	Revision	By	Date	In Charge Off.
		Designed	WVW	11/06/09
		Drawn	WVW	11/06/09
		Checked	WVW	11/06/09

Maine Turnpike Authority Maine Turnpike				
BUILDING RENOVATION AND EXPANSION				
BASEMENT PLUMBING PLAN				
HNTB ARCHITECTS ENGINEERS PLANNERS				
Contract		Sheet No.		
YORK TOLL PLAZA - 99.7		32 OF 38		
		P1.1		



PLUMBING FIXTURE CONNECTION SCHEDULE					
TAG	DESCRIPTION	SAW	VENT	CW	HW
P-1	HC FLR MTD WC	3"	2"	1/2"	-
P-2	FLR MTD WC	3"	2"	1/2"	-
P-3	W/ URINAL	2"	1/2"	1/2"	-
P-4	COUNTERTOP LAVATORY	1/2"	1/2"	1/2"	1/2"
P-5	KITCHEN SINK	1/2"	1/2"	1/2"	1/2"
P-6	SERVICE SINK	3"	2"	1/2"	1/2"

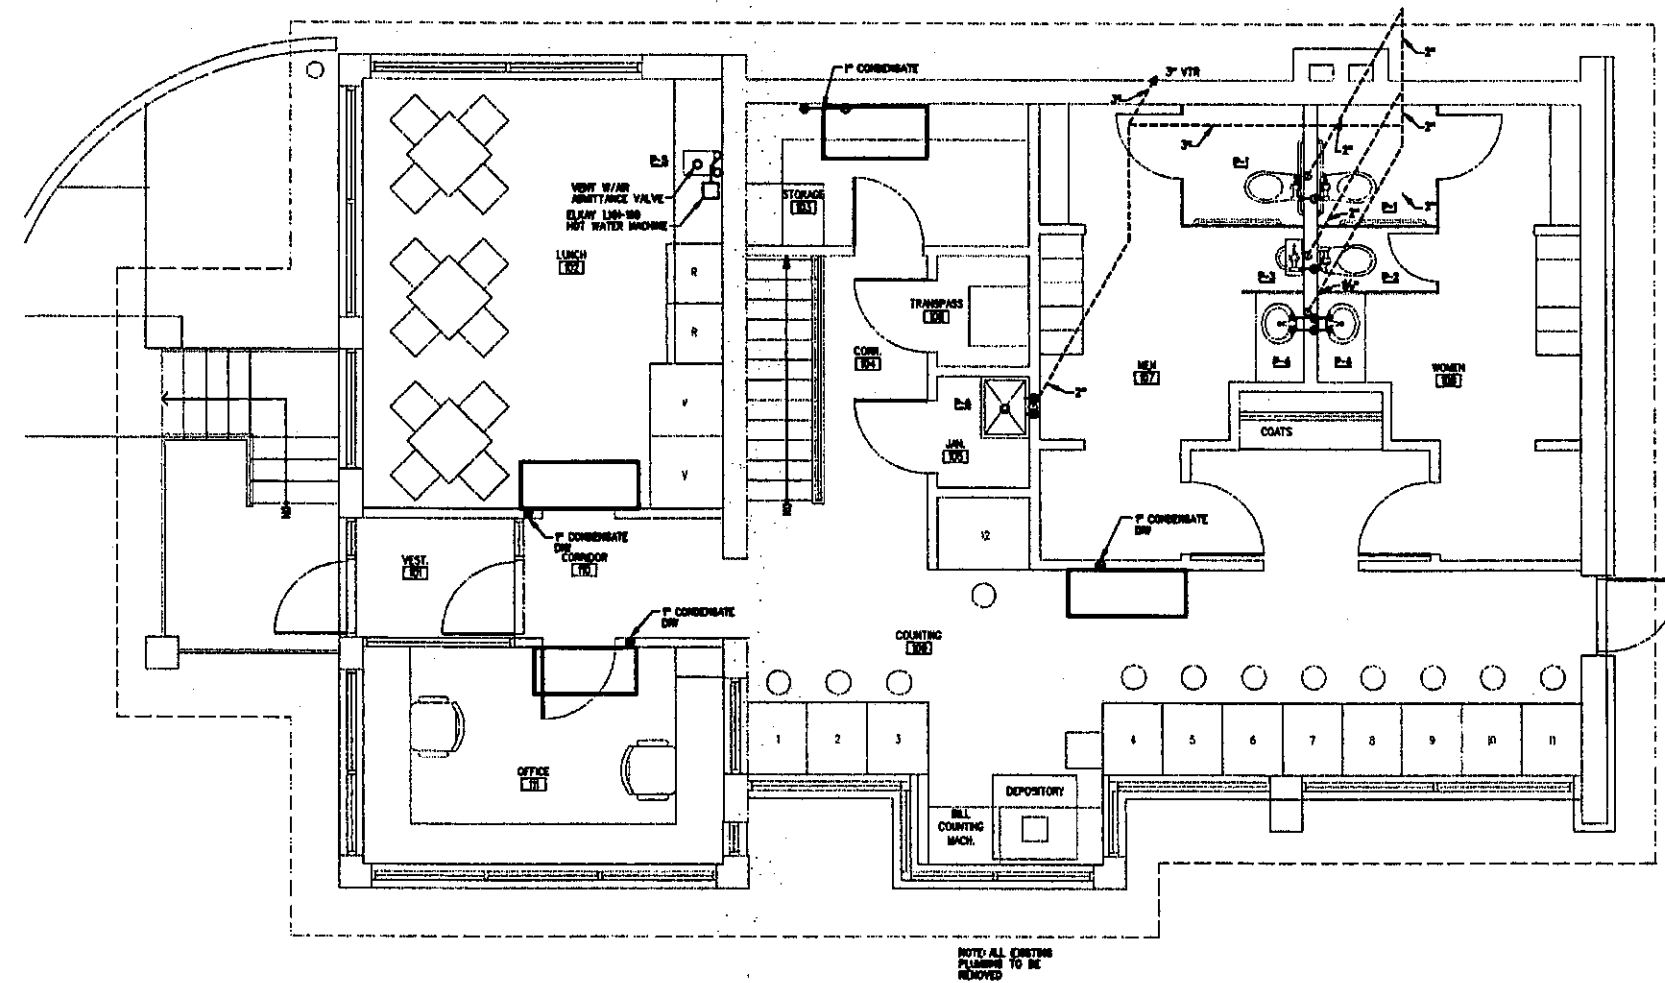

NOTE: ALL EXISTING PLUMBING TO BE REMOVED

No.	Revision	By	Date	In Charge Of:
		Designed	JMW	MAY 99
		Drawn	JMW	MAY 99
		Checked	LWS	JUN 99



WILLIAM S. BENNETT
 CONSULTING ENGINEERS
 BENNETT ROAD P.O. BOX 297
 FREEPORT, MAINE 04032
 (207) 865-8475

Maine Turnpike Authority Maine Turnpike	
	BUILDING RENOVATION AND EXPANSION
FIRST FLOOR PLUMBING PLAN	
HNTB ARCHITECTS ENGINEERS PLANNERS	
Contract YORK TOLL PLAZA - 99.7	Sheet No. 33 OF 38 P1.2



BFP PERFORMANCE SCHEDULE											
TAG	SIZE	H2O FLOW (GPM)	W.P.D (FT.WG)	AP FLOW (CFM)	THROW	HTGHT. (FEET)	ELECTRICAL REQUIREMENTS	BASIS OF DESIGN: STERLING			
							HP	WATTS	V/PH/Hz	SERVICE	MODEL
BT-1	1/2"	8.8	7.8	210	170	8	180V/60	180V/60	180V/60	180V/60	

UNIT HEATER PERFORMANCE SCHEDULE											
TAG	MIN	H2O FLOW (GPM)	W.P.D (FT.WG)	AP FLOW (CFM)	THROW	HTGHT. (FEET)	ELECTRICAL REQUIREMENTS	BASIS OF DESIGN: STERLING			
							HP	WATTS	V/PH/Hz	SERVICE	MODEL
UH-1	7.4	1.0	1.0	300	20	8	180V/60	180V/60	180V/60	180V/60	
UH-2	8.2	1.0	1.0	240	20	8	180V/60	180V/60	180V/60	180V/60	

AIR SEPARATOR PERFORMANCE SCHEDULE										
TAG	H2O FLOW (GPM)	W.P.D (FT.WG)	CV FACTOR (1/1 OR 1/2)	STRAINER (1/1 OR 1/2)	STRAINER (1/1 OR 1/2)	STRAINER (1/1 OR 1/2)	STRAINER (1/1 OR 1/2)	BASIS OF DESIGN: STERLING		
							HP	WATTS	V/PH/Hz	MODEL
AS-1	88	.17	200	1/2	270	180	180V/60	180V/60	180V/60	180V/60

HEAT RECOVERY VENTILATOR PERFORMANCE SCHEDULE										
TAG	EXHAUST CFM	SUPPLY CFM	EFF. %	HW AREA (SQ FT)	EFF. X	BASIS OF DESIGN: BOSSARD				
						HP	WATTS	V/PH/Hz	SERVICE	MODEL
HV-1	300	300	0.80	0.80	75	1/4	180V/60	180V/60	180V/60	180V/60

CONVECTOR/FTR PERFORMANCE SCHEDULE										
TAG	OUTPUT (BTU)	H2O FLOW (GPM)	W.P.D (FT.WG)	ENCL. HEIGHT (IN)	ENCL. LENGTH (IN)	ELEMENT LENGTH (IN)	BASIS OF DESIGN: STERLING			
							TUBE SIZE (IN)	FIN SIZE (IN)	FIN PITCH (IN)	MODEL
CONV-1	10	1.0	1.0	30	30	30	3/4	1/2	1/2	180-120
FTR-1	37.8	4.0	2.0	30	30	30	3/4	1/2	1/2	JWB-320
FTR-2	1.8	1.0	1.0	14	4	3	3/4	1/2	1/2	JWB-314
FTR-3	0.9	1.0	1.0	14	3	2	3/4	1/2	1/2	JWB-314
FTR-4	0.2	1.0	1.0	14	3	2	3/4	1/2	1/2	JWB-314
FTR-5	4.0	2.0	1.0	14	8	8	3/4	1/2	1/2	JWB-314
FTR-6	4.8	2.0	1.0	14	7	8	3/4	1/2	1/2	JWB-314
FTR-7	11.8	2.0	1.0	14	18	18	3/4	1/2	1/2	JWB-314
FTR-8	2.0	1.0	1.0	14	3	2	3/4	1/2	1/2	JWB-314
FTR-9	11.8	1.0	1.0	14	28	28	3/4	1/2	1/2	JWB-314

EXPANSION TANK PERFORMANCE SCHEDULE										
TAG	TANK VOLUME (GAL)	W.P.D (FT.WG)	W.P.D (FT.WG)	W.P.D (FT.WG)	W.P.D (FT.WG)	W.P.D (FT.WG)	BASIS OF DESIGN: TACO			
							HP	WATTS	V/PH/Hz	MODEL
ET-1	87	31	20.3	240	128	918	180V/60	180V/60	180V/60	180V/60

HEATING COIL PERFORMANCE SCHEDULE										
TAG	OUTPUT (BTU)	H2O FLOW (GPM)	W.P.D (FT.WG)	HTG. AIR FLOW (CFM)	MAX. AIR FLOW (CFM)	MAX. A.P.D (IN.WG)	E.A.T (DEGREES F)	L.A.T (DEGREES F)	SERVICE	
HC-1	14,000	1	.41	300	300	.08	40	70	SUPPLY AIR	



AIR DEVICE PERFORMANCE SCHEDULE										
TAG	SIZE	AP FLOW (CFM)	SP. LOSS (IN.WG)	THROW (1)	THROW (2)	No	BASIS OF DESIGN: KLEBER			
							DUST CONNECTION	PATTERN	MODEL	
(A)	8" x 8"	50	.018	2-5-10	-	120	8" x 8"	22.5° REFLECT	885V	
(B)	12" x 12"	200	.028	8-12-20	-	120	12" x 12"	22.5° REFLECT	885V	
(C)	12" x 12"	300	.038	-	-	120	12" x 12"	30° REFLECT	885V	
(D)	8" x 8"	50	.024	-	-	120	8" x 8"	30° REFLECT	885V	

LOUVER PERFORMANCE SCHEDULE										
TAG	AP FLOW (CFM)	SP LOSS (IN.WG)	HW VEL (FPM)	SIZE (INxH)	FREE AREA (SQ FT)	DRAINABLE (Y/N)	BLADE ANGLE & FRAME DEPTH	BASIS OF DESIGN: AMERICAN		
								WASHING AND VENTILATION	MODEL	
L-1	300	.030	300	24x24	0.70	Y	30°, 4"	SUPPLY	LE-23	
L-2	300	.030	300	24x24	0.70	Y	30°, 4"	BUILDING EXHAUST	LE-23	
L-3	200	.01	90	24x36	2.98	Y	30°, 6"	COMBUSTION	LE-31	
L-4	200	.01	90	24x36	2.98	Y	30°, 6"	BLR RM EXHAUST	LE-31	

CABINET UNIT HEATER PERFORMANCE SCHEDULE										
TAG	MIN	H2O FLOW (GPM)	W.P.D (FT.WG)	AP FLOW (CFM)	THROW	HTGHT. (FEET)	ELECTRICAL REQUIREMENTS	BASIS OF DESIGN: STERLING		
							HP	WATTS	V/PH/Hz	MODEL
CUH-1	9.8	1.0	.88	170	-	9'-0"	180V/60	180V/60	180V/60	180V/60
CUH-2	10.8	1.0	.88	170	-	9'-0"	180V/60	180V/60	180V/60	180V/60

FAN PERFORMANCE SCHEDULE											
TAG	AP FLOW (CFM)	T.S.P (IN.WG)	NOISE (DBS)	RPM	DRIVE	ELECTRICAL REQUIREMENTS				BASIS OF DESIGN: COOK	
						HP	WATTS	V/PH/Hz	SERVICE	ARRANGEMENT	MODEL
SF-1	200	.5	8.2	1440	DIRECT	1/4	78.37	180V/60	180V/60	180V/60	180V/60

PUMP PERFORMANCE SCHEDULE											
TAG	H2O FLOW (GPM)	HEAD (FT.WG)	W.P.D (FT.WG)	RPM	EFF. %	ELECTRICAL REQUIREMENTS				BASIS OF DESIGN: TACO	
						HP	WATTS	V/PH/Hz	SERVICE	ARRANGEMENT	MODEL
CP-1	31	20	4.8	1750	44	1/3	1/4	180V/60	180V/60	180V/60	180V/60
CP-2	21	20	4.8	1750	44	1/3	1/4	180V/60	180V/60	180V/60	180V/60

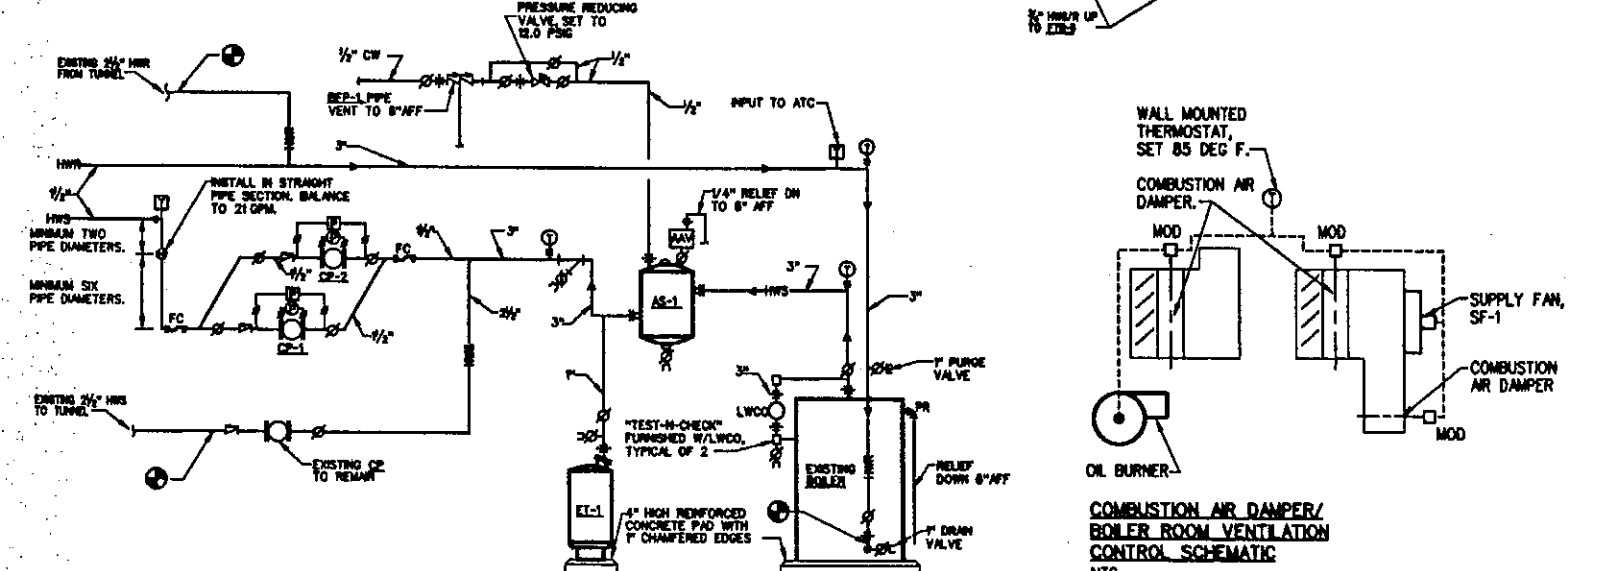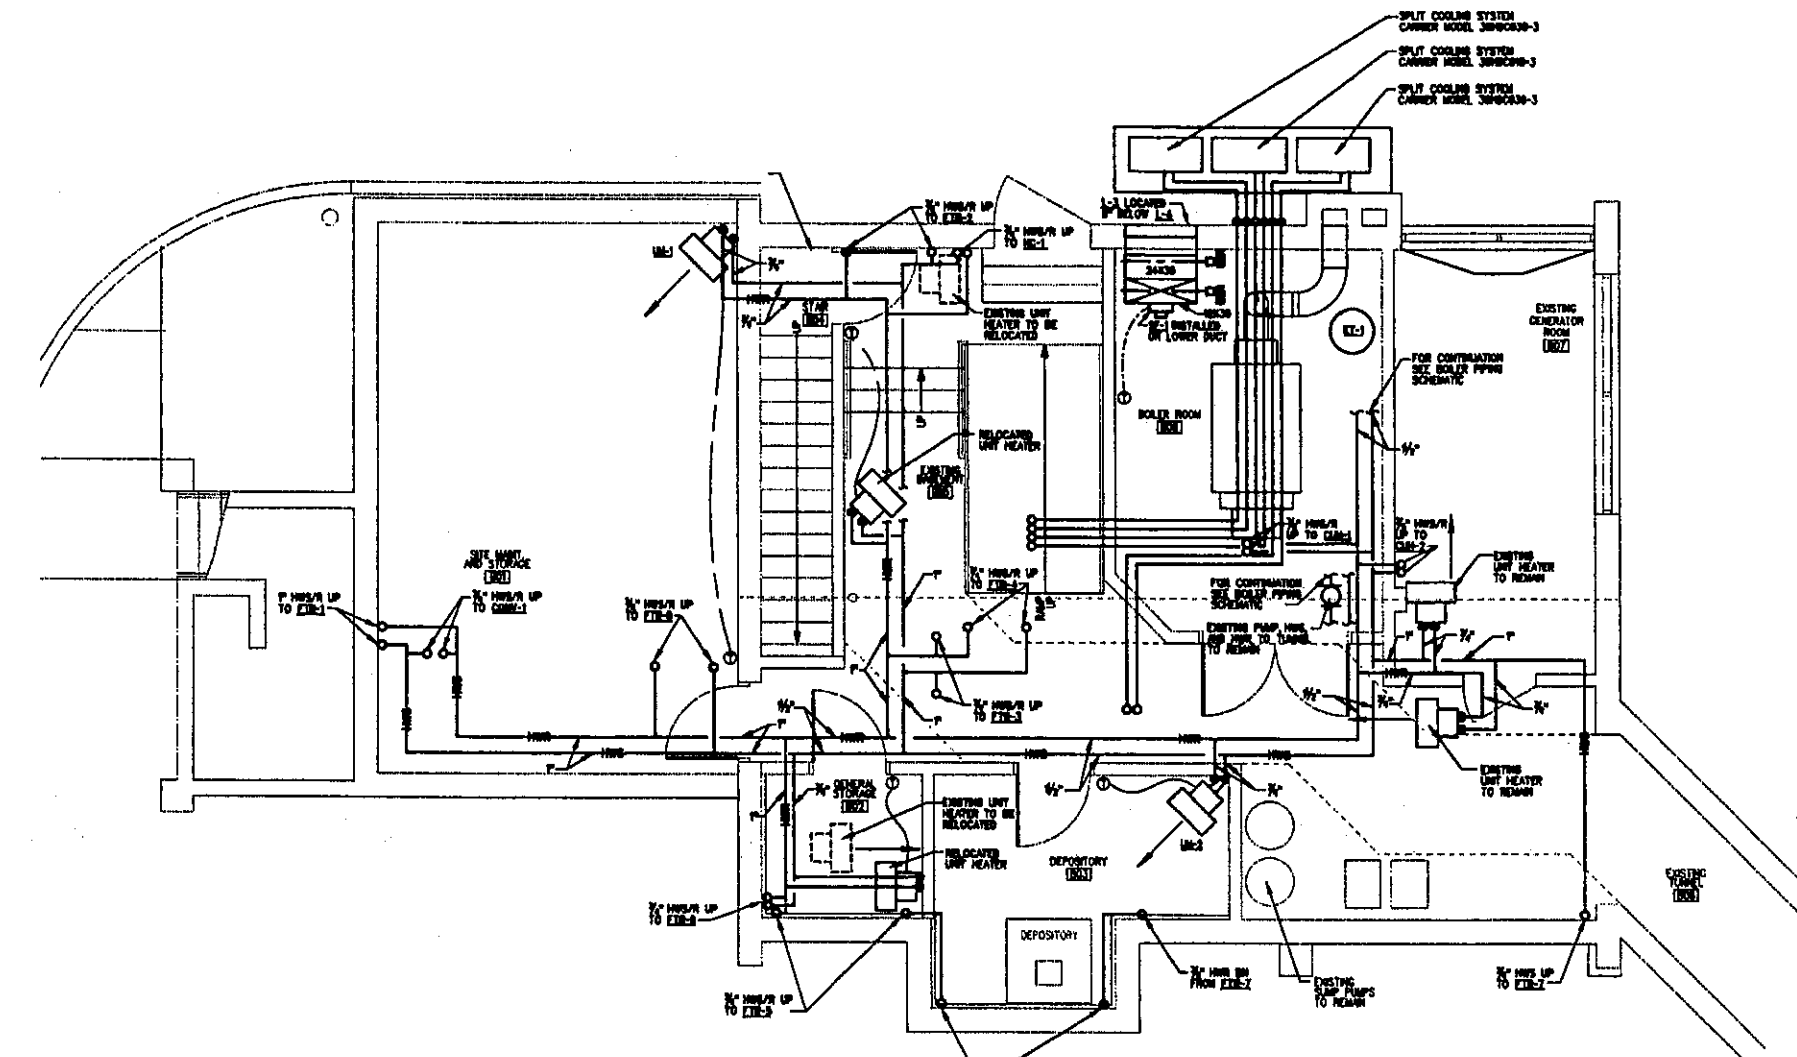

BOILER PIPING SCHEMATIC
NTS

COMBUSTION AIR DAMPER/
BOILER ROOM VENTILATION
CONTROL SCHEMATIC
NTS

NOTE: ALL EXISTING PIPING TO BE REMOVED EXCEPT AS NOTED

NOTE: EXISTING EXPANSION TANK TO BE REMOVED

NOTE: REMOVE EXISTING PIPING BACK TO THE BOILER HEADS EXCEPT AS NOTED

No.	Revision	By	Date	In Charge Of:
		Designed	1/14/88	
		Drawn	1/14/88	
		Checked	1/14/88	

Maine Turnpike Authority
Maine Turnpike

Trans
Express

BUILDING RENOVATION AND EXPANSION

BASEMENT MECHANICAL PLANS

HNTE
ARCHITECTS ENGINEERS PLANNERS

Contract YORK TOLL PLAZA - 99.7

Sheet No. 34 OF 38

M1.1




BENNETT ENGINEERS
CONSULTING ENGINEERS
BENNETT ROAD P.O. BOX 297
FREETPORT, MAINE 04032
(207) 860-9475




NOTES:

1. ALL EXISTING ELECTRICAL EQUIPMENT TO BE REMOVED UNLESS OTHERWISE NOTED
2. ALL WIRING ASSOCIATED WITH UTILITY TUNNEL/TOLL BOOTHS TO REMAIN.
3. FOR ALL EXISTING BASEMENT EQUIPMENT BEING RELOCATED - SEE DWG E2 FOR NEW LOCATION.
FOR ALL EXISTING FIRST FLOOR EQUIPMENT BEING RELOCATED - SEE DWG E3 FOR NEW LOCATION.

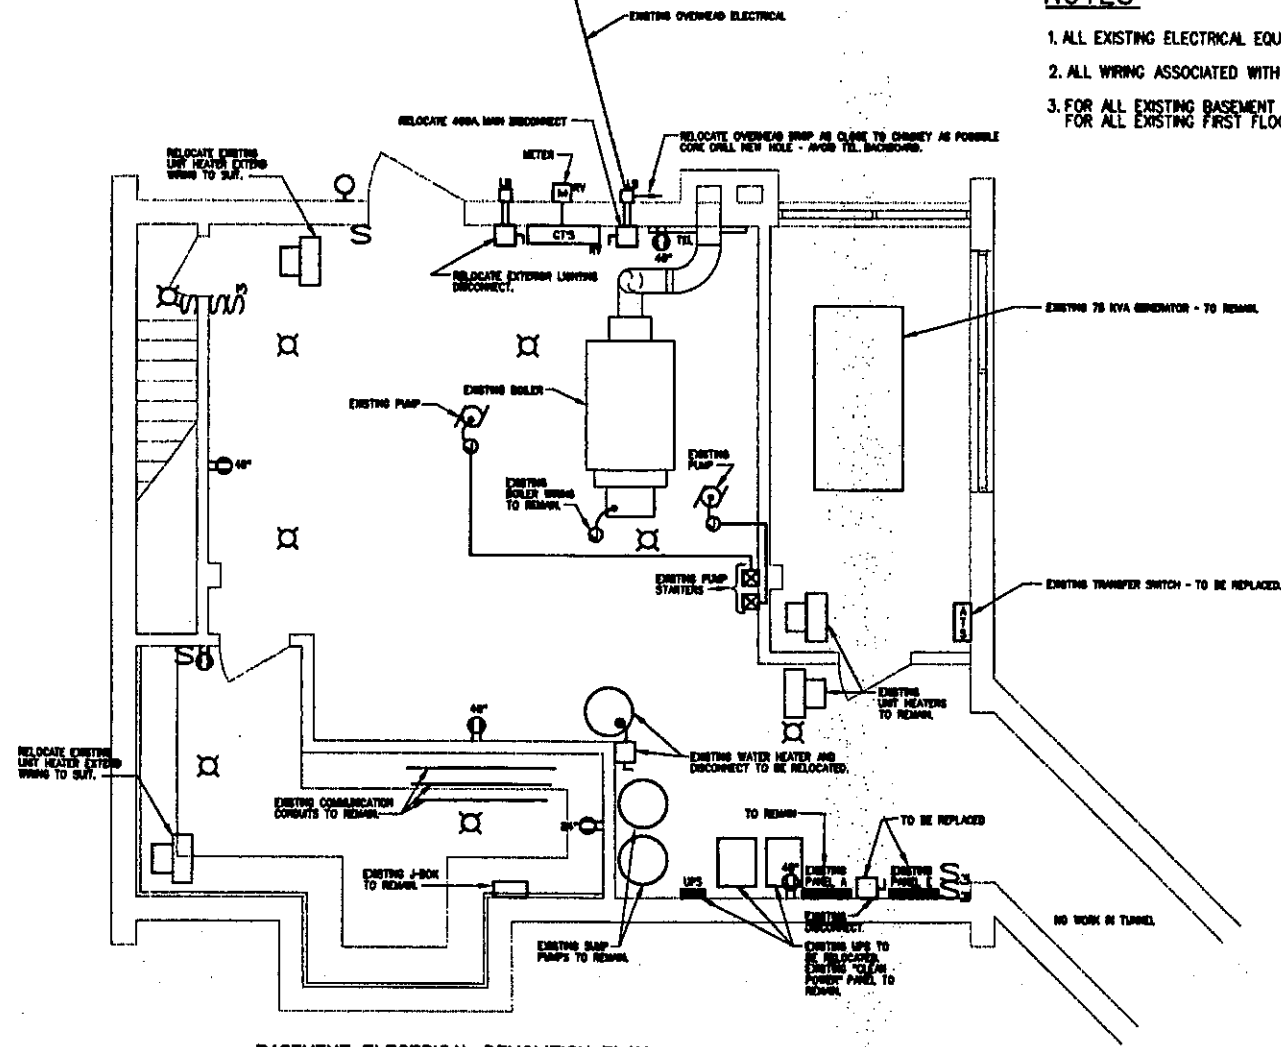

BASEMENT ELECTRICAL DEMOLITION PLAN
SCALE 1/4"=1'-0"

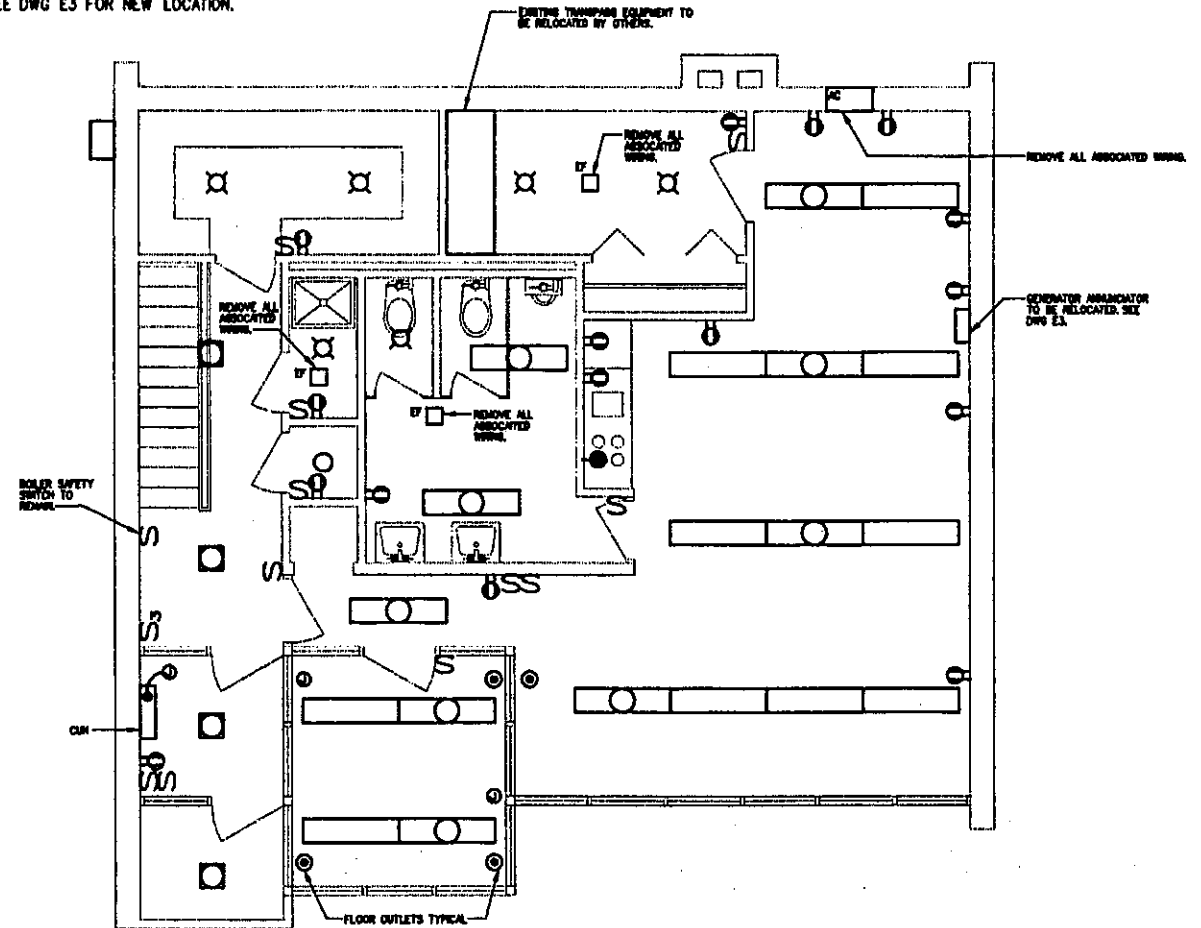


FIRST FLOOR ELECTRICAL DEMOLITION PLAN
SCALE 1/4"=1'-0"

PROJECT	THREE PHASE PANELBOARD SCHEDULE	PANEL DESIGNATION
YORK TOLL PLAZA YORK, MAINE		PANEL E - GENERATOR
MAIN LUGS: 220A	VOLTS: 120/208	PHASE: 3
		WIRE: 4
KVA LOAD		KVA LOAD
FIRST FLOOR LIGHTING	1-20	CRC. PUMP #1
TUNNEL LIGHTING	3-20	SPACE
FOG LIGHTS	5-20	GENERATOR ROOM
OL BURNER	7-20	EXISTING LOAD
ONLY ONE PHASE CONNECTED	21-20	EXISTING LOAD
EXISTING LOADS	13-20	TRAFFIC CONTROL
	14-20	CRC. PUMP #2
BOOTH PANELS (D, E, F, G, H)	18-20	UPS
	19-20	SPACE
SPACE	25-20	PANELS A, B, C
COMPUTER	27-20	
SPACE	28-20	
RANGE	31-20	BOOTH PANELS I, J, K, L
SPACE	36-20	
SPACE	37-20	WELL PUMP
EXISTING LOAD	38-20	
SPACE	41-20	
TOTAL CONN. LOAD		TOTAL DEM. LOAD

PROJECT	THREE PHASE PANELBOARD SCHEDULE	PANEL DESIGNATION
YORK TOLL PLAZA YORK, MAINE		PANEL A - GENERATOR
MAIN LUGS: 300A	VOLTS: 120/208	PHASE: 3
		WIRE: 4
KVA LOAD		KVA LOAD
FIRST FLOOR LIGHTING LOAD	1-20	FIRST FLOOR OUTLETS
FIRST FLOOR LIGHTING LOAD	3-20	FIRST FLOOR OUTLETS
SPARE	5-20	FIRST FLOOR OUTLETS
LOAD	7-20	BASEMENT OUTLETS
BOILER ROOM LOAD	9-20	SPARE
LOAD	11-20	LIFT HEATERS
LOAD	13-20	AREA LIGHTING
SPARE	15-20	AREA LIGHTING
WATER HEATER	17-20	AIR CONDITIONER
TOTAL CONN. LOAD		TOTAL DEM. LOAD

By	Date			
Designed	JSBR 8/4/98			
Drawn	SB 8/4/98			
Checked	CWA 8/4/98			
No.	Revision	By	Date	In Charge Of:
Maine Turnpike Authority Maine Turnpike				
BUILDING RENOVATION AND EXPANSION				
BASEMENT AND FIRST FLOOR ELECTRICAL DEMOLITION PLANS				
HNTB ARCHITECTS ENGINEERS PLANNERS				
Contract		Sheet No.		
YORK TOLL PLAZA - 99.7		36 OF 38 E1		

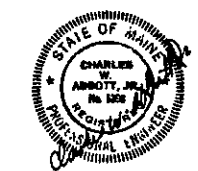


HNTB
CONSULTING ENGINEERS
BENNETT ROAD P.O. BOX 297
FREETOWN, MAINE 04032
(207) 860-9475



SYMBOL LEGEND



- POWER PANEL 120/208, 3PHS, 4WIRE
- ⊕ ELECTRIC MOTOR DRIVEN EQUIPMENT, HP SHOWN
- ⊖ UNFUSED DISCONNECT SWITCH - 250 VOLT SIZE & NO. POLES AS NOTED.
- SM MANUAL MOTOR STARTER SWITCH WITH THERMAL OVERLOAD DEVICE, MOUNTED AT UNIT
- ⊙ JUNCTION BOX
- ⊕ LIGHTING FIXTURES- CAPITAL LETTERS DENOTE TYPE AS PER LIGHTING FIXTURE SCHEDULE, LOWER CASE LETTERS INDICATE SWITCH CONTROL.
- ⊕ EXIT LIGHT FIXTURE-UNSWITCHED
- RACEWAY & WIRING OR MC CABLE RUN CONCEALED IN WALLS/CeilINGS.
- - - RACEWAY & WIRING RUN EXPOSED
- RACEWAY & WIRING RUN CONCEALED UNDER FLOOR
- LP1 → HOME RUN TO PANEL - ARROWS INDICATE QUANTITY OF CIRCUITS - NUMERALS DENOTE CIRCUIT NUMBERS
- EB1 → HOME RUN TO EMERG. BATTERY UNIT 12 VOLTS D.C.
- CONDUIT TURNING UP
- CONDUIT TURNING DOWN
- ⊕ COMBINATION CIRCUIT BREAKER & MAGNETIC MOTOR STARTER - NEMA SIZE 1 1/4 AIX CONTACTS AND HAND-OFF-AUTO SWITCH W/RED POWER ON PILOT LIGHT.
- S SINGLE POLE SWITCH, 120 VOLT, 20 AMP, SPEC GRADE, GROUNDING TYPE, MOUNT 48" AFF, 3-3-WAY, 4-4-WAY, P-PILOT, WP-WEATHERPROOF, LOWER CASE LETTER INDICATES FIXTURE OR CONTROLLED LOAD, PILOT LIGHT SWITCHES SHALL BE PROVIDED W/ ENGRAVED NAMEPLATE IDENTIFYING USE.
- ⊖ DUPLEX RECEPTACLE - 20A, 125V SPEC GRADE GROUNDING TYPE AND MATCHING IVORY PLATE - MOUNT 24" AFF. "R" DENOTES REFRIGERATOR - "D" DENOTES 2 DUPLEX OUTLETS IN A 2 GANG BOX
- ⊖ DUPLEX RECEPTACLE - GROUND FAULT OUTLET 20A, 125V- WITH MATCHING IVORY PLATE FURNISHED W/ OUTLET, FLUSH MOUNTED 45" AFF EXCEPT AS NOTED.
- ⊕ FIRE ALARM HEAT DETECTOR, FIXED TEMPERATURE 130°F -120 VOLTS
- FT ⊕ FIRE ALARM HEAT DETECTOR, FIXED TEMPERATURE 200°F
- ⊕ SMOKE DETECTOR, PHOTOELECTRIC TYPE- SYSTEM CONNECTED
- ⊕ HEAT DETECTOR
- ⊕ FIRE ALARM CONTROL PANEL SURFACE MOUNT 78" AFF TO TOP
- ⊕ FIRE ALARM PULL STATION MOUNT 48" AFF
- ⊕ FIRE ALARM AUDIO/VISUAL, MOUNT 8'-8" AFF - "M" DENOTES MINIMORN
- SD FIRE ALARM VISUAL STROBE ONLY
- ⊕ DIGITAL ALARM COMMUNICATOR TRANSMITTER
- ⊕ TELEPHONE CONNECTION MOUNT 18" AFF - W/1-4 PAIR CABLE TO TEL. BACKBOARD
- PLUGMOLD - 8" O.C.
- WP DENOTES WEATHERPROOF CONSTRUCTION
- RM DENOTES EXISTING ELECTRICAL EQUIPMENT TO REMAIN.
- RL DENOTES EXISTING ELECTRICAL EQUIPMENT TO BE RELOCATED.
- RV DENOTES EXISTING ELECTRICAL EQUIPMENT TO BE REMOVED.

SHORT CROSS LINES INDICATE QUANTITY OF #12 AWG WIRES IN CABLE OR IN 3/4" WHEN GREATER THAN TWO. ABSENCE OF CROSS LINES INDICATES 2 #12 AWG WIRES. ASTERISK INDICATES #10 AWG FOR ALL CIRCUITS CONTAINED IN HOMERUN.

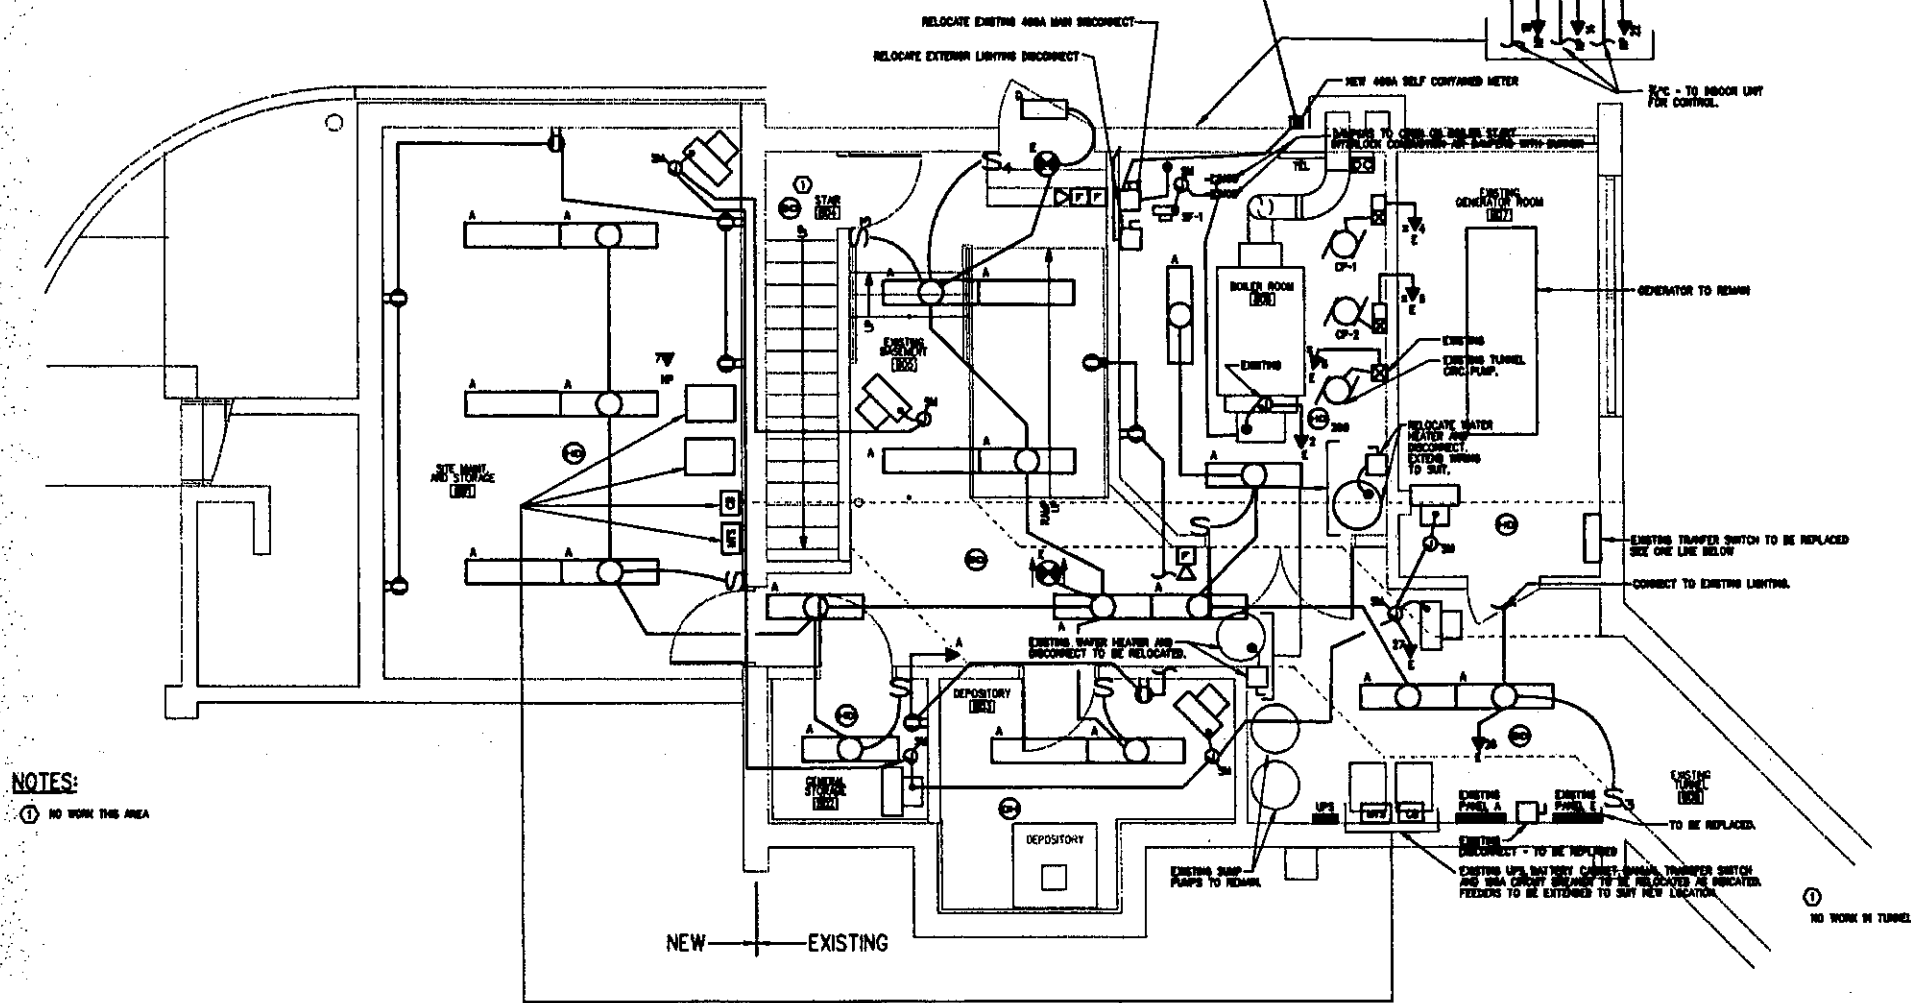


NOTES:
 ① NO WORK THIS AREA
 ② NO WORK IN TUNNEL

BASEMENT ELECTRICAL PLAN
 SCALE 1/4"=1'-0"

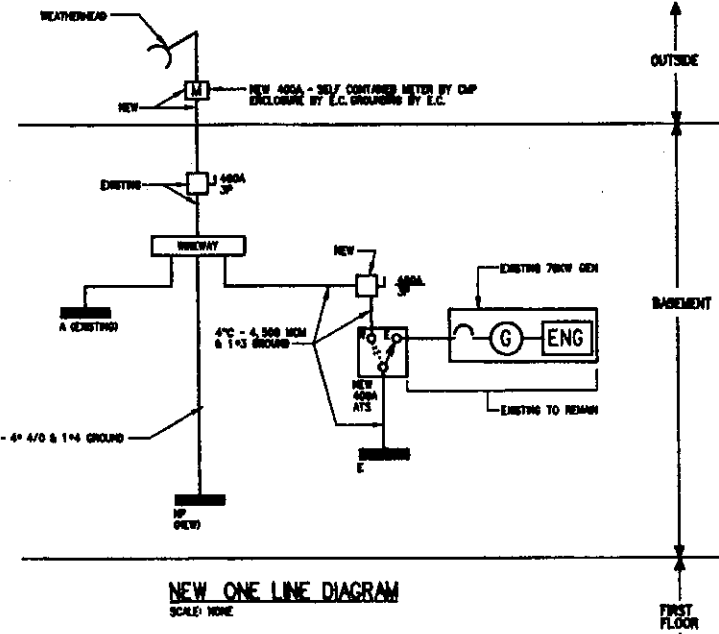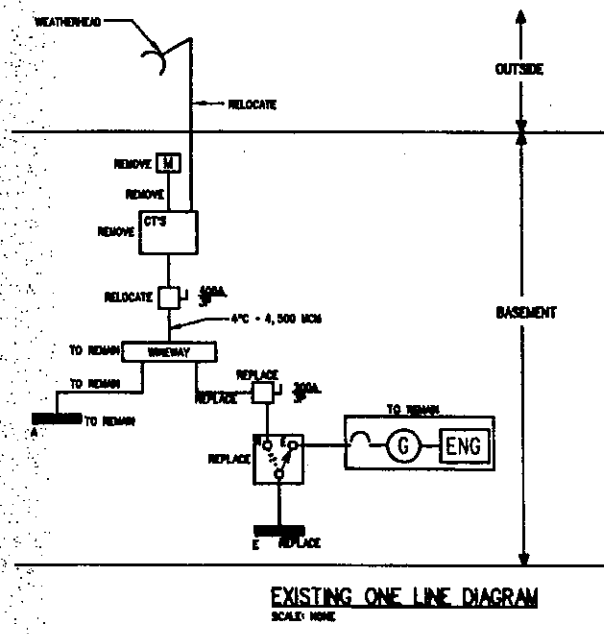

BENNETT
 CONSULTING ENGINEERS
 BENNETT ROAD P.O. BOX 297
 FREEPORT, MAINE 04032
 (207) 863-9475

By	Date			
Designed	WBR 8/4/98			
Drawn	SB 8/4/98			
Checked	CRH 8/4/98			
No.	Revision	By	Date	In Charge Of:
Maine Turnpike Authority Maine Turnpike				
BUILDING RENOVATION AND EXPANSION				
BASEMENT ELECTRICAL PLAN, LEGEND AND ONE LINE DIAGRAMS				
HNTB ARCHITECTS ENGINEERS PLANNERS				
Contract		Sheet No.		
YORK TOLL PLAZA - 99.7		37 OF 38 E2		

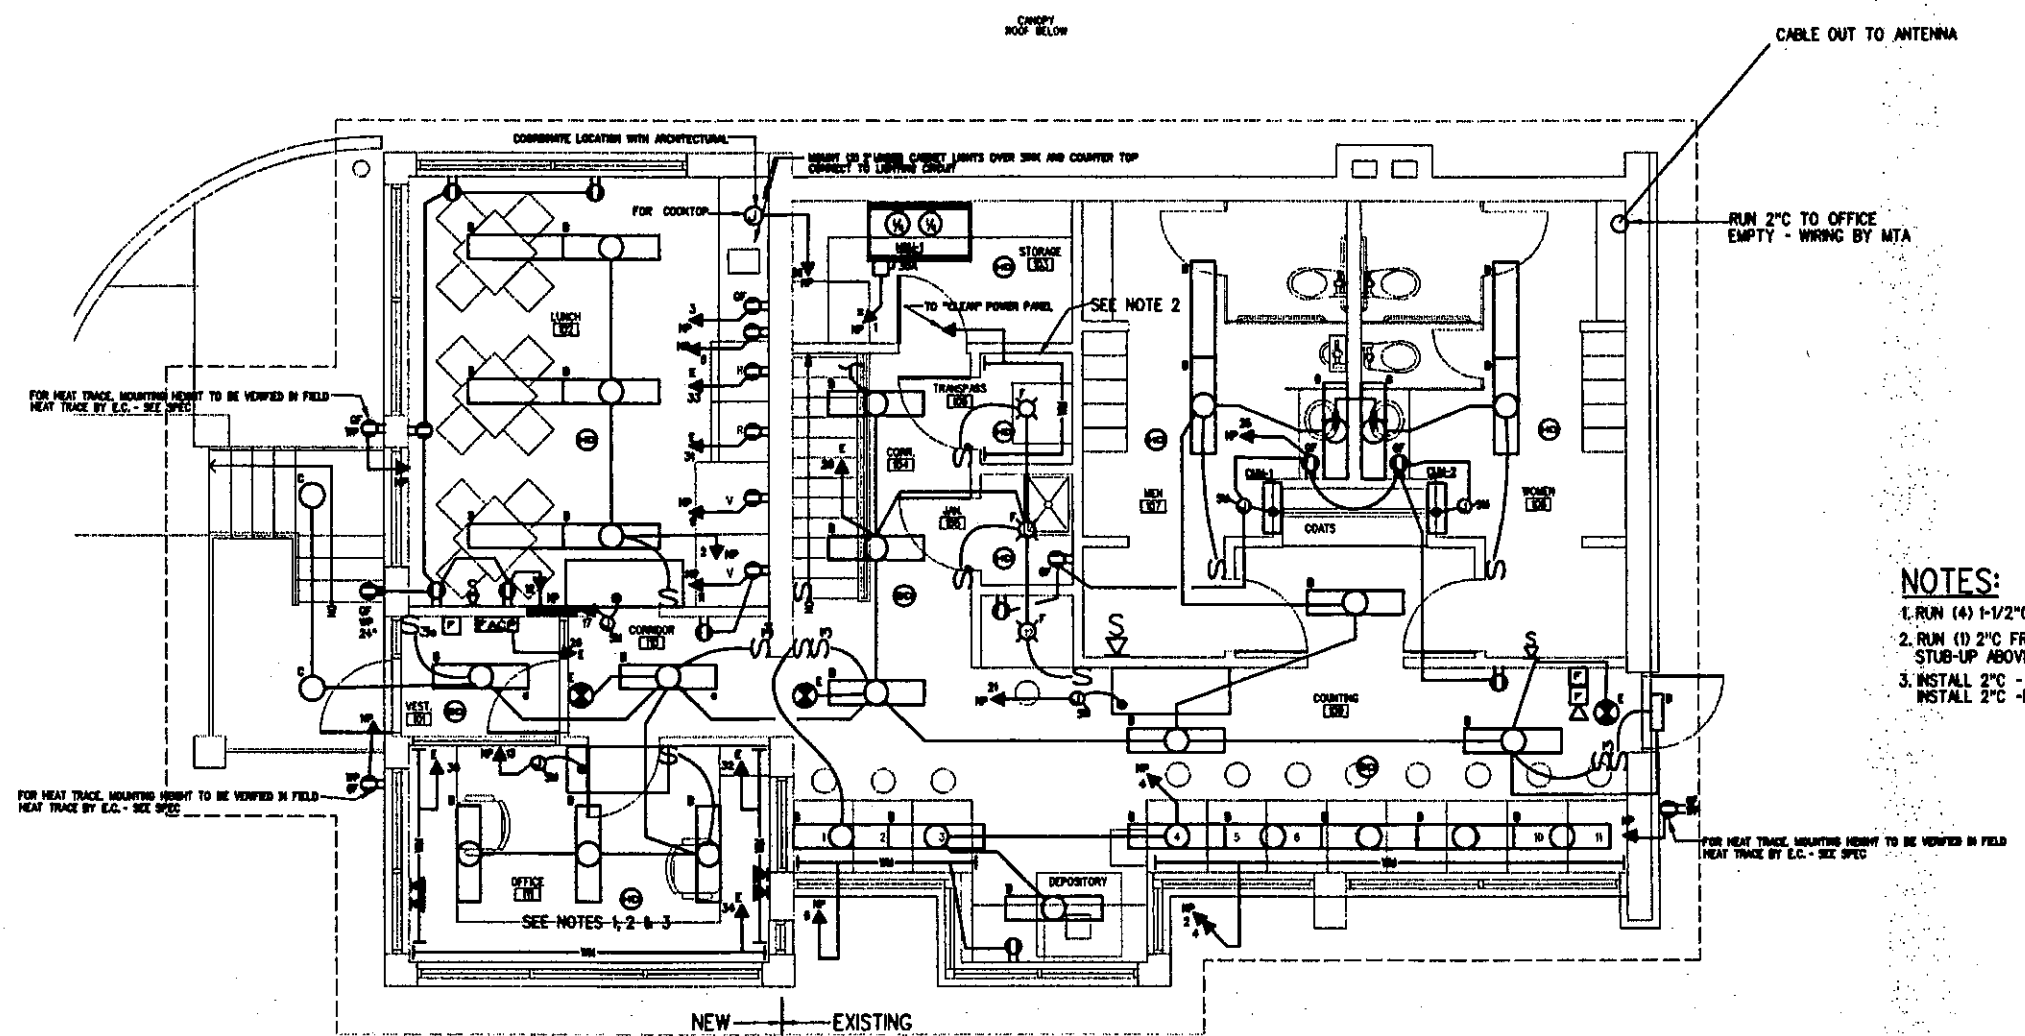

NOTES:

1. RUN (4) 1-1/2" C - EMPTY FROM OFFICE TO BASMENT. STUP ABOVE AND BELOW FLOOR AND CAP FOR FUTURE.
2. RUN (1) 2" C FROM TELEPHONE BACKBOARD TO TRANSPASS ROOM. RUN (1) 2" C FROM TRANSPASS ROOM TO OFFICE. STUB-UP ABOVE FLOOR. VERIFY LOCATION WITH HNTB
3. INSTALL 2" C - EMPTY TO TUNNEL FOR RADIO COMMUNICATIONS. SPLICE CONDUIT INTO EXISTING - WRING BY MTA. INSTALL 2" C - EMPTY FROM OFFICE TO BACK CORNER FOR ANTENNA CABLE. WRING BY MTA.

FIRST FLOOR ELECTRICAL PLAN
SCALE 1/8" = 1'-0"

PROJECT YORK TOLL PLAZA YORK, MAINE		THREE PHASE PANELBOARD SCHEDULE		PANEL DESIGNATION PANEL E - (NEW)	
MAIN LUGS 400A		VOLTS 120/208		JUNIOR 3	
KVA LOAD					KVA LOAD
0	TUNNEL PANELS (A, B, C)	1	20	2	BOLER
0		3	20	4	CP-1
0		5	20	6	CP-2
0	TUNNEL PANELS (D, E, F, G, H)	7	20	8	CP-3 (TUNNEL) & EXH. PUMP
0		9	20	10	
0		11	20	12	
0	TUNNEL PANELS (I, J, K, L)	13	20	14	WELL PUMP
0		15	20	16	
0		17	20	18	SEWAGE EJECT.
0	UPS	19	20	20	
0		21	20	22	FOG LIGHTS
0	TRAFFIC CONTROL	23	20	24	TUNNEL LIGHTS
0	GENERATOR POWER	25	20	26	BASMENT LIGHTING
1.5	UNIT HEATERS	27	20	28	UPSTAIRS LIGHTING
0.5	FACP	29	20	30	OFFICE OUTLETS
1.5	REFRIGERATOR	31	20	32	
1.0	REFRIGERATOR	33	20	34	
0	EXISTING LOAD	35	20	36	SPACE
0		37	20	38	
0		39	20	40	
0	SPACE	41	20	42	
TOTAL CONN. LOAD		TOTAL DEM. LOAD			

PROJECT YORK TOLL BOOTH YORK, MAINE		THREE PHASE PANELBOARD SCHEDULE		PANEL DESIGNATION P	
MAIN LUGS 250A		VOLTS 120/208		JUNIOR 3	
KVA LOAD					KVA LOAD
1.5	HV-1	1	20	2	LIGHTING - LOUNGE
1.5	MICROWAVE	3	20	4	LIGHTING - CABIN-UP
1.5	MICROWAVE	5	20	6	PLUMBOLD
1.0	OUTLETS - STORAGE	7	20	8	PLUMBOLD
0.5	VENDING	9	20	10	PLUMBOLD
0.5	VENDING	11	20	12	OUTLETS - LOUNGE
1.5	AC-1	13	20	14	CU-1
1.5	AC-2	17	20	18	CU-2
1.5	AC-3	21	20	22	CU-3
1.5		23	20	24	
1.4	OUTLETS & CUPS	25	20	26	COOKTOP
1.5	HEAT TRACE	27	20	28	SPACE
1.5	HEAT TRACE	29	20	30	
1.5	HEAT TRACE	31	20	32	
0	SPACE	33	20	34	
0		35	20	36	
0		37	20	38	
0		39	20	40	
0		41	20	42	
TOTAL CONN. LOAD		TOTAL DEM. LOAD			

LIGHTING FIXTURE SCHEDULE			
TYPE	DESCRIPTION	LAMPS QUANTITY & TYPE	REMARKS
A	COLUMBIA*CS4 -323-EB8-120	2-32T8-SPX35	CHAIN HUNG W/WIREGUARD CSWG4
B	COLUMBIA*WC4-232-EB8-120	2-32T8-SPX35	SURFACE MOUNT
C	KENALL*MR17-FDS-MW42P-3-120-BOPC	3-42PL	SURFACE MOUNT UNDER CANOPY
D	SPAULDING *WGRI-S100-120-PC	1- 100WMI	WALL MOUNT ABOVE DOOR WITH PHOTOCELL.
E	PRESCOLITE*PEX-L-3-R-EN-120	LEDS SUPPLIED W/UNIT	BACK OR TOP MOUNT

No.	Revision	By	Date	In Charge Of:
		Designed	WSR	8/4/98
		Drawn	SD	8/4/98
		Checked	CWA	8/4/98



BENNETT ENGINEERS
CONSULTING ENGINEERS
BENNETT ROAD P.O. BOX 297
FREEPORT, MAINE 04032
(207) 865-8475

Maine Turnpike Authority
Maine Turnpike

Trans
Express

HNTB
ARCHITECTS ENGINEERS PLANNERS


Contract YORK TOLL PLAZA - 99.7
Sheet No. 38 OF 38 **E3**

MAINE TURNPIKE



MAINE TURNPIKE AUTHORITY

SAMUEL M. ZAITLIN, CHAIRMAN
 PATRICK F. BUTLER, VICE CHAIRMAN
 LUCIEN B. GOSSELIN, MEMBER
 EARL L. ADAMS, MEMBER
 JOHN G. MELROSE, MEMBER EX-OFFICIO
 JANE. L. LINCOLN, MEMBER EX-OFFICIO
 PAUL E. VIOLETTE, EXECUTIVE DIRECTOR

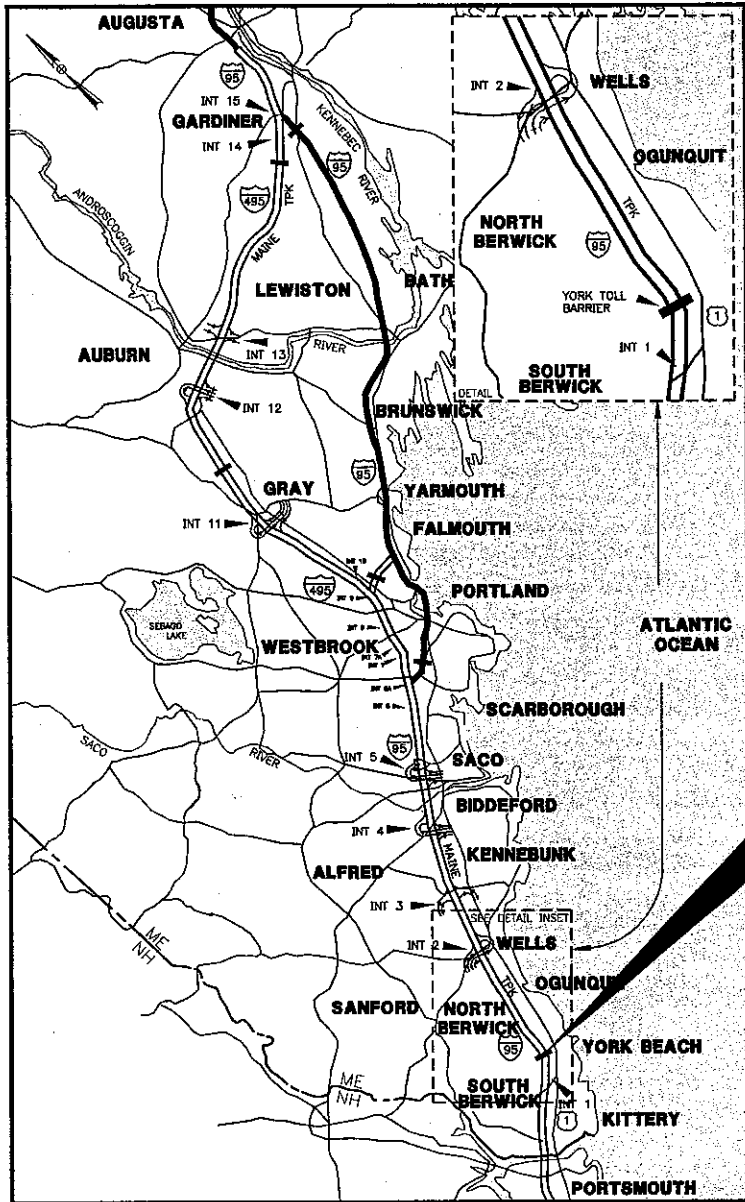

CONTRACT 2001.15
 YORK TOLL PLAZA
 CANOPY EXTENSION
 MILE 5.75

CONTRACT 2001.15 YORK TOLL PLAZA CANOPY EXTENSION MM 5.75

LOCATION MAP

INDEX OF SHEETS

SHEET NO.	DRAWING NO.	DESCRIPTION
1	-	TITLE SHEET
2	C-1	GENERAL NOTES AND ESTIMATED QUANTITIES
3	S-1	PLAN AND ELEVATION
4	S-2	CANOPY REMOVAL
5	S-3	FRAMING PLAN
6	S-4	FRAMING DETAILS I
7	S-5	FRAMING DETAILS II
8	S-6	CANOPY SIGNS TYPICAL DETAILS
9	S-7	OVERHEAD SIGN SUPPORT DETAILS
10	E-1	ELECTRICAL DEMOLITION PLAN AND ELEVATIONS
11	E-2	ELECTRICAL PLAN AND ELEVATIONS

STATE OF MAINE
 DEPARTMENT OF TRANSPORTATION

COMMISSIONER _____ DATE _____
 BUREAU DIRECTOR AND CHIEF ENGINEER _____ DATE _____



ARCHITECTS ENGINEERS PLANNERS



Roland A. Lavalley
 ROLAND A. LAVALLEY P.E., PLS
 VICE PRESIDENT
 DIRECTOR OF OPERATIONS
 DATE 8/16/01

APPROVED:
 MAINE TURNPIKE AUTHORITY

 CHAIRMAN

 EXECUTIVE DIRECTOR

 DATE

GENERAL NOTES

SPECIFICATIONS

DESIGN

AASHTO STANDARD SPECIFICATIONS FOR HIGHWAY BRIDGES
16TH EDITION, 1996 WITH LATEST INTERIMS.

CONSTRUCTION

STATE OF MAINE, DEPARTMENT OF TRANSPORTATION STANDARD
SPECIFICATIONS, HIGHWAYS AND BRIDGES, REVISION OF APRIL
1995.

MATERIALS

CONCRETE

CONCRETE SHALL BE CLASS A.

STRUCTURAL STEEL

STRUCTURAL STEEL SHALL BE AASHTO M270, GRADE 36

BASIC ALLOWABLE STRESSES

CONCRETE


$f'_c = 4,000$ P.S.I.

STRUCTURAL STEEL

AASHTO M270 GRADE 36 $F_y = 36,000$ P.S.I.

INDEX OF DRAWINGS	
C-1	GENERAL NOTES, INDEX, AND ESTIMATED QUANTITIES
S-1	PLAN AND ELEVATION
S-2	CANOPY REMOVAL
S-3	FRAMING PLAN
S-4	FRAMING DETAILS I
S-5	FRAMING DETAILS II
S-6	CANOPY SIGNS TYPICAL DETAILS
S-7	OVERHEAD SIGN SUPPORT DETAILS
E-1	ELECTRICAL DEMOLITION PLAN AND ELEVATIONS
E-2	ELECTRICAL PLAN AND ELEVATIONS

ITEM	DESCRIPTION	UNIT	QUANTITY
202.12	CONCRETE DEMOLITION	5	CY
203.20	COMMON EXCAVATION	5	CY
304.10	AGGREGATE SUBBASE COARSE - GRAVEL	5	CY
403.07	HOT BITUMINOUS PAVEMENT, GRADING B	5	TON
419.30	SAWING BITUMINOUS PAVEMENT	60	LF
501.50	STEEL H-BEAM PILES 42 LBS/FT DELIVERED	400	LF
501.50	STEEL H-BEAM PILES 42 LBS/FT IN PLACE	400	LF
501.90	PILE TIPS	5	EA
501.91	PILE SPLICES	5	EA
501.93	AUGERED PILE SHAFTS, CASINGS AND BACKFILL	5	EA
502.455	MISCELLANEOUS STRUCTURAL CONCRETE	7	CY
613.319	TEMPORARY EROSION CONTROL BLANKET	30	SY
615.07	LOAM	5	CY
618.13	SEEDING - METHOD NO. 1	1	UNIT
619.12	MULCH	1	UNIT
629.05	HAND LABOR - STRAIGHT TIME	40	MH
629.06	ELECTRICIAN - STRAIGHT TIME	40	MH
631.12	ALL PURPOSE EXCAVATOR (INCLUDING OPERATOR)	10	HR
631.173	TRUCK - LARGE (INCLUDING OPERATOR)	20	HR
606.36	FOREMAN	10	HR
652.30	FLASHING ARROW BOARD	2	EA
652.33	DRUM	50	EA
652.35	CONSTRUCTION SIGNS	426	SF
652.361	MAINTENANCE OF TRAFFIC CONTROL DEVICES	1	LS
656.50	BALED HAY, IN PLACE	20	EA
656.032	30" TEMPORARY SILT FENCE	100	LF
659.10	MOBILIZATION	1	LS
800.501	TOLL CANOPY EXTENSION - WEST END	1	LS
800.502	TOLL CANOPY EXTENSION - EAST END	1	LS

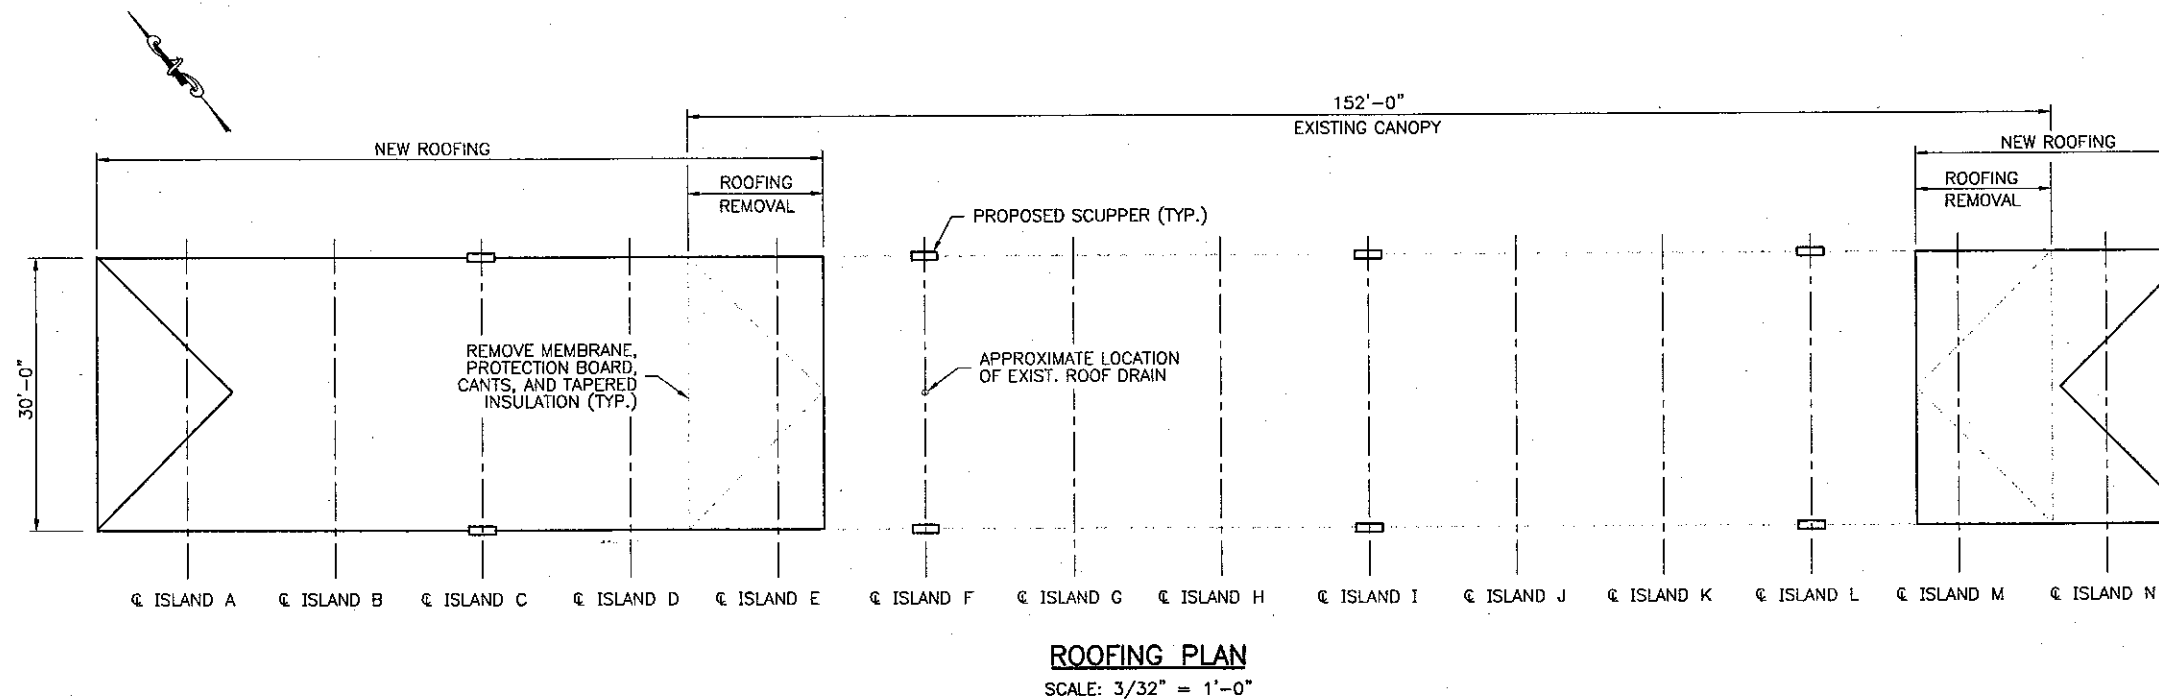


- NOTES:**
- SEE SHEET S-5 FOR SECTIONS.
 - INSTALL SCUPPERS IN NEW AND EXISTING ROOF EACH SIDE AT ISLANDS C, F, I & L.
 - REPLACE DRAIN WITH 4 INCH ZURN Z-105-EA-2-C CONTROL-FLO ROOF DRAIN WITH ALUMINUM DOME.


152'-0" YORK CANOPY EXTENSION INDEX 06-09-01 11:13

<p>Scale:</p>	<p>Designed by:</p> <div style="text-align: center;"> </div>	<p>HNTB CORPORATION 2 Thomas Drive Westbrook, ME 04092 TEL (207) 774-5155 FAX (207) 772-7410</p>	<p style="text-align: center; font-weight: bold; font-size: 1.2em;">MAINE TURNPIKE AUTHORITY</p> <div style="text-align: center;"> </div>	<p style="font-weight: bold; font-size: 1.1em;">YORK TOLL PLAZA CANOPY EXTENSION GENERAL NOTES, INDEX, AND QUANTITIES</p>																				
<table border="1" style="width: 100%; border-collapse: collapse;"> <thead> <tr> <th>No.</th> <th>Revision</th> <th>By</th> <th>Date</th> </tr> </thead> <tbody> <tr> <td> </td> <td> </td> <td> </td> <td> </td> </tr> </tbody> </table>	No.	Revision	By	Date					<table border="1" style="width: 100%; border-collapse: collapse;"> <thead> <tr> <th>By</th> <th>Date</th> <th>By</th> <th>Date</th> </tr> </thead> <tbody> <tr> <td>Designed CAH</td> <td>8/01</td> <td>Checked CAH</td> <td>8/01</td> </tr> <tr> <td>Drawn TRC</td> <td>8/01</td> <td>In Charge of RAL</td> <td>8/01</td> </tr> </tbody> </table>	By	Date	By	Date	Designed CAH	8/01	Checked CAH	8/01	Drawn TRC	8/01	In Charge of RAL	8/01	<p>CONTRACT: 2001.15</p>		<p>SHEET NUMBER: C-1 2 OF 11</p>
No.	Revision	By	Date																					
By	Date	By	Date																					
Designed CAH	8/01	Checked CAH	8/01																					
Drawn TRC	8/01	In Charge of RAL	8/01																					


H:\H0909XW\005\006 YORK CANOPY EXTENSION\S1-SITEPLAN.DWG 08/15/01 10:53

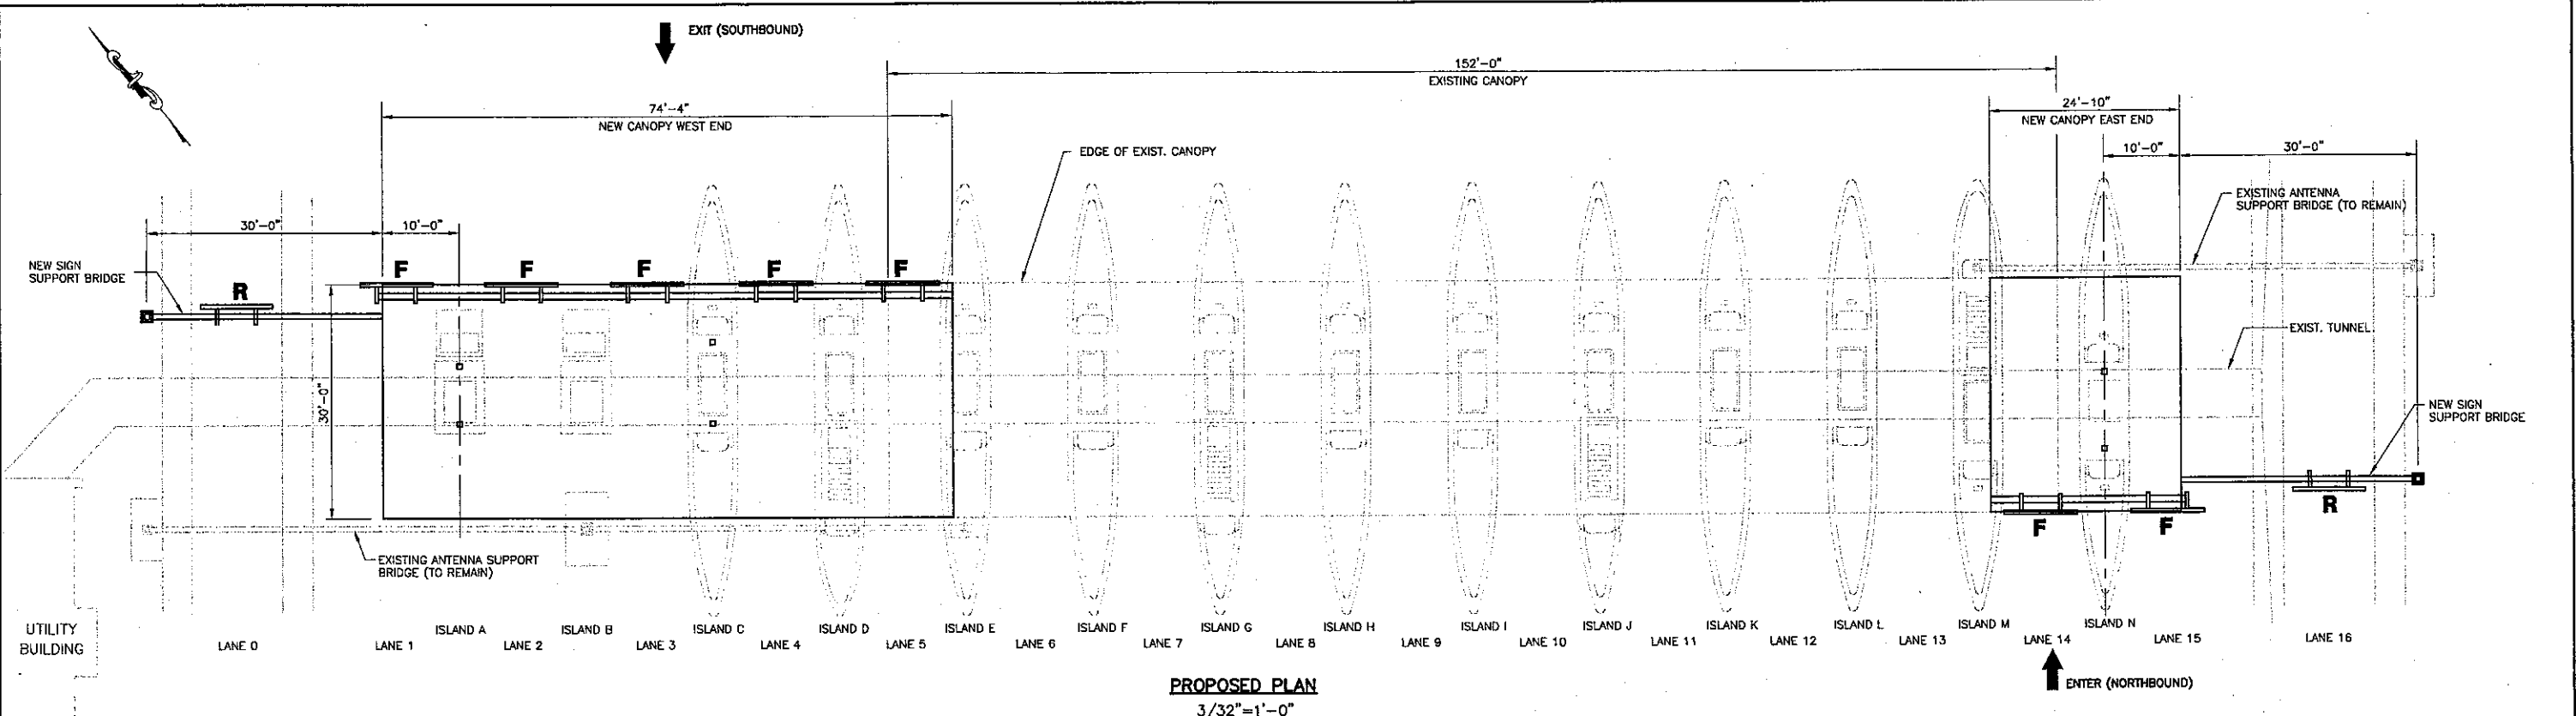

PROPOSED PLAN
3/32"=1'-0"

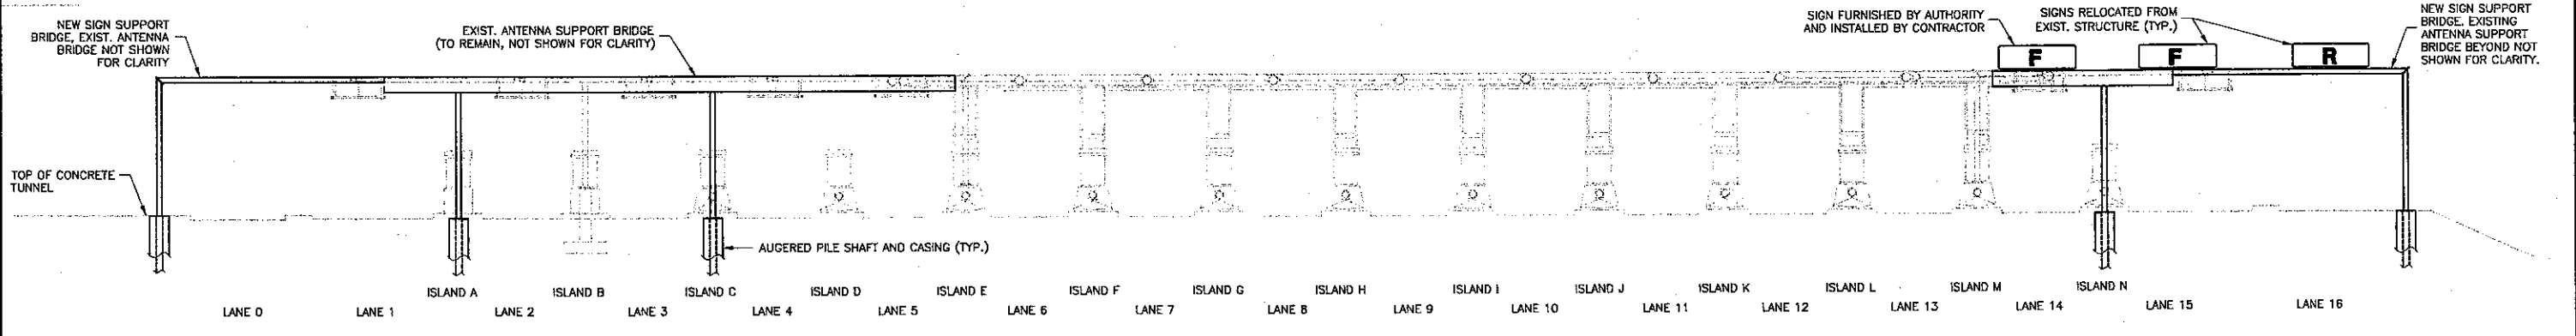

PROPOSED ELEVATION - LOOKING NORTH
3/32"=1'-0"

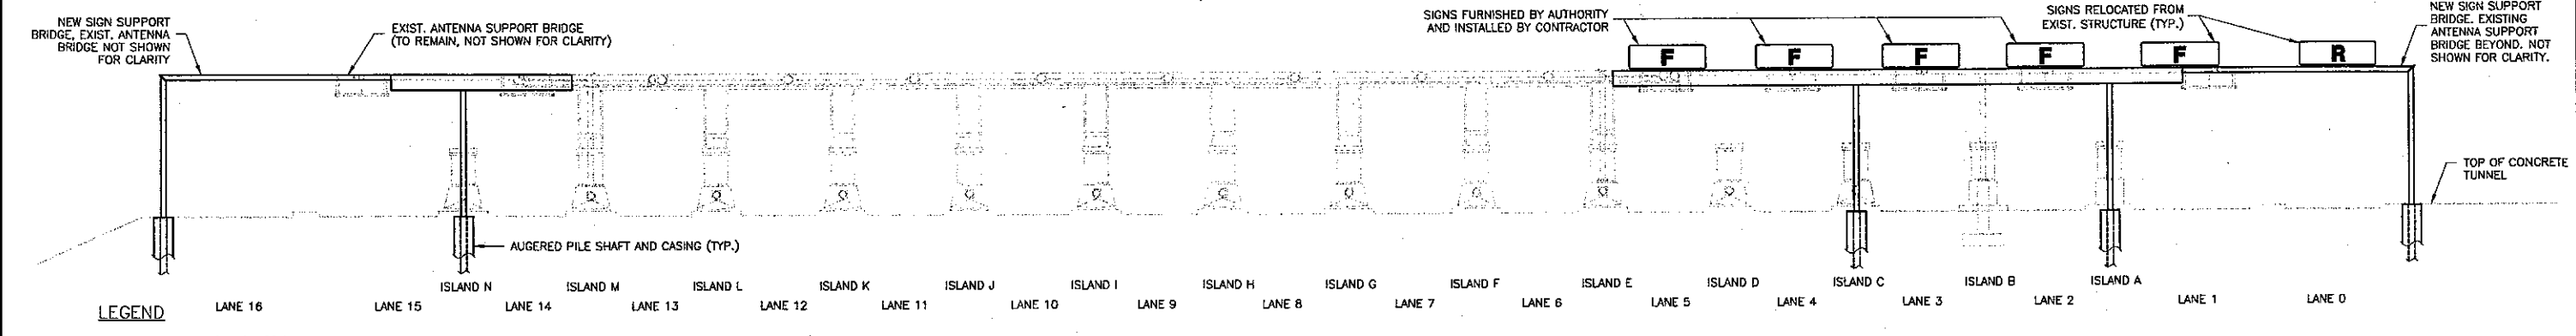

PROPOSED ELEVATION - LOOKING SOUTH
3/32"=1'-0"

LEGEND

PROPOSED TOLL CANOPY SUPPORT MOUNTED SIGN

F FIXED SIGN

R ROTATING SIGN

Scale: AS NOTED

No.	Revision	By	Date

Designed by:

HNTB
ARCHITECTS ENGINEERS PLANNERS

By	Date	By	Date
Designed JMB	08/01	Checked CAH	08/01
Drawn TRC	08/01	In Charge of RAL	08/01

HNTB CORPORATION
2 Thomas Drive
Westbrook, ME 04092
TEL (207) 774-5155
FAX (207) 772-7410

MAINE TURNPIKE AUTHORITY


YORK TOLL PLAZA
CANOPY EXTENSION

PLAN AND ELEVATION

SHEET NUMBER: S-1
3 OF 11

CONTRACT: 2001.15

H:\H0909XW\005\006 YORK CANOPY EXTENSION\S2-REMOVAL.DWG 08/14/01 08:40

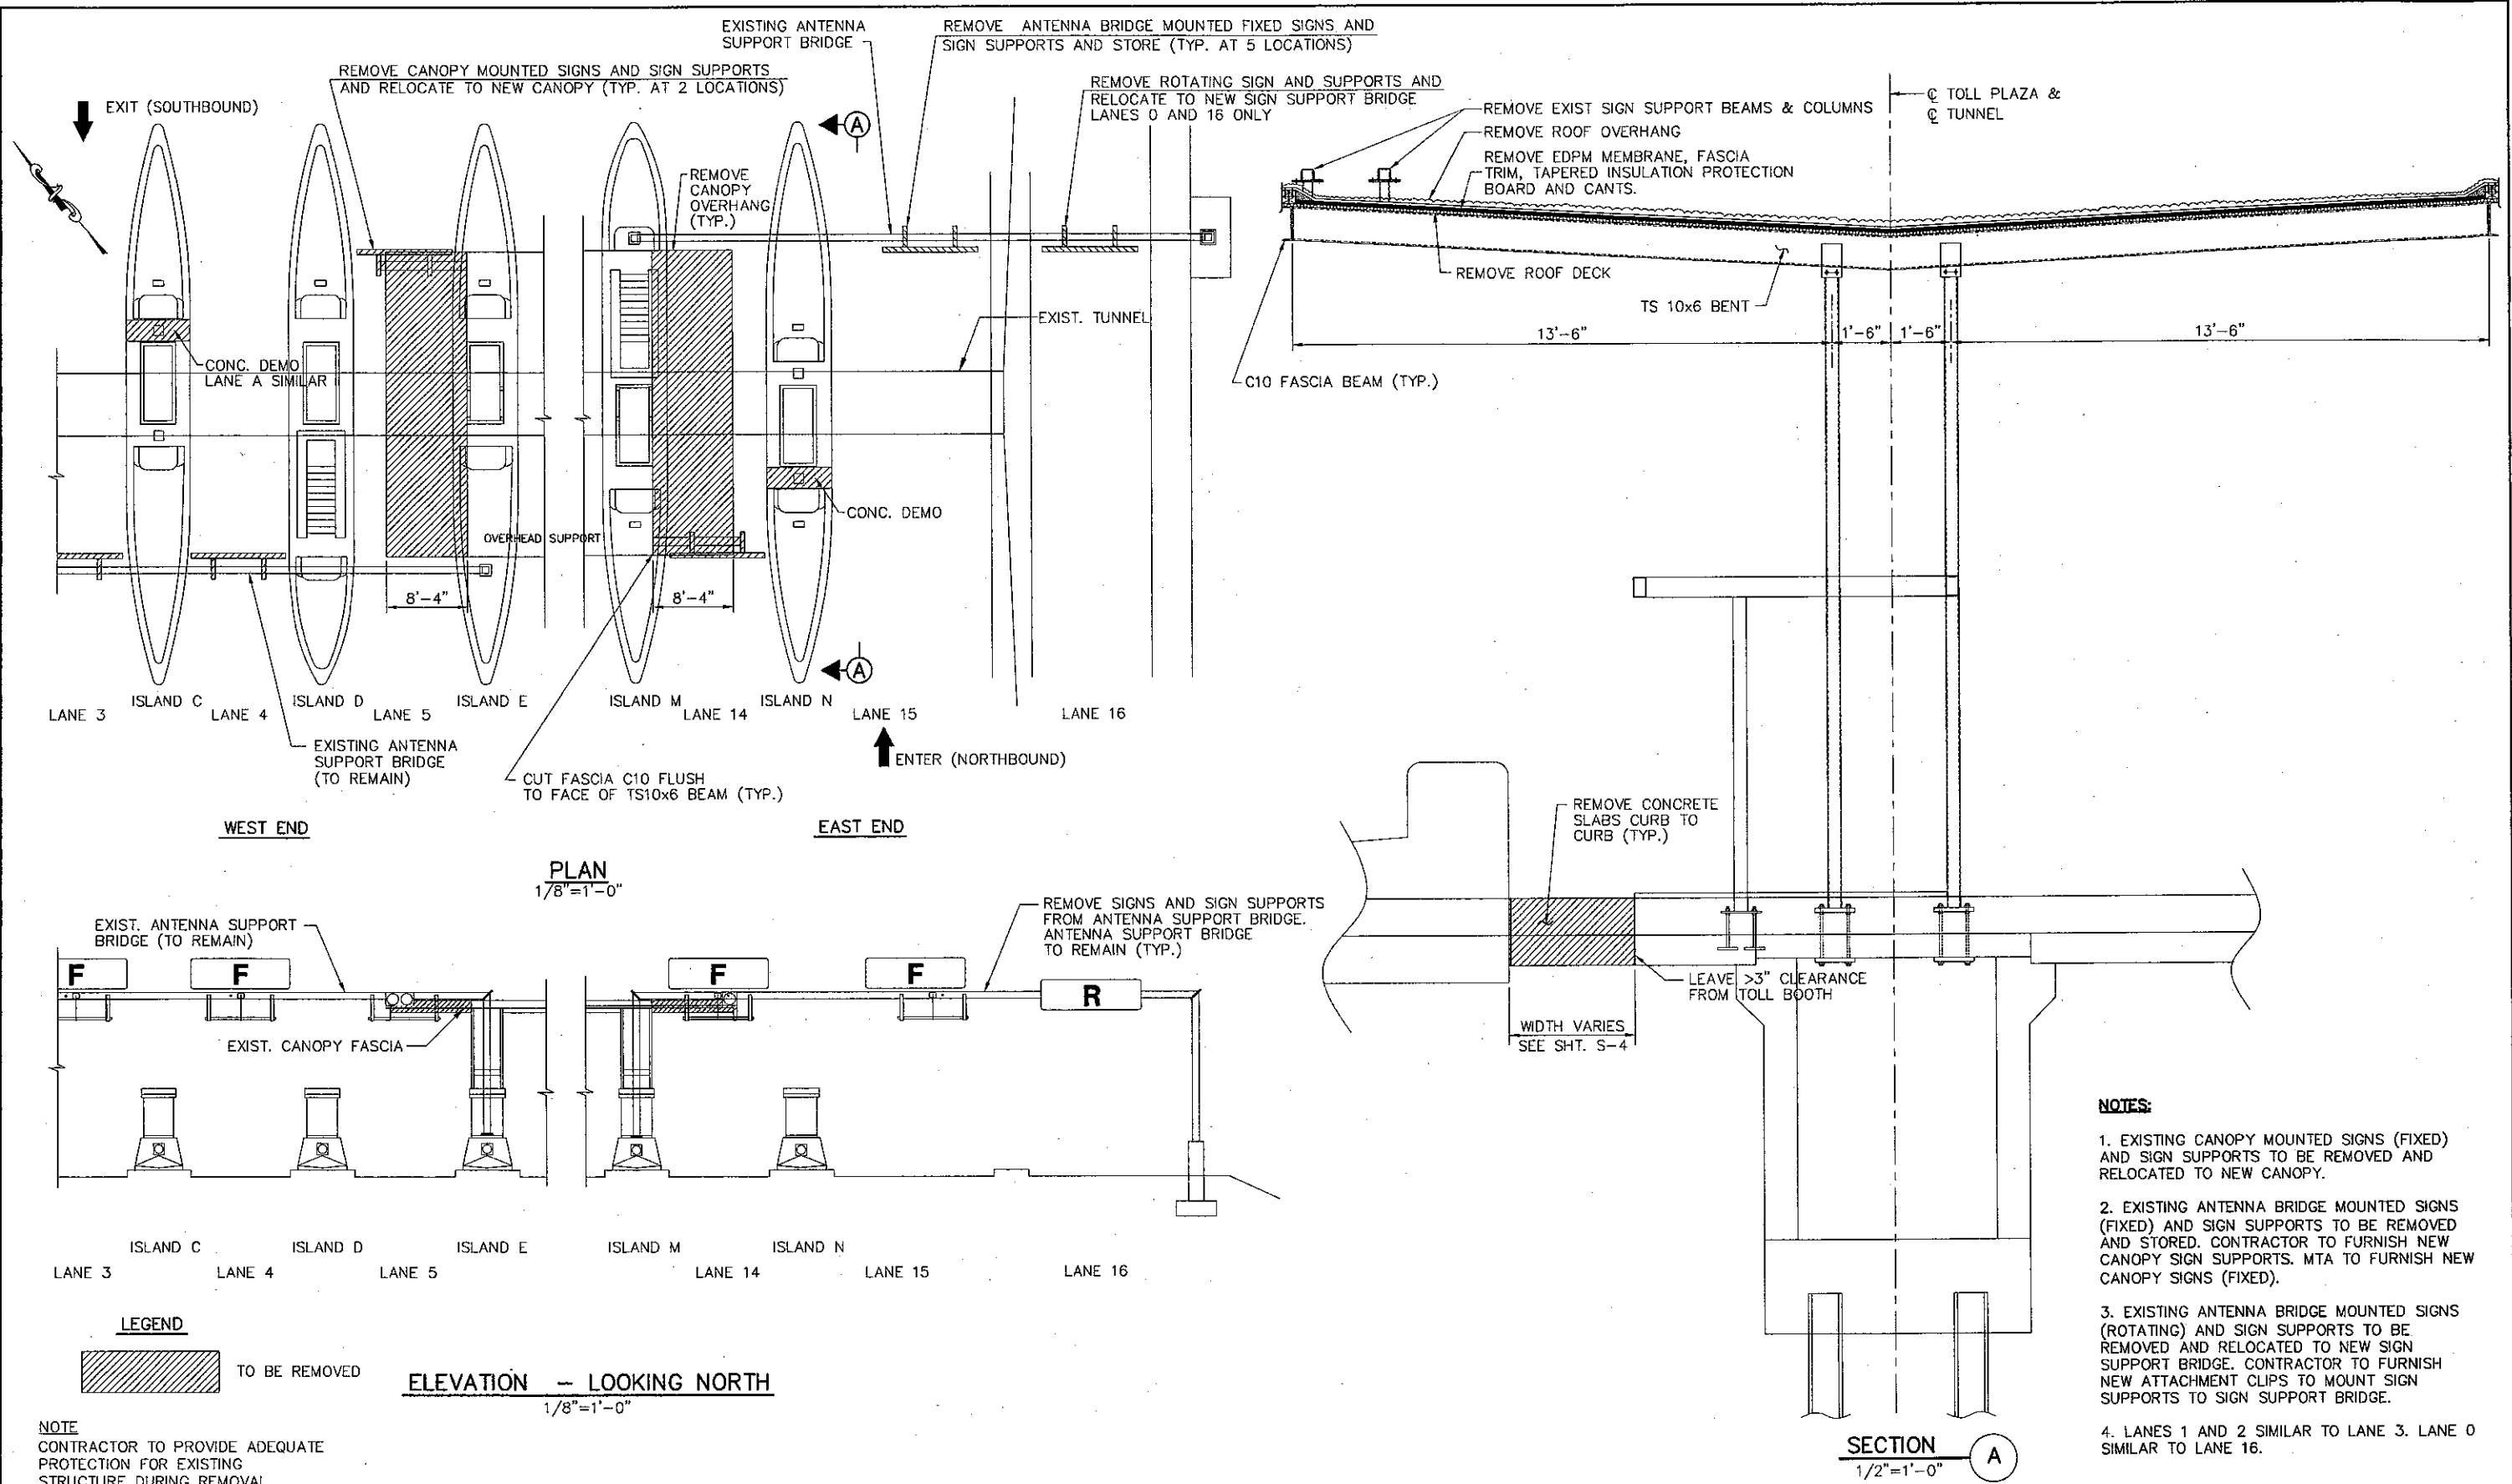

Scale: AS NOTED

No.	Revision	By	Date

Designed by:

HNTB
ARCHITECTS ENGINEERS PLANNERS

	By	Date	Checked	By	Date
Designed	JMB	08/01		CAH	08/01
Drawn	TRC	08/01	In Charge of	RAL	08/01


HNTB CORPORATION
2 Thomas Drive
Westbrook, ME 04092
TEL (207) 774-5155
FAX (207) 772-7410

MAINE TURNPIKE AUTHORITY

**YORK TOLL PLAZA
CANOPY EXTENSION**

CANOPY REMOVAL

SHEET NUMBER: S-2
CONTRACT: 2001.15
4 OF 11

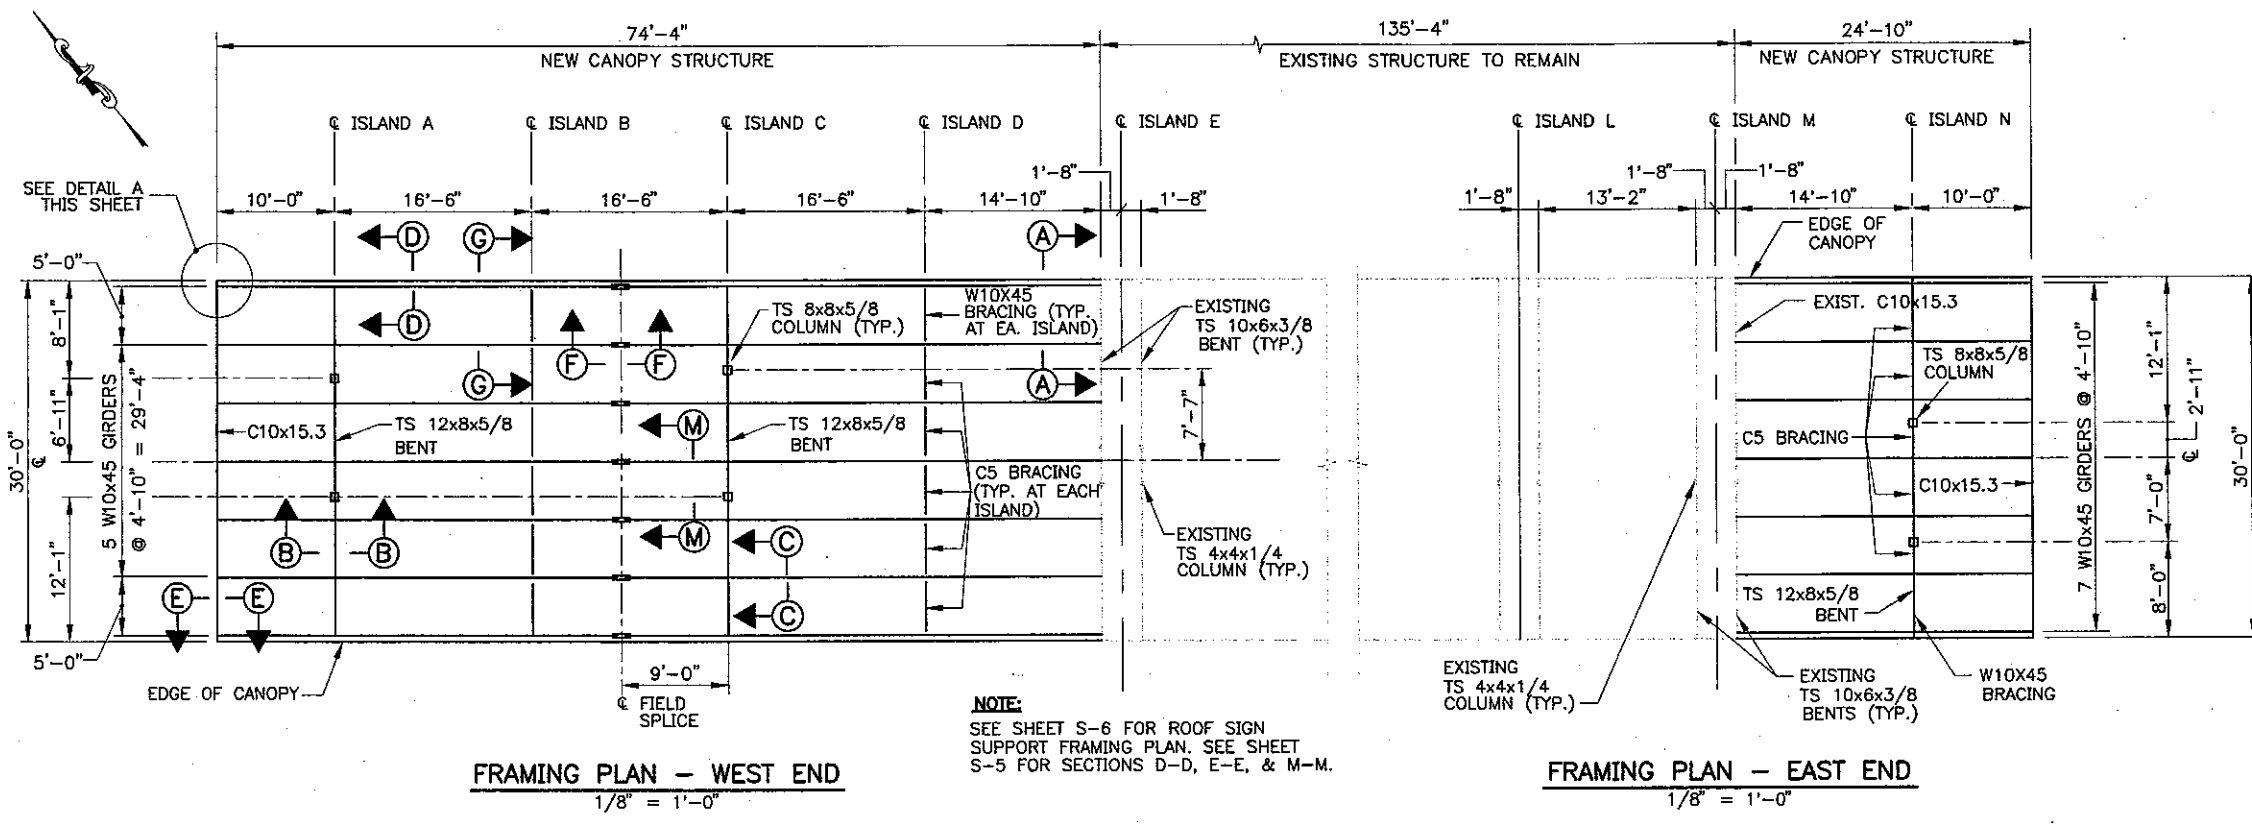

STRUCTURAL STEEL NOTES








SPECIFICATION
 A.I.S.C. ALLOWABLE STRESS DESIGN MANUAL, 9TH EDITION
 ASCE STANDARD 7-95: MINIMUM DESIGN LOADS FOR BUILDINGS AND OTHER STRUCTURES

LOAD
 ROOF SNOW LOAD = 38#/S.F. (HORIZONTAL PROJECTION)
 WIND LOAD = 102 MPH (3 SEC. GUSTS)

MATERIAL
 STRUCTURAL STEEL TUBING ASTM DESIGNATION A500,
 FY=46,000psi. ALL OTHER STRUCTURAL STEEL TO BE
 AASHTO M270 (ASTM A709) GRADE 36 OR 50.
 ALL HIGH STRENGTH BOLTS ARE 3/4"Ø ASTM A325.

COATINGS
 REFERENCE: MAINE TURNPIKE AUTHORITY SPECIAL PROVISION
 DIVISION 800 SECTION 09900
 FOR CANOPY FRAMING, USE SYSTEM A(1) - (GLOSS ALKYD)
 FOR SIGN SUPPORTS, USE SYSTEM A(2) - (HOT-DIP GALV.)

NOTE:
 SEE SHEET S-6 FOR ROOF SIGN
 SUPPORT FRAMING PLAN. SEE SHEET
 S-5 FOR SECTIONS D-D, E-E, & M-M.

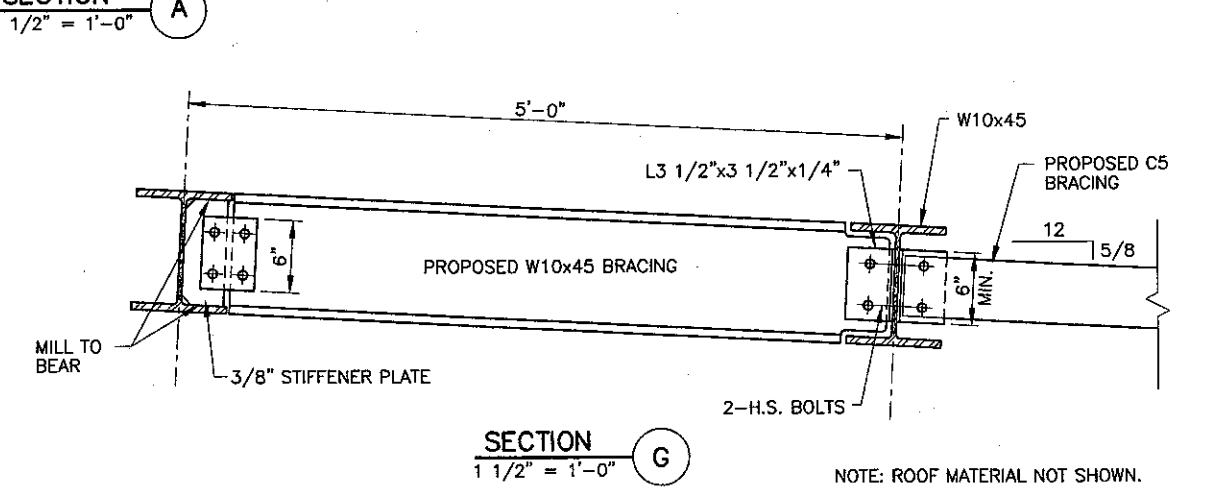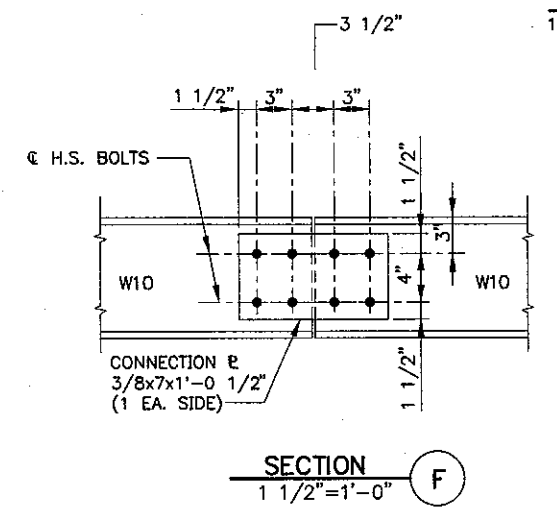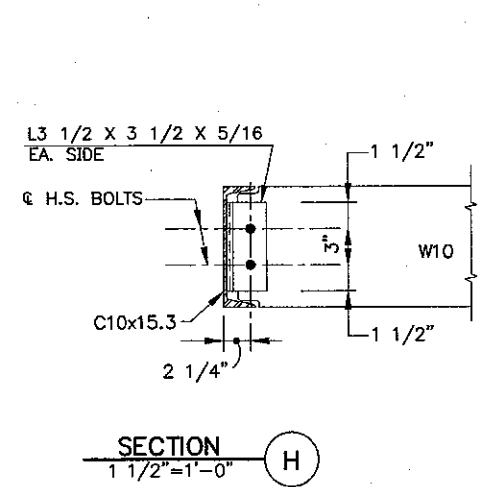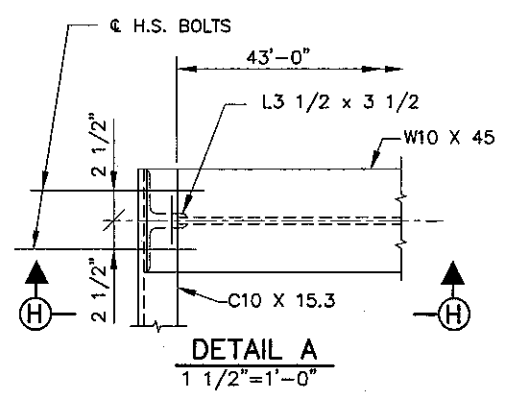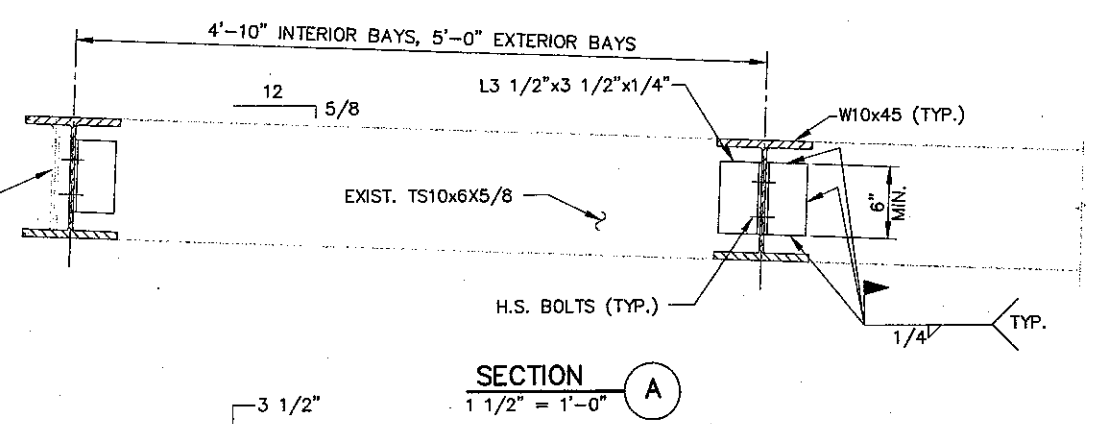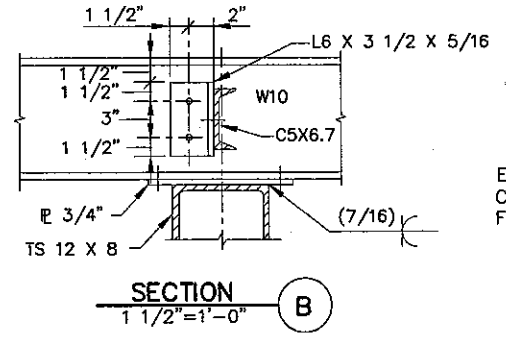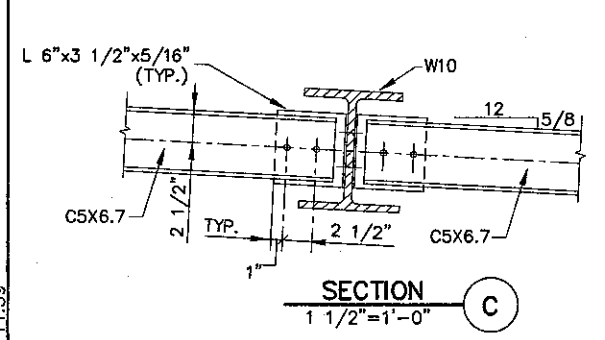

NOTE: ROOF MATERIAL NOT SHOWN.

H:\H09009\XW\005\006 YORK CANOPY EXTENSION\S3-FRAMINGPLAN.DWG 08/20/01 11:39

Scale: AS NOTED

No.	Revision	By	Date

Designed by:

HNTB
 ARCHITECTS ENGINEERS PLANNERS

By	Date	By	Date
Designed JMB	08/01	Checked CAH	08/01
Drawn TRC	08/01	In Charge of RAL	08/01

HNTB CORPORATION
 2 Thomas Drive
 Westbrook, ME 04092
 TEL (207) 774-5155
 FAX (207) 772-7410

MAINE TURNPIKE AUTHORITY


YORK TOLL PLAZA
 CANOPY EXTENSION

FRAMING PLAN

SHEET NUMBER: S-3
 5 OF 11

CONTRACT: 2001.15


H:\H09009\005\006 YORK CANOPY EXTENSION\S4-ELEVATION.DWG 08/14/01 09:12

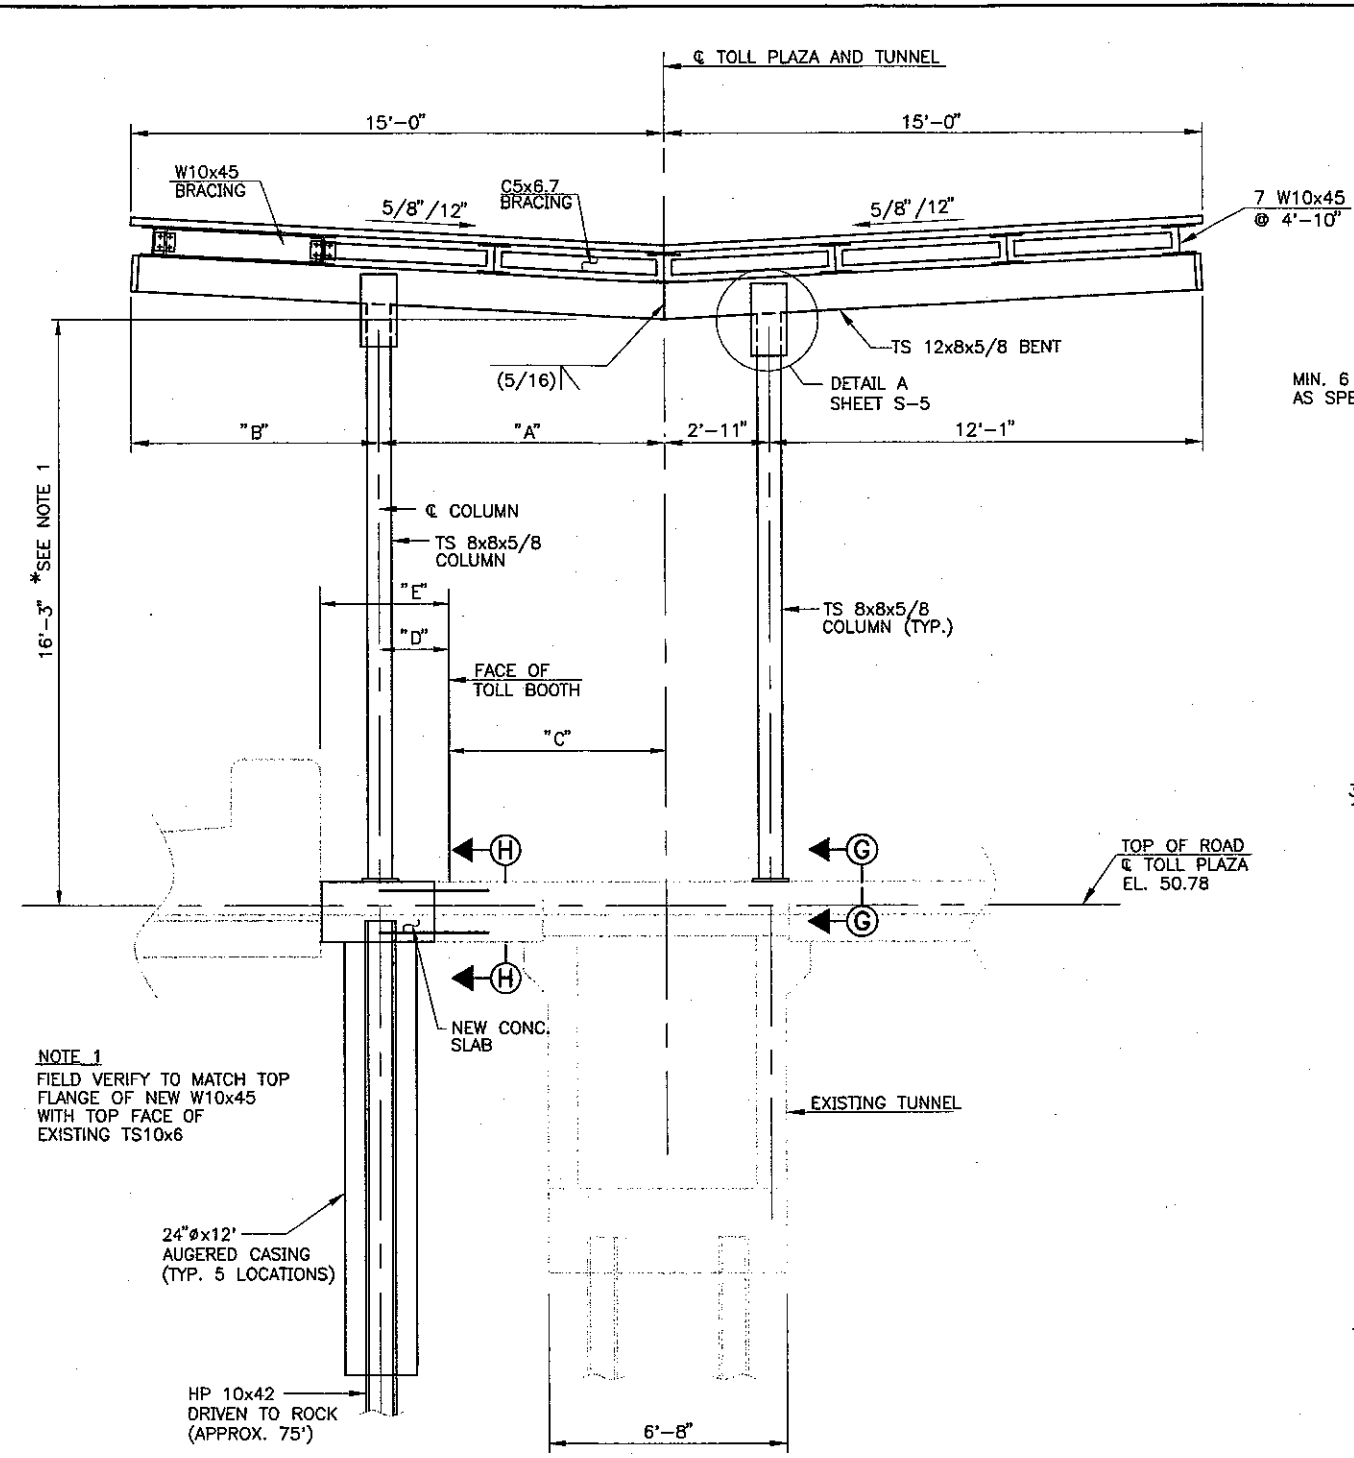


ELEVATION LOOKING EAST AT ISLANDS A, C
ELEVATION LOOKING WEST AT ISLAND N
3/8" = 1'-0"

ISLAND	"A"	"B"	"C"	"D"	"E"
A	6'-11"	8'-1"	5'-3"	1'-8"	3'-0"
C	7'-7"	7'-5"	5'-8"	1'-11"	3'-7"
N	7'-0"	8'-0"	4'-10"	2'-2"	4'-5"

NOTE: FIELD VERIFY DIMENSIONS PRIOR TO CONSTRUCTION

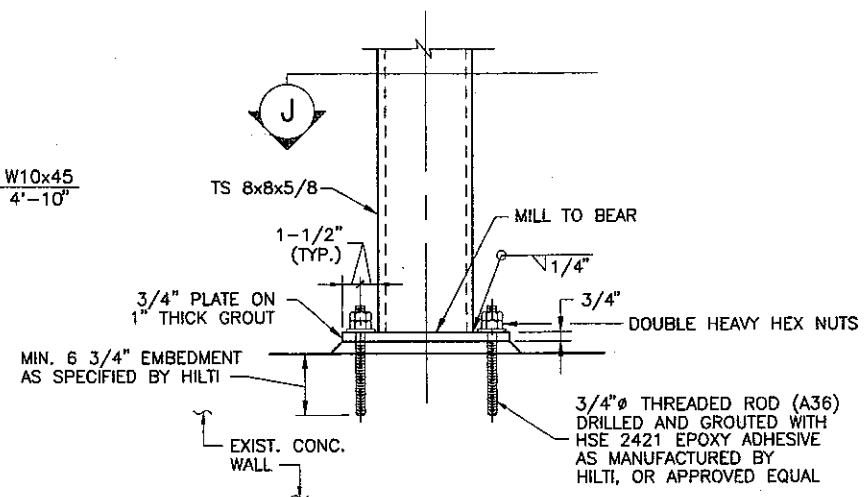


SECTION G
1 1/2" = 1'-0"

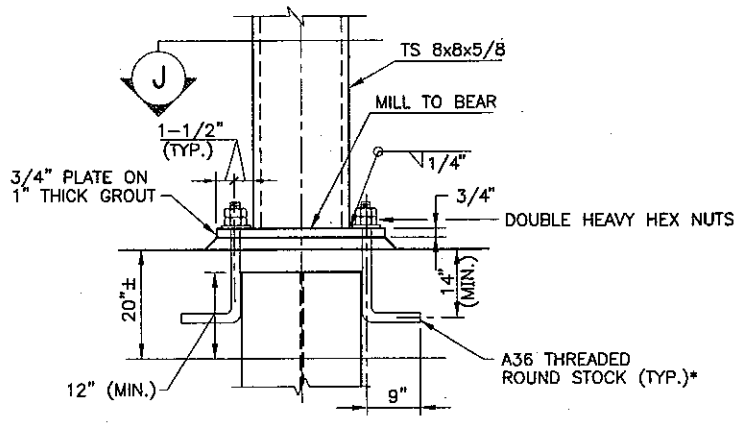


SECTION H
1 1/2" = 1'-0"


* USE 3/4" A36 THREADED ROUND STOCK, GALVANIZED, WITH THREADED END AT TOP AND 90° BEND AT BOTTOM

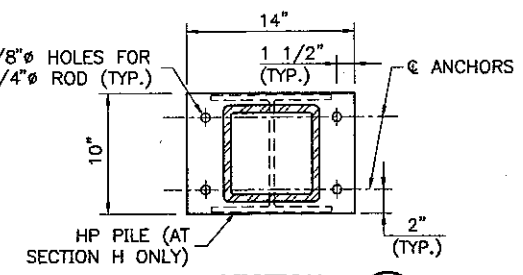


SECTION J
1 1/2" = 1'-0"

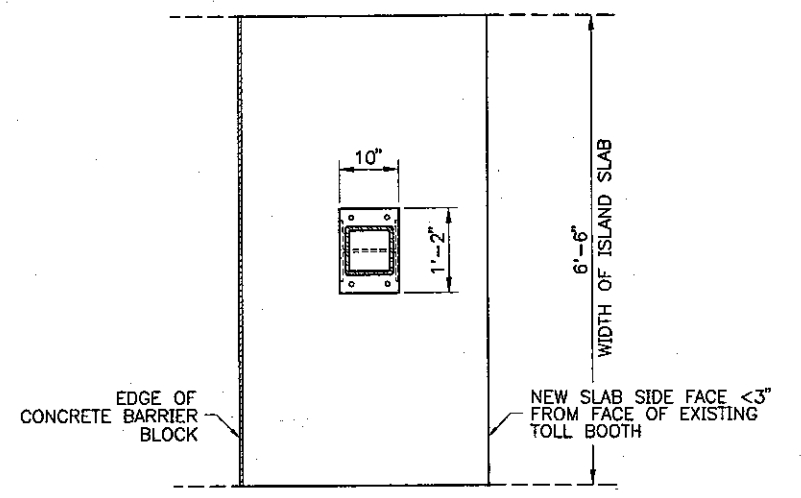

ISLAND PLAN VIEW AT NEW PILE LOCATION
3/4" = 1'-0"

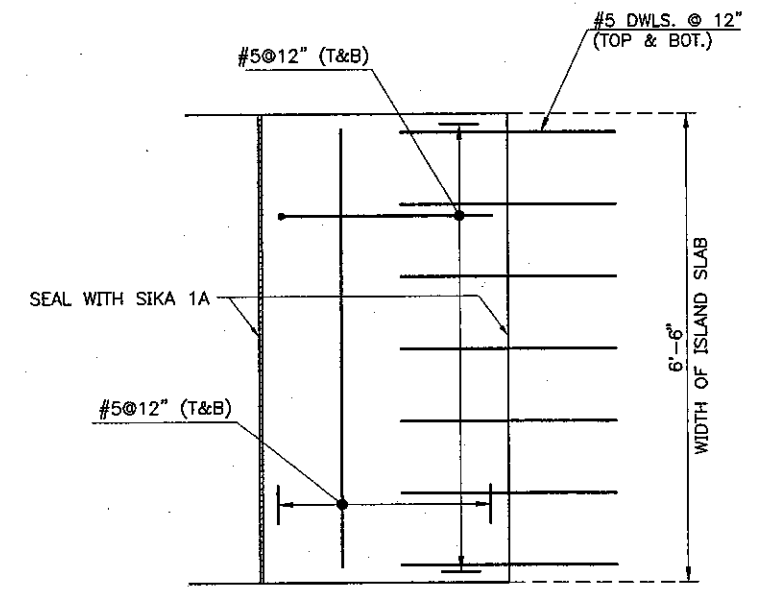

PLAN

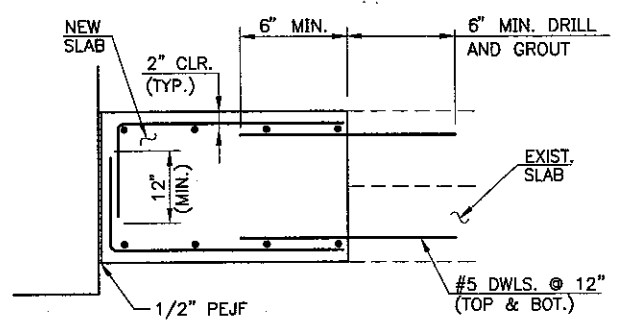

ELEVATION

CONCRETE SLAB REINFORCEMENT
3/4" = 1'-0"

NOTE: GROUT SHALL BE HSE 2421 EPOXY ADHESIVE AS MANUFACTURED BY HILTI, OR APPROVED EQUAL.

Scale: AS NOTED

No.	Revision	By	Date

Designed by:

HNTB
ARCHITECTS ENGINEERS PLANNERS

By	Date	By	Date
Designed JMB	08/01	Checked CAH	08/01
Drawn TRC	08/01	In Charge of RAL	08/01

HNTB CORPORATION
2 Thomas Drive
Westbrook, ME 04092
TEL (207) 774-5155
FAX (207) 772-7410






MAINE TURNPIKE AUTHORITY

YORK TOLL PLAZA
CANOPY EXTENSION
FRAMING DETAILS 1

YORK TOLL PLAZA
CANOPY EXTENSION
FRAMING DETAILS 1

SHEET NUMBER: S-4
CONTRACT: 2001.15
6 OF 11

H:\H09009XW\005\006 YORK CANOPY EXTENSION\SS-DETAILS2.DWG 08/20/01 13:47

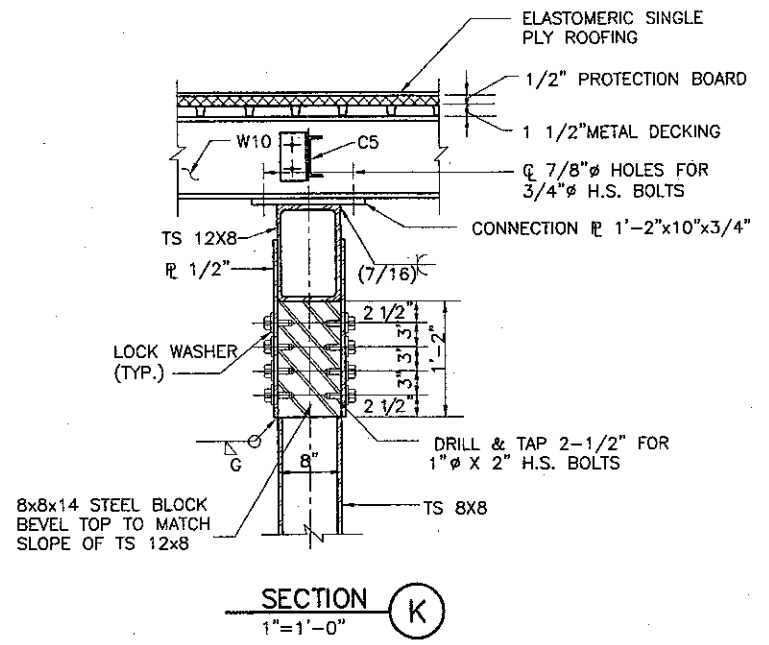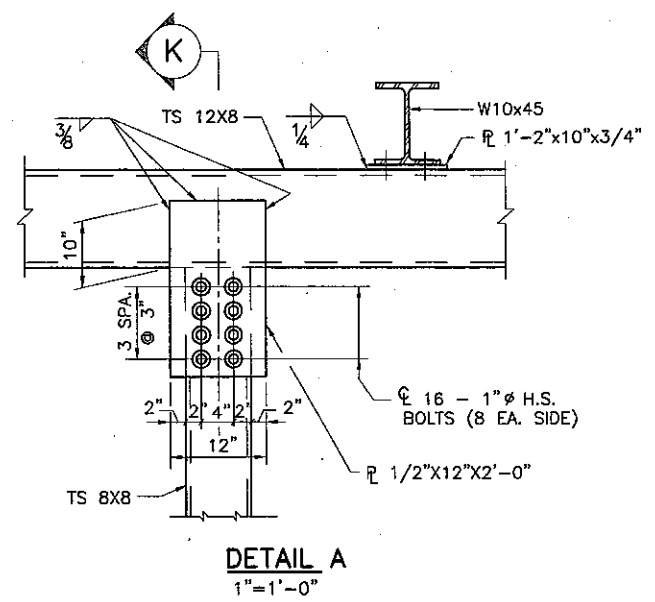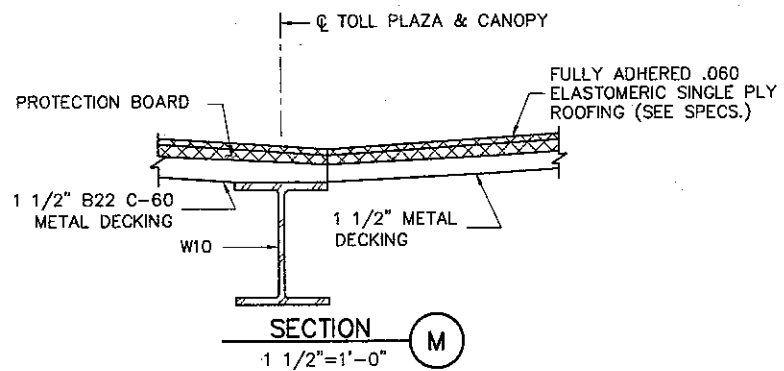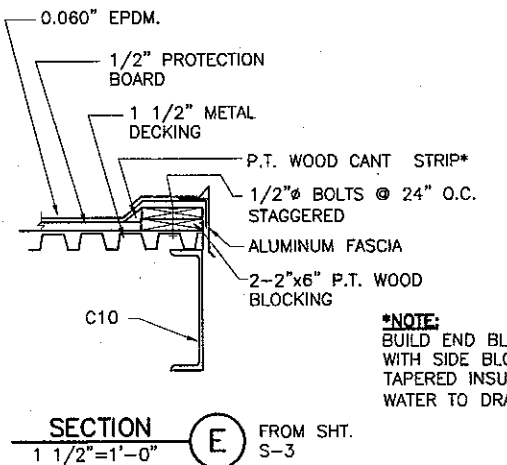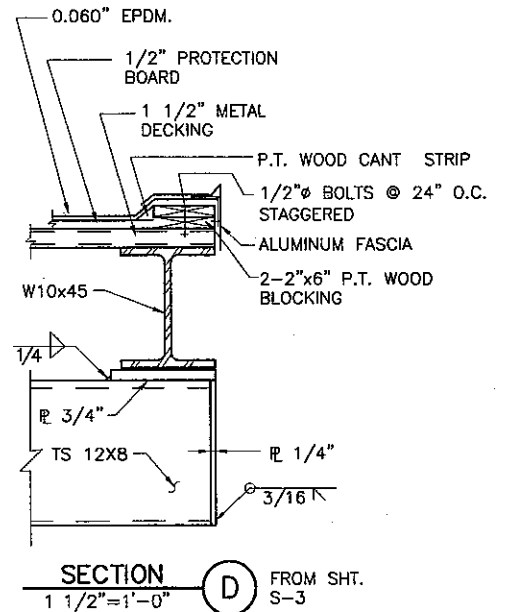

Scale: AS NOTED

No.	Revision	By	Date

Designed by:

HNTB
ARCHITECTS ENGINEERS PLANNERS

	By	Date		By	Date
Designed	JMB	08/01	Checked	CAH	08/01
Drawn	TRC	08/01	In Charge of	RAL	08/01

HNTB CORPORATION
2 Thomas Drive
Westbrook, ME 04092
TEL (207) 774-5155
FAX (207) 772-7410


MAINE TURNPIKE AUTHORITY

YORK TOLL PLAZA
CANOPY EXTENSION


FRAMING DETAILS 2

SHEET NUMBER: S-5
CONTRACT: 2001.15
7 OF 11


H:\H09009\005\006 YORK CANOPY EXTENSION\S6-CSIGNS.DWG 08/14/01 10:51

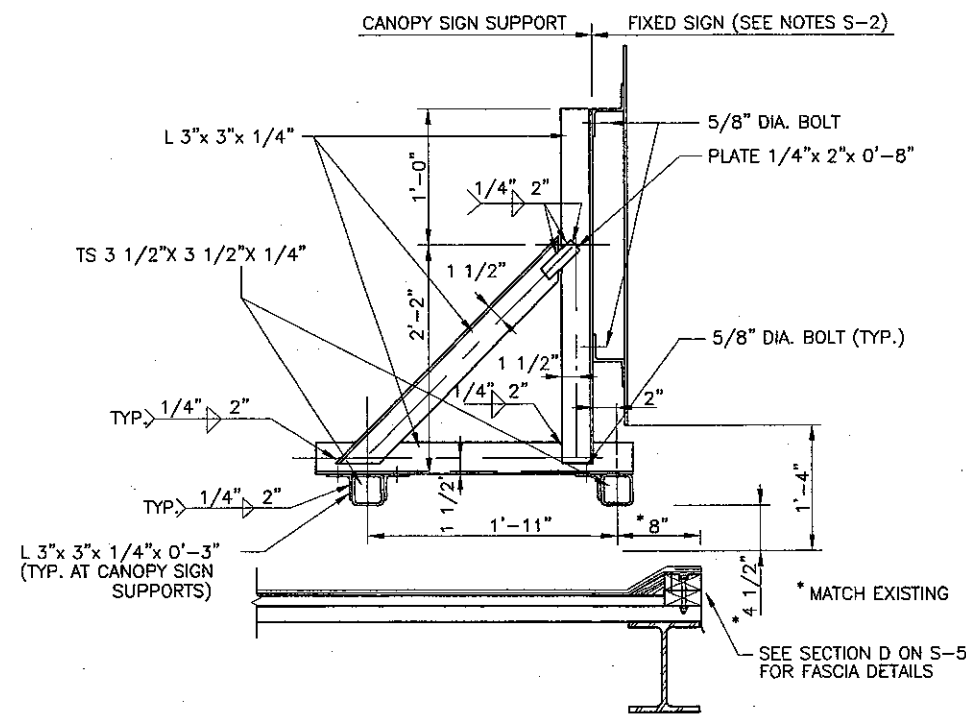


SECTION C
NOT TO SCALE

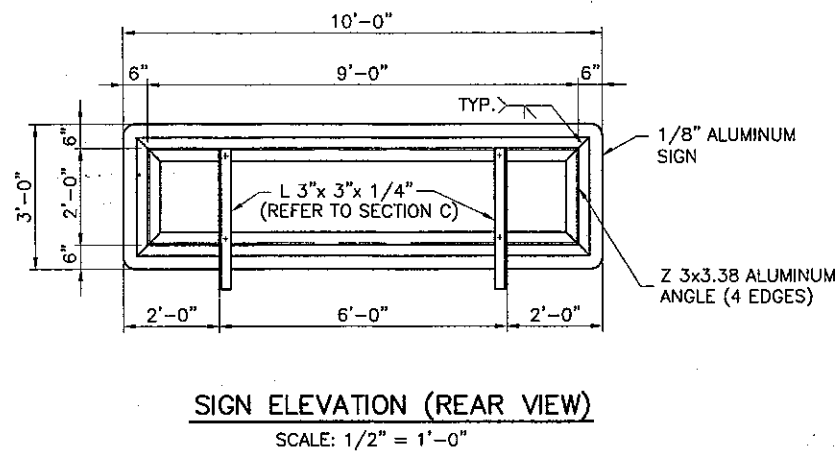


SIGN ELEVATION (REAR VIEW)
SCALE: 1/2" = 1'-0"

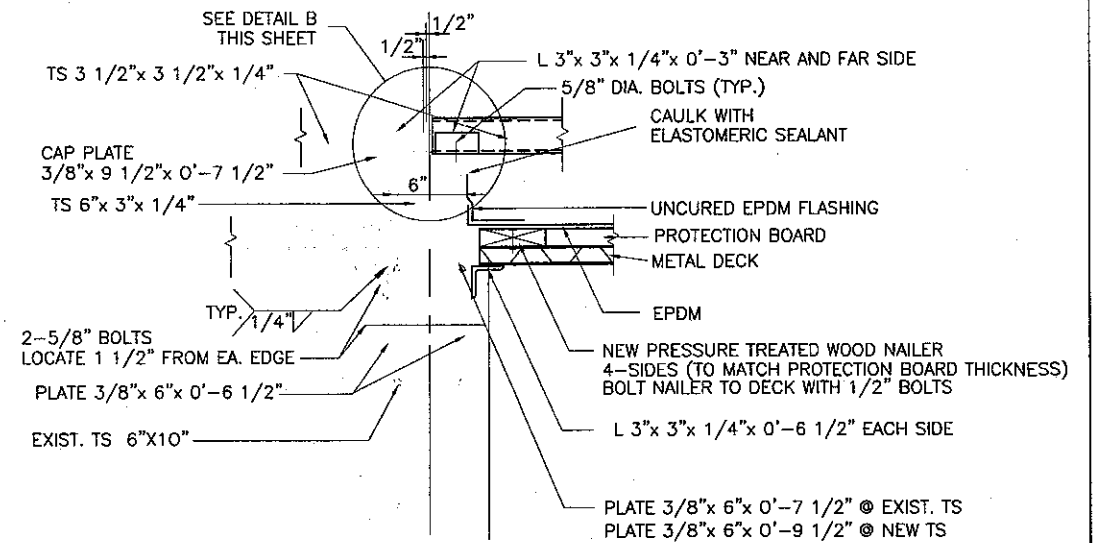


SECTION B
SCALE: 1 1/2" = 1'-0"

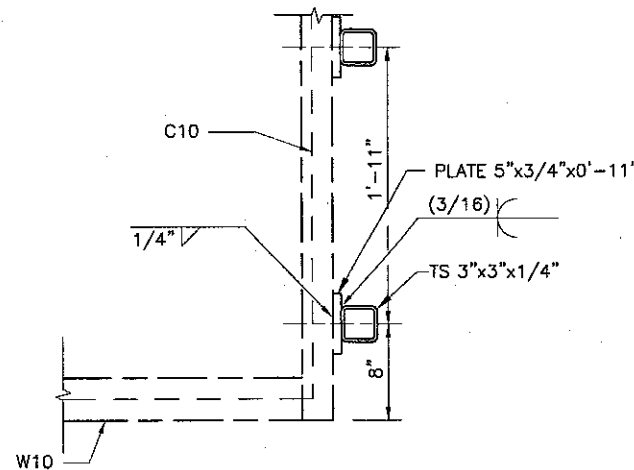


DETAIL A
1 1/2" = 1'-0"

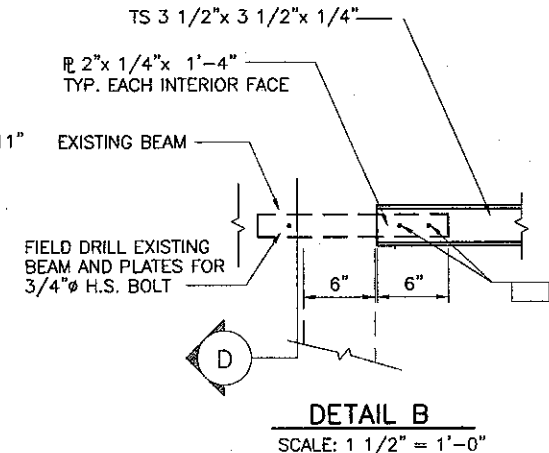


DETAIL B
SCALE: 1 1/2" = 1'-0"

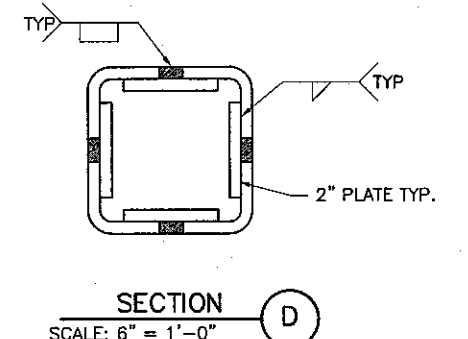

SECTION D
SCALE: 6" = 1'-0"

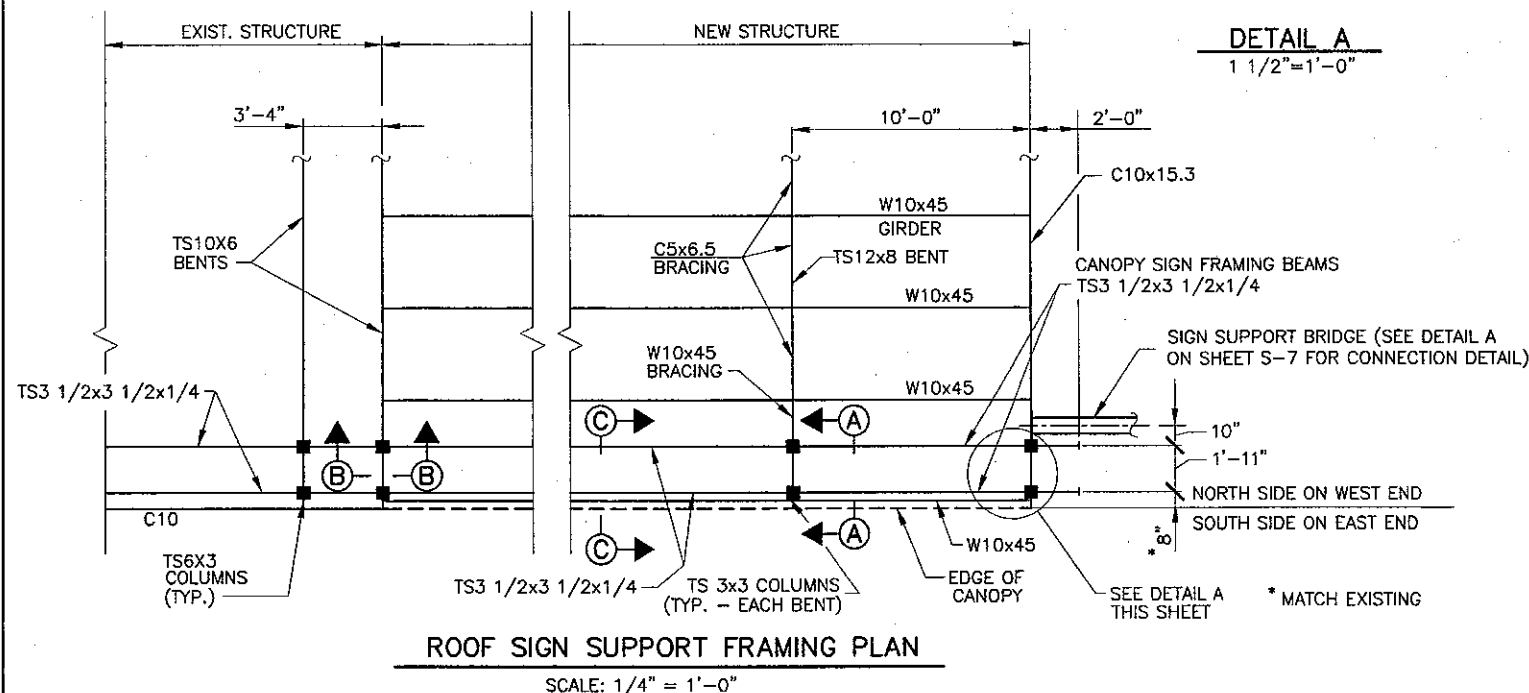

ROOF SIGN SUPPORT FRAMING PLAN
SCALE: 1/4" = 1'-0"

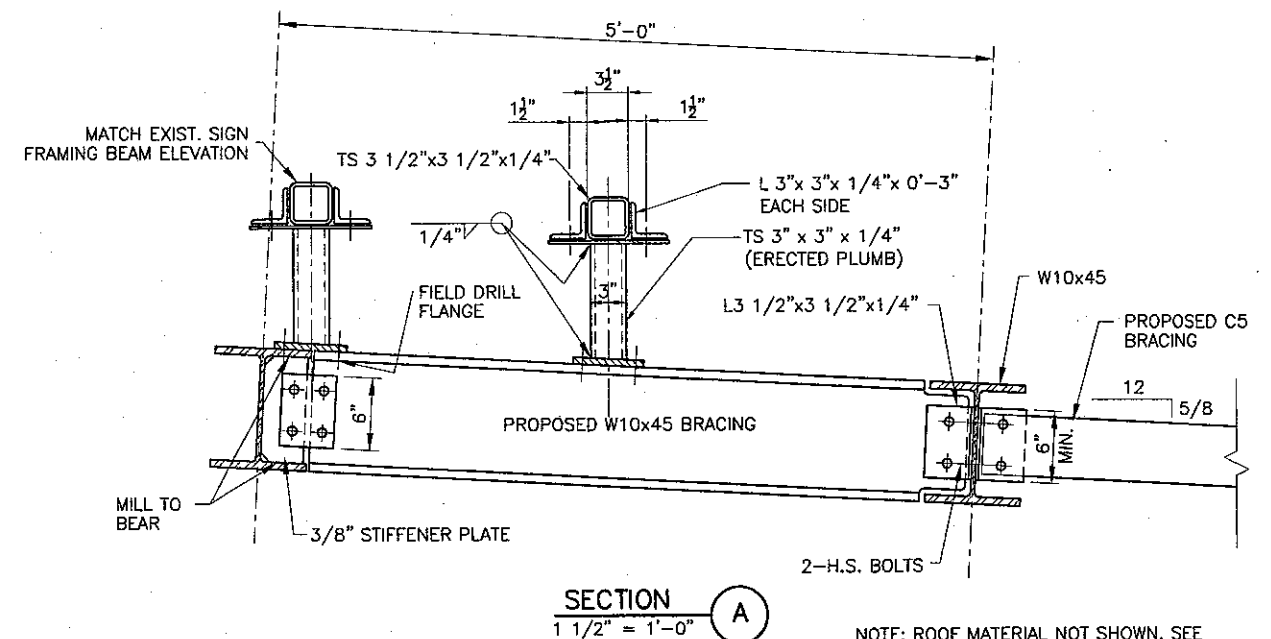

SECTION A
1 1/2" = 1'-0"

NOTE: ROOF MATERIAL NOT SHOWN. SEE SECTION B FOR SIMILAR DETAIL.

Scale: AS NOTED

Designed by:



ARCHITECTS ENGINEERS PLANNERS

HNTB CORPORATION
2 Thomas Drive
Westbrook, ME 04092
TEL (207) 774-5155
FAX (207) 772-7410

MAINE TURNPIKE AUTHORITY



YORK TOLL PLAZA
CANOPY EXTENSION

CANOPY SIGNS TYPICAL DETAILS

No.	Revision	By	Date


Designed	By	Date	Checked	By	Date
	JMB	08/01		CAH	08/01
Drawn	By	Date	In Charge of	By	Date
	TRC	08/01		RAL	08/01

CONTRACT: 2001.15

SHEET NUMBER: S-6

8 OF 11

H:\H09009\005\006 YORK CANOPY EXTENSION\S7-OVERHD1.DWG 08/20/01 15:50

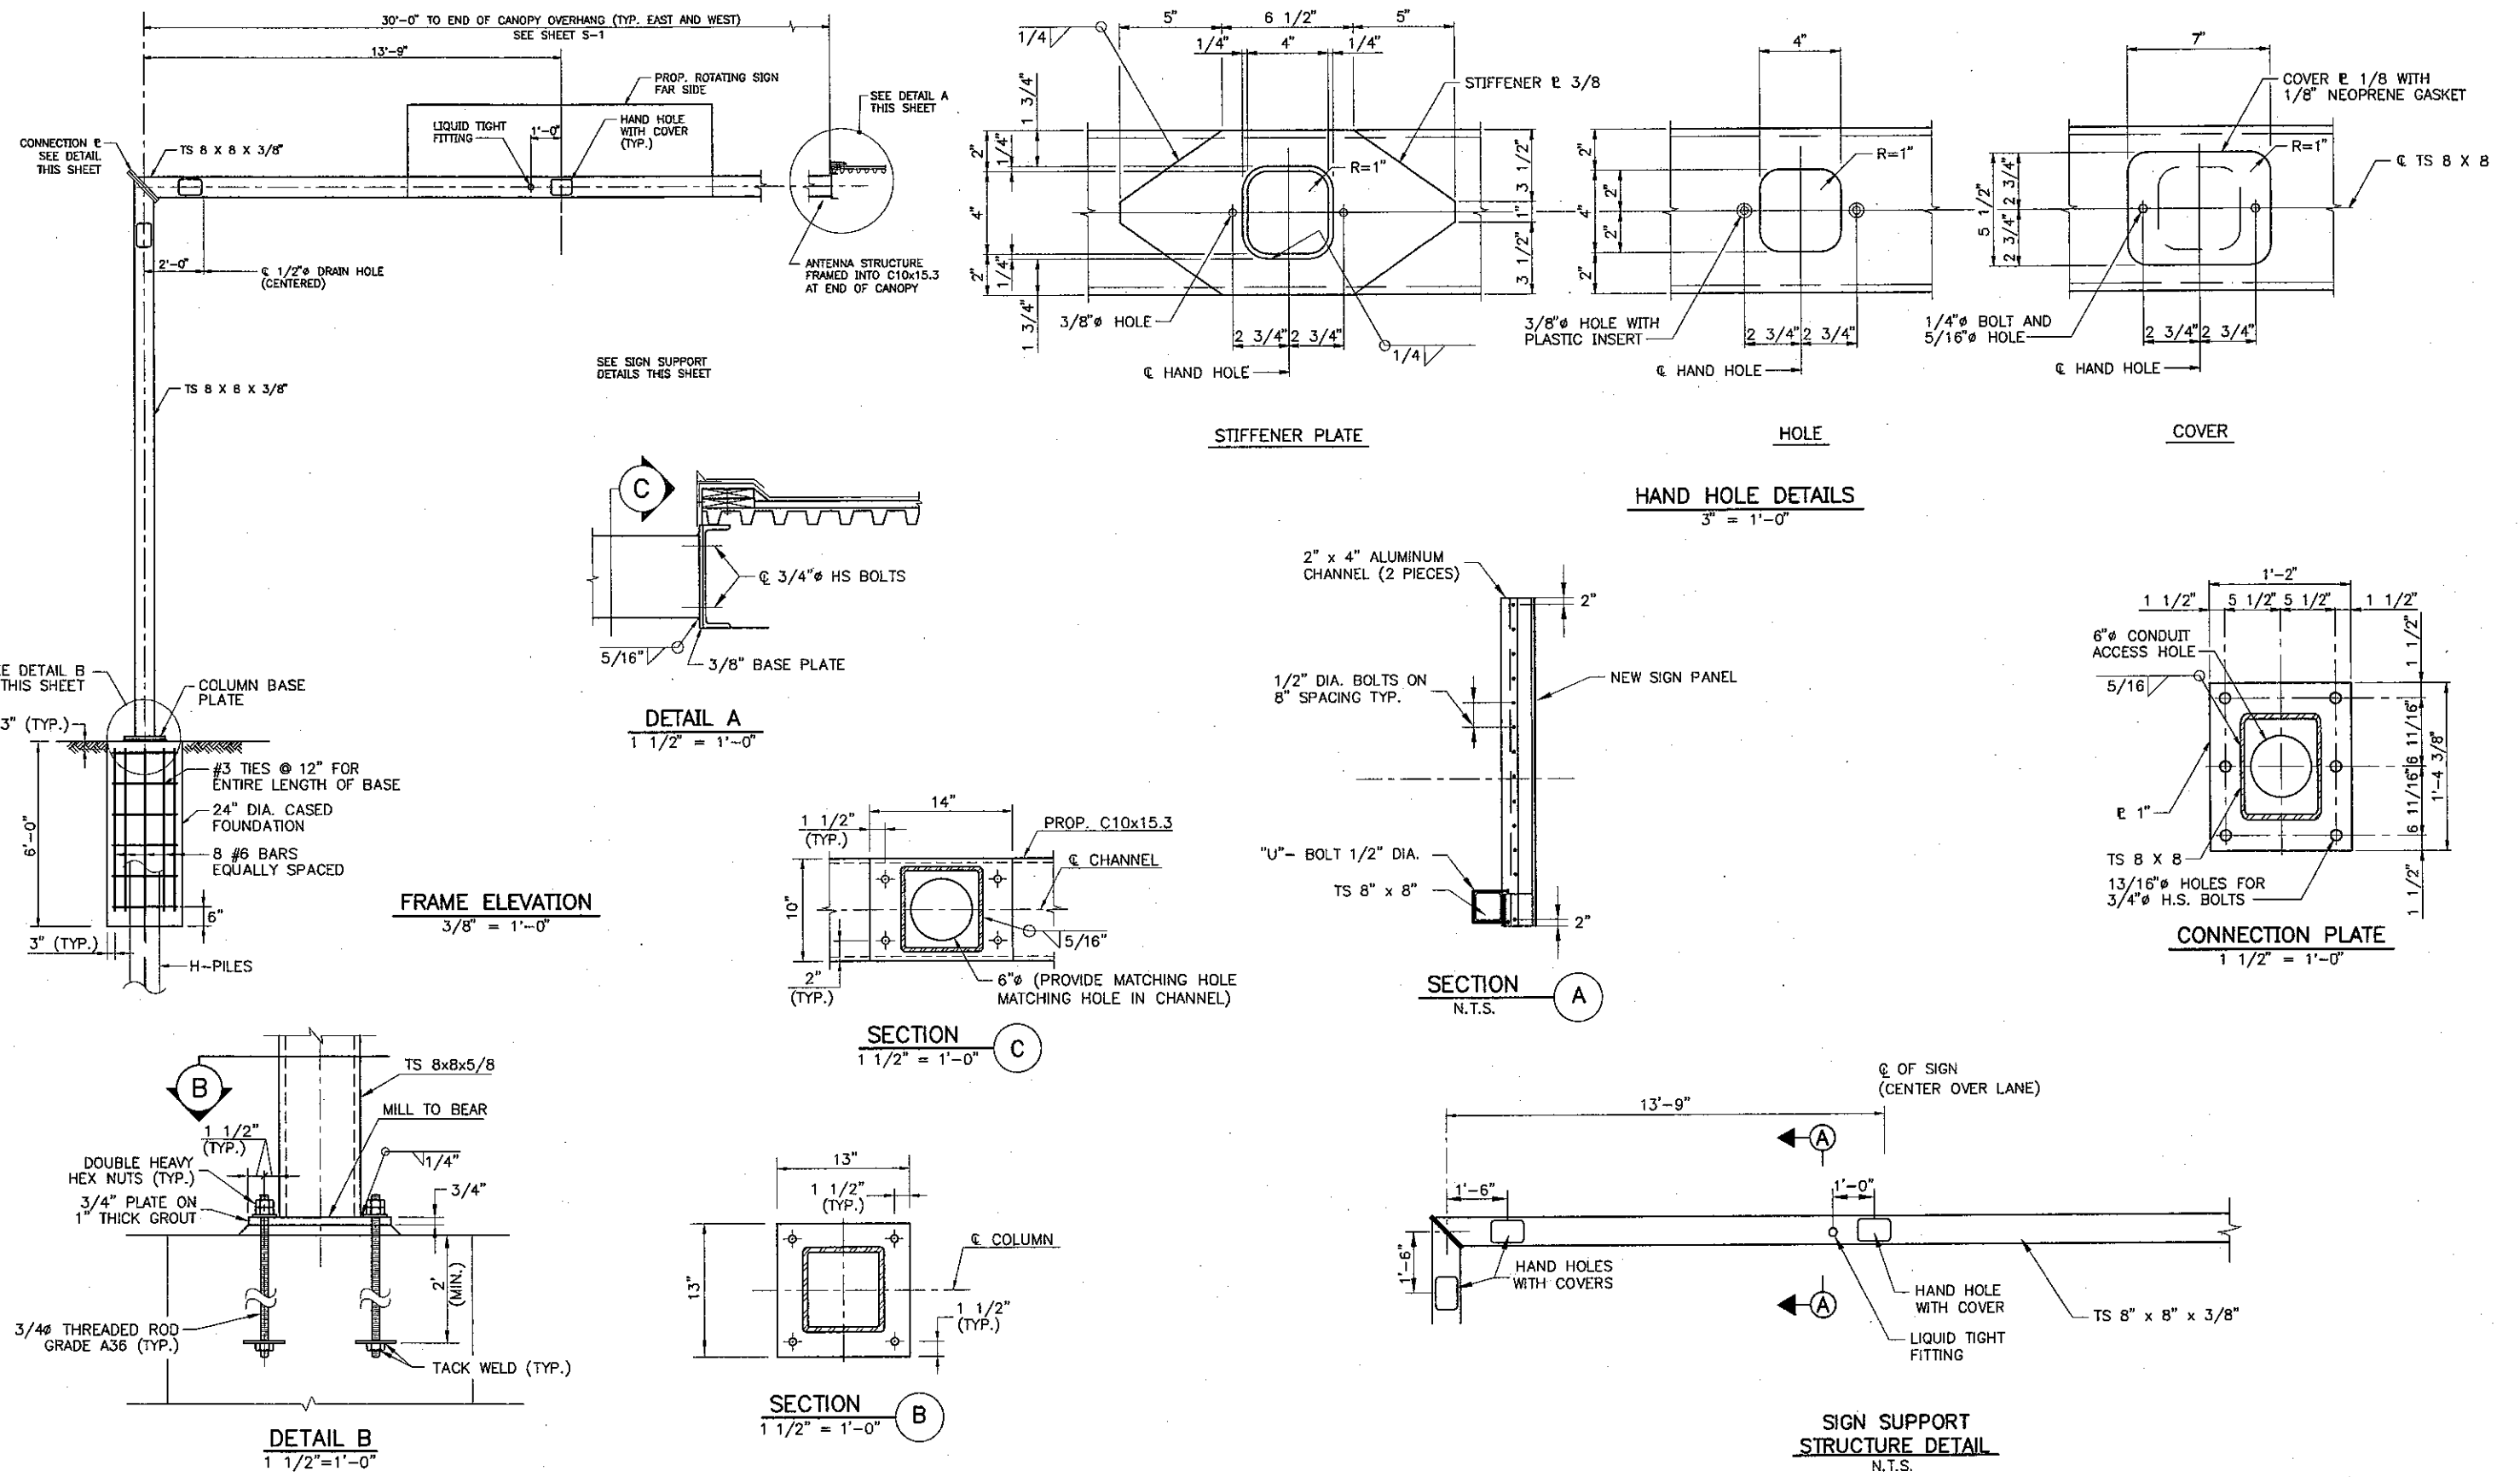

Scale: AS NOTED

No.	Revision	By	Date

Designed by:

HNTB
ARCHITECTS ENGINEERS PLANNERS

	By	Date		By	Date
Designed	JMB	08/01	Checked	CAH	08/01
Drawn	TRC	08/01	In Charge of	RAL	08/01

HNTB CORPORATION
2 Thomas Drive
Westbrook, ME 04092
TEL (207) 774-5155
FAX (207) 772-7410

MAINE TURNPIKE AUTHORITY


YORK TOLL PLAZA
CANOPY EXTENSION

OVERHEAD SIGN SUPPORT DETAILS

SHEET NUMBER: S-7


CONTRACT: 2001.15

9 OF 11

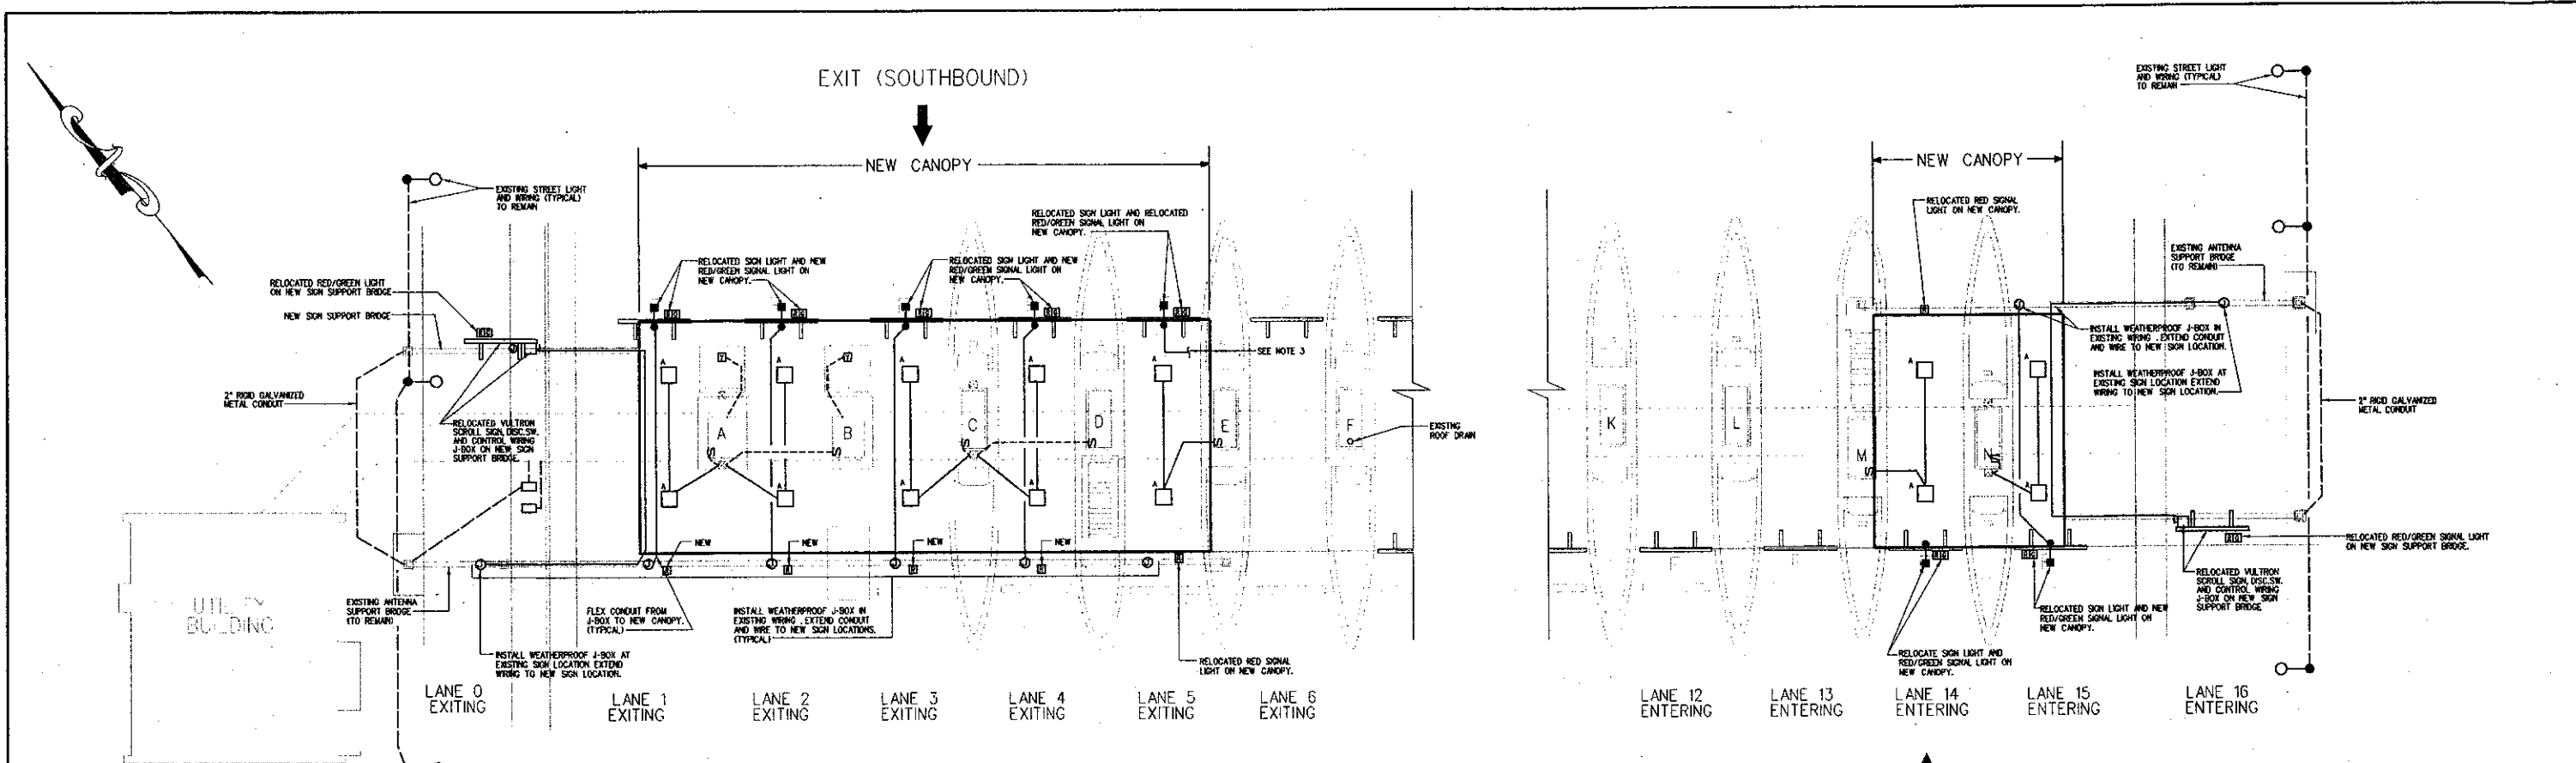


YORK TOLL PLAZA - NEW CANOPY ELECTRICAL PLAN
SCALE: 3/32"=1'-0"


- NOTES:
- EXISTING TRANSPASS ELECTRONIC TOLL ANTENNAS CONDUITS & WIRES TO REMAIN ON EXISTING ANTENNA SUPPORT BRIDGE.
 - CONTRACTOR TO PROVIDE UNISTRUT CHANNEL NEW FOR RELOCATED JUNCTION BOXES. WIRE CLAMPS ETC. AS NEED TO RELOCATE AND MOUNT EXIST. SIGN LIGHTS AND "PHOTOCELL" ON NEW FIXED SIGN SUPPORT.
 - LANE 5 CANOPY SIGN LIGHT FED FROM ISLAND E ACROSS EXISTING CANOPY.

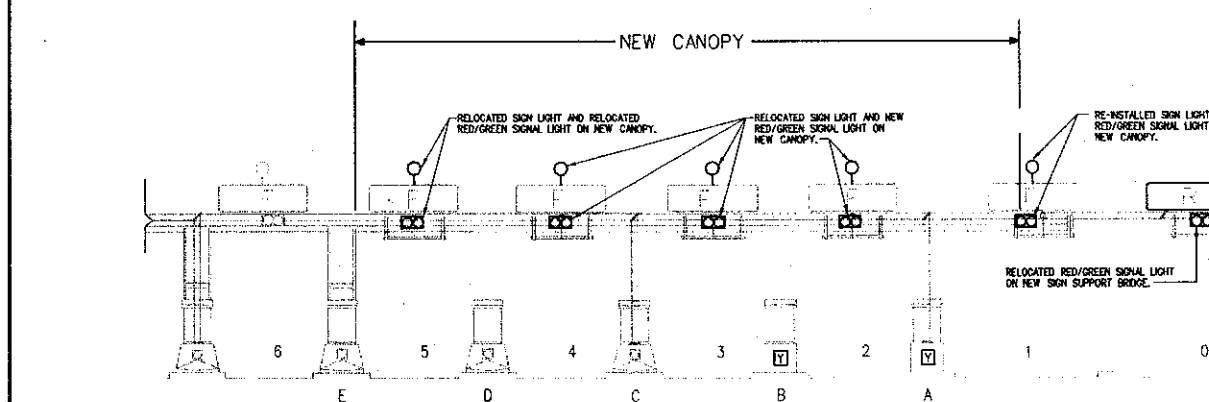

YORK TOLL PLAZA ELEVATION - SOUTHBOUND
SCALE: 3/32"=1'-0"

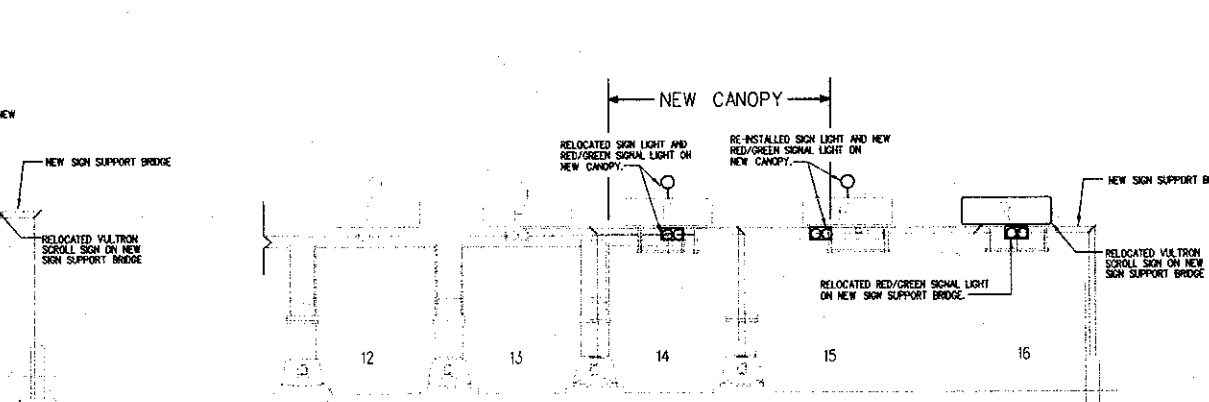

YORK TOLL PLAZA ELEVATION - NORTHBOUND
SCALE: 3/32"=1'-0"

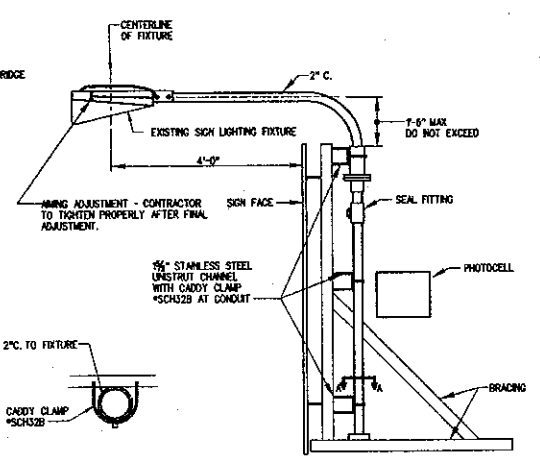

PLAN VIEW "A-A"
SCALE: NONE
FIXED SIGN LIGHT DETAIL
SCALE: NONE

SYMBOL LEGEND


- UNFUSED DISCONNECT SWITCH
- ⊙ JUNCTION BOX
- RACEWAY & WIRING OR MC CABLE RUN CONCEALED IN WALLS/CEILING.
- - - RACEWAY & WIRING RUN EXPOSED
- S SINGLE POLE SWITCH, 120 VOLT, 20 AMP, SPEC GRADE, GROUNDING TYPE, MOUNT 48" AFF. 3-3-WAY/4-4-WAY PULL-UP, W/ WEATHERPROOF. LOWER CASE LETTER INDICATES FIXTURE OR CONTROLLED LOAD. PLOT LIGHT SWITCHES SHALL BE PROVIDED W/ ENGRAVED NAMEPLATE IDENTIFYING USE.
- F FIXED SIGN
- R VULTRON ROTATING SIGN (INTERNALLY LIT)

SHORT CROSS LINES INDICATE QUANTITY OF #12 AWG WIRES IN CABLE OR IN 3/4" C WHEN GREATER THAN TWO. ABSENCE OF CROSS LINES INDICATES 2 #12 AWG WIRES

LIGHTING FIXTURE SCHEDULE			
TYPE	DESCRIPTION	LAMPS QUANTITY & TYPE	REMARKS
A	LITHONIA *GC13-100M-EP-QSR-SF(120V)	1- INXR100/C/U/MED 1- QDQGL/DC	SURFACE MOUNT ON CANOPY - W/ QUARTZ RE-STRIKE BALLAST RATED FOR - 20°F START OPERATION. SEE NOTE 1.
Y	DC INDICATOR CONTROLS *WTH144T-3	ECOLUX D12YA6	AMBER TRAFFIC CONTROL LIGHT PEDESTAL MOUNT - 1/2" NPS - ON FLASHER MOUNTED UNDER COUNTER.
R	ECONOLITE *TP11VSGP000	VERIFY WITH MFR.	RED 1 SECTION SIGNAL LIGHT FIXTURE - MOUNT ON NEW CANOPY
RG	ECONOLITE *TP26VSGP000	VERIFY WITH MFR.	RED/GREEN 2 SECTION SIGNAL LIGHTING FIXTURE - MOUNT ON NEW CANOPY/POLYCARBONATE
●	EXISTING SIGN LIGHTING FIXTURE - TO BE RE-USED.		


NOTE:
1. QUARTZ LAMPS TO LIGHT WHEN TEMPERATURE IS BELOW STARTING TEMPERATURE FOR TYPE "A" FIXTURE (TO RAISE TEMPERATURE IN FIXTURE PERMITTING LAMP GAS TO IONIZE)

Scale:	Designed by: BENNETT ENGINEERING CONSULTING ENGINEERS BENNETT ROAD, P.O. BOX 297, FREETOWN, MAINE 04032 (207) 855-9475	PE Stamp: 	Approved by: HNTB HNTB CORPORATION ARCHITECTS ENGINEERS PLANNERS 2 Thomas Drive Westbrook, ME 04092 TEL (207) 774-5155 FAX (207) 772-7410	MAINE TURNPIKE AUTHORITY 	YORK TOLL PLAZA CANOPY EXTENSION ELECTRICAL PLAN AND ELEVATIONS SHEET NUMBER: E2 OF																		
<table border="1"> <thead> <tr> <th>No.</th> <th>Revision</th> <th>By</th> <th>Date</th> </tr> </thead> <tbody> <tr> <td> </td> <td> </td> <td> </td> <td> </td> </tr> </tbody> </table>	No.	Revision	By	Date					<table border="1"> <thead> <tr> <th>Designed</th> <th>By</th> <th>Date</th> <th>By</th> <th>Date</th> </tr> </thead> <tbody> <tr> <td> </td> <td> </td> <td> </td> <td> </td> <td> </td> </tr> </tbody> </table>	Designed	By	Date	By	Date									CONTRACT: 2001.15
No.	Revision	By	Date																				
Designed	By	Date	By	Date																			

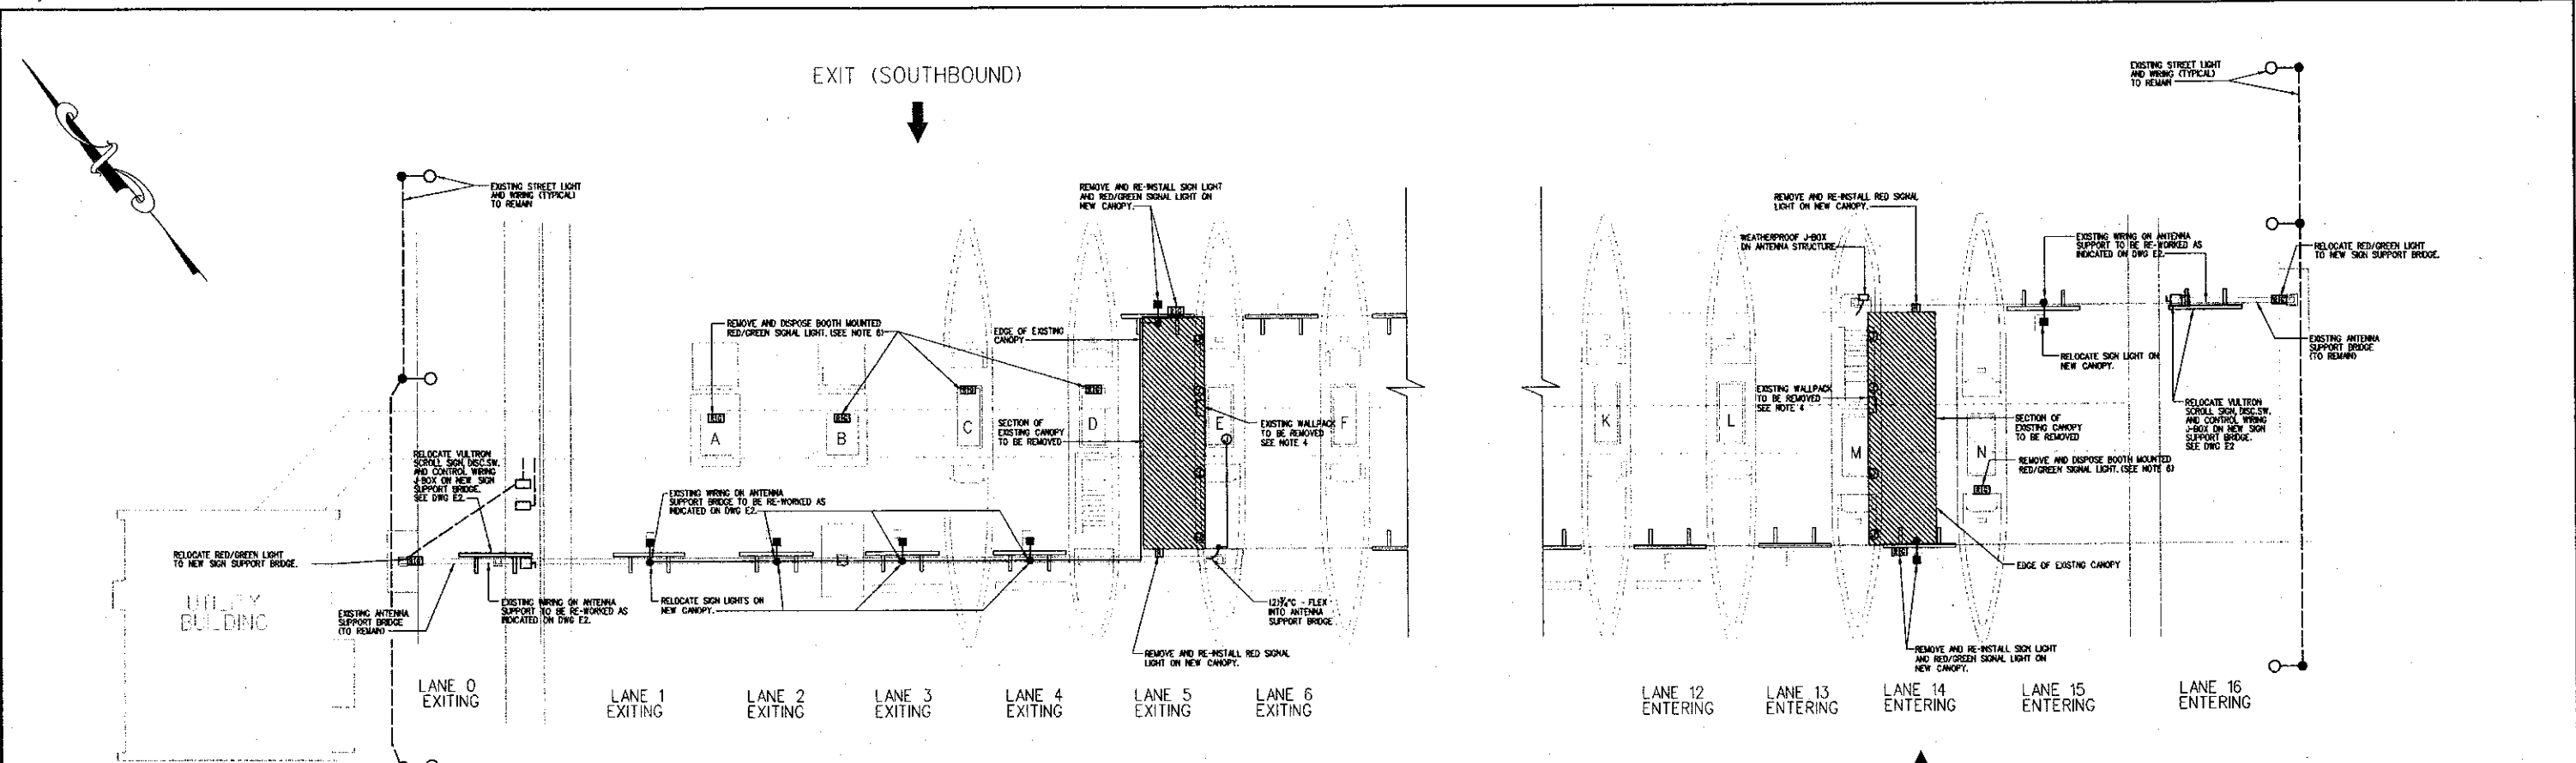


YORK TOLL PLAZA - ELECTRICAL DEMOLITION PLAN
SCALE: 3/32" = 1'-0"

- NOTES:**
1. CONDUIT/WIRES FEEDING RED/GREEN LIGHTS IN LANE 0 & 16 FROM TUNNEL TO ELECTRIC PULL BOX ON ISLAND (BETWEEN LANES 0&1/15&16) TO COLUMN BASE AND UP INTO TUBE STEEL COLUMN.
 2. CONDUITS/WIRES FEEDING VULTRON SIGN IN LANE 0 FEED THROUGH EXISTING ANTENNA SUPPORT BRIDGE FROM BOOTH E.
 3. CONDUITS/WIRES FEEDING VULTRON SIGN IN LANE 16 FEED THROUGH EXISTING SUPPORT BRIDGE FROM BOOTH M.
 4. WALL PACKS TO BE REMOVED AND TURNED OVER TO PROJECT INSPECTOR FOR MTA USE.
 5. PRIOR TO REMOVAL OF EXISTING CANOPY LIGHTS AND CONDUITS IN LANES 5 & 14 CONTRACTOR SHALL TRACE POWER CIRCUITS AND REROUTE (IF REQ'D) TO MAINTAIN POWER TO ADJACENT CANOPY SIGN, SIGN LIGHTS, TRANSPASS EQUIP., ETC.
 6. BOOTH MOUNTED RED/GREEN SIGNAL LIGHTS SHALL NOT BE REMOVED UNTIL THE CANOPY IS ERECTED AND THE NEW RED/GREEN SIGNAL LIGHTS ARE INSTALLED AND READY TO BE WIRED TO THE RELAY CONTROL SWITCH.

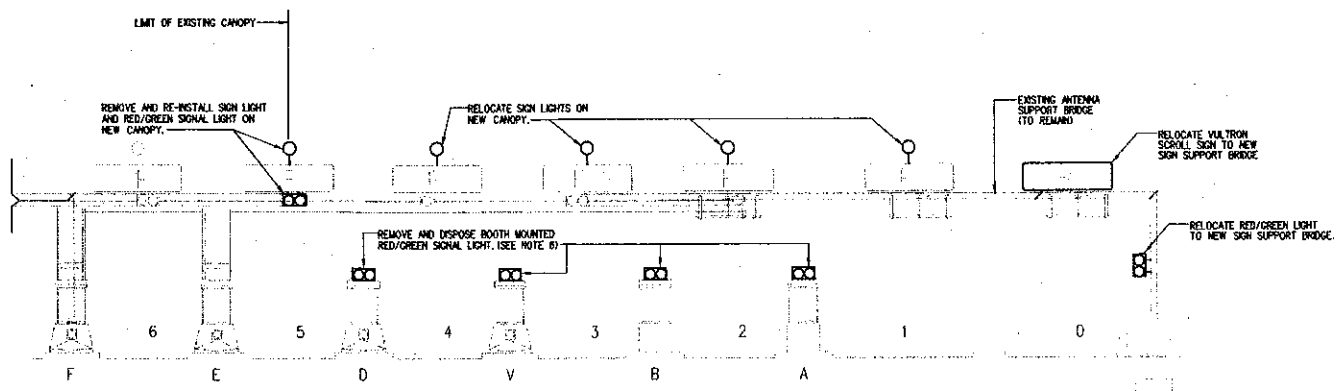

YORK TOLL PLAZA ELEVATION - SOUTHBOUND
SCALE: 3/32" = 1'-0"

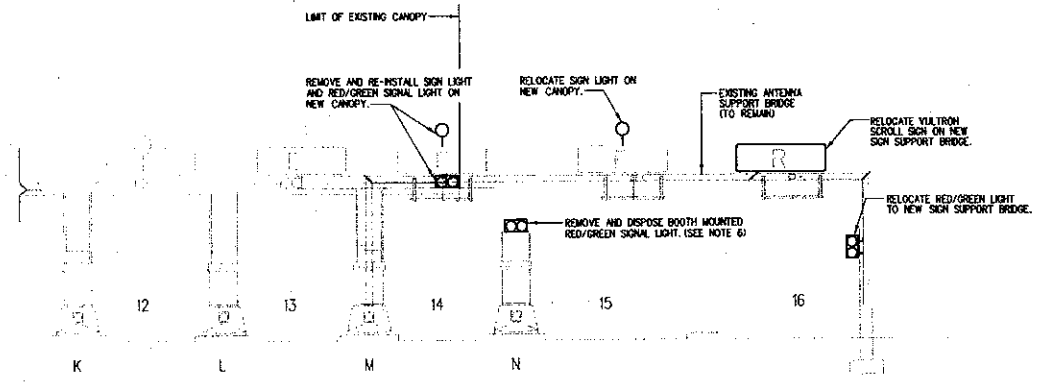


YORK TOLL PLAZA ELEVATION - NORTHBOUND
SCALE: 3/32" = 1'-0"

Scale:		Designed by: BENNETT ENGINEERING CONSULTING ENGINEERS <small>BENNETT ROAD, P.O. BOX 297, FREEPORT, MAINE 04032 (207) 865-9475</small>				PE Stamp: 		Approved by: HNTB HNTB CORPORATION ARCHITECTS ENGINEERS PLANNERS 2 Thomas Drive Westbrook, ME 04092 TEL (207) 774-5155 FAX (207) 772-7410		MAINE TURNPIKE AUTHORITY YORK TOLL PLAZA CANOPY EXTENSION ELECTRICAL DEMOLITION PLAN AND ELEVATIONS																																	
<table border="1" style="width:100%; border-collapse: collapse;"> <thead> <tr> <th>No.</th> <th>Revision</th> <th>By</th> <th>Date</th> </tr> </thead> <tbody> <tr><td> </td><td> </td><td> </td><td> </td></tr> <tr><td> </td><td> </td><td> </td><td> </td></tr> <tr><td> </td><td> </td><td> </td><td> </td></tr> </tbody> </table>		No.	Revision	By	Date													<table border="1" style="width:100%; border-collapse: collapse;"> <thead> <tr> <th>By</th> <th>Date</th> <th>By</th> <th>Date</th> </tr> </thead> <tbody> <tr> <td>WSB</td> <td>8/01</td> <td> </td> <td> </td> </tr> <tr> <td>SPD</td> <td>8/01</td> <td> </td> <td> </td> </tr> </tbody> </table>		By	Date	By	Date	WSB	8/01			SPD	8/01			<table border="1" style="width:100%; border-collapse: collapse;"> <tr> <td>DESIGNED</td> <td> </td> <td> </td> <td> </td> </tr> <tr> <td>DRAWN</td> <td> </td> <td> </td> <td> </td> </tr> </table>		DESIGNED				DRAWN				SHEET NUMBER: E1 CONTRACT: 2001.15 OF	
No.	Revision	By	Date																																								
By	Date	By	Date																																								
WSB	8/01																																										
SPD	8/01																																										
DESIGNED																																											
DRAWN																																											

Date: 4/25/2018

Filename: 001_Title Sheet.dgn

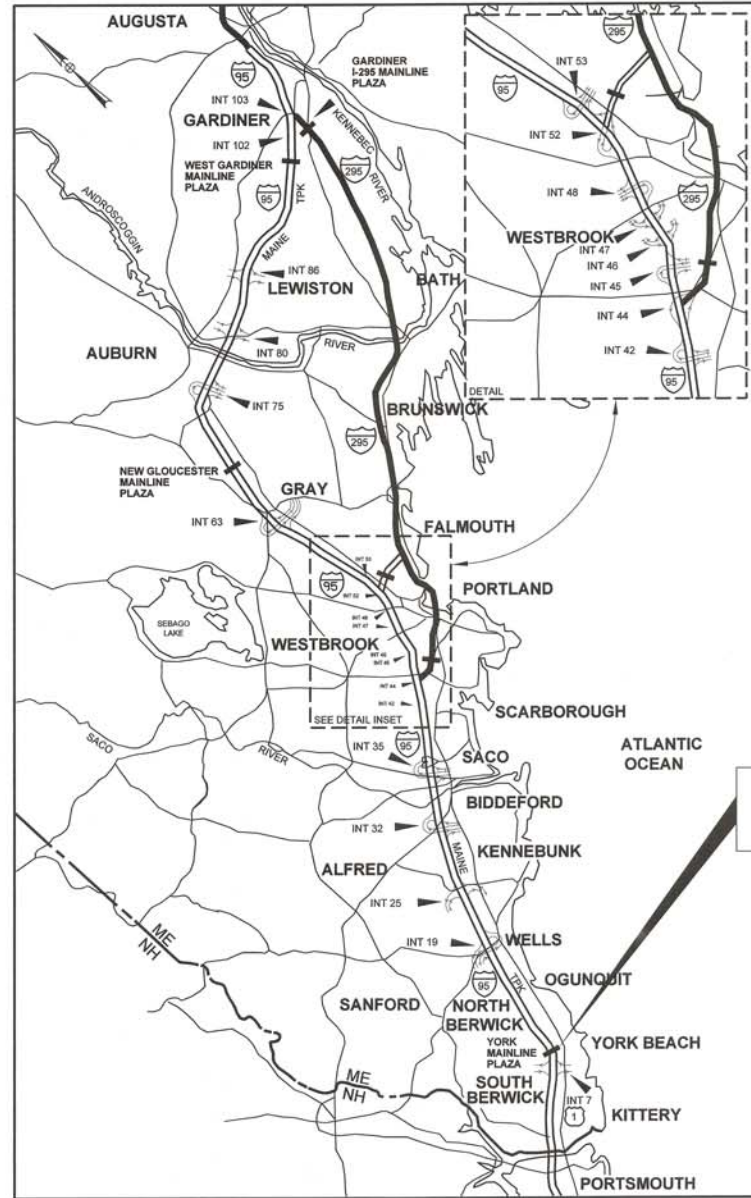

LOCATION MAP

CONTRACT 2018.22
 YORK TOLL PLAZA
 PAVING REHABILITATION
 MILE 7.3



THE GOLD STAR
 MEMORIAL HIGHWAY

MAINE TURNPIKE AUTHORITY

DANIEL E. WATHEN, CHAIR
 ROBERT D. STONE, VICE CHAIR
 MICHAEL J. CIANCHETTE, MEMBER
 JOHN E. DORITY, MEMBER
 ANN R. ROBINSON, MEMBER
 THOMAS J. ZUKE, MEMBER
 KAREN S. DOYLE, MEMBER EX-OFFICIO

S. PETER MILLS, EXECUTIVE DIRECTOR

CONTRACT 2018.22 YORK TOLL PLAZA PAVING REHABILITATION MILE 7.3

INDEX OF SHEETS

SHEET NO.	DESCRIPTION
1	TITLE SHEET
2	GENERAL NOTES AND ESTIMATED QUANTITIES
3	MAINTENANCE OF TRAFFIC
4	TYPICAL PROFILE ADJUSTMENT
5-6	PLANS
7-8	GRADING PLANS
9	SENSOR LOOP INSTALLATION DETAILS
10	TUNNEL REPAIR PLAN
11	TUNNEL SLAB REPAIR AND SHOULDER RECONSTRUCTION DETAILS

CONTRACT 2018.22

APPROVED: MAINE TURNPIKE AUTHORITY

Peter S. Merfeld
 PETER S. MERFELD, P.E. - CHIEF OPERATIONS OFFICER
 DATE: 4/27/18

Stephen R. Tartre
 STEPHEN R. TARTRE, P.E. - DIRECTOR OF ENGINEERING & BUILDING MAINTENANCE
 DATE: 4/27/18

HNTB



Roland A. Lavalley
 ROLAND A. LAVALLEY P.E., PLS
 VICE PRESIDENT
 DIRECTOR OF OPERATIONS
 DATE: 4/25/18

GENERAL NOTES

1. THE CONTRACTOR IS REQUIRED TO CALL DIG SAFE AT 1-888-344-7233 AT LEAST 72 HOURS PRIOR TO START OF WORK.

2. THE CONTRACTOR SHALL NOTIFY THE RESIDENT 5 DAYS PRIOR TO CONSTRUCTION SO THE RESIDENT CAN ARRANGE FOR MAINE TURNPIKE UNDERGROUND UTILITY LOCATION. ALL PROPOSED SIGN LOCATIONS AND EXCAVATION LOCATIONS SHALL BE MARKED AT THE TIME OF NOTIFICATION. EXCAVATION WILL NOT BE PERMITTED UNTIL THE AUTHORITY HAS LOCATED AND MARKED ITS UNDERGROUND UTILITIES, OR NOTIFIED THE RESIDENT THERE ARE NO UNDERGROUND UTILITIES IN THE MARKED AREAS.

THE AUTHORITY HAS PROGRAMMED TWO FIELD VISITS FOR MAINE TURNPIKE UTILITY COORDINATION ON THIS PROJECT. SHOULD THE CONTRACTOR NEED ADDITIONAL SIGN LOCATIONS AND/OR ADDITIONAL EXCAVATION LOCATIONS MARKED, OR SHOULD THE CONTRACTOR FAIL TO MAINTAIN THE AUTHORITY'S PREVIOUSLY ESTABLISHED DIG SAFE MARKS, THE AUTHORITY SHALL DEDUCT THE ADDED MARKING COSTS FROM THE CONTRACTOR'S PAYMENTS.

3. EXCAVATIONS ACCOMPLISHED AS PART OF THIS PROJECT SHALL BE CONSTRUCTED IN ACCORDANCE WITH OSHA SUBPART P OF 29 CFR PART 1926.650-652 (CONSTRUCTION STANDARDS FOR EXCAVATIONS).

4. ALL DETAILS SHALL BE IN CONFORMANCE WITH MAINE DEPARTMENT OF TRANSPORTATION (MAINEDOT) STANDARD DETAILS HIGHWAY AND BRIDGES 2014, WITH LATEST REVISIONS, AND MAINEDOT BEST MANAGEMENT PRACTICES FOR EROSION AND SEDIMENT CONTROL, LATEST REVISION, UNLESS OTHERWISE INCLUDED IN THESE PLANS.

5. REINFORCING STEEL SHALL HAVE A CLEAR COVER OF 2" UNLESS OTHERWISE NOTED.

6. CHAMFER ALL EXPOSED CONCRETE EDGES 3/4" UNLESS OTHERWISE NOTED.

7. WHERE DRILLING AND ANCHORING OF REINFORCING STEEL IS SPECIFIED THE CONTRACTOR SHALL USE A MATERIAL LISTED ON THE MAINEDOT PREQUALIFIED LIST OF CONCRETE ADHESIVE ANCHORING MATERIALS. THE CONTRACTOR SHALL VERIFY THE REQUIRED DEPTH OF EMBEDMENT AND ADJUST THE REQUIRED BAR LENGTHS AS REQUIRED.

8. THERE ARE NO PERMANENT OR TEMPORARY EASEMENTS ASSOCIATED WITH THIS PROJECT. ALL WORK SHALL BE COMPLETED WITHIN THE EXISTING RIGHT OF WAY.

9. THE CONTRACTOR SHALL SUBMIT THE PROPOSED STAGING AREA(S) TO THE RESIDENT PRIOR TO STARTING WORK.

10. ANY DAMAGE TO FINAL PAVEMENT, SLOPES, OR STRUCTURES CAUSED BY THE CONTRACTOR'S EQUIPMENT, PERSONNEL OR OPERATIONS SHALL BE REPAIRED TO THE SATISFACTION OF THE RESIDENT. ALL WORK, EQUIPMENT, AND MATERIALS REQUIRED TO MAKE REPAIRS SHALL BE AT THE CONTRACTOR'S EXPENSE.

DRAINAGE NOTES

1. NO EXISTING DRAINAGE SHALL BE ABANDONED, REMOVED OR PLUGGED WITHOUT APPROVAL OF THE RESIDENT.

EROSION CONTROL

1. ALL TEMPORARY EROSION CONTROL DEVICES SHALL BE INSTALLED IN ACCORDANCE WITH THE MAINE DEPARTMENT OF TRANSPORTATION BEST MANAGEMENT PRACTICES.

2. ADDITIONAL MEASURES MAY BE PROPOSED BY THE CONTRACTOR DUE TO SITE OR WEATHER CONDITIONS. THE RESIDENT MAY DIRECT THE CONTRACTOR TO IMPLEMENT ADDITIONAL MEASURES. ANY ADDITIONAL MEASURES APPROVED BY THE RESIDENT WILL BE MEASURED FOR PAYMENT.

GUARDRAIL NOTES

1. AT THE END OF THE WORK DAY, EVERYDAY, THE CONTRACTOR IS REQUIRED TO HAVE AN APPROVED CRASHWORTHY END TREATMENT ON ALL GUARDRAIL WITHIN ALL WORK AREAS THAT ARE ACCESSIBLE TO TRAFFIC.

2. CONNECTIONS FOR PROPOSED GUARDRAIL TO EXISTING GUARDRAIL SHALL BE INCIDENTAL TO THE PROPOSED GUARDRAIL ITEMS.

3. FOR ALL NEW GUARDRAIL TYPE 3d, OFFSET BLOCKS SHALL BE NON-WOOD CONFORMING TO NCHRP 350 TEST LEVEL.

4. ALL PROPOSED GUARDRAIL AND RESET GUARDRAIL SHALL BE INSTALLED IN A MANNER TO AVOID DRAINAGE STRUCTURES AND UTILITIES.

EARTHWORK

1. WASTE MATERIALS SHALL BE DISPOSED OF OFF THE PROJECT SITE, IN ACCORDANCE WITH ALL ENVIRONMENTAL REGULATIONS.

MATERIALS

CONCRETE

SUBSTRUCTURE CONCRETE REPAIR MATERIALS SHALL BE PER SPECIAL PROVISION 518. ALL OTHER CONCRETE SHALL BE CLASS AAA.

REINFORCING STEEL

ASTM A 615, GRADE 60
AASHTO M55 WELDED WIRE FABRIC

ITEM NO.	ITEM DESCRIPTION	UNIT	TOTAL QUANTITY
202.202	Removing Pavement Surface - Mainline	SY	2600
202.202I	Removing Pavement Surface - Bridge Deck	SY	120
205.51I	Widening of Existing Shoulder	LF	250
403.208	Hot Mix Asphalt, 12.5mm Nominal Maximum Size, RAP	TON	500
403.21I	Hot Mix Asphalt, Shimming	TON	920
409.15	Bituminous Tack Coat, Applied	Gal	780
502.50	Structural Concrete Island Extension	CY	20
503.12	Reinforcing Steel, Fabricated and Delivered	LB	350
503.13	Reinforcing Steel, Placing	LB	350
503.16	Welded Steel Fabric, Fabricated, Complete and In Place	LB	150
518.80I	Concrete Tunnel Slab Repairs	SF	140
604.18I	Adjusting Manhole or Catch Basin to Grade	EA	2
606.24	Guardrail Type 3d - Single Rail	LF	137.5
606.3605	Guardrail - Remove, Modify and Reset, Single Rail	LF	112.5
606.362I	Guardrail - Adjust, Single Rail	LF	50
606.363I	Guardrail - Remove and Dispose	LF	137.5
627.802	Temporary Raised Pavement Markers	EA	600
629.05	Hand Labor, Straight Time	HR	20
631.10	Air Compressor (including operator)	HR	10
631.1I	Air Tool (including operator)	HR	20
631.12	All Purpose Excavator (including operator)	HR	10
631.172	Truck - Large (including operator)	HR	10
631.36	Foreman	HR	20
645.109	Remove and Reset Sign	EA	6
652.30	Type III Barricade	EA	6
652.33I	Drum	EA	90
652.35	Construction Signs	SF	230
652.36I	Maintenance of Traffic Control Devices	LS	1
652.4I	Portable Changeable Message Sign	EA	3
652.45	Truck Mounted Attenuator	CD	35
652.45I	Automated Trailer Mounted Speed Limit Sign	CD	35
655.04	Installation of Sensor Loops	LS	1
656.632	30 inch Temporary Silt Fence	LF	300
659.10	Mobilization	LS	1

LIST OF ABBREVIATIONS

- ABUT. - ABUTMENT
- ADDL. - ADDITIONAL
- ALT. - ALTERNATE
- APPROX. - APPROXIMATELY
- BOT. - BOTTOM
- BRG. - BEARING
- CL. - CLEAR
- CL - CENTERLINE
- CONC. - CONCRETE
- CONSTR. - CONSTRUCTION
- DEMO. - DEMOLITION
- DIA. - DIAMETER
- EA. - EACH
- EB - EASTBOUND
- E.F. - EACH FACE
- EL. - ELEVATION
- EQ. - EQUAL
- EXIST. - EXISTING
- EXP. - EXPANSION
- F.F. - FAR FACE
- JT. - JOINT
- MAX. - MAXIMUM
- MAINEDOT - MAINE DEPARTMENT OF TRANSPORTATION
- MIN. - MINIMUM
- MTA - MAINE TURNPIKE AUTHORITY
- NB - NORTHBOUND
- N.F. - NEAR FACE
- N.T.S. - NOT TO SCALE
- PED. - PEDESTAL
- PGL - PROFILE GRADE LINE
- PL - PLATE
- PROP. - PROPOSED
- P.S.I. - POUNDS per SQUARE INCH
- RDWY. - ROADWAY
- SHLDR. - SHOULDER
- SB - SOUTHBOUND
- SP. - SPACES
- STA. - STATION
- T.&B. - TOP & BOTTOM
- TPKE. - TURNPIKE
- TYP. - TYPICAL
- U.O.N. - UNLESS OTHERWISE NOTED
- VERT. - VERTICAL
- WB - WESTBOUND
- W.P. - WORKING POINT

Date: 4/30/2018

Filename: 002_GeneralNotes and Estimate Quantities.dgn

Scale:		Designed by:			
		HNTB			
No.	Revision	By	Date		
				CONSULTANT PROJECT MANAGER: Dale Mitchell, P.E.	
		By	Date	By	Date
		Designed	PEM 04/18	Checked	CAH 04/18
		Drawn	SLS 04/18	In Charge of	RAL 04/18

HNTB CORPORATION
340 County Road, Suite 6-C
Westbrook, ME 04092
TEL (207) 774-5155
FAX (207) 228-0909

THE GOLD STAR
MEMORIAL HIGHWAY

MTA PROJECT MANAGER: Peter S. Merfeld, P.E.


YORK TOLL PLAZA
PAVEMENT REHABILITATION

GENERAL NOTES AND
ESTIMATED QUANTITIES


SHEET NUMBER: QT-1
CONTRACT: 2018.22
2 OF 11

Date: 4/30/2018

Filename: 003_Maintenance of Traffic.dgn

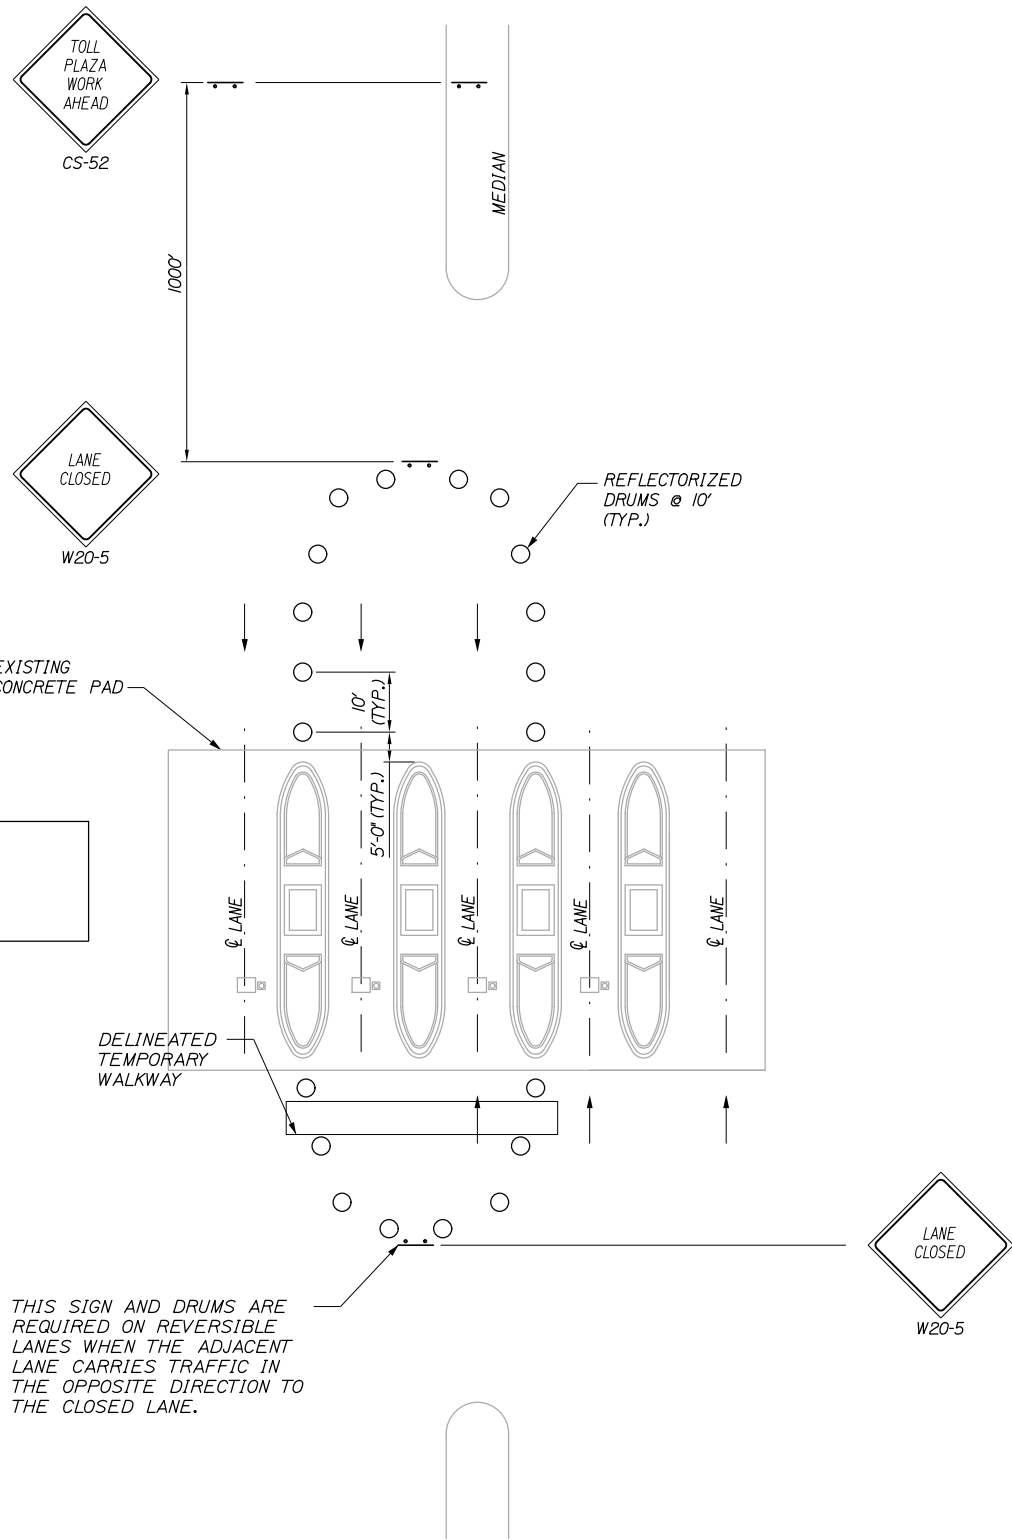

YORK TOLL PLAZA INTERIOR LANE(S) CLOSURE
N.T.S.

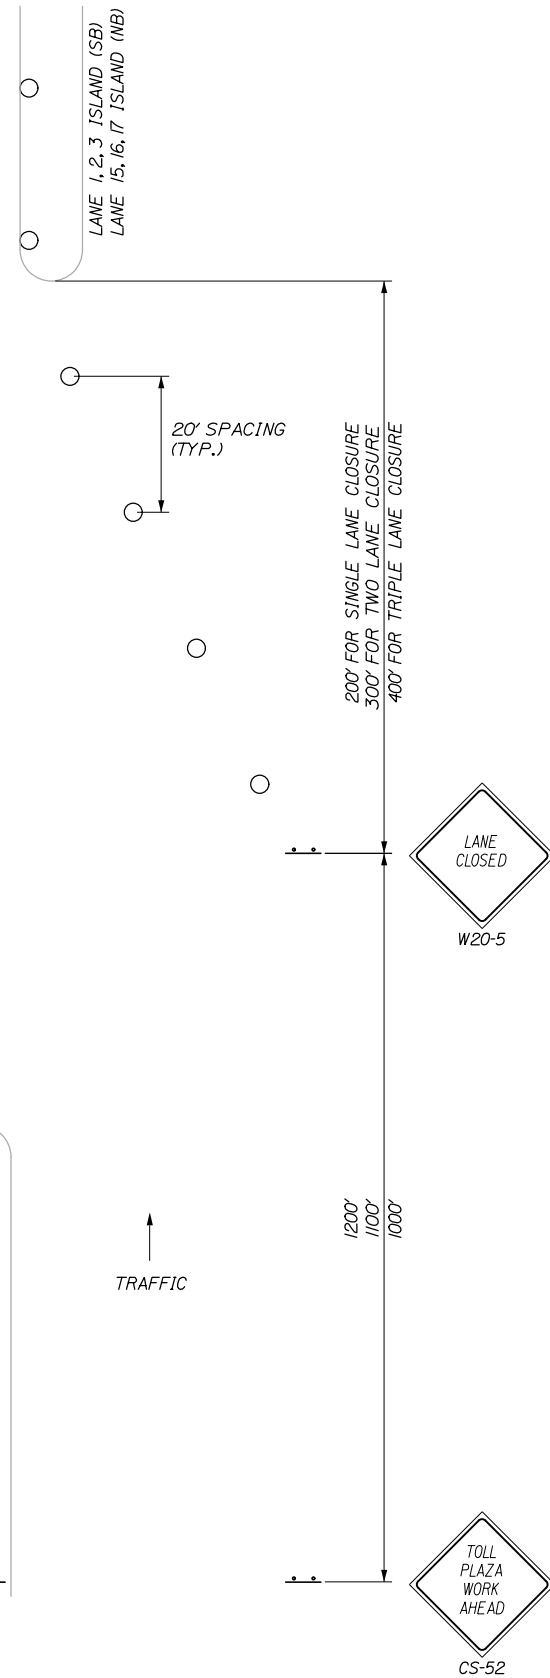

YORK TOLL PLAZA EXTERIOR LANE(S) CLOSURE
N.T.S.

IDENTIFICATION NUMBER	SIZE OF SIGN		TEXT	TEXT DIMENSIONS (INCHES)			NUMBER OF SIGNS REQUIRED	COLOR		BORDER RADIUS	AREA IN SQUARE FEET
	WIDTH	HEIGHT		LETTER HEIGHT	VERTICAL SPACING	ARROW RTE. MKR.		BACK-GROUND	LEGEND BORDER		
CS-52	48"	48"	TOLL PLAZA WORK AHEAD	TEXT DIMENSIONS SHALL CONFORM TO 'STANDARD HIGHWAY SIGNS' - 2000			5	ORANGE	BLACK		16.00 (80.00)
W20-5	48"	48"	LANE CLOSED				8				16.00 (128.00)
* ALSO PROVIDE 10 - 10"x14" "DANGER" SIGNS AS SPECIFIED IN APPENDIX A - PLAZA SAFETY REQUIREMENTS.											1.00 (10.00)

NOTES:

1. A SINGLE LANE CLOSURE IS REQUIRED FOR CONSTRUCTION AND MAINTENANCE WORK IN THE LANE OR ON AN ISLAND.
2. CANOPY LIGHT ABOVE CLOSED LANE SHALL BE RED.
3. ALL CONSTRUCTION SIGNS SHALL BE 4'X4'.
4. ALL CONSTRUCTION SIGNS MAY BE MOUNTED ON EASELS.
5. CONTRACTOR SHALL MAINTAIN A 5' WIDE PATHWAY FOR MTA EMPLOYEES TO ACCESS PLAZA BUILDING AND TOLL BOOTHS TO CROSS WORK ZONES SAFELY DURING ALL PHASES OF WORK. THIS MAY REQUIRE BREAKS IN BARRIER, USE OF BARRELS, SAFETY TAPE DELINEATING PATHS AND TEMPORARY SIGNAGE. THE PATH SHALL BE LIGHTED FROM DUSK TO DAWN AND FREE FROM TRIP HAZARDS. LIGHTING, SIGNAGE AND SAFETY TAPE SHALL BE INCIDENTAL TO ITEM 659.10 MOBILIZATION.
6. REFER TO APPENDIX A OF SPECIFICATIONS FOR PLAZA SAFETY REQUIREMENTS.

Scale: N.T.S.			
No.	Revision	By	Date

Designed by:					
HNTB					
CONSULTANT PROJECT MANAGER: Dale Mitchell, P.E.					
	By	Date		By	Date
Designed	PEM	04/18	Checked	CAH	04/18
Drawn	SLS	04/18	In Charge of	RAL	04/18

HNTB CORPORATION
340 County Road, Suite 6-C
Westbrook, ME 04092
TEL (207) 774-5155
FAX (207) 228-0909

**THE GOLD STAR
MEMORIAL HIGHWAY**


MTA PROJECT MANAGER: Peter S. Merfeld, P.E.

YORK TOLL PLAZA
PAVEMENT REHABILITATION
MAINTENANCE OF TRAFFIC

SHEET NUMBER: MOT-1
3 OF 11

CONTRACT: 2018.22

Date: 4/30/2018

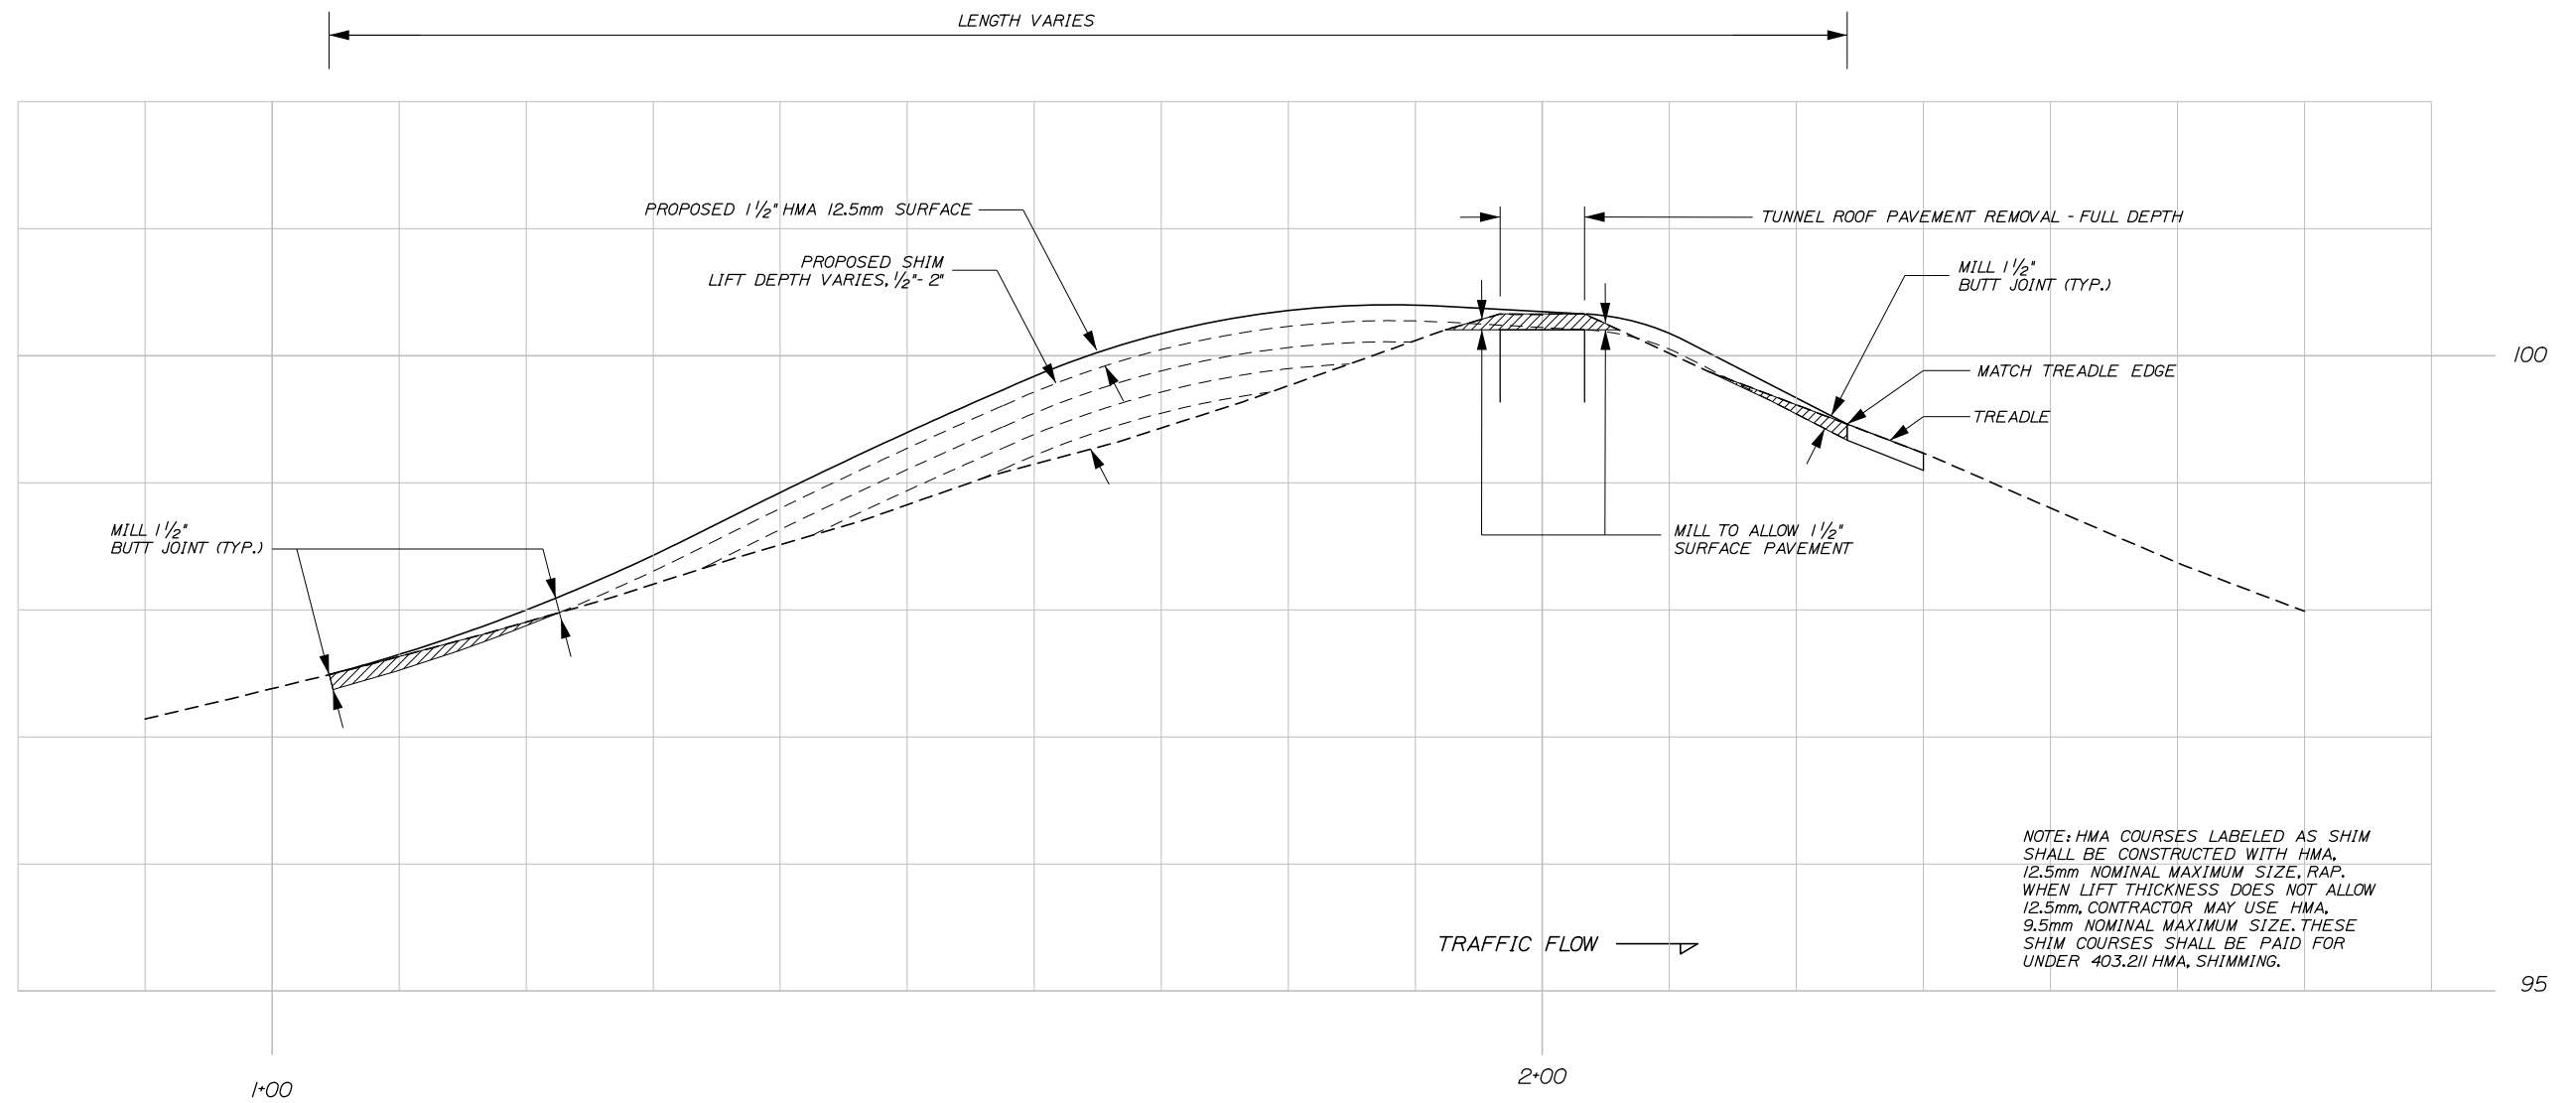

NOTE: HMA COURSES LABELED AS SHIM SHALL BE CONSTRUCTED WITH HMA, 12.5mm NOMINAL MAXIMUM SIZE, RAP. WHEN LIFT THICKNESS DOES NOT ALLOW 12.5mm, CONTRACTOR MAY USE HMA, 9.5mm NOMINAL MAXIMUM SIZE. THESE SHIM COURSES SHALL BE PAID FOR UNDER 403.211 HMA, SHIMMING.


TYPICAL PROFILE ADJUSTMENT
(NORTHBOUND SHOWN, SOUTHBOUND SIMILAR)
N.T.S.

Filename: 004_Typical Profile.dgn

Scale:			
No.	Revision	By	Date

Designed by:					
HNTB					
CONSULTANT PROJECT MANAGER: Dale Mitchell, P.E.					
	By	Date		By	Date
Designed	PEM	04/18	Checked	CAH	04/18
Drawn	PEM	04/18	In Charge of	RAL	04/18

HNTB CORPORATION
340 County Road, Suite 6-C
Westbrook, ME 04092
TEL (207) 774-5155
FAX (207) 228-0909




THE GOLD STAR
MEMORIAL HIGHWAY

MTA PROJECT MANAGER: Peter S. Merfeld, P.E.

YORK TOLL PLAZA
PAVEMENT REHABILITATION

TYPICAL PROFILE ADJUSTMENT

SHEET NUMBER: D-1
CONTRACT: 2018.22
4 OF 11

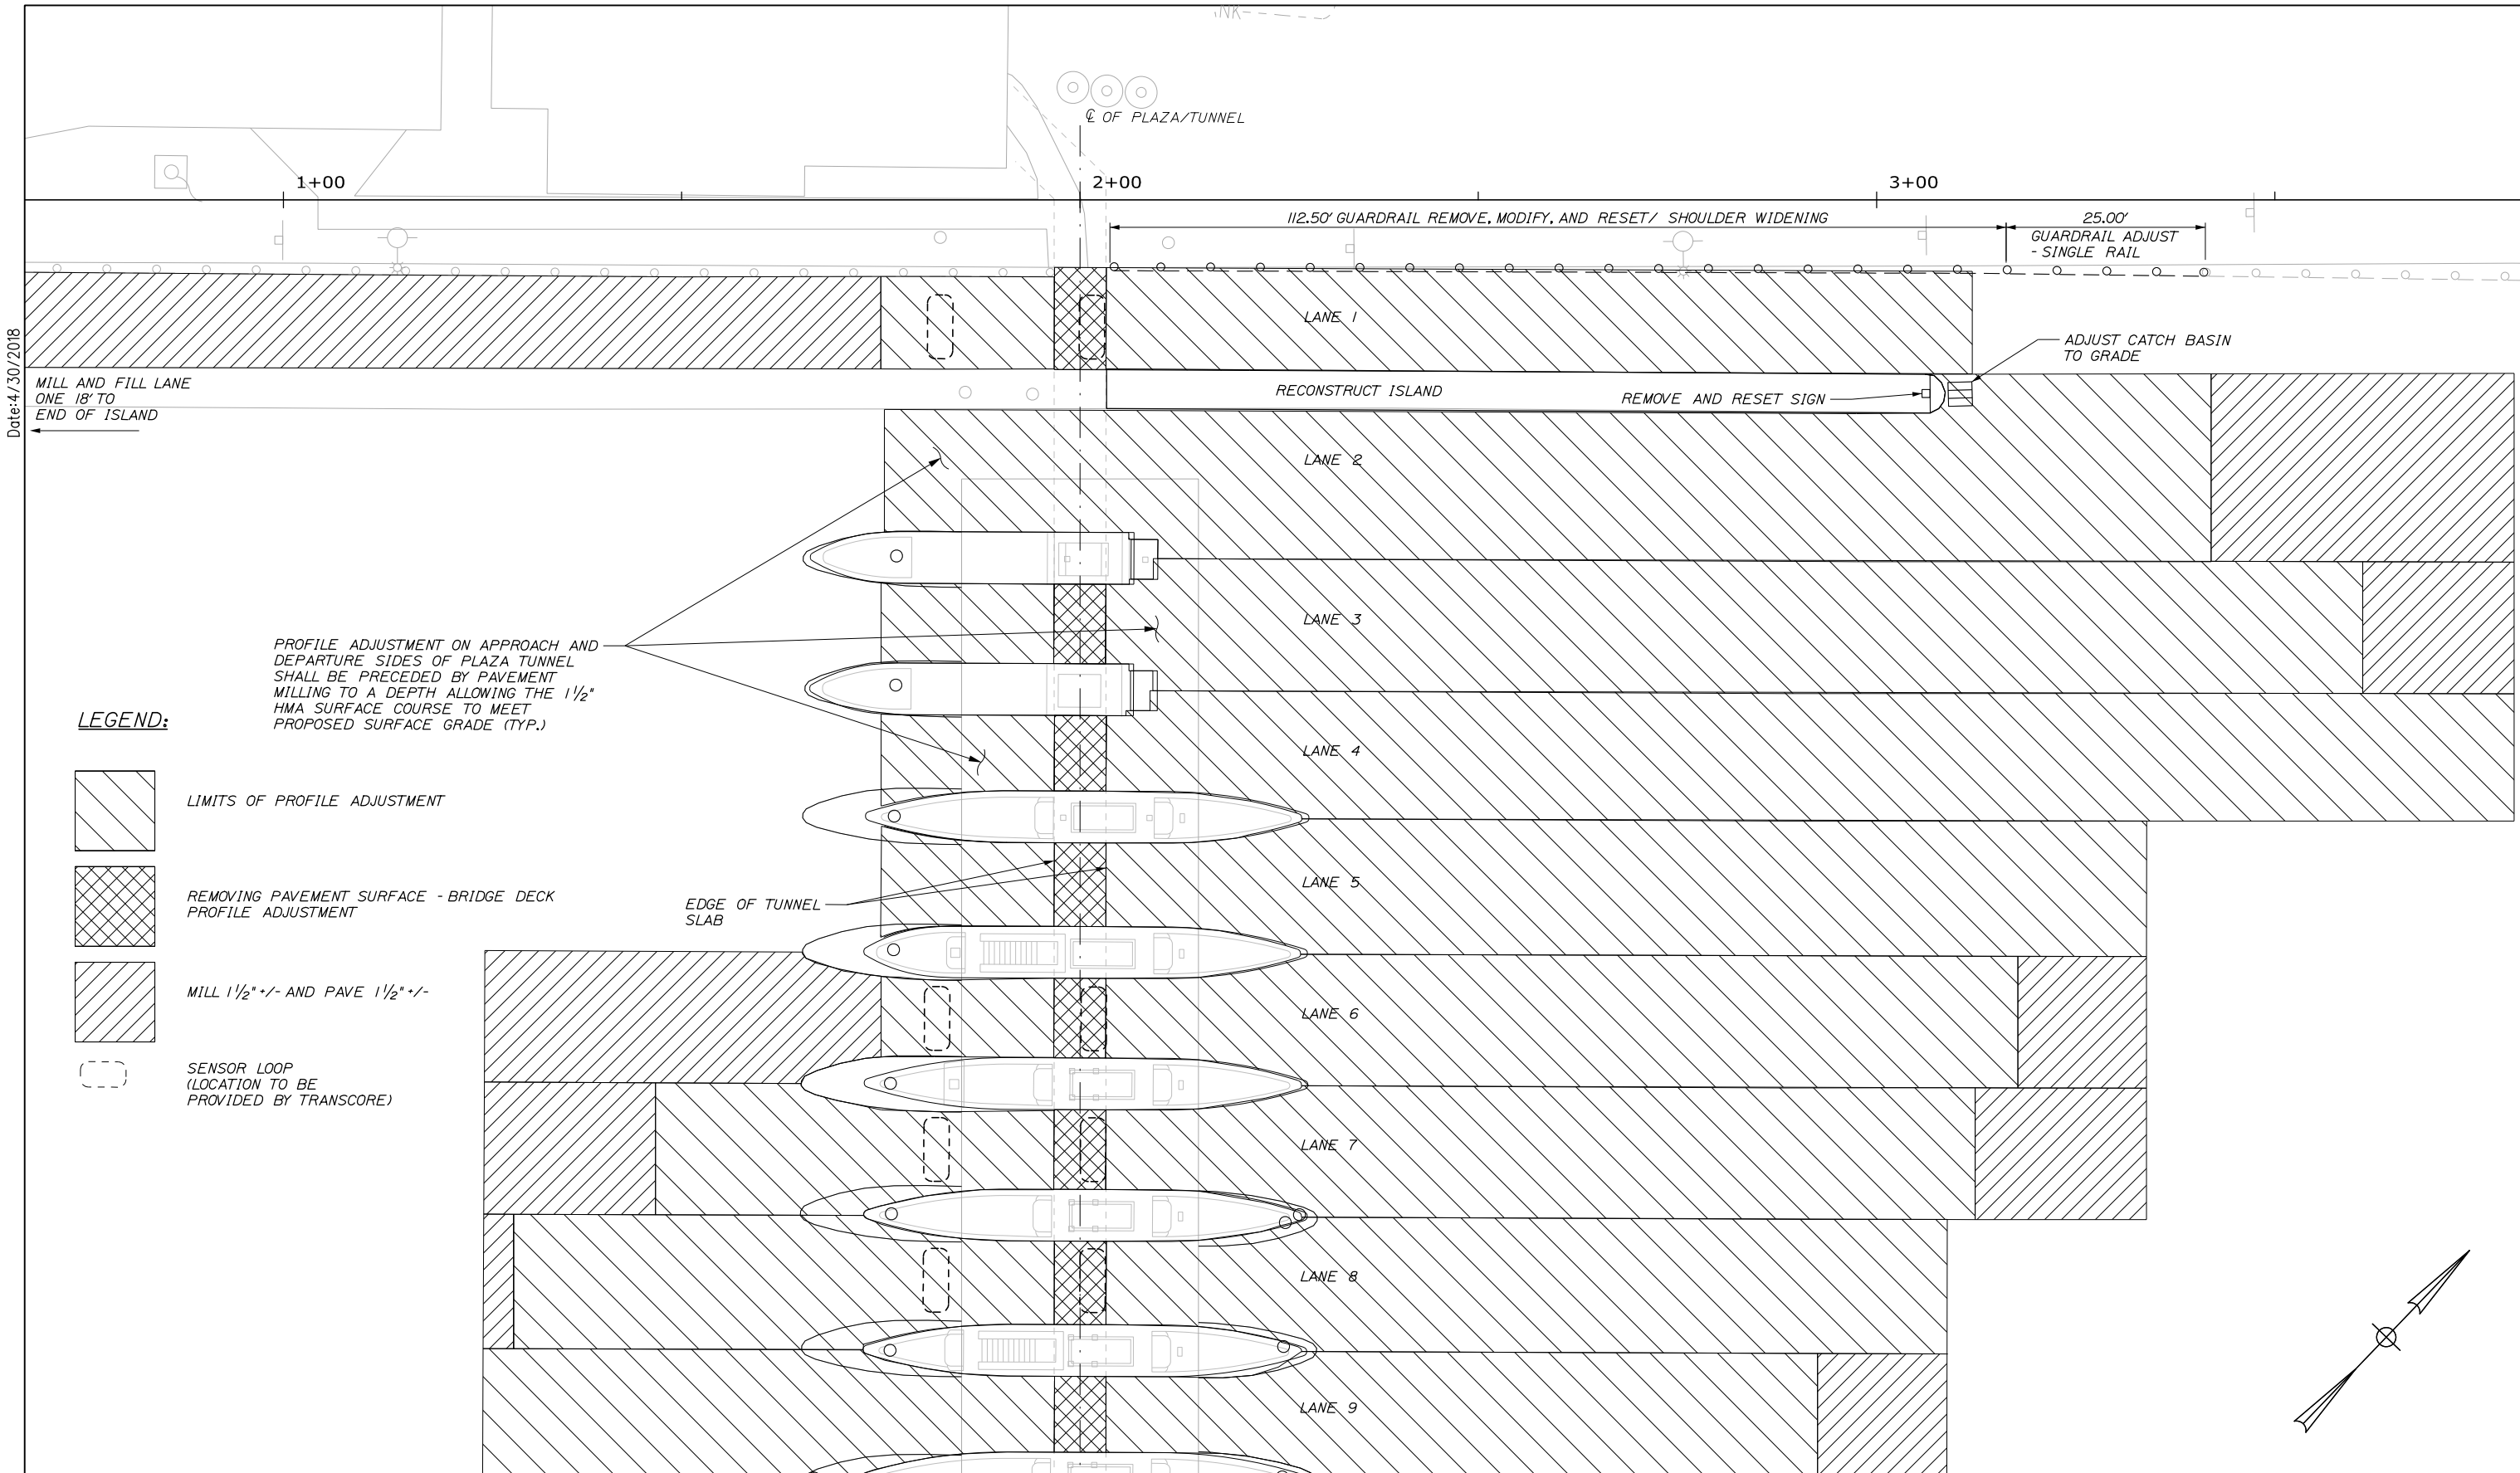


Date: 4/30/2018

LEGEND:

- LIMITS OF PROFILE ADJUSTMENT
- REMOVING PAVEMENT SURFACE - BRIDGE DECK PROFILE ADJUSTMENT
- MILL 1 1/2" +/- AND PAVE 1 1/2" +/-
- SENSOR LOOP (LOCATION TO BE PROVIDED BY TRANSCORE)

PROFILE ADJUSTMENT ON APPROACH AND DEPARTURE SIDES OF PLAZA TUNNEL SHALL BE PRECEDED BY PAVEMENT MILLING TO A DEPTH ALLOWING THE 1 1/2" HMA SURFACE COURSE TO MEET PROPOSED SURFACE GRADE (TYP.)

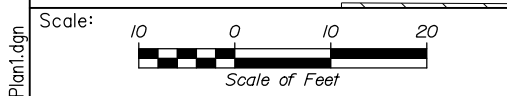

No.	Revision	By	Date

Designed by:

HNTB

HNTB CORPORATION
340 County Road, Suite 6-C
Westbrook, ME 04092
TEL (207) 774-5155
FAX (207) 228-0909

CONSULTANT PROJECT MANAGER: Dale Mitchell, P.E.

	By	Date		By	Date
Designed	PEM	04/18	Checked	CAH	04/18
Drawn	SLS	04/18	In Charge of	RAL	04/18

HNTB CORPORATION
340 County Road, Suite 6-C
Westbrook, ME 04092
TEL (207) 774-5155
FAX (207) 228-0909

THE GOLD STAR
MEMORIAL HIGHWAY

MTA PROJECT MANAGER: Peter S. Merfeld, P.E.


YORK TOLL PLAZA
PAVEMENT REHABILITATION

PLAN 1

SHEET NUMBER: H-1
5 OF 11





CONTRACT: 2018.22


Date: 4/30/2018

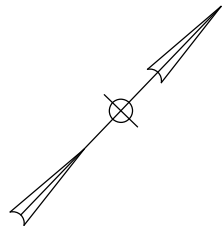

PROFILE ADJUSTMENT ON APPROACH AND DEPARTURE SIDES OF PLAZA TUNNEL SHALL BE PRECEDED BY PAVEMENT MILLING TO A DEPTH ALLOWING THE 1 1/2" HMA SURFACE COURSE TO MEET PROPOSED SURFACE GRADE (TYP.)

LEGEND:

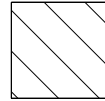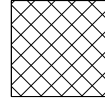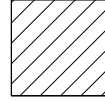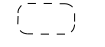-  LIMITS OF PROFILE ADJUSTMENT
-  REMOVING PAVEMENT SURFACE - BRIDGE DECK PROFILE ADJUSTMENT
-  MILL 1 1/2" +/- AND PAVE 1 1/2"
-  SENSOR LOOP (LOCATION TO BE PROVIDED BY TRANSORE)

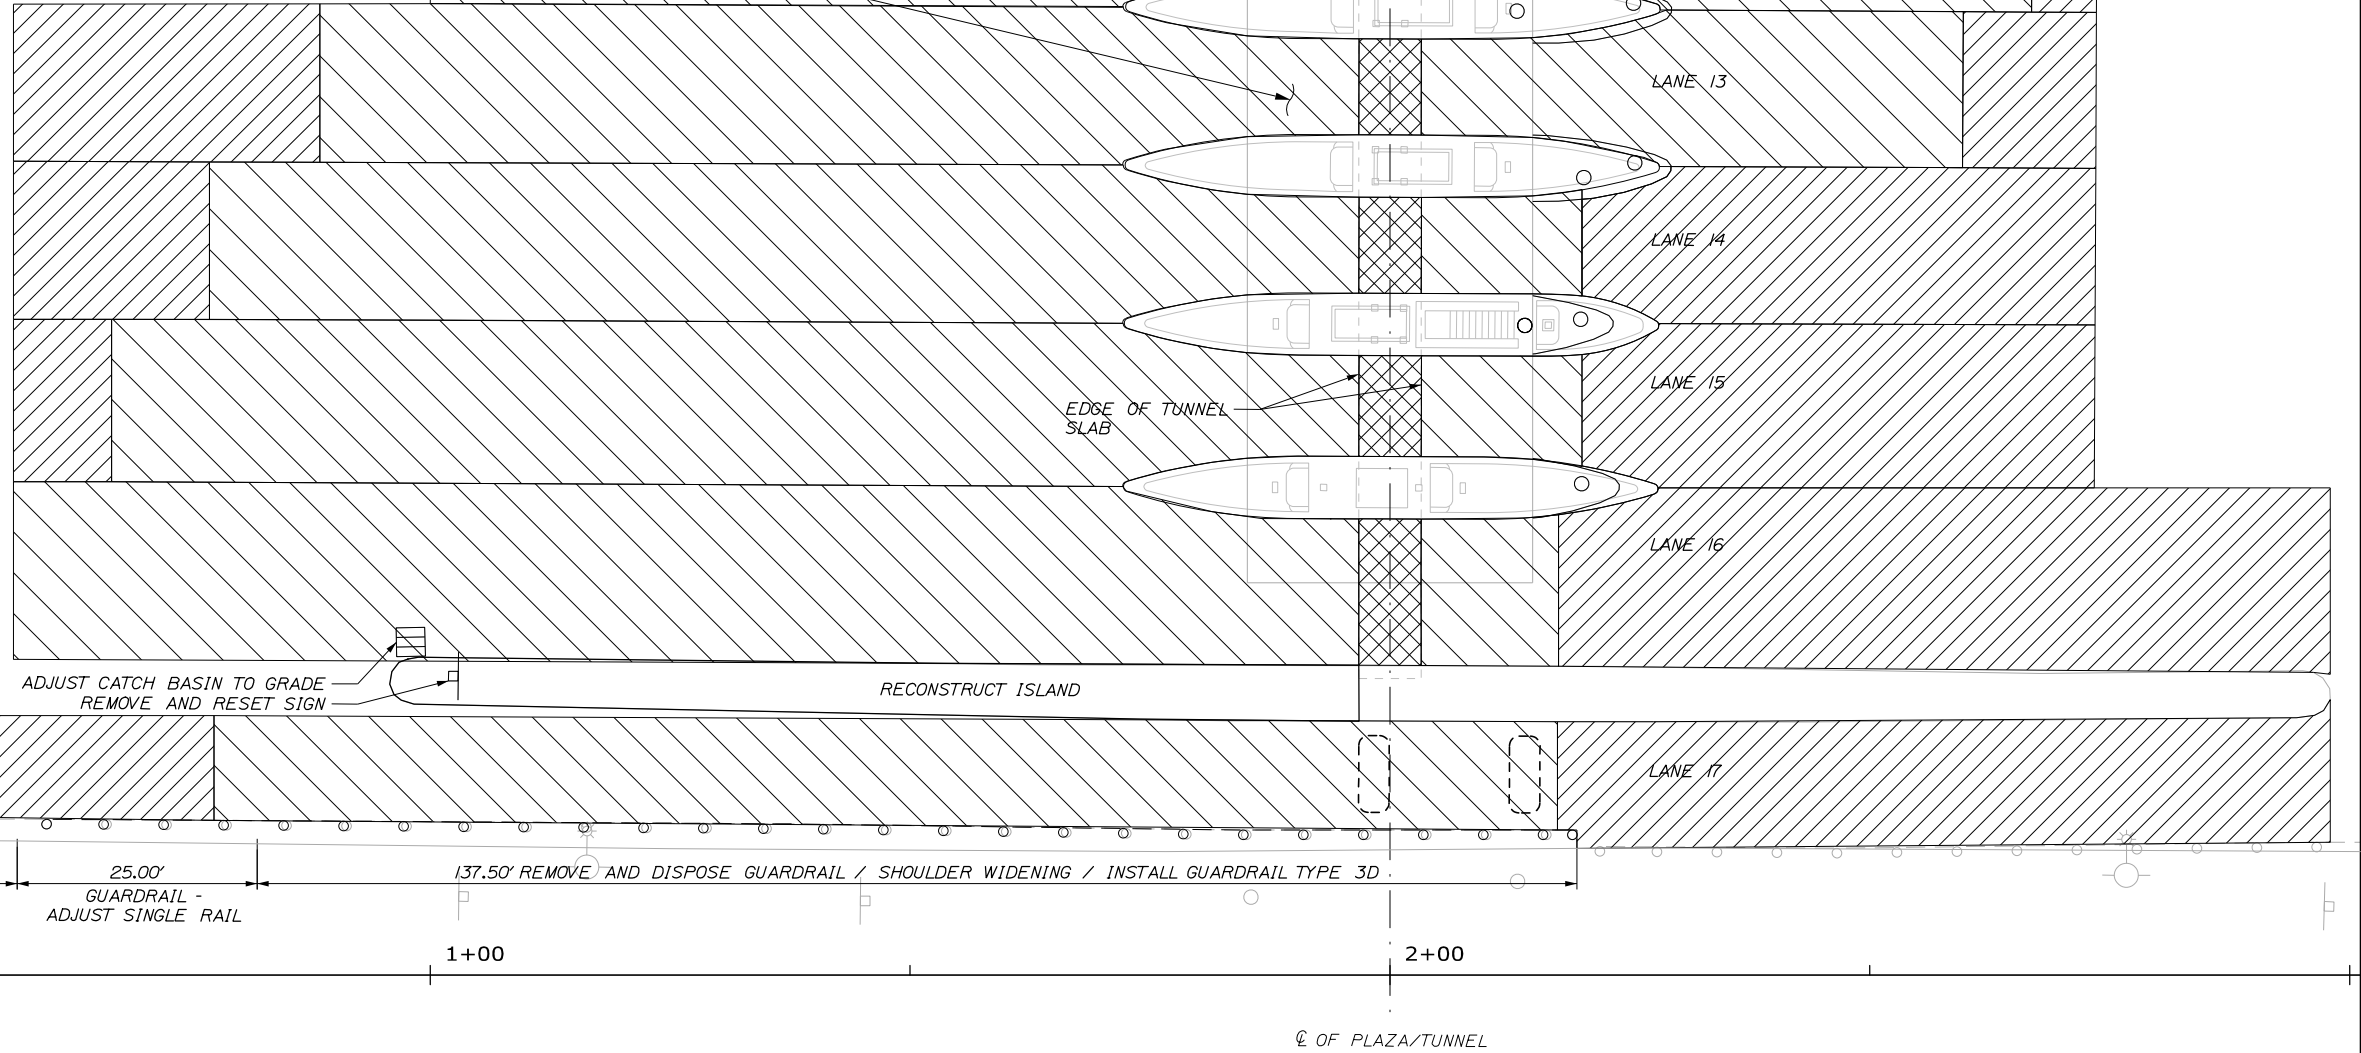

Designed by:



HNTB CORPORATION
340 County Road, Suite 6-C
Westbrook, ME 04092
TEL (207) 774-5155
FAX (207) 228-0909



**THE GOLD STAR
MEMORIAL HIGHWAY**

**YORK TOLL PLAZA
PAVEMENT REHABILITATION**

PLAN 2

No.	Revision	By	Date

CONSULTANT PROJECT MANAGER: Dale Mitchell, P.E.					
Designed	By	Date	Checked	By	Date
	PEM	04/18		CAH	04/18
Drawn	By	Date	In Charge of	By	Date
	SLS	04/18		RAL	04/18

MTA PROJECT MANAGER: Peter S. Merfeld, P.E.


CONTRACT: 2018.22

SHEET NUMBER: H-2

6 OF 11

Filename: 006_HDPlan2.dgn


Date: 4/30/2018

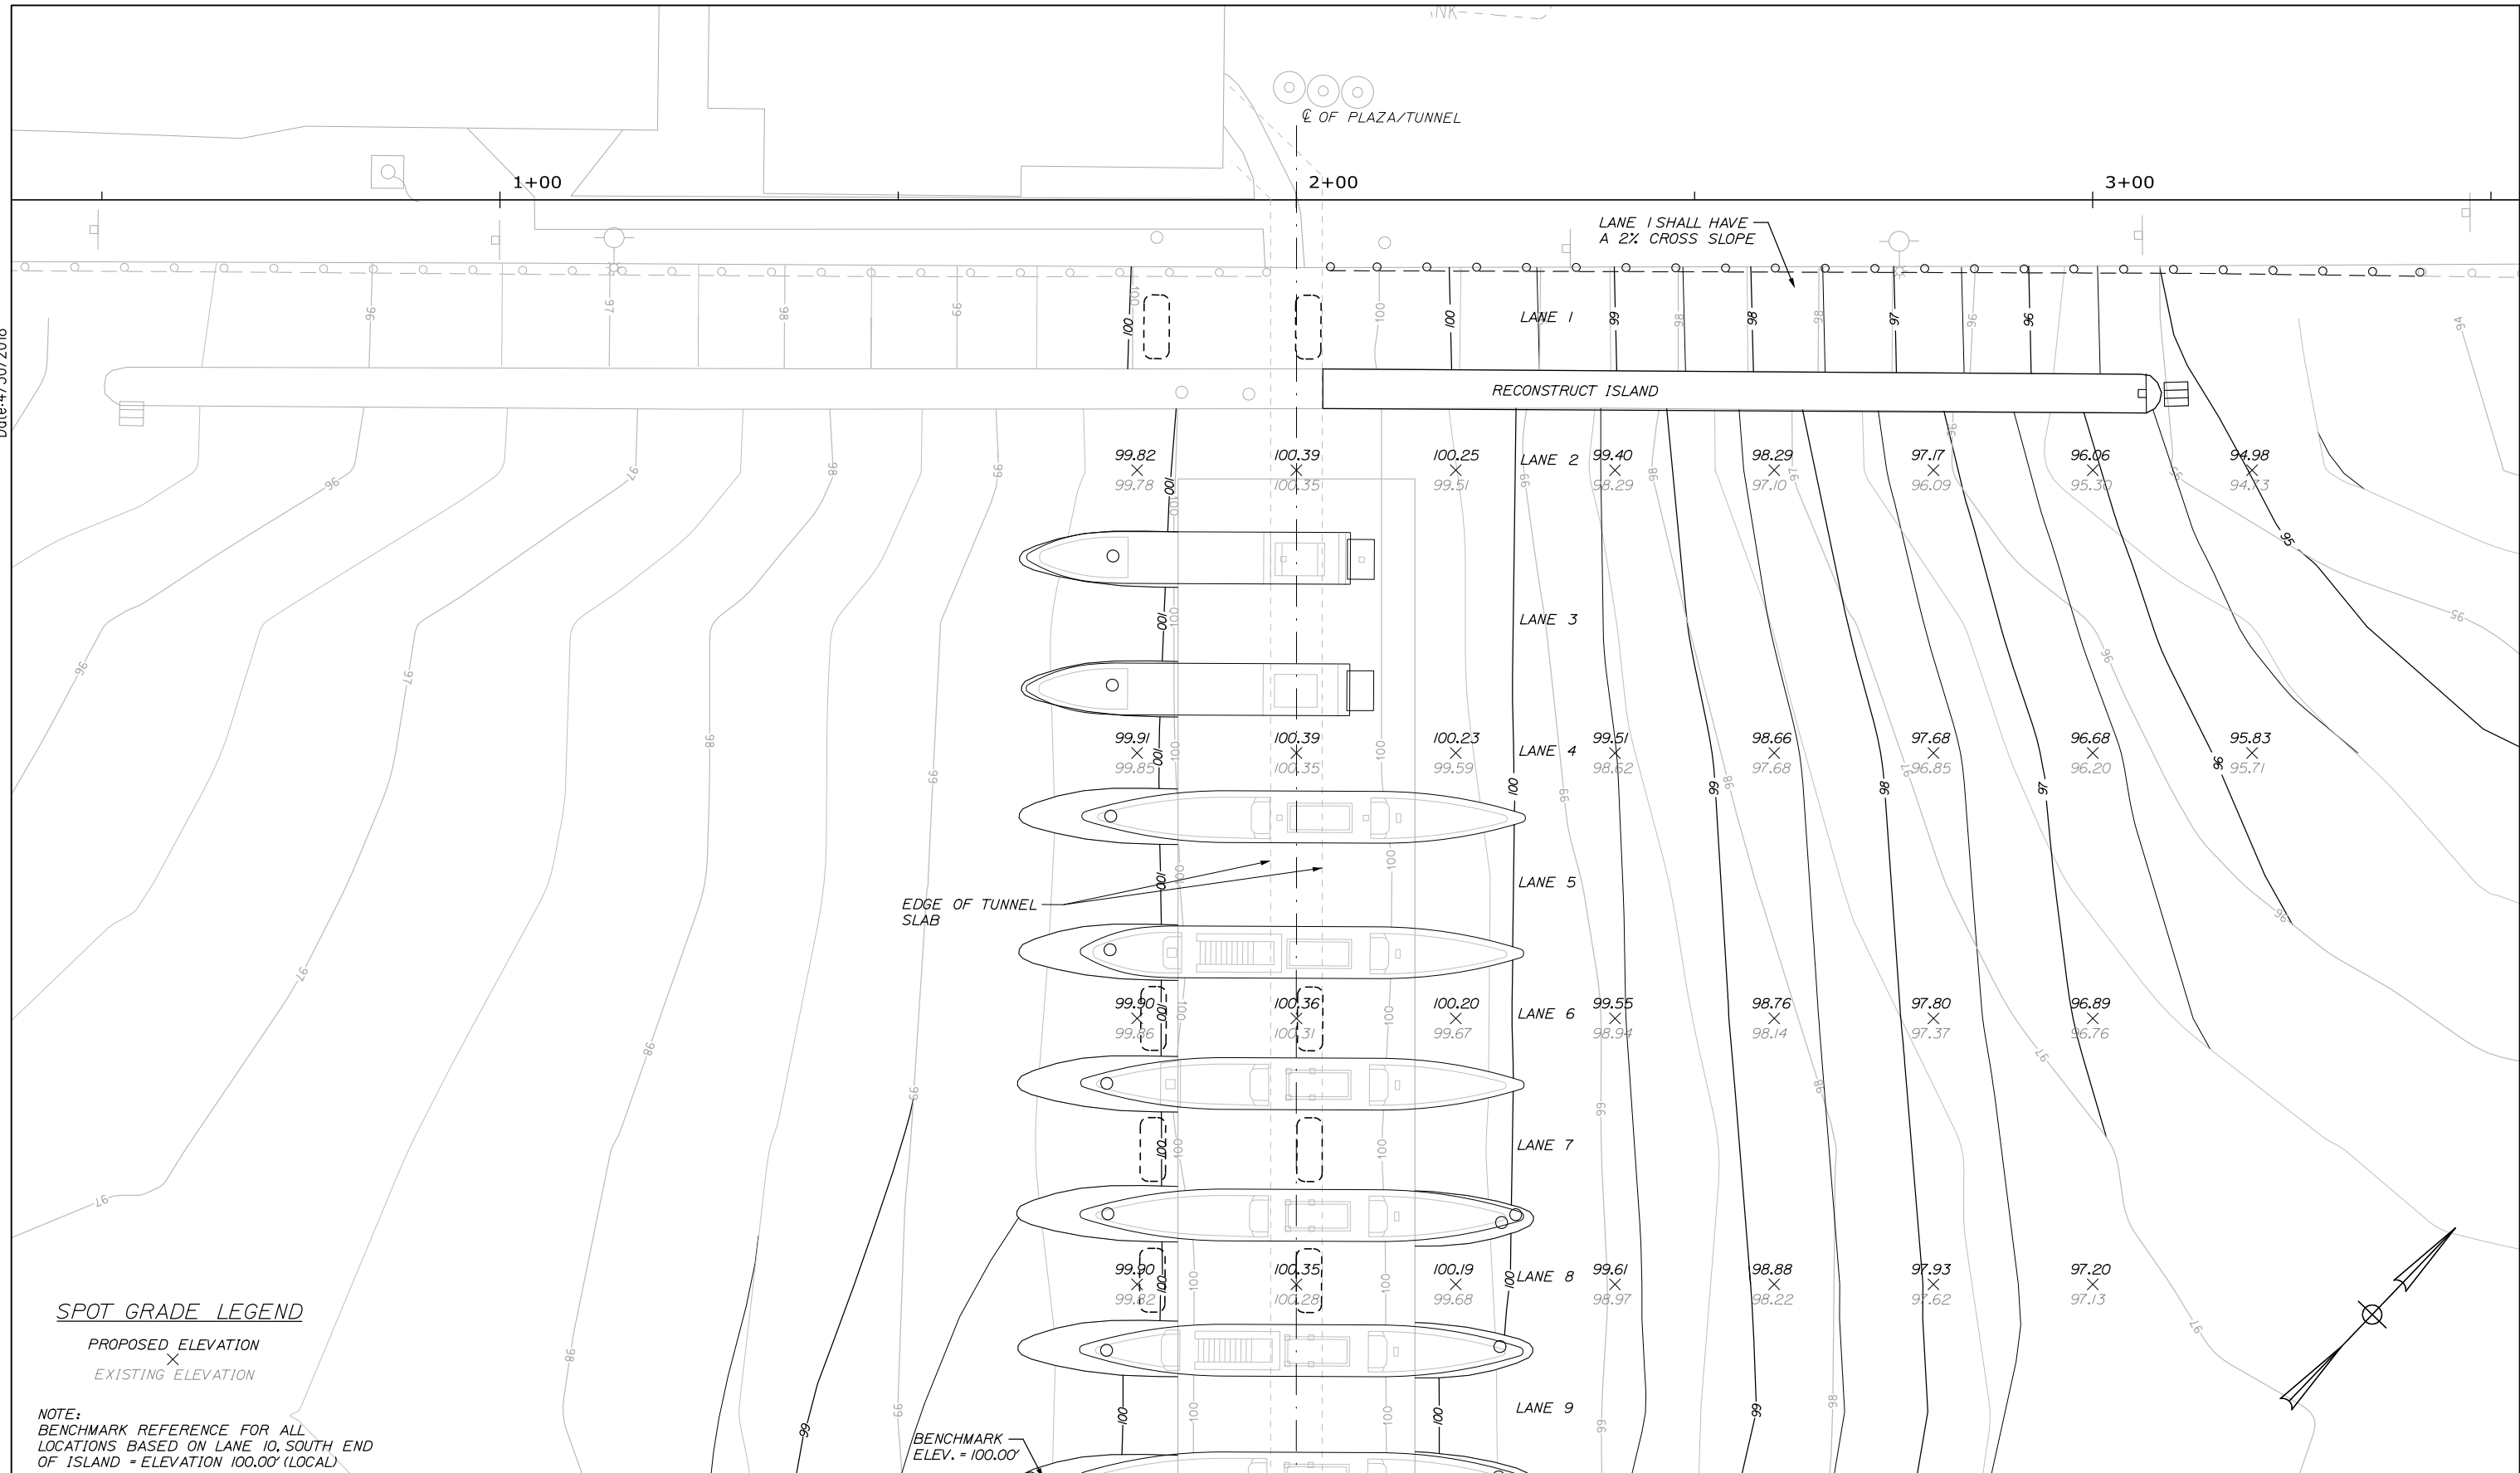

SPOT GRADE LEGEND

PROPOSED ELEVATION
X
EXISTING ELEVATION

NOTE:
BENCHMARK REFERENCE FOR ALL
LOCATIONS BASED ON LANE 10, SOUTH END
OF ISLAND = ELEVATION 100.00' (LOCAL)

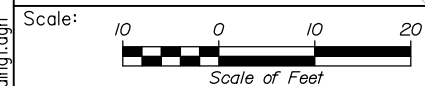

Designed by:



HNTB CORPORATION
340 County Road, Suite 6-C
Westbrook, ME 04092
TEL (207) 774-5155
FAX (207) 228-0909



**THE GOLD STAR
MEMORIAL HIGHWAY**

YORK TOLL PLAZA
PAVEMENT REHABILITATION
PROPOSED GRADING PLAN 1

No.	Revision	By	Date

CONSULTANT PROJECT MANAGER: Dale Mitchell, P.E.			
Designed	By	Date	Checked
	PEM	04/18	CAH
Drawn	By	Date	In Charge of
	SLS	04/18	RAL


MTA PROJECT MANAGER: Peter S. Merfeld, P.E.

CONTRACT: 2018.22

SHEET NUMBER: H-3

7 OF 11


Date: 4/30/2018

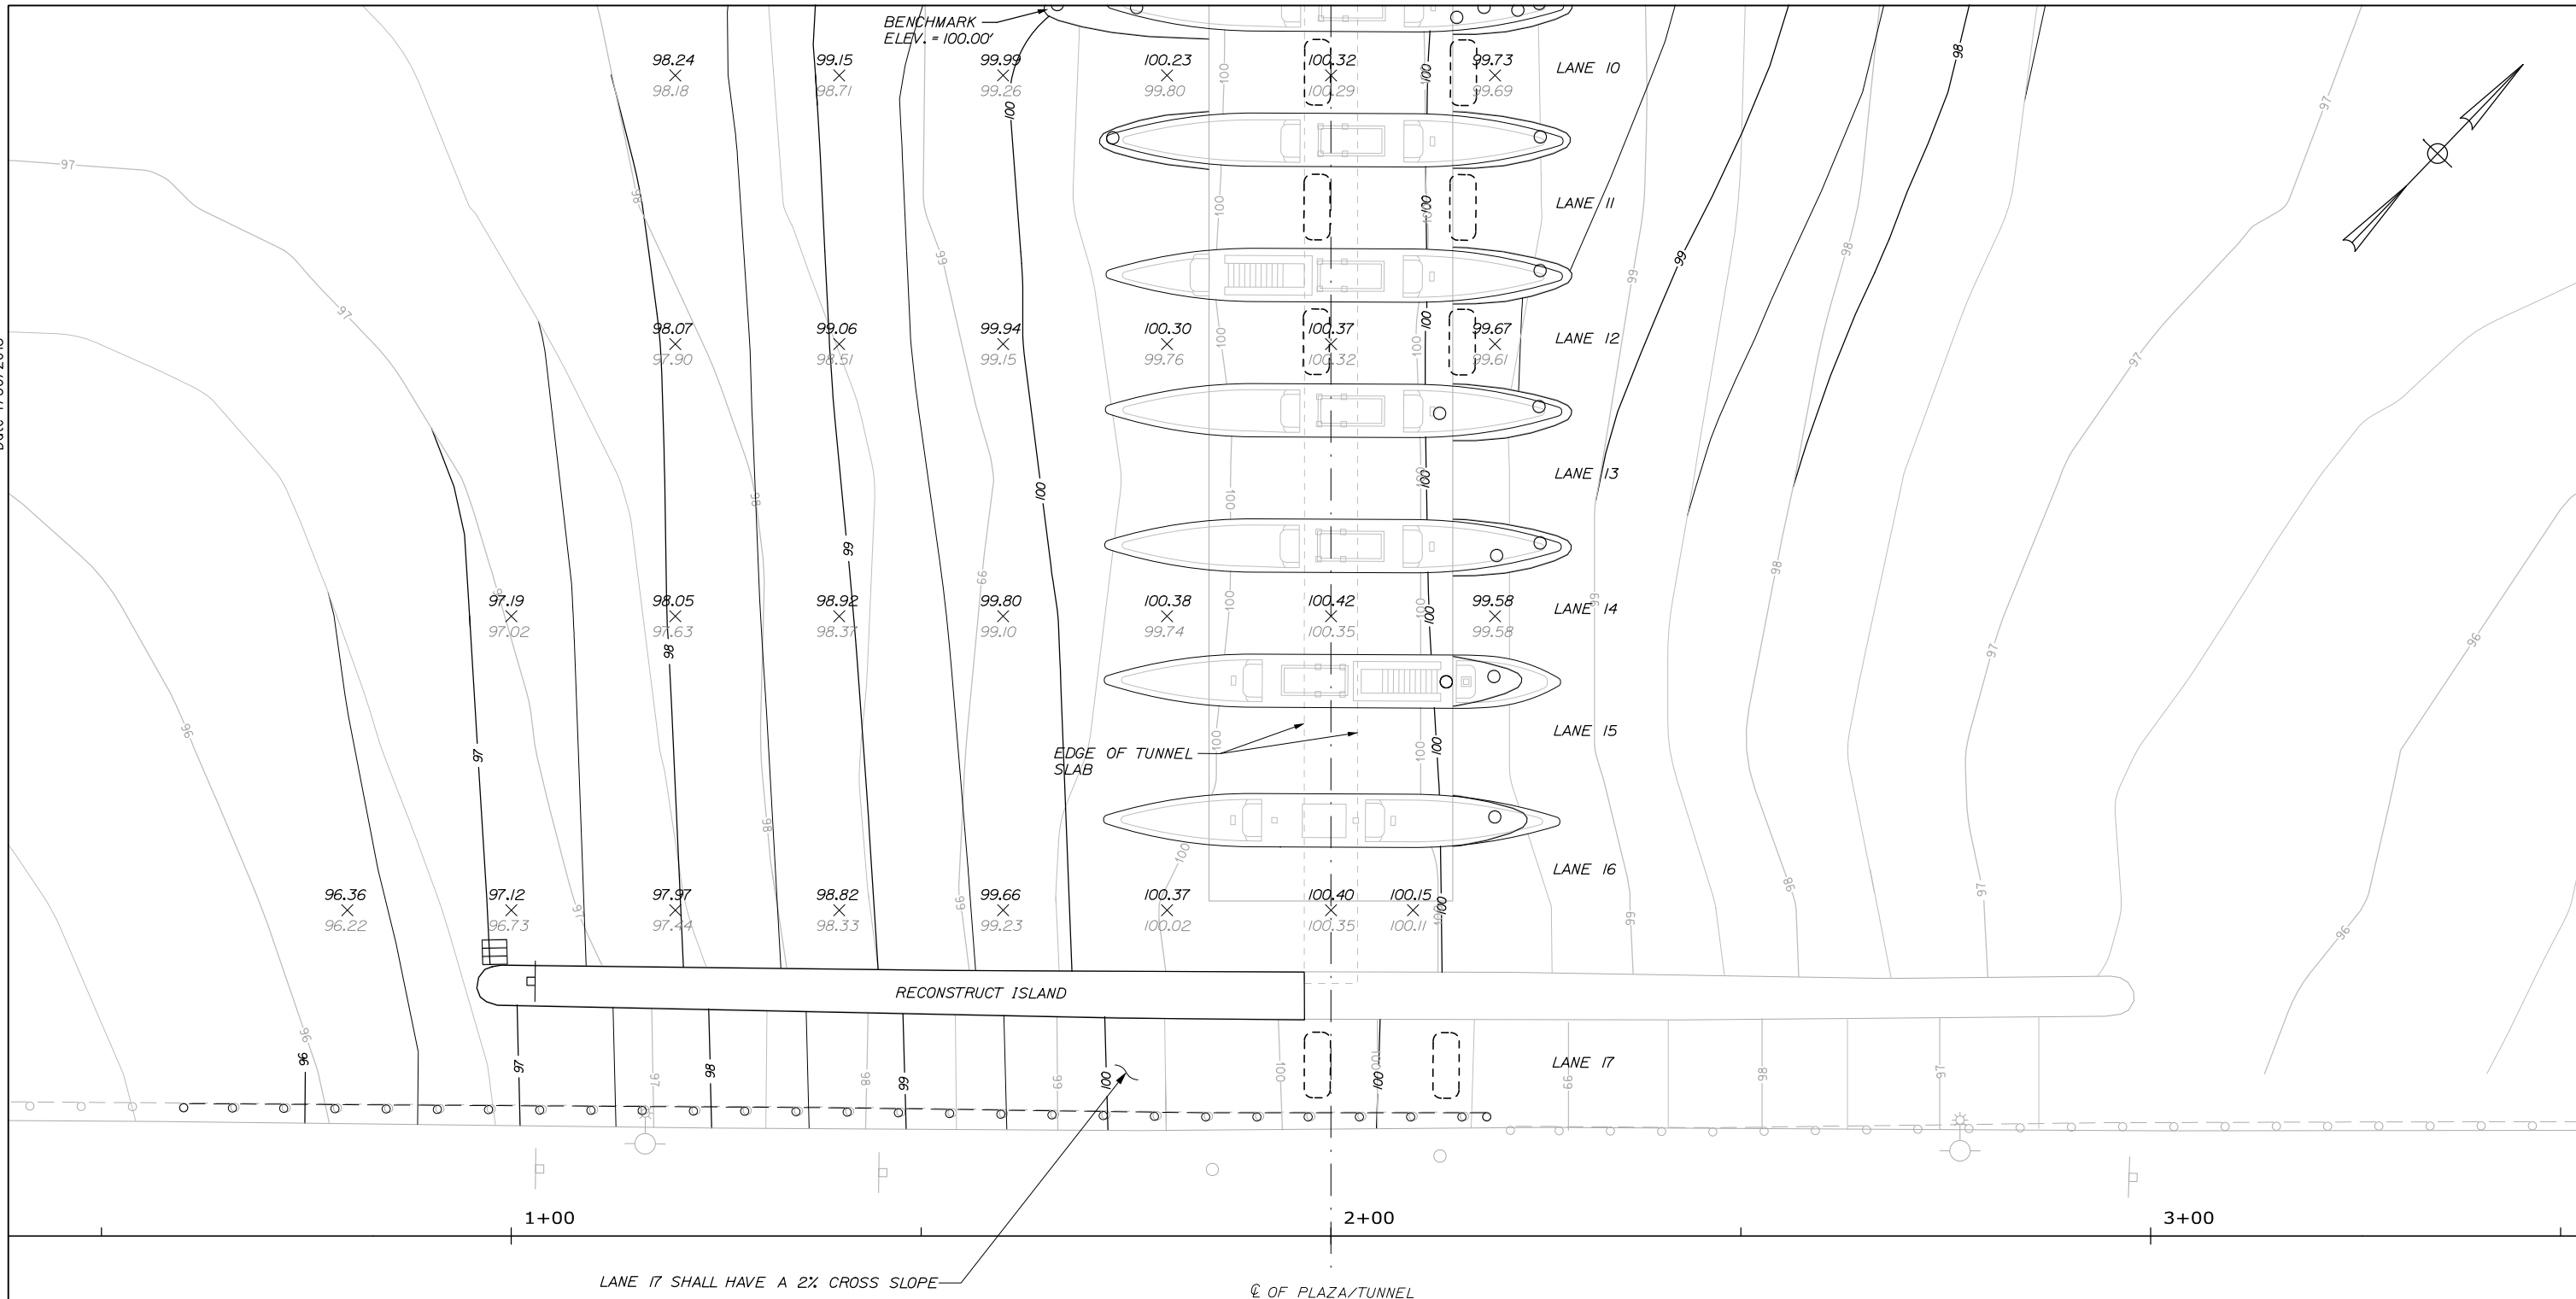

SPOT GRADE LEGEND

PROPOSED ELEVATION
X
EXISTING ELEVATION

NOTE:
BENCHMARK REFERENCE FOR ALL
LOCATIONS BASED ON LANE 10, SOUTH END
OF ISLAND = ELEVATION 100.00' (LOCAL)

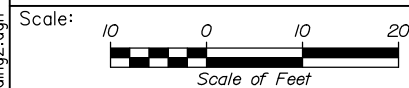

Designed by:



HNTB CORPORATION
340 County Road, Suite 6-C
Westbrook, ME 04092
TEL (207) 774-5155
FAX (207) 228-0909



**THE GOLD STAR
MEMORIAL HIGHWAY**

YORK TOLL PLAZA
PAVEMENT REHABILITATION
PROPOSED GRADING PLAN 2

No.	Revision	By	Date

CONSULTANT PROJECT MANAGER: Dale Mitchell, P.E.

	By	Date		By	Date
Designed	PEM	04/18	Checked	CAH	04/18
Drawn	SLS	04/18	In Charge of	RAL	04/18

MTA PROJECT MANAGER: Peter S. Merfeld, P.E.


CONTRACT: 2018.22

SHEET NUMBER: H-4

8 OF 11


Filename: 008_Grading2.dgn

Date: 4/30/2018

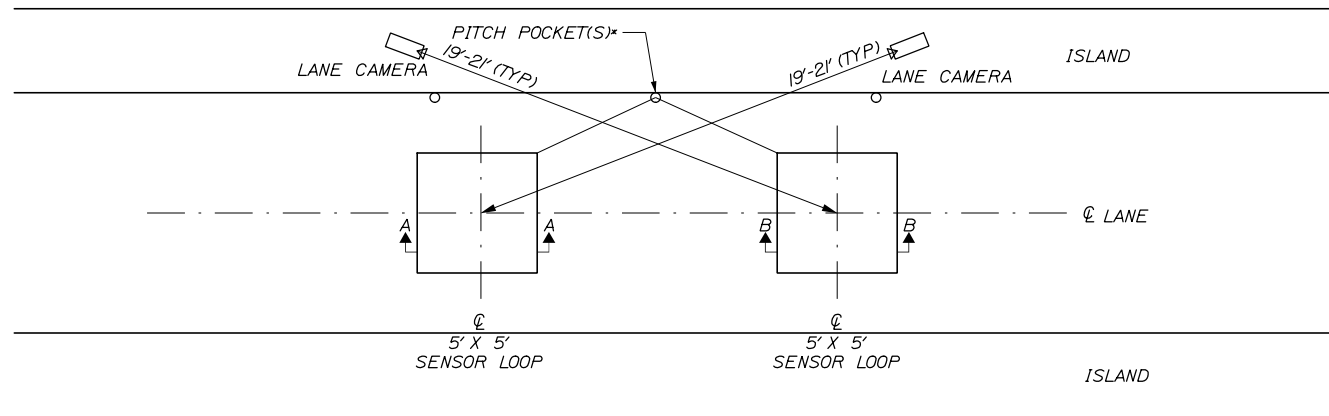


**TYPICAL INTERIOR
EZ PASS LANE**


*NOTE - EACH SENSOR LOOP
DETECTOR MAY TERMINATE IN A
SEPARATE PITCH POCKET

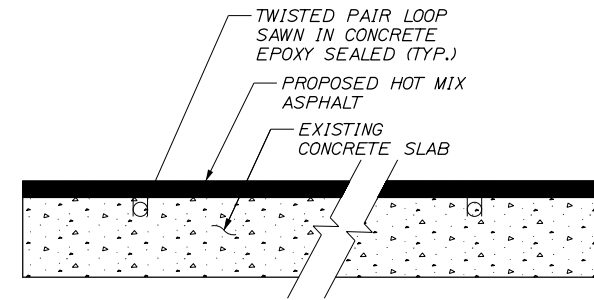

**SECTION A-A
EMBEDDED IN CONCRETE SLAB**

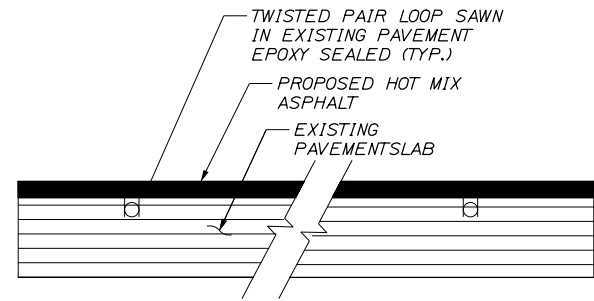

**SECTION B-B
EMBEDDED IN EXISTING PAVEMENT**

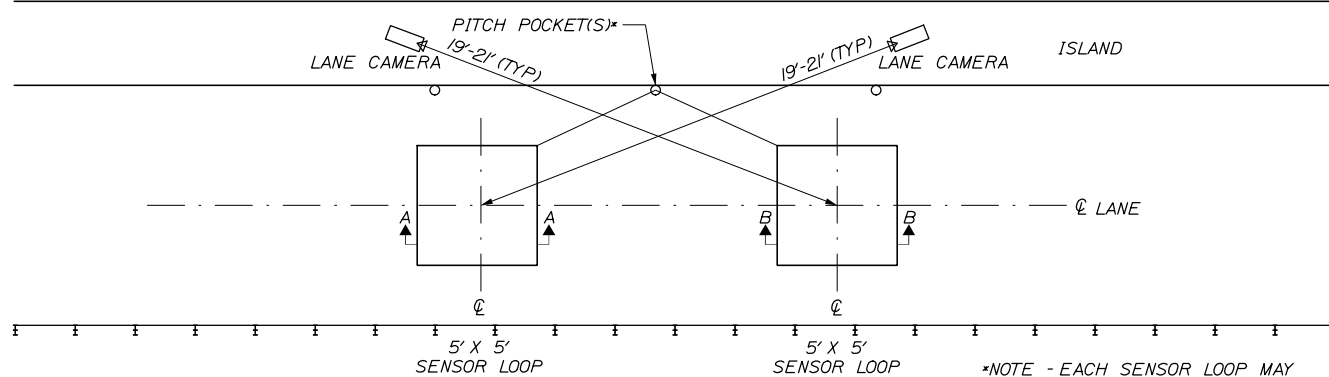

**TYPICAL EXTERIOR
EZ PASS LANE**

*NOTE - EACH SENSOR LOOP MAY
TERMINATE IN A SEPARATE
PITCH POCKET

SENSOR LOOP INSTALLATION NOTES:

1. LOOP INFORMATION IS PROVIDED FOR BIDDING PURPOSES ONLY.
2. THE LOOPS MAY ENTER THE TUNNEL THROUGH SEPARATE EXISTING PITCH POCKETS.
3. THE LOOP WORK SHALL BE COORDINATED WITH TRANSCORE, THE AUTHORITY'S TOLL SYSTEM PROVIDER. PRIOR TO STARTING THE WORK THE CONTRACTOR SHALL CONTACT TRANSCORE AND HAVE THEM CONFIRM THE LOCATION AND LAYOUT OF THE EXISTING AND PROPOSED LOOPS. CALL 1-207-797-2902 TO REACH TRANSCORE. A MINIMUM 24 HOUR NOTICE IS REQUIRED.
4. THE CONTRACTOR SHALL SAW THE LOOPS AS MARKED BY TRANSCORE, SET THE TWISTED PAIRS, AND EPOXY THEM IN PLACE, AND EXTEND THE LOOPS TO THE TERMINATION POINT(S) IN THE TUNNEL. TRANSCORE SHALL MAKE THE FINAL TERMINATION TO THE EZ-PASS EQUIPMENT.
5. ALL SENSOR LOOPS SHALL BE SAWN IN THE CONCRETE OR PAVEMENT, EPOXIED IN PLACE, TERMINATED IN THE TUNNEL, AND TESTED PRIOR TO THE FINAL LIFT OF PAVEMENT BEING PLACED.
7. TWO SENSOR LOOPS ARE REQUIRED IN EACH EZ-PASS LANE. EZ-PASS LANES ARE LANES 1,6,7,8,10,11,12, AND 17.

Filename: 009_Sensor Loop Installation Details.dgn

Scale:			
No.	Revision	By	Date

Designed by:					
HNTB					
CONSULTANT PROJECT MANAGER: Dale Mitchell, P.E.					
	By	Date		By	Date
Designed	PEM	04/18	Checked	CAH	04/18
Drawn	SLS	04/18	In Charge of	RAL	04/18

HNTB CORPORATION
340 County Road, Suite 6-C
Westbrook, ME 04092
TEL (207) 774-5155
FAX (207) 228-0909

**THE GOLD STAR
MEMORIAL HIGHWAY**

MTA PROJECT MANAGER: Peter S. Merfeld, P.E.

YORK TOLL PLAZA
PAVEMENT REHABILITATION


SENSOR LOOP INSTALLATION DETAILS

SHEET NUMBER: SL-1
9 OF 11

CONTRACT: 2018.22

Date: 4/30/2018

Filename: 010_Pavement Repair Plan.dgn

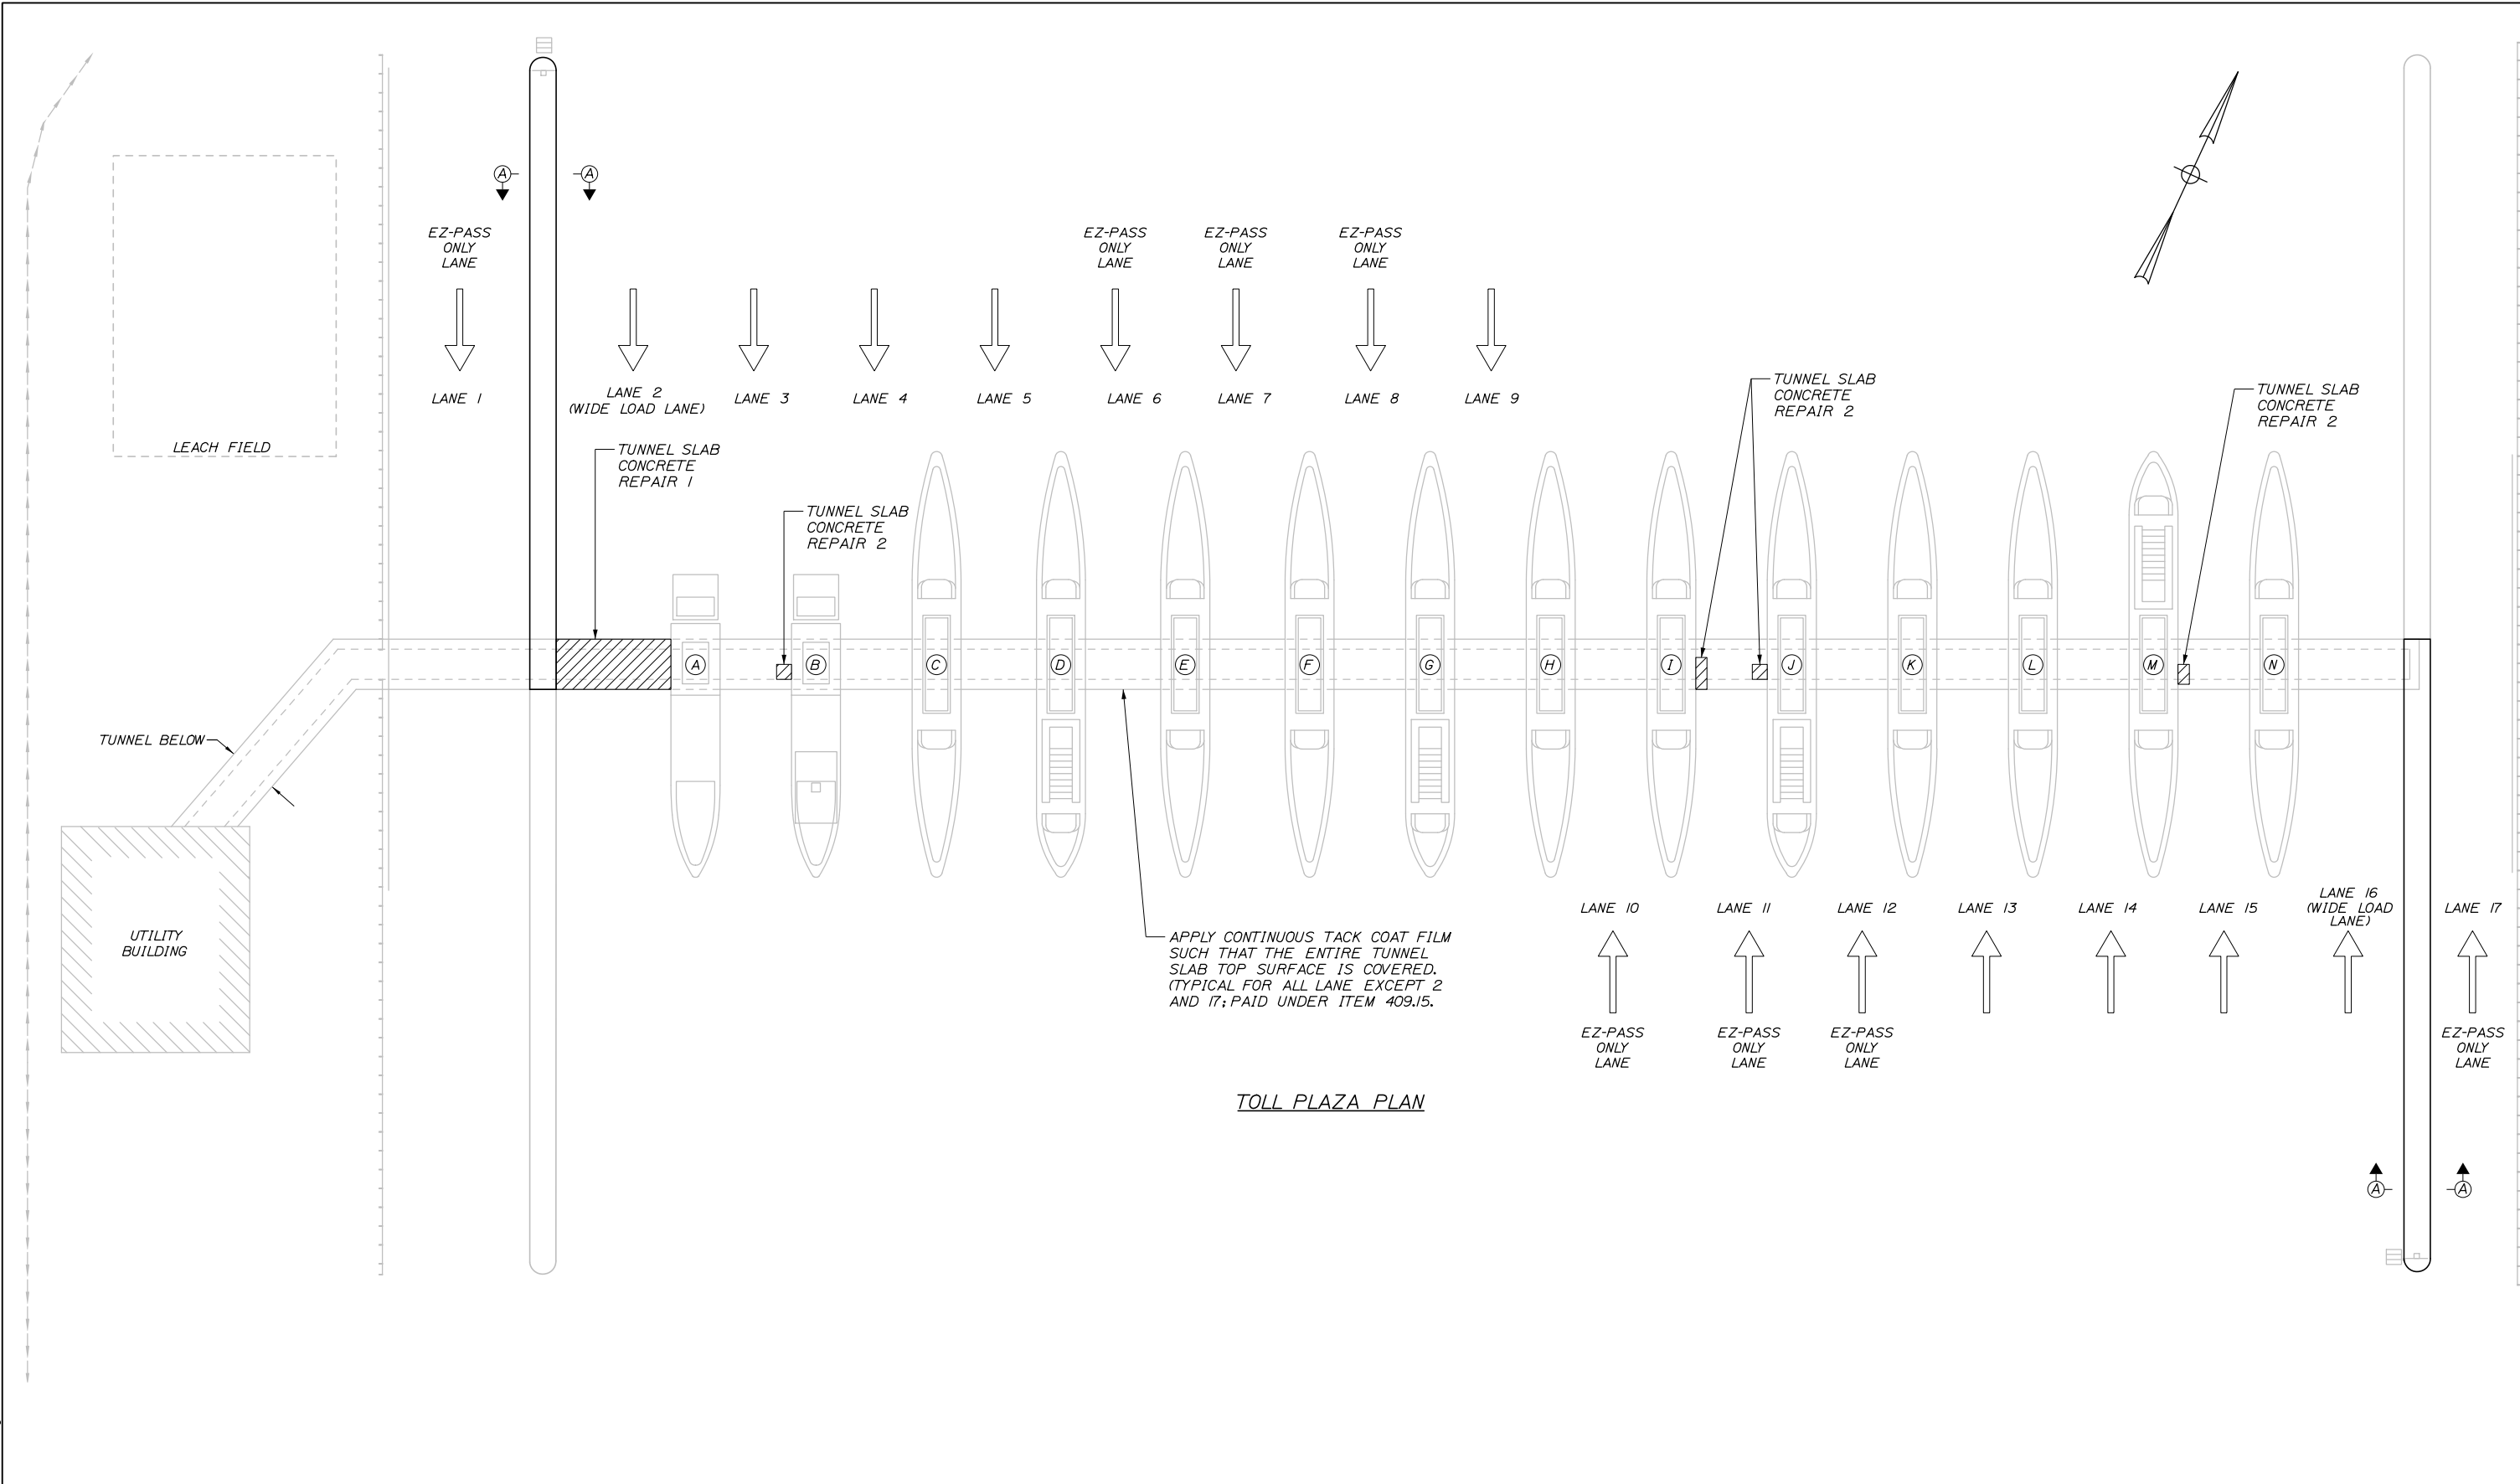

TOLL PLAZA PLAN

No.	Revision	By	Date

Designed by:

HNTB

CONSULTANT PROJECT MANAGER: Dale Mitchell, P.E.

	By	Date		By	Date
Designed	BRG	04/18	Checked	CAH	04/18
Drawn	PEB	04/18	In Charge of	RAL	04/18

HNTB CORPORATION
 340 County Road, Suite 6-C
 Westbrook, ME 04092
 TEL (207) 774-5155
 FAX (207) 228-0909

MAINE TURNPIKE

THE GOLD STAR MEMORIAL HIGHWAY


MTA PROJECT MANAGER: Peter S. Merfeld, P.E.

YORK TOLL PLAZA
 PAVEMENT REHABILITATION
 TUNNEL SLAB REPAIR PLAN

SHEET NUMBER: S-01
 10 OF 11

CONTRACT: 2018.22


Date: 4/30/2018

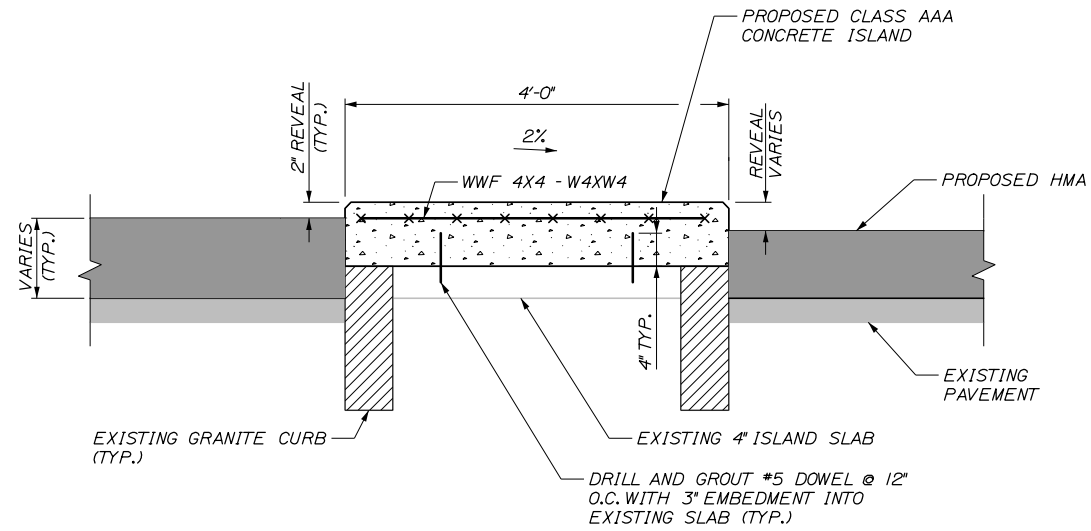

SECTION A-A


1" = 1'-0"

NOTE: PROPOSED CONCRETE ISLAND ELEVATIONS SHALL BE SET 2" ABOVE LANE 2 AND 16 SPOT ELEVATIONS SHOWN ON SHEETS 7 AND 8 RESPECTIVELY

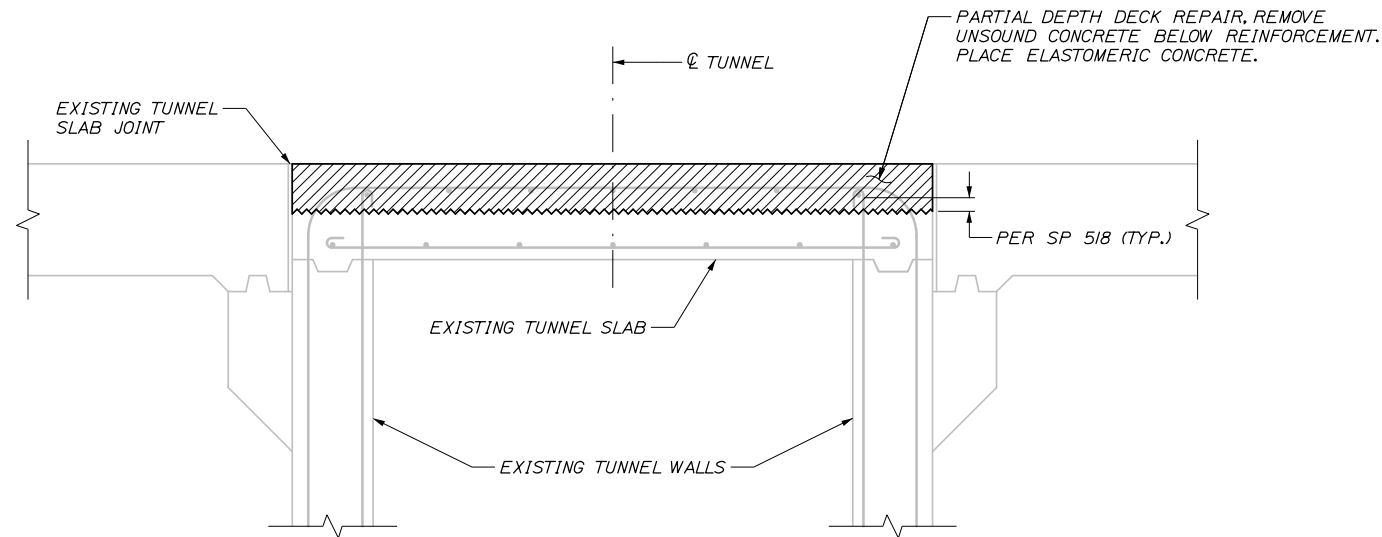


TUNNEL SLAB CONCRETE REPAIR 1

LANE 2
1" = 1'-0"

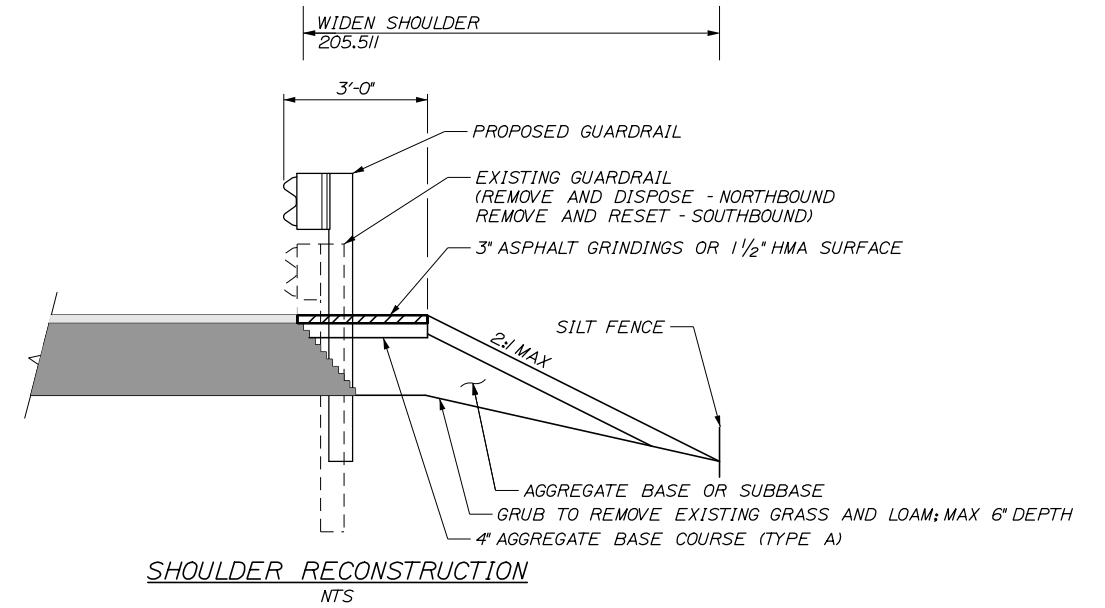

SHOULDER RECONSTRUCTION

NTS

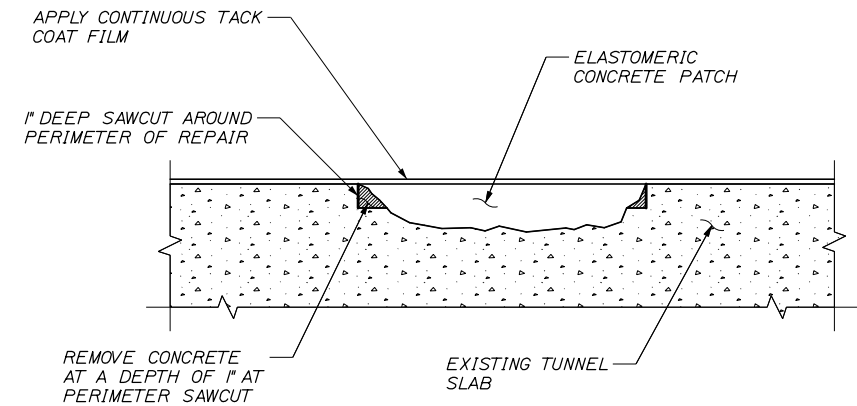

TUNNEL SLAB CONCRETE REPAIR 2

LANE 3, LANE 11, LANE 15
3" = 1'-0"

TUNNEL SLAB CONCRETE REPAIR NOTES:


1. FOR APPROXIMATE LOCATIONS OF TUNNEL SLAB REPAIRS SEE SHEET S-01. ACTUAL REPAIR AREAS WILL BE DETERMINED BY THE RESIDENT DURING CONSTRUCTION.
2. PRIOR TO THE START OF CONCRETE REPAIRS THE RESIDENT AND THE CONTRACTOR SHALL SOUND ALL TUNNEL SLAB SURFACES AND AGREE ON THE REPAIR LIMITS.
3. PERFORM 1" DEEP SAW CUTS ALONG THE LIMITS OF REMOVAL.
4. CHIP CONCRETE TO THE DEPTH SPECIFIED IN SUPPLEMENTAL SPECIFICATION 518. IF THE REMOVAL LIMITS CHANGE DURING THE DEMOLITION PROCESS THE CONTRACTOR SHALL NOTIFY THE RESIDENT. THE RESIDENT AND CONTRACTOR SHALL AGREE ON THE REVISED PAY LIMITS PRIOR TO THE CONTRACTOR CONTINUING THE REMOVAL.
5. PREPARE AND PATCH REPAIR AREAS. SEE SPECIFICATIONS FOR SURFACE PREPARATION, MATERIALS, PLACEMENT AND CURING REQUIREMENTS.
6. ALL WORK SHALL BE ACCOMPLISHED USING THE CONSTRUCTION SEQUENCE PRESENTED IN THE MAINTENANCE OF TRAFFIC DETAILS AND THE SPECIFICATIONS.

Filename: 011_Pavement_Repair_Details.dgn

Scale:			
No.	Revision	By	Date

Designed by:					
HNTB					
CONSULTANT PROJECT MANAGER: Dale Mitchell, P.E.					
	By	Date		By	Date
	BRG	04/18	Checked	CAH	04/18
	PEB	04/18	In Charge of	RAL	04/18

HNTB CORPORATION
340 County Road, Suite 6-C
Westbrook, ME 04092
TEL (207) 774-5155
FAX (207) 228-0909



**MAINE
TURNPIKE**

**THE GOLD STAR
MEMORIAL HIGHWAY**

MTA PROJECT MANAGER: Peter S. Merfeld, P.E.

**YORK TOLL PLAZA
PAVEMENT REHABILITATION
TUNNEL SLAB REPAIR AND
SHOULDER RECONSTRUCTION DETAILS**

SHEET NUMBER: S-02
CONTRACT: 2018.22
11 OF 11