


PLAN
Scale: $\frac{1}{16}$

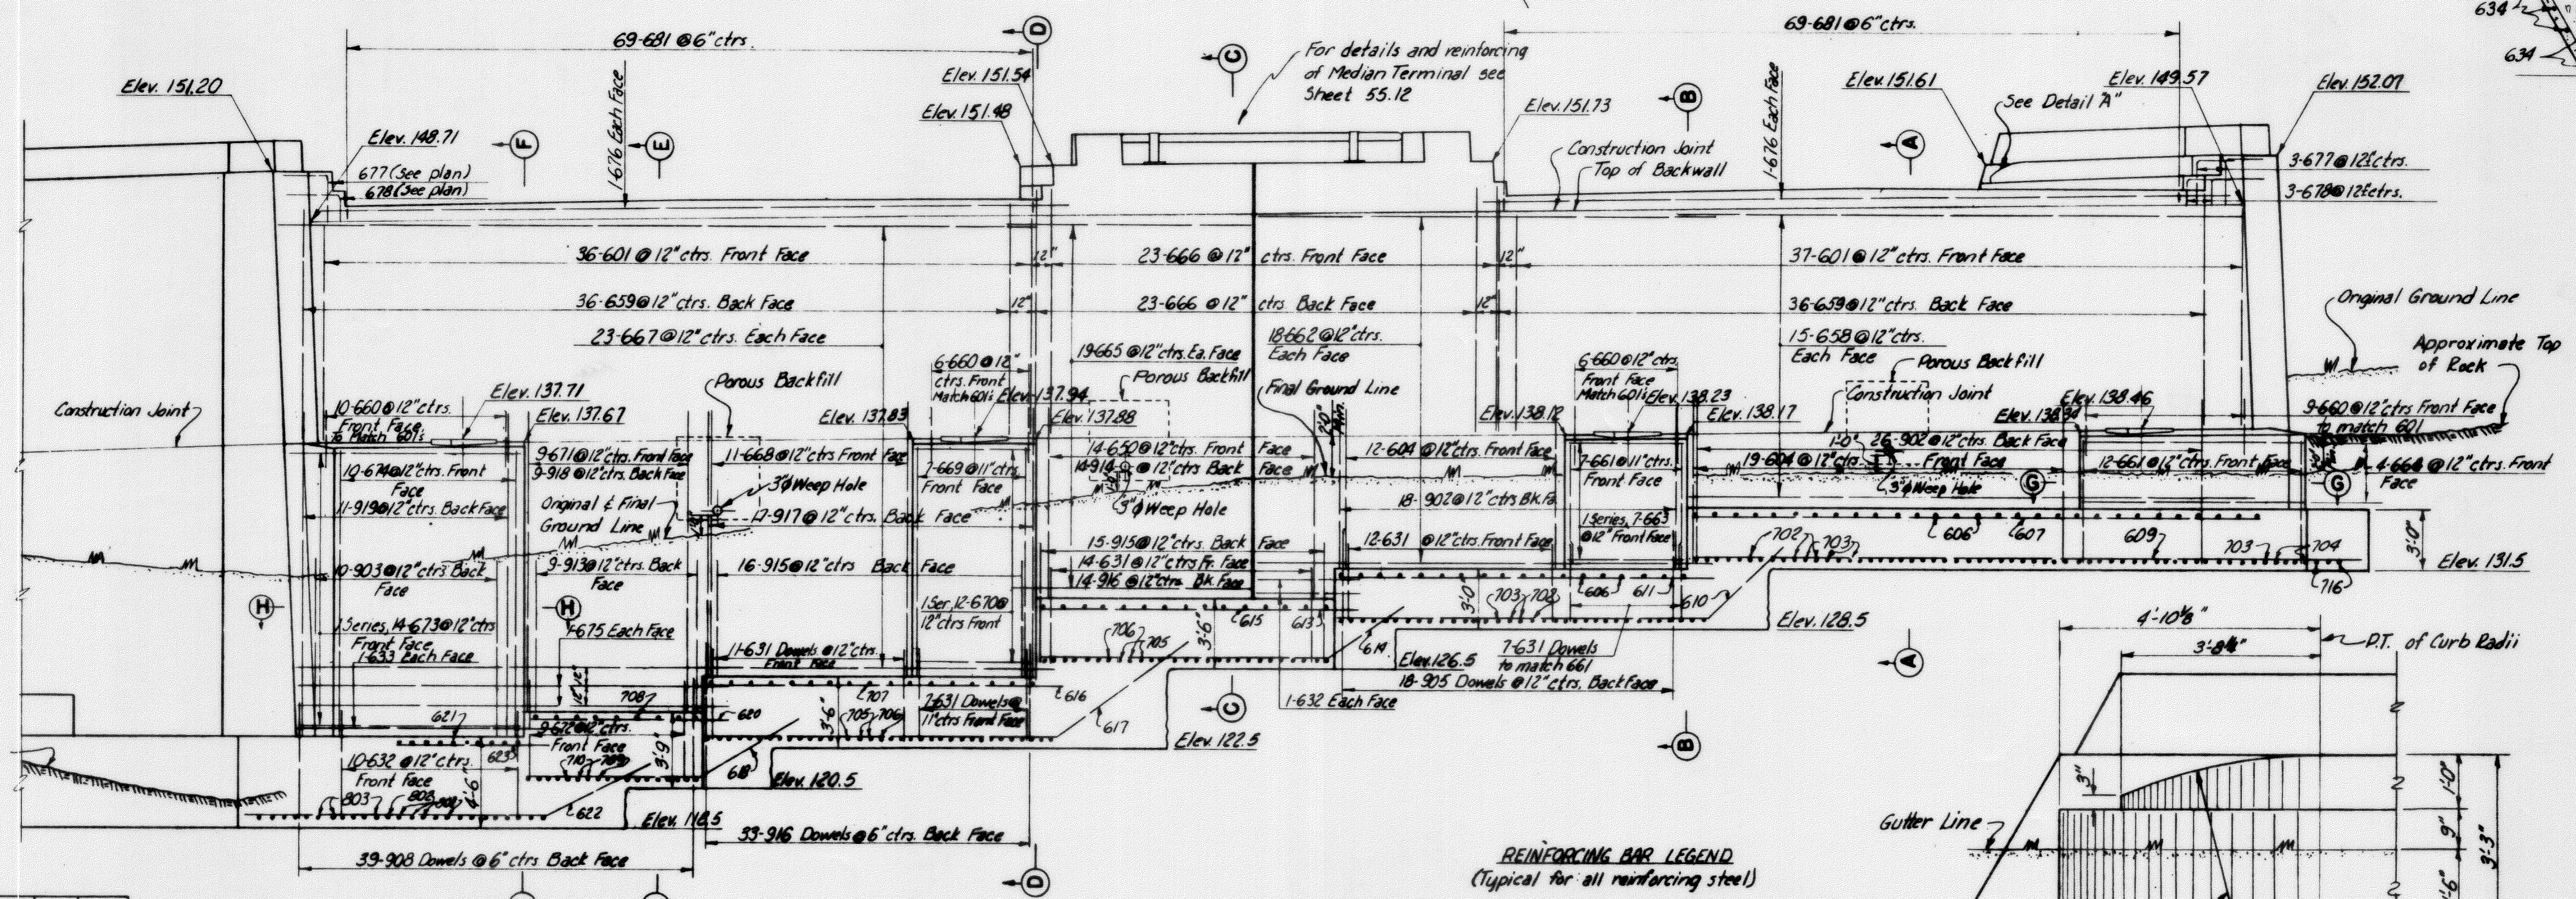

REINFORCING BAR LEGEND

First Digit (1st two digits when four digits are used): Bar Size
Last Two Digits: Bar Number
Examples: 605 - "6 bar, fifth bar used
1106 - "11 bar, sixth bar used

DETAIL "A"

Notes:
Footings are to be carried a minimum of 6" into solid undisturbed rock.
Curbs along wingwalls are not in this contract and will be placed by others.

Concrete above top of backwall between wings and Median Terminal shall be placed after the roadway expansion joint has been erected in accordance with the specifications.

• The *liver* is the largest glandular organ in the body.

For required form markings and curb reinforcing, see Standard Drawing No 1A.
For sections not shown see Charts B.11 and

For required form markings and curb reinforcing, see Standard Drawing No 1A.
For sections not shown see Sheets 55.11 and 55.12.

MAINE TURNPIKE AUTHORITY

MAINE TURNPIKE

SECTION 2— PORTLAND TO AUGUSTA

SECTION 2— PORTLAND TO AUGUSTA

**STRUCTURE NO. 55 TURNPIKE OVER
ANDROSCOGGIN RIVER**

**ANDROSCOGGIN RIVER
STA. 3900 + 37.17
ABUTMENT NO. 2**


HOWARD, NEEDLES, TAMMEN & BERGENDOFF **SCALE:** *As Needed*

CONSULTING ENGINEERS **CONTRACT NO.** _____

NEW YORK KANSAS CITY SHEET NO. 245 OF 392

NEW YORK **BOSTON** **CHICAGO** **DETROIT** **MILWAUKEE** **PHILADELPHIA** **SAN FRANCISCO**

For more information about the study, please contact Dr. John P. Morrissey at (212) 639-7300 or via email at jmorrissey@nyp.edu.

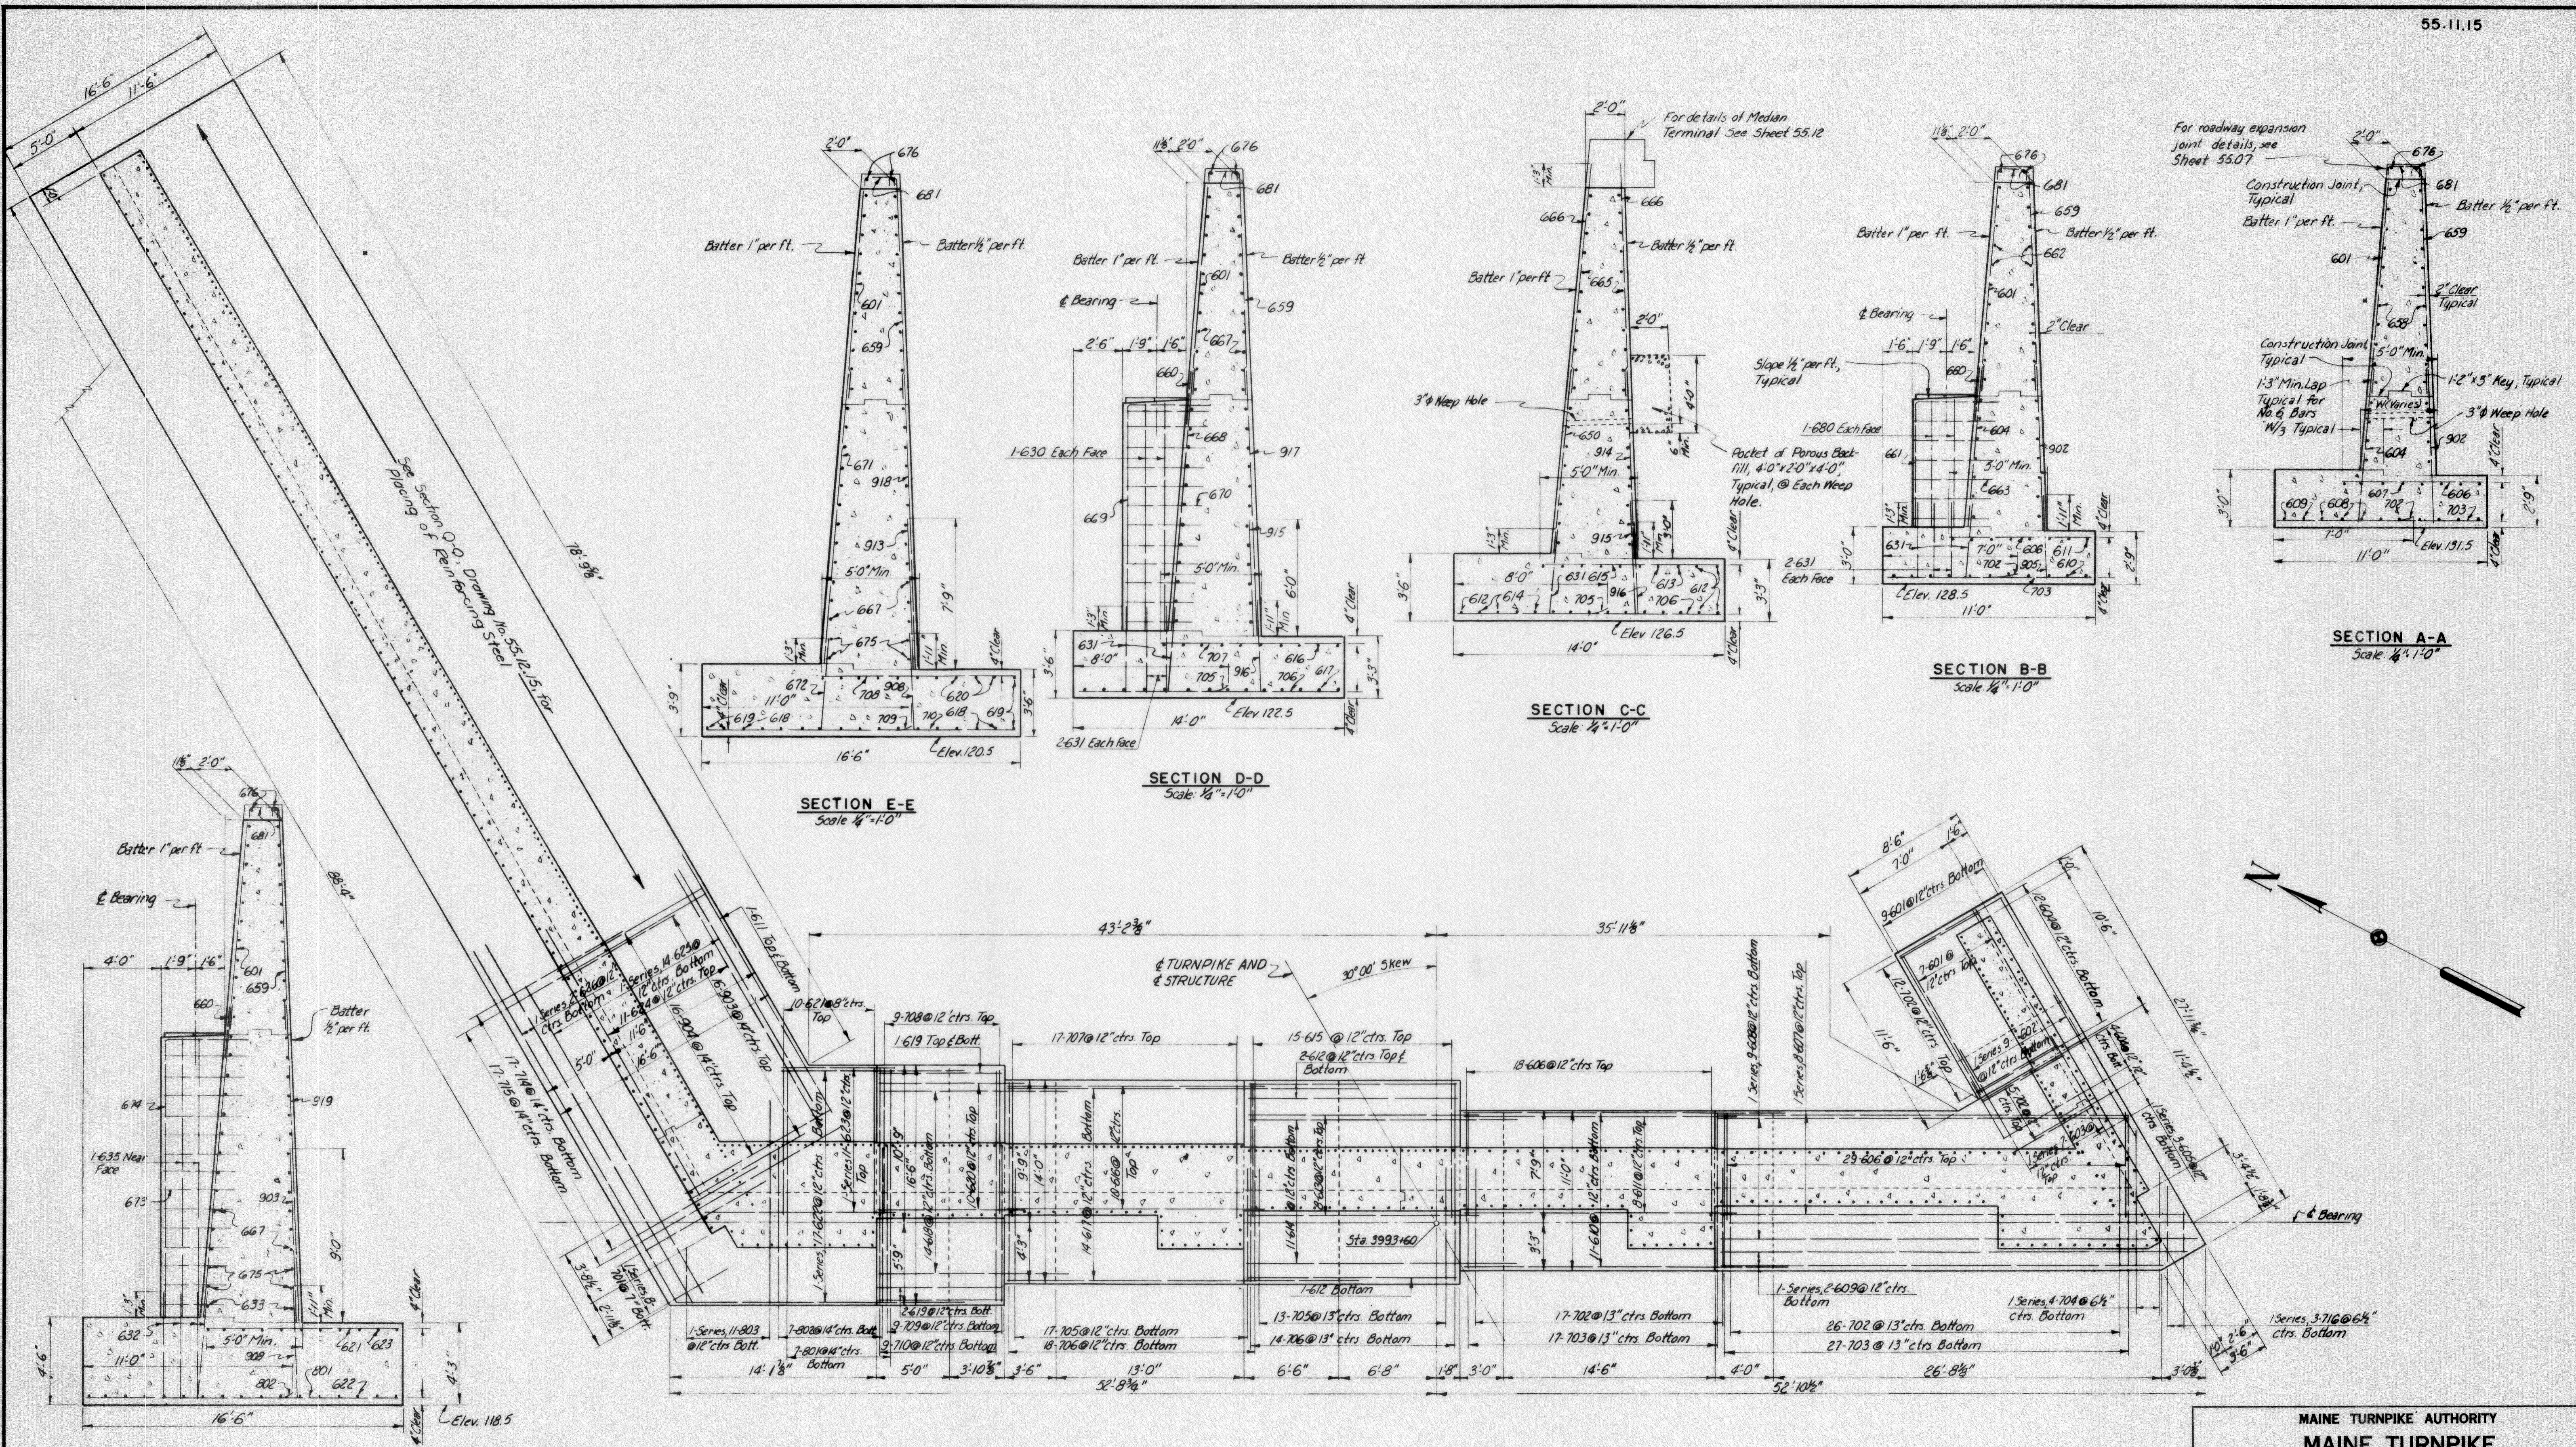



FOOTING PL


MAINE TURNPIKE AUTHORITY
MAINE TURNPIKE
SECTION 2— PORTLAND TO AUGUSTA

SECTION 2 PORTLAND TO AUGUSTA
STRUCTURE NO. 55 TURNPIKE OVER
ANDROSCOGGIN RIVER
STA. 3989 + 37.17
ABUTMENT NO. 2
WARD, NEEDLES, TAMMEN & BERGENDOFF CONSULTING ENGINEERS
NEW YORK KANSAS CITY
SCALE: As Noted CONTRACT NO. _____
SHEET NO. 246 OF 382

DRAWING NO. 55.11.15		BY	DATE		
MADE	H.J.G.	3-4-54			
TRACED					
CHECKED	R.S.G.	3-18-54	1	As-Built	HBM 12056
IN CHARGE OF	IOSH		No.	REVISION	BY DATE

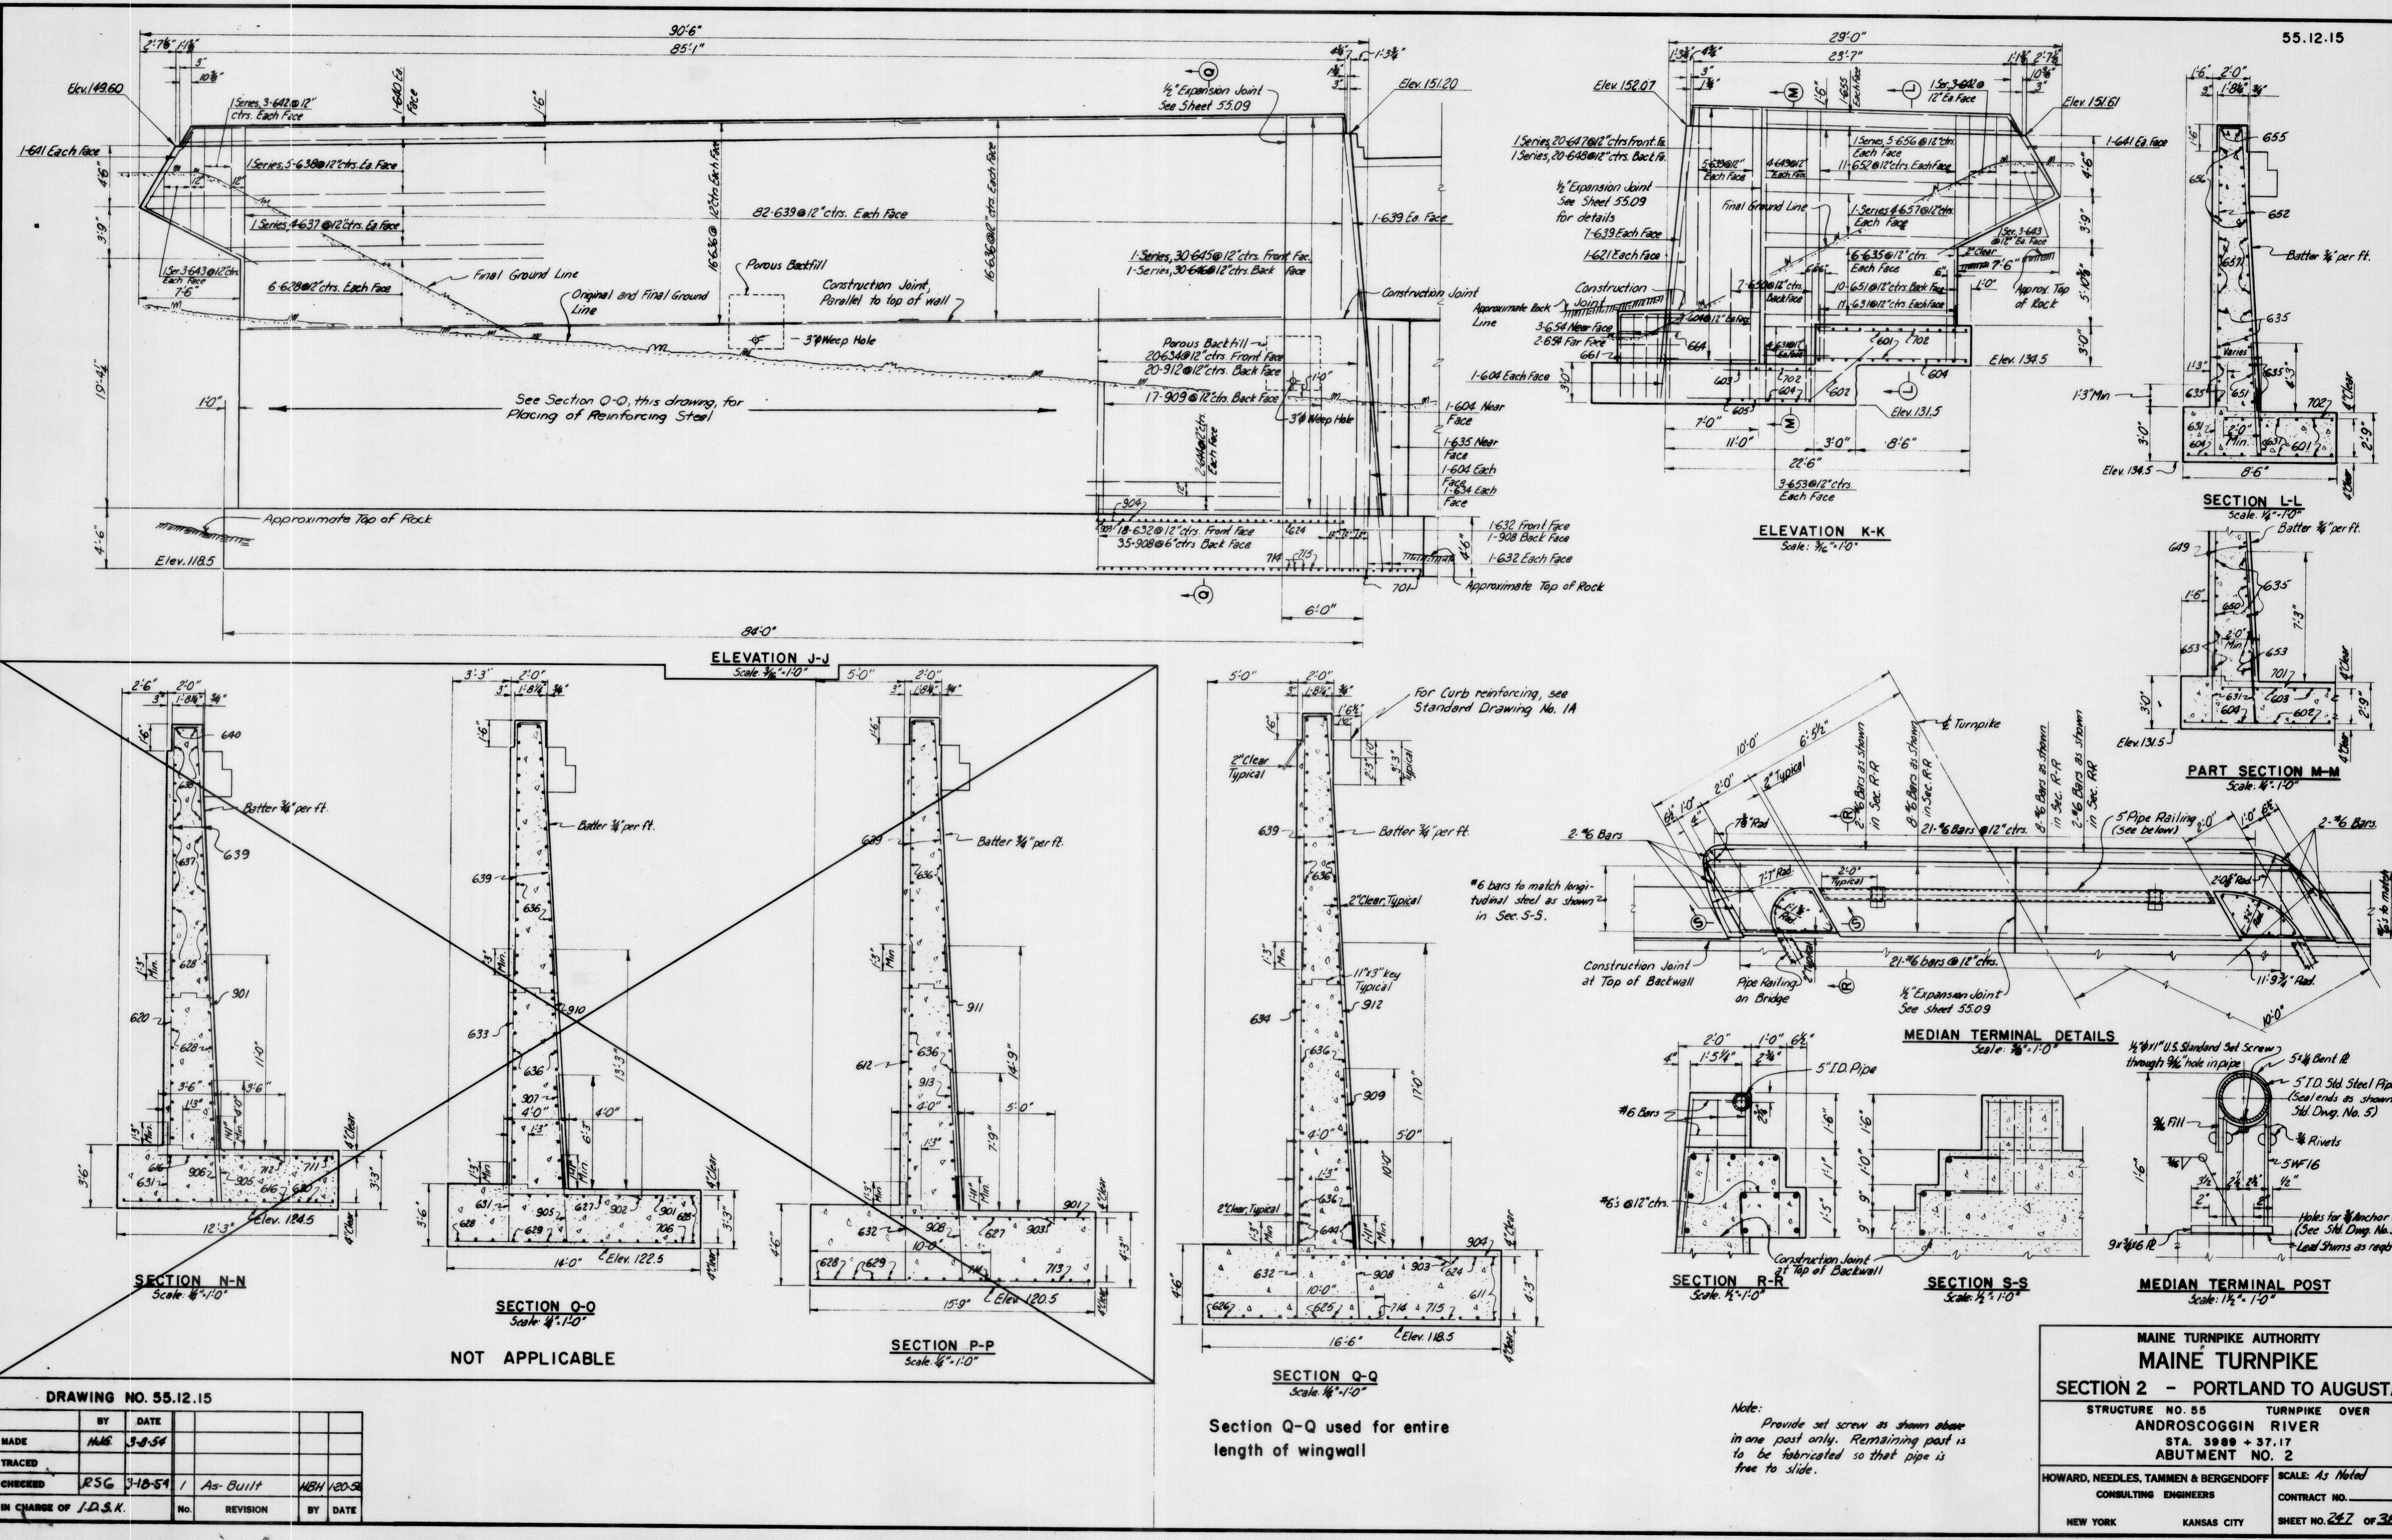

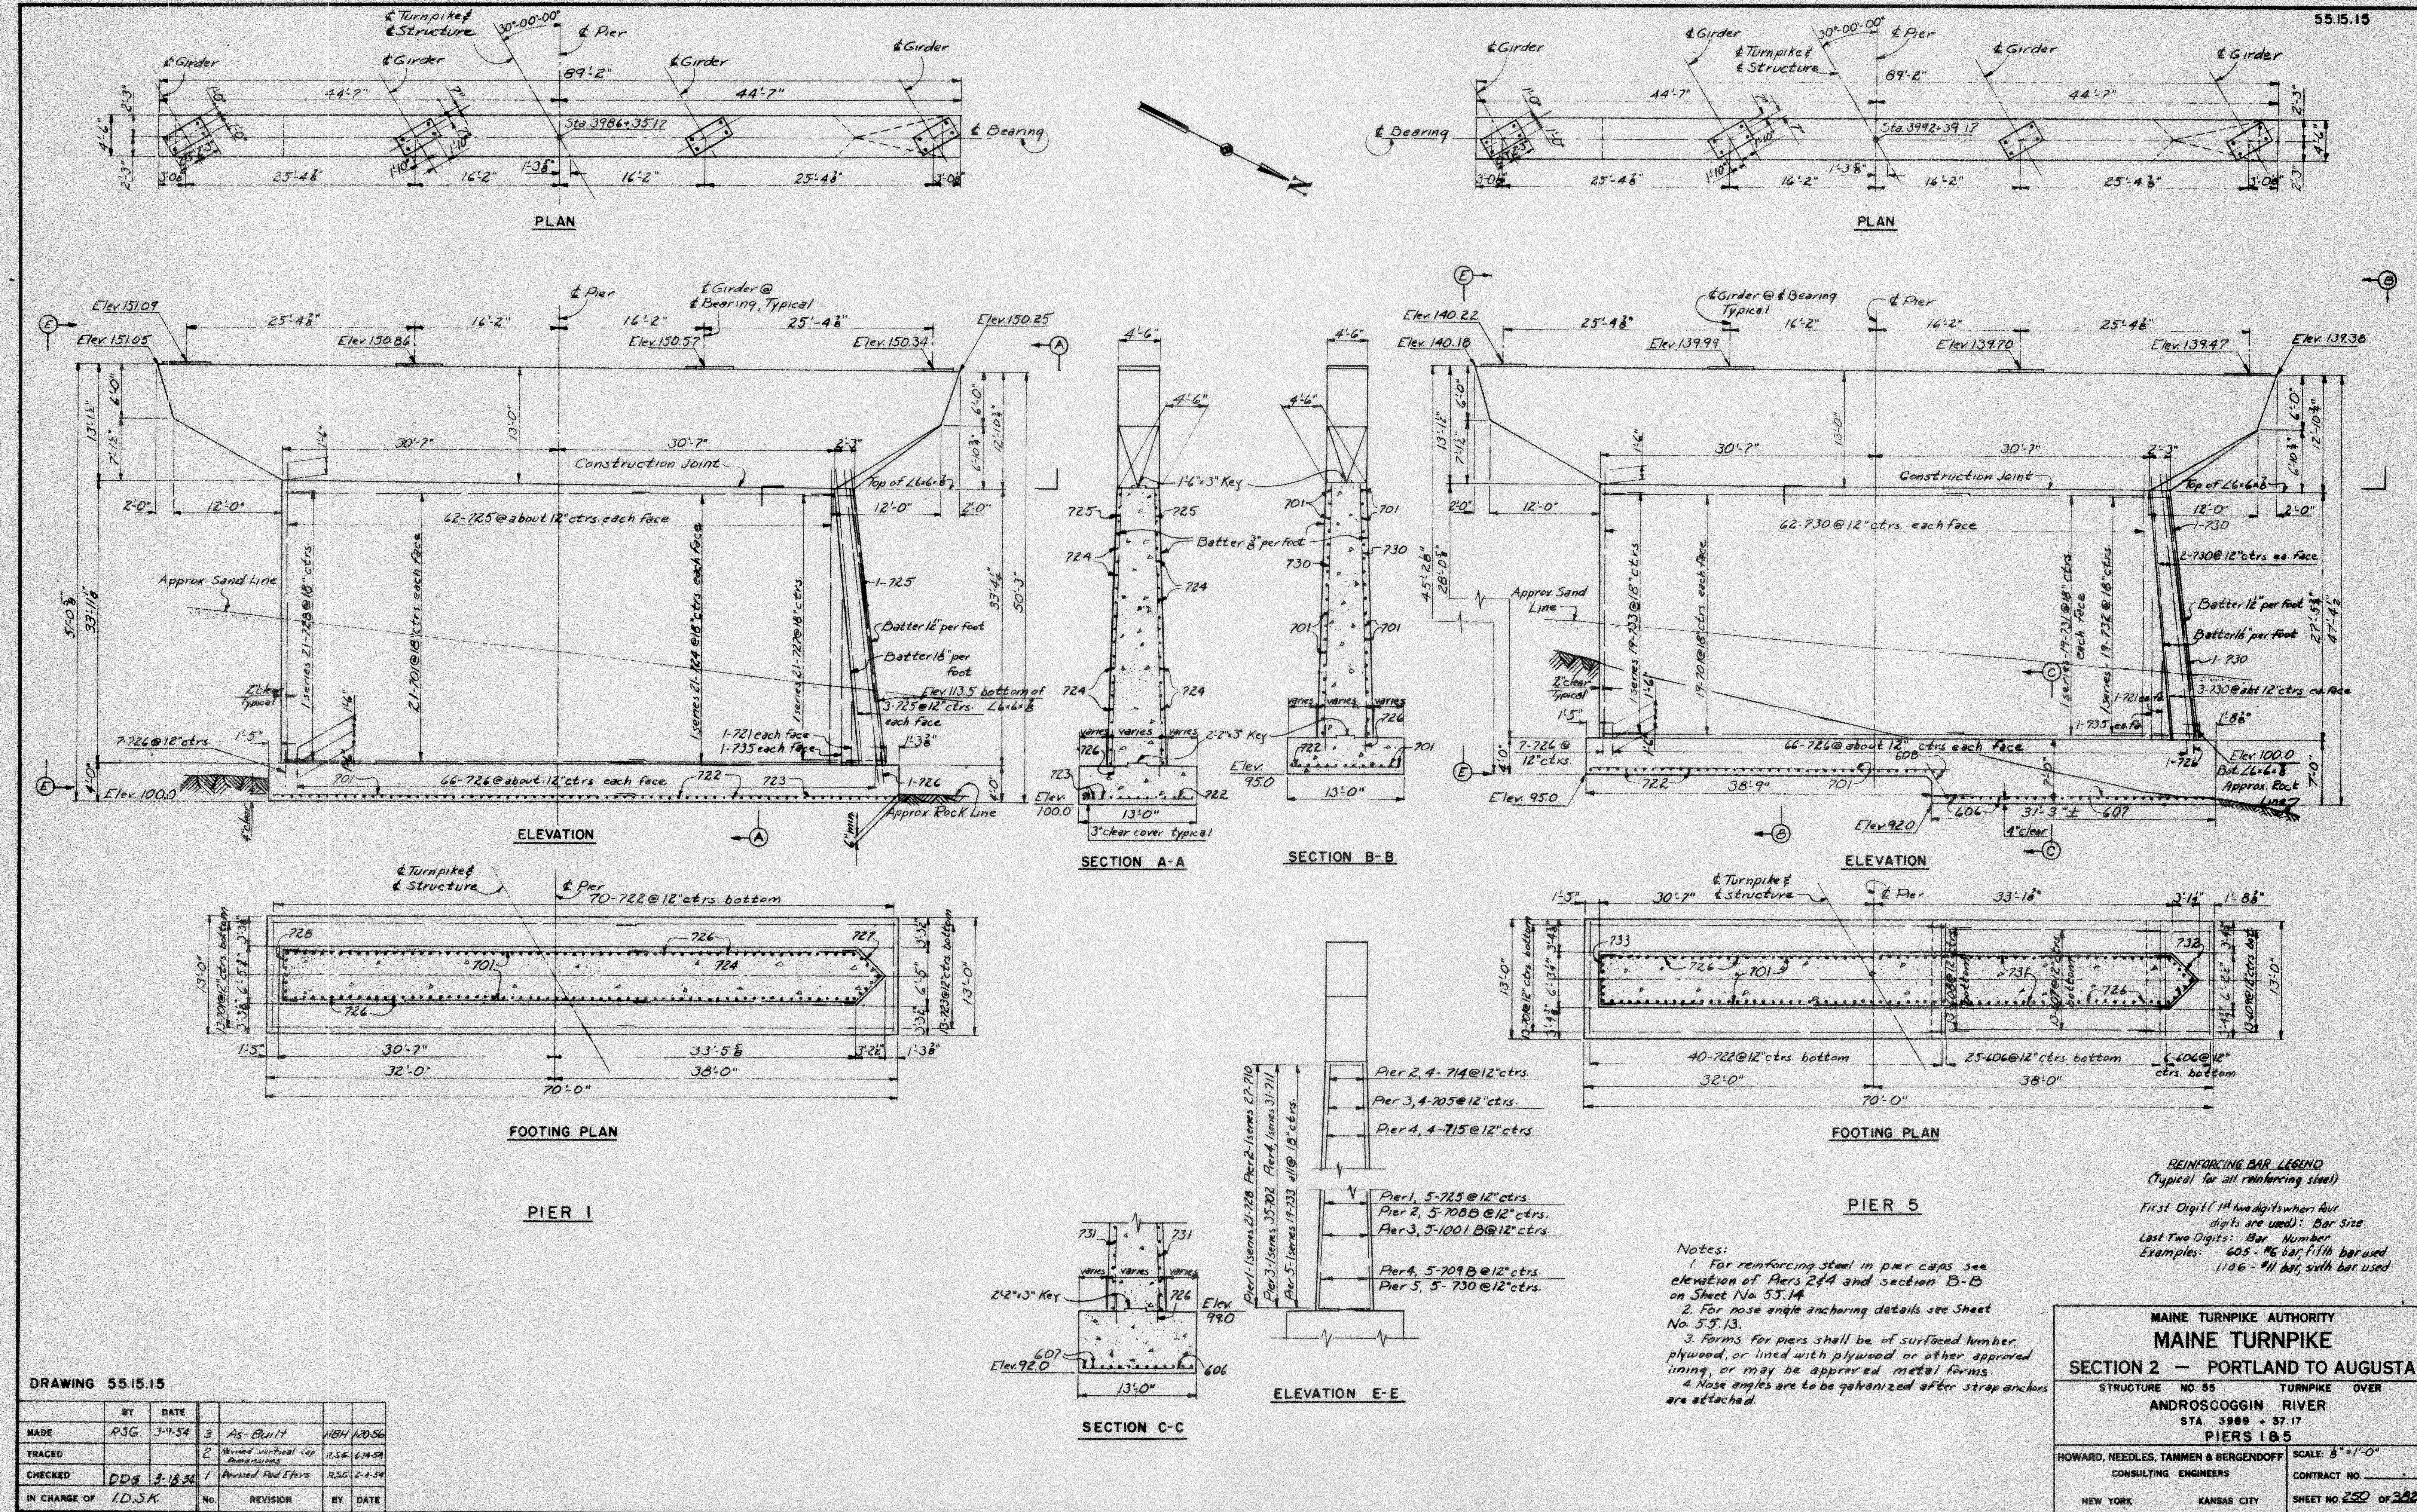

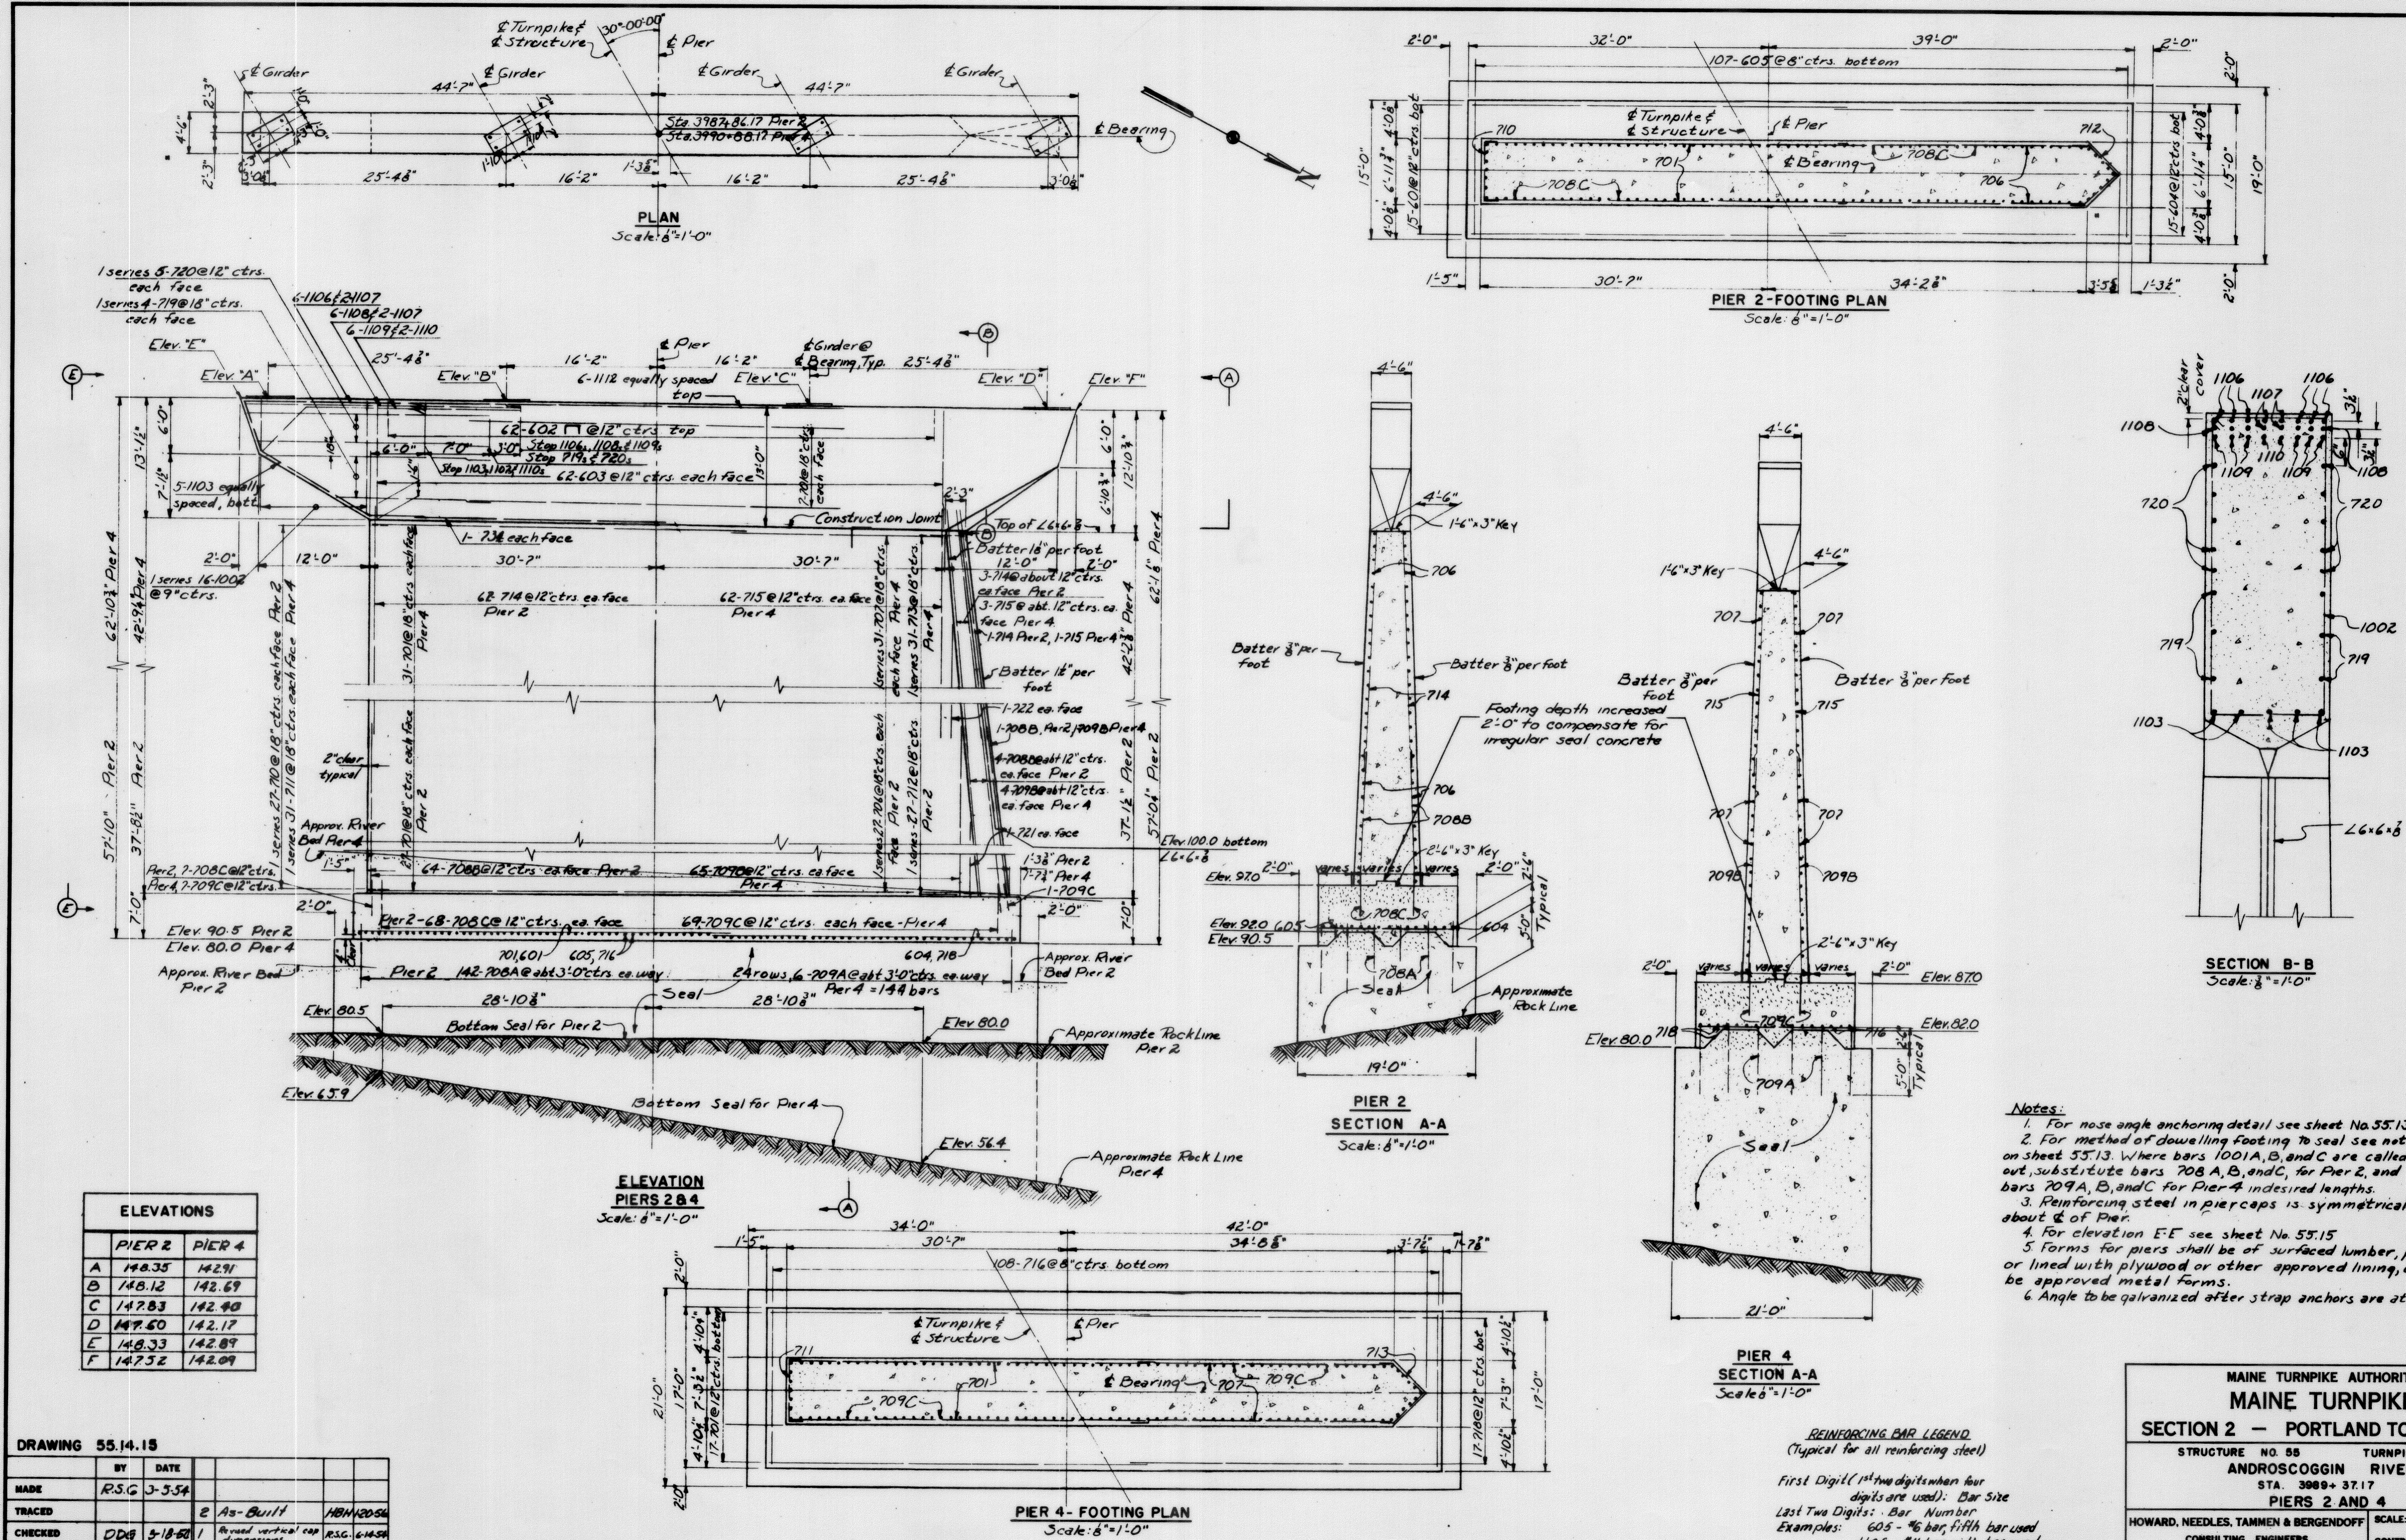

Notes:

1. For nose angle anchoring detail see sheet No. 55.13
2. For method of dowelling footing to seal see note sheet 55.13. Where bars 1001A, B, and C are called out, substitute bars 708 A, B, and C, for Pier 2, and bars 709 A, B, and C for Pier 4 in desired lengths.
3. Reinforcing steel in pier caps is symmetrical about \$ of Pier.

out & of Pier.

4. For elevation E-E see sheet No. 55.15
5. Forms for piers shall be of surfaced lumber, plywood, lined with plywood or other approved lining, or may be approved metal forms.

6. Angle to be galvanized after strap anchors are attached.

...and the children are scattered

Digitized by srujanika@gmail.com

MAINE TURNPIKE AUTHORITY

MAINE TURNPIKE

MAINE TURNPIKE

SECTION 2 = PORTLAND TO AUGUSTA

SECTION 2 — PORTLAND TO AUGUSTA

STRUCTURE NO. 55 TURNPIKE OVER

ANDROSCOGGIN RIVER

STA. 3909+37.17

PIERS 2 AND 4

HOWARD, NEEDLES, TAMMEN & BERGENDOFF SCALE: A3 Shows

HOWARD, NEEDLES, TAMMEN & BERGENDOFF CONSULTING ENGINEERS

sed CONSULTING ENGINEERS CONTRACT NO. _____


NEW YORK KANSAS CITY SHEET NO. 249 OF

NEW YORK KANSAS CITY SHEET NO. 1 OF

Digitized by srujanika@gmail.com


Digitized by srujanika@gmail.com

Journal of Health Politics, Policy and Law, Vol. 35, No. 3, June 2010
DOI 10.1215/03616878-35-3 © 2010 by The University of Chicago

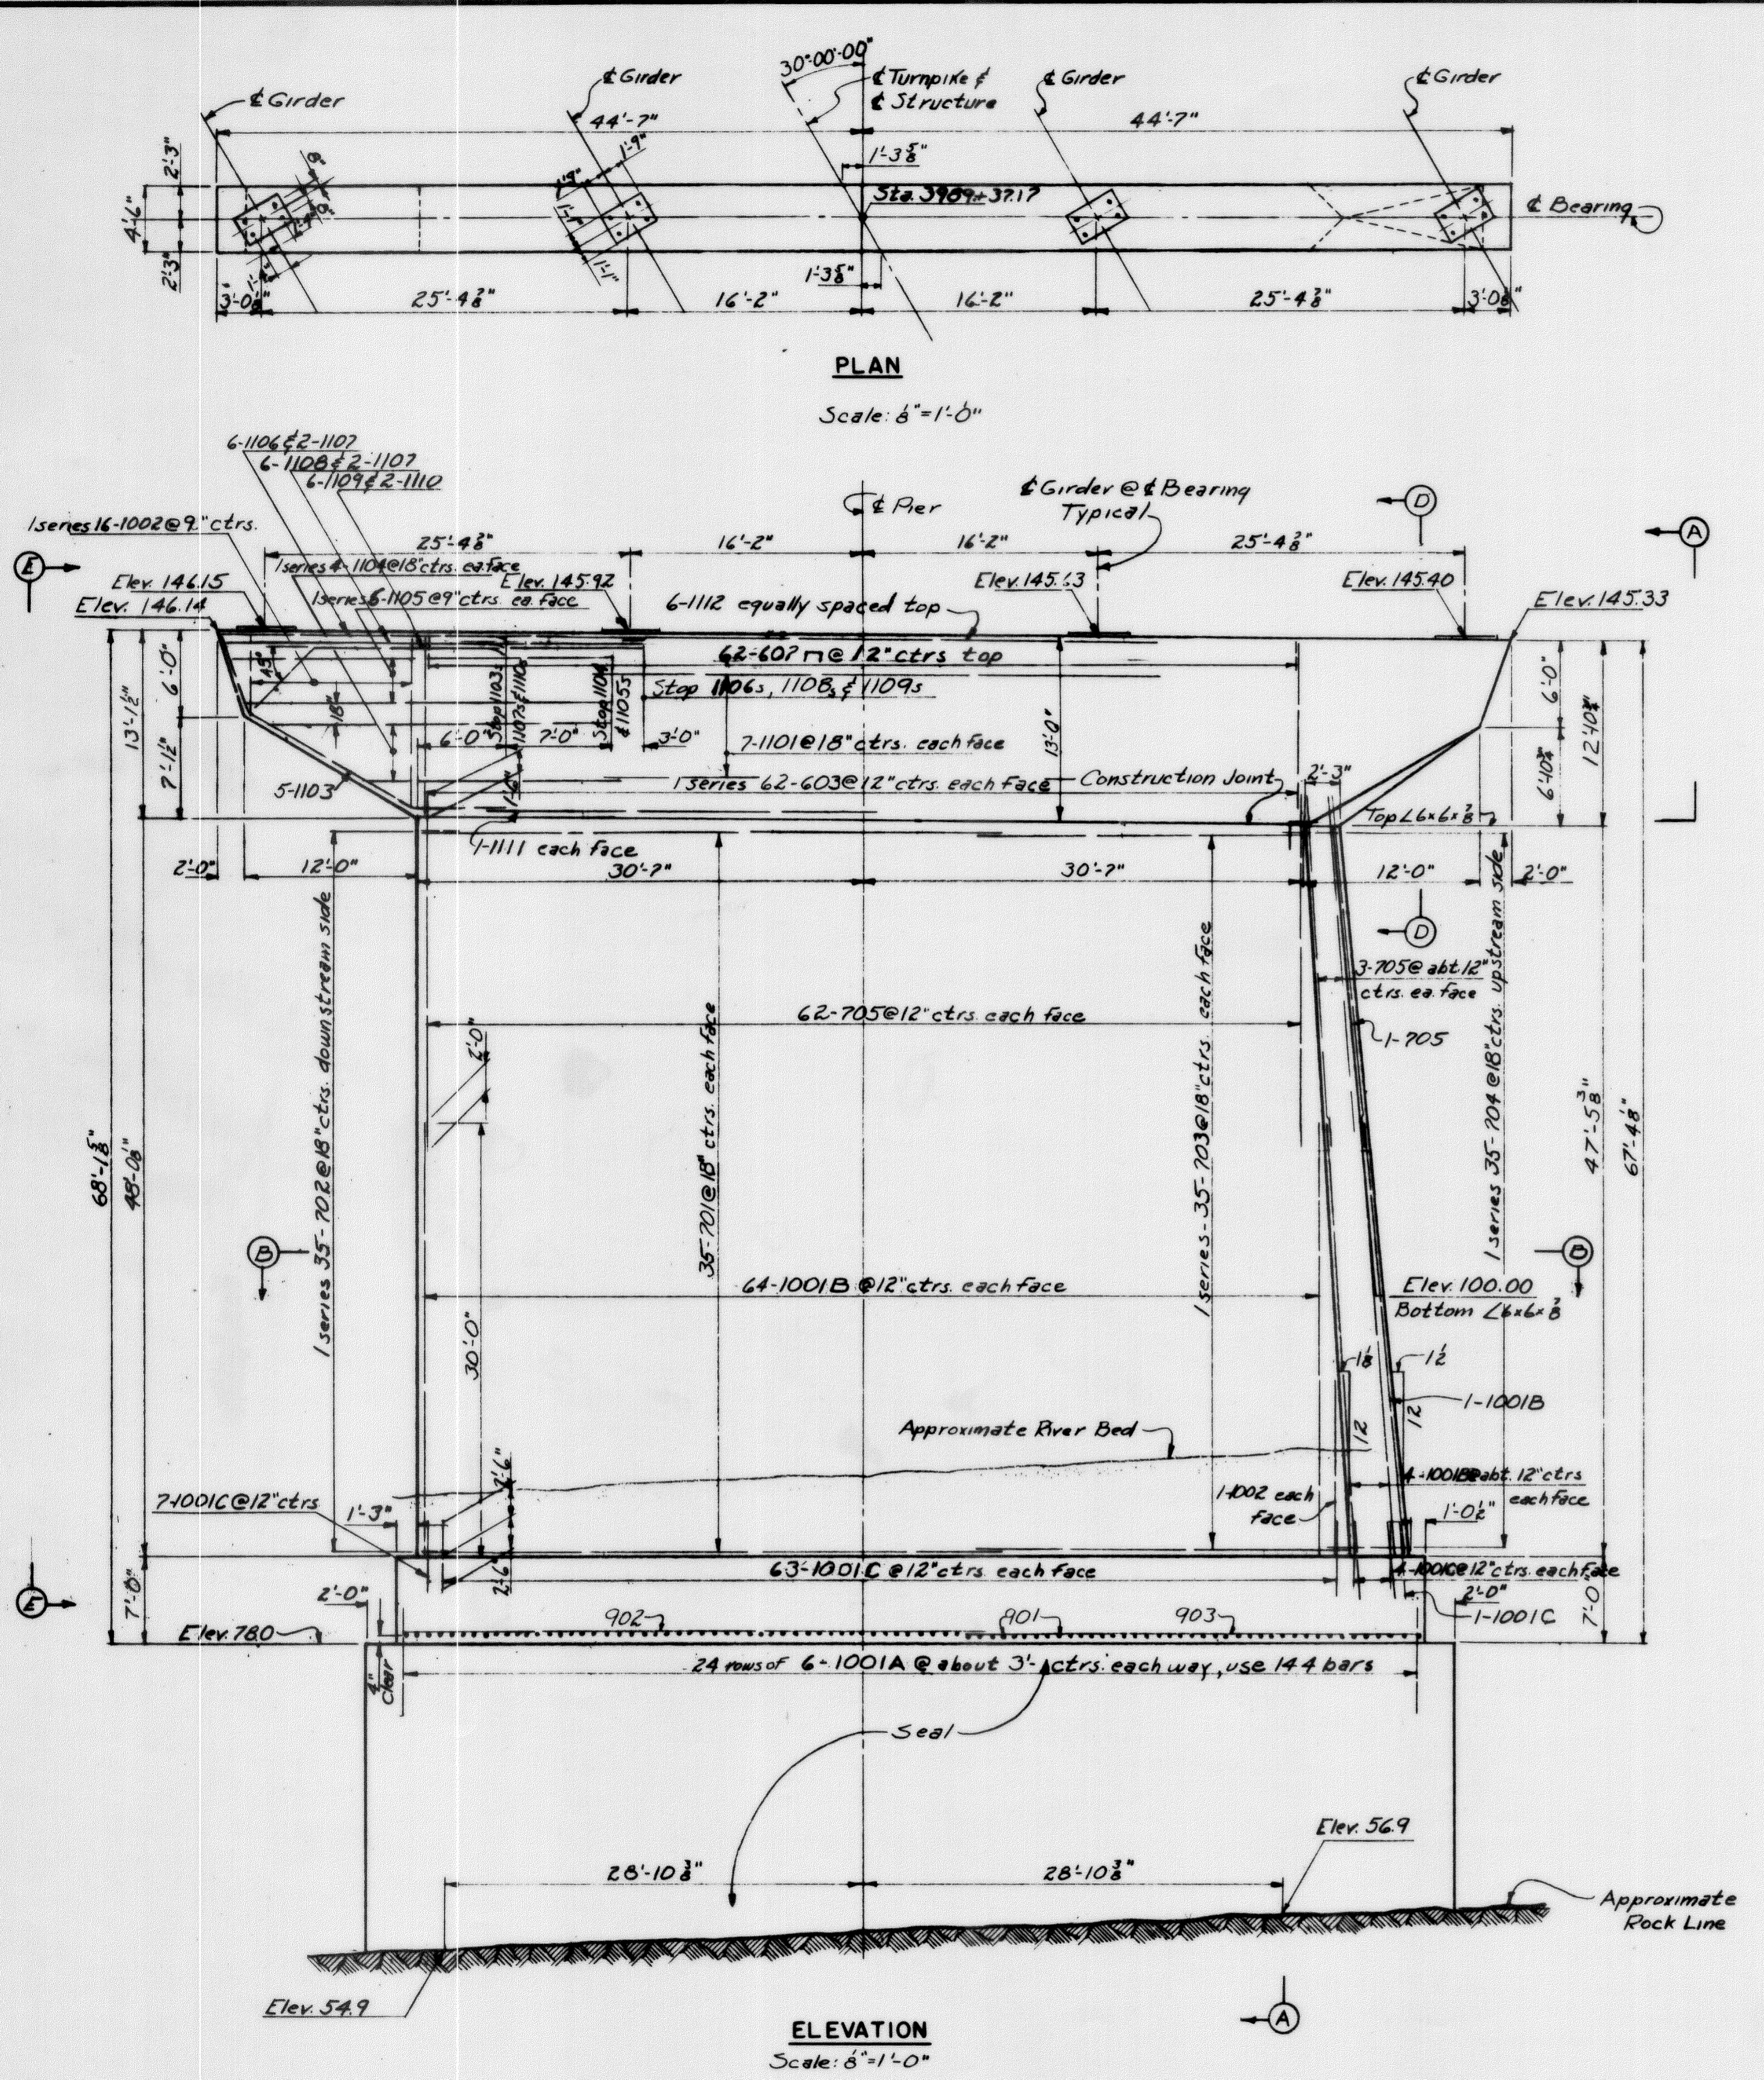


DRAWING 55.13.15


	BY	DATE			
MADE	R.S.G.	3-2-54			
TRACED			2	As-Built	H.B.H. 12056
CHECKED	DDG	3-18-54	1	Revised vertical cap dimensions	R.S.G. 6-14-54
IN CHARGE OF	L.D.S.K.		NO.	REVISION	BY DATE

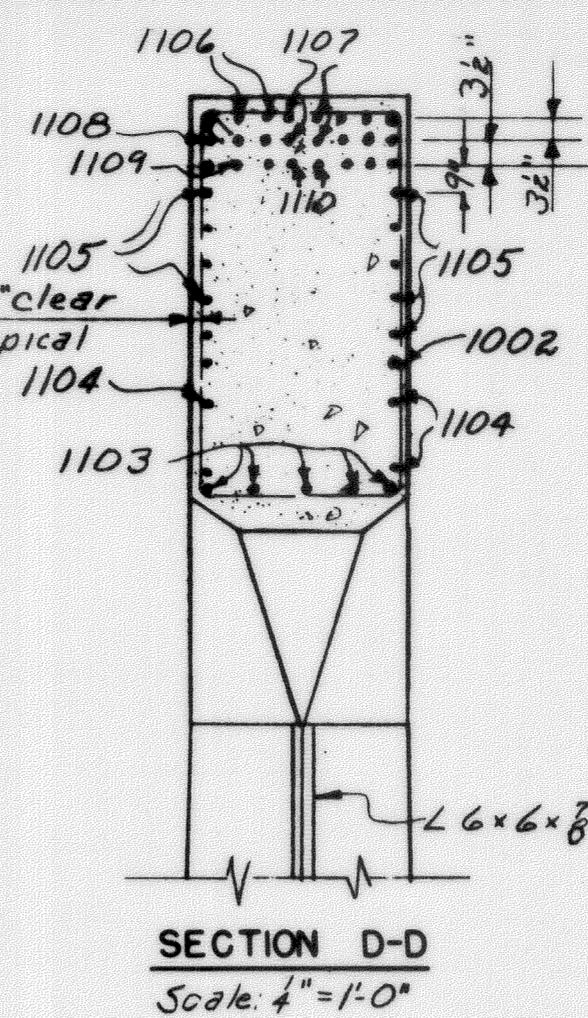

SECTION D-

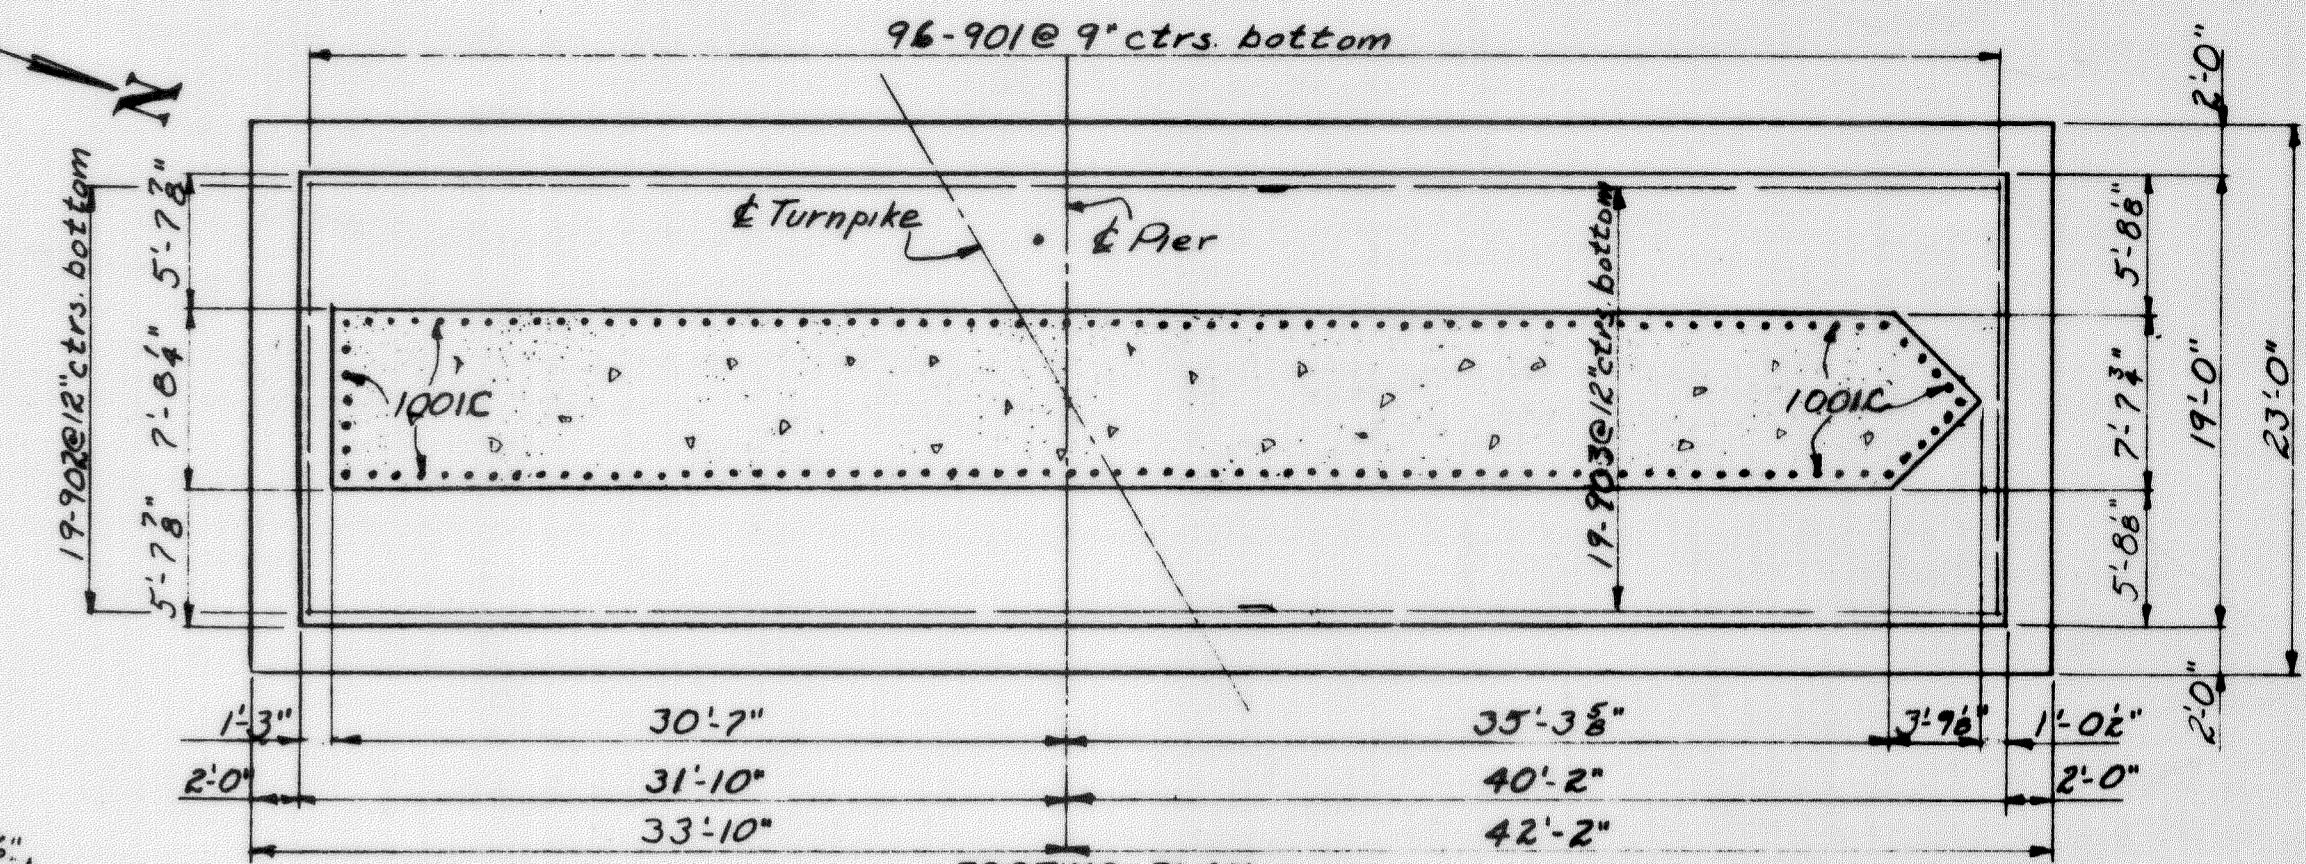

FOOTING PLAN

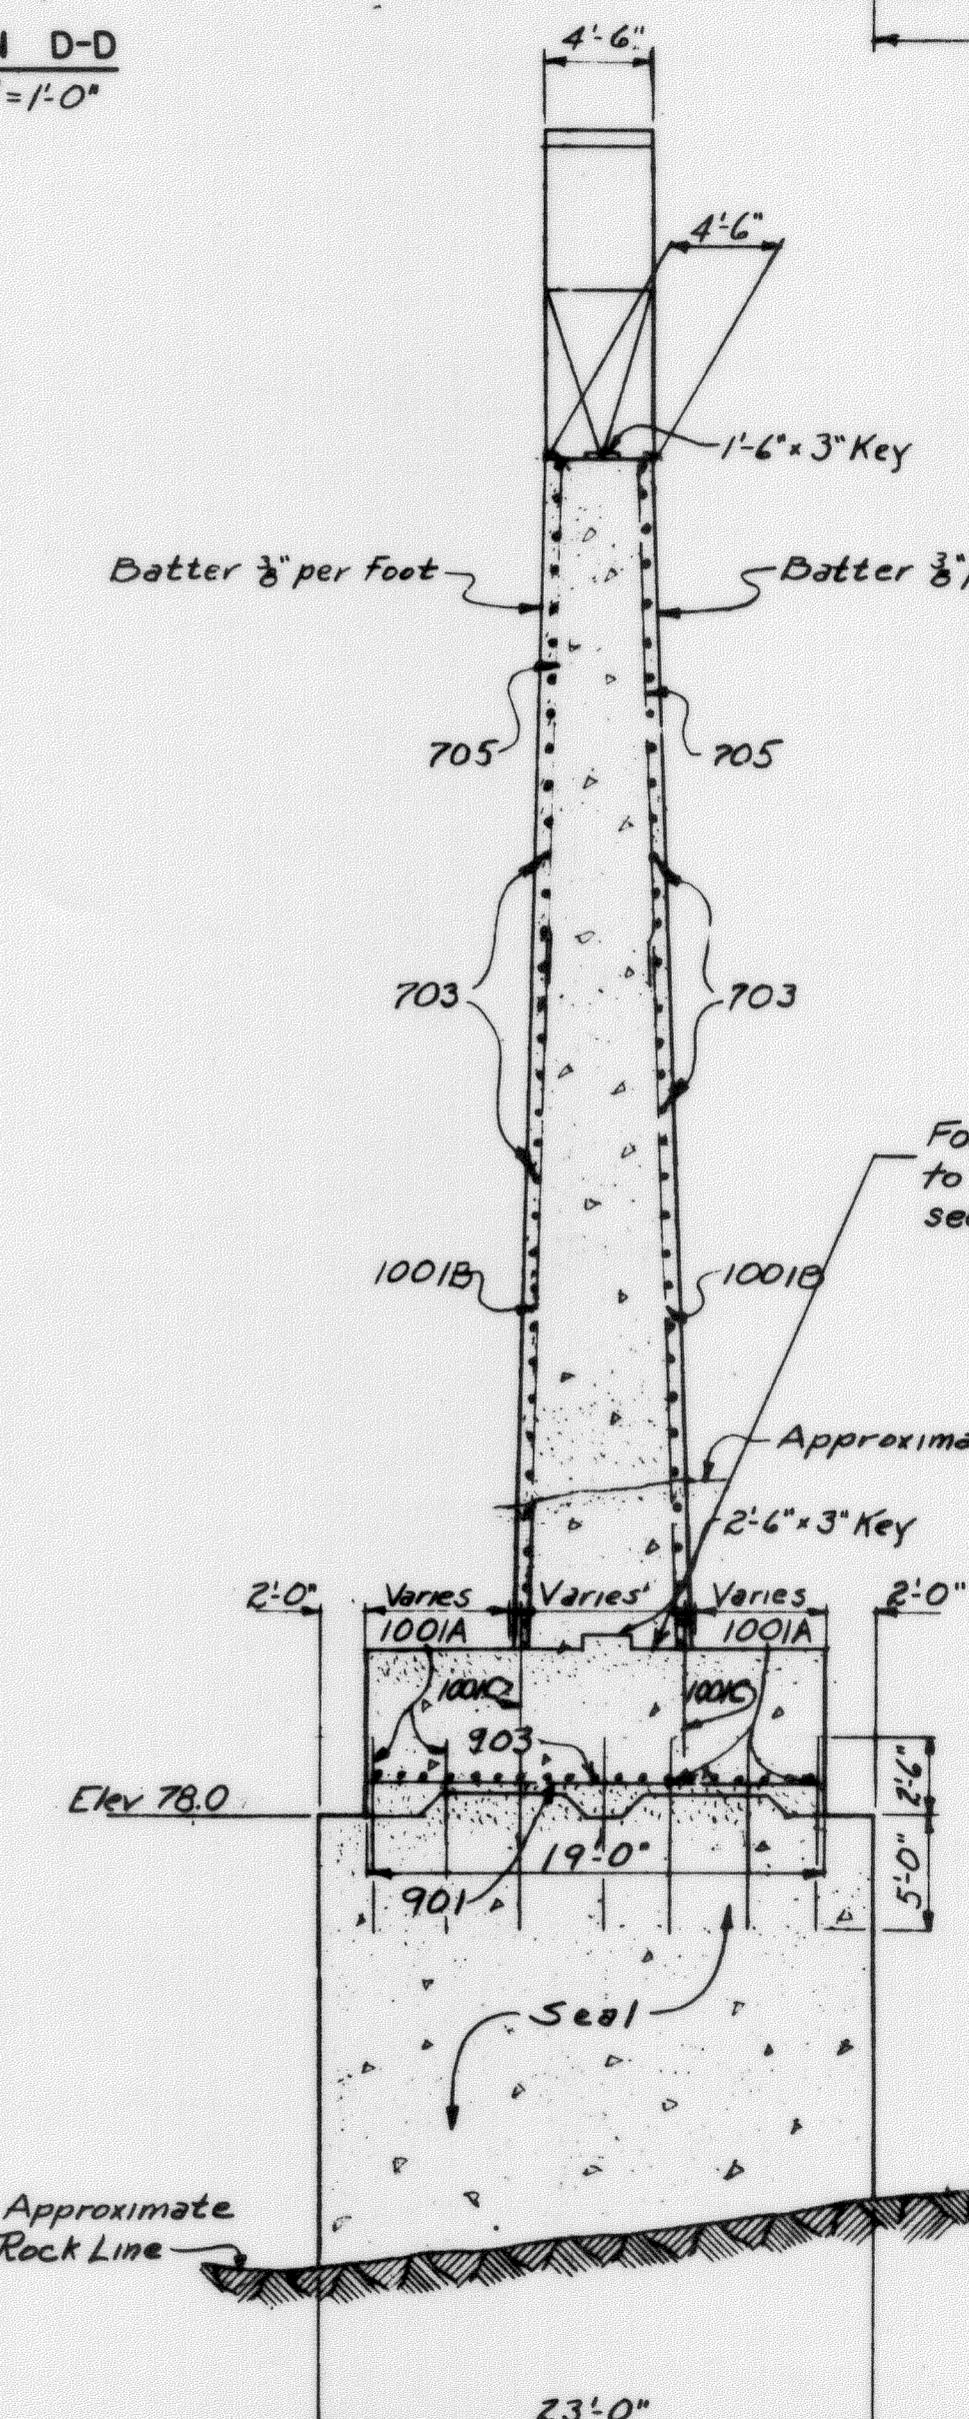

SECTION A-A

REINFORCING BAR LEGEND
(Typical for all reinforcing steel)

First Digit (1st two digits when four
digits are used) Bar size
Last Two Digits: Bar Number
Examples: 605 - 46 bar, fifth bar used
1196 - 41 bar, sixth bar used

Notes:
Reinforcing steel in the pier cap is symmetrical about the E of Pier.
For Elevation E-E see sheet No. 55.15.
Forms for piers shall be of surfaced lumber, plywood, or lined with plywood or other approved lining, or may be approved metal forms.
Either of the following methods, or any method approved by the Engineer may be used to place dowels 1001A in the seal concrete:

Course: (a) Bars 1001 shall be delivered in 42'-6" lengths. Before the seal concrete has taken its initial set, bars 1001 shall be properly positioned and pushed 5'-0" into the seal course. After the cofferdam is dewatered bars 1001 shall be cut off 2'-6" above the top of the seal course to leave bars 1001A as shown. The remainder of bars 1001 shall be cut into 30'-0" and 5'-0" lengths to form bars 1001B and 1001C respectively.

(b) Bars 1001A, 1001B, and 1001C shall be delivered in lengths shown on the plans. Dowels 1001A shall be drilled and grouted into the concrete seal course after the cofferdam is dewatered. A non-shrinking grout such as "Embeco" grout or equivalent shall be used.

Nose angle to be galvanized after strap anchors are attached.

MAINE TURNPIKE AUTHORITY
MAINE TURNPIKE
SECTION 2 — PORTLAND TO AUGUSTA

STRUCTURE NO. 55 TURNPIKE OVER
ANDROSCOGGIN RIVER
STA. 3989 + 37.17
PIER NO. 3