


GENERAL NOTES


Design Specifications: AASHTO (1953) with minor modifications.
 Design Loading: H-15
 Maximum Base Pressure at Abutments: 1.6 Tons/sq. ft.
 Maximum Base Pressure at Piers #1 and #3: 2.5 Tons/sq. ft.
 Maximum Base Pressure at Pier #2: 2.4 Tons/sq. ft.

REFERENCES


Dwg. No.	Title	Sub-structure Contractor	Superstructure		
			Steel Fabricator	Steel Erector	Floor Contractor
SD1	Standard Abutment Details	✓	✓	✓	✓
SD2	Standard Pier Details	✓	✓	✓	✓
SD3	Abutment Drainage Details	✓	✓	✓	✓
SD5	Std. Handrail, Bearing Devices and Miscellaneous Details	✓	✓	✓	✓
SD6	Standard Diaphragm Details	✓	✓	✓	✓
SD7	Standard Type A Splices for 27WF Bms.	✓	✓	✓	✓
SD11	Type "X" and "Y" Expansion Joints	✓	✓	✓	✓
SD13	Standard Bridge Floor Cross Sections 14'-0" & 30'-0" Roadway	✓	✓	✓	✓

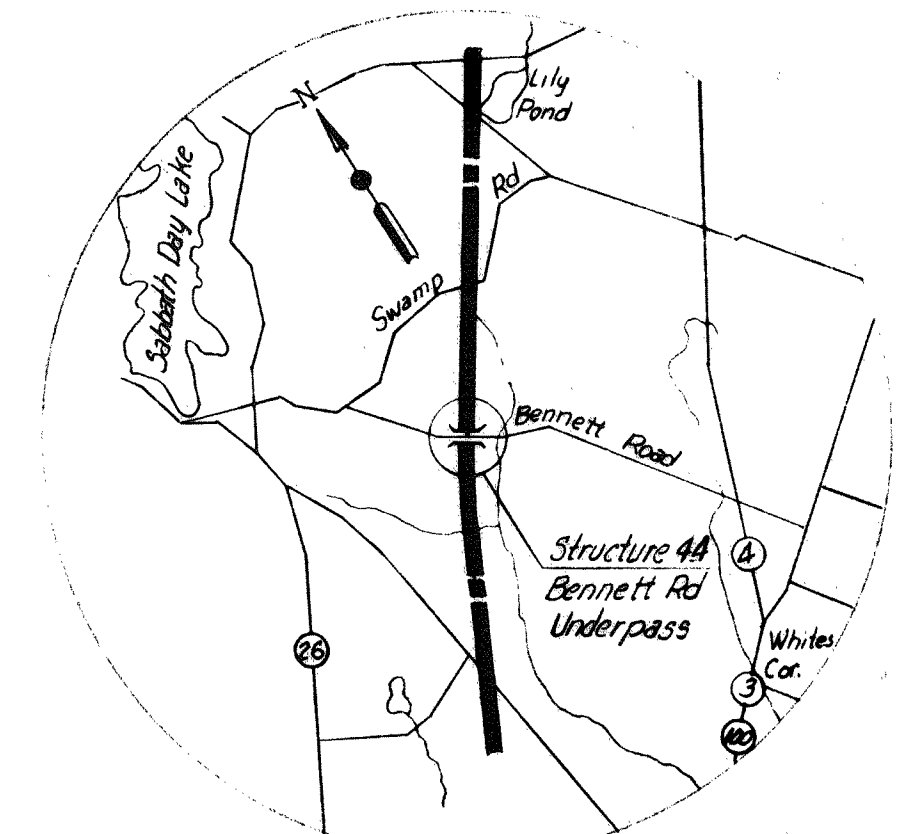


VICINITY MAP
Scale: 1" = 1 Mile

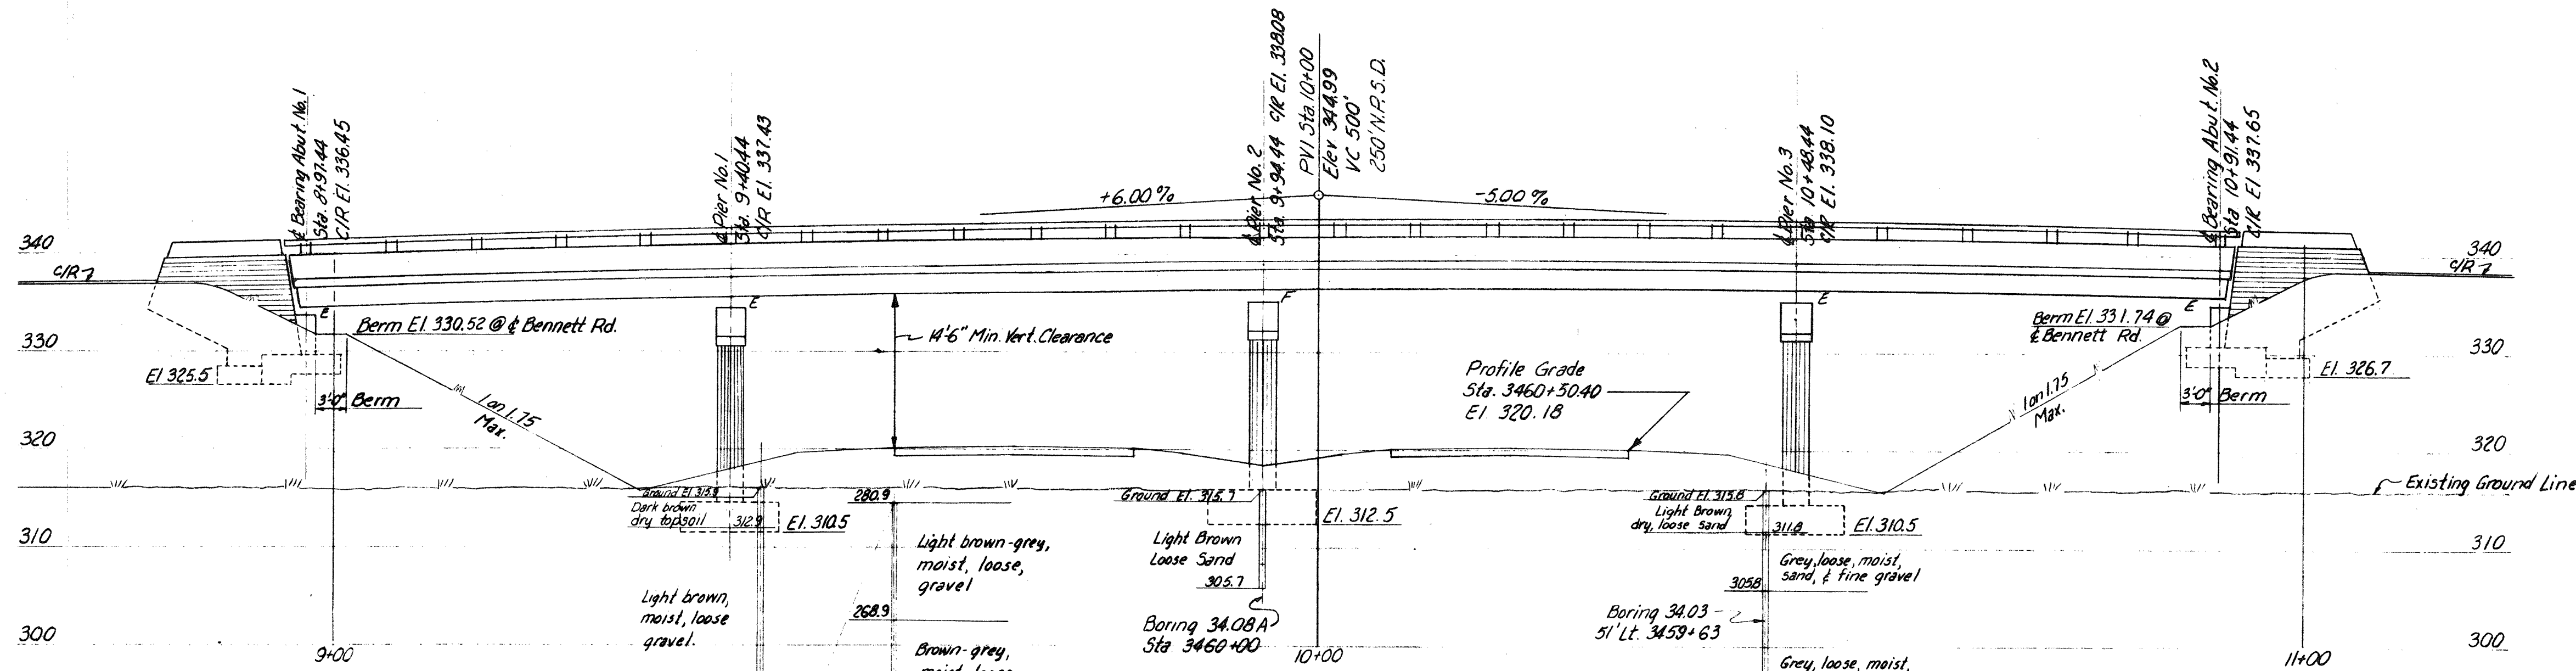

ELEVATION

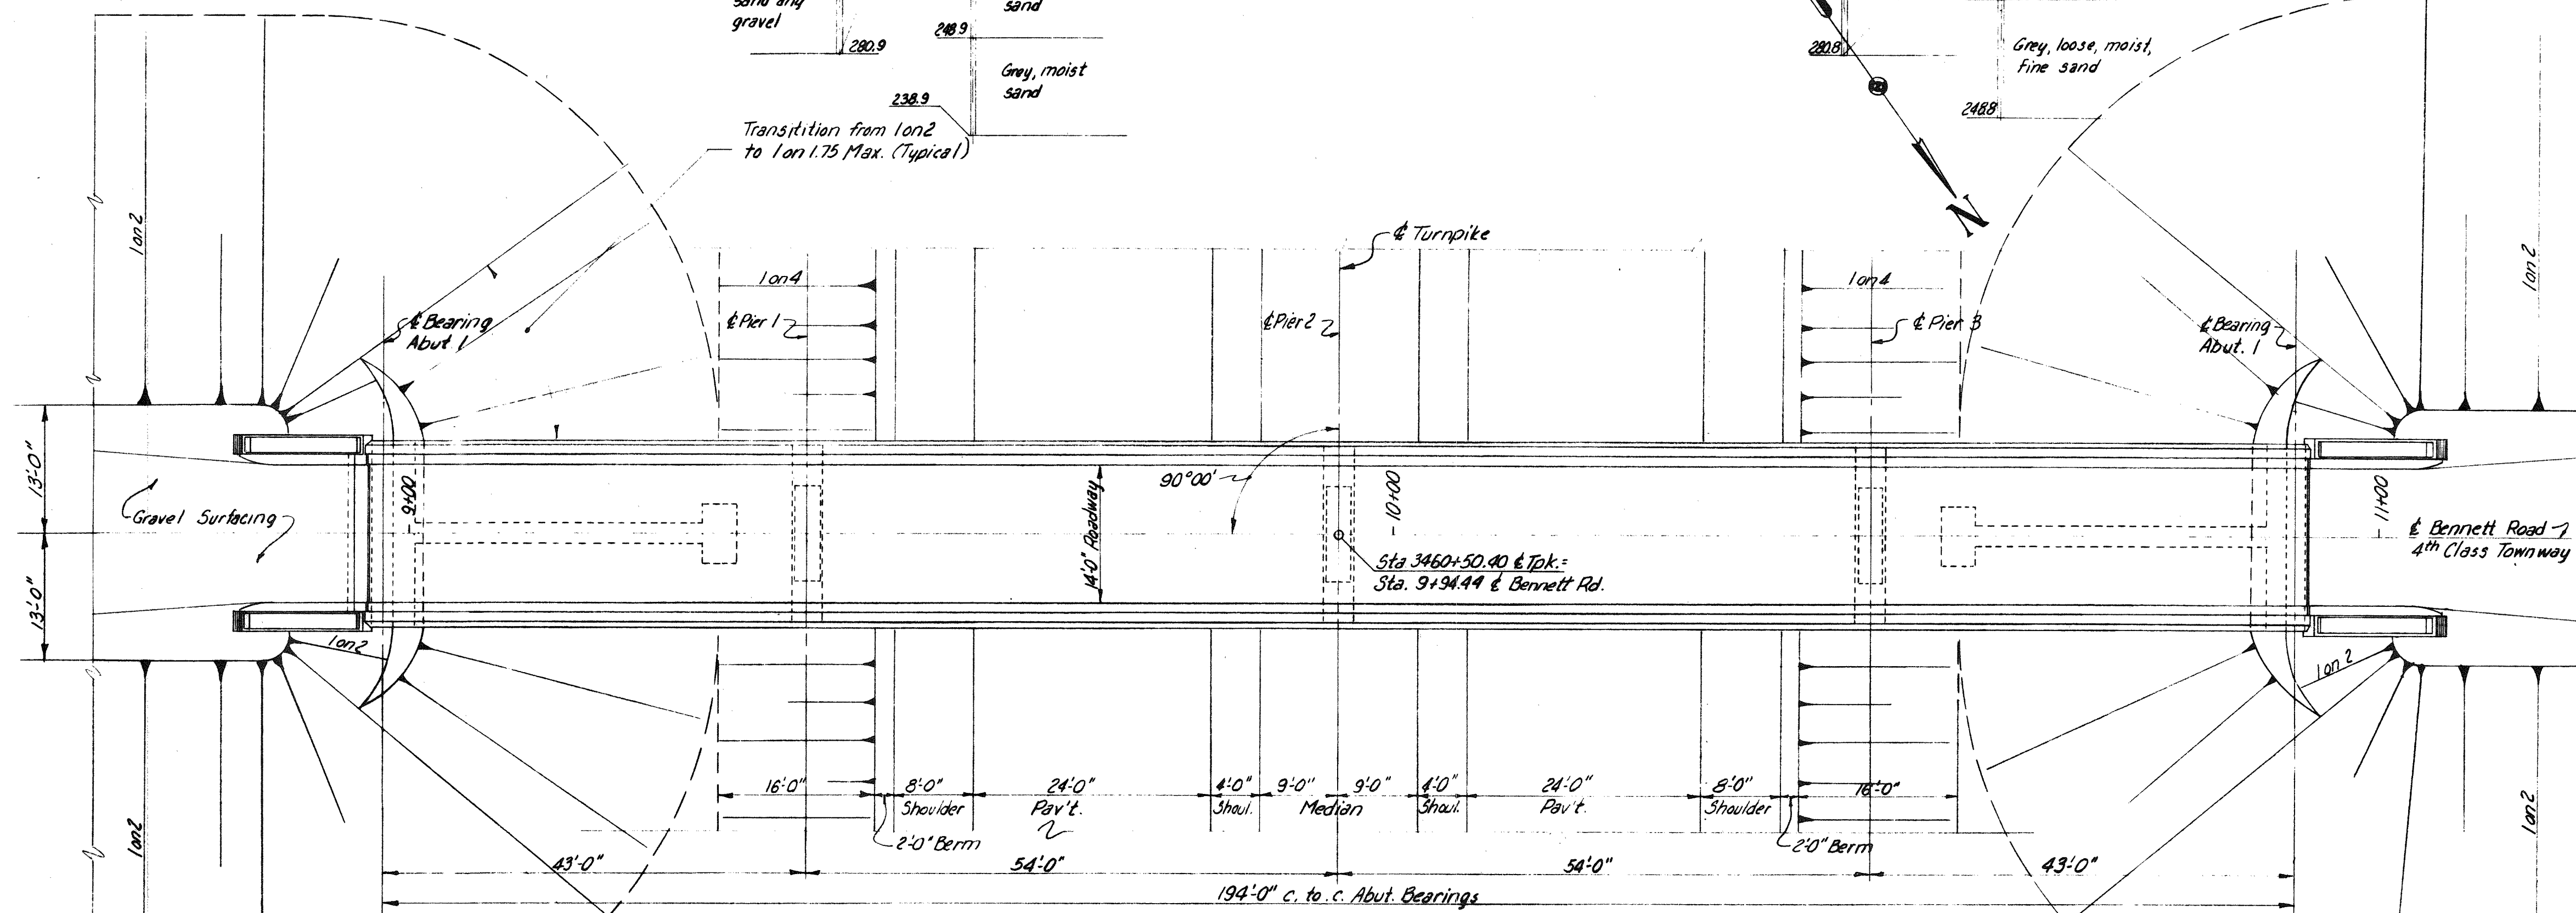

PLAN


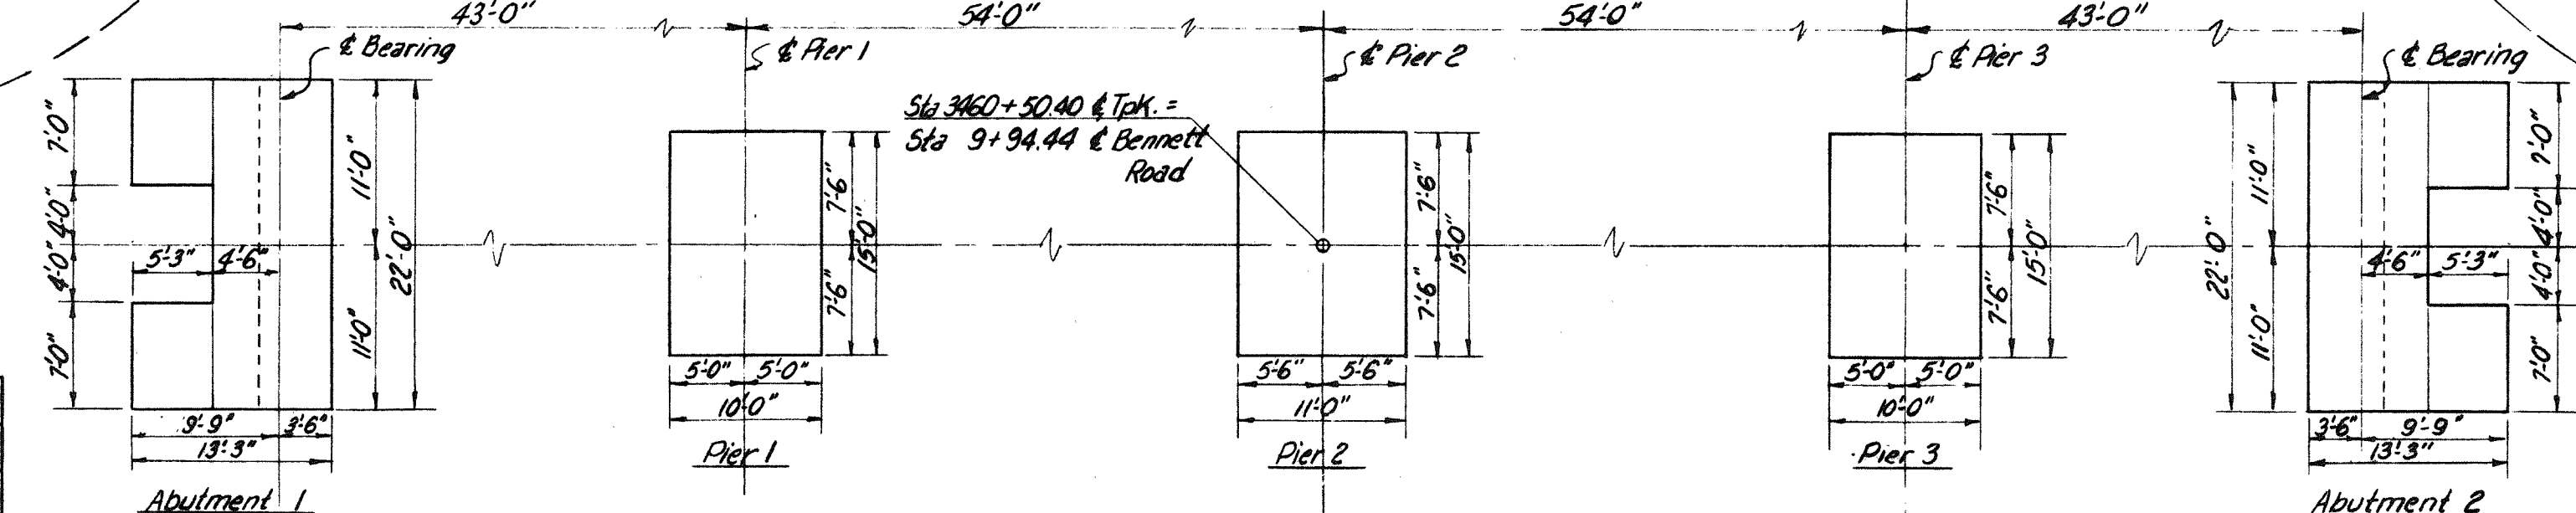


FOOTING PLAN








DRAWING 44.01.03

MADE	BY	DATE	NO.	REVISION	BY	DATE
TRACED	HUG	11-10-53				
CHECKED	TKC	12-1-53	1	As-Built	HGM	1-18-56
IN CHARGE OF	IDSK					

MAINE TURNPIKE AUTHORITY
MAINE TURNPIKE
 SECTION 2— PORTLAND TO AUGUSTA
 STRUCTURE NO. 44 TURNPIKE UNDER
BENNETT ROAD
 STA. 3460+50.40
GENERAL PLAN AND ELEVATION
 HOWARD, NEEDLES, TAMMEN & BERGENDOFF CONSULTING ENGINEERS
 NEW YORK KANSAS CITY
 SCALE: 3/32" = 1'-0"
 CONTRACT NO. _____
 SHEET NO. 192 OF 392

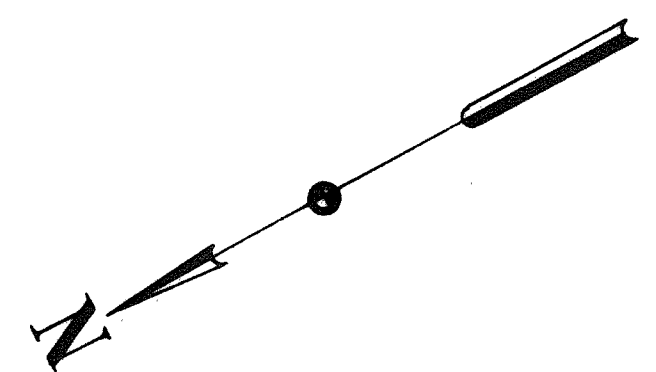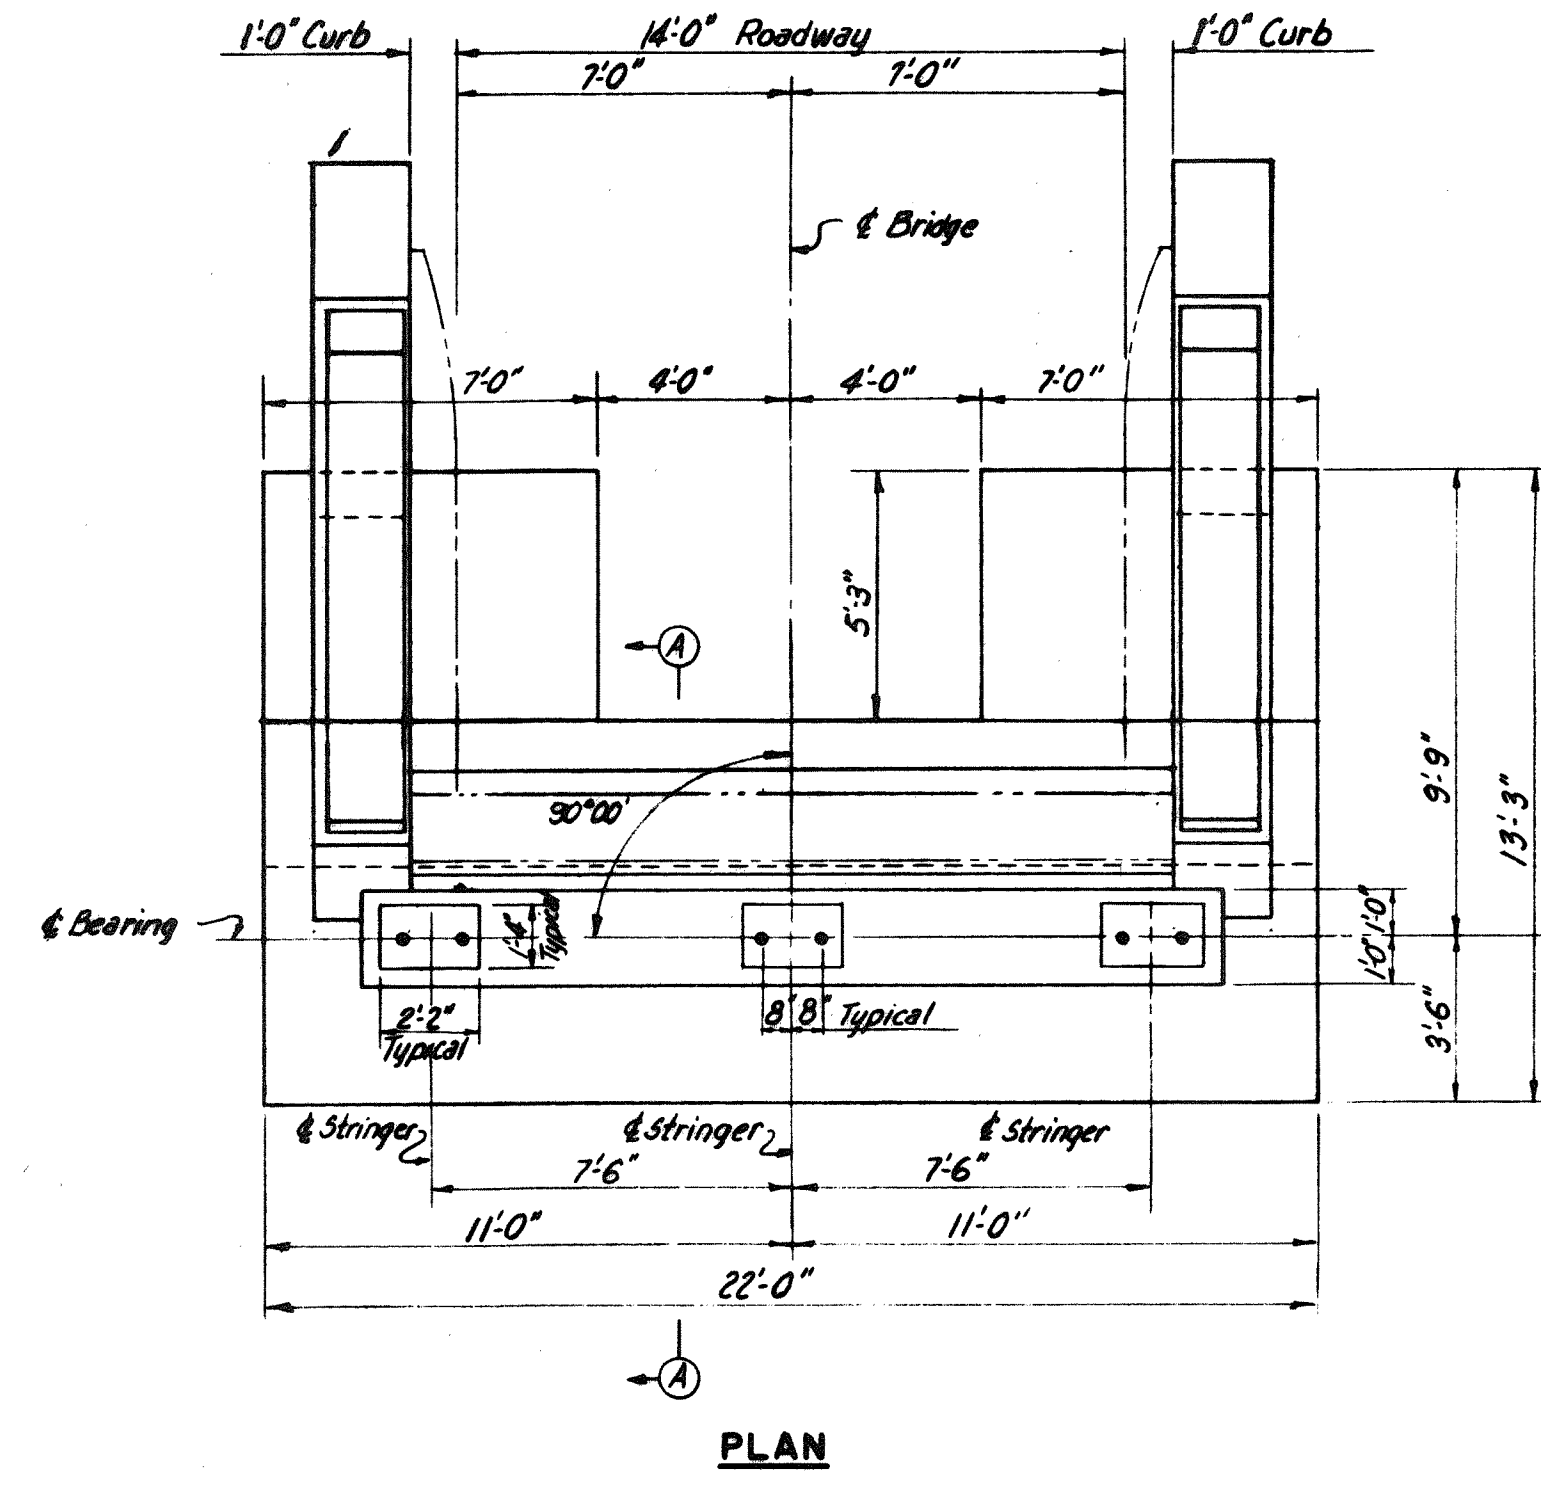

Note: Abutment 1 shown, Abutment 2 similar by rotation.

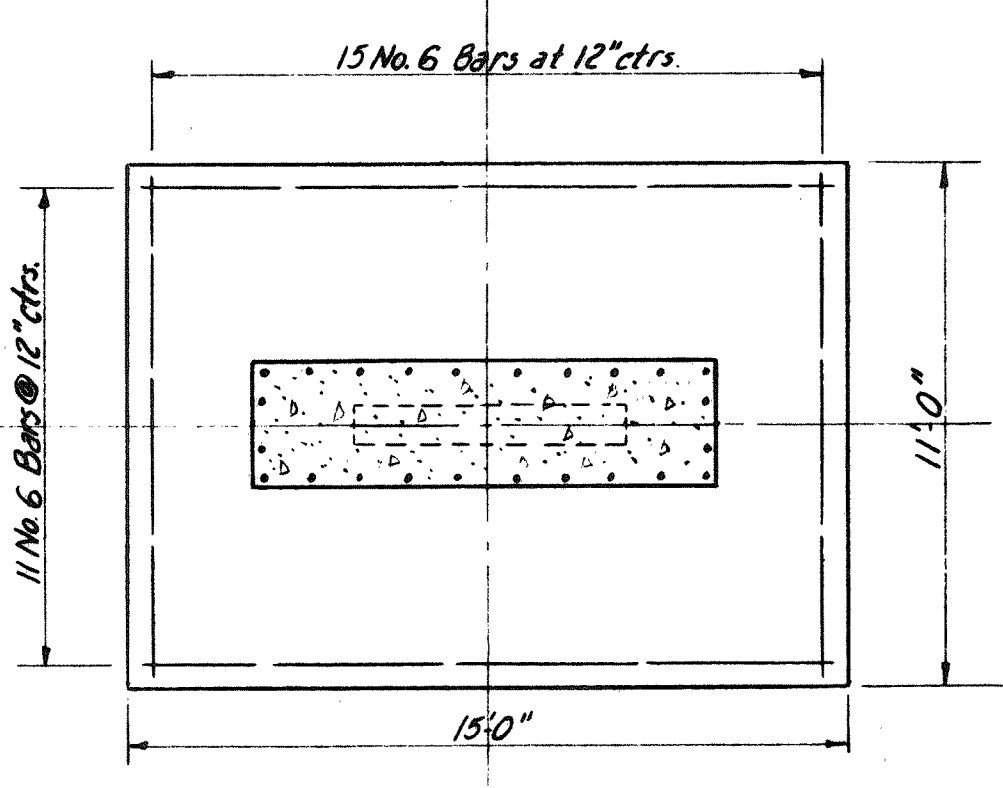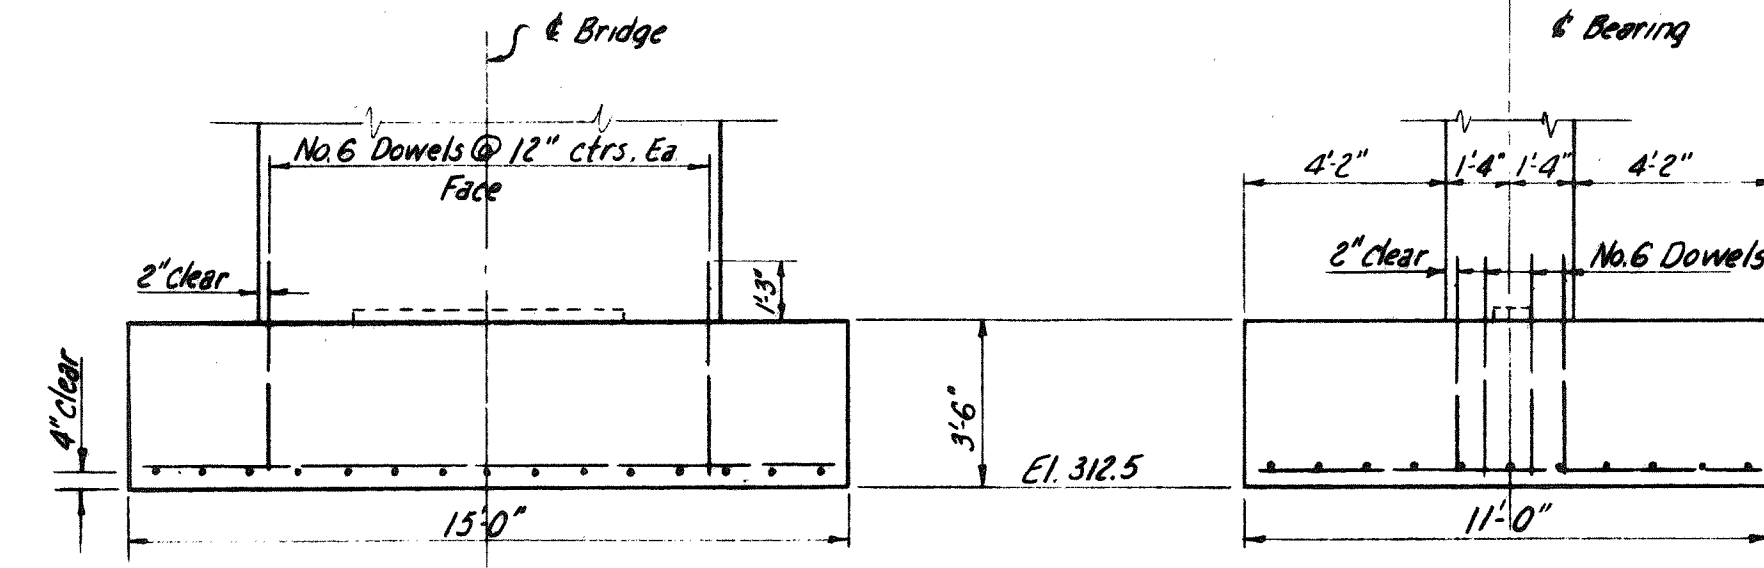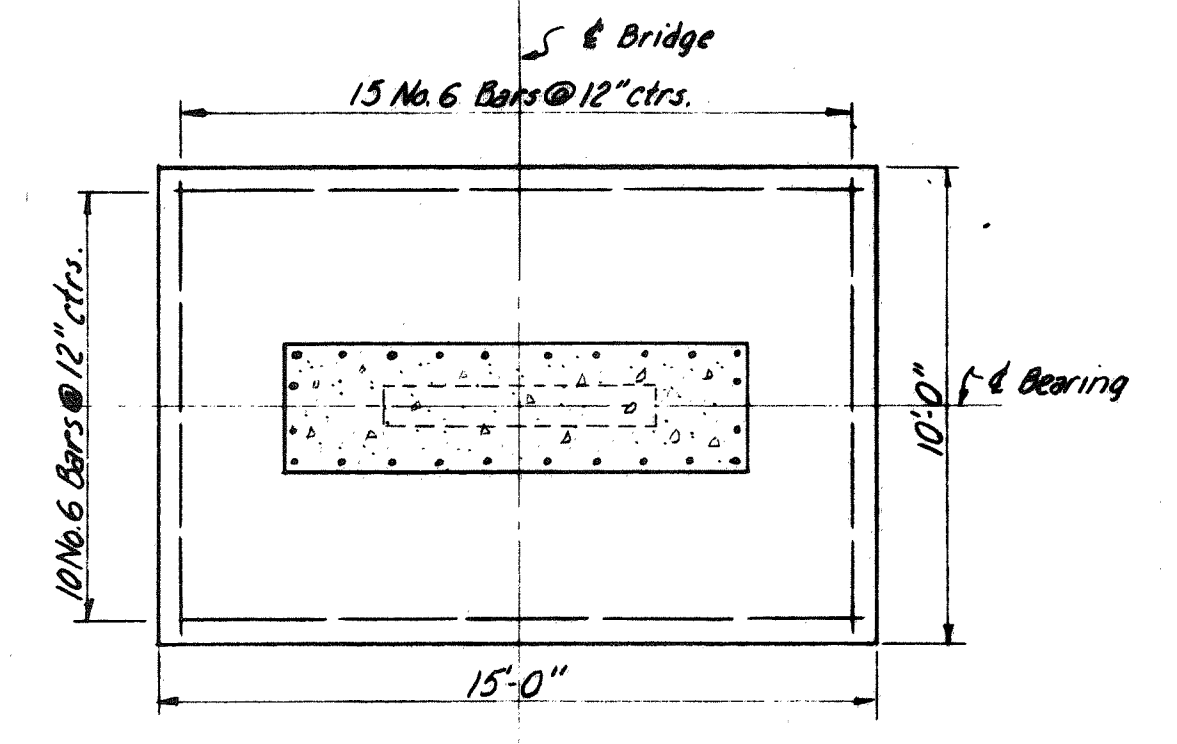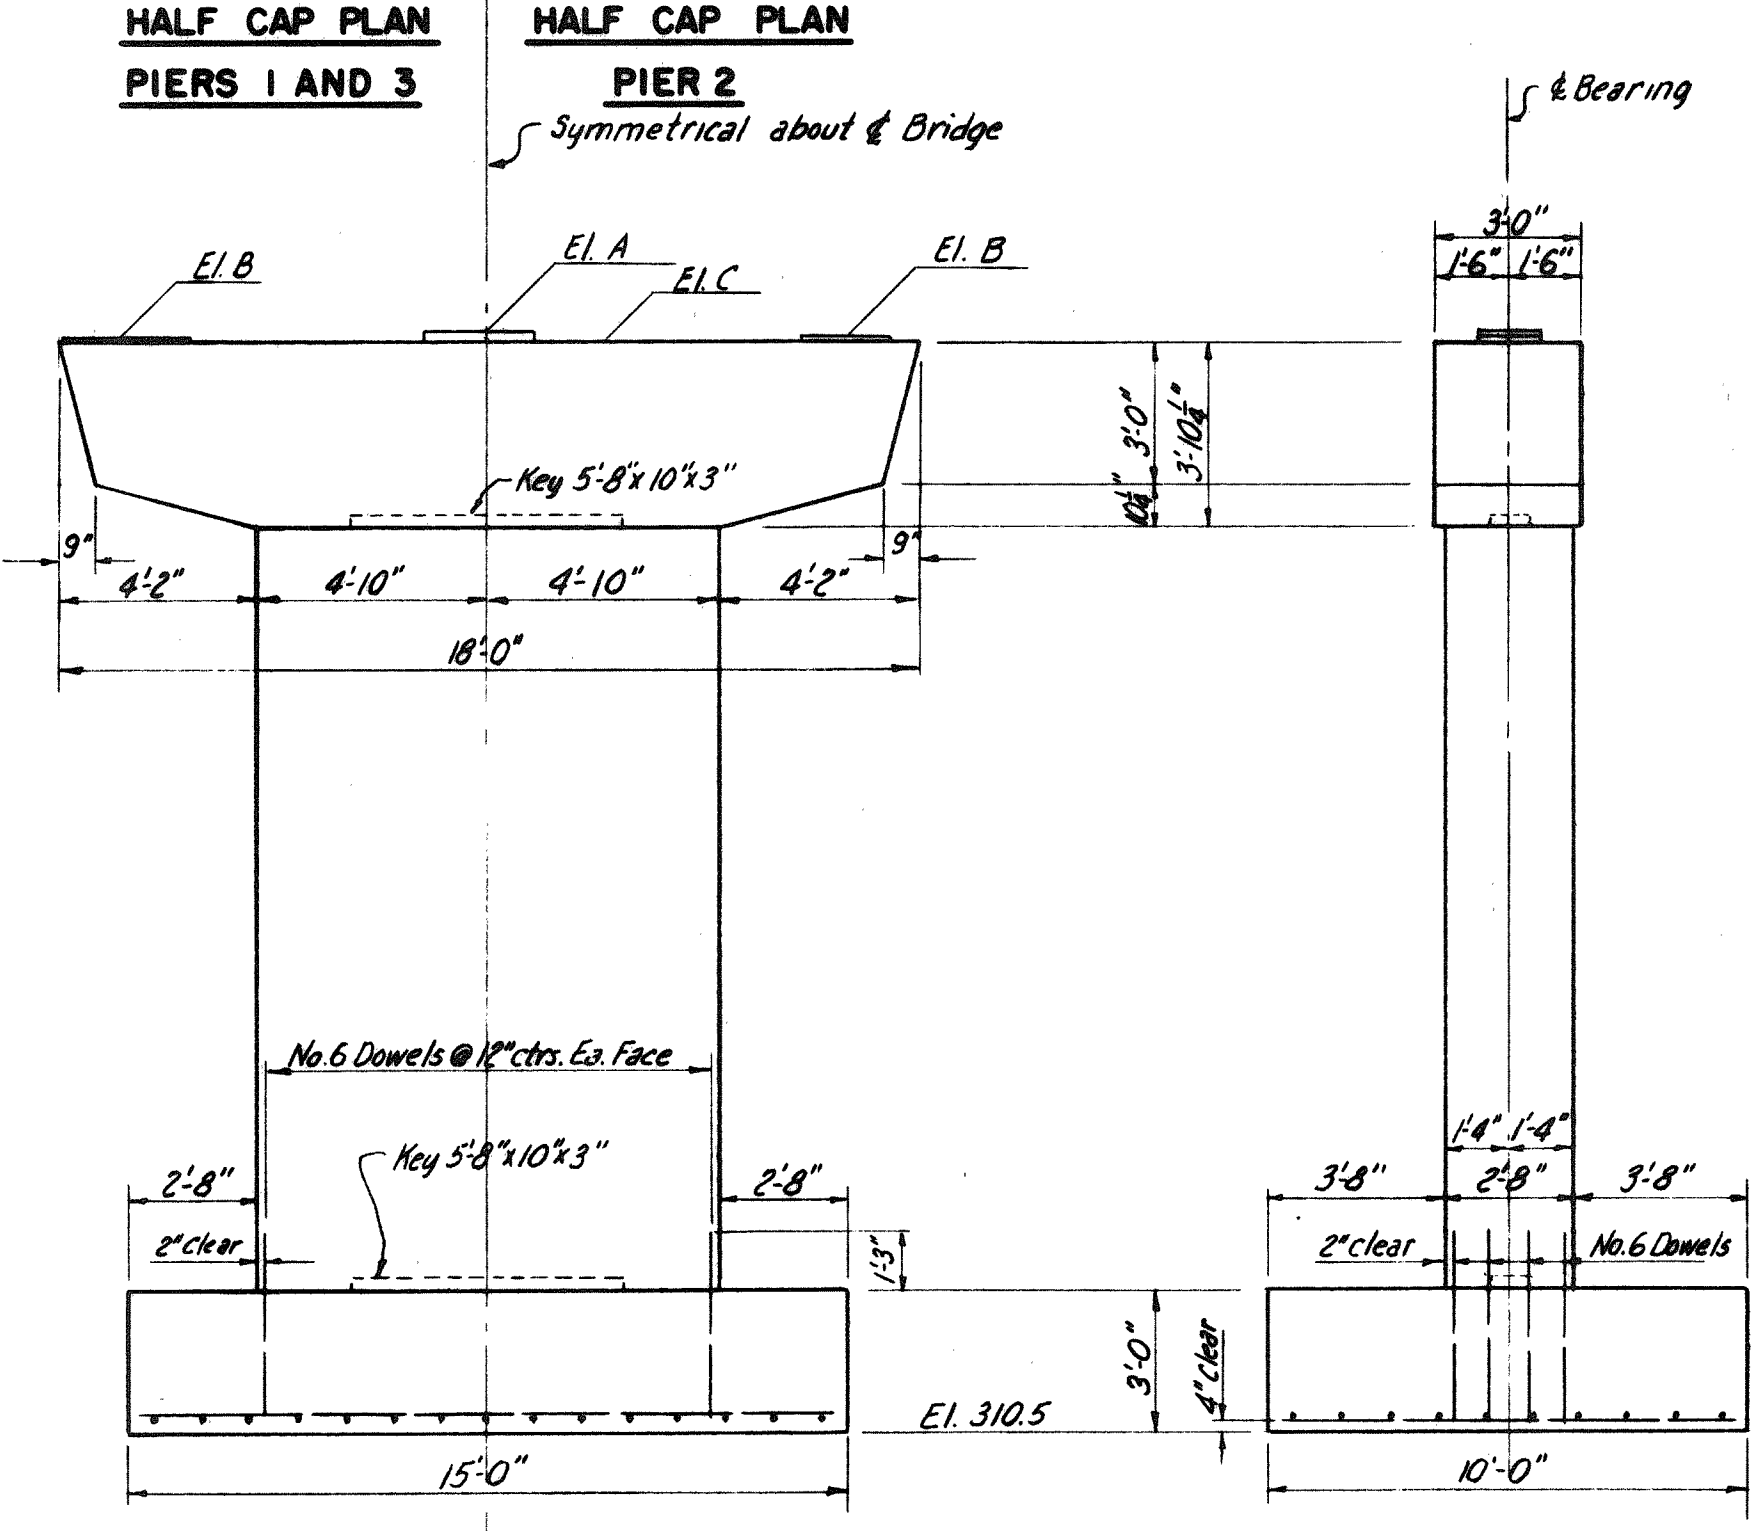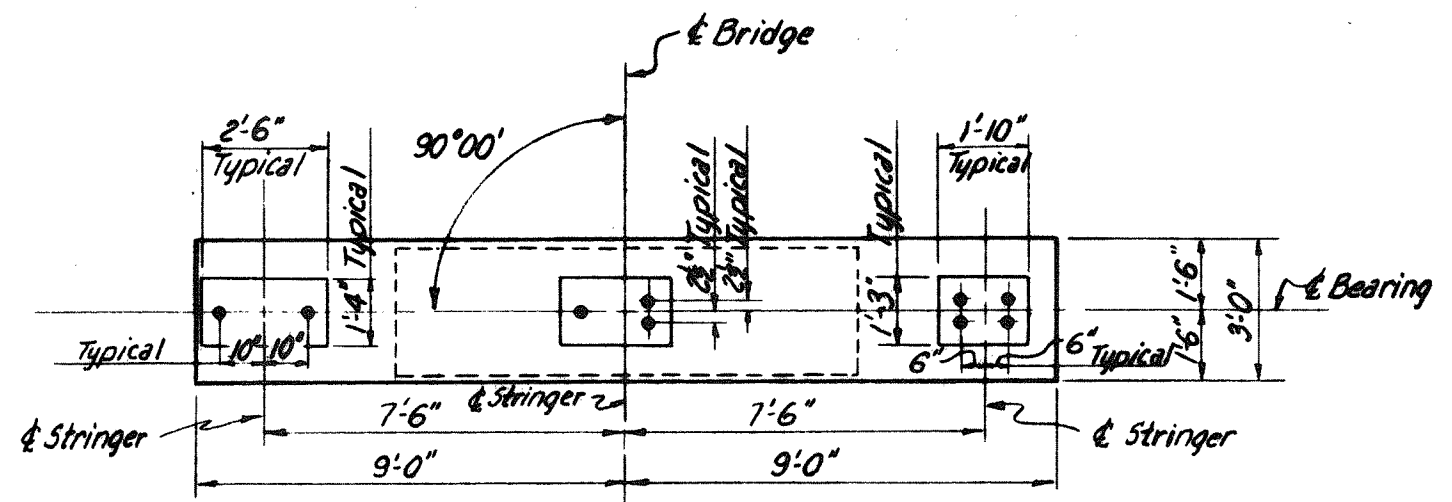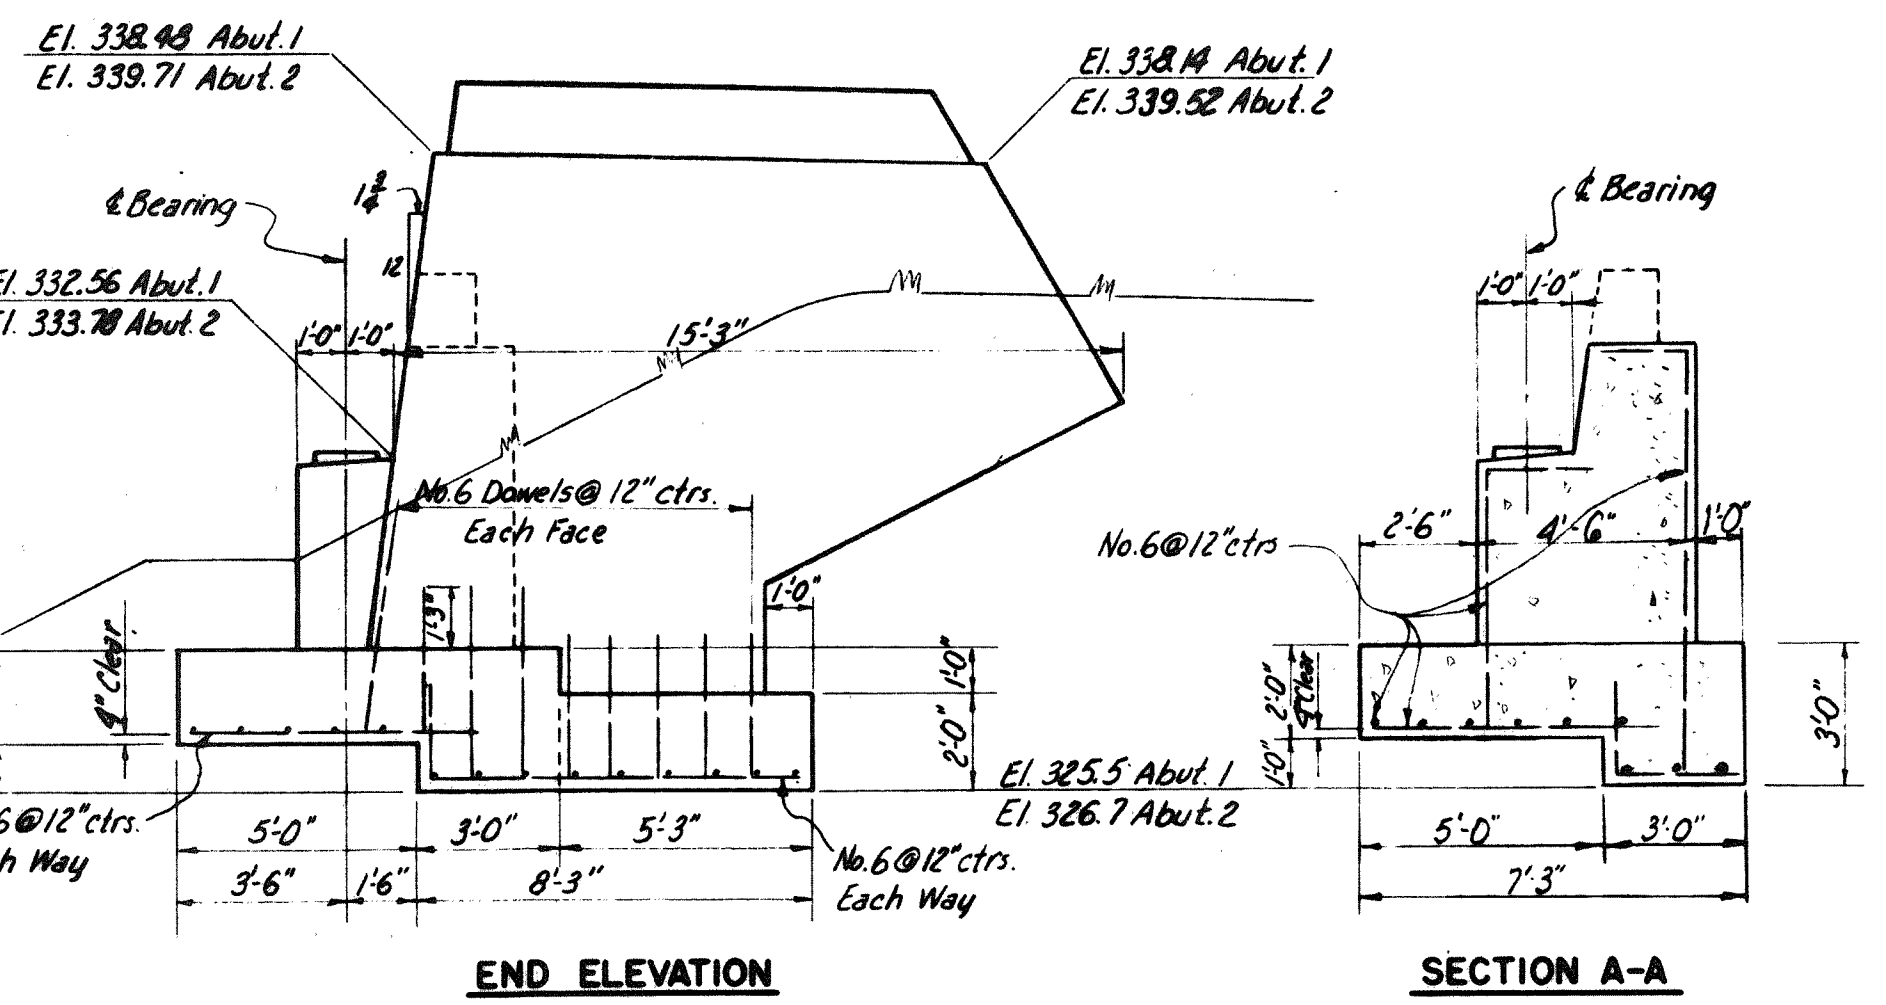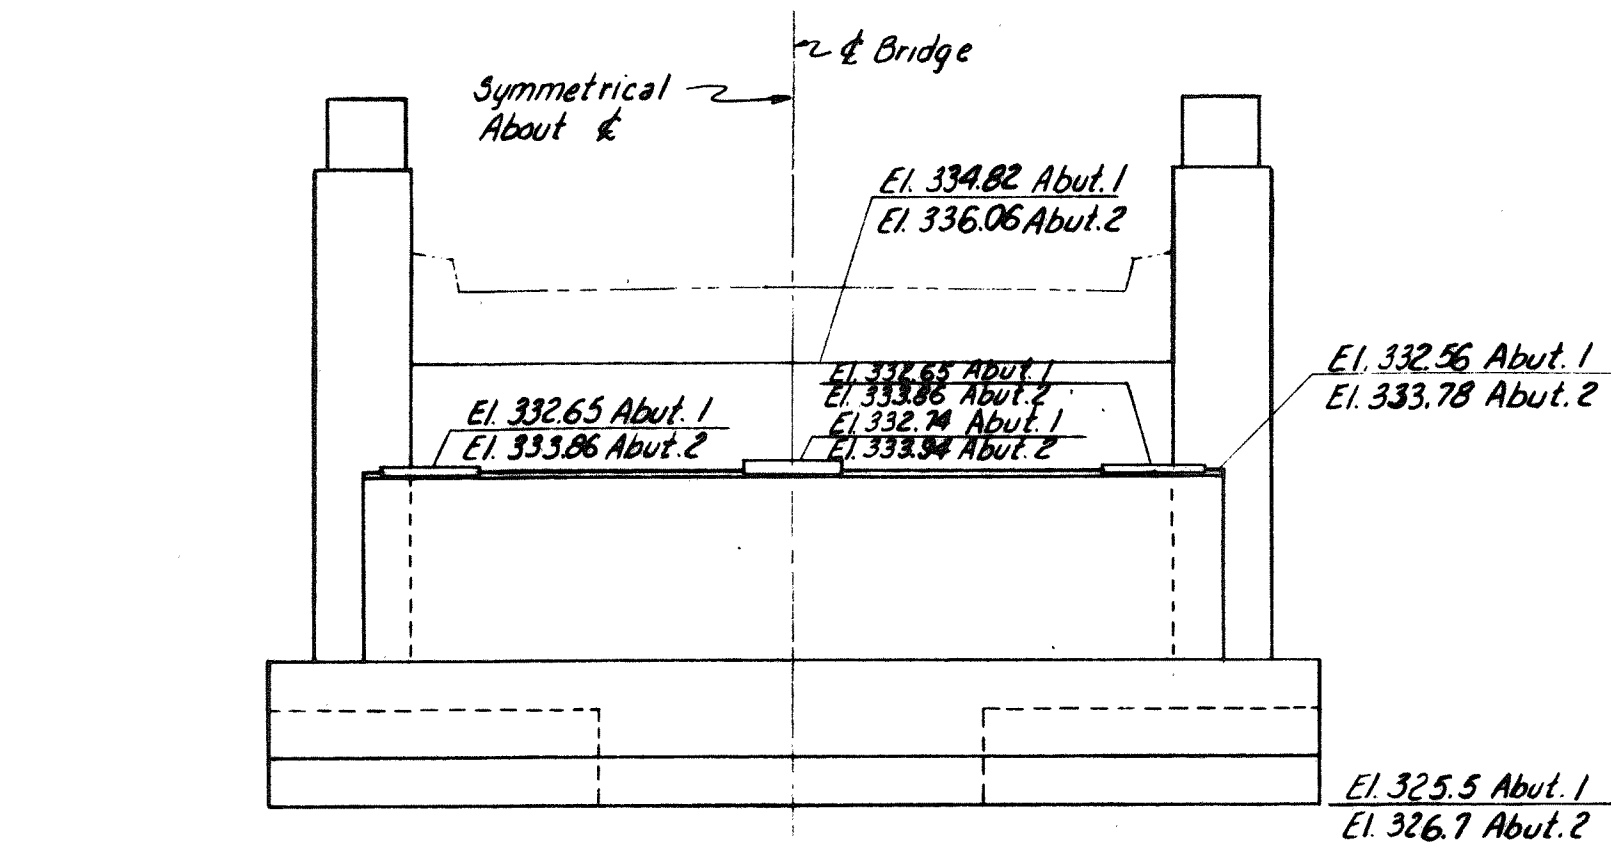

Pier Elevations			
Point	Pier 1	Pier 2	Pier 3
A	333.69	334.34	334.96
B	333.60	334.25	334.27
C	333.58	334.23	334.25


DRAWING 44.02.03

BY	DATE	REVISION	BY	DATE
MADE	HUG	11-10-53		
TRACED		2	As-Built	HSH 11-18-56
CHECKED	TKC	12-1-53	1	Added clear distance to Abut. footing rebar
IN CHARGE OF	IDSK			

ABUTMENTS NO. 1 AND 2


PIERS NO. 1, 2, AND 3

MAINE TURNPIKE AUTHORITY
MAINE TURNPIKE
 SECTION 2— PORTLAND TO AUGUSTA
 STRUCTURE NO. 44 TURNPIKE UNDER
BENNETT ROAD
 STA. 3460+50.40
ABUTMENTS AND PIERS
 HOWARD, NEEDLES, TAMMEN & BERGENDOFF
 CONSULTING ENGINEERS
 NEW YORK KANSAS CITY
 SCALE: 1/4" = 1'-0"
 CONTRACT NO. _____
 SHEET NO. 123 OF 382

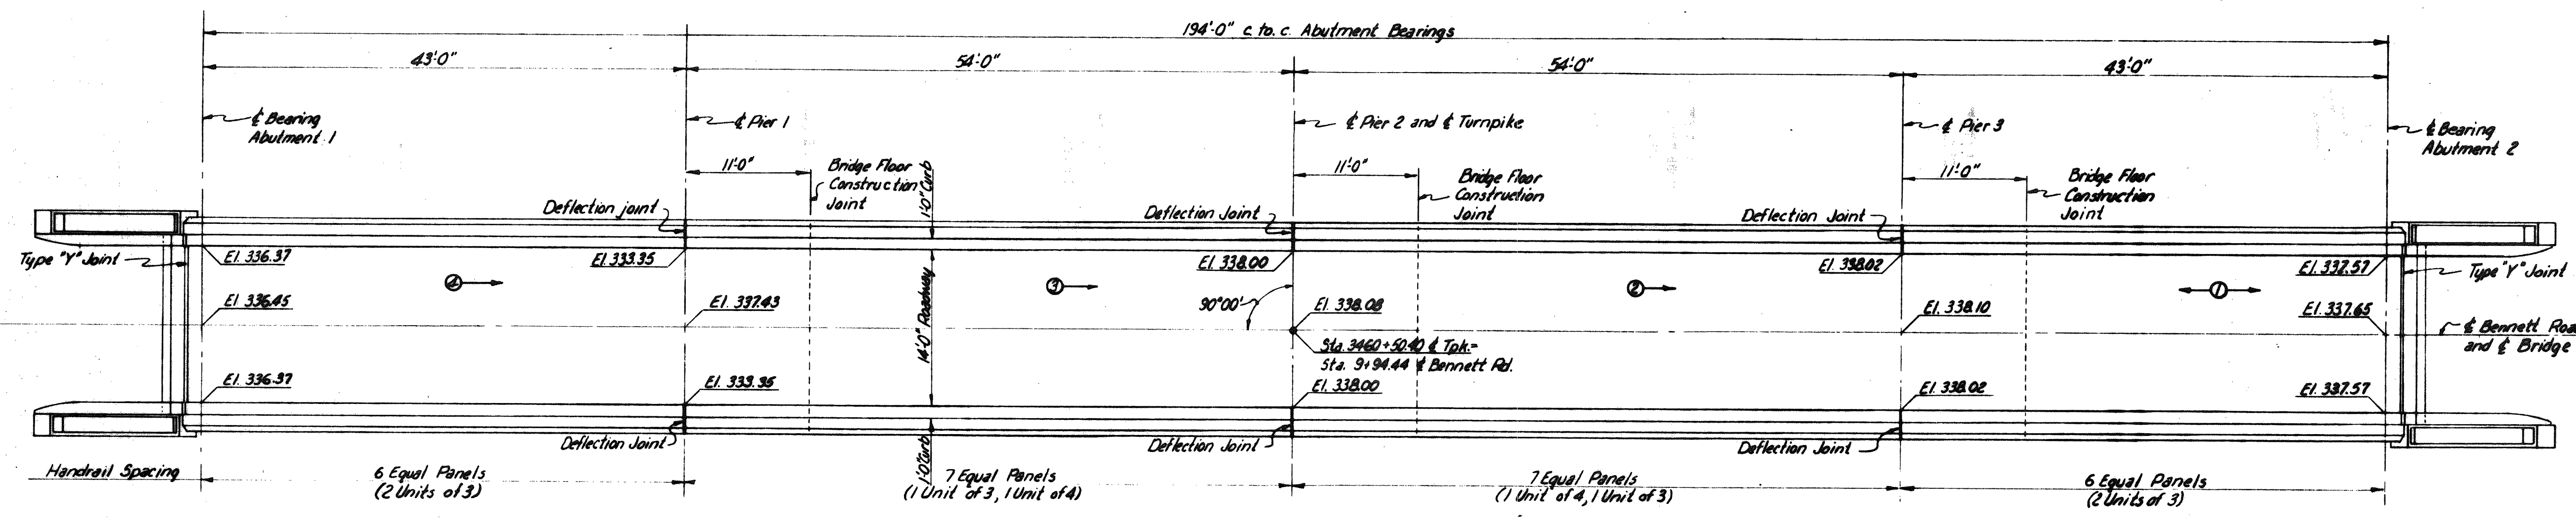


PLAN Scale: 1/4" = 1'-0"

Note: Elevations shown are to top of Bridge Floor. Concrete placing sequence and direction noted Thus ⊙ Use 7" bridge floor (non-composite design) as shown on Standard Det. No. 13.

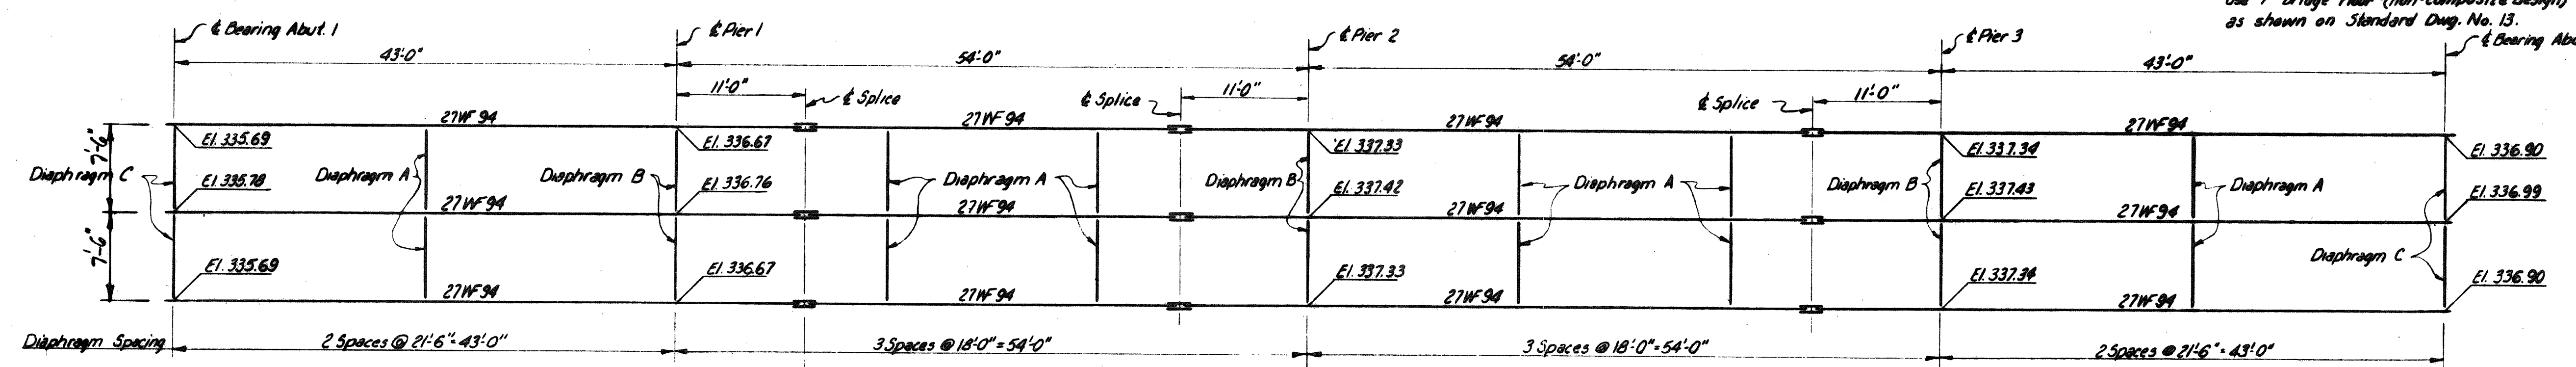


FRAMING PLAN Scale: 1/4" = 1'-0"

Note: Elevations shown are to top of stringer flanges in place.

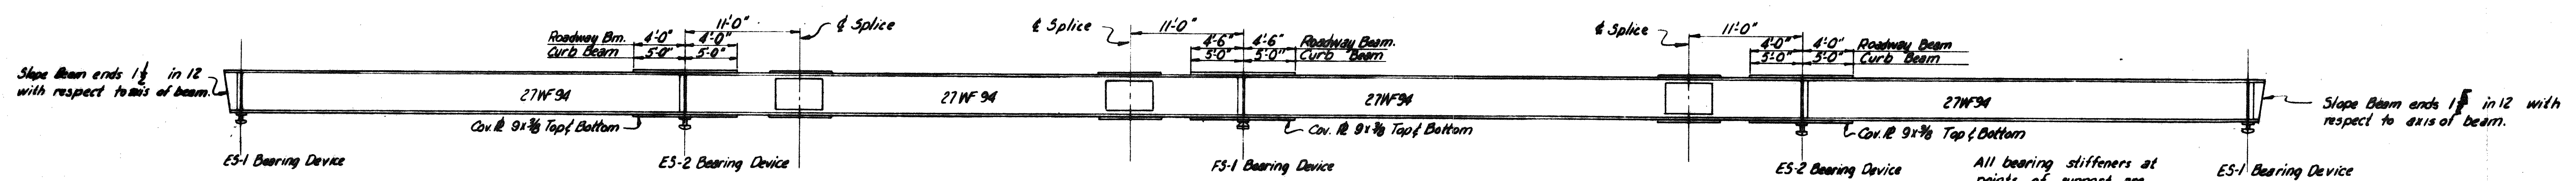

BEAM ELEVATION (No Scale)

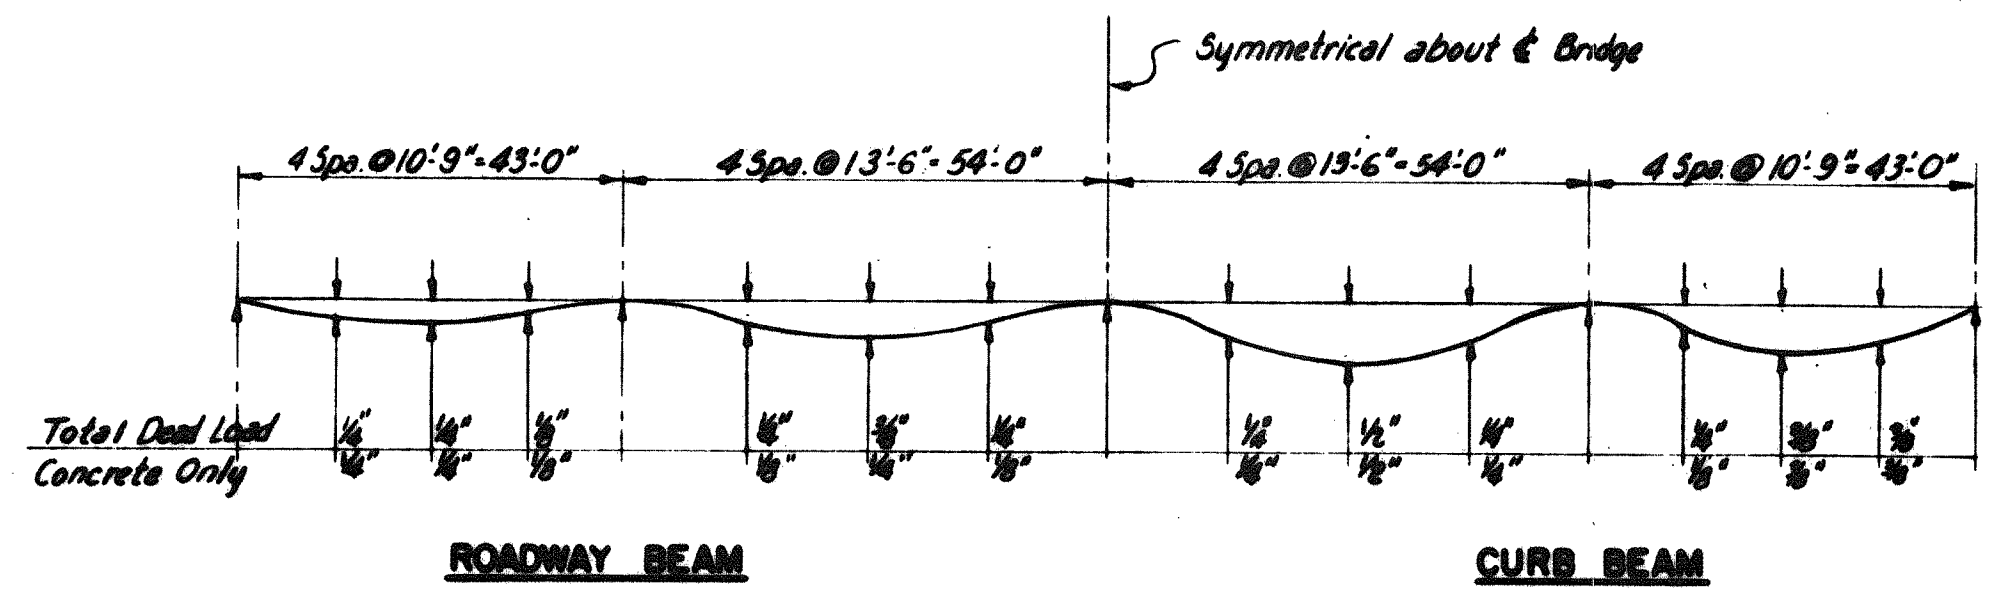

ROADWAY BEAM CURB BEAM DEAD LOAD DEFLECTION DIAGRAM (No Scale)

DRAWING 44.03.03

MADE	BY	DATE			
TRACED	HJG	11-11-53			
CHECKED	TKC	12-2-53	1	As-Built	WBN 1/25/56
IN CHARGE OF	IDSK		No.	REVISION	BY DATE

MAINE TURNPIKE AUTHORITY
MAINE TURNPIKE
 SECTION 2— PORTLAND TO AUGUSTA

STRUCTURE NO. 44 TURNPIKE UNDER
 BENNETT ROAD
 STA. 3460+50.44
 SUPERSTRUCTURE

HOWARD, NEEDLES, TAMMEN & BERGENDOFF CONSULTING ENGINEERS
 NEW YORK KANSAS CITY

SCALE: As Shown
 CONTRACT NO. _____
 SHEET NO. 22 of 32

MAINE TURNPIKE AUTHORITY

MAINE TURNPIKE

, CHAIRMAN
ROBERT K. PACIOS, VICE CHAIRMAN
ABRAHAM LEIBOWITZ, MEMBER
SAMUEL L. COHEN, MEMBER
DANA F. CONNORS, MEMBER EX-OFFICIO

DAVID H. STEVENS, SECRETARY & TREASURER

CONTRACT 86.3

BENNETT ROAD BRIDGE REPLACEMENT

NEW GLOUCESTER

HOWARD, NEEDLES, TAMMEN & BERGENDOFF
ENGINEERS · ARCHITECTS · PLANNERS

BOSTON


Carl J. Mellea



INDEX OF SHEETS

1	TITLE SHEET
2	ESTIMATED QUANTITIES, GENERAL NOTES & TYPICAL SECTION
3-5	STANDARD SHEETS-NOT ISSUED
6, 7	PLAN AND PROFILE BENNETT ROAD
8-17	BRIDGE PLANS
18-23	CROSS SECTIONS

TOTAL SHEETS - 20

STATE OF MAINE
DEPARTMENT OF TRANSPORTATION

COMMISSIONER

BUREAU DIRECTOR AND CHIEF ENGINEER

DATE


APPROVED:

MAINE TURNPIKE AUTHORITY

CHAIRMAN

EXECUTIVE DIRECTOR

DATE _____

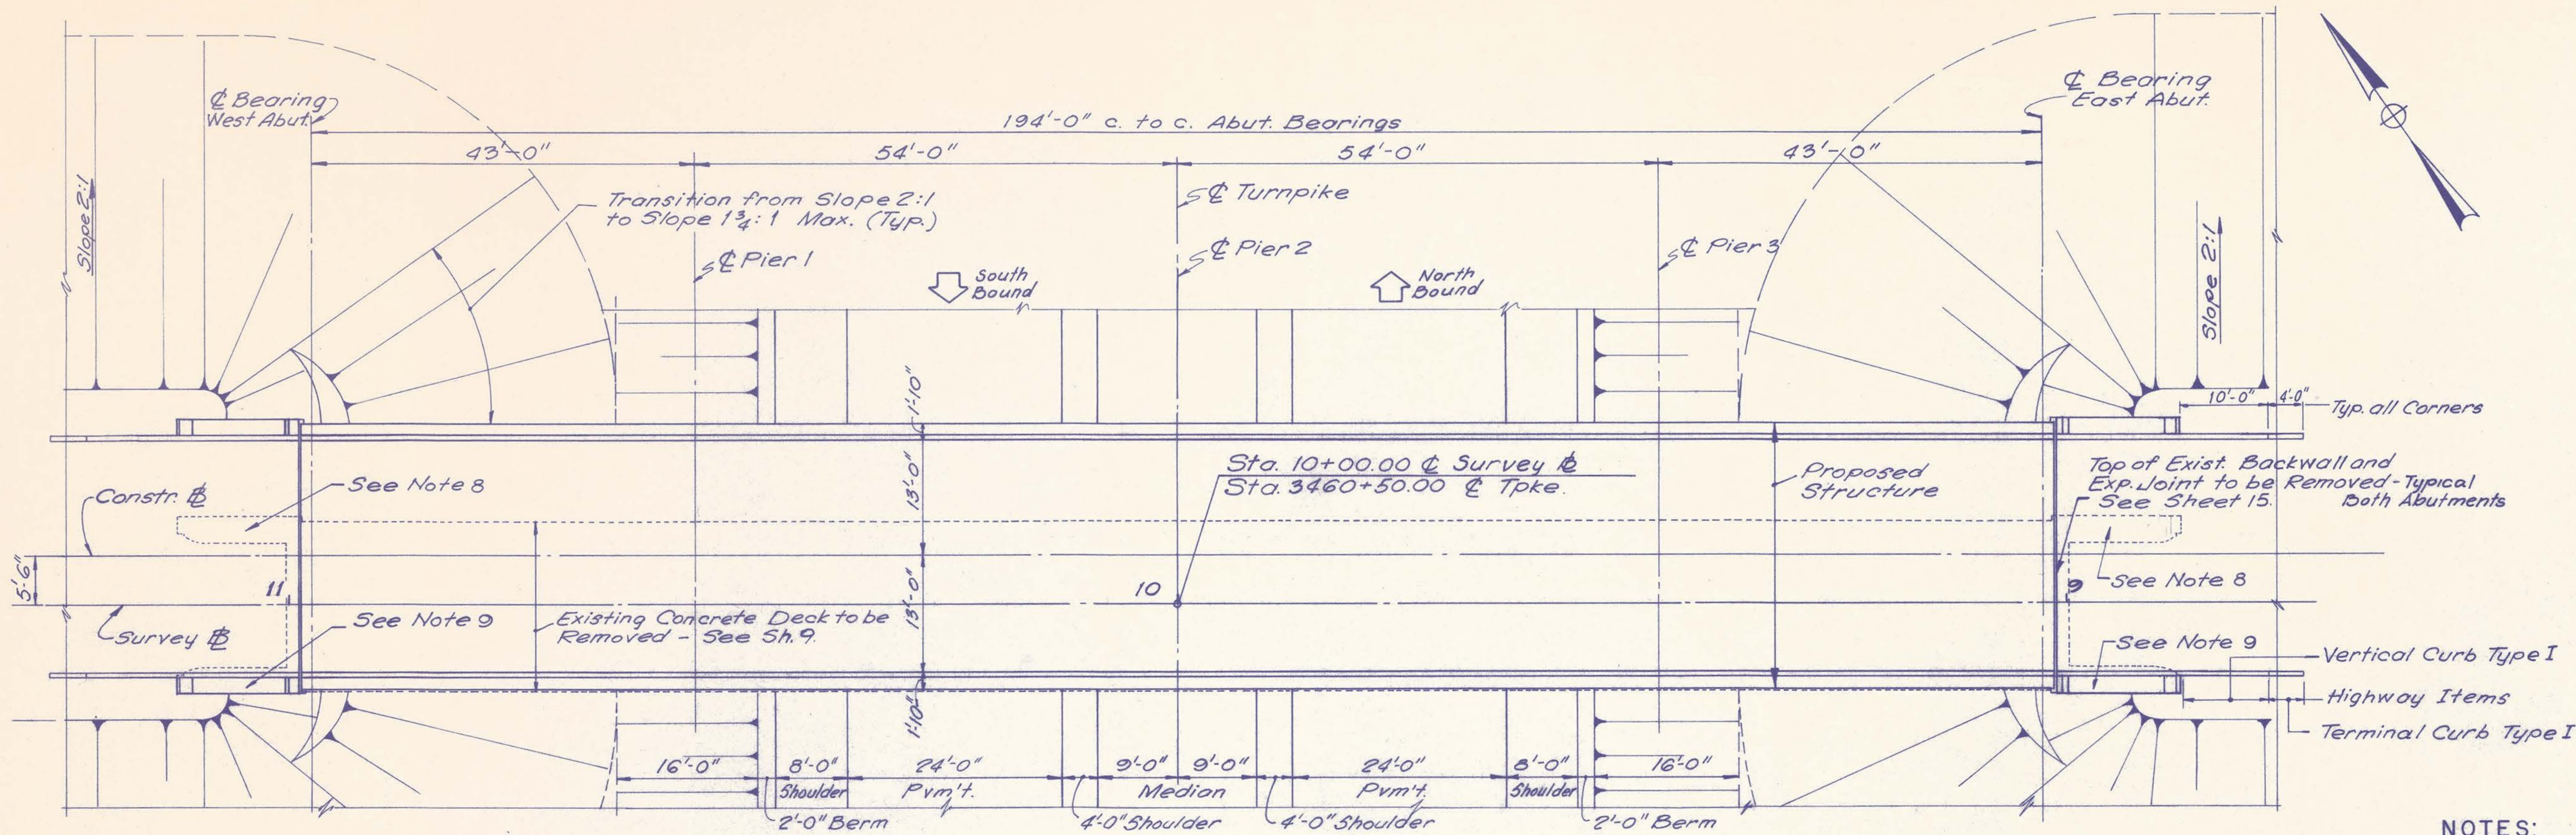

DESIGN
 AASHTO Standard Specifications
 For Highway Bridges 1983 with All
 Interims.

CONTRACT
 State of Maine, Department of
 Transportation, Standard
 Specifications, Highways & Bridges,
 Revision of January 1984.

LIVE LOAD
 H15

MATERIALS

CONCRETE
 All Concrete Shall be Class A
 $f_c = 1,200$ P.S.I., $n=9$

REINFORCING STEEL
 ASTM A615 Grade 60
 $f_b = 24,000$ P.S.I.

STRUCTURAL STEEL
 ASTM A36 $f_b = 20,000$ P.S.I.

HIGH STRENGTH BOLTS
 ASTM A325

NOTES:

1. Reinforcing Steel to Have a Clear Cover as Shown on the Plans.
2. Chamfer all Exposed Edges 1".
3. Plans of Existing Bridges are Available at the Authority's Office at 430 Riverside St., Portland, Maine.
4. Do not Break the Bond Between the Concrete Surfaces of Vertical Construction Joints in Superstructure Slab. Form a 1" V-Groove on the Outside Faces of Slab at Each Construction Joint. See Note "A" Sh.14.
5. Provide 23 Gauge Galvanized Screen Over 1" Deck Drains, 1/8" Mesh.
6. The Authority's Personnel Will Profile The Tops of All Stringers Before the Form Work is Started and Supply the Contractor with Final Bottom of Slab Elevation.
7. Shielding Required During Concrete Removal Shall not Project Below the Bottom Flanges of Stringers. The Estimated Quantity of Shielding is The Minimum Required and is Based on the Following Limits:
 - a. Normal to ϕ Bridge: as Shown on Plans
 - b. Parallel to ϕ Bridge: Pier 1 to Pier 3.
8. Northwest & Northeast Existing Wingwalls to be Partially Removed - See Sheet 10.
9. Southwest & Southeast Existing Wingwalls to be Modified - See Sheet 10.
10. Place the Concrete in Panels "A" and "B" Before the Expansion Device is Installed. Place the Concrete in Panels "A" Before Pacing in Panels "B". Place the Concrete in Panels "C" Last.

BRIDGE SHEET INDEX	
SHEET No.	TITLE
8	GENERAL PLAN AND ELEVATION
9	QUANTITIES, MISC. DETAILS AND CONSTRUCTION SEQUENCE.
10	ABUTMENTS AND WINGWALLS.
11	PIER AND ABUTMENT DETAILS.
12	FRAMING PLAN.
13	STEEL DETAILS.
14	DECK REINFORCEMENT.
15	EXPANSION DEVICE DETAILS.
16	ALUMINUM BRIDGE RAILING.
17	REINFORCING SCHEDULE.


MAINE TURNPIKE AUTHORITY
MAINE TURNPIKE




BENNETT ROAD BRIDGE REPLACEMENT.
 GENERAL PLAN AND ELEVATION.

HOWARD, NEEDLES, TAMMEN & BERGENDOFF ARCHITECTS ENGINEERS PLANNERS
 BOSTON


SCALE: 3/32"=1'-0"
 SHEET NO. 8 OF 23

NO.	REVISION	BY	DATE	IN CHARGE OF
		DESIGNED: I.S.	1/86	
		DRAWN: M.S.B.	1/86	
		CHECKED: I.S.	3/86	
		BY DATE		JPW

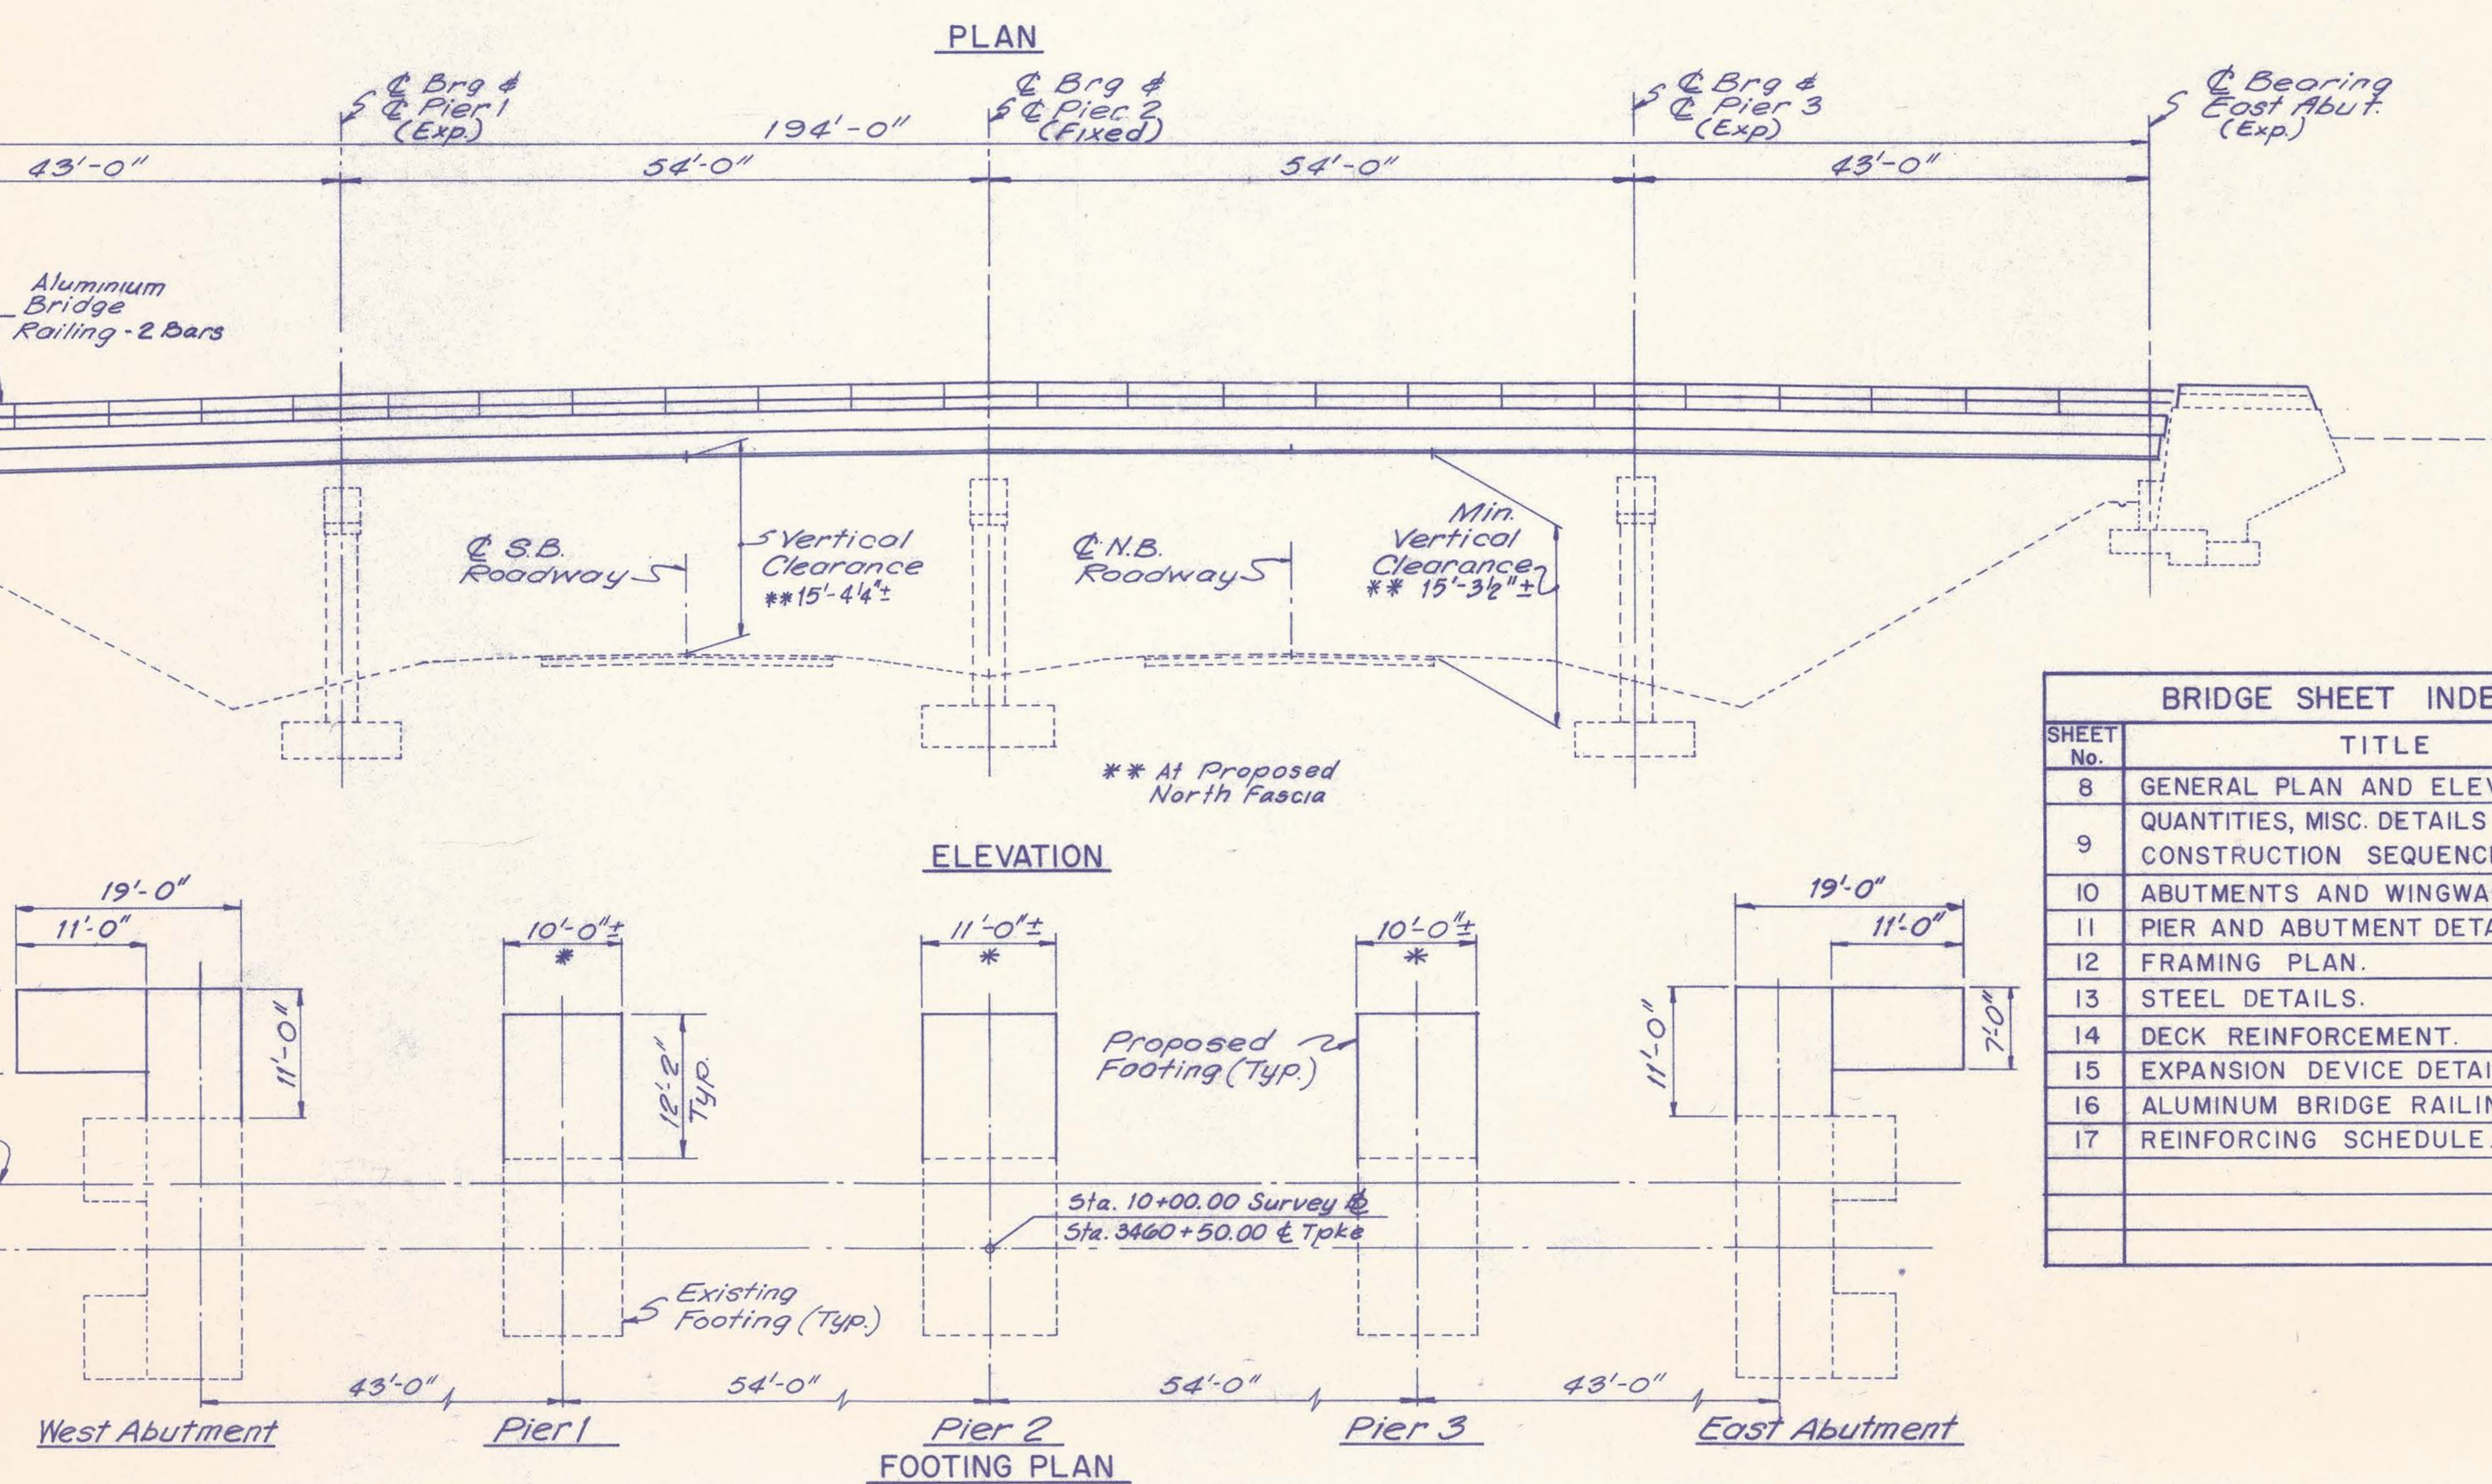


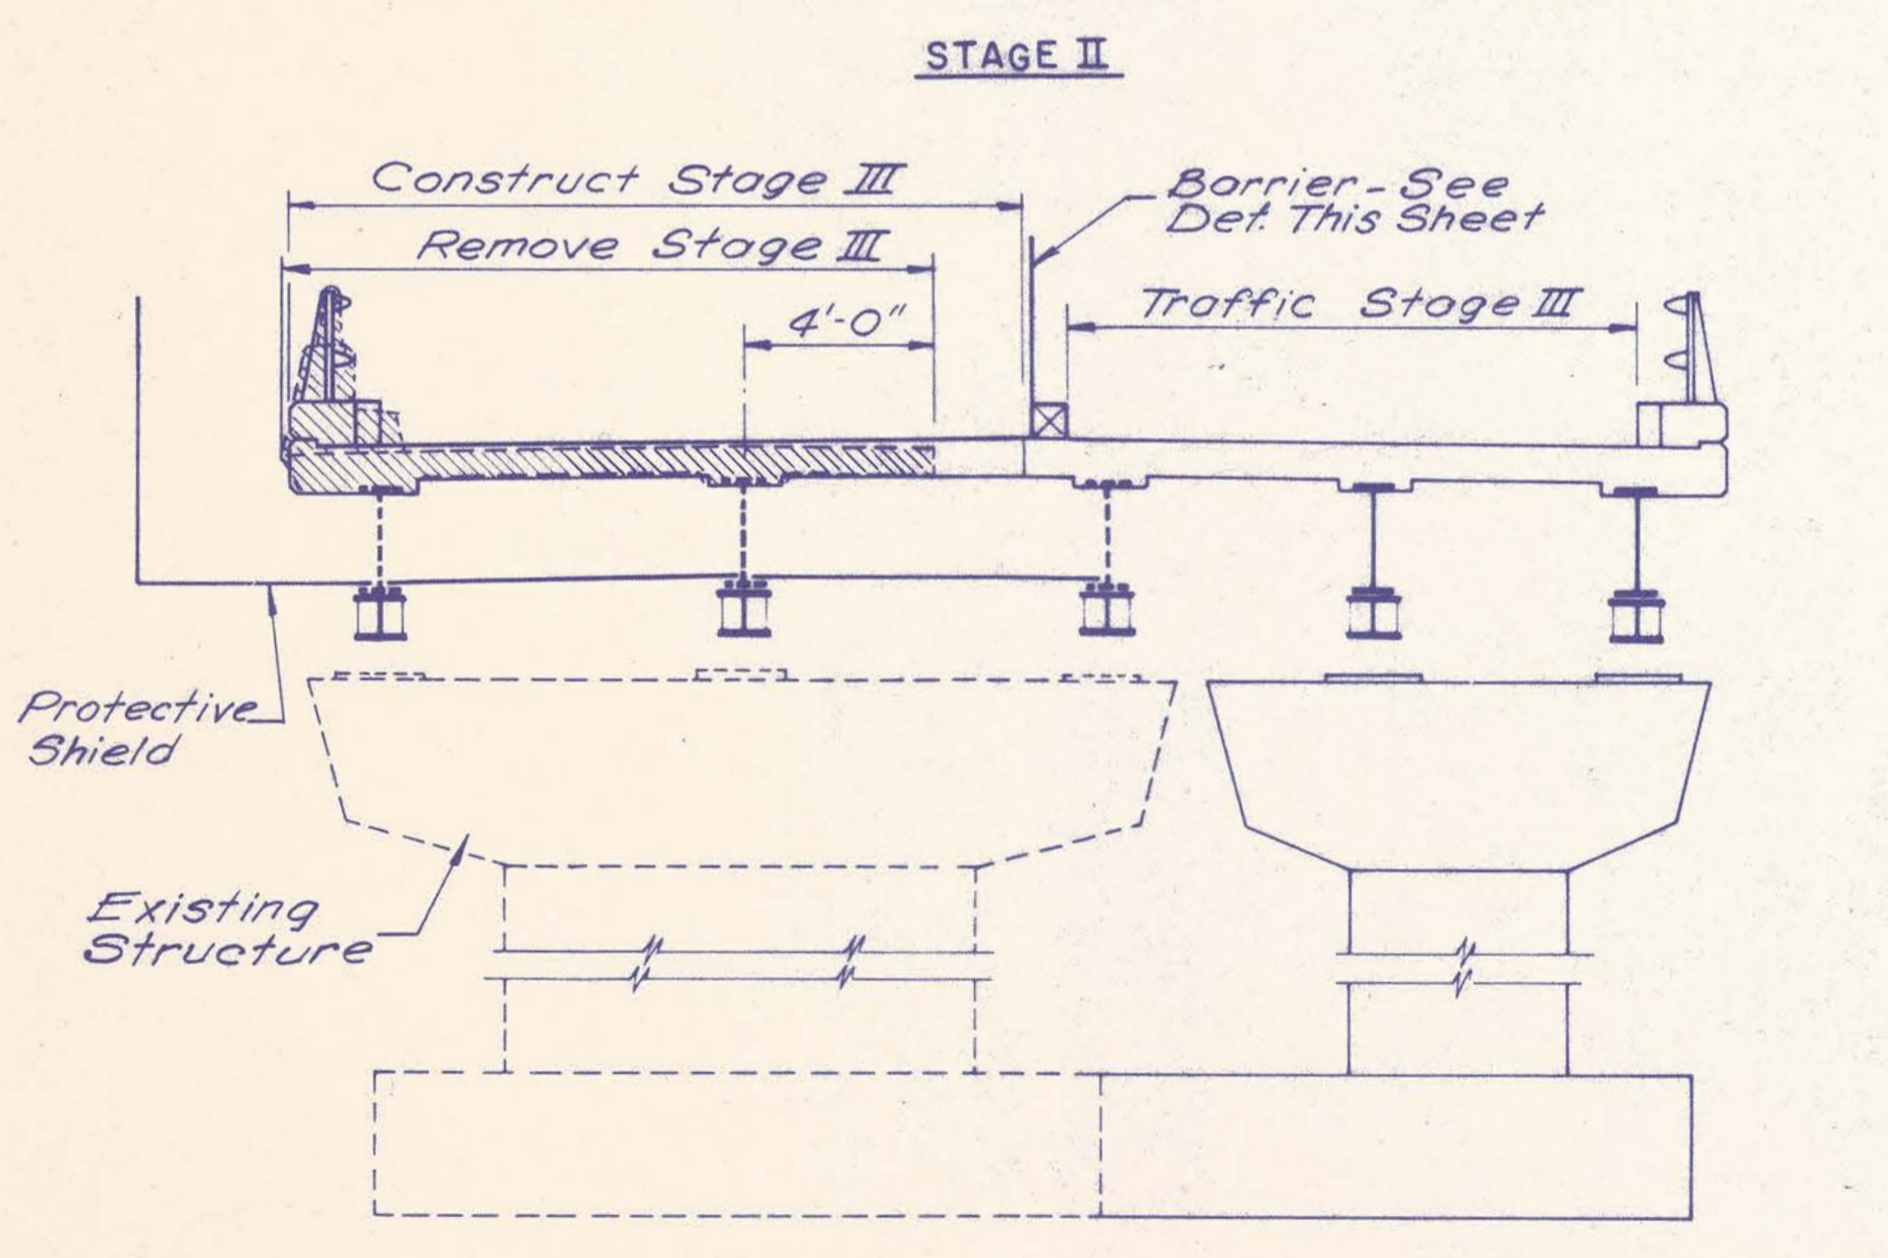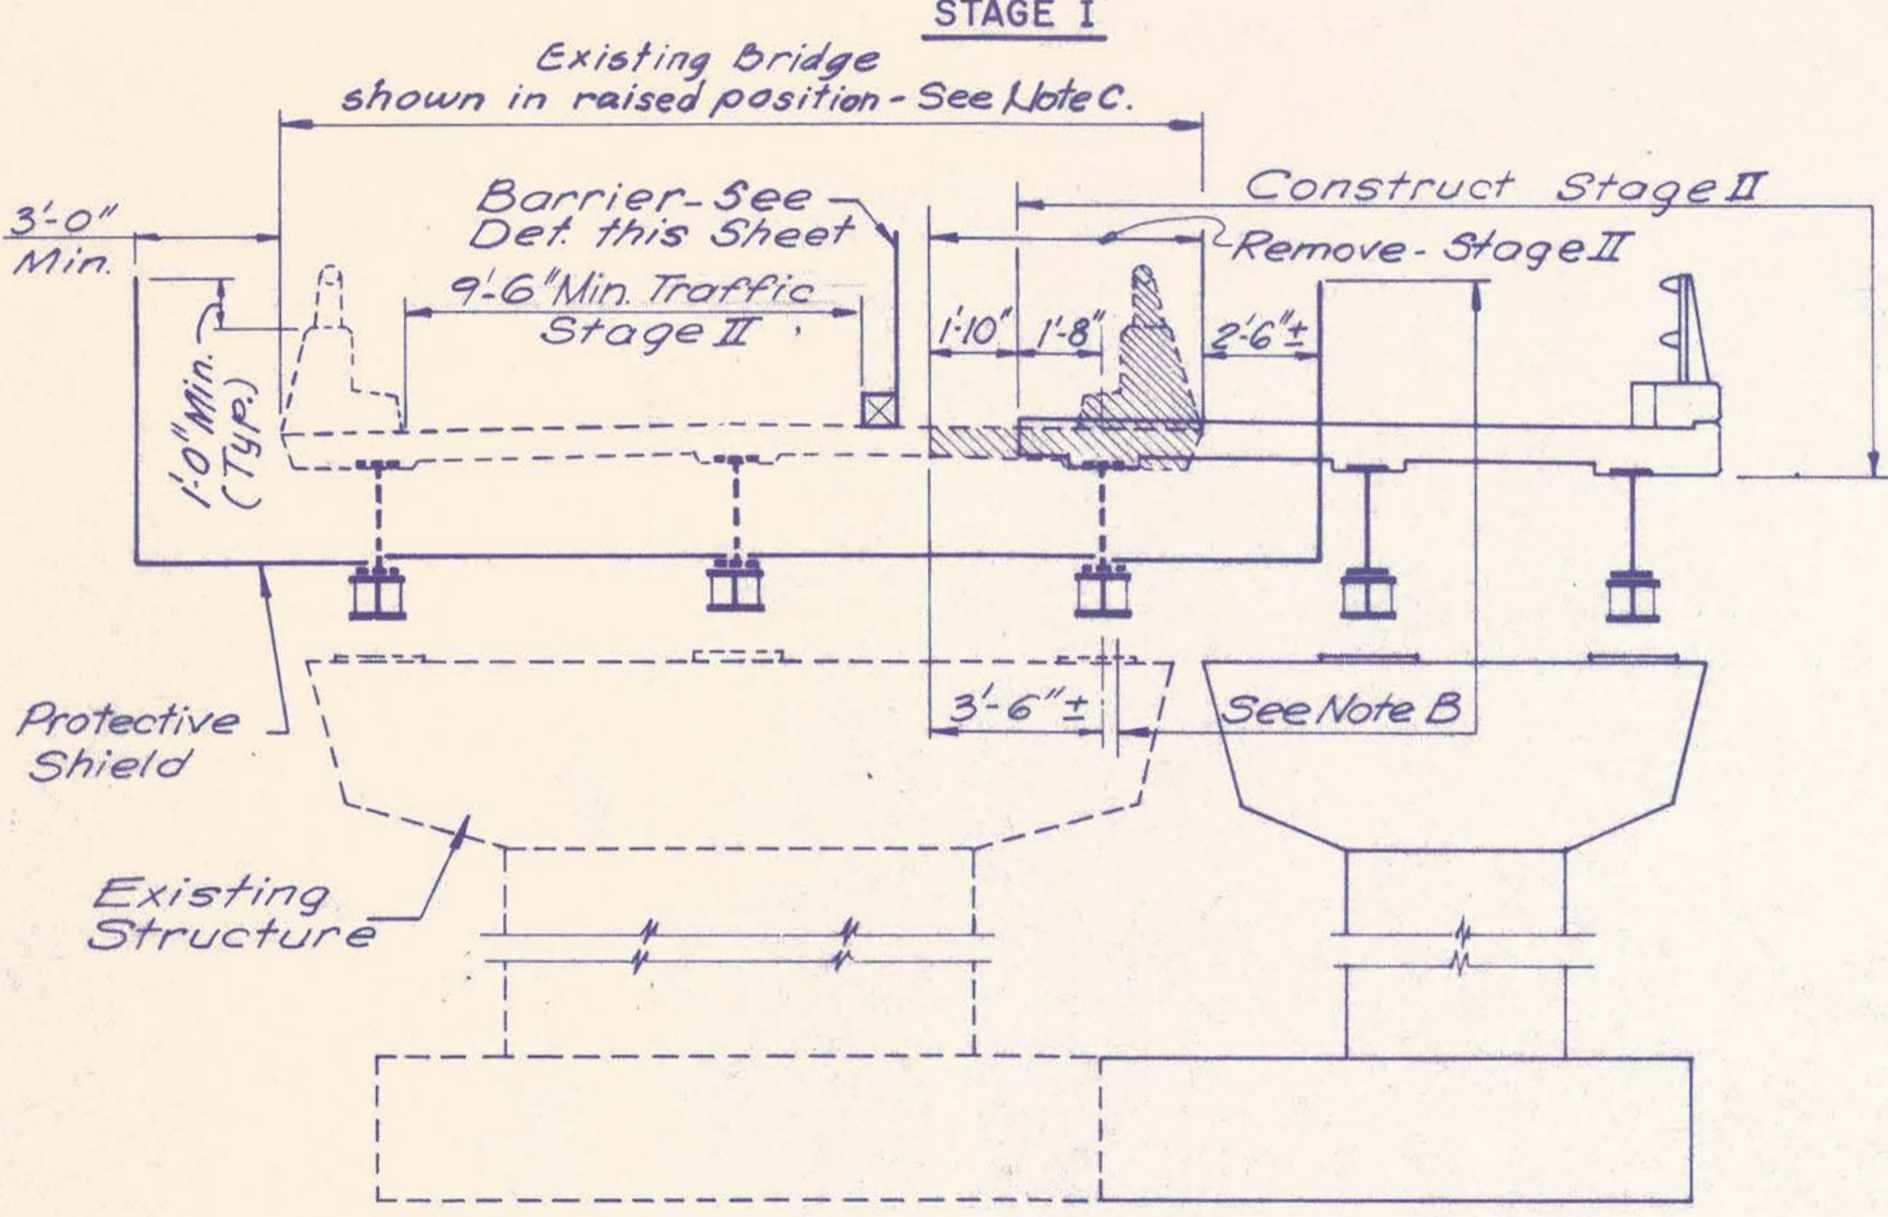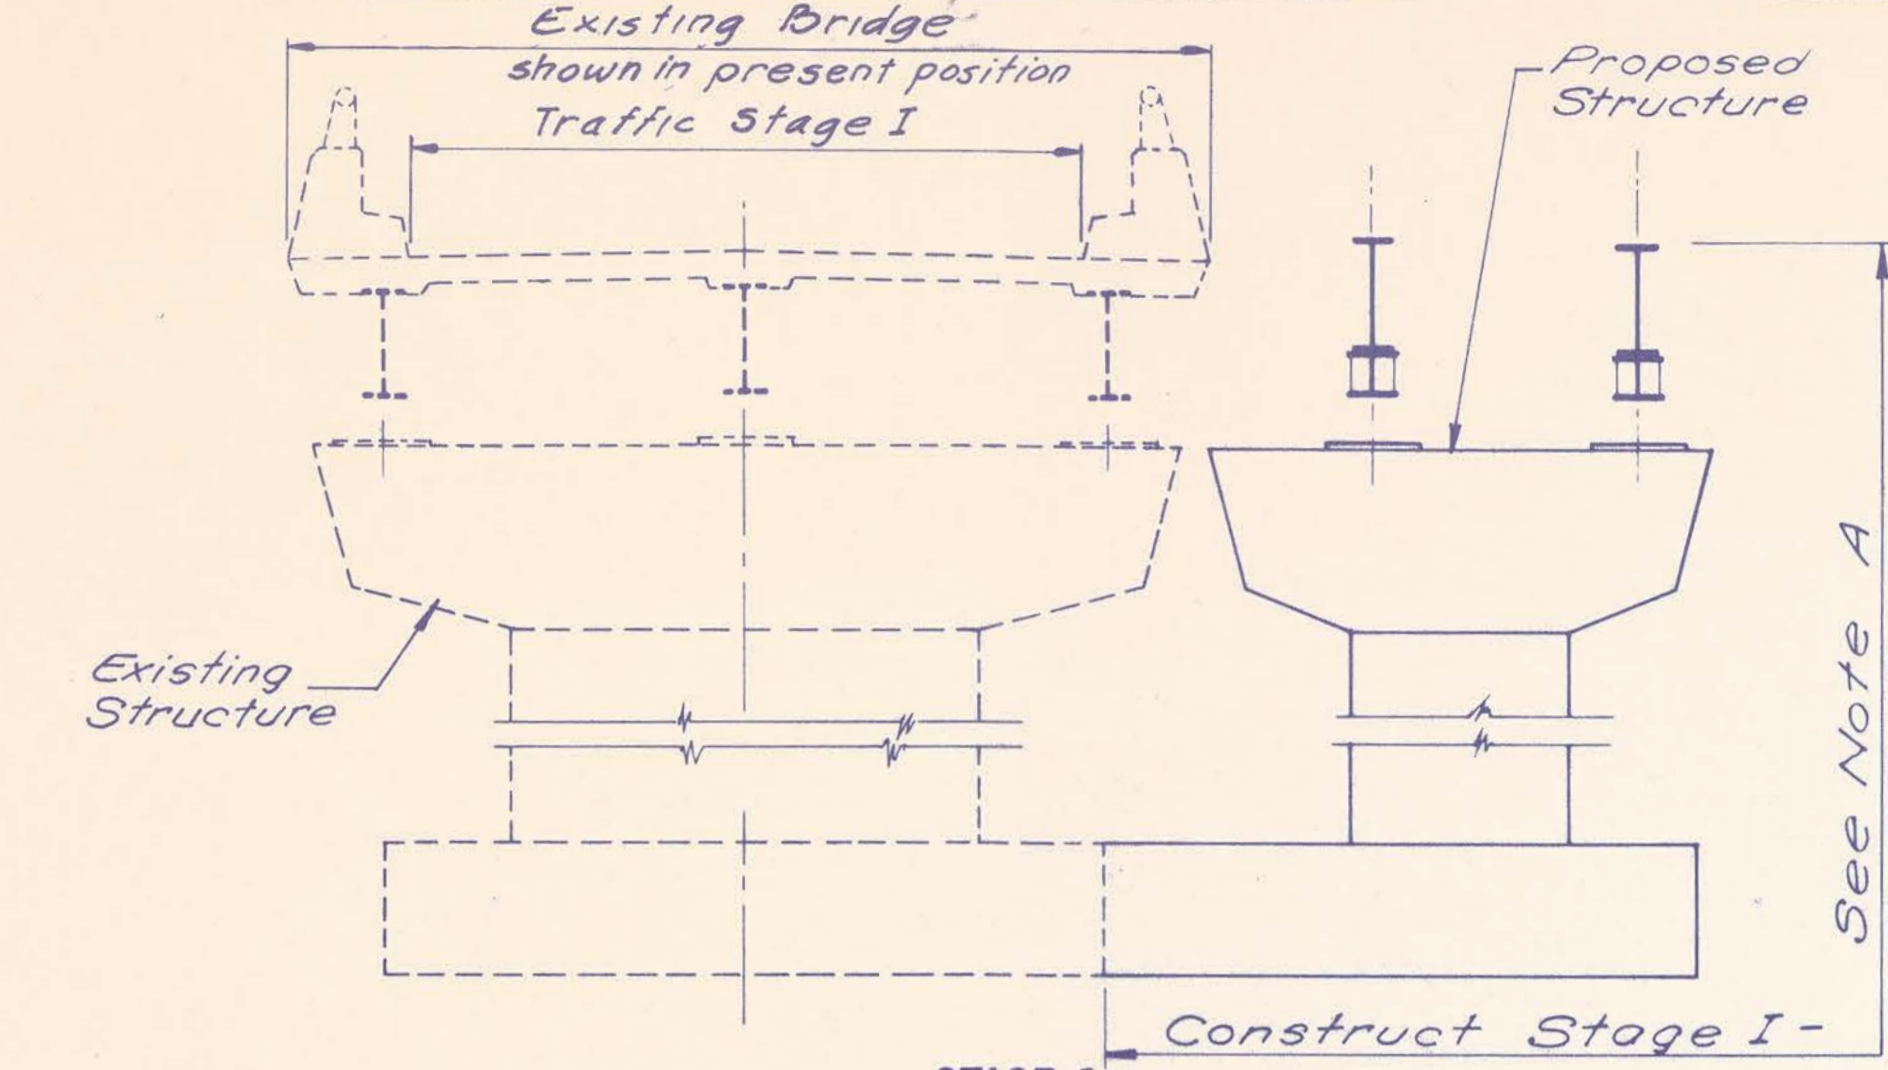


STAGE III
SEQUENCE OF CONSTRUCTION
(LOOK WEST)
1/4" = 1'-0"

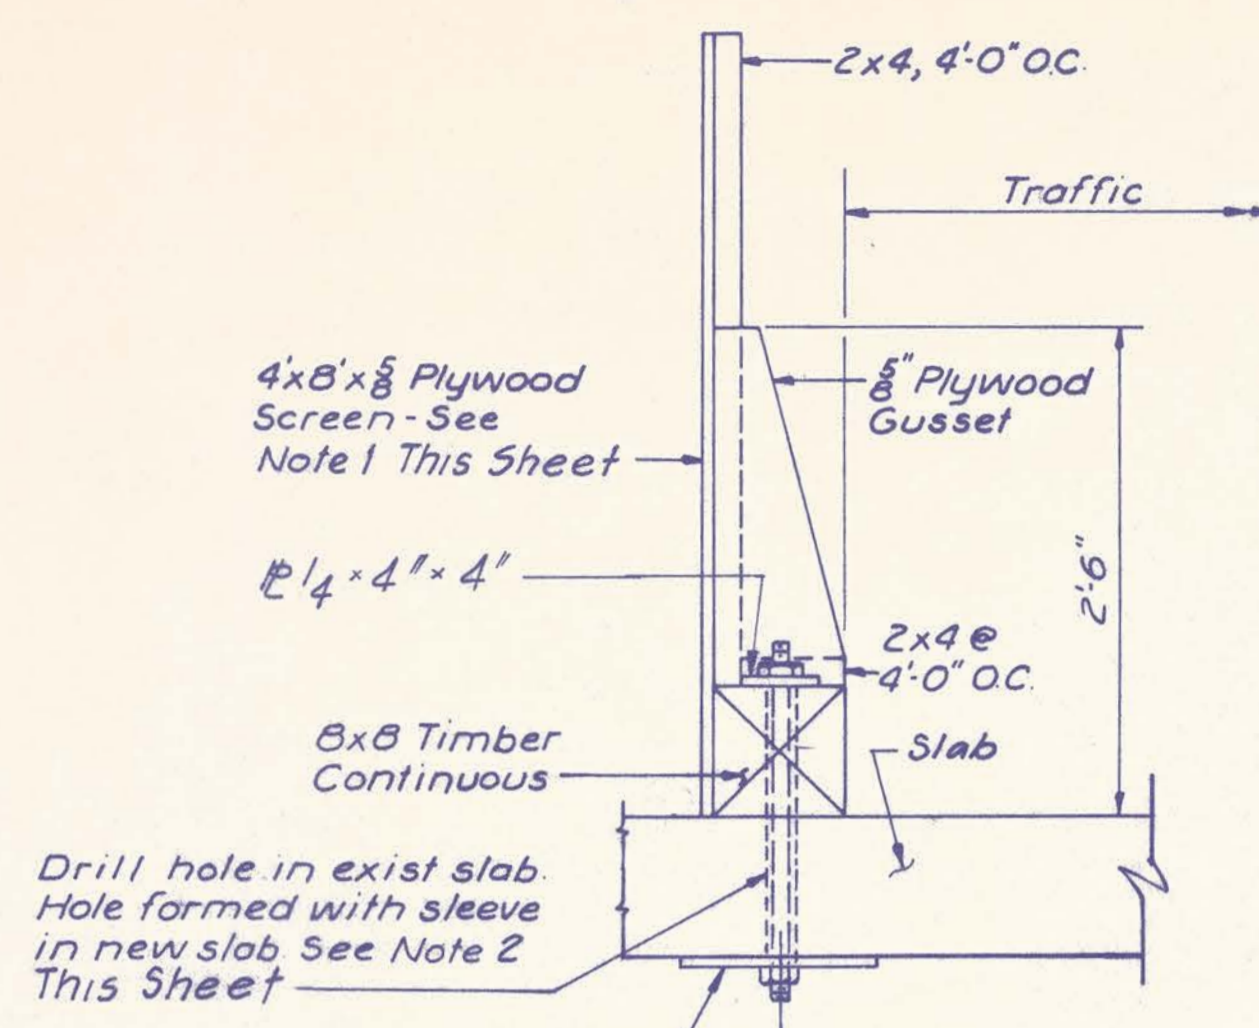


Drill hole in exist slab. Hole formed with sleeve in new slab. See Note 2 This Sheet.
BARRIER DETAILS
1" = 1'-0"

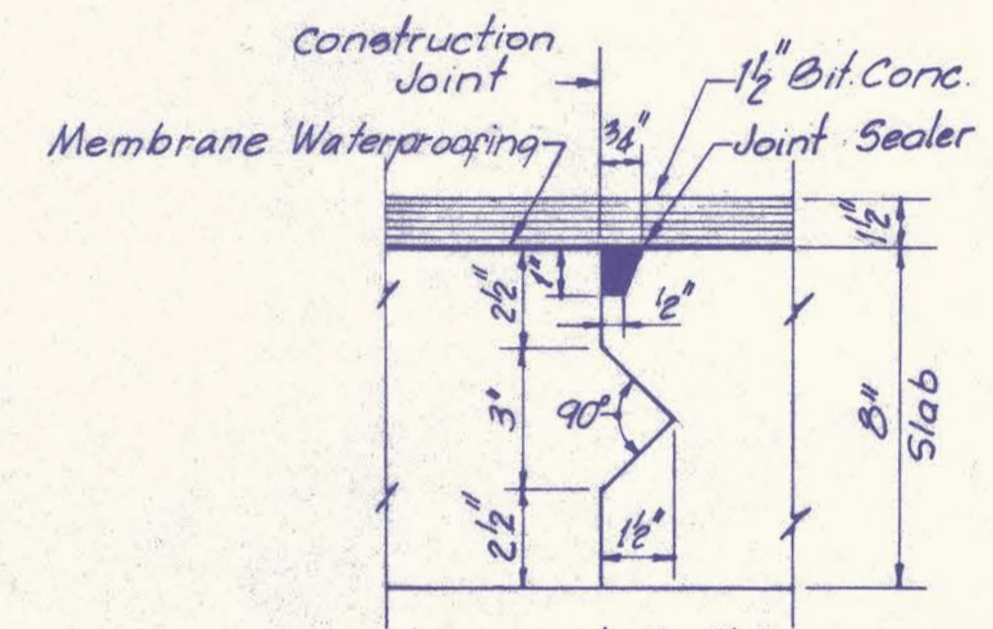

Reinforcement shall be continuous through the joint.
CONSTRUCTION JOINT
DETAIL
3" = 1'-0"

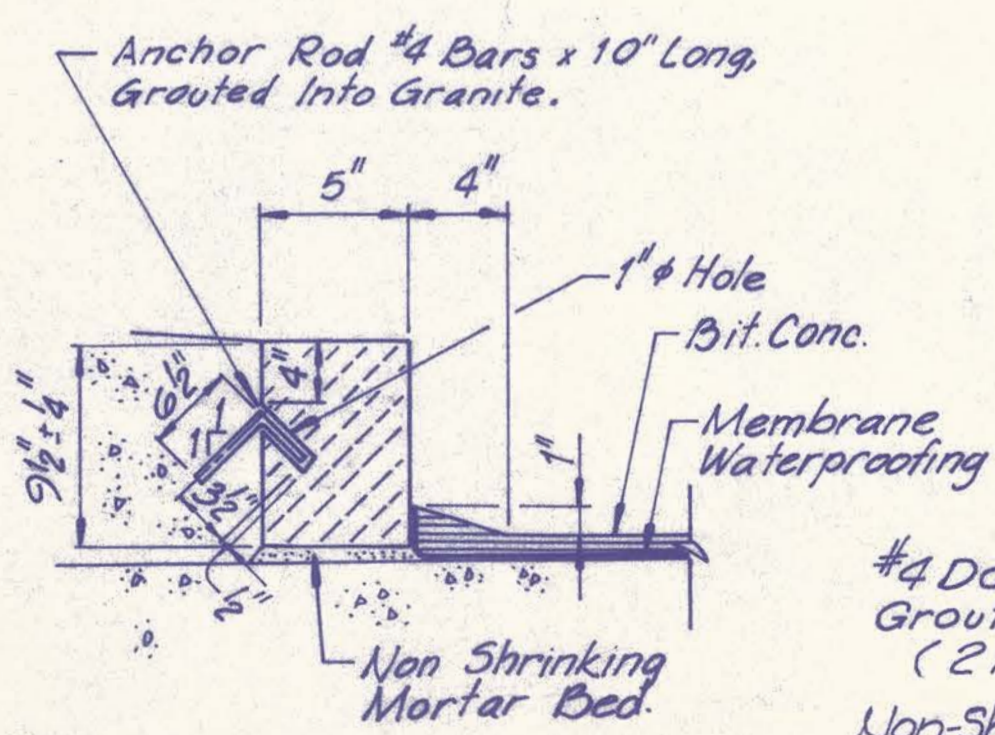


DETAIL A
1/2" = 1'-0"

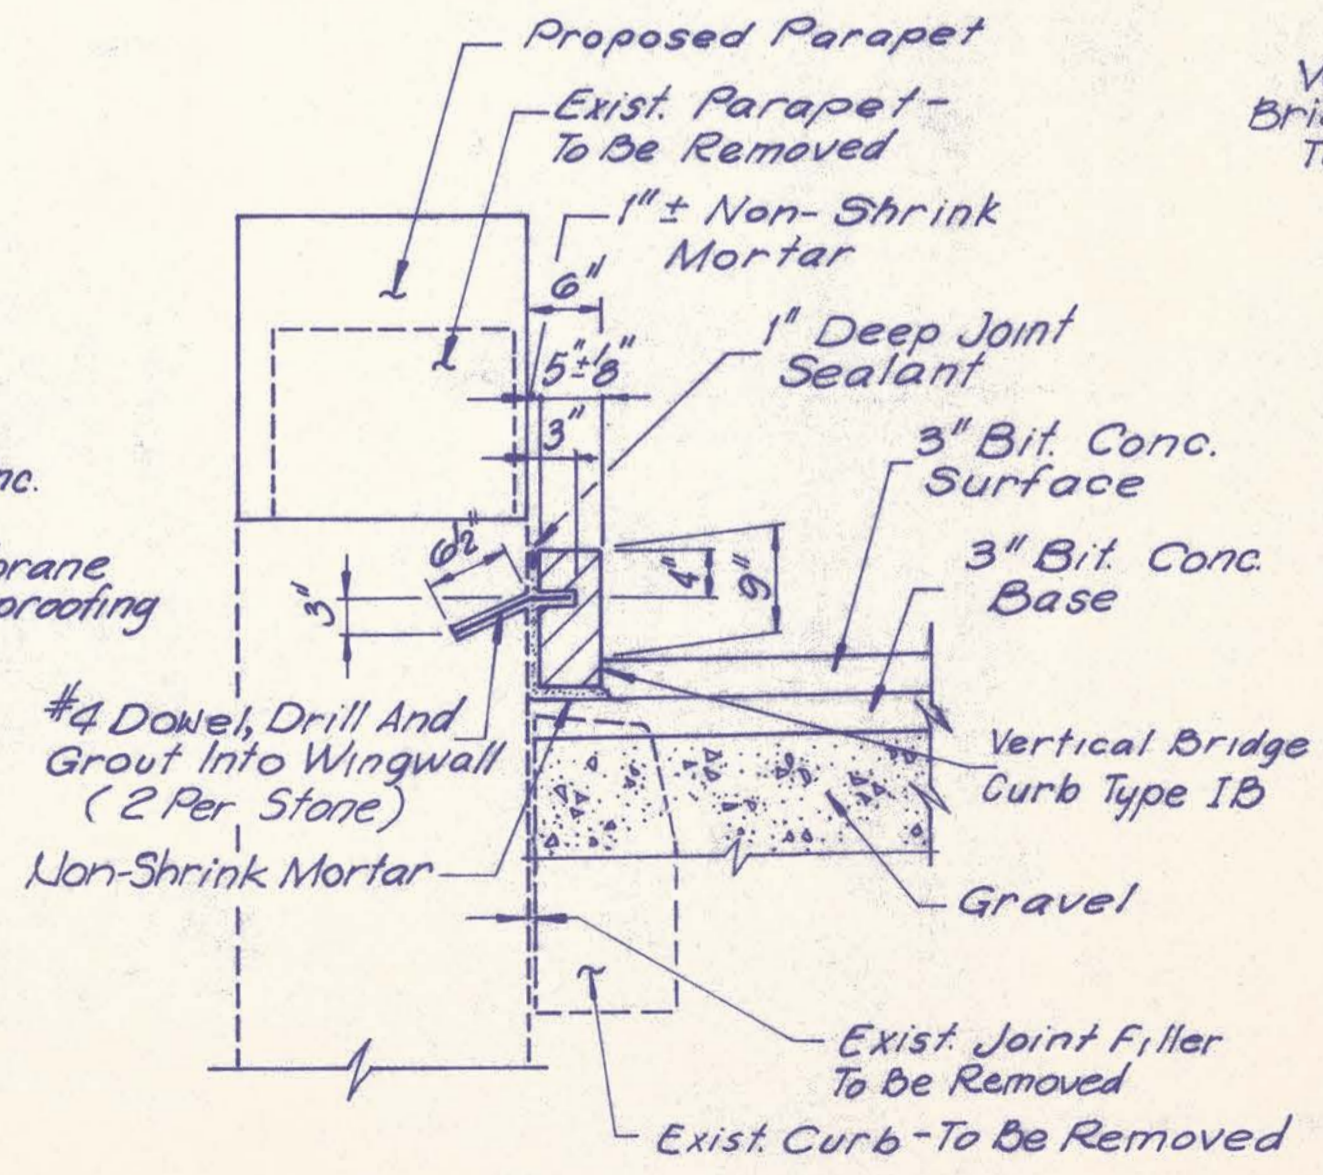




CURB DETAIL AT EXISTING WINGWALL
(SW & SE)

NOTES
A. Construct Abutment Extensions and Wingwalls During Stage I.
B. Protective shield in place during "Remove Stage II". Remove this portion of shield for "Construction Stage II".
C. Install suggested jacking devices, as shown on Sheet 12. Provide bracing as required to maintain the superstructure system in stable condition. Lift superstructure to the required height. (See Special Provisions).

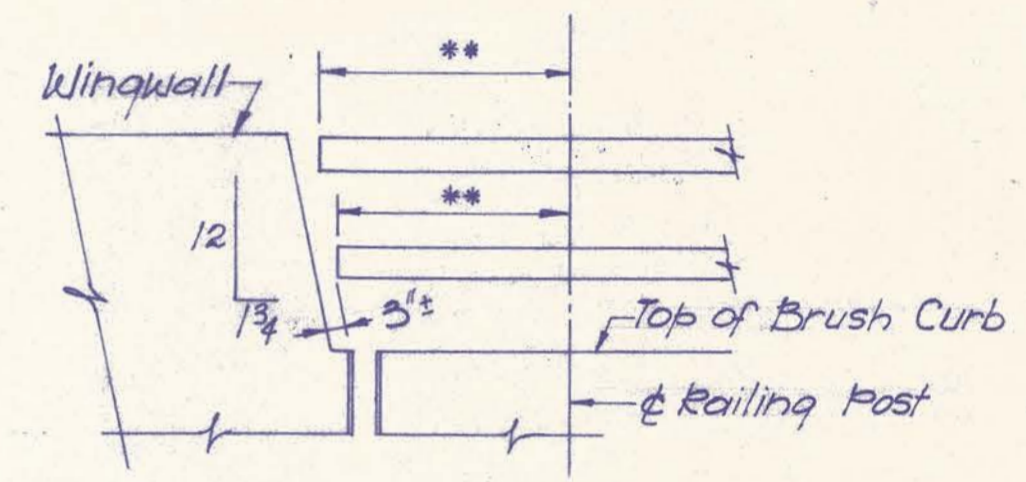

** Determine by Field Measurement Before Fabrication.

RAILING EXTENSION DETAIL
1/2" = 1'-0"

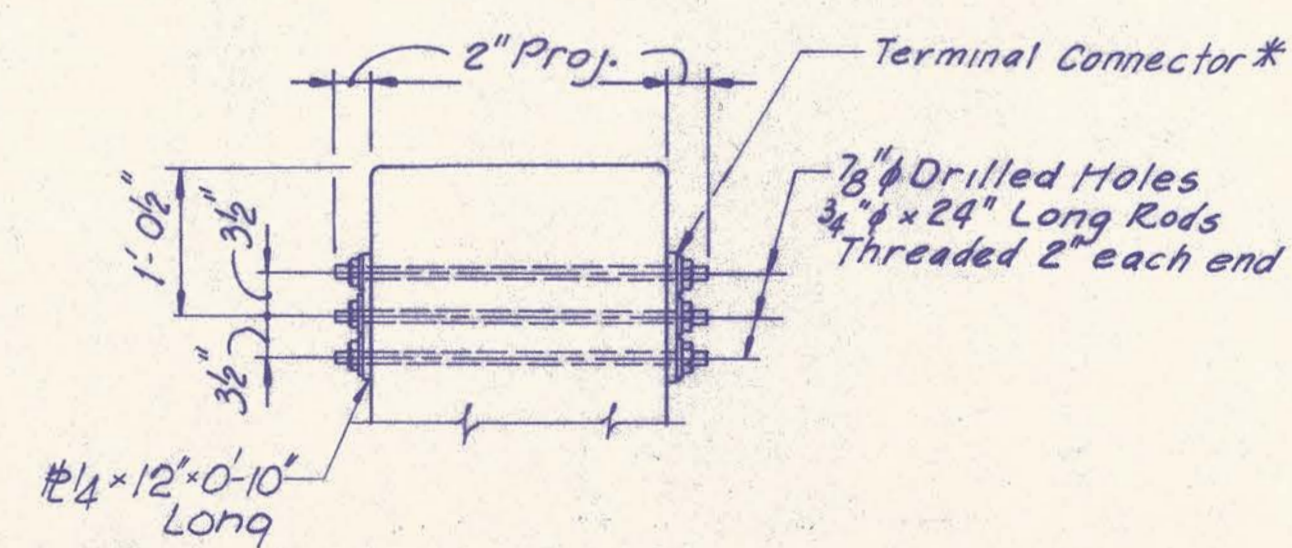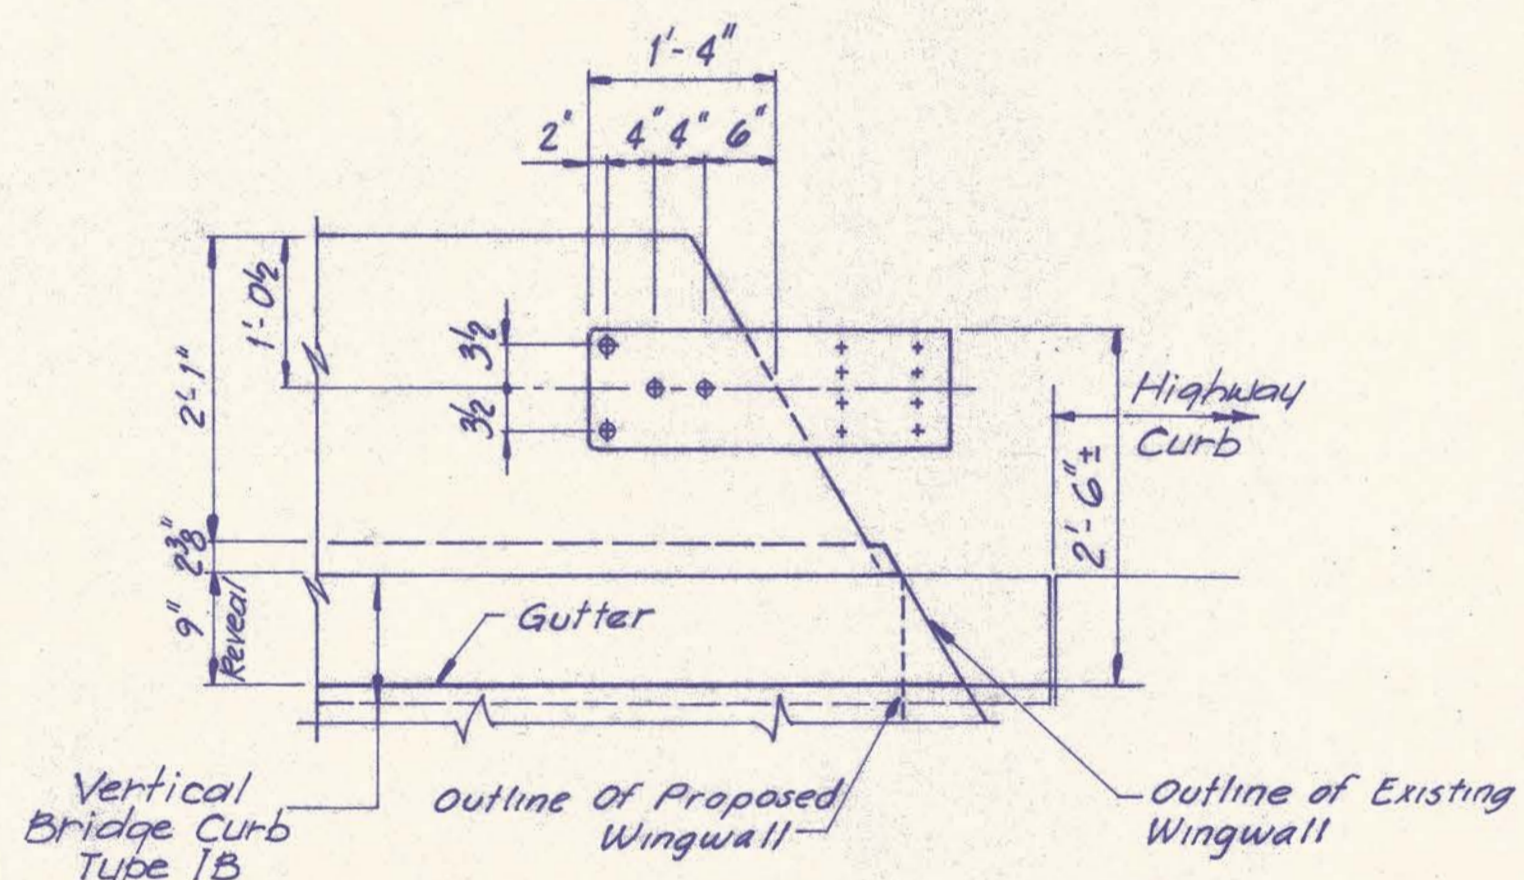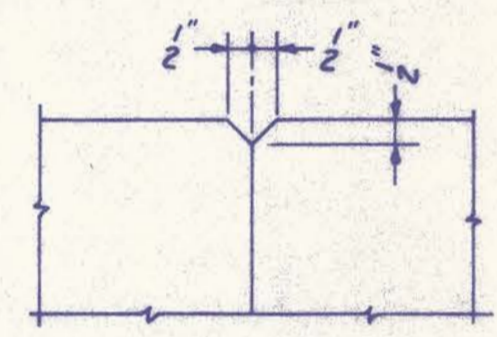

* Place parallel to Approach roadway.

DETAIL @ END OF WINGWALL


ITEM	DESCRIPTION	QUAN.	UNIT
202.12	Removing of Existing Structural Concrete	445	S.Y.
203.26	Gravel Borrow	25	C.Y.
206.081	Structural Earth Excavation - Abutments, Retaining Walls, Box Culverts and Structural Plate Units	100	C.Y.
206.10	Structural Earth Excavation - Piers	170	C.Y.
403.08	Hot Bituminous Pavement - Grading C	50	Ton
502.21	Structural Concrete Abutments and Retaining Walls	70	C.Y.
502.23	Structural Concrete Piers	80	C.Y.
502.26	Structural Concrete Roadway and Sidewalk Slabs on Steel Bridges (175 CY)*	1	L.S.
502.71	Protective Shield	300	S.Y.
503.12	Reinforcing Steel Fabricated and Delivered	62,000	L.B.
503.13	Reinforcing Steel Placing	62,000	L.B.
504.70	Structural Steel Fabricated and Delivered (50,000 Lbs)*	1	L.S.
504.71	Structural Steel Erection (50,000 Lbs)*	1	L.S.
504.72	Jacking Existing Superstructure	1	L.S.
506.141	Field Painting New Structural Steel (25 Tons)*	1	L.S.
506.142	Field Painting Existing Structural Steel (35.3 Tons)*	1	L.S.
507.092	Aluminum Bridge Rolling - 2 Bar	400	L.F.
508.10	Membrane Waterproofing	570	S.Y.
514.06	Curing Box for Concrete Cylinders	1	Each
515.20	Protective Coating for Concrete Surfaces	190	S.Y.
515.22	ThoroSeal Coating for Concrete Surfaces	550	S.F.
520.20	Expansion Device	1	L.S.
609.131	Vertical Bridge Curb - Type IA (5" x 9 1/2")	400	L.F.
609.132	Vertical Bridge Curb - Type IB (5" x 11")	70	L.F.

* Approximate Quantity for Estimating only.

NOTES
1. The entire Traffic side face of the plywood screen shall be painted with yellow traffic paint.
2. Holes in new slab shall be filled with mortar after barrier is removed and before membrane waterproofing is applied.
3. Refer to Part 2, Special Provisions, Article 14, for alternate method of sequence of construction.


MAINE TURNPIKE AUTHORITY
MAINE TURNPIKE
BENNETT ROAD BRIDGE REPLACEMENT
QUANTITIES, MISC.
DETAILS AND CONSTRUCTION SEQUENCE
HOWARD, NEEDLES, TAMMEN & BERGENDOFF ARCHITECTS ENGINEERS PLANNERS BOSTON
SCALE: AS NOTED
SHEET NO. 9 OF 23

NO.	REVISION	BY	DATE	IN CHARGE OF
		DESIGNED: J.S.	1/86	
		DRAWN: M.S.B.	2/86	
		CHECKED: J.S.	3/86	
		BY	DATE	IN CHARGE OF JPW

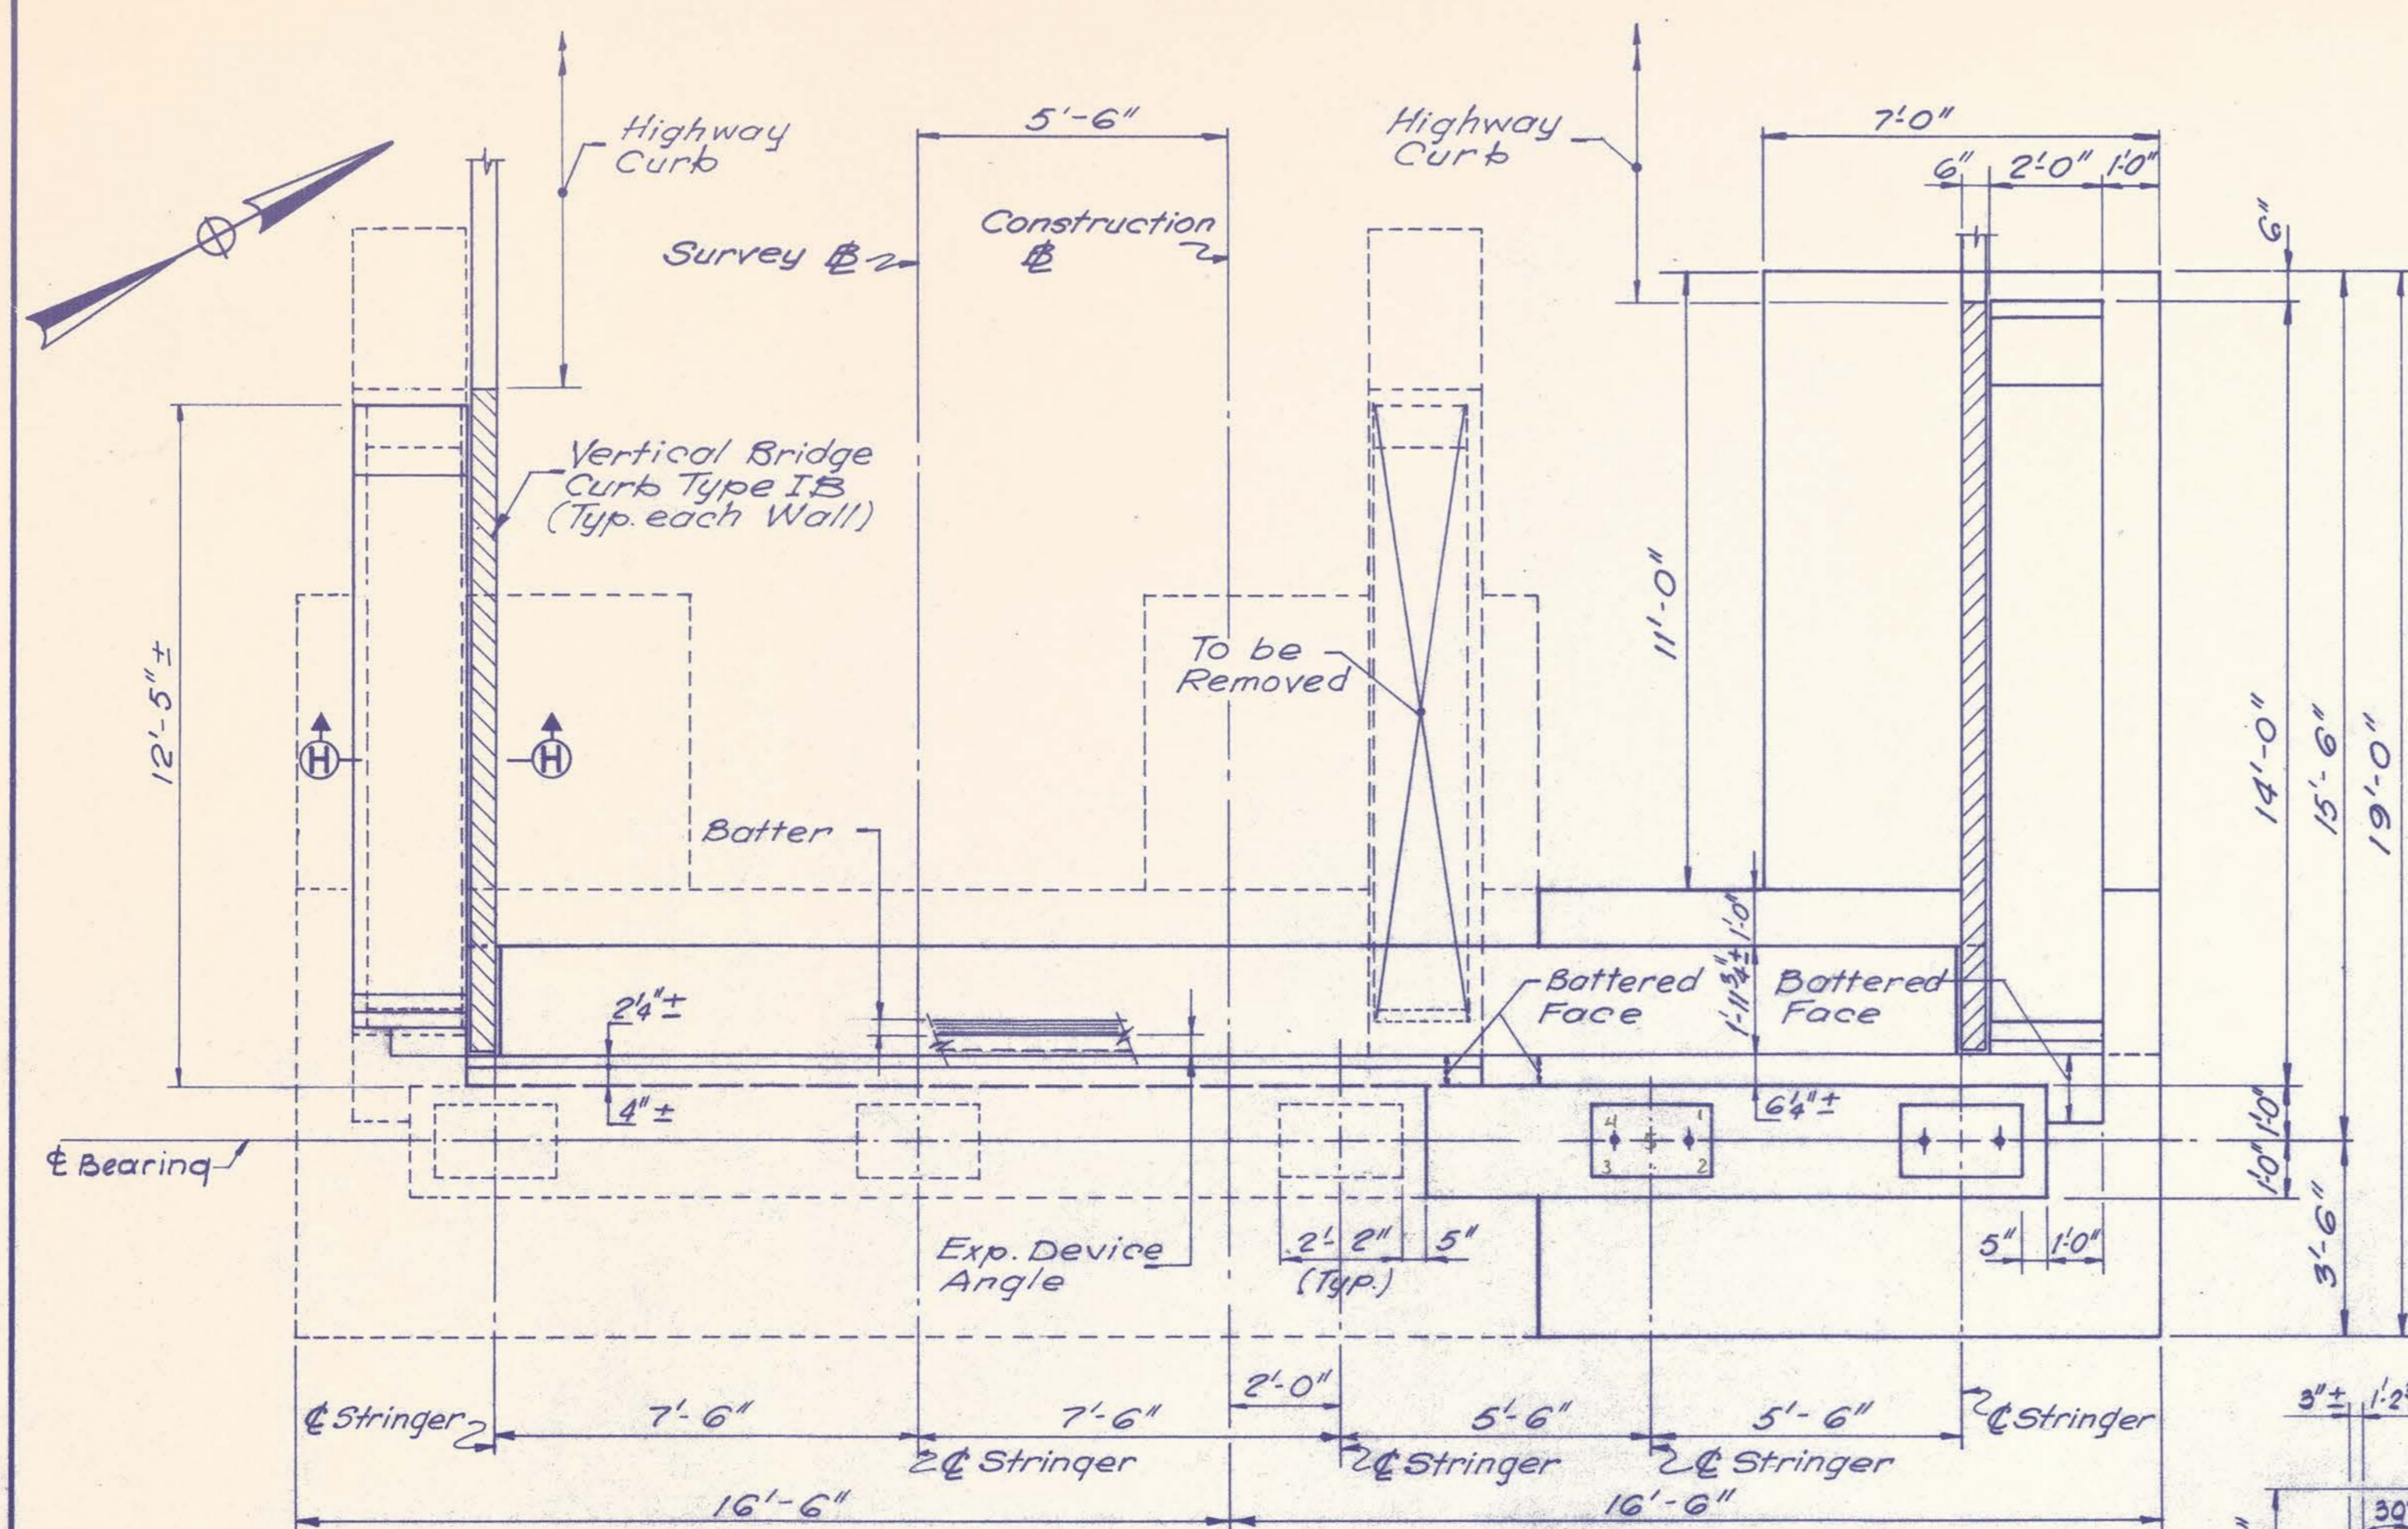


PLAN
3/8" = 1'-0"


NOTE: West Abutment Shown
East Abutment Similar

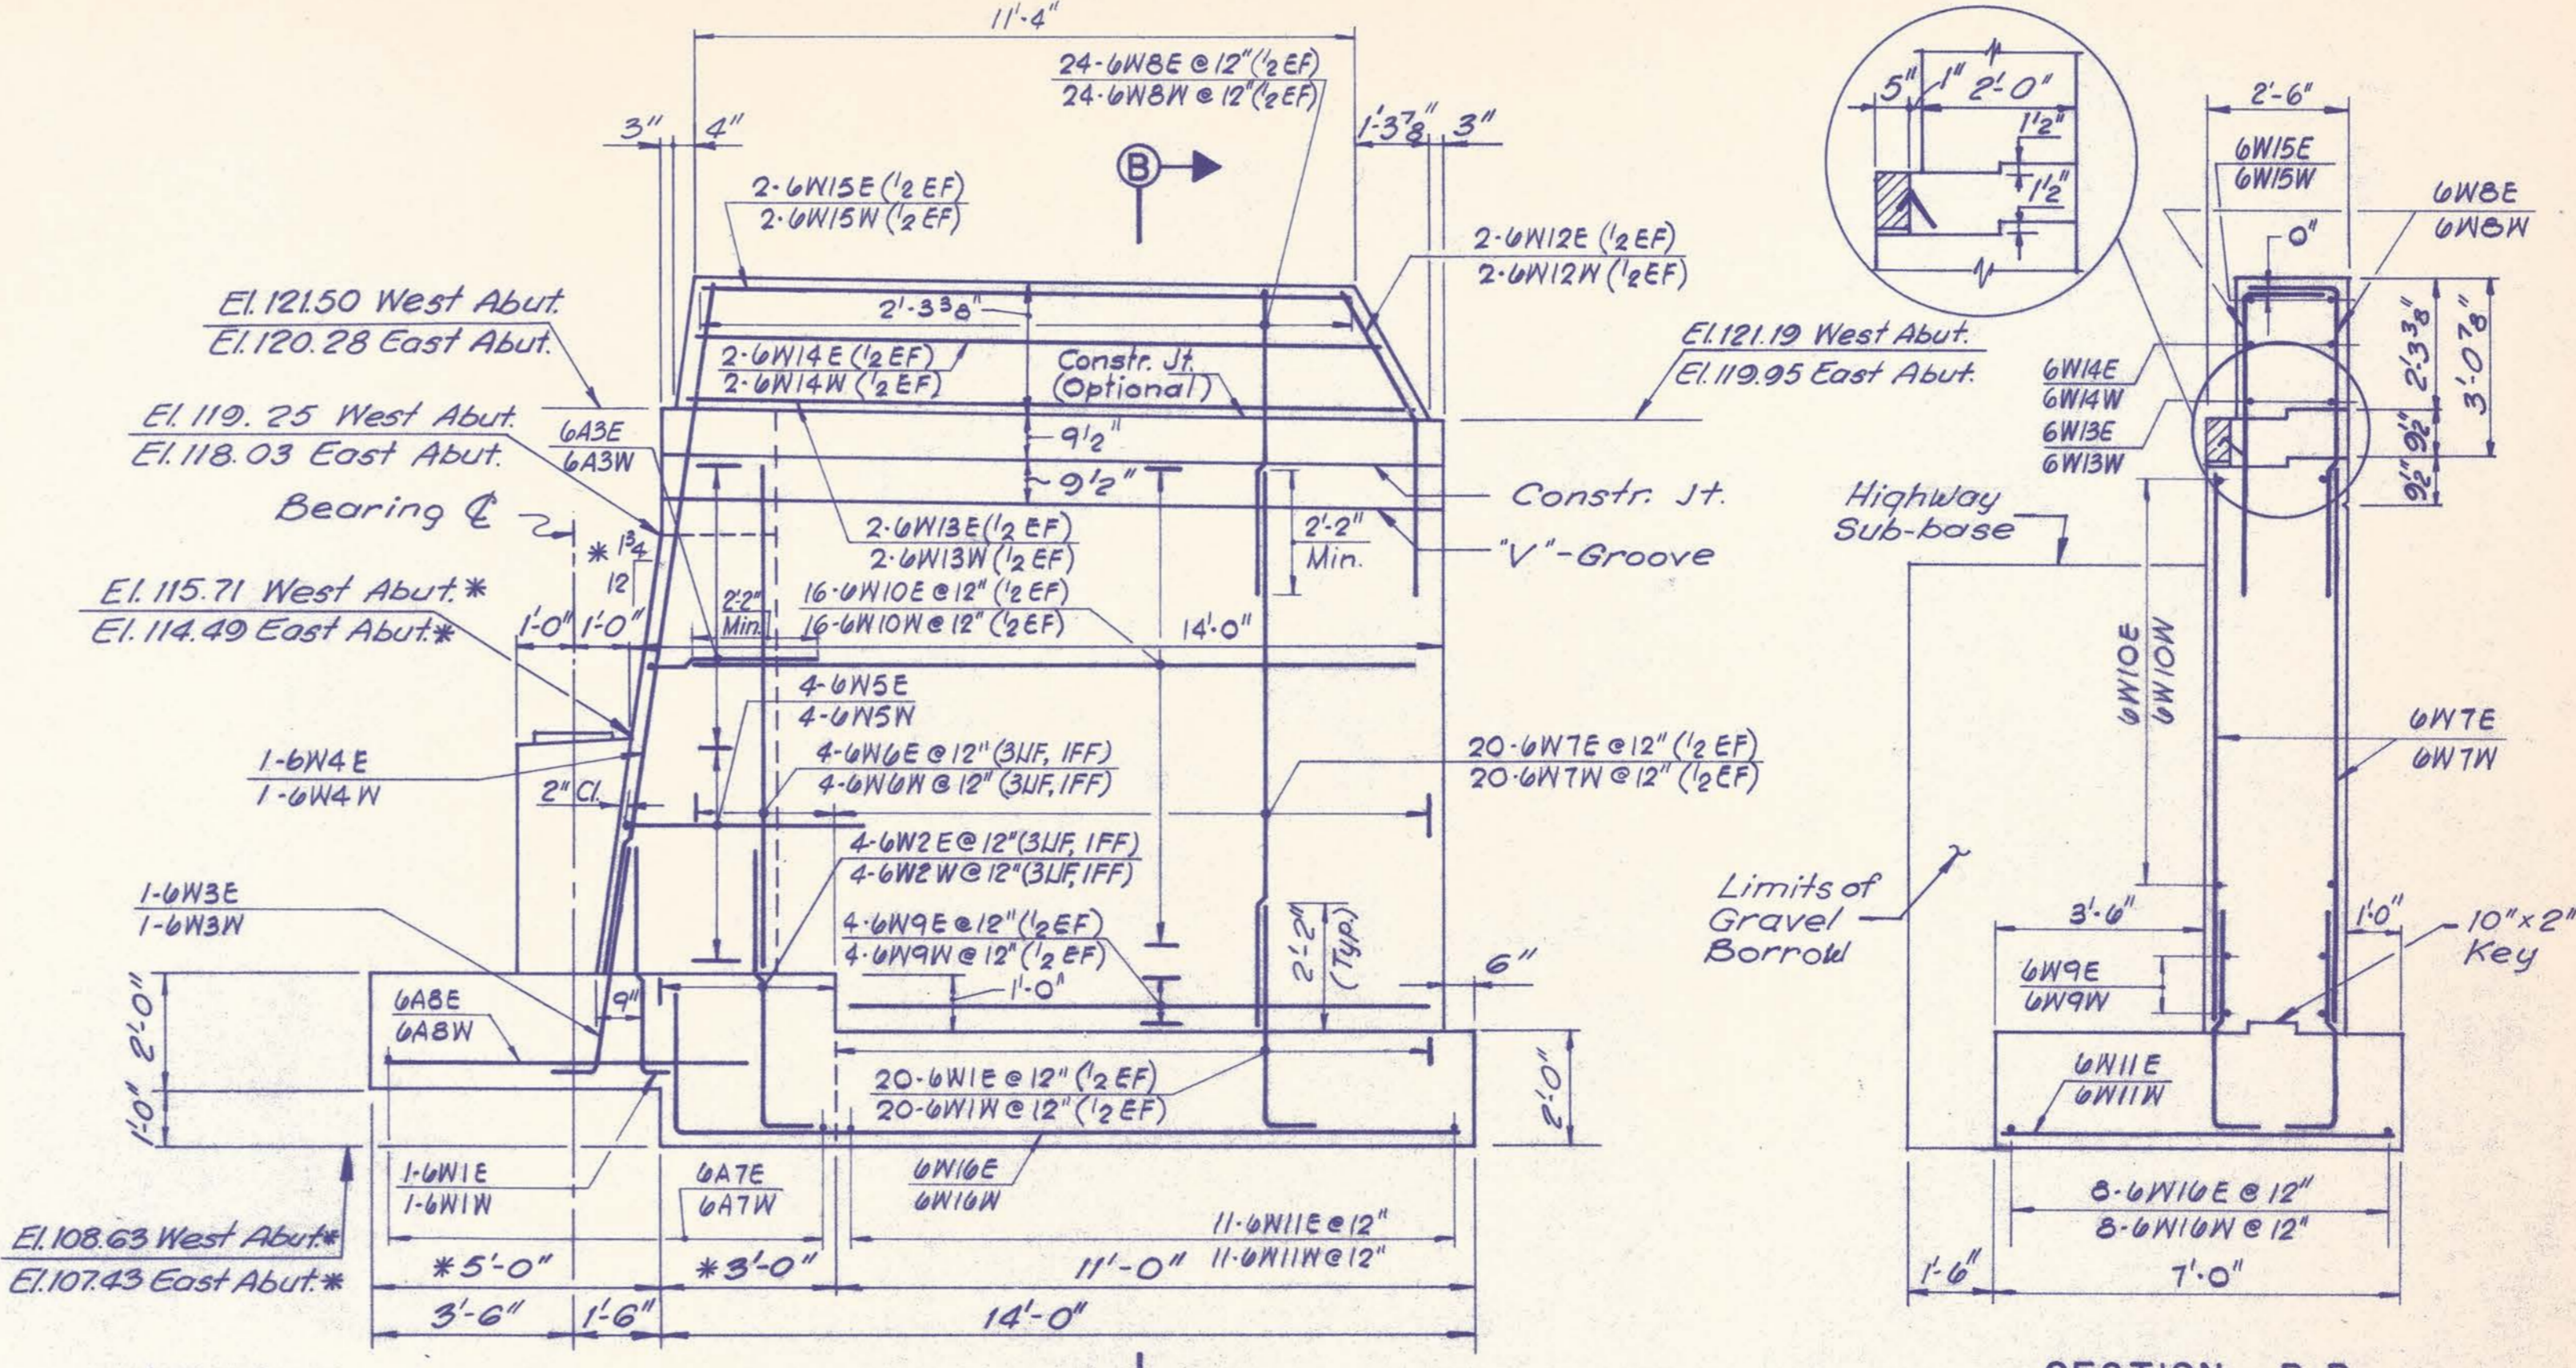


SECTION B-B
3/8" = 1'-0"

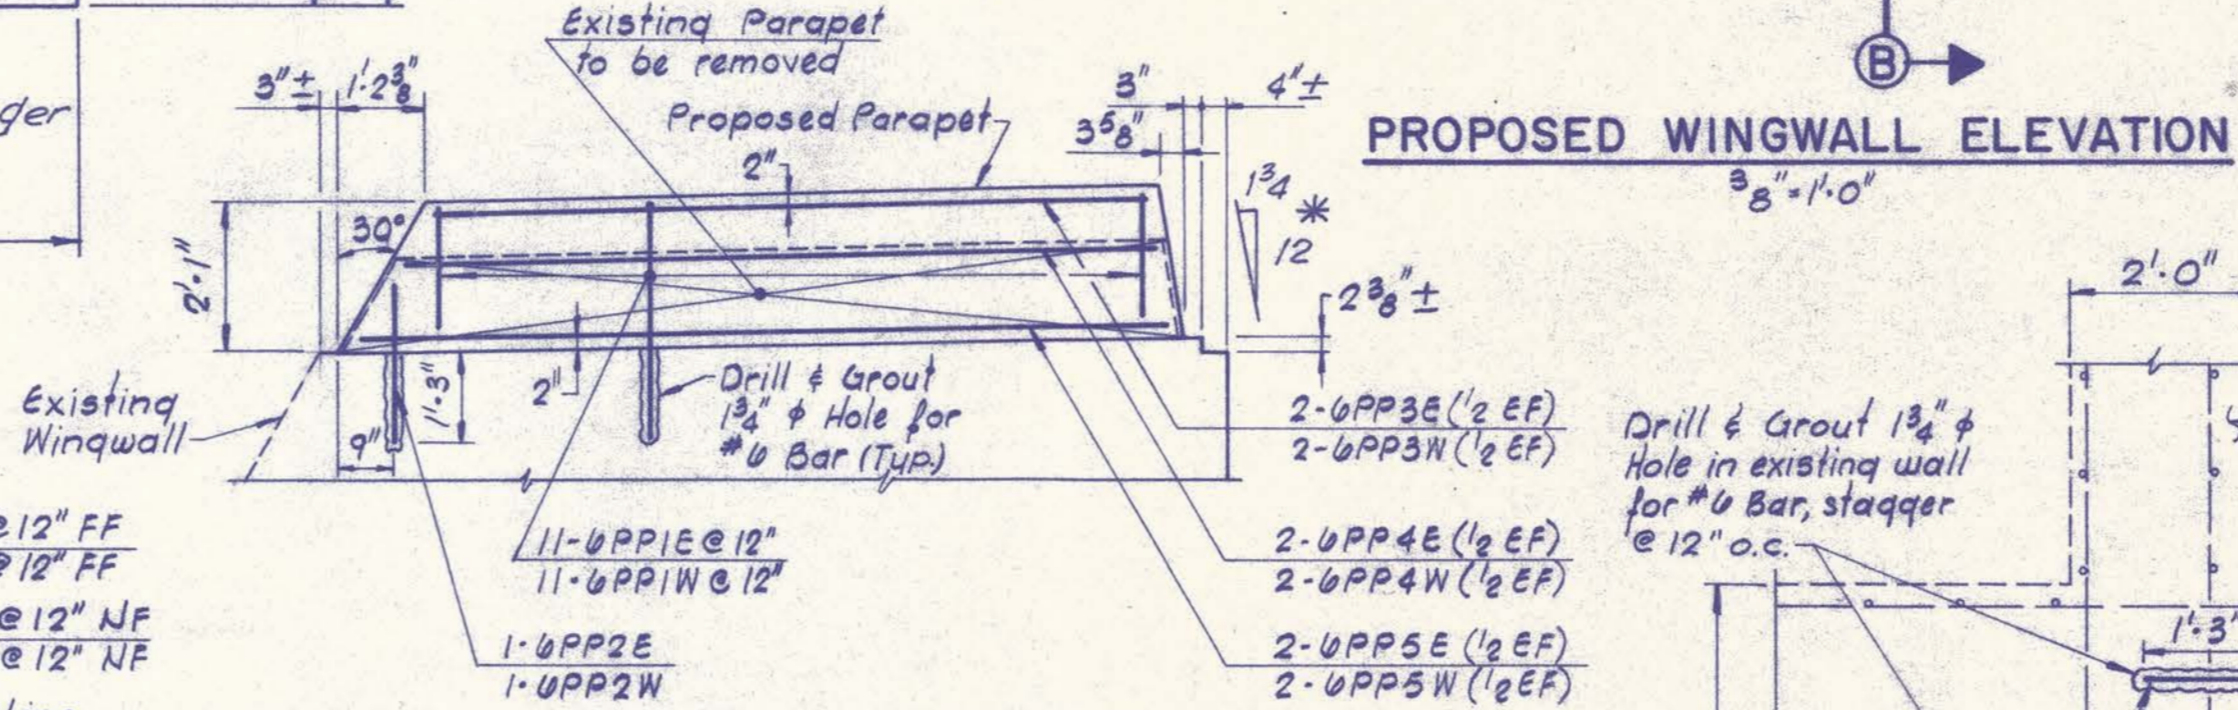


EXISTING WINGWALL MODIFICATION
3/8" = 1'-0"

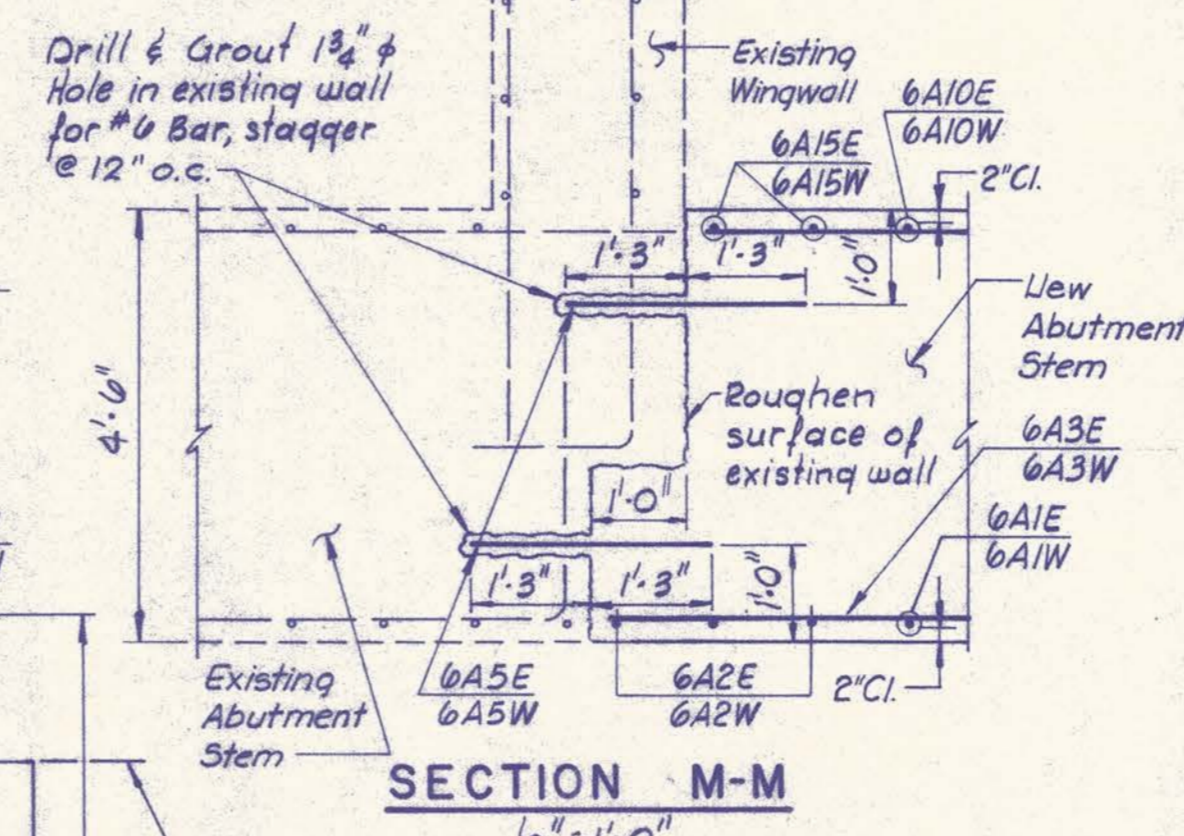

SECTION M-M
1/2" = 1'-0"

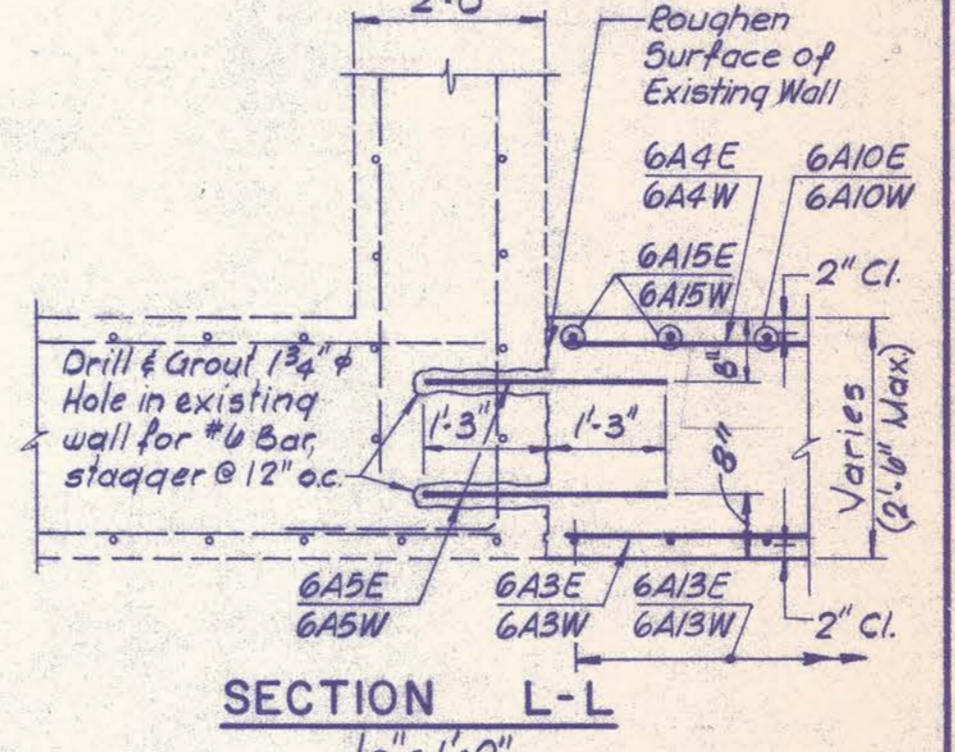


SECTION L-L
1/2" = 1'-0"

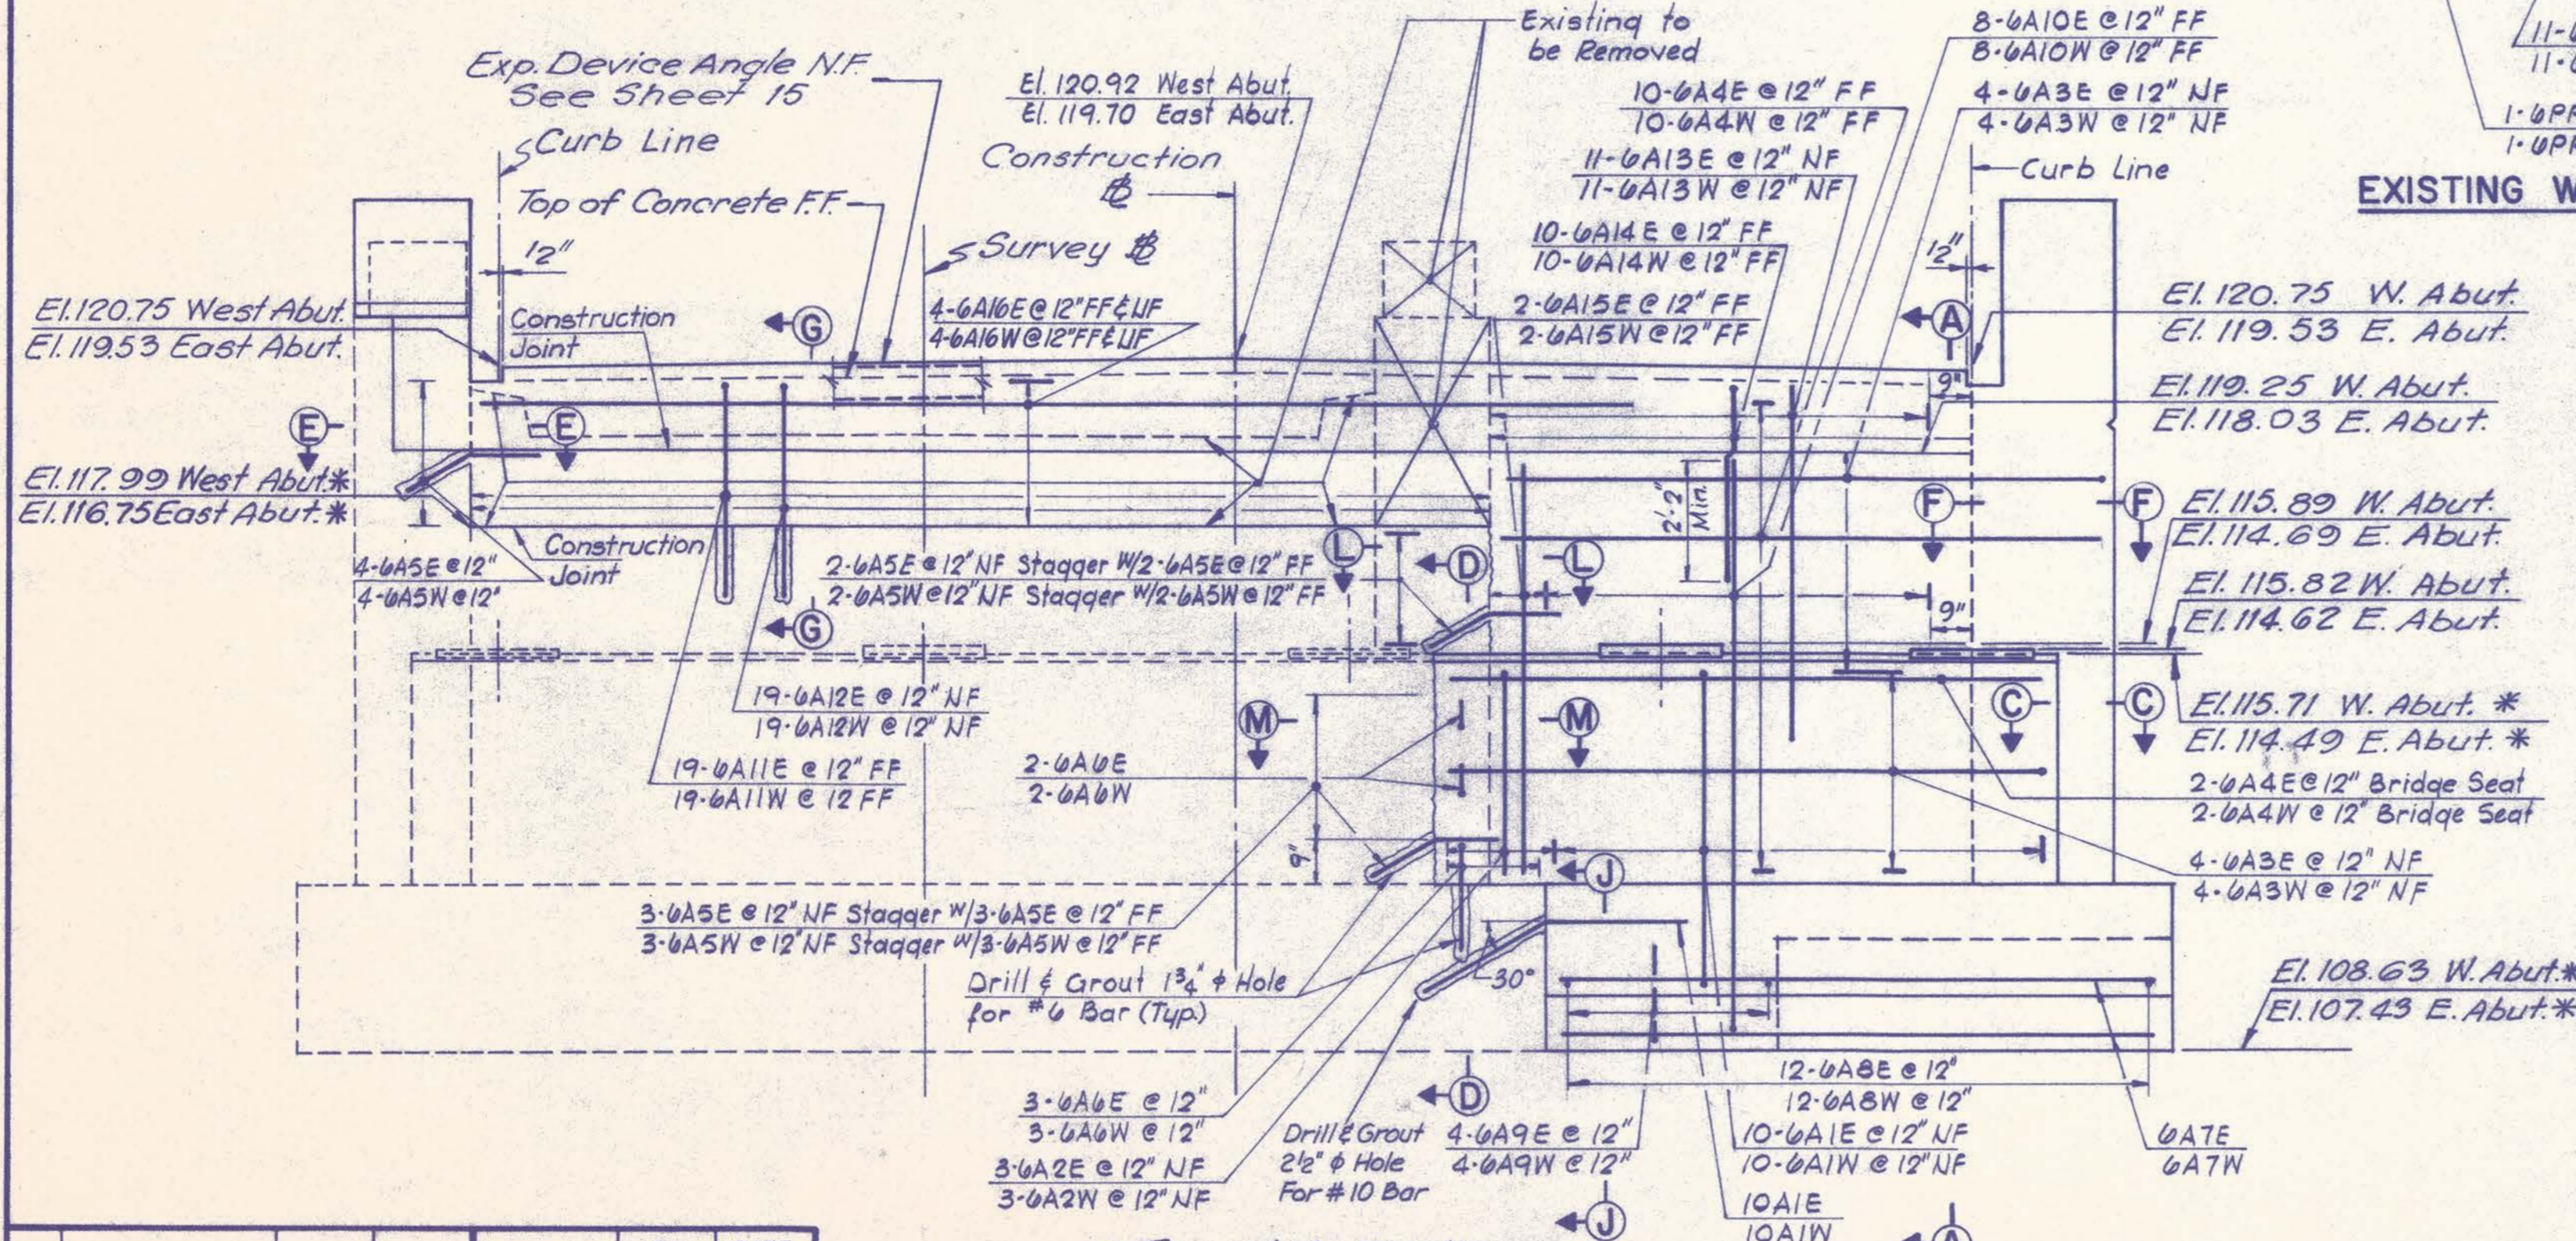

ELEVATION
3/8" = 1'-0"

* To match Existing
N.F. = Near Face
F.F. = Far Face

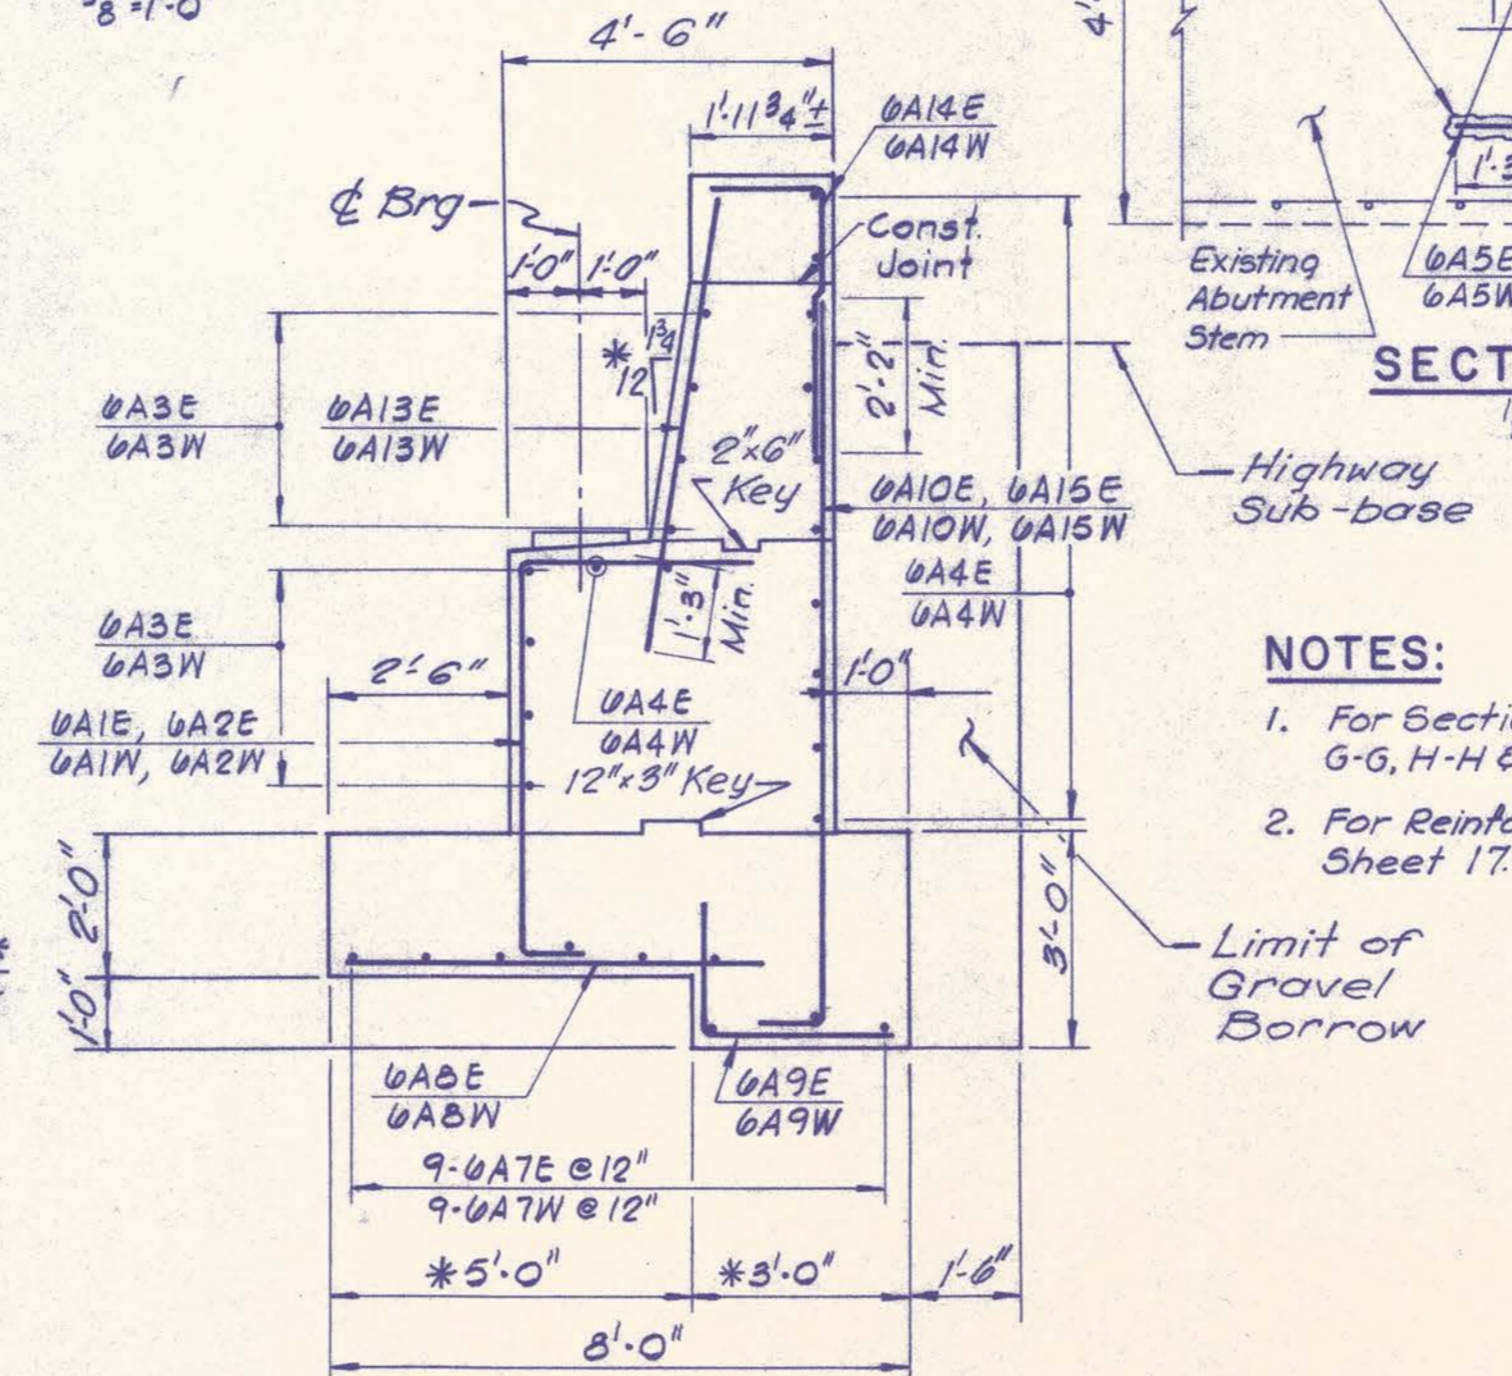

SECTION A-A
3/8" = 1'-0"

- NOTES:**
1. For Sections C-C, D-D, E-E, F-F, G-G, H-H & J-J, See Sheet 11.
 2. For Reinforcing Bar List, See Sheet 17.


NO.	REVISION	BY	DATE	IN CHARGE OF
		BY	DATE	
		DESIGNED: J.S.	2/86	
		DRAWN: M.S.B.	2/86	
		CHECKED: A.B.S.	2/86	
				J.P.W.

MAINE TURNPIKE AUTHORITY
MAINE TURNPIKE


**BENNETT ROAD BRIDGE REPLACEMENT
ABUTMENTS AND WINGWALLS**

HOWARD, NEEDLES, TAMMEN & BERGENDOFF ARCHITECTS ENGINEERS PLANNERS BOSTON

SCALE: AS NOTED
SHEET NO. 10 OF 23

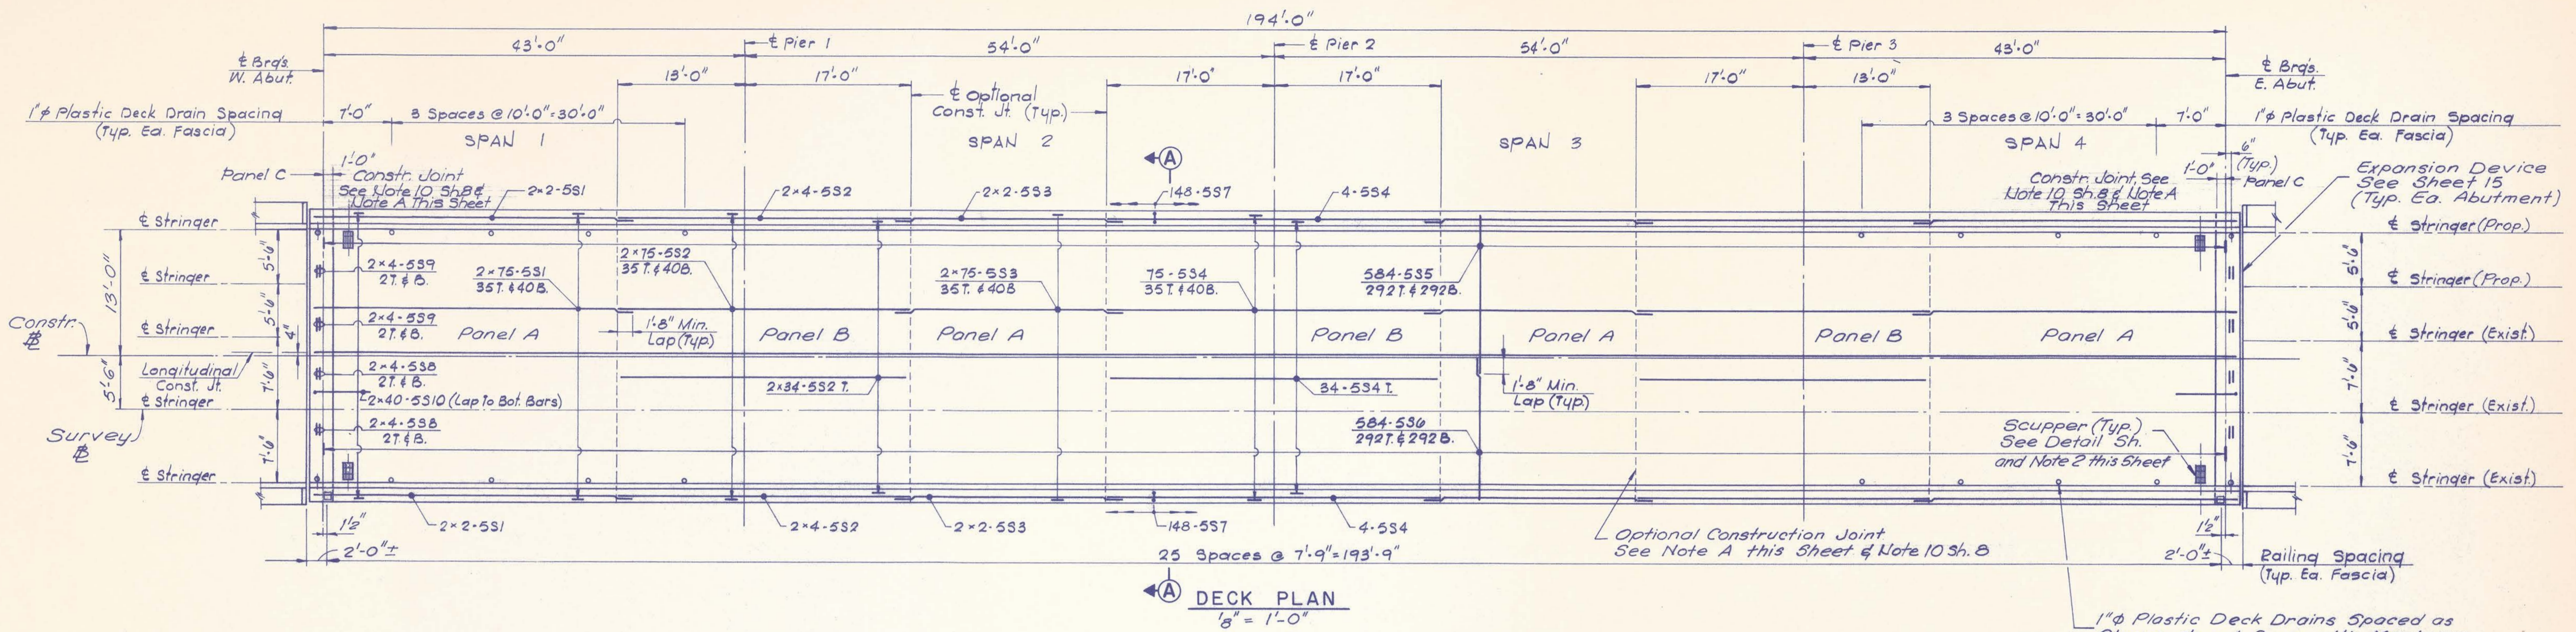

DECK PLAN
1/8" = 1'-0"

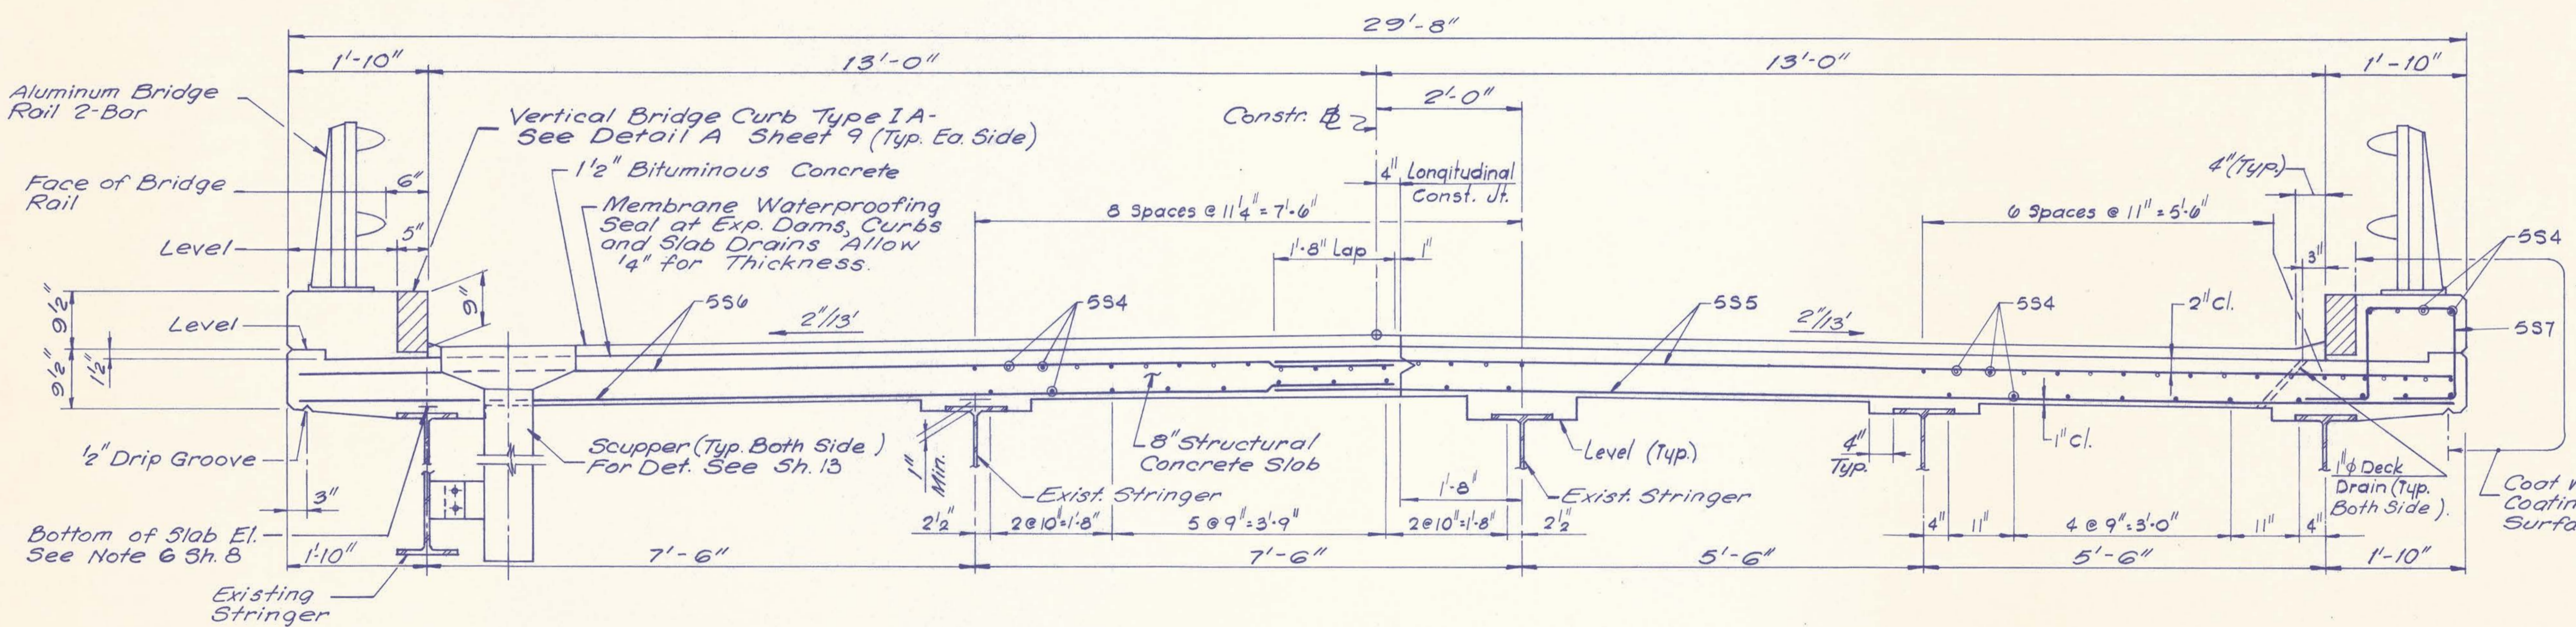

SECTION A-A
3/4" = 1'-0"

NOTE A
As An Alternate And At The Contractors Option, The Deck Concrete May Be Placed In One Continuous Operation From Panel C To Panel C Thus Eliminating Slab Construction Joints At The Piers. Continuous Placing Of Concrete In The Deck Shall Be Made With The Use Of An Acceptable Set-Retarder.

- NOTES:**
1. For General Notes and Quantities, See Sheet 9.
 2. Locate Scupper in Field to Discharge into Existing Trough. Cut Steel in Field at Scuppers as Required.
 3. Length of Last Section of Curb to be Field Checked.
 4. Place Longitudinal Steel as Shown in Section A-A.
 5. For 1" V-Groove Details, See Sheet 9.
 6. For Railing Details, See Sheet 9 and 16.


NO.	REVISION	BY	DATE	IN CHARGE OF
		DESIGNED:	I.S. 1/86	
		DRAWN:	M.S.B. 1/86	
		CHECKED:	S.F.L. 2/86	
		BY	DATE	

MAINE TURNPIKE AUTHORITY
MAINE TURNPIKE

**BENNETT ROAD BRIDGE REPLACEMENT.
DECK REINFORCEMENT**

HOWARD, NEEDLES, TAMMEN & BERGENDOFF ARCHITECTS ENGINEERS PLANNERS BOSTON

SCALE: AS NOTED
SHEET NO. 14 OF 23

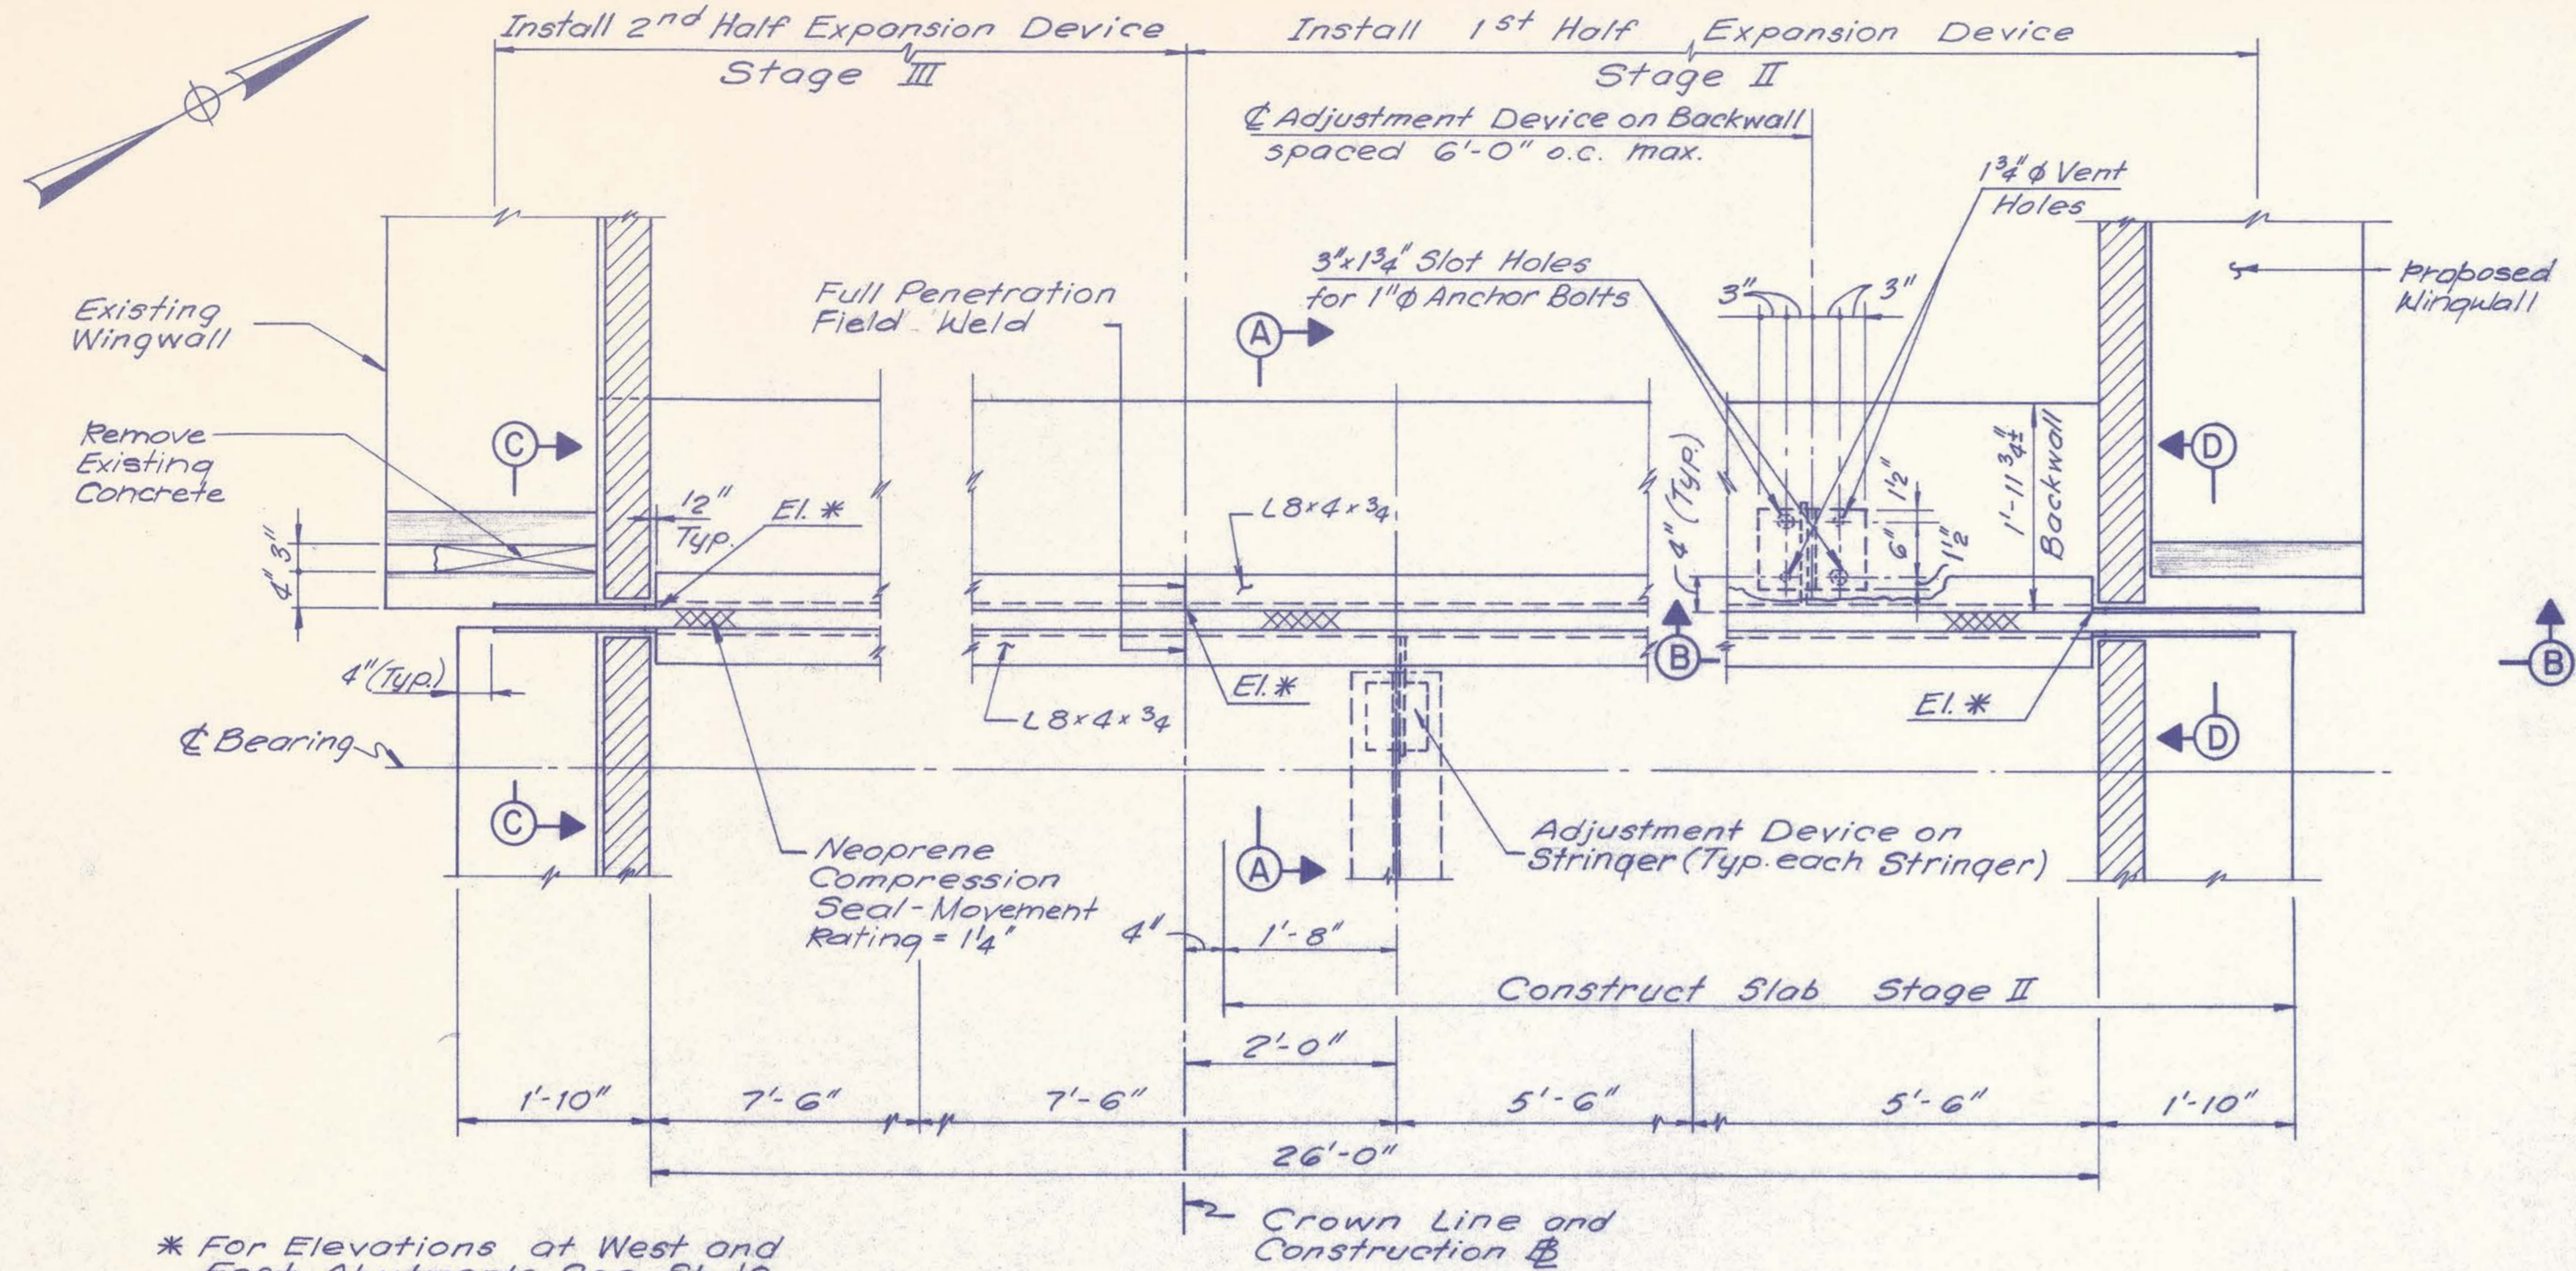


NOTES:

1. Shop Drawings Shall Be Submitted For Expansion Device.
2. Expansion Device Assembly Shall Be Secured To The Stringer And/Or Anchor Bolts When The Ambient Temperature is Between 40°F And 80°F. Setting Schedule For Dim. A Shall Be Supplied By The Manufacturer Of The Seal.
3. Neoprene Compression Seal To Be Installed In One Piece.
4. Dimension "B" Shall Be Set Equal To Compressed Seal Height Plus 3/8".
5. Uncompressed Seal Height Shall Be Equal To Or Greater Than Uncompressed Width Of The Seal.
6. Roadway Surface Of The Armored Devices To Be Painted In The Field.
7. The Fabricators Attention Is Directed To The Necessity Of Fabricating And Installing The Device In Two Sections.
8. Welds In Contact With Compression Seal To Be Ground Smooth.
9. Provide 1"Ø Vent Holes In Horizontal Leg Of B x 4 Angle At 3'-0" o.c. Max.


* For Elevations at West and East Abutments See Sh. 10

PLAN - ROADWAY EXPANSION JOINT
(West Abutment, East Abutment - opposite hand)
3/4" = 1'-0"

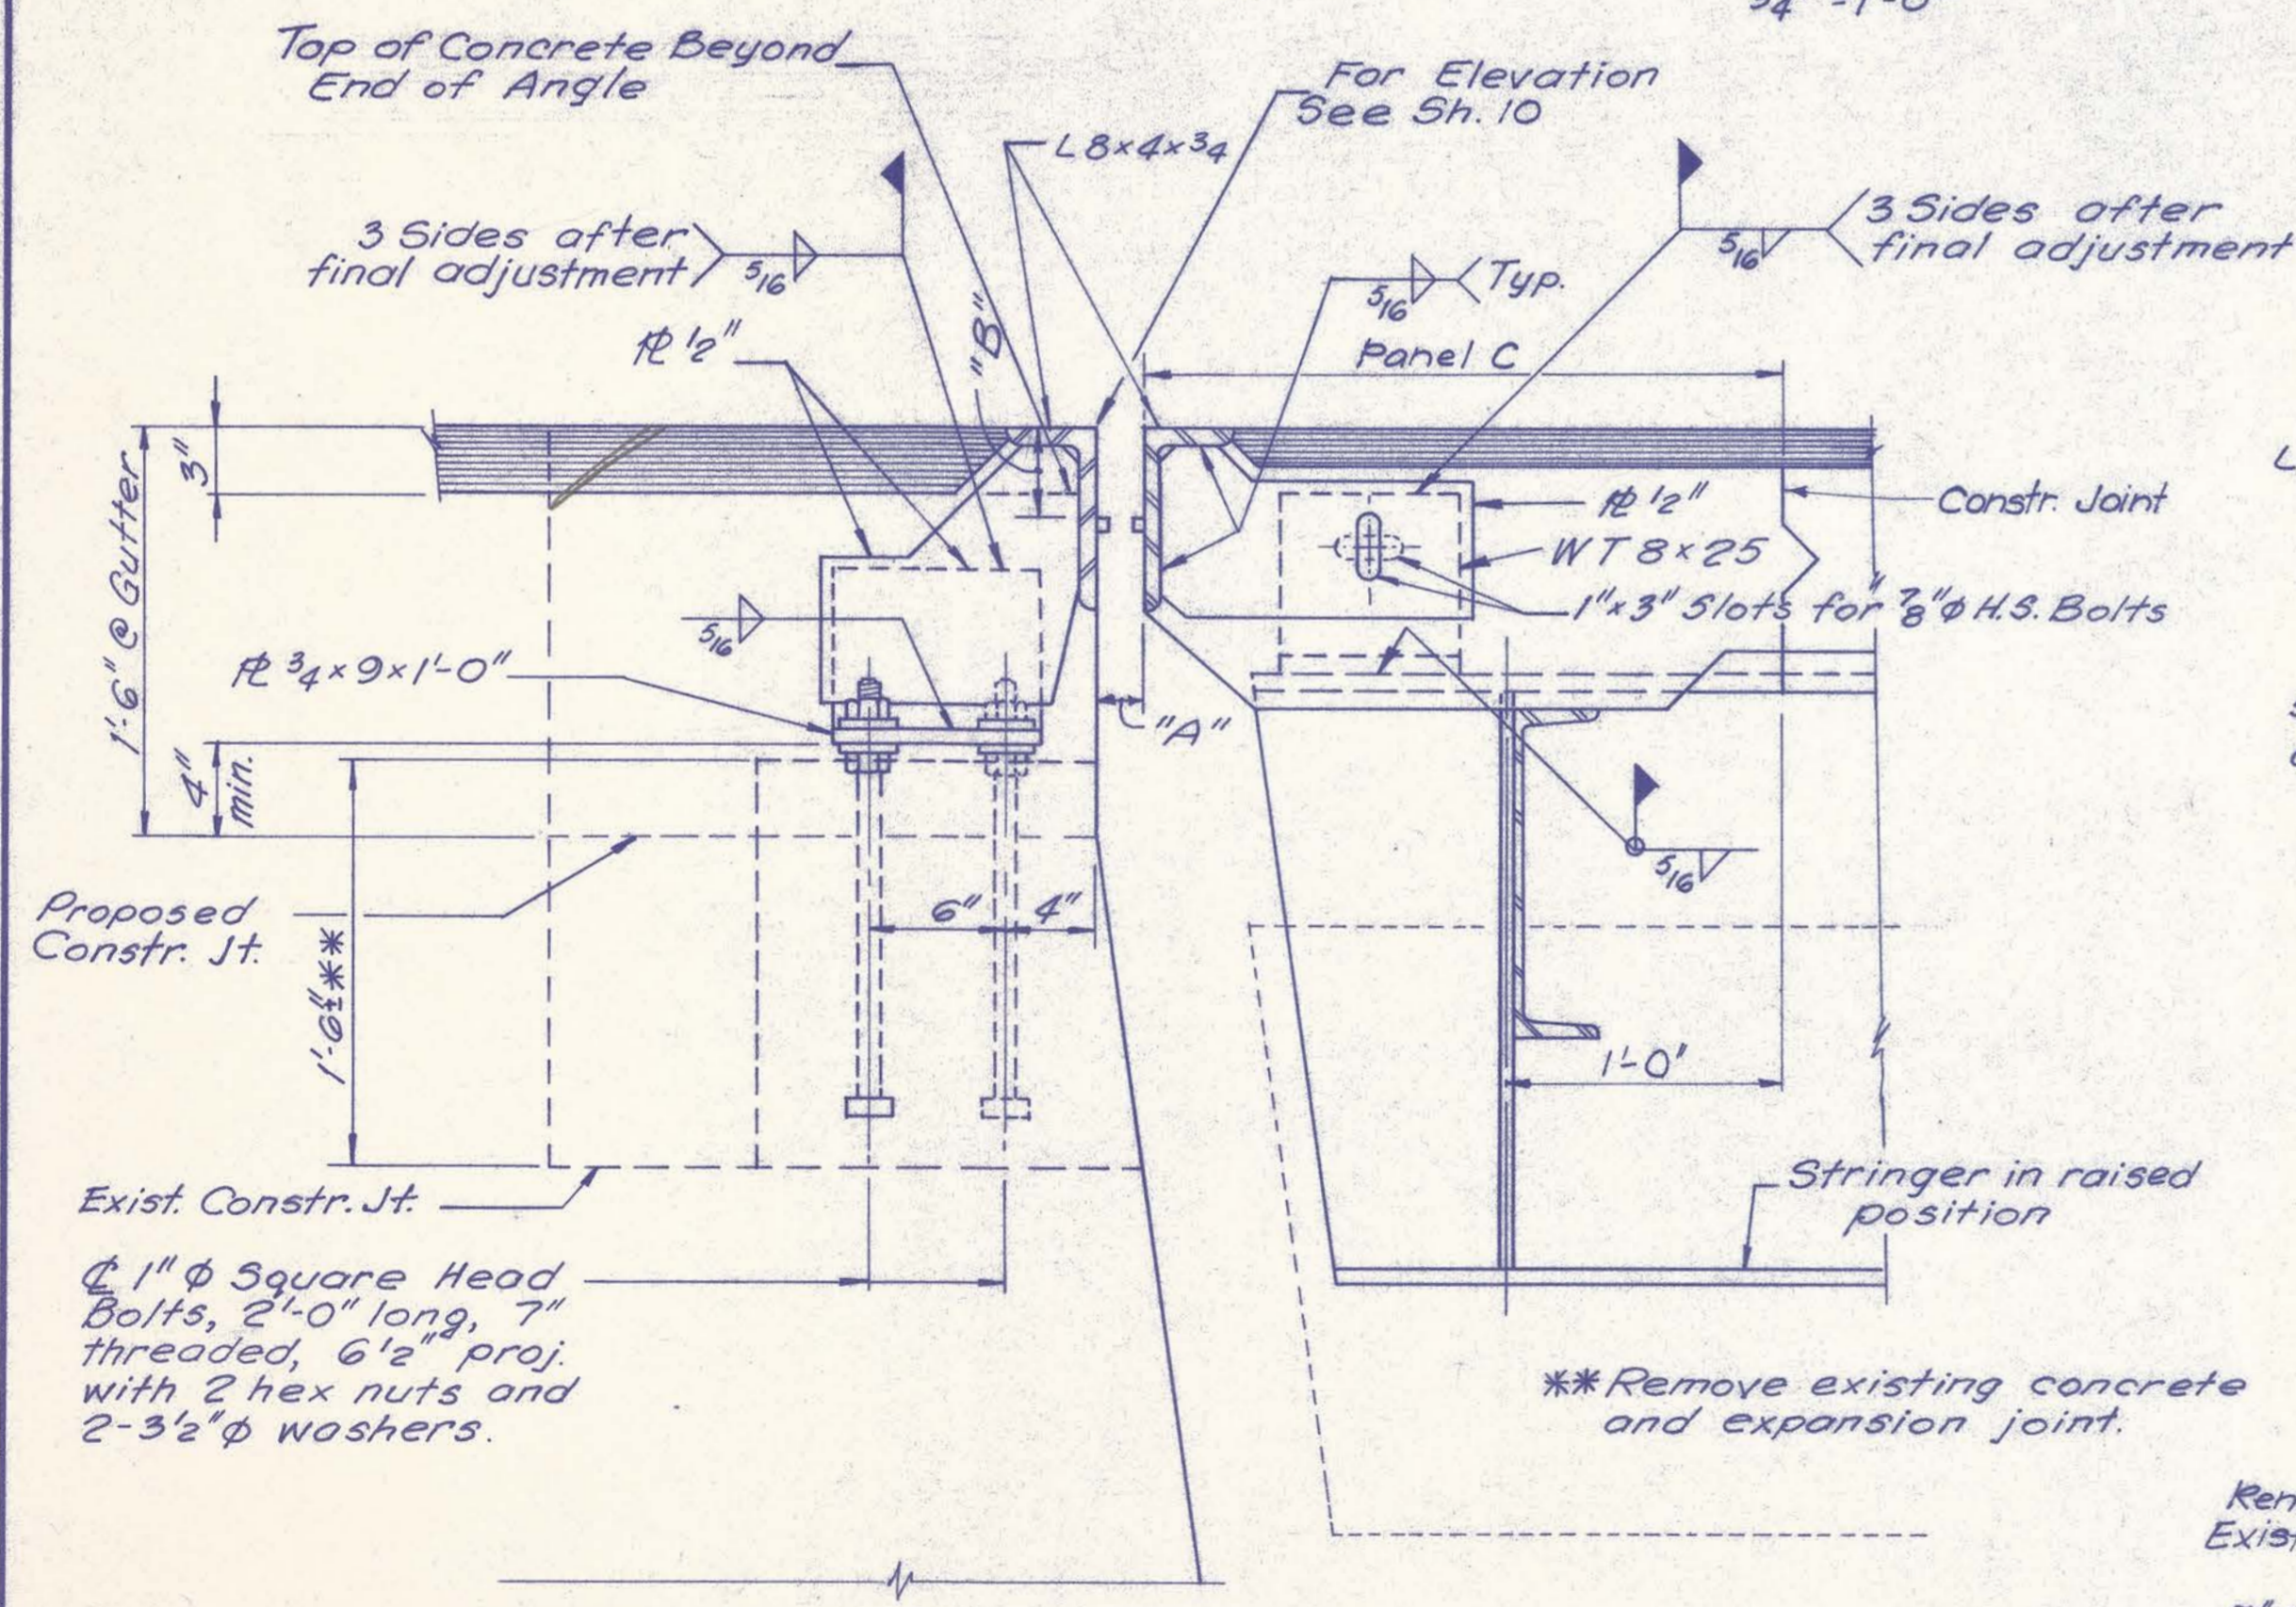


1"Ø Square Head Bolts, 2'-0" long, 7" threaded, 6 1/2" proj. with 2 hex nuts and 2-3/2"Ø washers.


**Remove existing concrete and expansion joint.

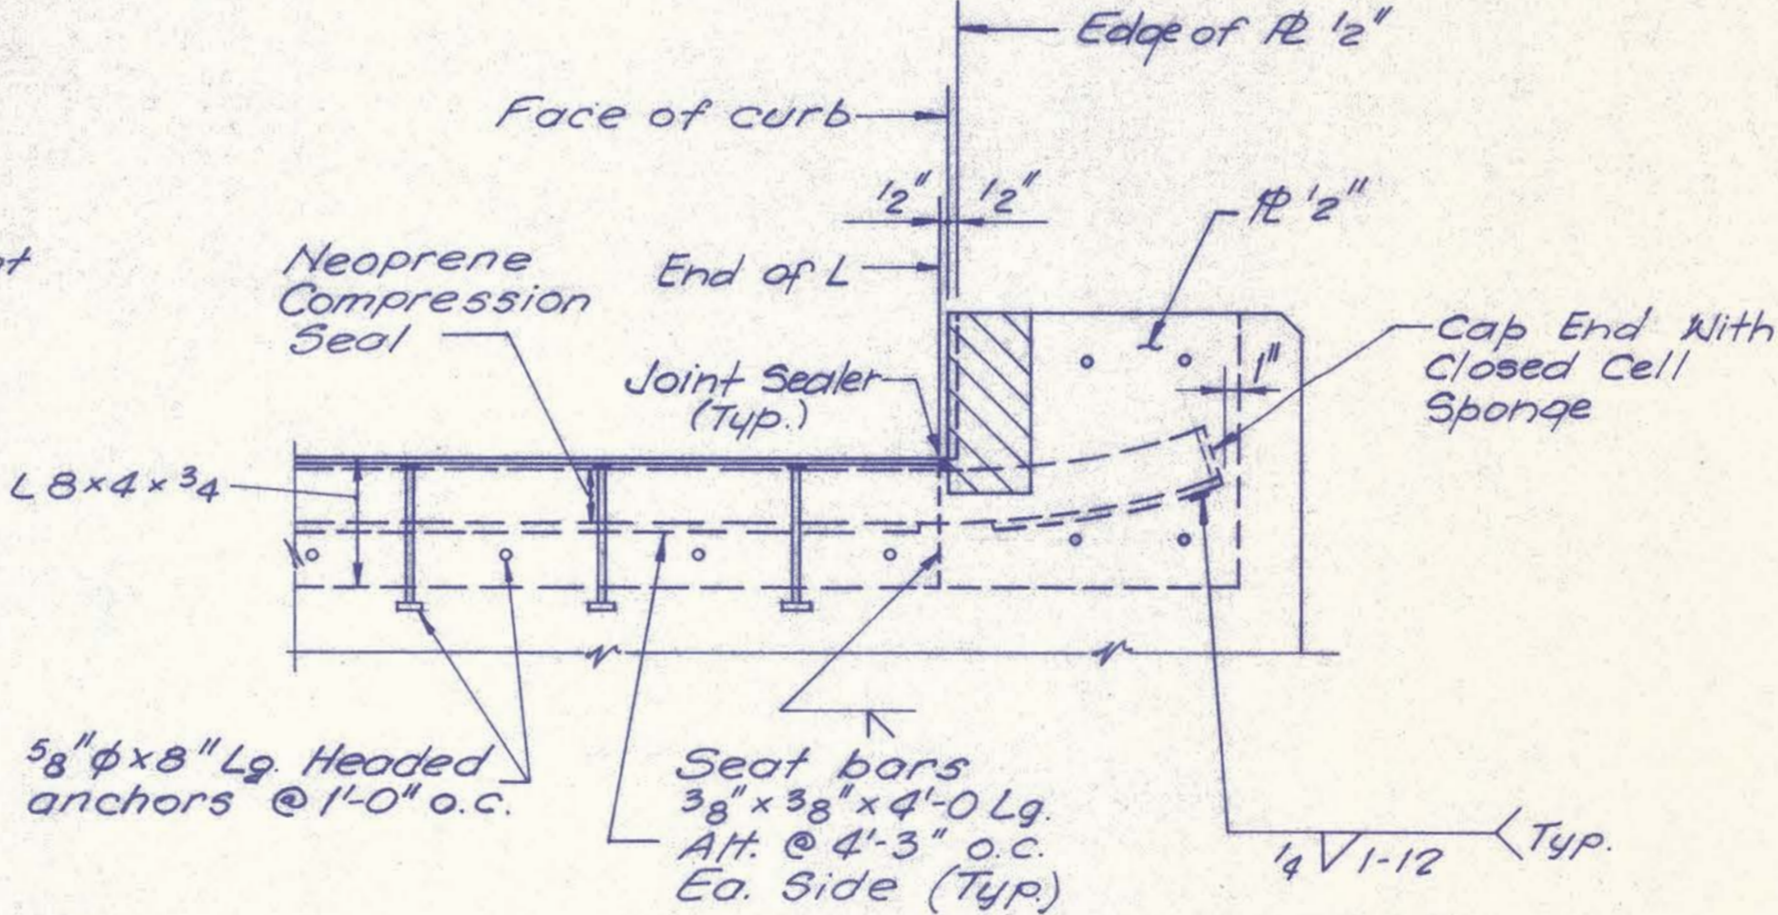

SECTION B-B
1" = 1'-0"

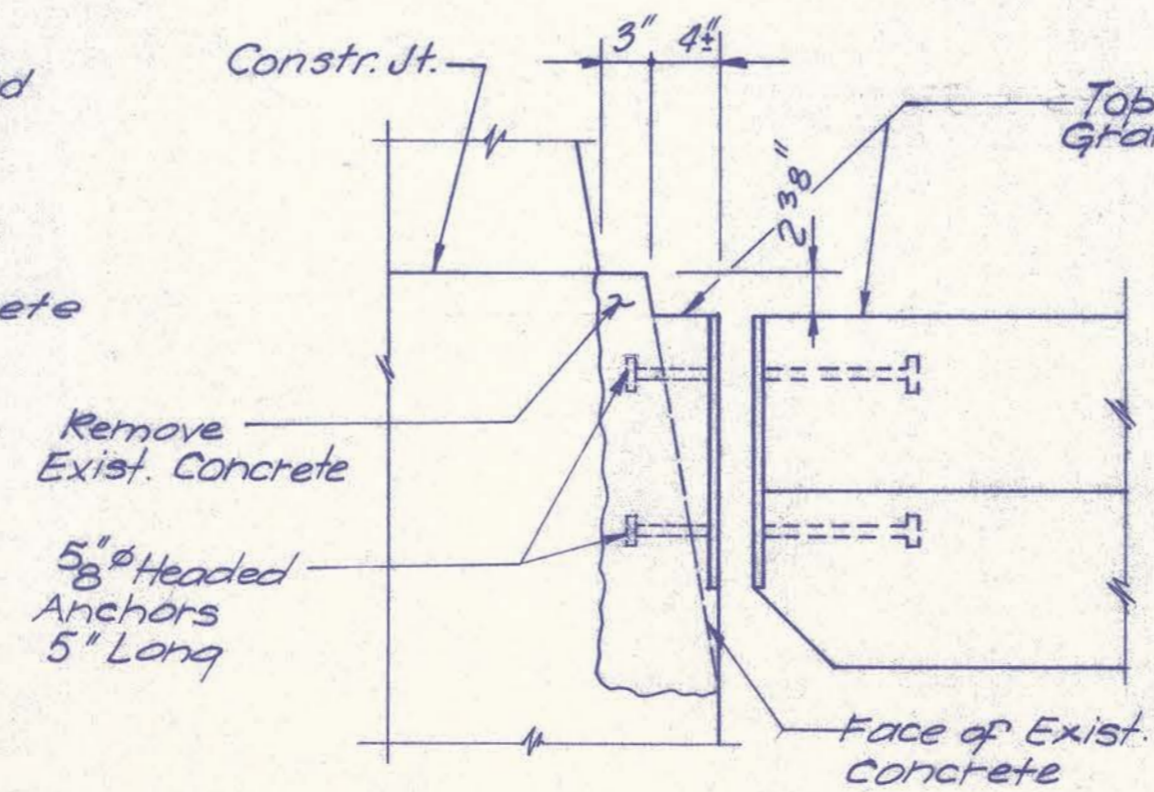




SECTION C-C
1" = 1'-0"

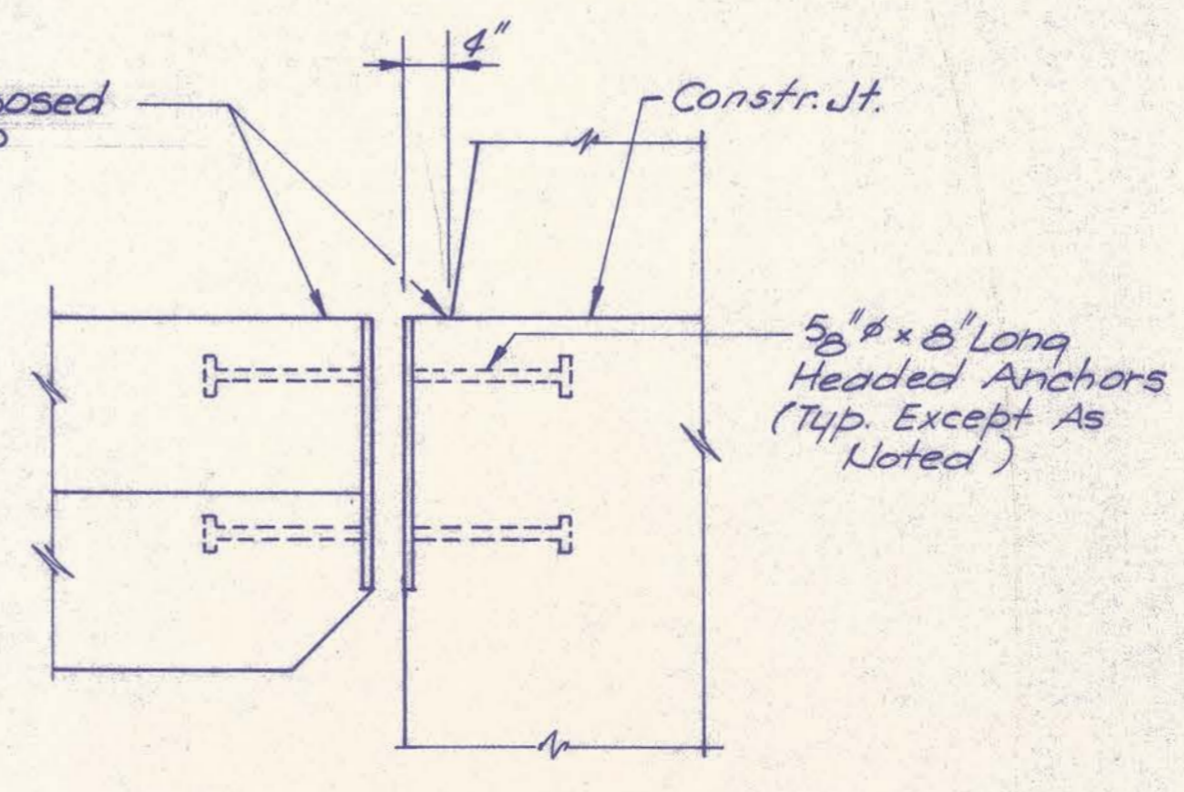

SECTION D-D
1" = 1'-0"

BY		DATE	
DESIGNED:	I.S.	1/86	
DRAWN:	M.S.B.	2/86	
CHECKED:	I.S.	3/86	
NO.	REVISION	BY	DATE
IN CHARGE OF		J.P.W.	

MAINE TURNPIKE AUTHORITY	
MAINE TURNPIKE	
BENNETT ROAD BRIDGE REPLACEMENT EXPANSION DEVICE DETAILS	
HOWARD, NEEDLES, TAMMEN & BERGENDOFF	SCALE: AS NOTED
ARCHITECTS ENGINEERS PLANNERS	
BOSTON	SHEET NO. 15 OF 23

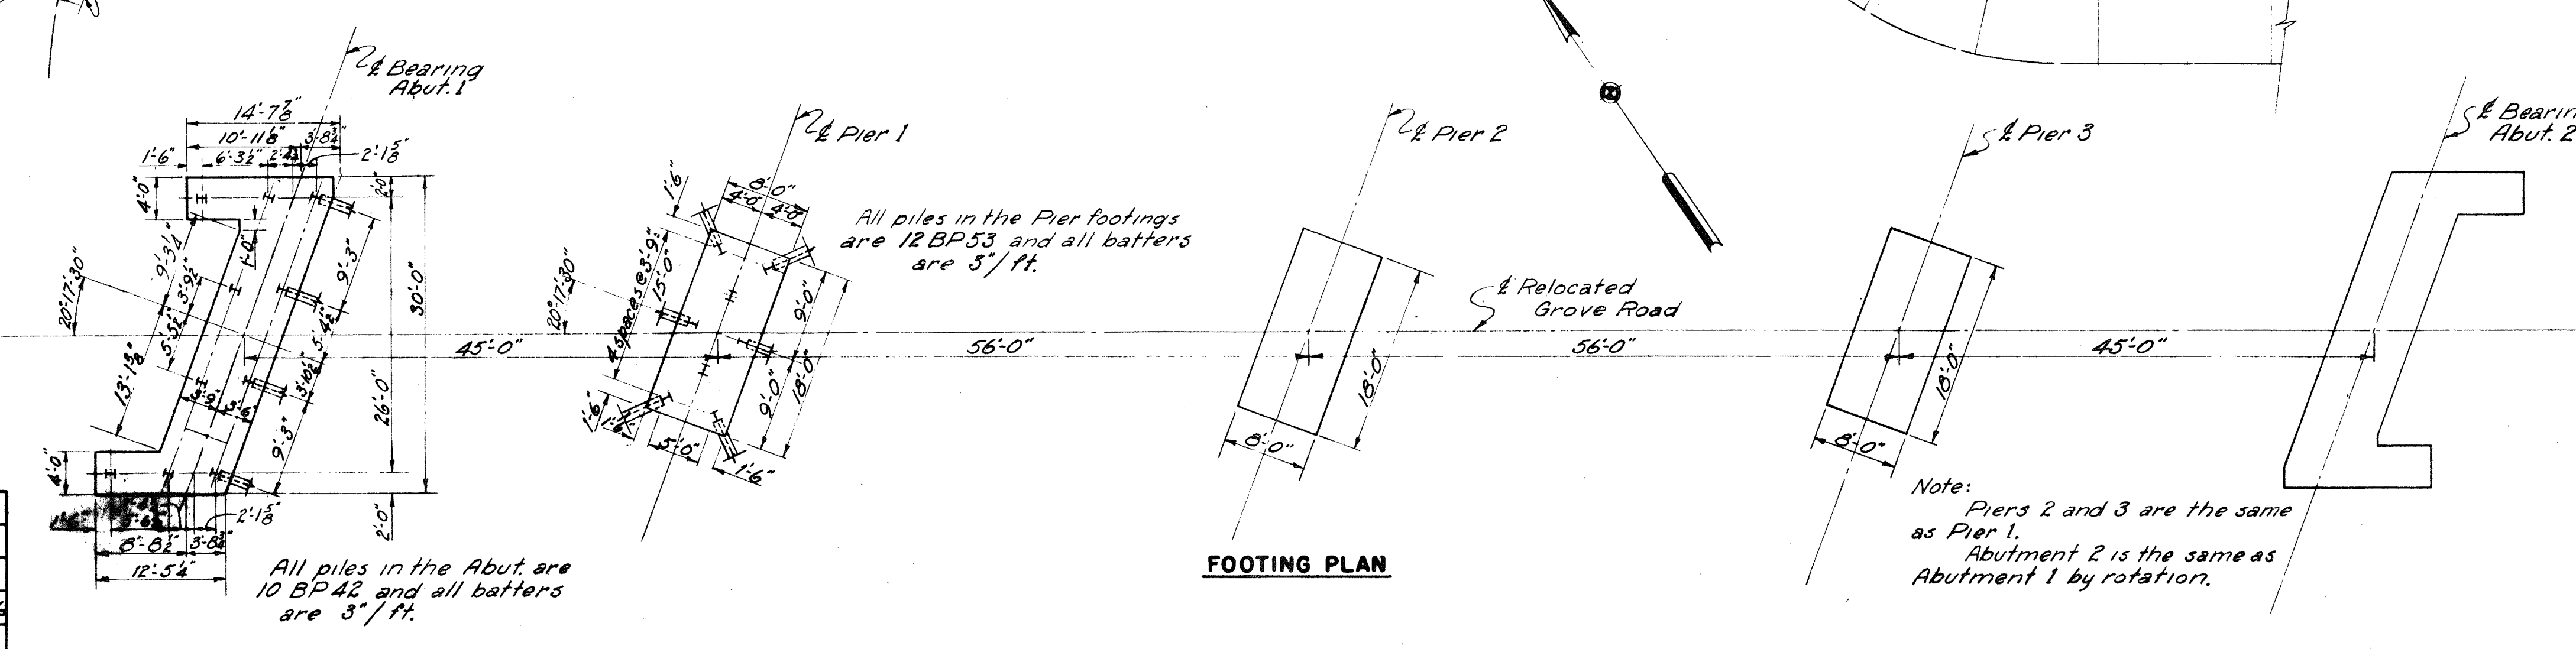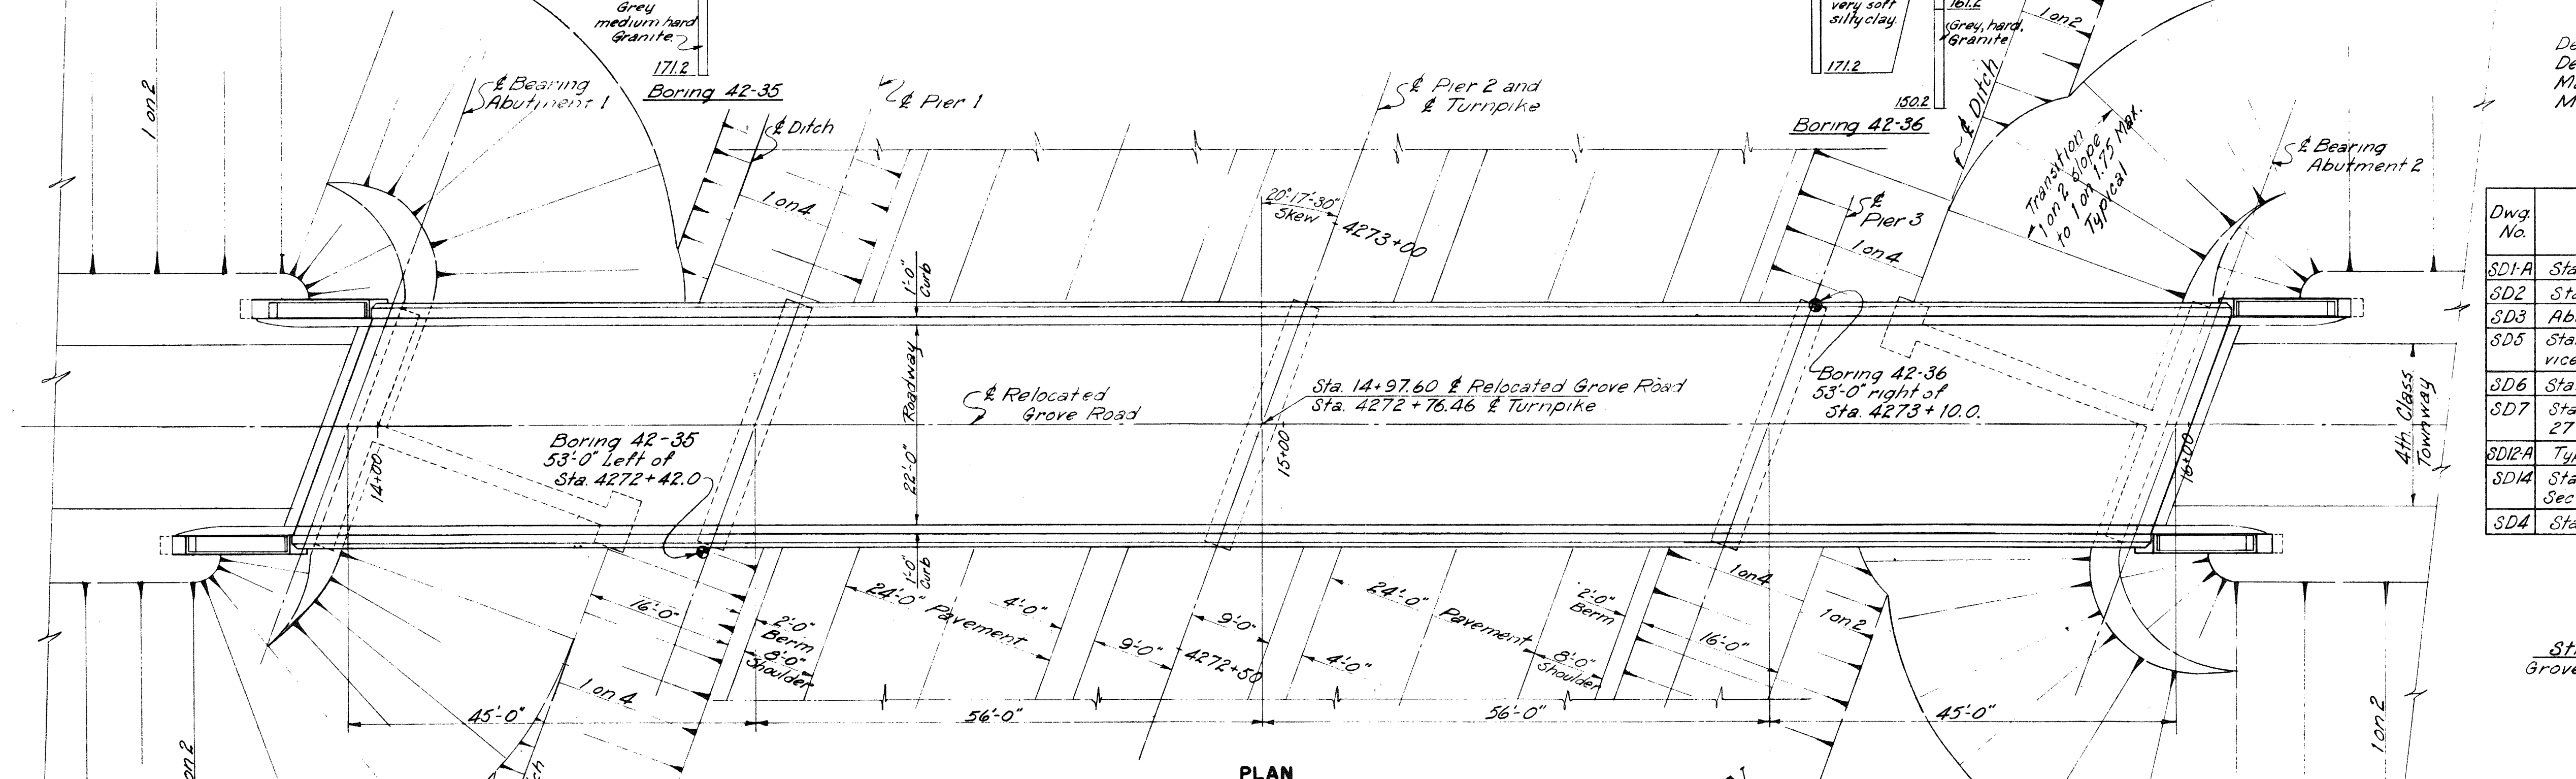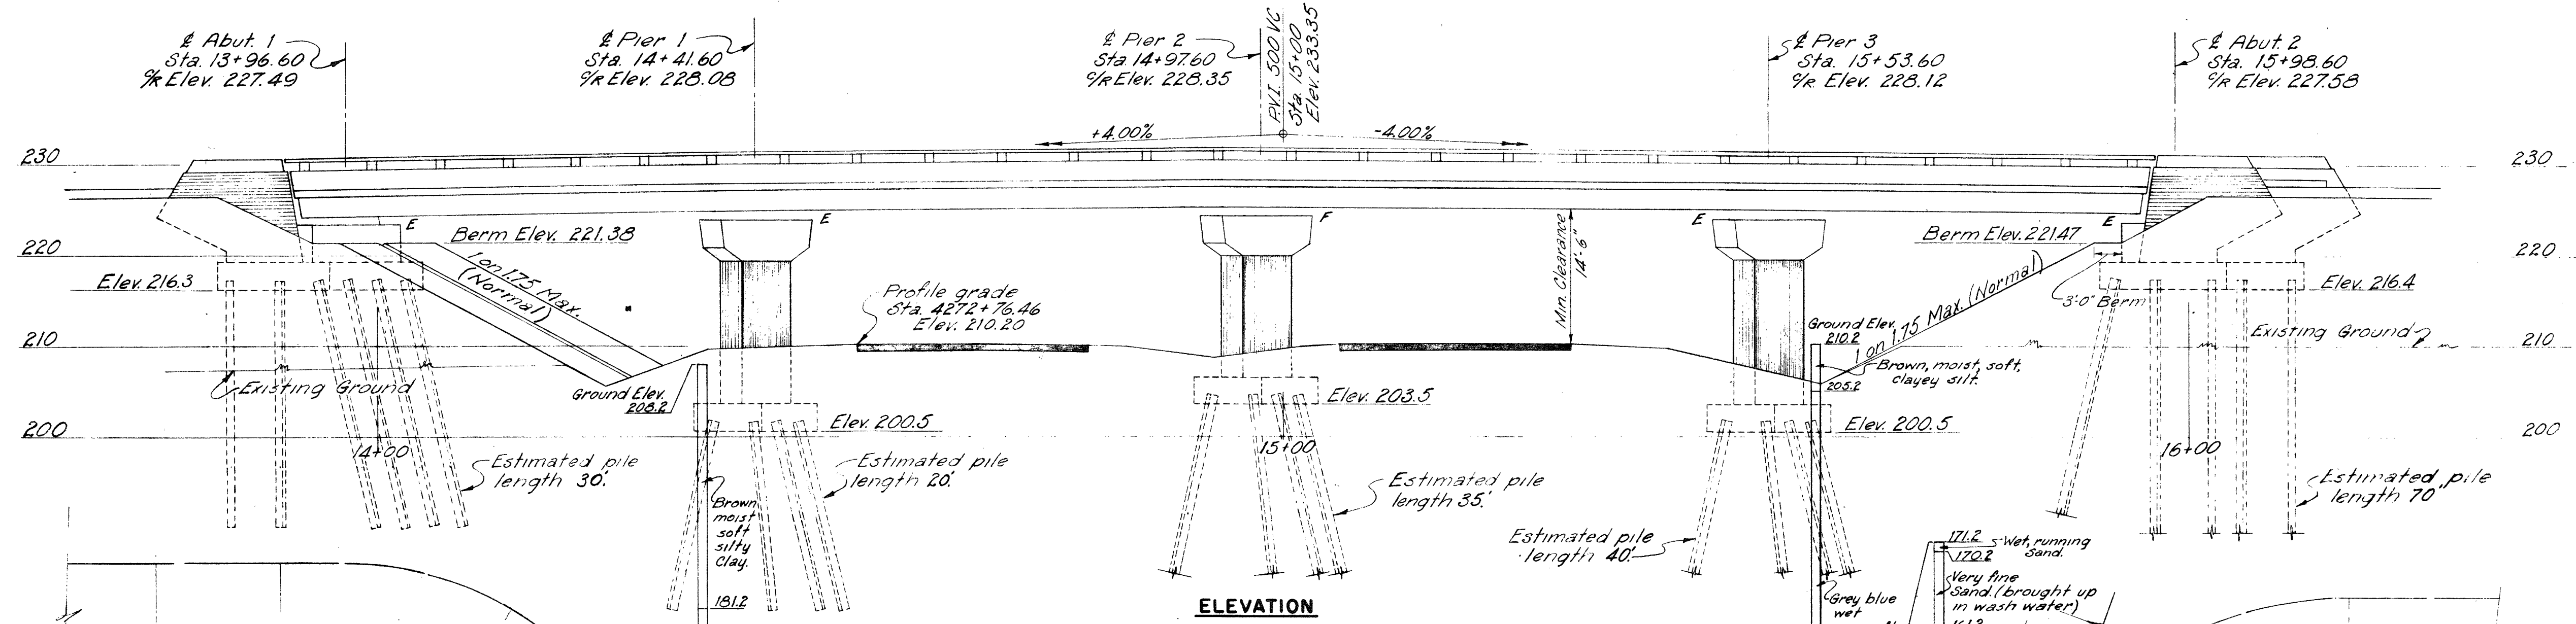


GENERAL NOTES

Design Specifications: AASHO (1953) with minor modifications.
 Design Live Load: H15-44.
 Maximum Pile Load on Abutments is 34 Tons.
 Maximum Pile Load on Piers is 57 Tons.

REFERENCES

Dwg. No.	Title	Superstructure		
		Sub-structure	Steel Fabricator	Floor Contractor
SD1-A	Standard Abutment Details	✓	✓	✓
SD2	Standard Pier Details	✓	✓	✓
SD3	Abutment Drainage Details	✓		
SD5	Standard Handrail, Bearing Devices, and Miscellaneous Details	✓	✓	✓
SD6	Standard Diaphragm Details		✓	✓
SD7	Standard Type 'A' Splices for 27 W Beams.		✓	✓
SD12A	Type 'Z' Expansion joint.	✓	✓	✓
SD14	Standard Bridge Floor Cross-Sections 20'-0" & 22'-0" Roadways	✓	✓	✓
SD4	Standard Pile Details.	✓		

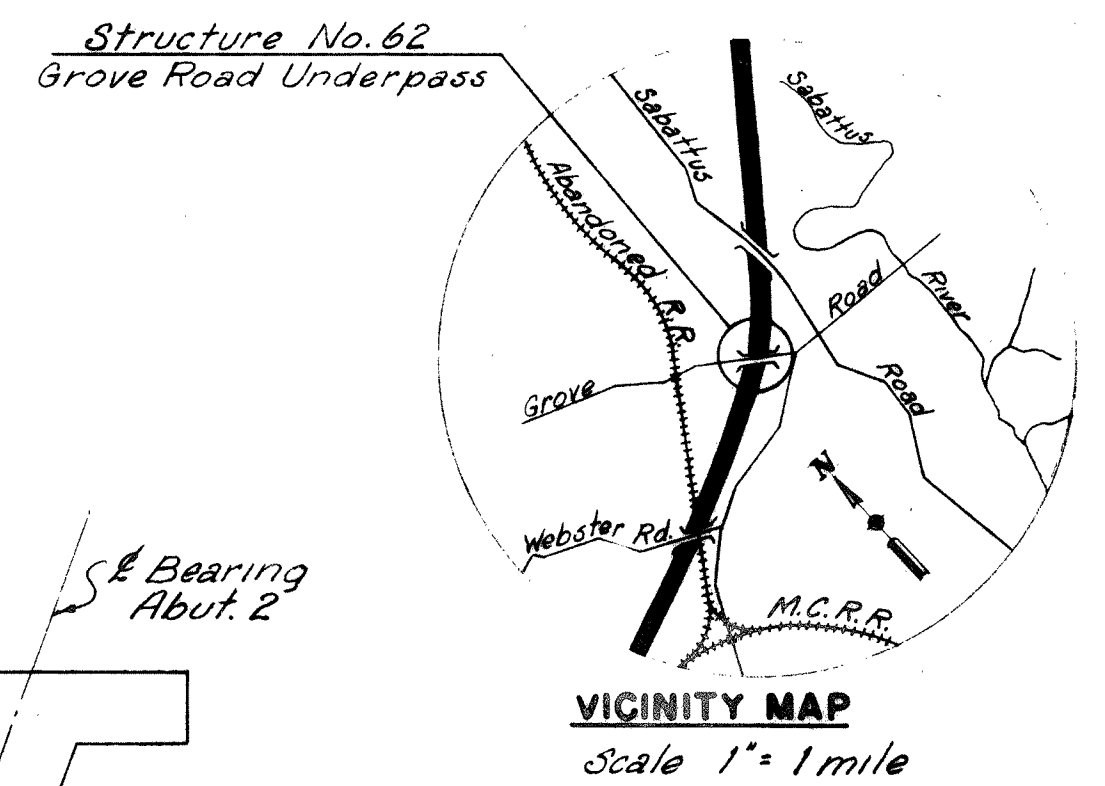


DRAWING 62.01.03

MADE	BY	DATE	NO.	REVISION	BY	DATE
	DHL	1-28-54				
CHECKED	DDB	2-24-54	1	As-Built	HGH	3-25-54
IN CHARGE OF	JDSK					


MAINE TURNPIKE AUTHORITY
MAINE TURNPIKE
SECTION 2— PORTLAND TO AUGUSTA
 STRUCTURE NO. 62 TURNPIKE UNDER
GROVE ROAD
 STA. 4272+76.46
GENERAL PLAN AND ELEVATION
 HOWARD, NEEDLES, TAMMEN & BERGENDOFF CONSULTING ENGINEERS
 NEW YORK KANSAS CITY
 SCALE: 3/8" = 1'-0"
 CONTRACT NO. _____
 SHEET NO. 287 OF 382

Note: Piers 2 and 3 are the same as Pier 1.
 Abutment 2 is the same as Abutment 1 by rotation.

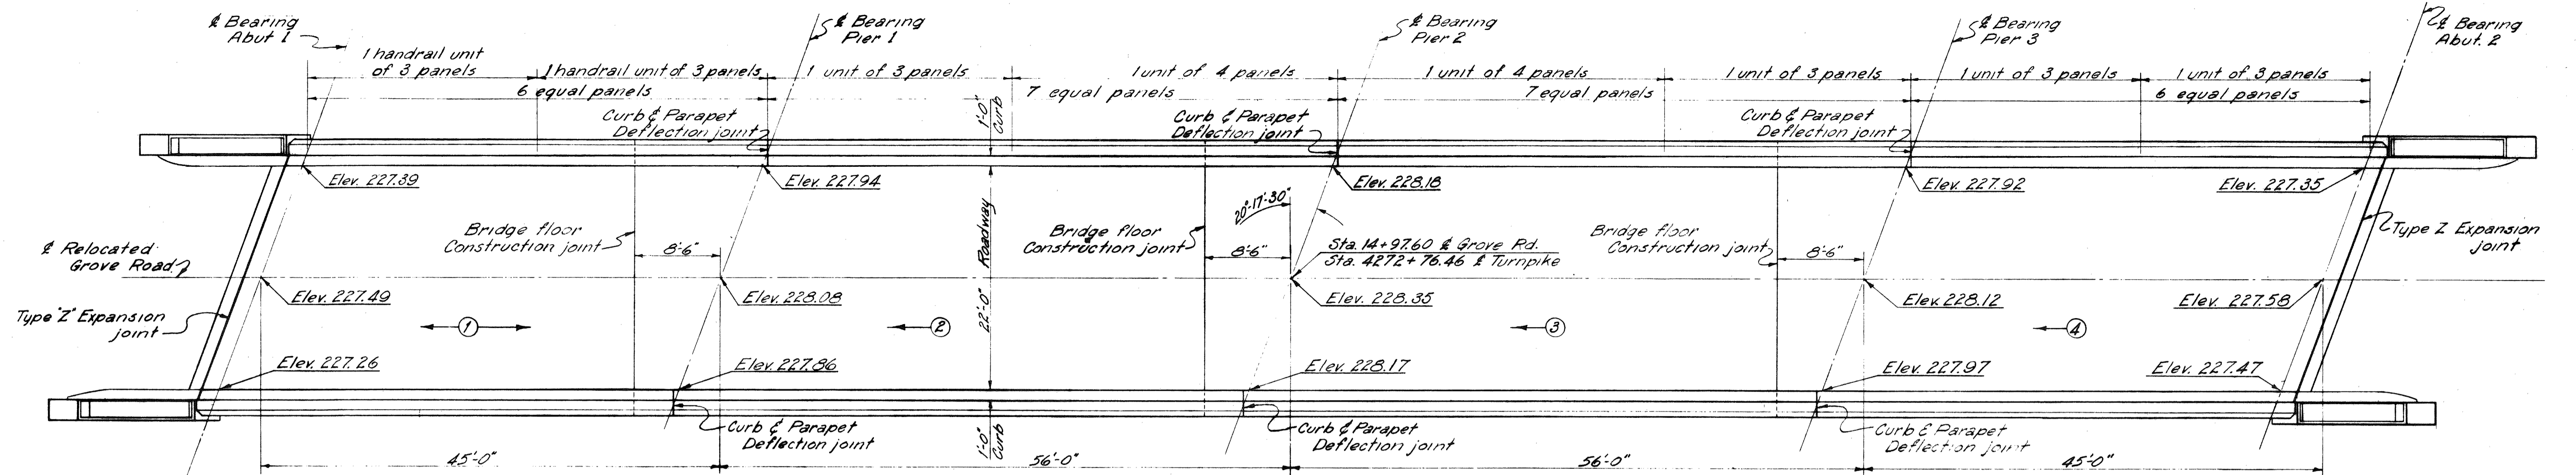


FLOOR PLAN

Note:- Elevations given are to top of Bridge Floor. Sequence and direction of pouring are noted thus: \rightarrow . Use a 7" Bridge Floor (non-composite) as shown on Standard Drawing No 14.

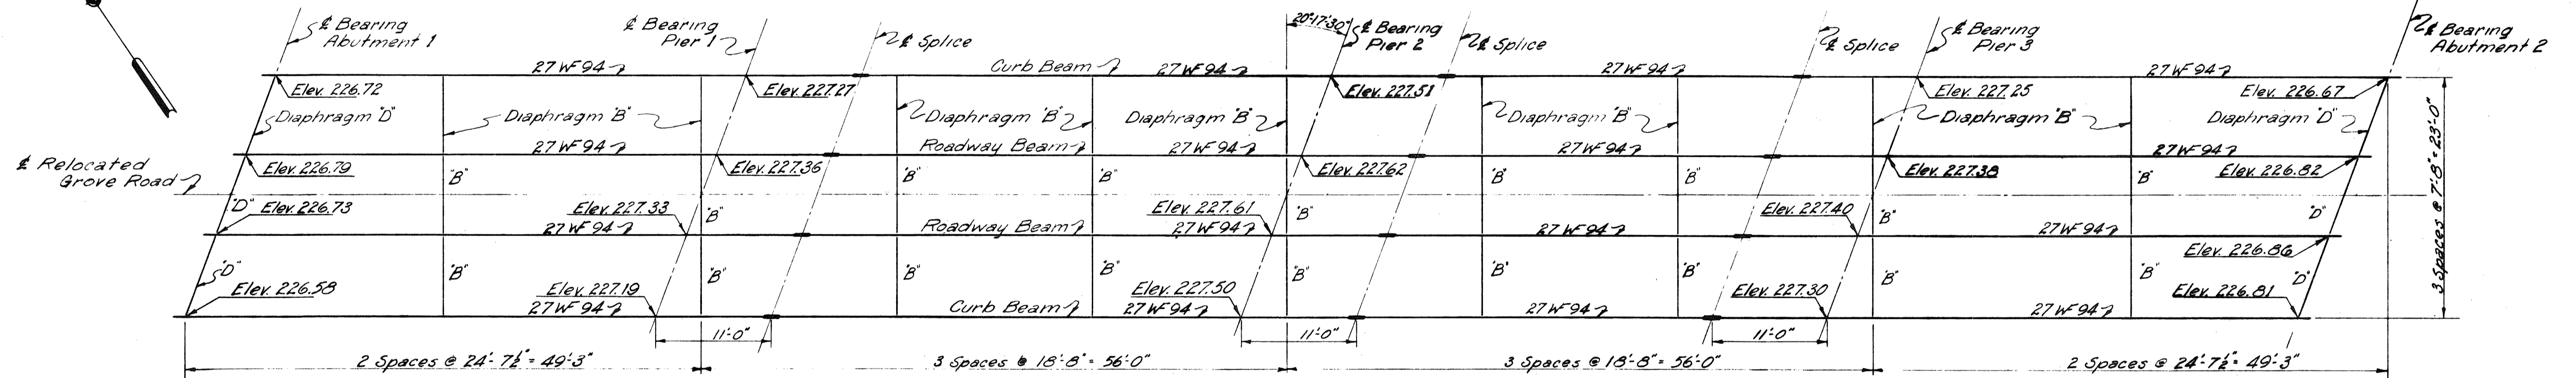


FRAMING PLAN

Note: Elevations given are to top of beam flanges.

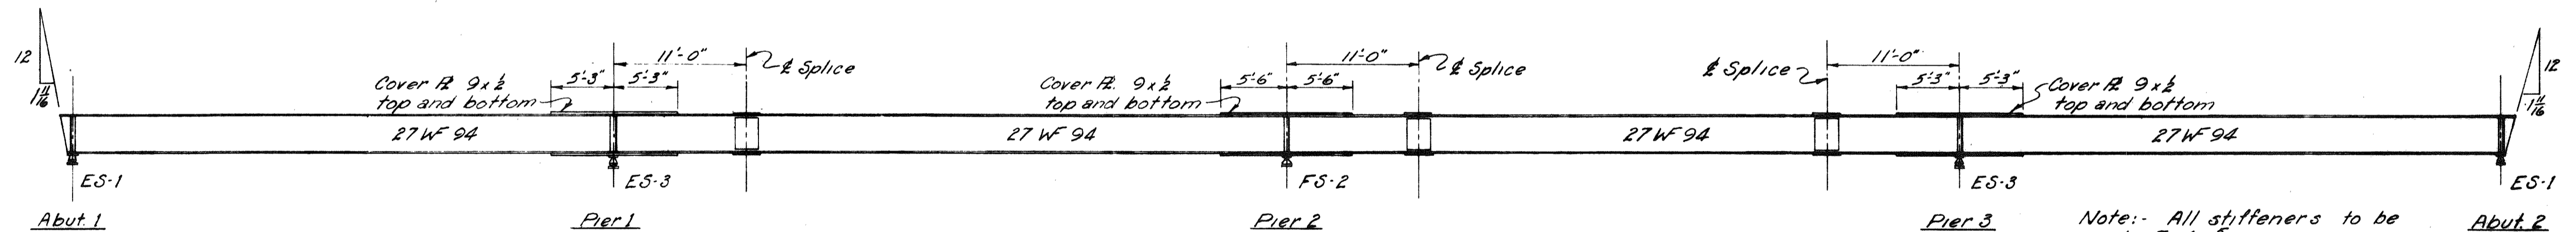

TYPICAL BEAM ELEVATION

Note:- All stiffeners to be Ls. 7x4x3/8. End slopes of beams are true with respect to the axis of the beam.

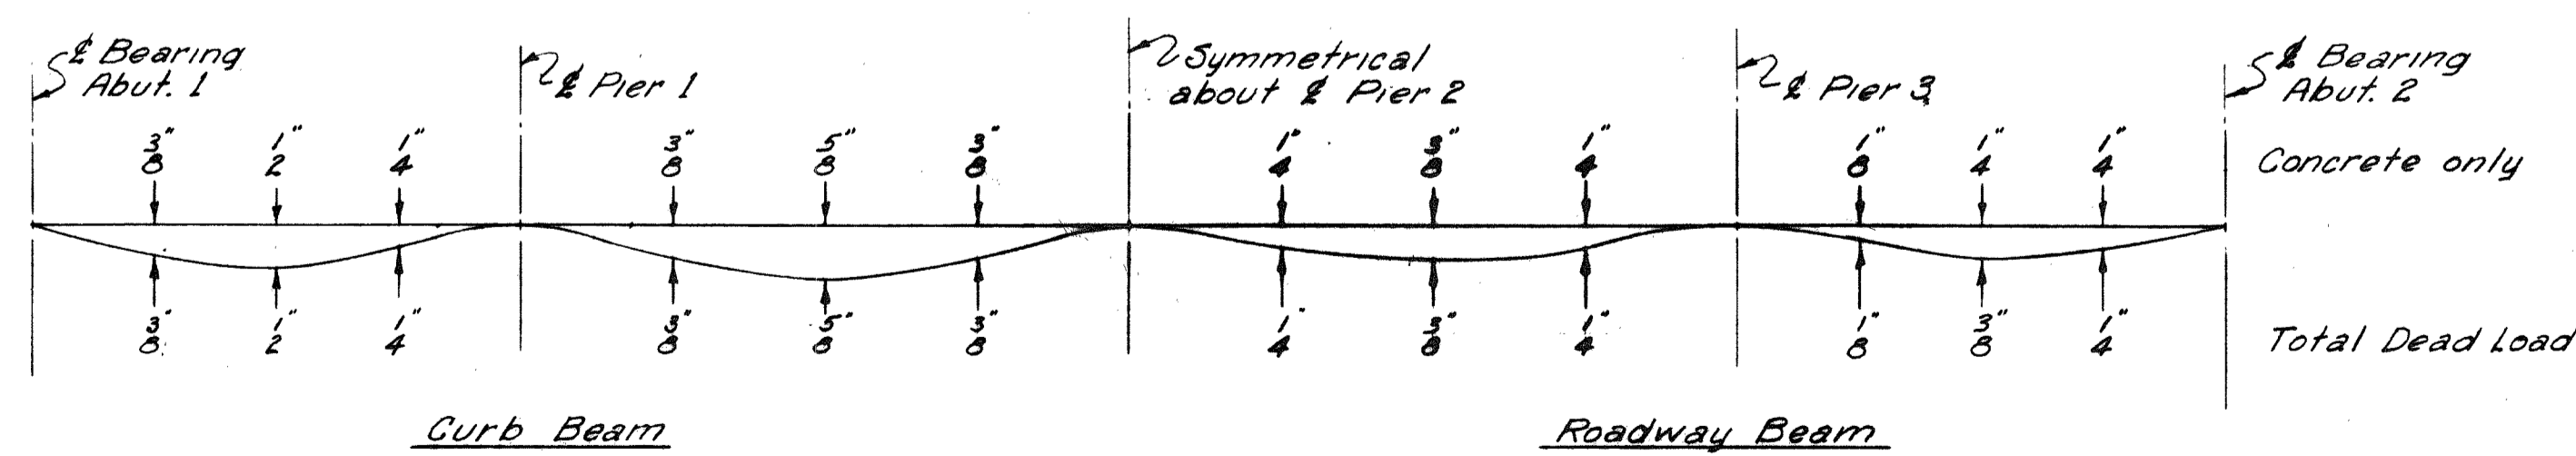

DEAD LOAD DEFLECTION DIAGRAM
Deflections shown at 4 points of spans
No scale

DRAWING 62.03.03					
BY	DATE				
MADE	DHL	1-22-54			
TRACED					
CHECKED	DDG	2-27-54	1	As-Built	MMW 2756
IN CHARGE OF	IOSK	No.	REVISION	BY	DATE

MAINE TURNPIKE AUTHORITY MAINE TURNPIKE SECTION 2- PORTLAND TO AUGUSTA	
STRUCTURE NO. 62	TURNPIKE UNDER
GROVE ROAD STA. 4272+76.46 SUPERSTRUCTURE	
HOWARD, NEEDLES, TAMMEN & BERGENDOFF CONSULTING ENGINEERS NEW YORK KANSAS CITY	SCALE: 1/8" = 1'-0" CONTRACT NO. _____ SHEET NO. 282 OF 382

SPECIFICATIONS

DESIGN

AASHTO STANDARD SPECIFICATIONS FOR HIGHWAY BRIDGES 1992 AND INTERIM SPECIFICATIONS 1994.

CONTRACT

STATE OF MAINE, DEPARTMENT OF TRANSPORTATION, STANDARD SPECIFICATIONS, HIGHWAY AND BRIDGES, REVISION OF OCTOBER 1990.

DESIGN LOADING

LIVE LOAD

H20, 500,000 CYCLES

DESIGN METHOD

LOAD FACTOR (SUPERSTRUCTURE ONLY)

MATERIALS

CONCRETE

SUPERSTRUCTURE SLAB CONCRETE SHALL BE CLASS AAA, f'c = 4,500 P.S.I.

ALL OTHER CONCRETE SHALL BE CLASS A, f'c = 4000 P.S.I.

REINFORCING STEEL

ASTM 615 GRADE 60, (ALL BARS EPOXY-COATED)

STRUCTURAL STEEL

EXISTING STRUCTURAL STEEL IS ASTM A7, GRADE 33

GENERAL NOTES

1. PLANS OF EXISTING BRIDGES ARE AVAILABLE AT THE AUTHORITY'S OFFICE AT 430 RIVERSIDE ST., PORTLAND, MAINE.
2. SHIELDING REQUIRED DURING CONCRETE REMOVAL SHALL NOT PROJECT BELOW THE BOTTOM FLANGES OF STRINGERS. THE ESTIMATED QUANTITY OF SHIELDING IS THE MINIMUM REQUIRED AND IS BASED ON THE FOLLOWING LIMITS:
 - A. NORMAL TO & BRIDGE: AS SHOWN ON THE PLANS
 - B. PARALLEL TO & BRIDGE: ABUTMENT TO ABUTMENT
3. THE AUTHORITY'S PERSONNEL WILL PROFILE THE TOPS OF ALL STRINGERS BEFORE THE FORM WORK IS STARTED AND SUPPLY THE CONTRACTOR WITH FINAL BOTTOM OF SLAB ELEVATIONS.
4. REINFORCING STEEL SHALL HAVE A CLEAR COVER OF 2" UNLESS OTHERWISE NOTED.
5. ALL STEEL REINFORCING SHALL BE EPOXY COATED. FOR STEEL REINFORCING SCHEDULE, SEE SHEET GR-17.
6. THE CONCRETE DECK SURFACE SHALL BE GIVEN A SMOOTH BULL FLOAT OR WOOD FLOAT FINISH.
7. CHAMFER ALL EXPOSED CONCRETE EDGES 3/4", UNLESS OTHERWISE NOTED.
8. THE BEARING DIMENSIONS SHOWN ON THE BEARING DETAIL SHEET AND THE CORRESPONDING BRIDGE SEAT ELEVATIONS SHOWN ON THE ABUTMENT AND PIER SHEETS ARE BASED ON POT BEARINGS MANUFACTURED BY SAI/SPENSER OF TERRYVILLE CT. IF THE CONTRACTOR SELECTS A BEARING FROM ANOTHER APPROVED BEARING MANUFACTURER, AFFECTED DETAILS AND ELEVATIONS SHALL BE ADJUSTED TO ACCOMMODATE THE SELECTED BEARINGS.


ITEM	DESCRIPTION	UNIT	QUANTITIES
202.12	REMOVING EXISTING STRUCTURAL CONCRETE	C.Y.	25
202.122	REMOVING EXISTING SUPERSTRUCTURE CONCRETE	S.Y.	615
203.20	COMMON EXCAVATION	C.Y.	15
203.25	GRANULAR BORROW	C.Y.	15
403.13	DENSE GRADED BITUMINOUS PAVEMENT FOR BRIDGES	TON	55
502.21	STRUCTURAL CONCRETE, ABUTMENTS AND RETAINING WALLS	C.Y.	30
502.231	STRUCTURAL CONCRETE PIERS-GROVE ROAD	C.Y.	15
502.262	STRUCTURAL CONCRETE ROADWAY AND PARAPETS ON STEEL BRIDGES-GROVE ROAD	L.S.	1
503.14	EPOXY-COATED REINFORCING STEEL, FABRICATED AND DELIVERED	LB.	54,000
503.15	EPOXY-COATED REINFORCING STEEL, PLACING	LB.	54,000
504.721	JACKING EXISTING SUPERSTRUCTURE-GROVE ROAD	L.S.	1
505.092	STUD WELDED SHEAR CONNECTORS-GROVE ROAD	L.S.	1
507.092	ALUMINUM BRIDGE RAILING, 2 BAR	L.F.	414
508.132	MEMBRANE WATERPROOFING-GROVE ROAD	L.S.	1
514.06	CURING BOX FOR CONCRETE CYLINDERS	EA.	1
515.20	PROTECTIVE COATING FOR CONCRETE SURFACE	S.Y.	380
515.201	PIGMENTED CONCRETE PROTECTIVE COATING	S.Y.	460
520.21	EXPANSION DEVICE - GLAND SEAL	EA.	2
523.103	POT BEARINGS	EA.	20
524.40	PROTECTIVE SHIELD	S.Y.	740
606.172	TEMPORARY STEEL GUARDRAIL	L.F.	230
609.15	SLOPED CURB TYPE 1	L.F.	466

INDEX OF DRAWINGS

SHEET NO.	TITLE
GR-1	SPECIFICATIONS, GENERAL NOTES AND QUANTITIES
GR-2	GENERAL PLAN AND ELEVATION
GR-3	SEQUENCE OF CONSTRUCTION
GR-4	ABUTMENT 1 MODIFICATIONS
GR-5	ABUTMENT 2 MODIFICATIONS
GR-6	WINGWALL MODIFICATIONS I
GR-7	WINGWALL MODIFICATIONS II
GR-8	PIER MODIFICATIONS
GR-9	FRAMING PLAN AND STRINGER ELEVATION
GR-10	POT BEARING DETAILS
GR-11	DECK PLAN AND TYPICAL SECTION
GR-12	SLAB DETAILS I
GR-13	SLAB DETAILS II
GR-14	EXPANSION JOINT DETAILS I
GR-15	EXPANSION JOINT DETAILS II
GR-16	ALUMINUM BRIDGE RAIL DETAILS
GR-17	REINFORCING SCHEDULE

STANDARD DETAIL SHEETS


SHEET NO.	TITLE
BD 201-89	2-BAR CONCRETE END POST

Maine Turnpike Authority
Maine Turnpike

 GROVE ROAD UNDERPASS
 SPECIFICATIONS,
 GENERAL NOTES
 AND QUANTITIES
HNTB HOWARD NEEDLES TAMMEN & BERGENDOFF
 ARCHITECTS ENGINEERS PLANNERS


Designed	SHR 2/95	By	Date
Drawn	LMR 2/95		
Checked	SHR 2/95		
No.	Revision	By	Date
		In Charge Of	RAL

Contract	95.11	Sheet No.	GR-1
		48	of 65

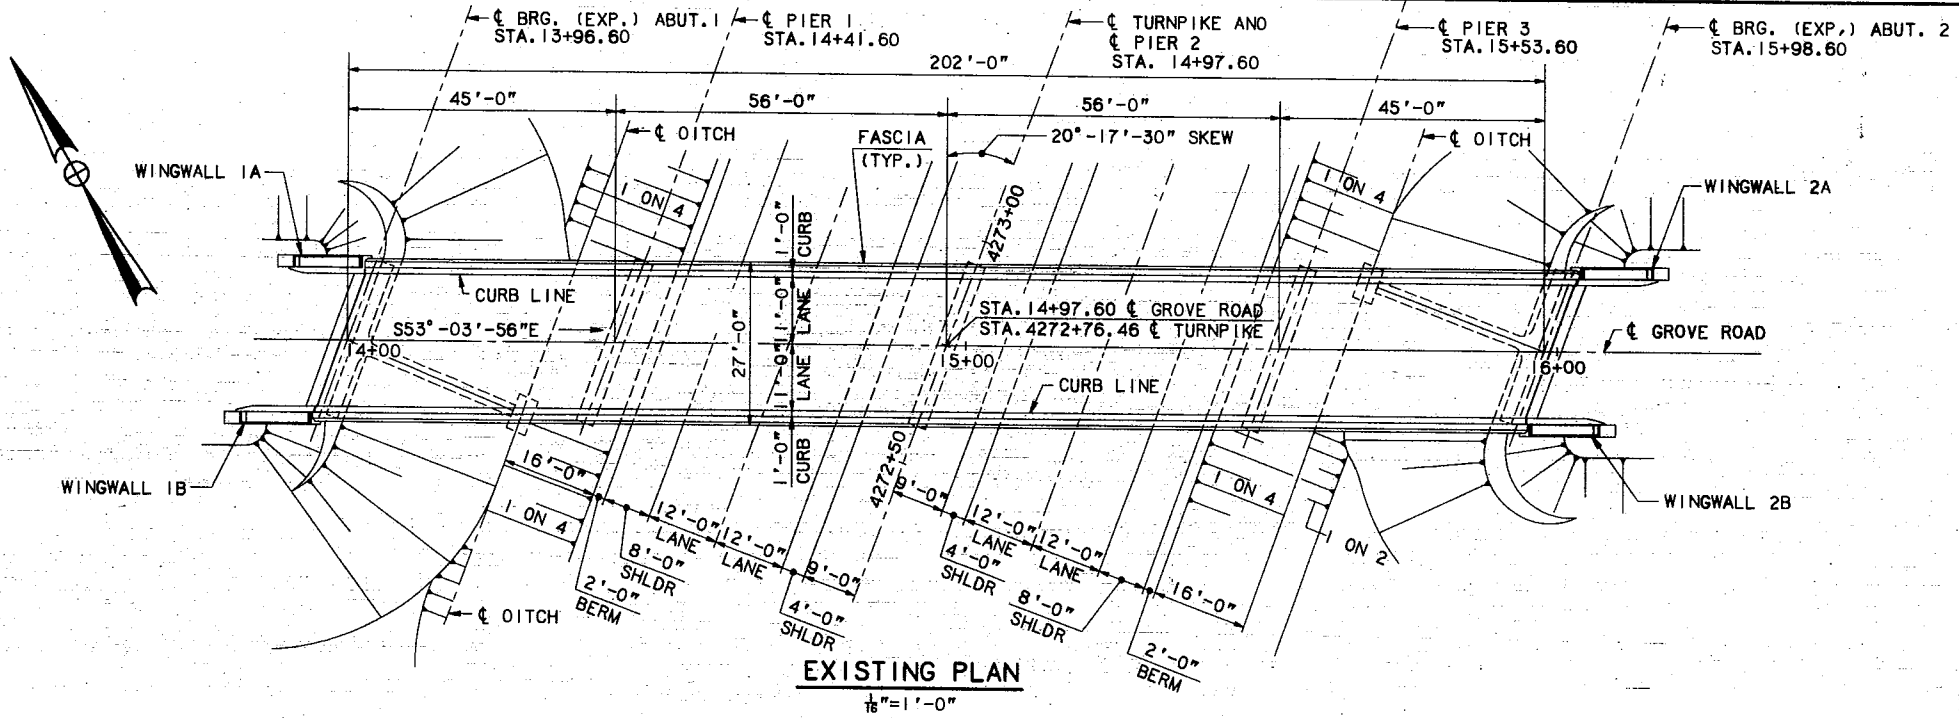
MAINE 117K




EXISTING PLAN
1/8" = 1'-0"

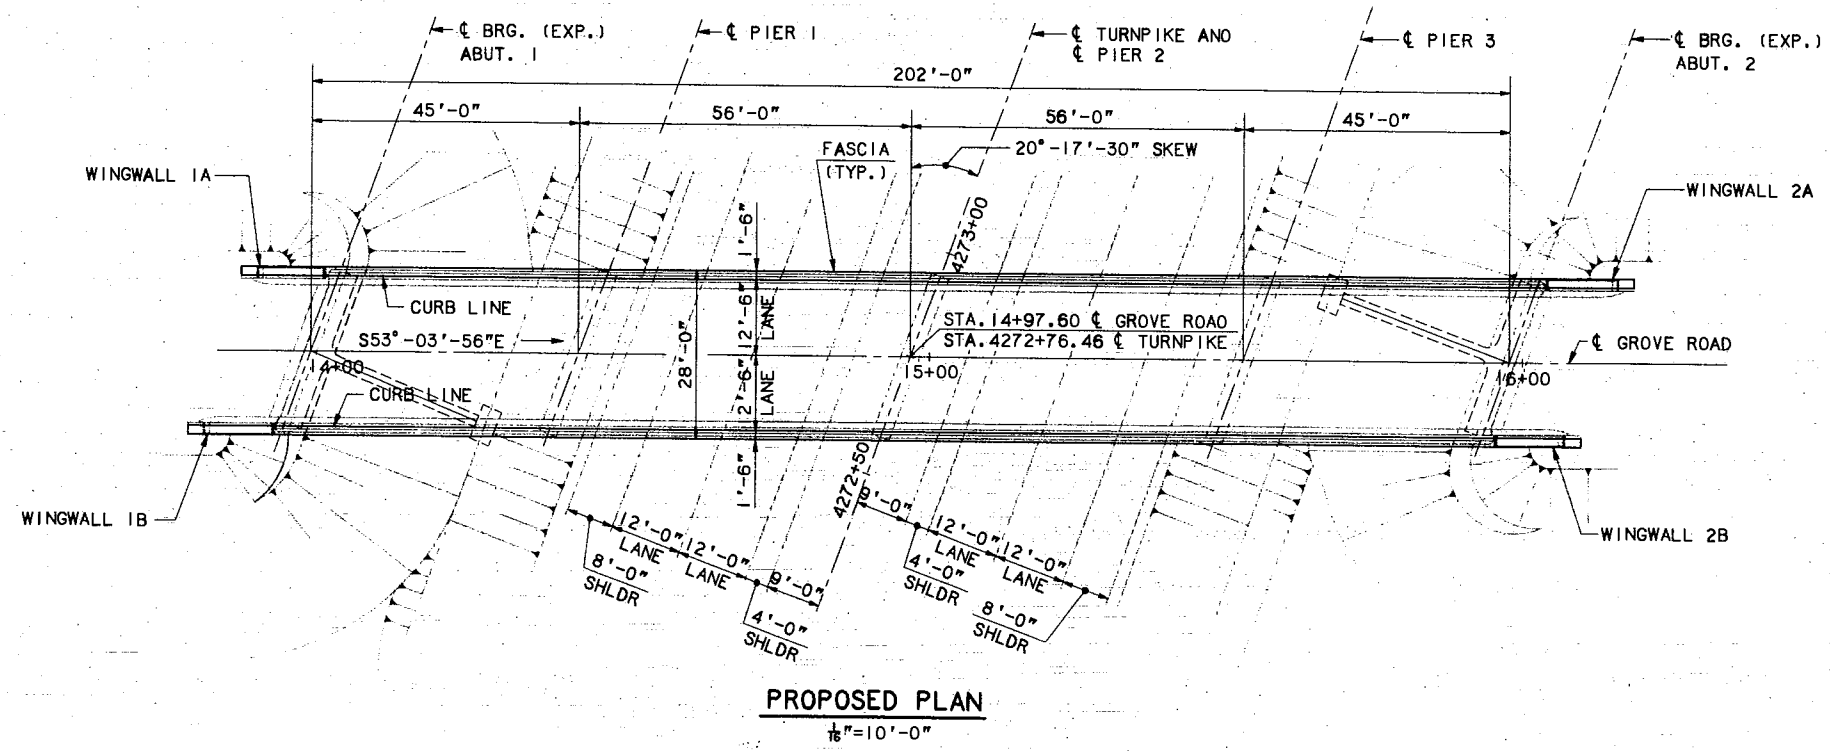

PROPOSED PLAN
1/8" = 10'-0"

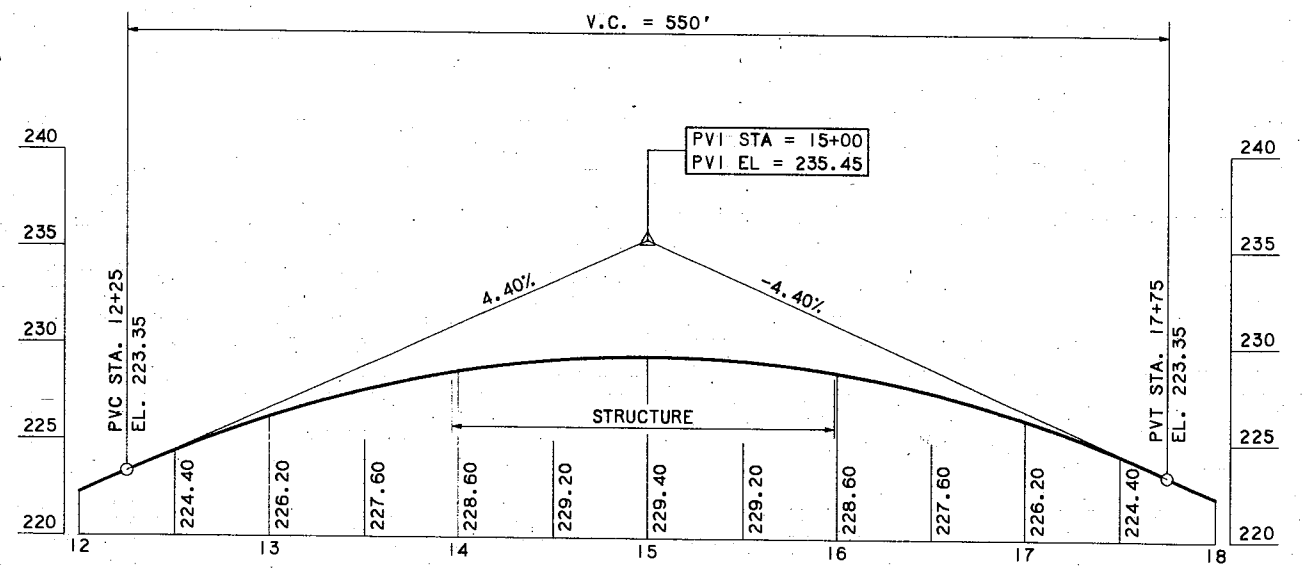

PROPOSED PROFILE
HORIZ. 1" = 50'
VERT. 1" = 5'

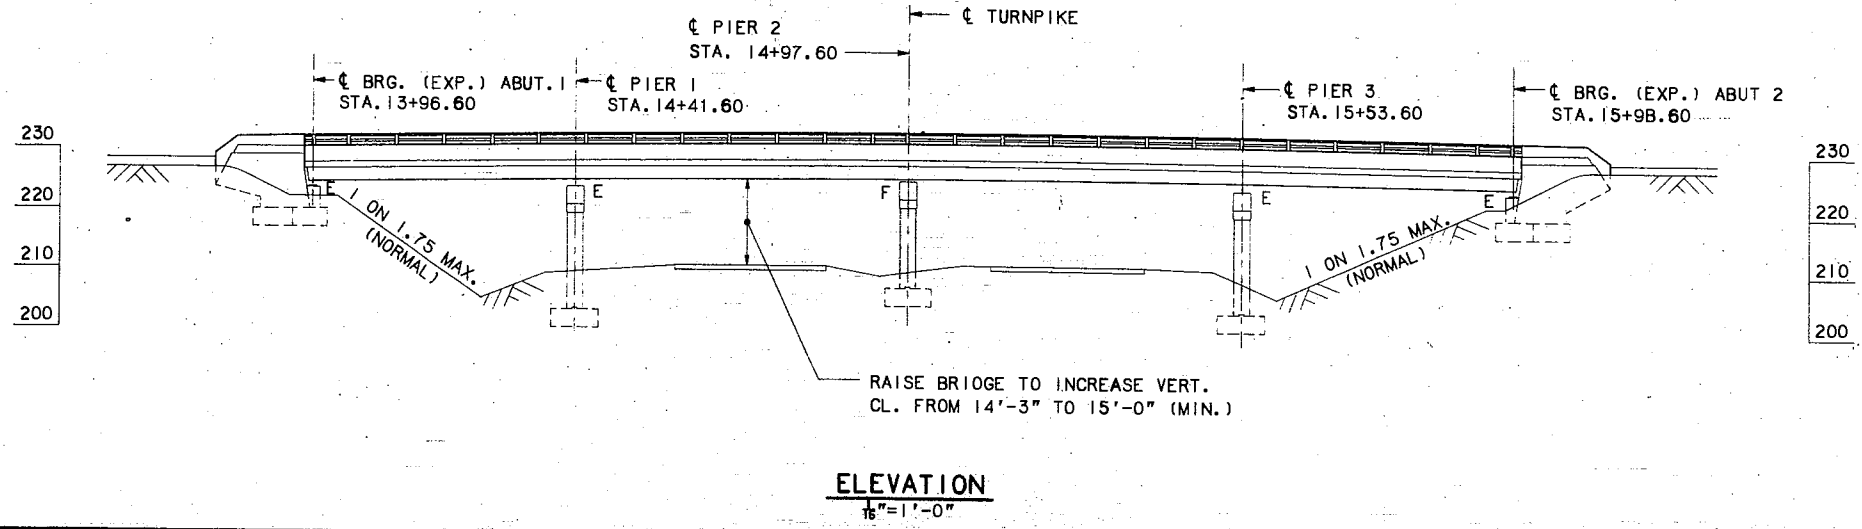

ELEVATION
1/8" = 1'-0"


Maine Turnpike Authority
Maine Turnpike

GROVE ROAD UNDERPASS
GENERAL PLAN AND ELEVATION


HNTB HOWARD NEEDLES TAMMEN & BERGENDOFF
ARCHITECTS ENGINEERS PLANNERS

No.	Revision	By:	Date:	In charge of:	RAL
		Designed	GPM 1/95		
		Drawn	LS 1/95		
		Checked	HNL 1/95		

Contract 95.11 Sheet No. GR-2
49 of 65

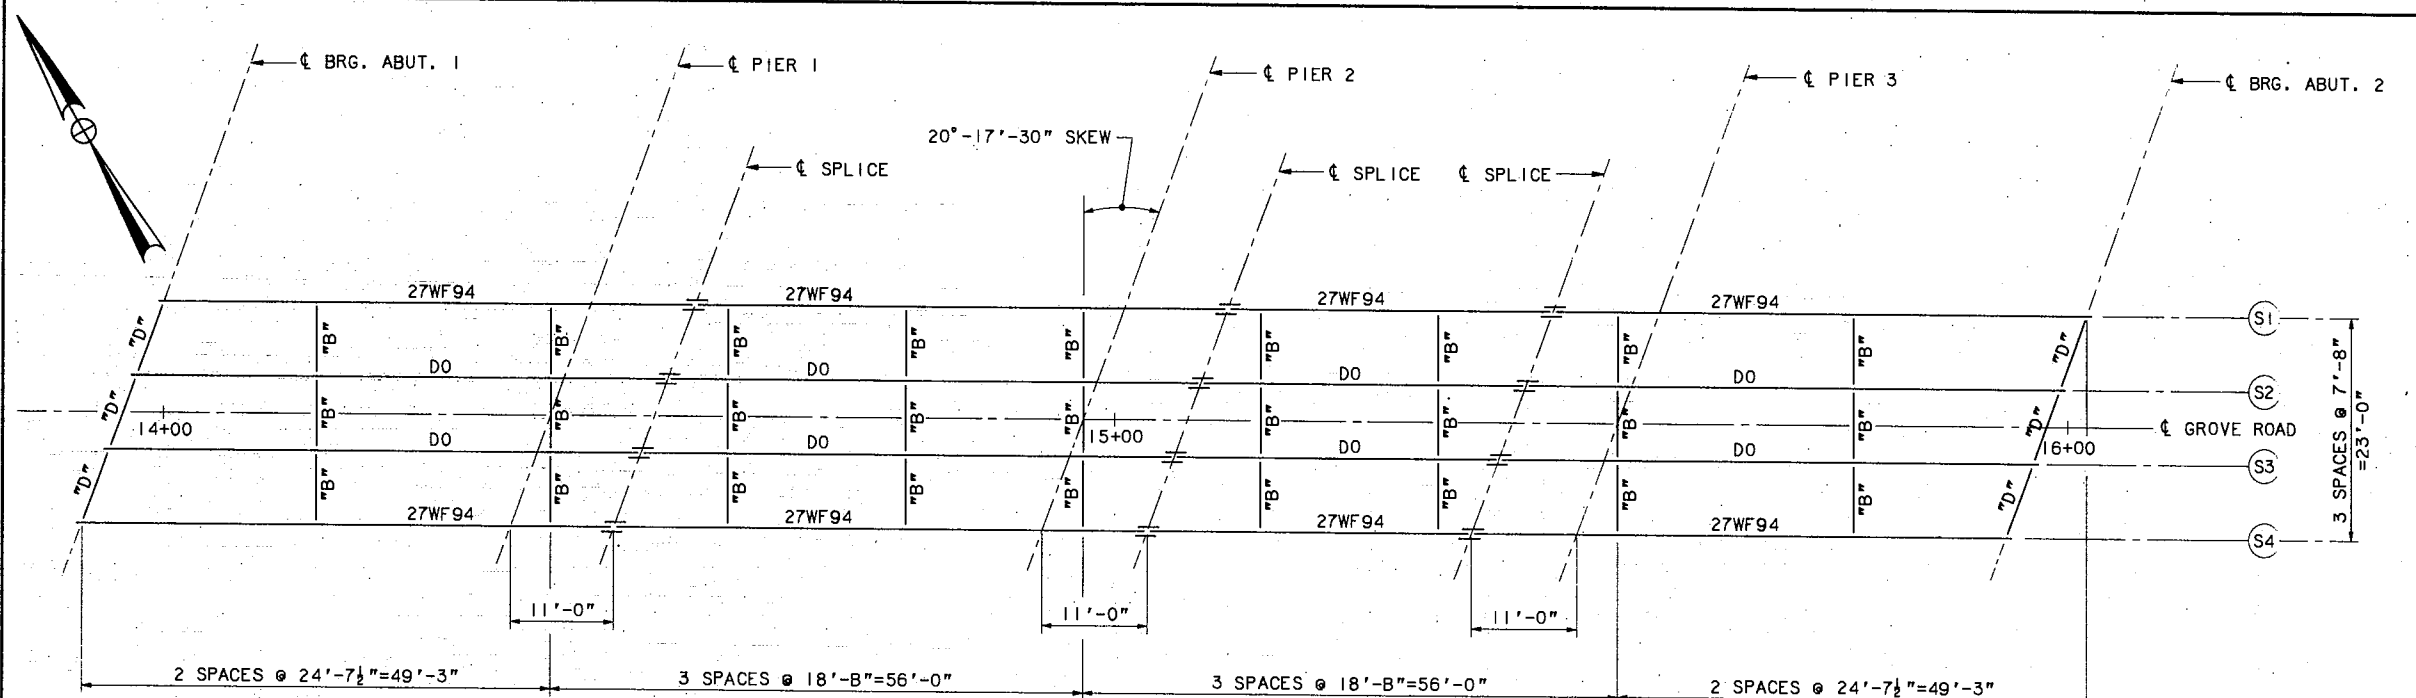


FRAMING PLAN (EXISTING)
1" = 10'-0"

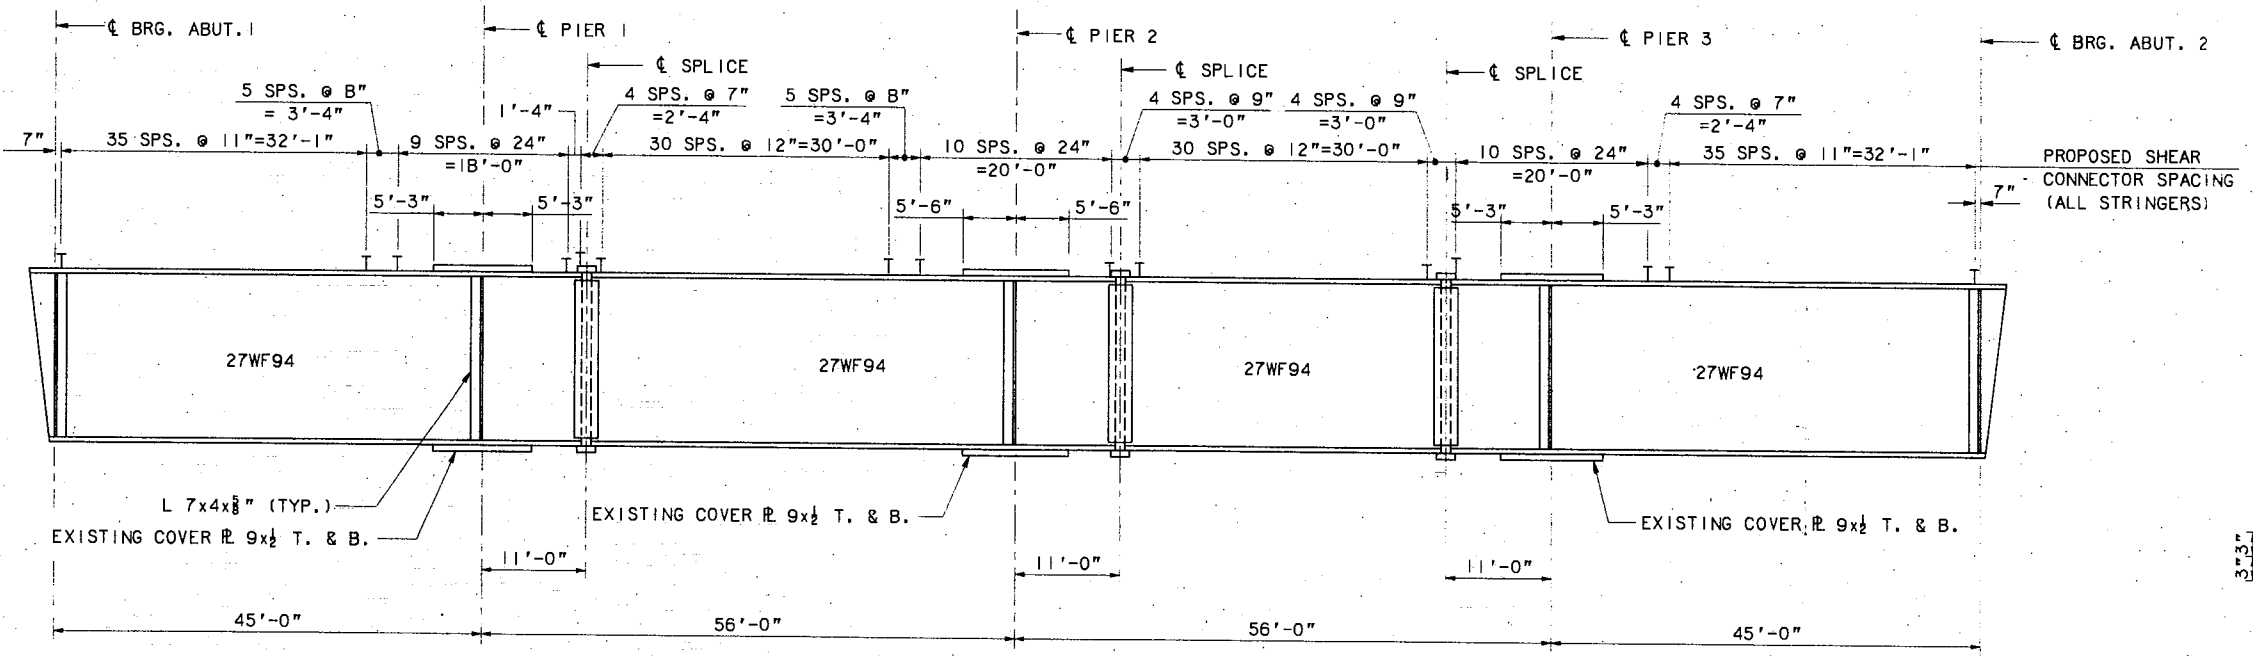


STRINGER ELEVATION (EXISTING)
NO SCALE

NOTES


- EXISTING DIAPHRAGMS ARE CONNECTED TO THE STRINGERS WITH THE USE OF BOLTS AND/OR RIVETS. ALL BOLTS AND RIVETS WHICH ARE REMOVED TO JACK THE SUPERSTRUCTURE SHALL BE REPLACED WITH NEW 3/4" A-325 BOLTS, H.S. NUTS AND WASHERS, WHICH SHALL BE INCIDENTAL TO ITEM 504.721.
- PROPOSED SHEAR CONNECTORS ARE SHOWN ON THE EXISTING STRINGER ELEVATIONS. SHEAR CONNECTORS ARE PAID FOR UNDER ITEM 505.092.

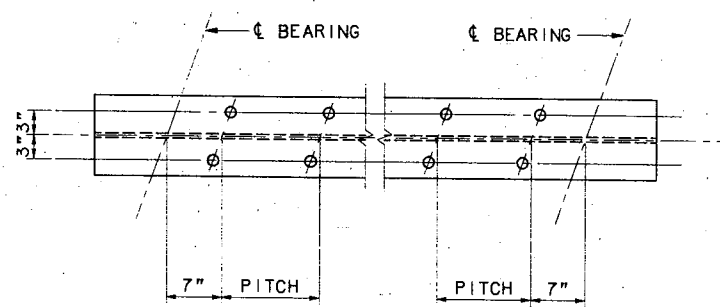


SHEAR CONNECTOR LAYOUT
1" = 1'-0"

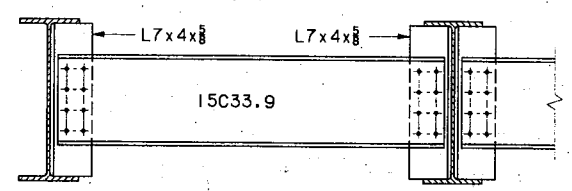

DIAPHRAGM TYPE B (EXISTING)
3/4" = 1'-0"

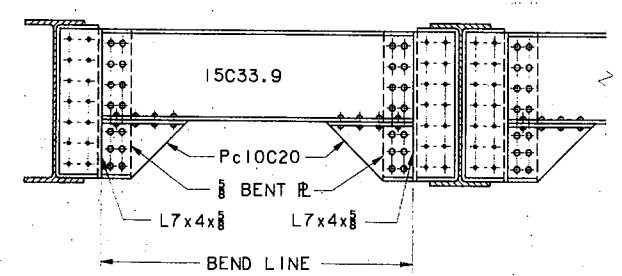

DIAPHRAGM TYPE D (EXISTING)
3/4" = 1'-0"

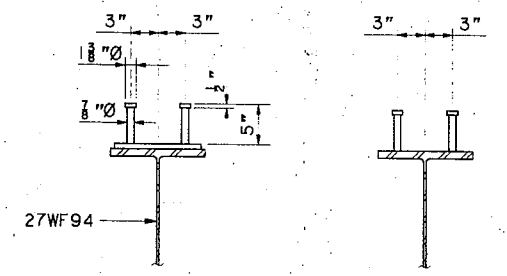

PROPOSED SHEAR CONNECTOR DETAIL
1" = 1'-0"


No.	Revision	By:	Date:	In charge of:
		Designed	GPM 1/95	
		Drawn	LS 1/95	
		Checked	HNL 1/95	
				RAL

Maine Turnpike Authority
Maine Turnpike


GROVE ROAD UNDERPASS
FRAMING PLAN AND STRINGER ELEVATION

HNTB HOWARD NEEDLES TAMMEN & BERGENDOFF ARCHITECTS ENGINEERS PLANNERS


Contract 95.11 Sheet No. **GR-9**
56 of 65

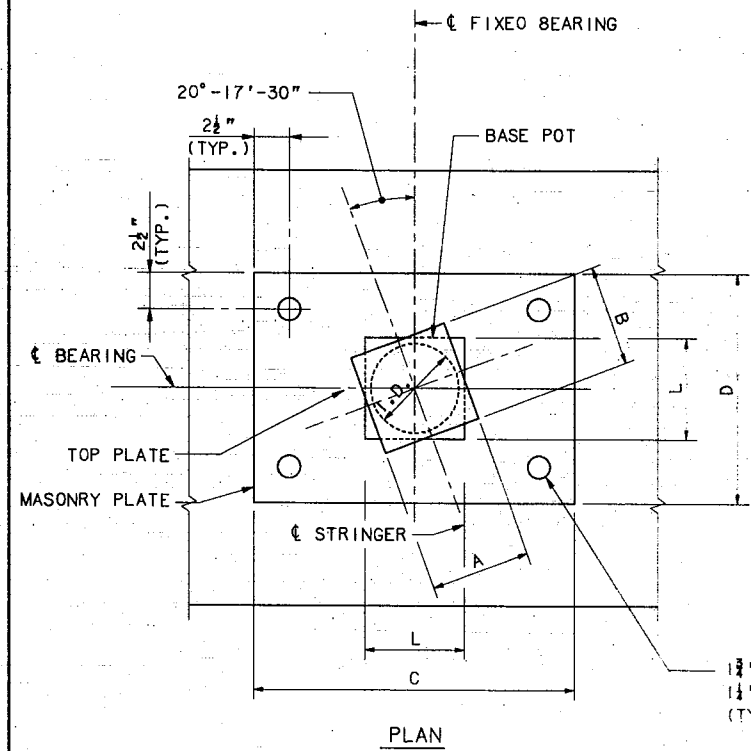


PLAN

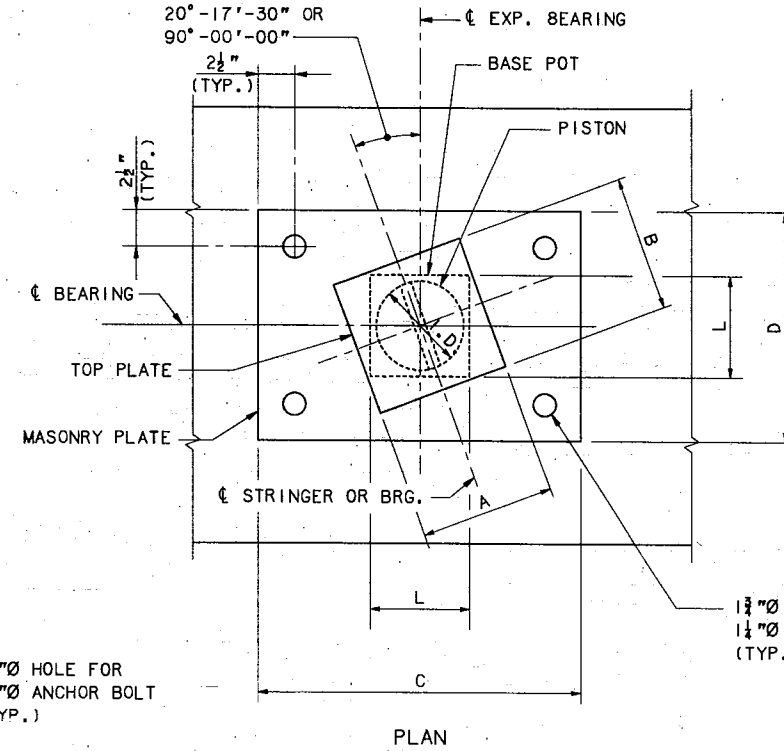

PLAN

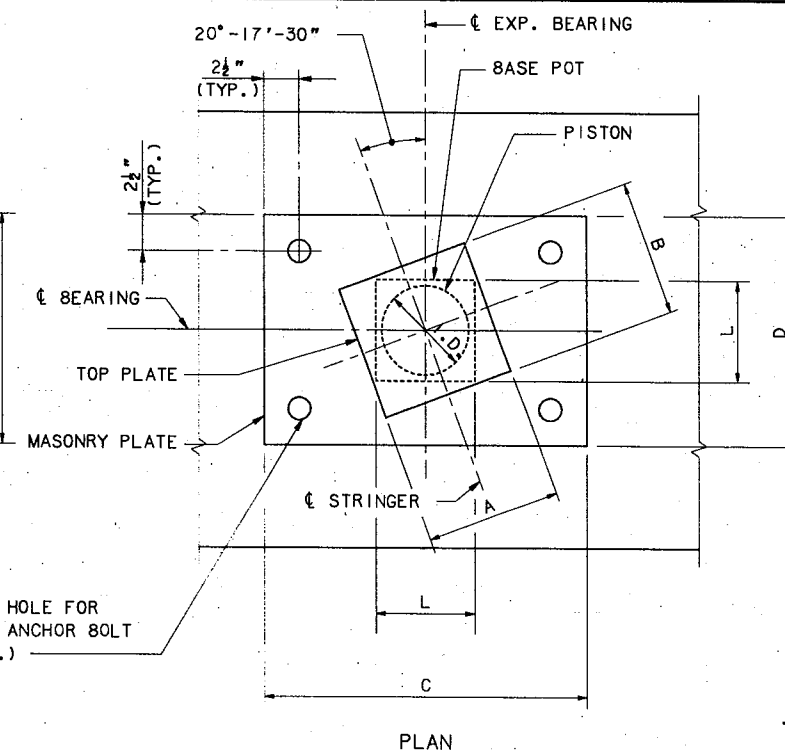


PLAN

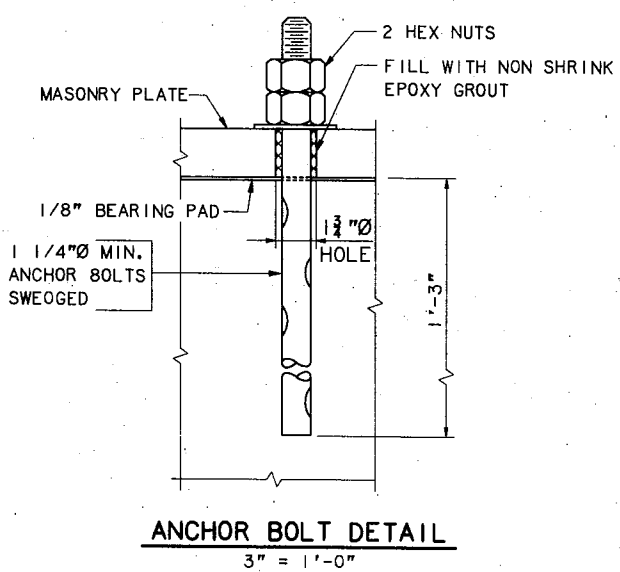

ANCHOR BOLT DETAIL
3" = 1'-0"


BEARING DEVICE NOTES

1. THE BEARING DIMENSIONS SHOWN ON THIS SHEET AND THE CORRESPONDING BRIDGE SEAT ELEVATIONS ARE BASED ON GUIDED EXPANSION & FIXED BEARINGS MANUFACTURED BY SAI/SPENCER OF TERRYVILLE CT. IF THE CONTRACTOR SELECTS A BEARING FROM ANOTHER APPROVED BEARING MANUFACTURER, AFFECTED DETAILS AND ELEVATIONS SHALL BE ADJUSTED TO ACCOMMODATE THE SELECTED BEARINGS.
2. ALL DIMENSIONS ARE IN INCHES.
3. CONTRACTOR SHALL SUBMIT SHOP DRAWINGS FOR APPROVAL.
4. ALL STEEL FOR THE BEARING DEVICES ASSEMBLIES SHALL BE ASTM A709, GRADE 36, UNLESS NOTED OTHERWISE.
5. MASONRY BASE PLATES SHALL BE PLACED ON 1/8" PREFORMED FABRIC PAD.
6. TOP PLATES AND PISTONS SHALL HAVE MACHINED SURFACES TO FINISH ANSI 12S.
7. STAINLESS STEEL SHALL CONFORM TO THE REQUIREMENTS OF ASTM A 167, TYPE 317 OR ASTM A 240, TYPE 317. STAINLESS STEEL IN CONTACT WITH PTFE SHEET SHALL BE POLISHED TO A BRIGHT MIRROR FINISH (NO. 8), LESS THAN 5 MICRO-INCHES ROOT MEAN SQUARE.
8. THE 1 1/4" ANCHOR BOLTS AND NUTS SHALL BE A307. WASHERS SHALL CONFORM TO REQUIREMENTS OF AASHTO M293 (ASTM F4361). WASHERS AND NUTS SHALL BE GALVANIZED.
9. PTFE INDICATES POLYTETRAFLUORETHYLENE.
10. ANCHOR BOLT SPACING SHALL BE COORDINATED WITH THE BEARING MANUFACTURER.

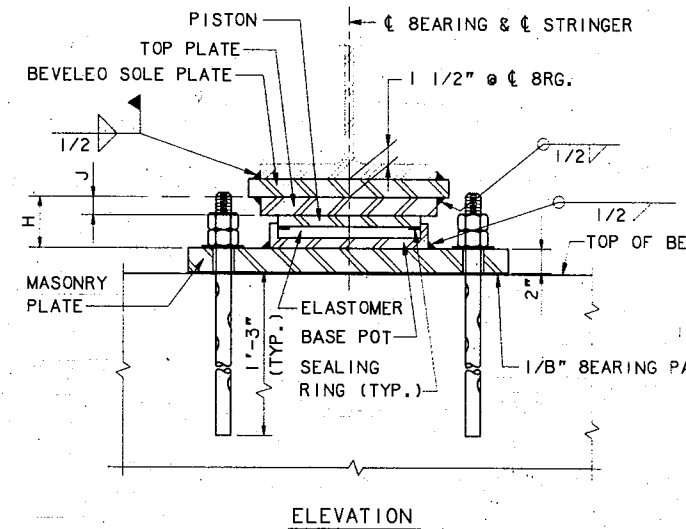


ELEVATION

FIXED BEARING
1 1/2" = 1'-0"

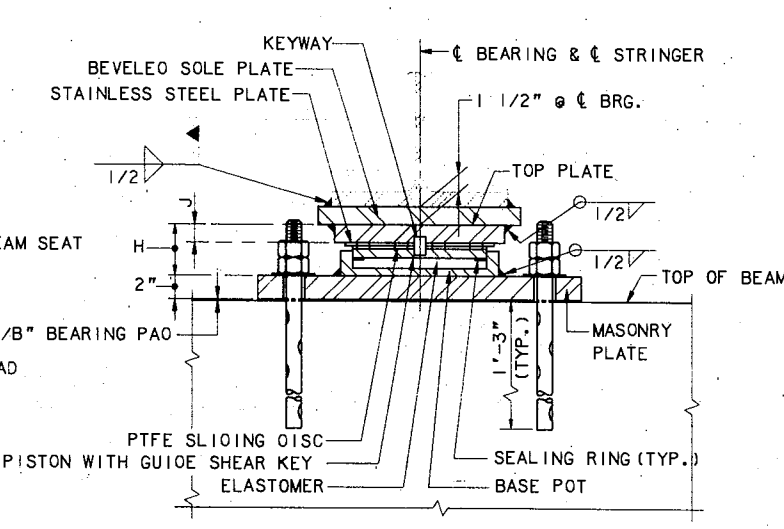

ELEVATION

GUIDED EXPANSION BEARING
1 1/2" = 1'-0"

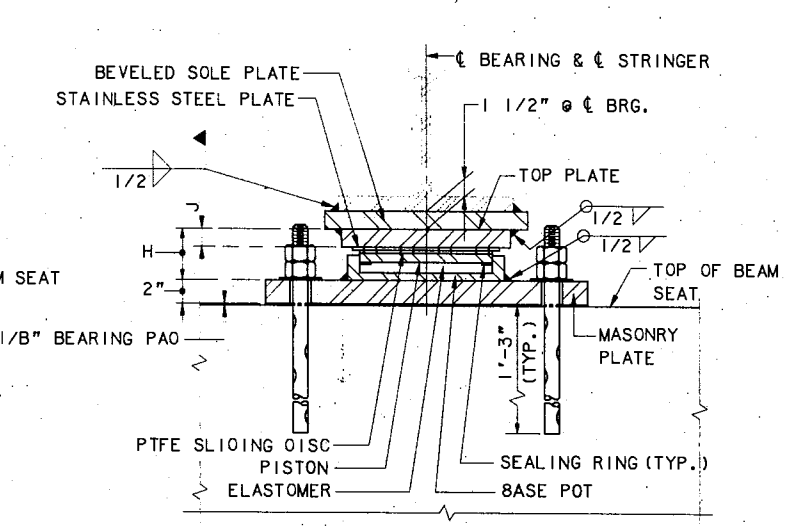


ELEVATION

NON-GUIDED EXPANSION BEARING
1 1/2" = 1'-0"

MAXIMUM LOADS ON EACH BEARING									
LOCATION	STRINGER	O.L. (KIPS)	L.L. (KIPS)	TOTAL (KIPS)	HORIZ. FORCE (KIPS)		MOVEMENT (IN)		BEARING TYPE
					LONG.	TRANS.	LONG.	TRANS.	
ABUTMENT 1	S1, S4	21	33	S4	-	-	5/8	-	NGE1
	S2, S3	21	37	S8	-	5	5/8	-	GE1
PIER 1	S1, S4	70	S3	123	-	-	3/8	-	NGE2
	S2, S3	70	S8	128	-	10	3/8	-	GE2
PIER 2	S1, S4	70	S4	124	4	-	-	-	GE2
	S2, S3	70	S8	128	4	11	-	-	F1
PIER 3	S1, S4	70	S3	123	-	-	3/8	-	NGE2
	S2, S3	70	S8	128	-	10	3/8	-	GE2
ABUTMENT 2	S1, S4	21	33	S4	-	-	5/8	-	NGE1
	S2, S3	21	37	S8	-	5	5/8	-	GE1

BEARING TYPE	MAX VERT. LOAD (KIP)	DIMENSIONS						SOLE PLATE		MASONRY PLATE	
		I.D.	A	B	H	J	L	C	O	2" THICK	
GE1	100	6.03	9.75	10.00	2.63	0.75	6.75	14x14x1 1/2	27	19	
GE2	150	7.38	11.25	11.25	2.63	0.75	8.38	14x14x1 1/2	27	17 or 19	
F1	150	7.38	8.38	8.38	2.50	0.75	8.38	14x14x1 1/2	27	17	
NGE1	100	6.03	10.00	10.00	2.63	0.75	6.75	14x14x1 1/2	27	19	
NGE2	150	7.38	11.25	11.25	2.63	0.75	8.38	14x14x1 1/2	27	19	

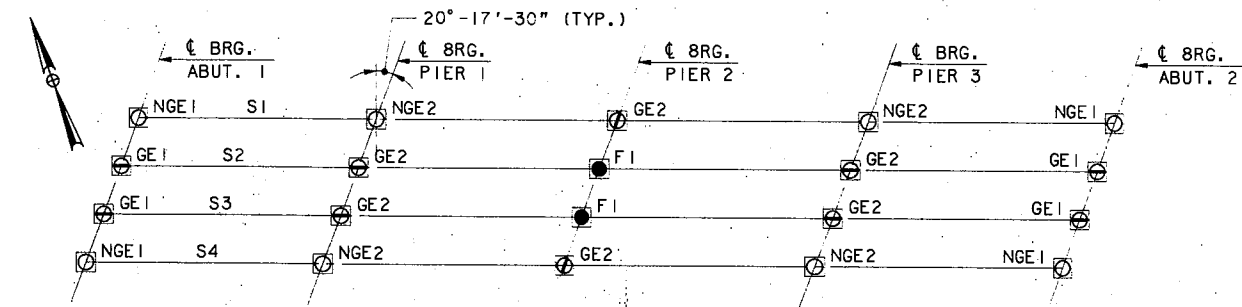

POT BEARING ALIGNMENT PLAN
NO SCALE

- LEGEND**
- - FIXED
 - - GUIDED LONGITUDINAL EXP.
 - - GUIDED TRANSVERSE EXP.
 - - NON-GUIDED EXPANSION

No.	Revision	By:	Date:	In charge of:	RAL


Maine Turnpike Authority
Maine Turnpike

GROVE ROAD UNDERPASS
POT BEARING DETAILS


HOWARD NEEDLES TAMMEN & BERGENDOFF
ARCHITECTS ENGINEERS PLANNERS

Contract 95.11 Sheet No. **GR-10**
57 of 65

Designed: GPM 1/95
Drawn: LS 1/95
Checked: HNL 1/95

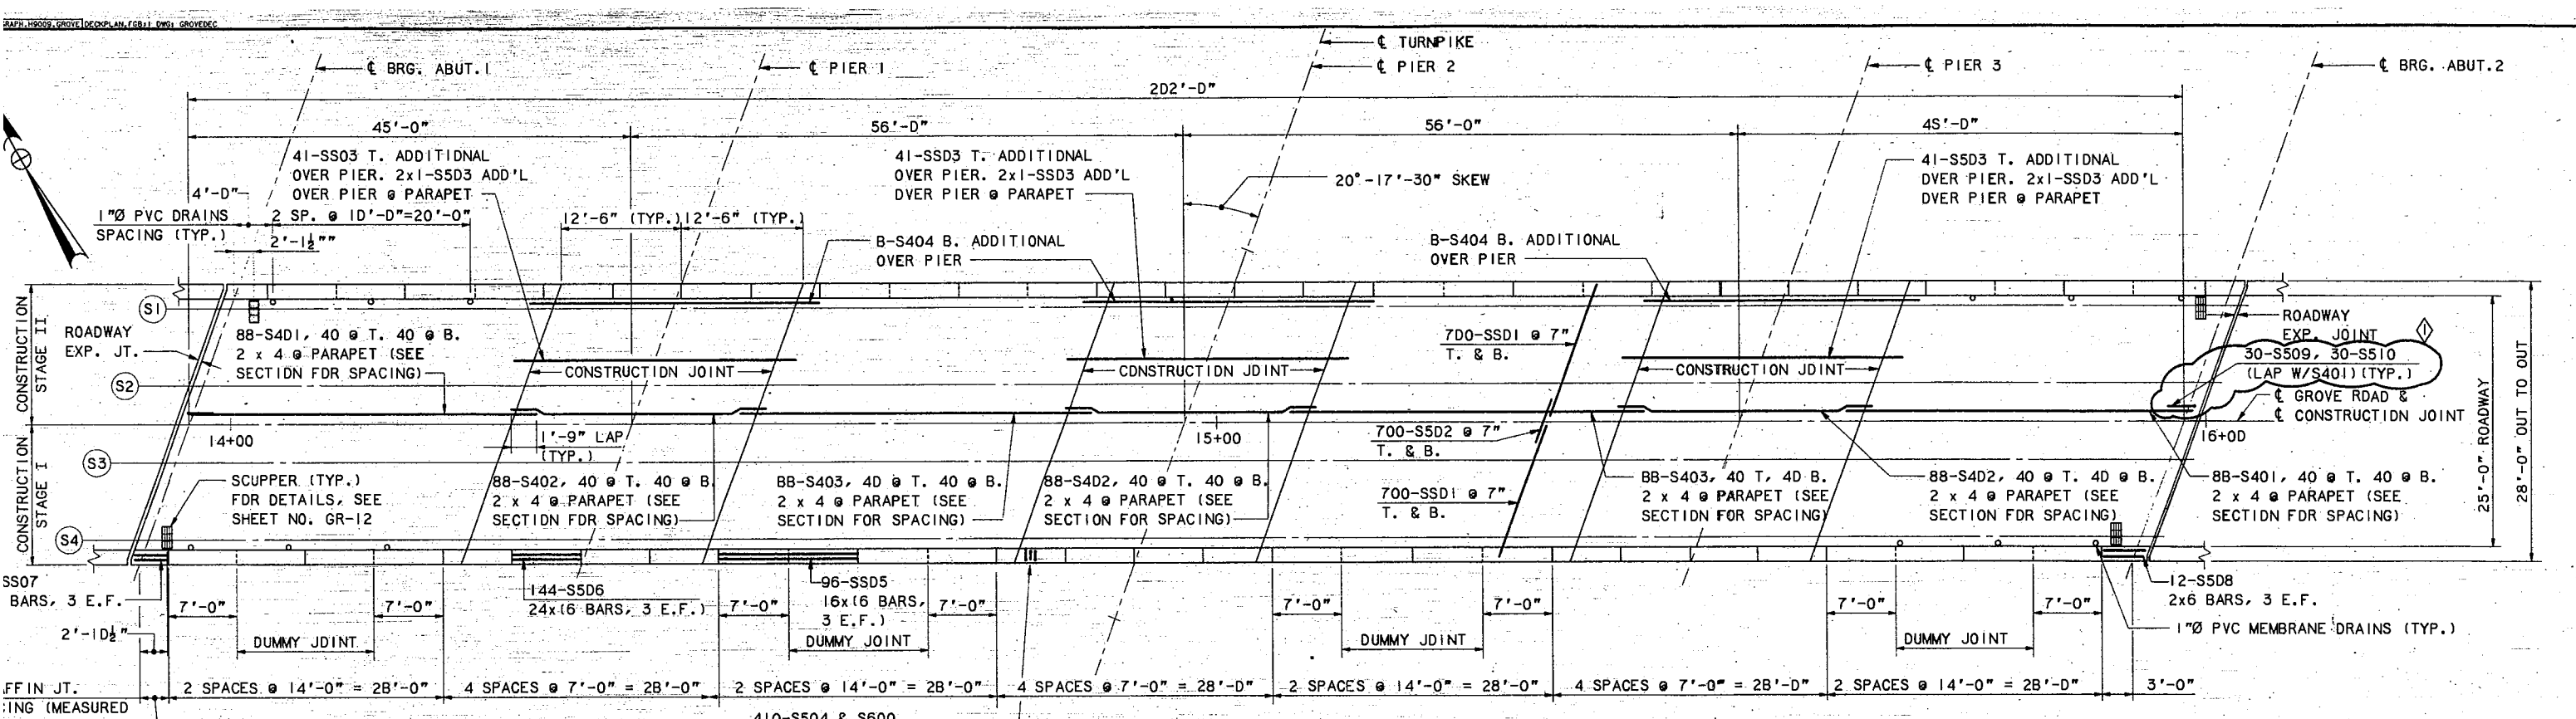


DECK PLAN
1/2" = 1'-0"

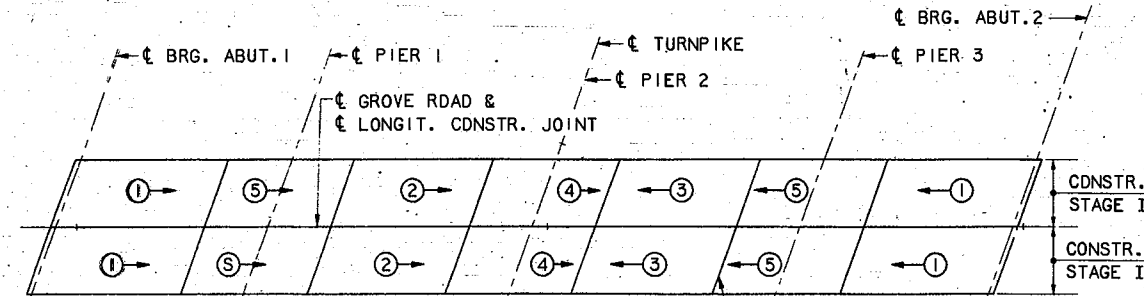

DECK PLACEMENT SEQUENCE
1" = 20'

PLACEMENT NOTES

1. THE NUMBERS IN CIRCLES INDICATE POURING SEQUENCE. POURS MAY BE MADE IN THE SAME DAY FOR 1, 2, 3 AND FOR POURS 4 AND 5. A WAITING PERIOD OF 72 HOURS IS NECESSARY BETWEEN POURS 3 AND 4.
2. THE FORMWORK AND ITS SUPPORTS, OVER THE FULL WIDTH OF THE STRUCTURAL SLAB FOR STAGE I CONSTRUCTION, SHALL REMAIN IN PLACE UNTIL A MINIMUM OF 48 HOURS HAS ELAPSED AFTER PLACEMENT OF THE SLAB, AFTER WHICH, REMOVAL OF FORMWORK FOR SECTIONS MEETING THE REQUIREMENTS FOR FORM REMOVAL OF SECTION 502, STRUCTURAL CONCRETE, OF THE STANDARD SPECIFICATIONS, MAY PROCEED.

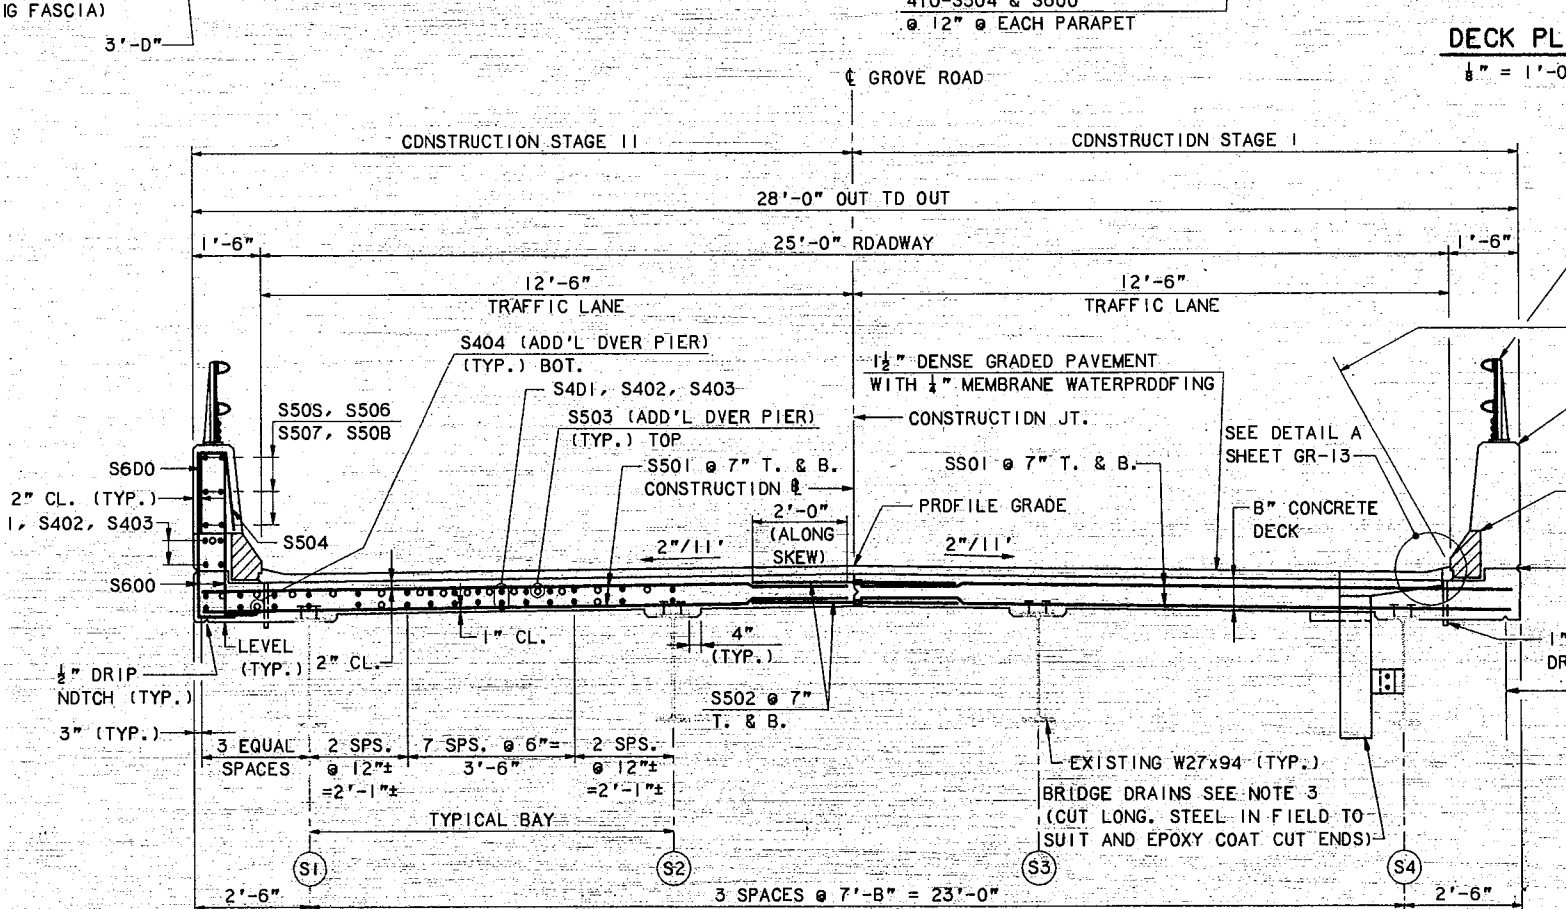

TYPICAL SECTION
(LOOKING UPSTATION)
1/2" = 1'-0"

SUPERSTRUCTURE NOTES

1. ADJUST REINFORCING STEEL TO FIT AROUND THE DRAINS IN A MANNER APPROVED BY THE ENGINEER. DO NOT CUT TRANSVERSE REINFORCING BARS.
2. FOR STEEL REINFORCING SCHEDULE, SEE SHEET GR-17.
3. FOR SCUPPER AND DRAIN DETAILS SEE SHEET NO. GR-12.
4. FOR 2-BAR ALUMINUM BRIDGE RAILING DETAILS, SEE SHEET NO. GR-16.
5. FOR SLAB DETAILS, SEE SHEET NOS. GR-12 AND GR-13.
6. FOR ROADWAY EXPANSION JOINT DETAILS, SEE SHEET NOS. GR-14 AND GR-15.


Maine Turnpike Authority
Maine Turnpike

GROVE ROAD UNDERPASS
DECK PLAN AND TYPICAL SECTION

HNTB HOWARD NEEDLES TAMMEN & BERGENOFF, INC.
ARCHITECTS ENGINEERS PLANNERS


			By:	Date:
			Designed	GPM 1/95
			Drawn	LS 1/95
◇	DECK REINF.	GPM	4/14/95	Checked HNL 1/95
No.	Revision	By:	Date:	In charge of: RAL

Contract 95.11. Sheet No. GR-11
58 of 65

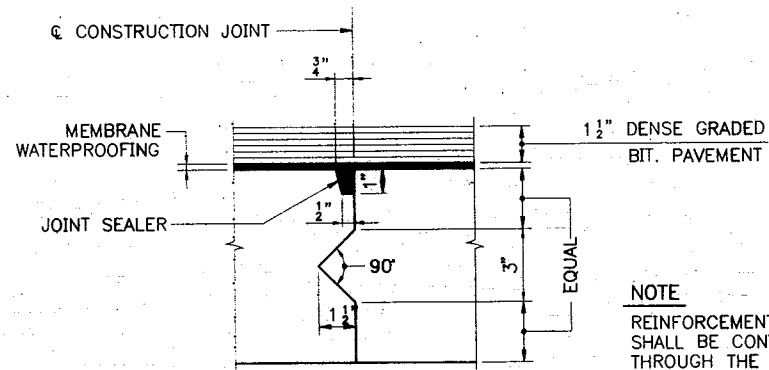


TRANSVERSE CONSTRUCTION JOINT DETAIL

3" = 1'-0"

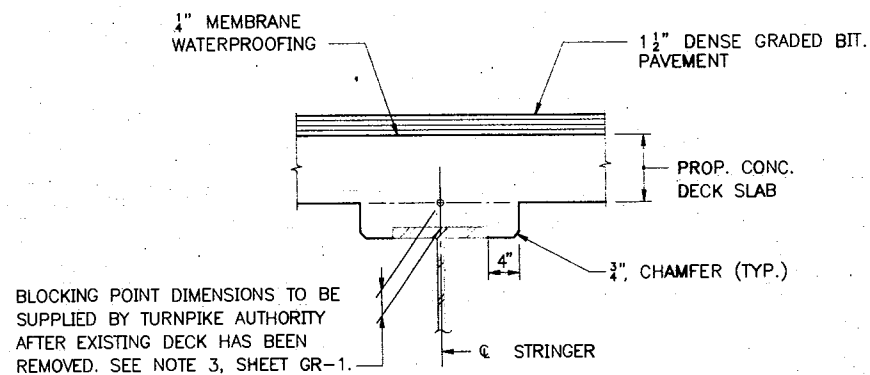


BLOCKING POINT DETAIL

1" = 1'-0"

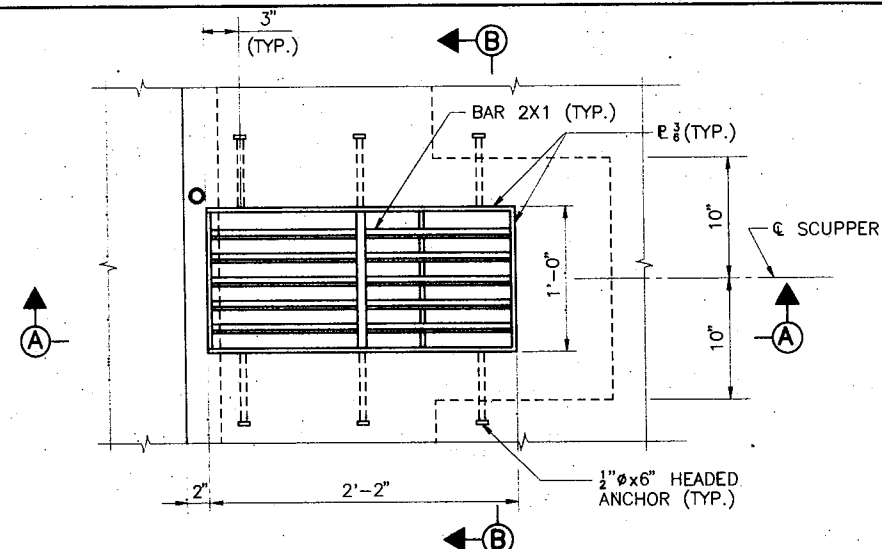


PLAN - SCUPPER

1 1/2" = 1'-0"

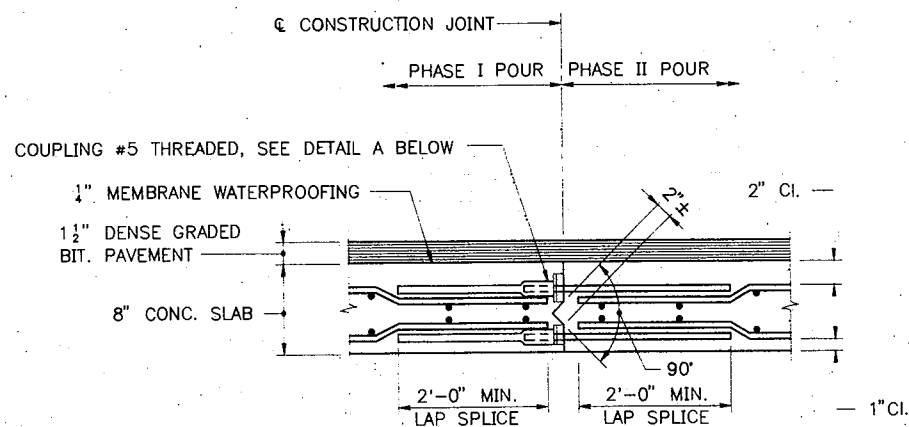

LONGITUDINAL CONSTRUCTION JOINT DETAIL


NOT TO SCALE

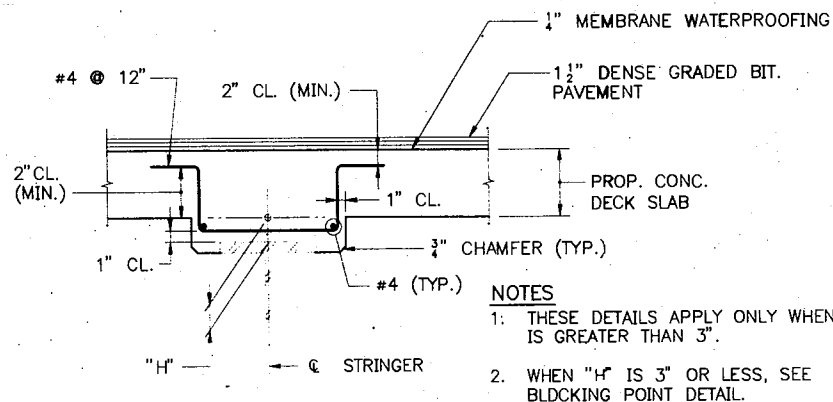

EXTRA DEPTH HAUNCH DETAILS


1" = 1'-0"

- NOTES**
- 1: THESE DETAILS APPLY ONLY WHEN "H" IS GREATER THAN 3".
 - 2: WHEN "H" IS 3" OR LESS, SEE BLOCKING POINT DETAIL.

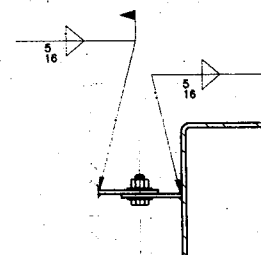

SECTION C-C

1 1/2" = 1'-0"

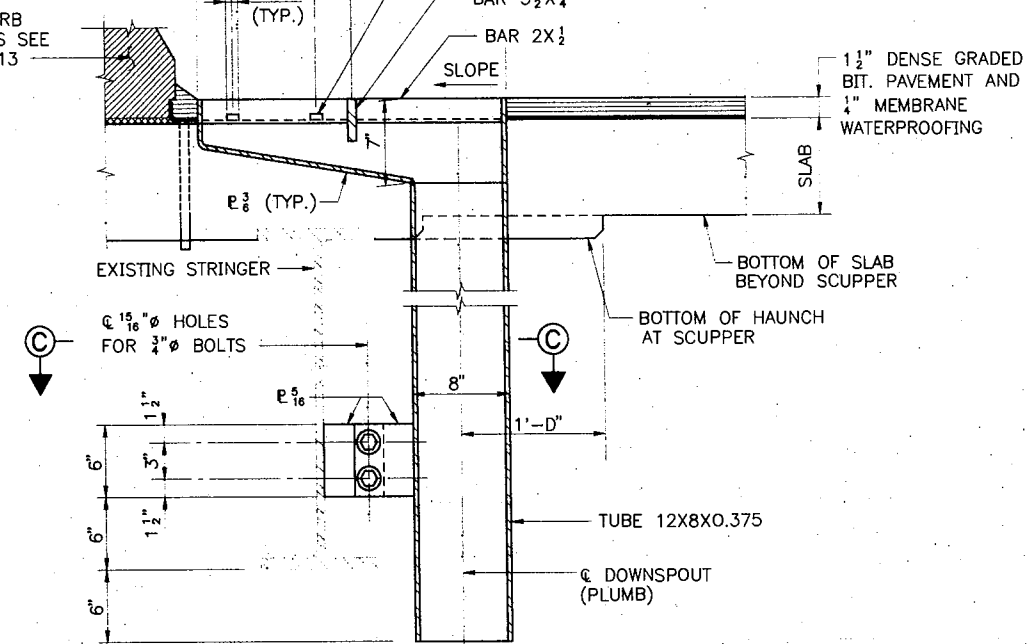


SECTION A-A


1 1/2" = 1'-0"

SCUPPER NOTES

1. ALL WELDS TO BE CONTINUOUS 1/4" FILLET WELDS EXCEPT AS NOTED.
2. DO NOT COVER DECK DRAINS WITH MEMBRANE WATERPROOFING. DEPRESS DRAINS 1/2" BELOW TOP OF SLAB, PROVIDE 23 GAUGE GALVANIZED SCREENS (1/4" MESH) OVER DRAINS.
3. SCUPPERS TO BE GALVANIZED AFTER FABRICATION. GALVANIZING SHALL CONFORM TO ASTM A153.
4. ALL PLATES SHALL CONFORM TO ASTM A7D9, GRADE 36.
5. STRUCTURAL TUBES SHALL CONFORM TO ASTM A5D1.
6. PAYMENT FOR SCUPPERS PVC DRAINS AND SCREENS INCIDENTAL TO CONTRACT ITEM 5D2.262.
7. FOR LOCATION OF SCUPPERS AND 1" DIA DRAINS, SEE SHEET GR-11.

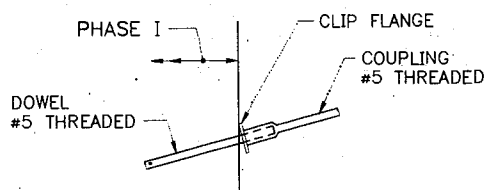


OPTIONAL CONSTRUCTION

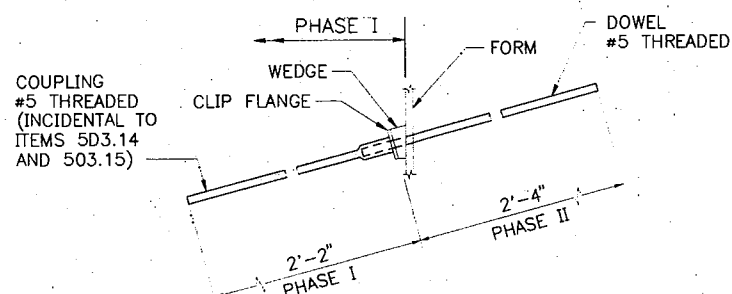

DETAIL A

NO SCALE

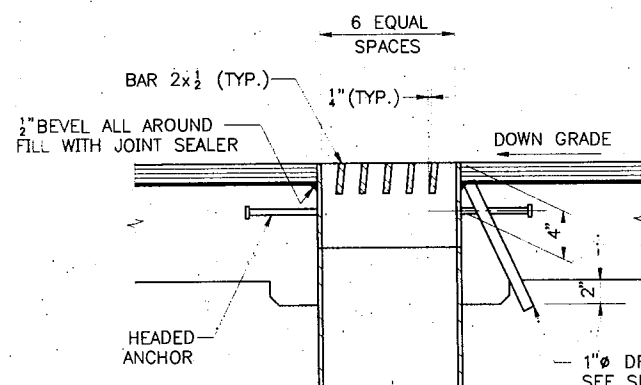

SECTION B-B

1 1/2" = 1'-0"


1" DIA. DRAIN. SEE SUBSECTION 502.17 OF MDOT STANDARD SPECIFICATIONS AND NOTE 2, THIS SHEET

By	Date
Designed	SHR 12/94
Drawn	LMR 12/94
Checked	GPM 1/95
In Charge Of	RAL

Maine Turnpike Authority
Maine Turnpike
 GROVE ROAD UNDERPASS
SLAB DETAILS I


HNTB HOWARD NEEDLES TAMMEN & BERGENDOFF
 ARCHITECTS ENGINEERS PLANNERS

Contract 95.11 Sheet No. GR-12
 59 of 65

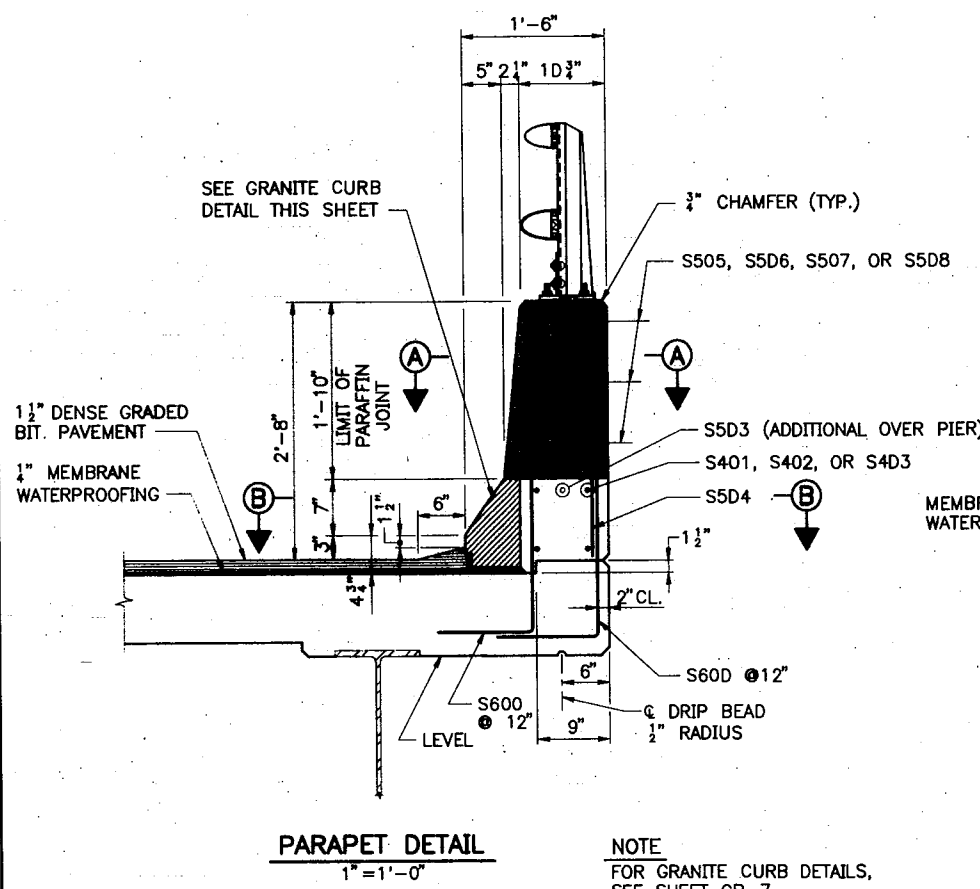


PARAPET DETAIL
1" = 1'-0"

NOTE
FOR GRANITE CURB DETAILS,
SEE SHEET GR-7

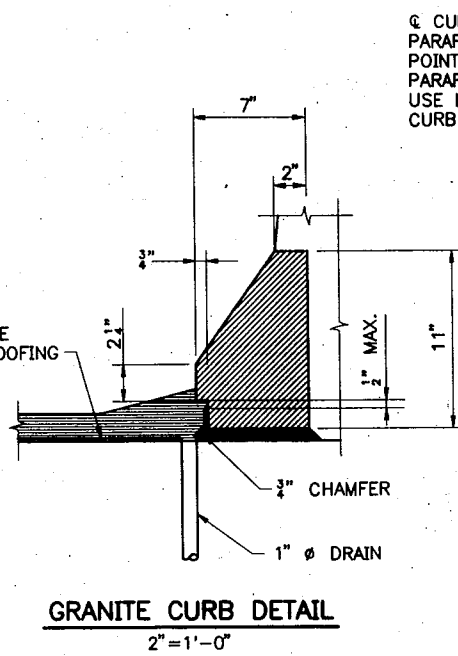


GRANITE CURB DETAIL
2" = 1'-0"

© CURB JOINT (PARAPET
PARAFFIN OR DUMMY JOINT)
POINT CURB JOINTS LOCATED AT PARAPET
PARAFFIN JOINTS WITH JOINT SEALANT.
USE MORTAR AT ALL OTHER
CURB JOINTS

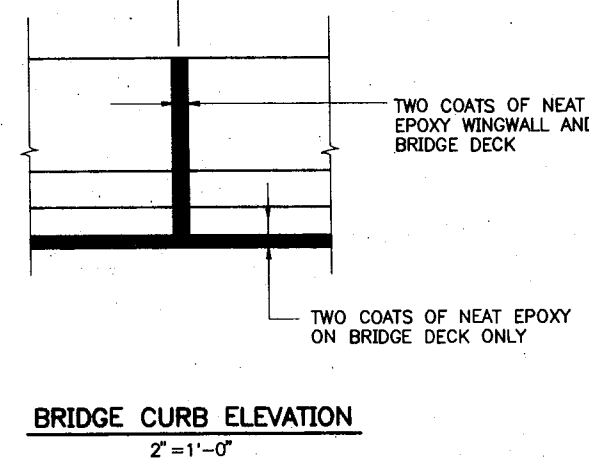

BRIDGE CURB ELEVATION
2" = 1'-0"

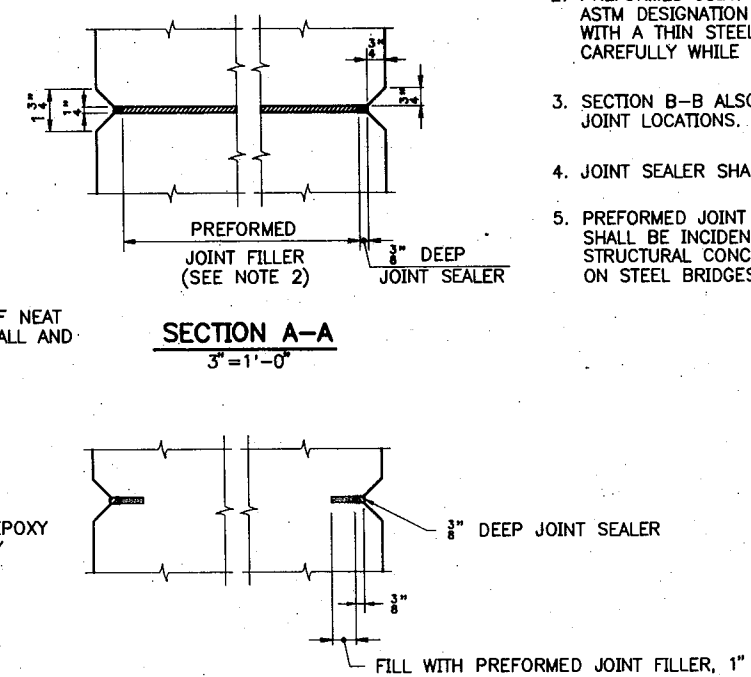


SECTION A-A
3" = 1'-0"

SECTION B-B
3" = 1'-0"

PARAFFIN AND DUMMY JOINT NOTES

1. CONCRETE SHALL BE PLACED SIMULTANEOUSLY ON BOTH SIDES OF JOINT.
2. PREFORMED JOINT FILLER SHALL CONFORM TO ASTM DESIGNATION D1751 AND MAY BE SUPPORTED WITH A THIN STEEL PLATE. REMOVE PLATE CAREFULLY WHILE THE CONCRETE IS PLASTIC.
3. SECTION B-B ALSO APPLIES TO DUMMY JOINT LOCATIONS.
4. JOINT SEALER SHALL BE SIKA FLEX 1A.
5. PREFORMED JOINT FILLER AND JOINT SEALER SHALL BE INCIDENTAL TO ITEM 5D2.262, STRUCTURAL CONCRETE ROADWAY AND PARAPET ON STEEL BRIDGES.

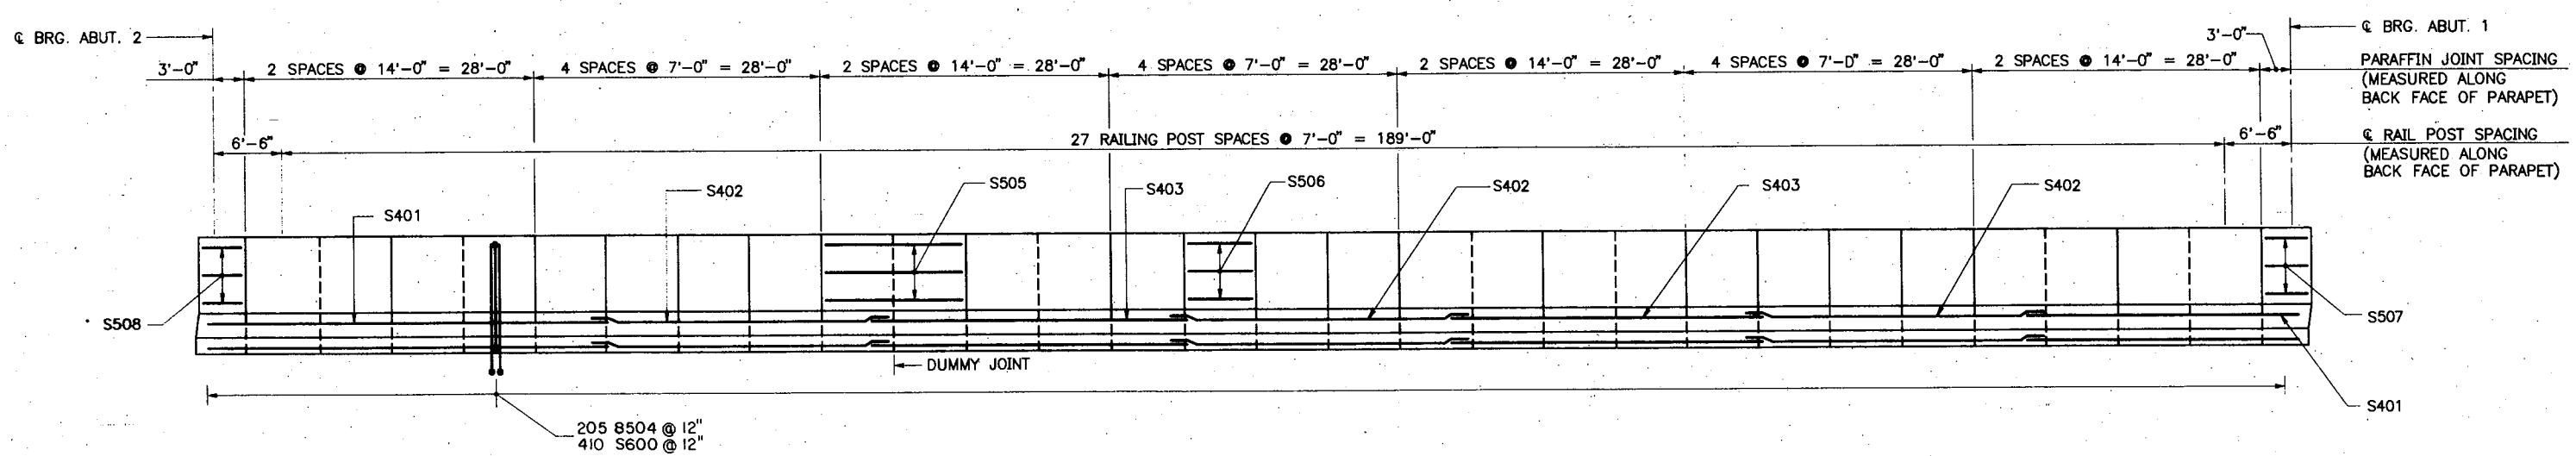

PARAPET ELEVATION
(LOOKING SOUTH)
HORZ. 1/8" = 1'-0"
VERT. 1/2" = 1'-0"

Maine Turnpike Authority
Maine Turnpike

GROVE ROAD UNDERPASS
SLAB DETAILS II

HNTB HOWARD NEEDLES TAMMEN & BERGENDOFF
ARCHITECTS ENGINEERS PLANNERS

Contract **95.11** Sheet No. **GR-13**
60 of 65

By	Date
Designed	GPM 2/95
Drawn	LMR 2/95
Checked	HNL 2/95
In Charge Of:	RAL


(MAINETPK)

MAINE TURNPIKE MODERNIZATION AND WIDENING PROJECT MILES 12-42



MAINE TURNPIKE AUTHORITY


SAMUEL M. ZAITLIN, CHAIRMAN
LUCIEN B. GOSSELIN, VICE CHAIRMAN
EARL L. ADAMS, MEMBER
JANIS COHEN, MEMBER
HARLAND GOODWIN, MEMBER
JANE L. LINCOLN, MEMBER EX-OFFICIO
PAUL E. VIOLETTE, EXECUTIVE DIRECTOR

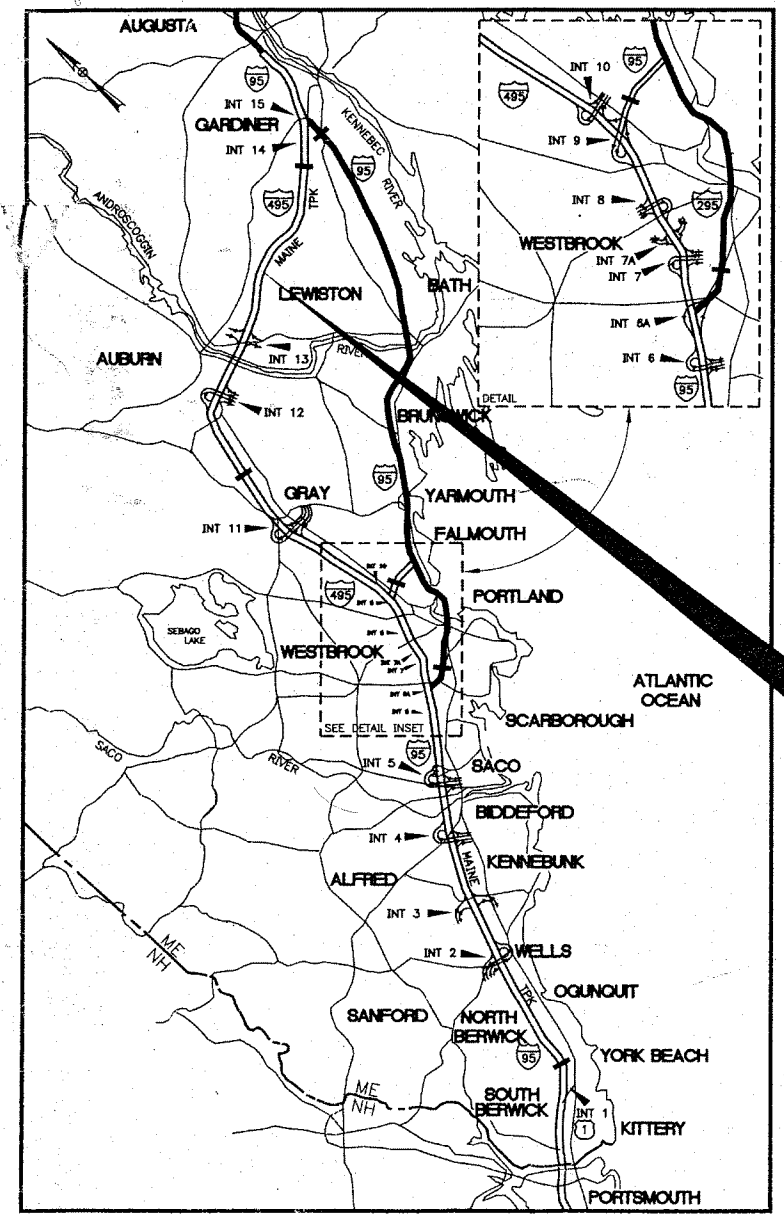


LOCATION MAP

1	TITLE SHEET
2	ESTIMATED QUANTITIES & EARTHWORK SUMMARY
3	GENERAL NOTES & LEGEND
4	TYPICAL SECTIONS & DETAILS
5	MISCELLANEOUS DETAILS
6	EROSION CONTROL DETAILS
7-10	SITE PLANS
11	ROUTE 9 PROFILE
12-20	MAINTENANCE OF TRAFFIC PLANS & SIGNS
21-24	MAXWELL BROOK BOX CULVERT STRUCTURAL PLANS
25-33	ROUTE 9 CROSS SECTIONS
34-60	ROUTE 9 BRIDGE RECONSTRUCTION PLANS
61-63	ROUTE 9 AS-BUILT PLANS

THE FOLLOWING PAGES WERE DESIGNED
BY TAYLOR ENGINEERING: 2 - 33

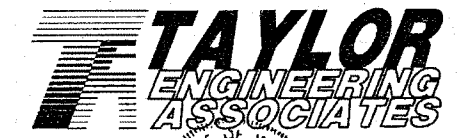

APPROVED BY: *Joseph Norton*

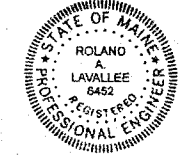

Roland A. Lavalley
ROLAND A. LAVALLEY P.E., PLS
VICE PRESIDENT
DIRECTOR OF OPERATIONS

Handwritten notes:
Full to 50 ft
23' L¹⁰⁰
311+50
MAIN 312+50 - 311
12" dia e 36+V0

CONTRACT 2002.25 ROUTE 9 ROADWAY AND BRIDGE RECONSTRUCTION

APPROVED: MAINE TURNPIKE AUTHORITY

CHAIRMAN

EXECUTIVE DIRECTOR

DATE _____

STATE OF MAINE
DEPARTMENT OF TRANSPORTATION

COMMISSIONER


BUREAU DIRECTOR AND CHIEF ENGINEER

DATE


DATE

Handwritten notes:
402+50 with curbs...
413+92 over rd...
410+0 High point with curbs...
Silt fence


3/28/02
DATE

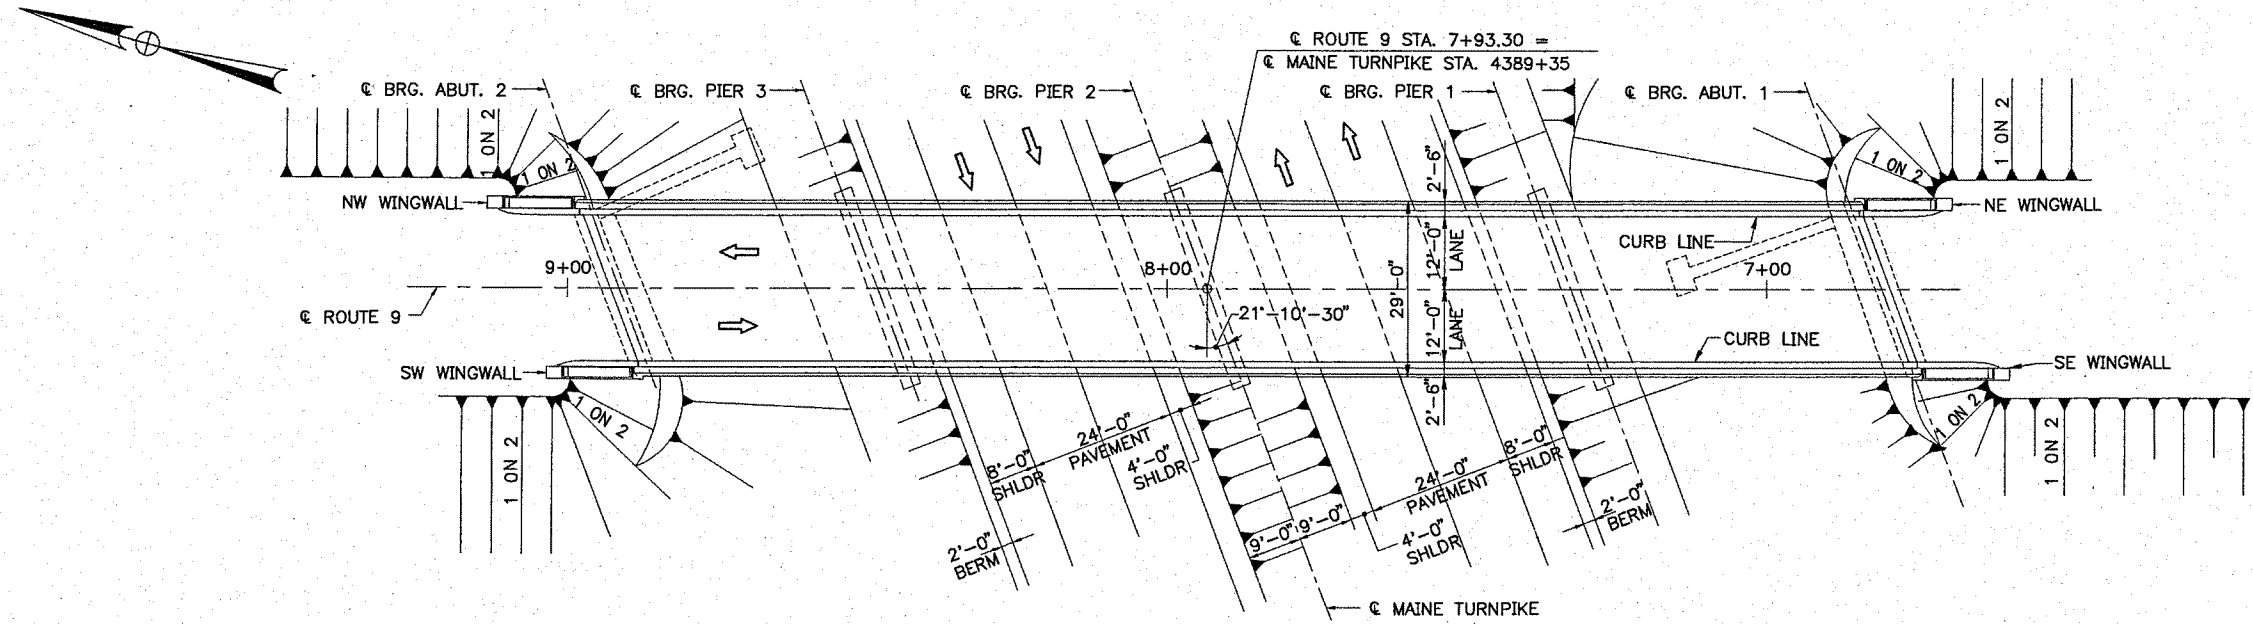


EXISTING PLAN
1/16" = 1'-0"

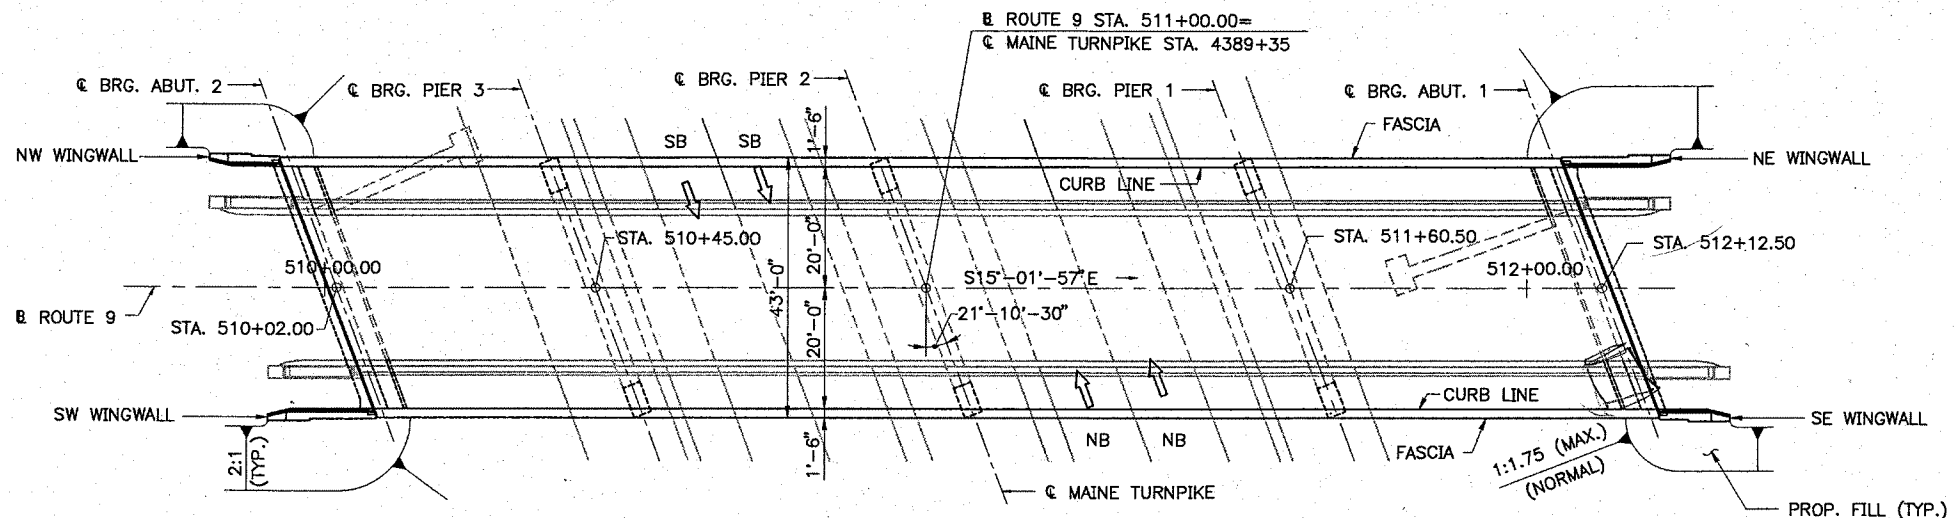

PROPOSED PLAN
1/16" = 1'-0"

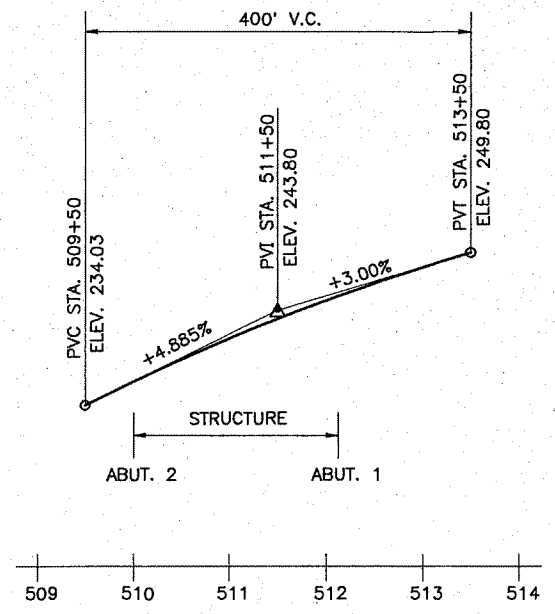

PROPOSED PROFILE
HOR. 1" = 100'
VERT. 1" = 10'

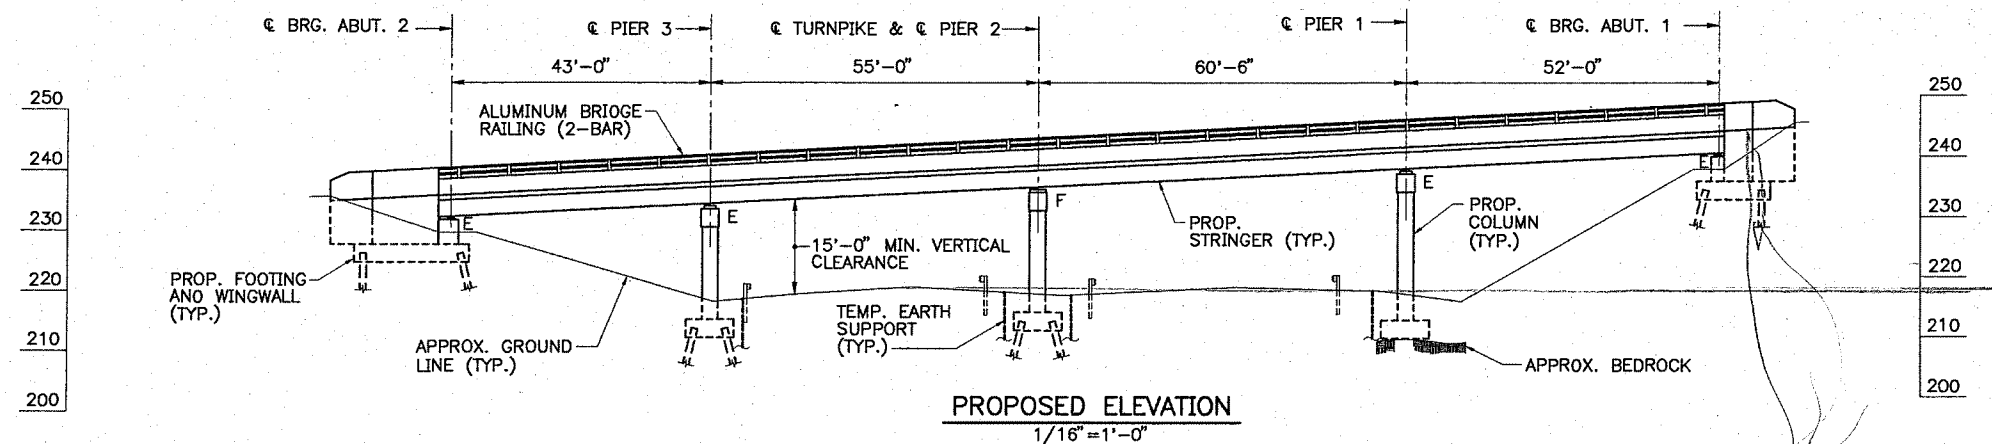

PROPOSED ELEVATION
1/16" = 1'-0"

212.5 - 217.0

M:\14335\003\001\SIGPES1.DWG 04/03/02 10:56

Scale: AS NOTED

No.	Revision	By	Date

Designed by:

HNTB
ARCHITECTS ENGINEERS PLANNERS

By	Date	By	Date
AD	1/02	AAD	1/02
AR	10/01	RAL	3/02


HNTB CORPORATION
2 Thomas Drive
Westbrook, ME 04092
TEL (207) 774-5155
FAX (207) 772-7410

MAINE TURNPIKE AUTHORITY


MAINE TURNPIKE **Transpass**

SABATTUS INTERCHANGE/
ROUTE 9
GENERAL PLAN AND ELEVATION


SHEET NUMBER: SI-2
CONTRACT: 2002.25
35 OF 63

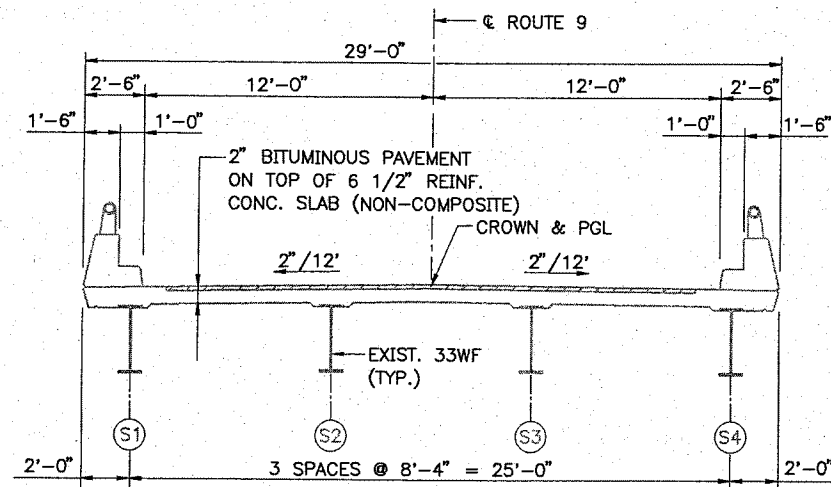


EXISTING CROSS SECTION
1/4" = 1'-0"

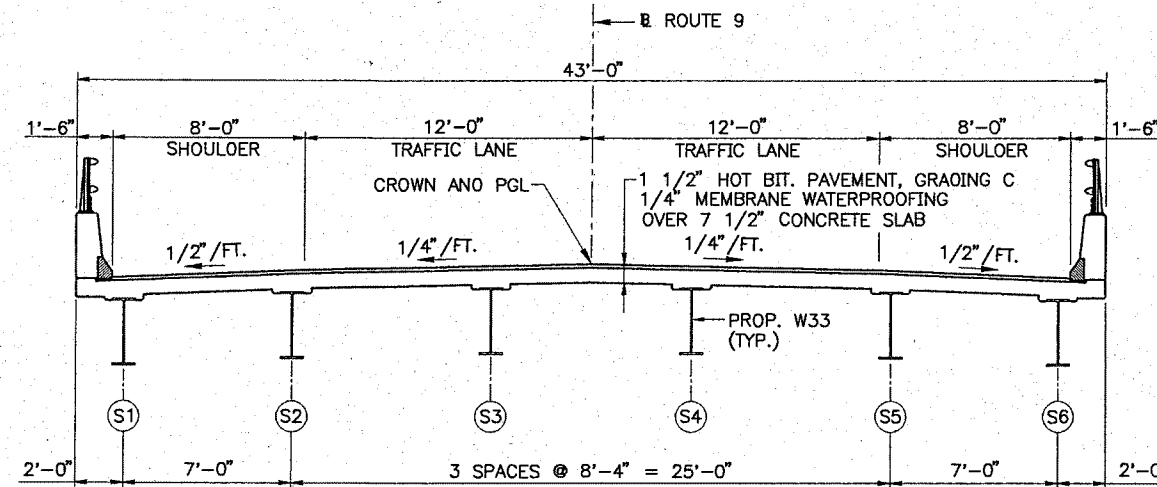

PROPOSED CROSS SECTION
1/4" = 1'-0"

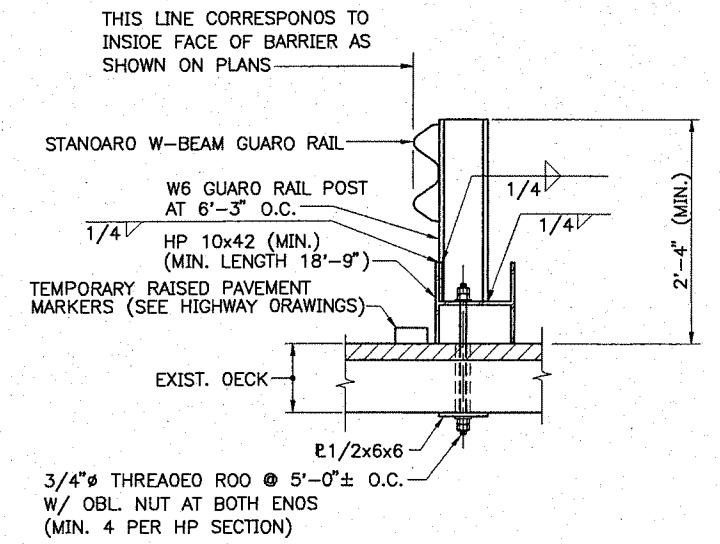


TEMPORARY STEEL GUARD RAIL DETAIL - 1
(EXISTING DECK SLAB)
1" = 1'-0"

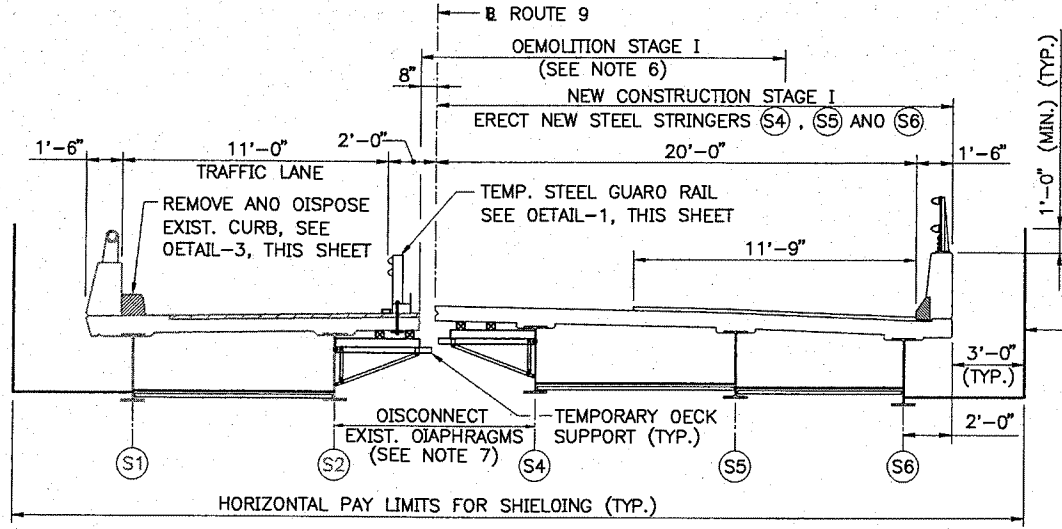


STAGE I CONSTRUCTION
1/4" = 1'-0"

SHIELDING DURING CONSTRUCTION (TYP.)


TEMPORARY RAISED PAVEMENT MARKERS (SEE HIGHWAY DRAWINGS)

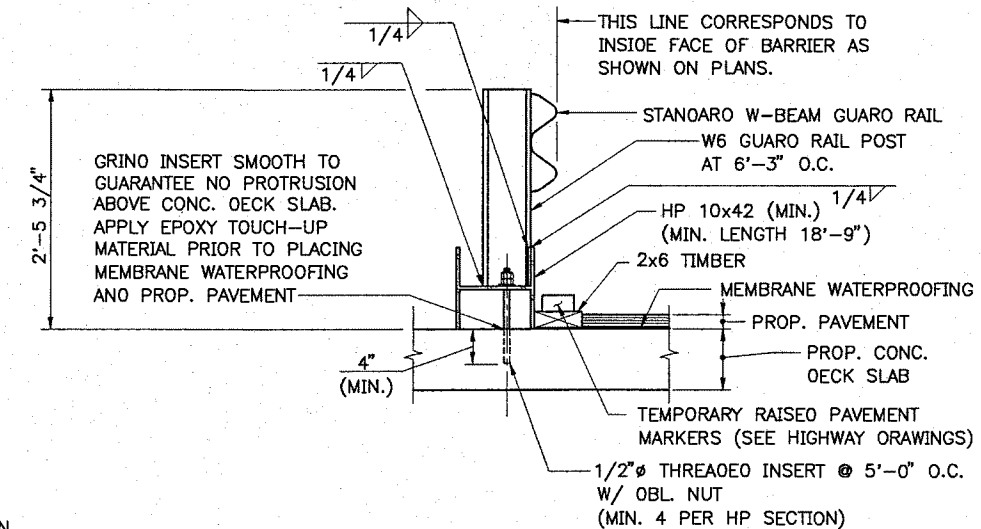

TEMPORARY STEEL GUARD RAIL DETAIL - 2
(PROPOSED DECK SLAB)
1" = 1'-0"

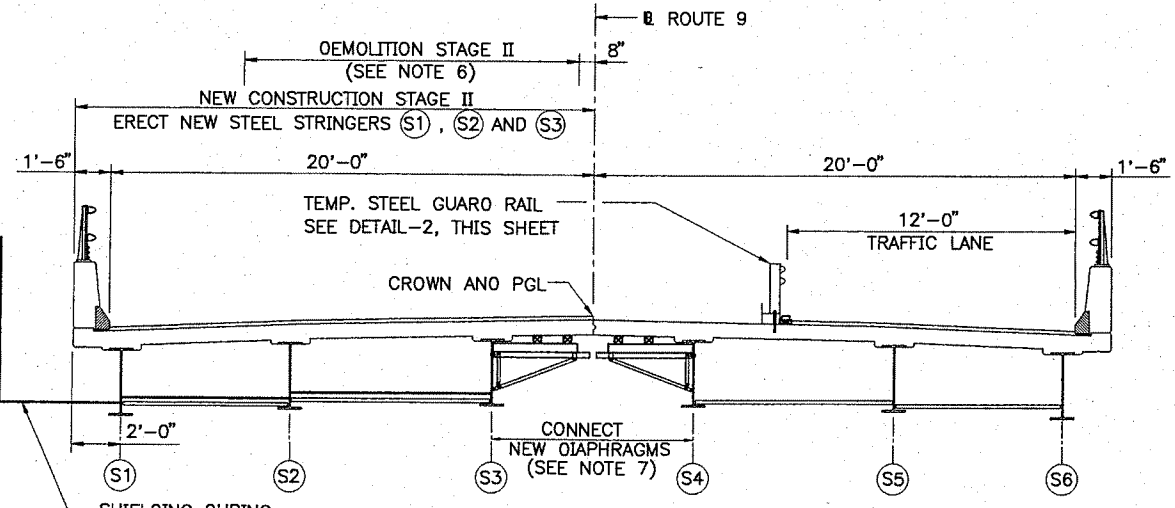

STAGE II CONSTRUCTION
1/4" = 1'-0"

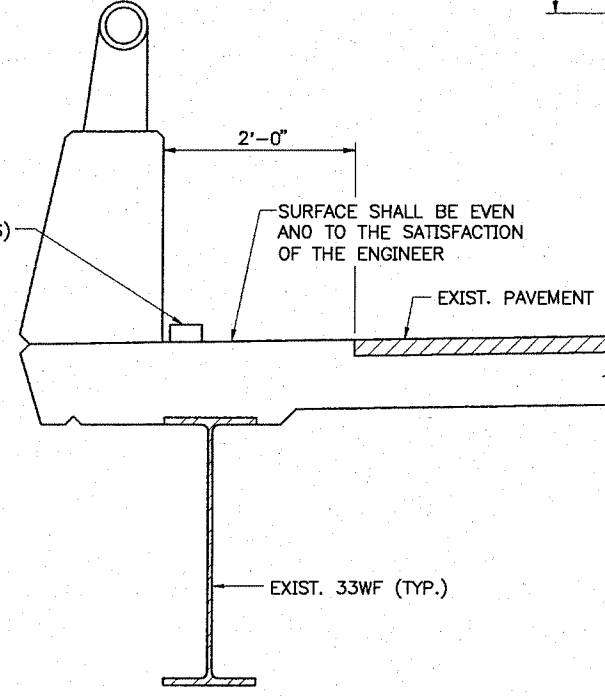

DETAIL-3
1" = 1'-0"

NOTES

1. ALL WORK NECESSARY TO FURNISH, ERECT, RESET AND REMOVE TEMPORARY STEEL GUARD RAIL SHALL BE PAID UNDER ITEM 606.172.
2. THE CONTRACTOR SHALL SUBMIT A TEMPORARY DECK SUPPORT DESIGN, STAMPED BY A REGISTERED PROFESSIONAL ENGINEER IN THE STATE OF MAINE, FOR REVIEW AND APPROVAL.
3. TEMPORARY DECK SUPPORTS SHALL BE DESIGNED FOR AN AASHTO HS20-44 LIVE LOAD.
4. ALL WORK NECESSARY TO FURNISH, ERECT AND REMOVE THE TEMPORARY DECK SUPPORTS SHALL BE PAID FOR UNDER ITEM 524.361.
5. ALL SECTIONS ARE LOOKING UPSTATION.
6. EXISTING DECK AND STRINGERS, FOR EACH STAGE, SHALL BE DEMOLISHED AND REMOVED BEFORE INSTALLING THE PROPOSED STRINGERS.
7. FOR NOTES ON CONNECTING NEW DIAPHRAGMS, SEE SHEET NO. SI-14.

M:\14335\003\001\SSSEQ1S1.DWG 04/03/02 10:57

Scale: AS NOTED

Designed by:



ARCHITECTS ENGINEERS PLANNERS

HNTB CORPORATION
2 Thomas Drive
Westbrook, ME 04092
TEL (207) 774-5155
FAX (207) 772-7410

MAINE TURNPIKE AUTHORITY



SABATTUS INTERCHANGE/
ROUTE 9
SEQUENCE OF CONSTRUCTION






No.	Revision	By	Date

	By	Date		By	Date
Designed	AD	10/01	Checked	AAD	1/02
Drawn	LS	10/01	In Charge of	RAL	3/02

CONTRACT: 2002.25

SHEET NUMBER: SI-3

36 OF 63

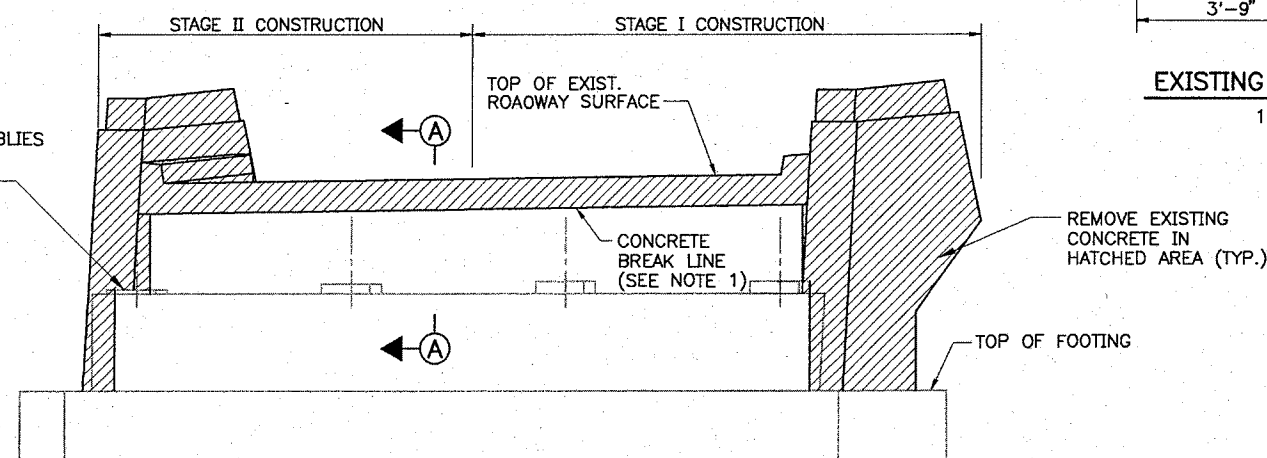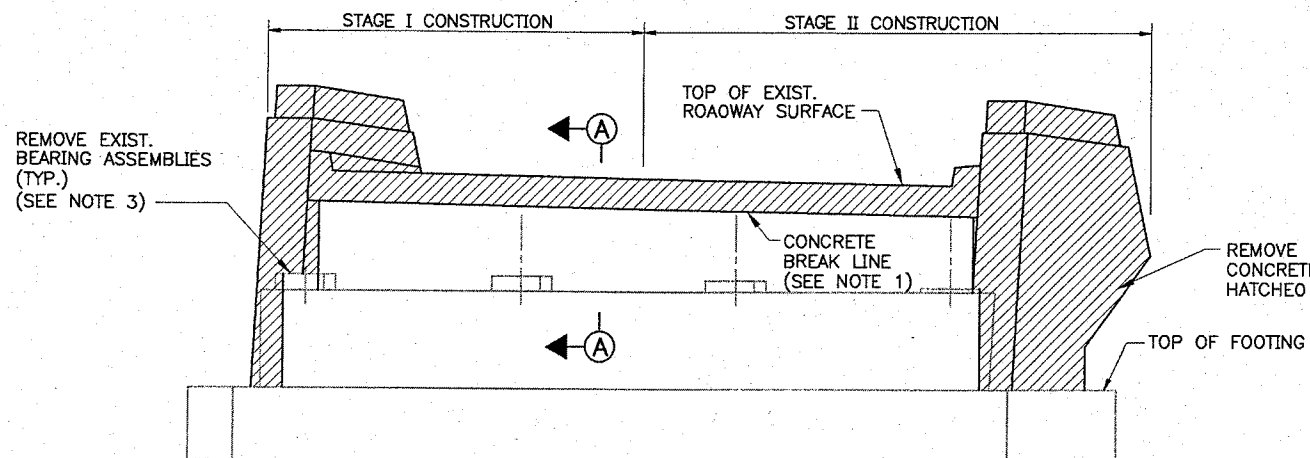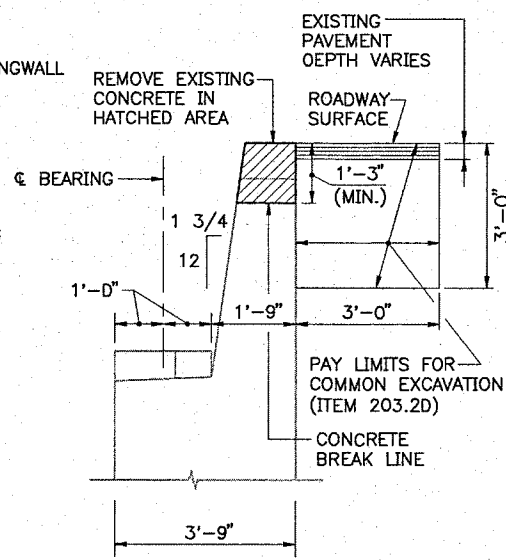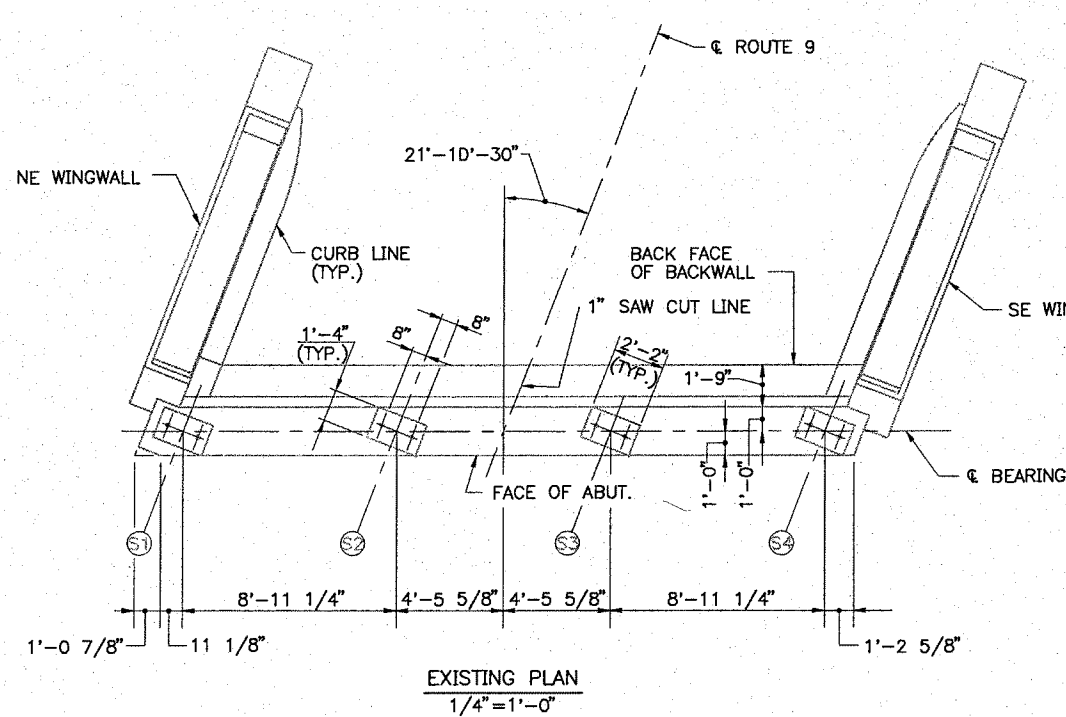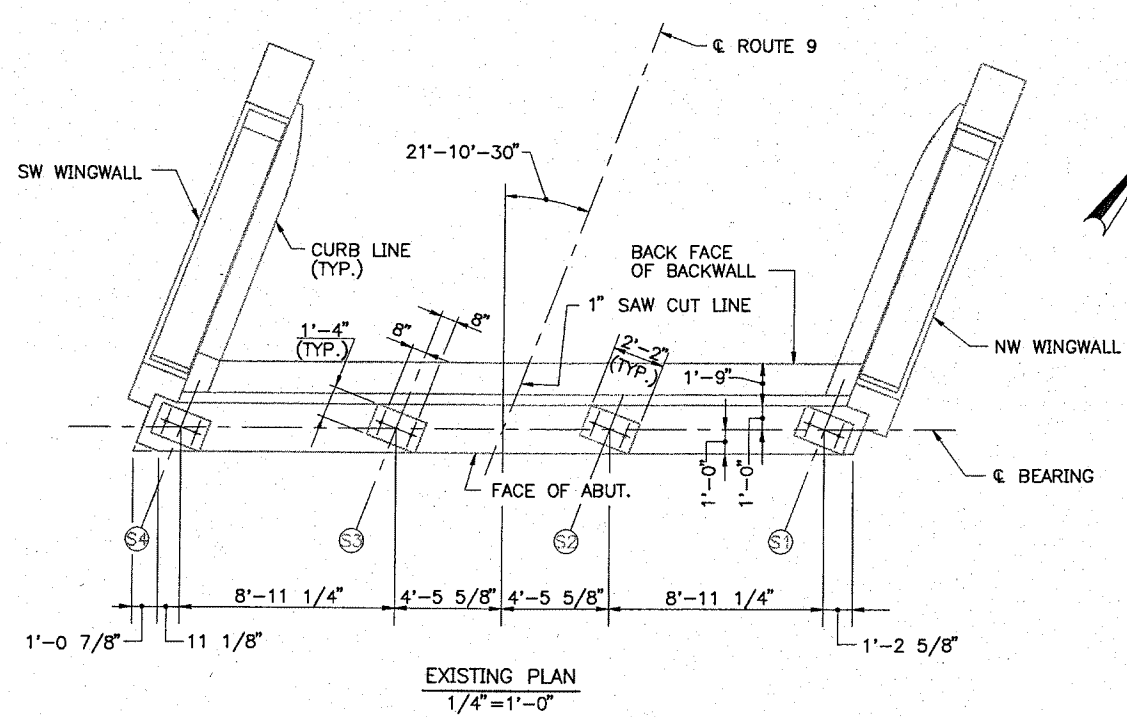

- NOTES**
1. SAW CUT 1-IN. (MIN.) DEEP BEFORE REMOVING EXISTING CONCRETE AT CONCRETE BREAK LINES.
 2. REMOVAL OF THE EXISTING EXPANSION JOINT SHALL BE INCIDENTAL TO ITEM 202.1D.
 3. EXISTING BEARING ASSEMBLIES SHALL BE REMOVED AND STACKED AT THE CROSBY MAINTENANCE AREA, MILE 44 SB OF MAINE TURNPIKE. THIS WORK WILL NOT BE MEASURED FOR PAYMENT, BUT WILL BE INCIDENTAL TO ITEM 202.1D.
 4. EXCAVATION FOR BACKWALL MODIFICATION SHALL BE PAID FOR UNDER ITEM 203.2D TO THE LIMITS SHOWN.

M:\14335\003\001\SI\EXABTSI.DWG 04/03/02 10:58

Scale: AS NOTED

No.	Revision	By	Date

Designed by:

HNTB
ARCHITECTS ENGINEERS PLANNERS


By	Date	By	Date
AD	9/01	AAD	1/02
AR	9/01	RAL	3/02

HNTB CORPORATION
2 Thomas Drive
Westbrook, ME 04092
TEL (207) 774-5155
FAX (207) 772-7410

MAINE TURNPIKE AUTHORITY

SABATTUS INTERCHANGE/
ROUTE 9
EXISTING ABUTMENTS


SHEET NUMBER: SI-4
CONTRACT: 2002.25
37 OF 63

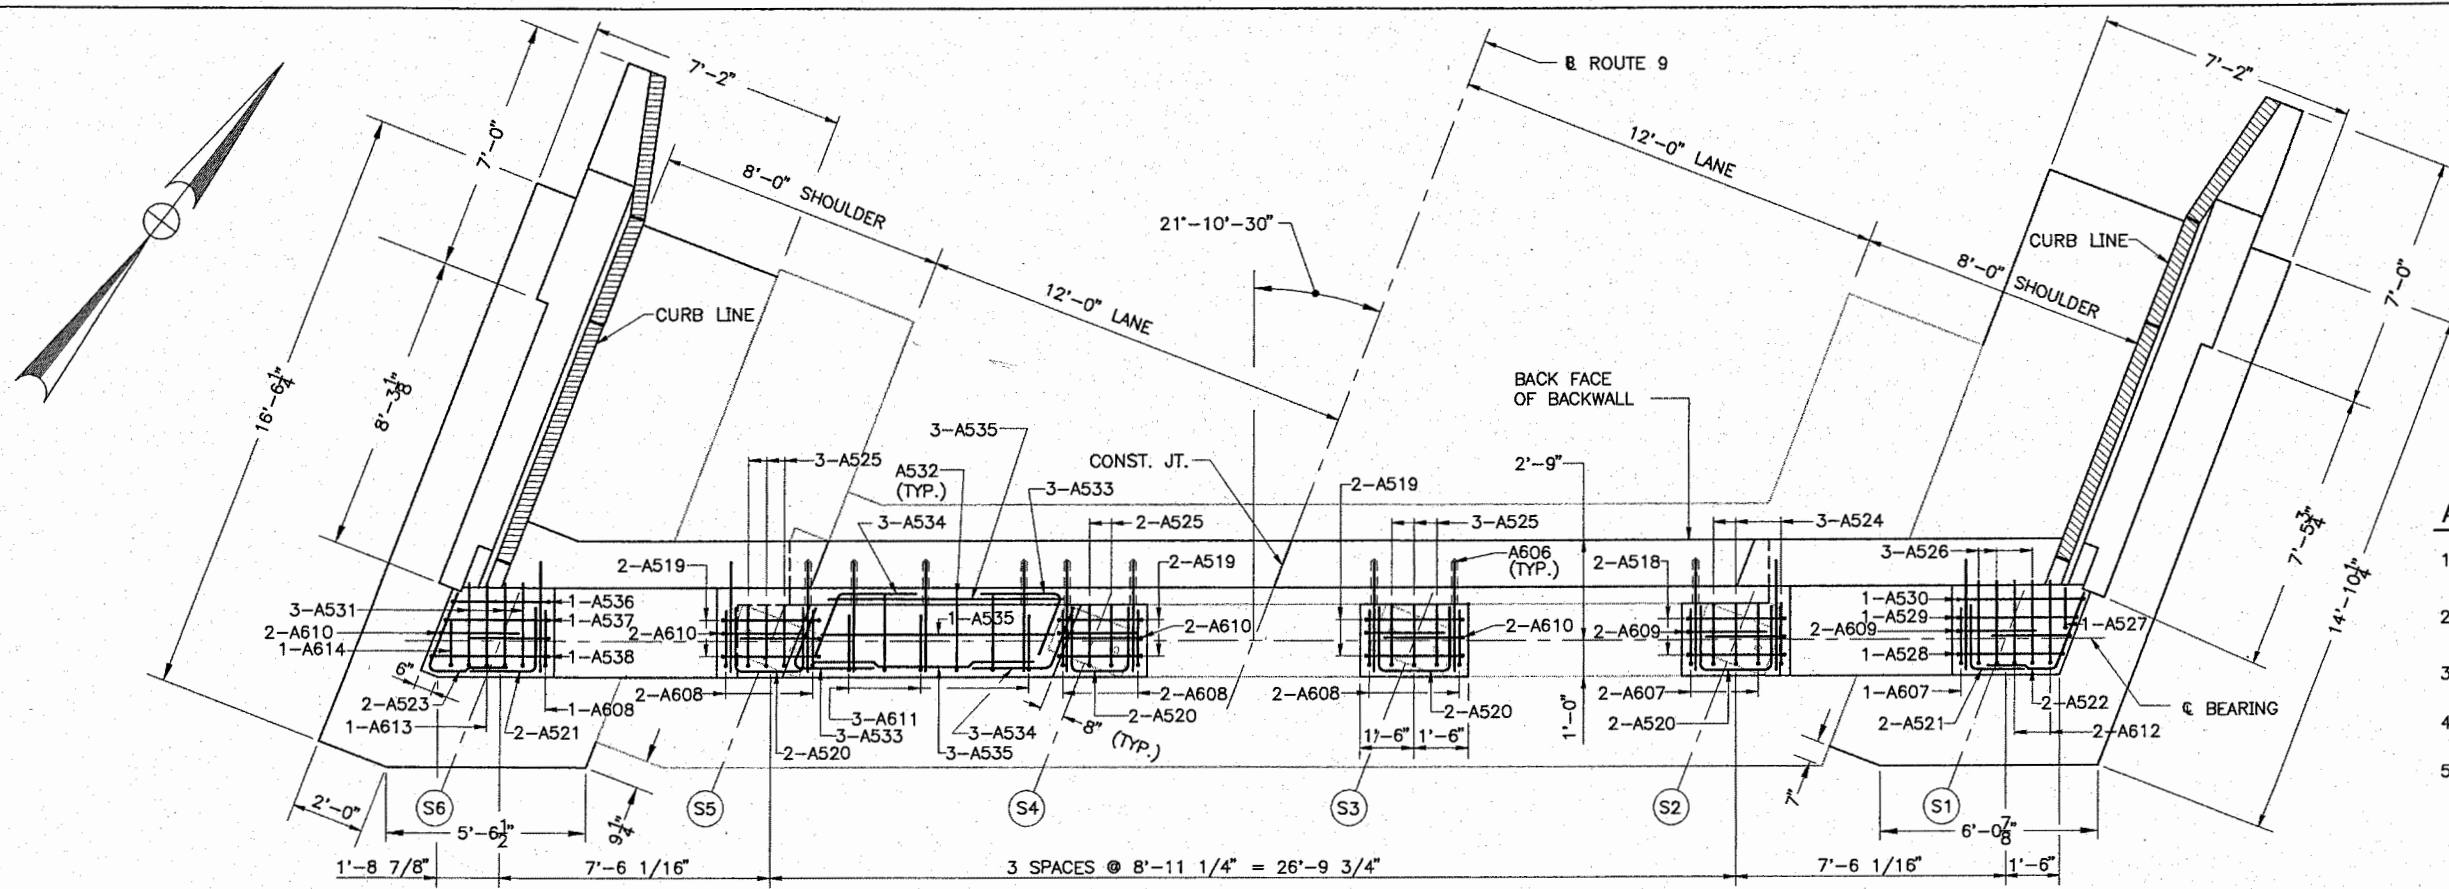

PROPOSED PLAN

ABUTMENT NOTES

1. FOR REINFORCING STEEL SCHEDULE, SEE SHEET NO. SI-25.
2. FOR WINGWALL DETAILS, SEE SHEET NOS. SI-8 AND SI-9.
3. FOR ROADWAY EXPANSION JOINT DETAILS, SEE SHEET NOS. SI-19, SI-20 AND SI-21.
4. FOR LIMITS OF CONCRETE PROTECTIVE COATING, SEE SHEET NO. SI-7.
5. THE CONTRACTOR SHALL EXPOSE THE TOP LAYER OF THE EXISTING ABUTMENT REINFORCING STEEL PRIOR TO DRILLING AND GROUTING ANY OWELS. THE CONTRACTOR SHALL REPORT ANY INTERFERENCE OF DOWELS WITH EXISTING REINFORCING STEEL TO THE ENGINEER. CARE SHALL BE TAKEN NOT TO DAMAGE THE EXISTING REINFORCING STEEL. (DRILLING AND GROUTING HOLES SHALL BE INCIDENTAL TO ITEM 502.2191).
6. REMOVE ALL DETERIORATED OR LOOSE CONCRETE AT EACH OF THE EXISTING CONCRETE PEDESTALS. CLEAN AND ROUGHEN ALL CONCRETE SURFACES TO ELIMINATE BOND INHIBITING MATERIALS, INCLUDING LOCATIONS WHERE EXPOSING THE TOP LAYER OF REINFORCING STEEL IS NOT REQUIRED. CLEAN ALL EXPOSED REINFORCING STEEL USING AN ACCEPTABLE METHOD APPROVED OF BY THE ENGINEER, THEN APPLY AN EPOXY COATING TO THE BARS. APPLY A BONDING AGENT TO THE EXISTING SUBSTRATE BY FOLLOWING THE MANUFACTURER'S INSTRUCTIONS AND APPROVED OF BY THE ENGINEER, PRIOR TO PLACEMENT OF NEW CONCRETE. (PAYMENT SHALL BE INCIDENTAL TO ITEM NO. 502.2191).
7. * ELEVATIONS SHOWN ARE AT THE FRONT FACE OF BACKWALL.
8. SLOPE PROPOSED BRIDGE SEAT 1/2" PER FT. OR MATCH EXISTING.
9. FOR SECTIONS J-J, K-K, L-L, M-M AND FOUNDATION DETAILS, SEE SHEET NO. SI-7.
10. EXISTING PILES NOT SHOWN. REFER TO AS-BUILT PLANS FOR LOCATION.
11. PROPOSED SECTION A-A, SHOWN ON SHEET NO. SI-7, REPRESENTS CONDITIONS AT ABUTMENT 2. PROPOSED SECTION A-A FOR ABUTMENT 1 IS SIMILAR, EXCEPT FOR THE MODIFIED HEIGHT OF BACKWALL AND CONCRETE BEARING PAD.
12. BAR MARK A509 (B509) AND A603 (B603), WHICH ARE LOCATED OVER THE EXISTING FOOTING, SHALL BE DRILLED AND GROUTED TO THE RESPECTIVE EMBEDMENT DEPTH PROVIDED.
13. BAR MARK A501 (B501) SHALL BE THE OWEL BAR SPLICER SYSTEM, CONSISTING OF OWEL BAR SPLICER (OB-SAE) AND OWEL-IN (OI), AS MANUFACTURED BY OAYTON/RICHMOND OR EQUIVALENT.
14. REINFORCING STEEL SHALL BE EQUALLY SPACED, UNLESS OTHERWISE NOTED.

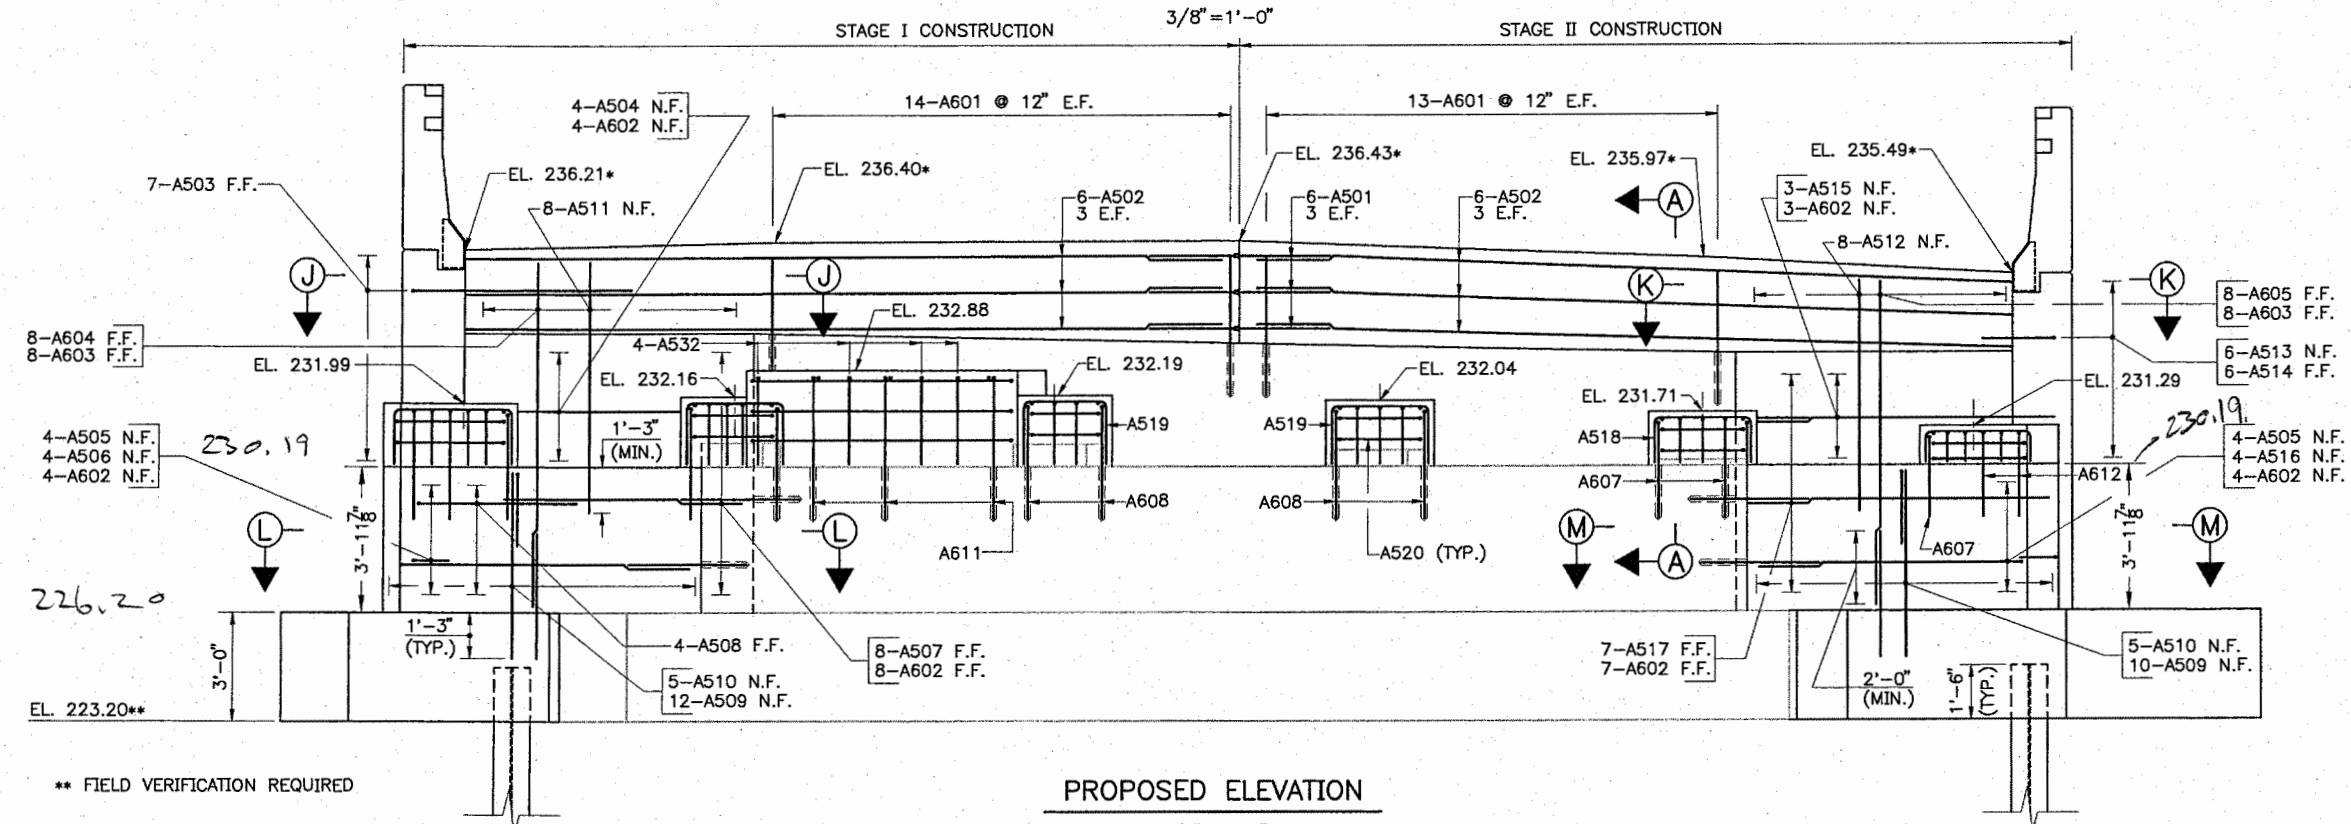

PROPOSED ELEVATION

M:\14335\003\001\SI\ABT2SI.DWG 04/03/02 15:23

Scale: AS NOTED

No.	Revision	By	Date

Designed by:

HNTB
ARCHITECTS ENGINEERS PLANNERS


Designed	By	Date	Checked	By	Date
	AD	1/02		AAD	3/02
Drawn	By	Date	In Charge of	By	Date
	AD	1/02		RAL	3/02

HNTB CORPORATION
2 Thomas Drive
Westbrook, ME 04092
TEL (207) 774-5155
FAX (207) 772-7410

MAINE TURNPIKE AUTHORITY


SABATTUS INTERCHANGE/
ROUTE 9
ABUTMENT 2 MODIFICATIONS

SHEET NUMBER: SI-5
CONTRACT: 2002.25
38 OF 63

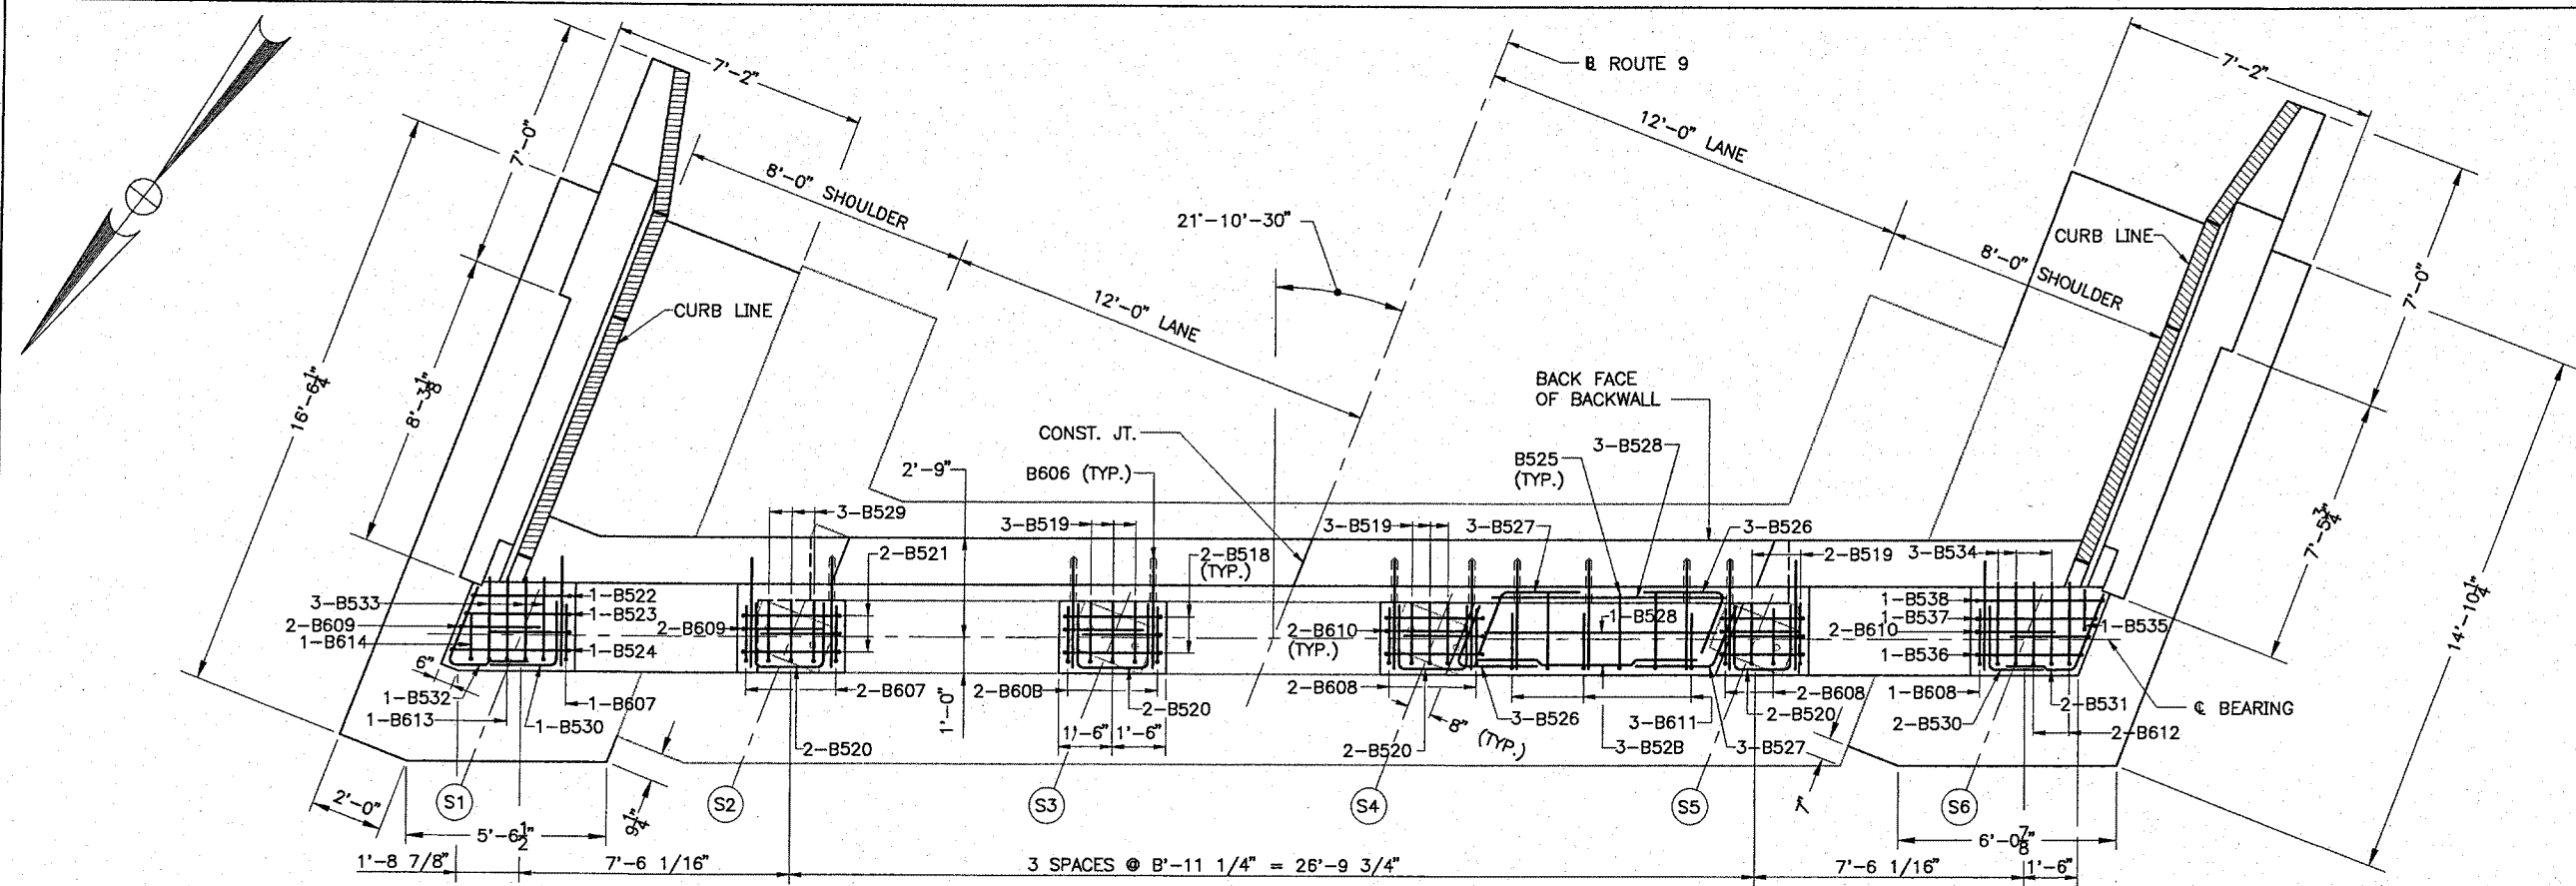

PROPOSED PLAN

3/8" = 1'-0"

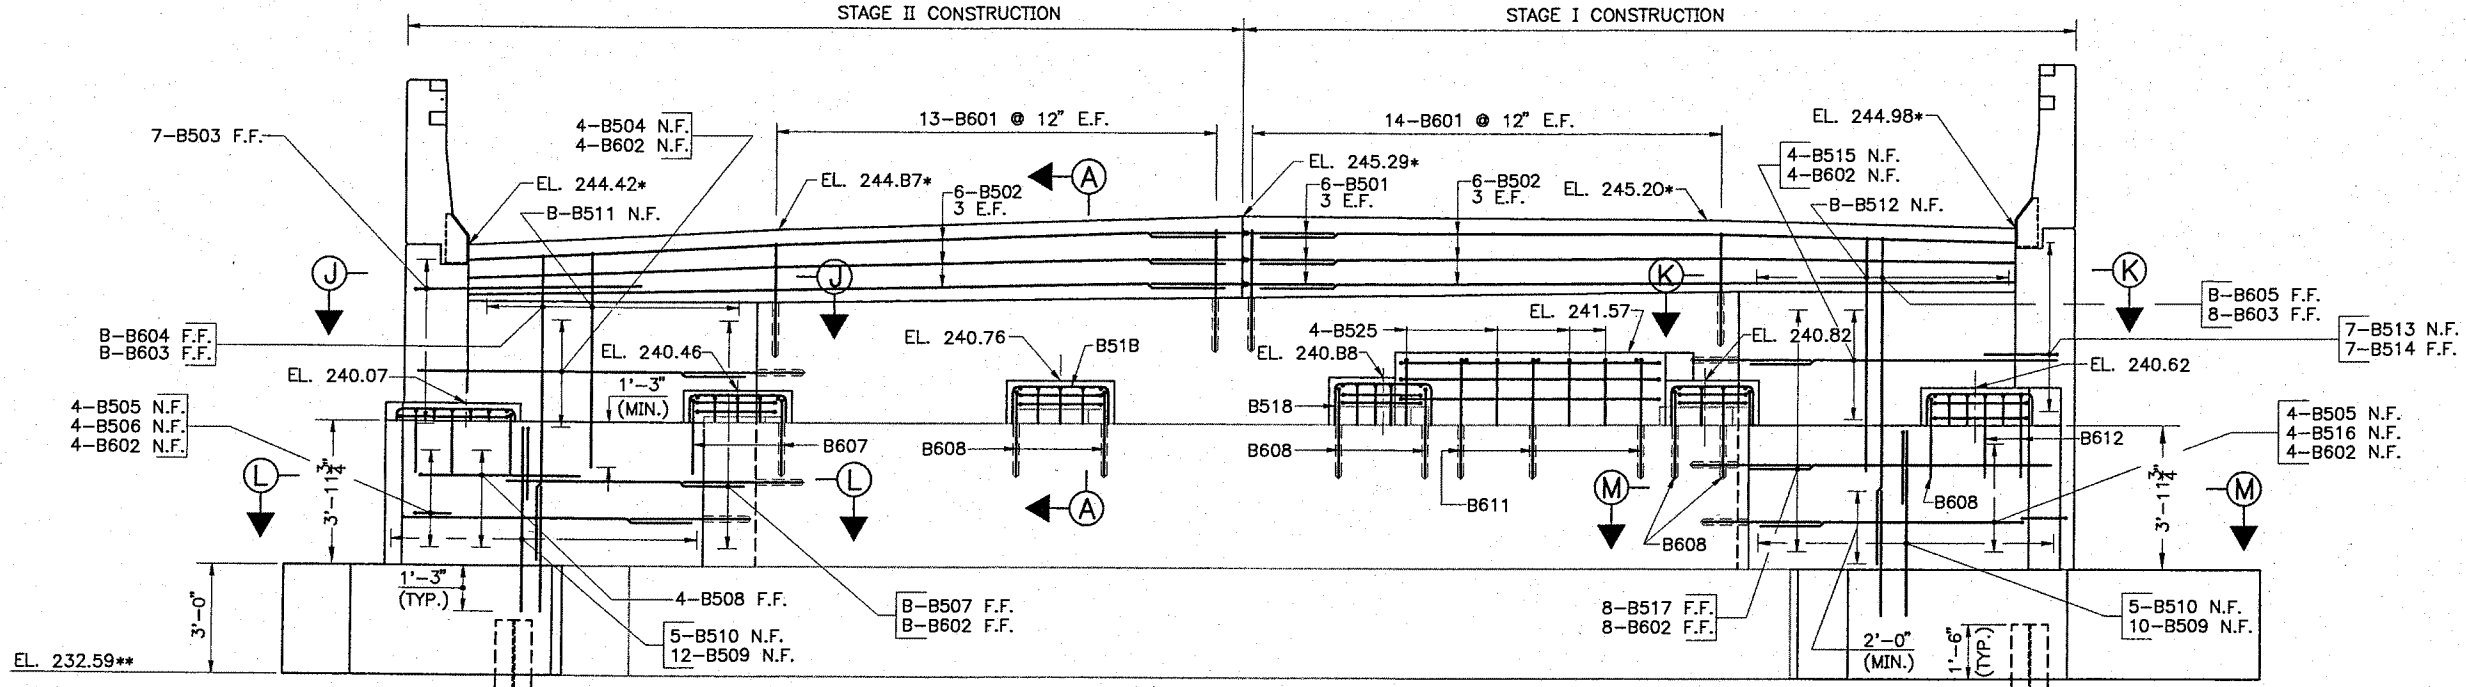

PROPOSED ELEVATION

3/8" = 1'-0"

NOTES

1. FOR ABUTMENT NOTES, SEE SHEET NO. SI-5.
2. FOR SECTIONS J-J, K-K, L-L AND M-M, SEE SHEET NO. SI-7.

M:\14335\003\001\SI\ABT1.SI.DWG 04/03/02 10:59

Scale: AS NOTED

Designed by:



ARCHITECTS ENGINEERS PLANNERS

HNTB CORPORATION
2 Thomas Drive
Westbrook, ME 04092
TEL (207) 774-5155
FAX (207) 772-7410

MAINE TURNPIKE AUTHORITY




SABATTUS INTERCHANGE/
ROUTE 9
ABUTMENT 1 MODIFICATIONS

No.	Revision	By	Date


	By	Date		By	Date
Designed	AD	11/01	Checked	AAD	3/02
Drawn	AD	11/01	In Charge of	RAL	3/02

CONTRACT: 2002.25


SHEET NUMBER: SI-6
39 OF 63

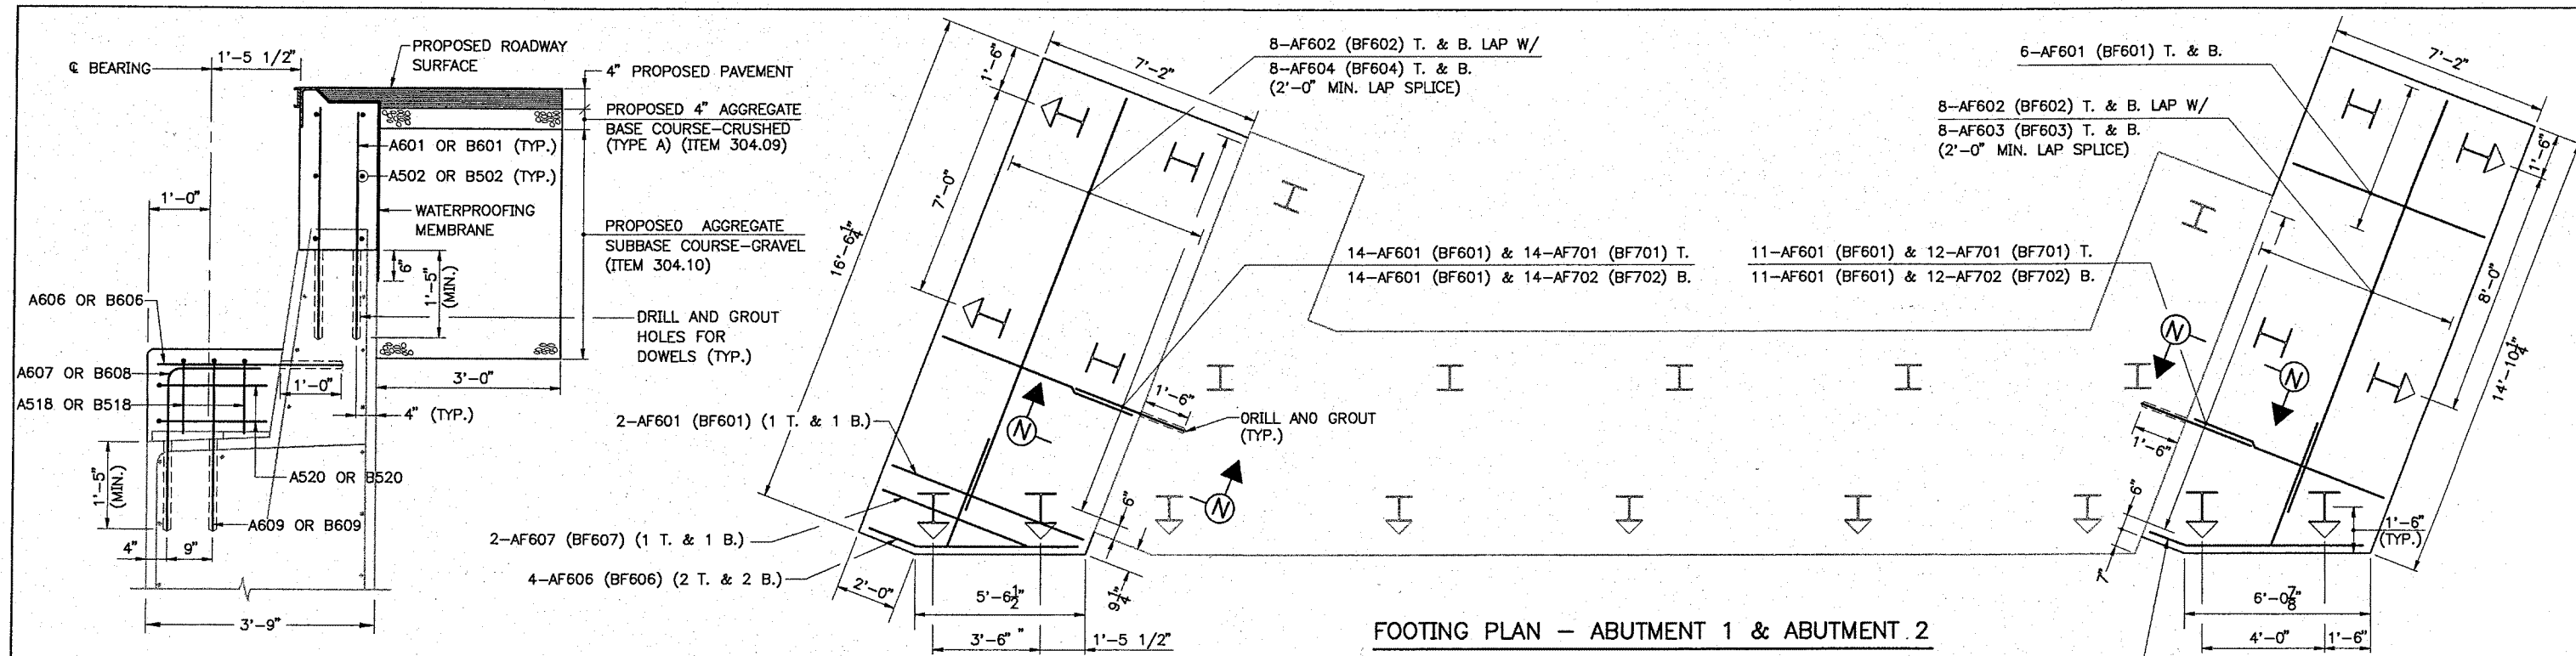


PROPOSED SECTION A-A
3/4" = 1'-0"

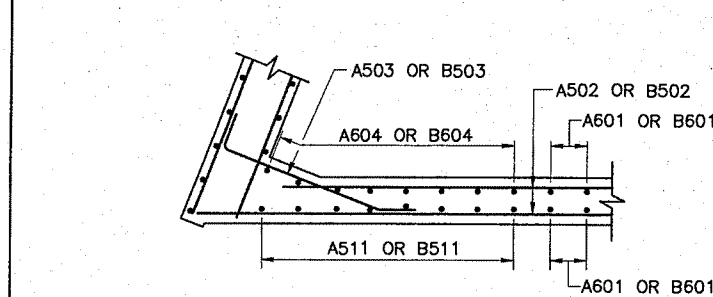


SECTION J-J
3/8" = 1'-0"

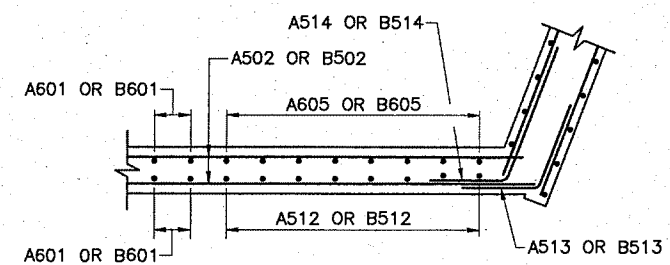


SECTION K-K
3/8" = 1'-0"

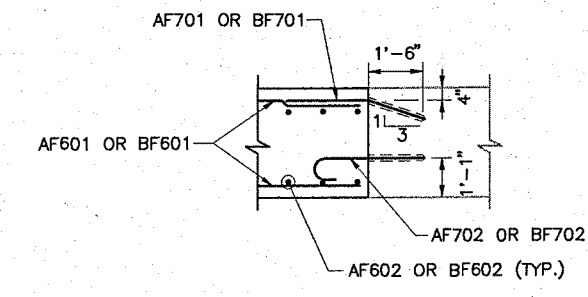

SECTION N-N
3/8" = 1'-0"

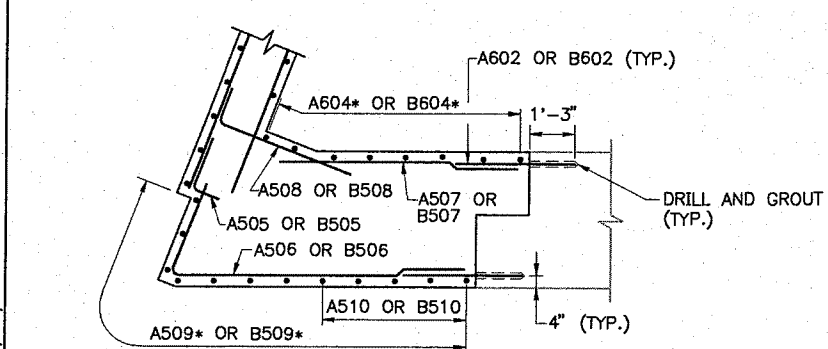


SECTION L-L
3/8" = 1'-0"

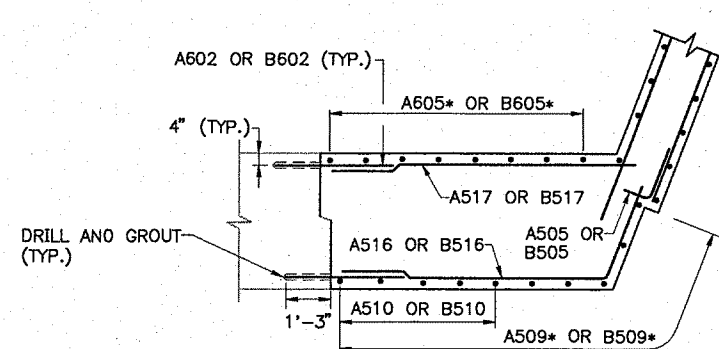

SECTION M-M
3/8" = 1'-0"

*SEE ABUTMENT NOTE 12, SHEET NO. SI-5.

FOOTING PLAN - ABUTMENT 1 & ABUTMENT 2
3/8" = 1'-0"

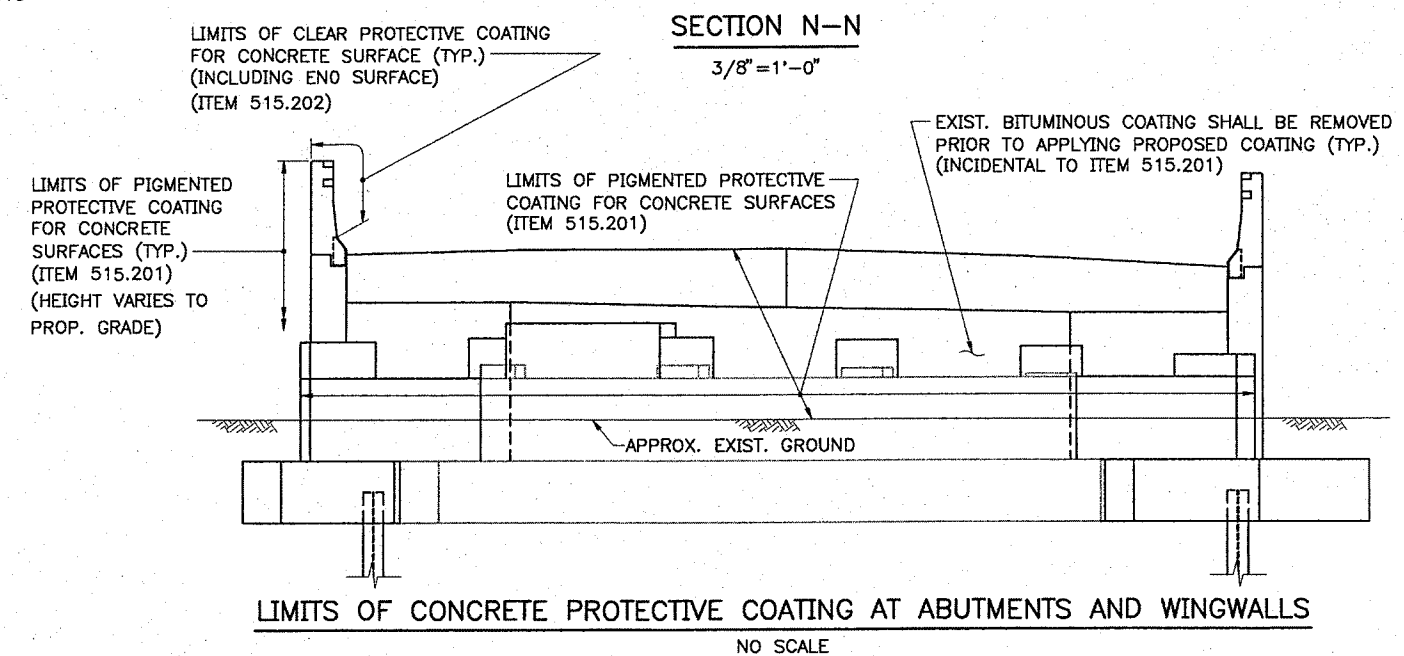

LIMITS OF CONCRETE PROTECTIVE COATING AT ABUTMENTS AND WINGWALLS
NO SCALE

M:\14335\003\001\SIABTDLI.DWG 04/03/02 11:00

Scale: AS NOTED

No.	Revision	By	Date

Designed by:

HNTB
ARCHITECTS ENGINEERS PLANNERS

By	Date	Checked	By	Date
AD	1/02	AAD	RAL	3/02
AD	1/02	In Charge of	RAL	3/02






HNTB CORPORATION
2 Thomas Drive
Westbrook, ME 04092
TEL (207) 774-5155
FAX (207) 772-7410

MAINE TURNPIKE AUTHORITY




SABATTUS INTERCHANGE/
ROUTE 9
ABUTMENT DETAILS

SHEET NUMBER: SI-7
40 OF 63

CONTRACT: 2002.25

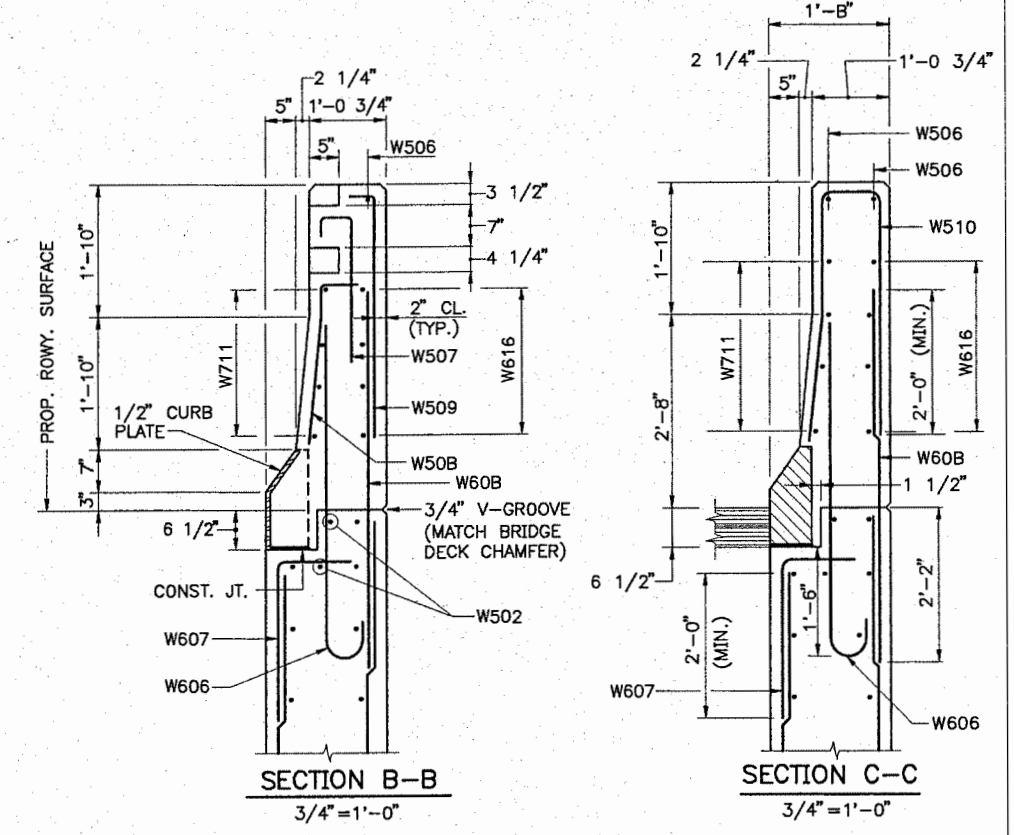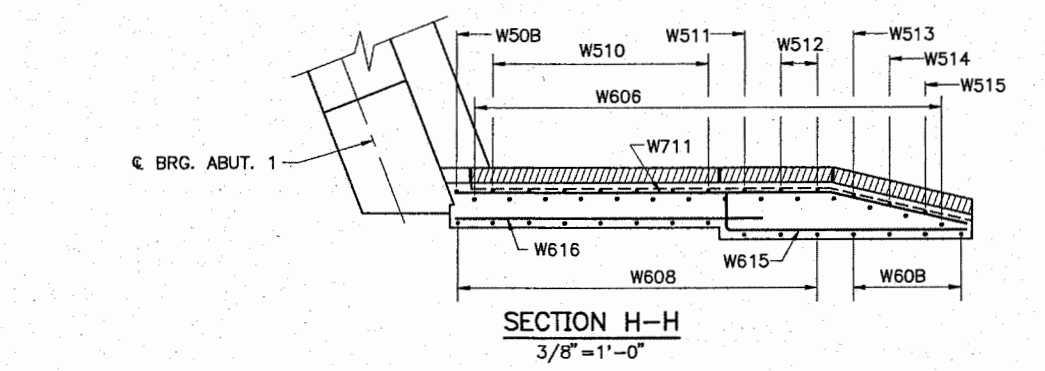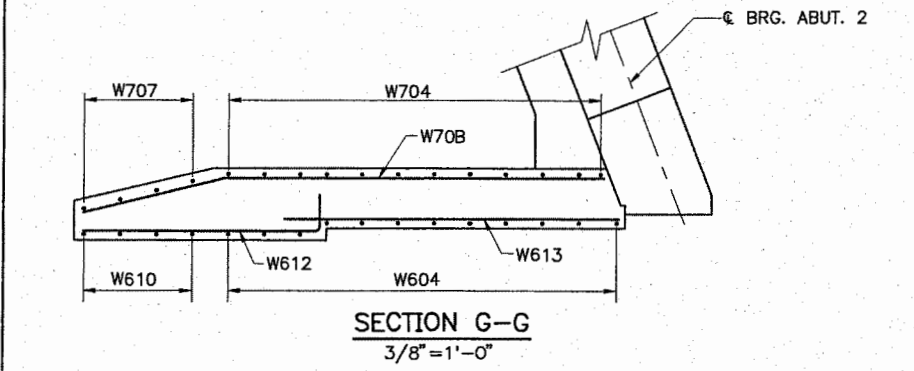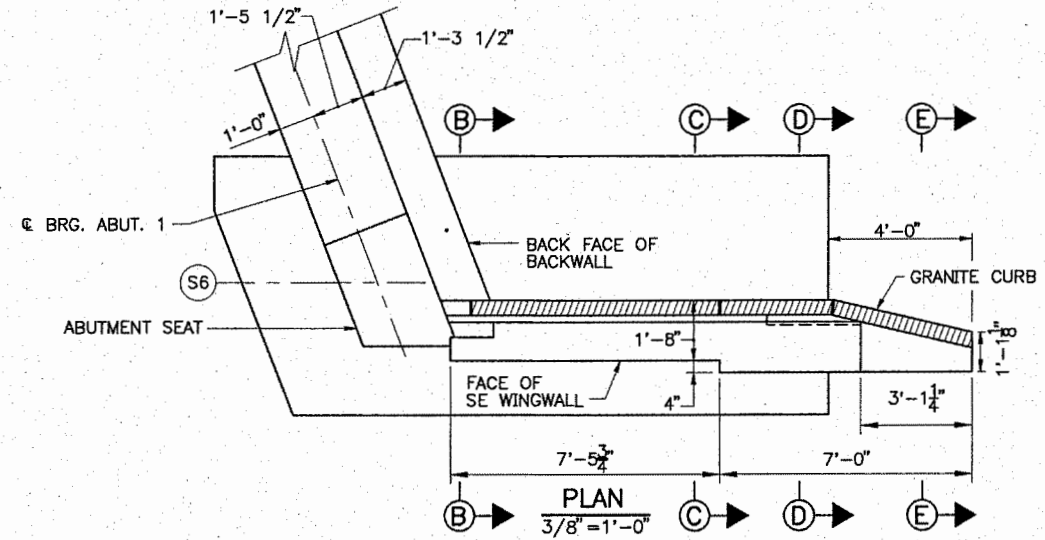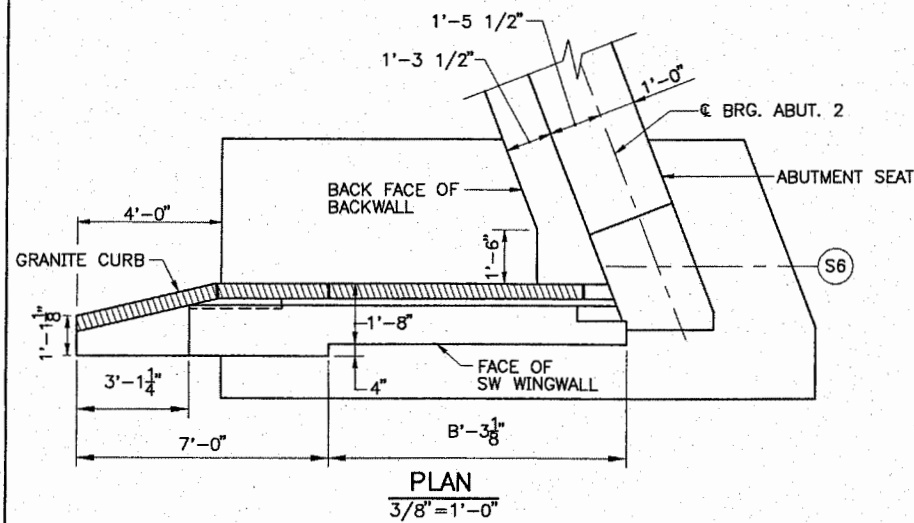

* TYP. FOR SECTIONS B, C, D & E

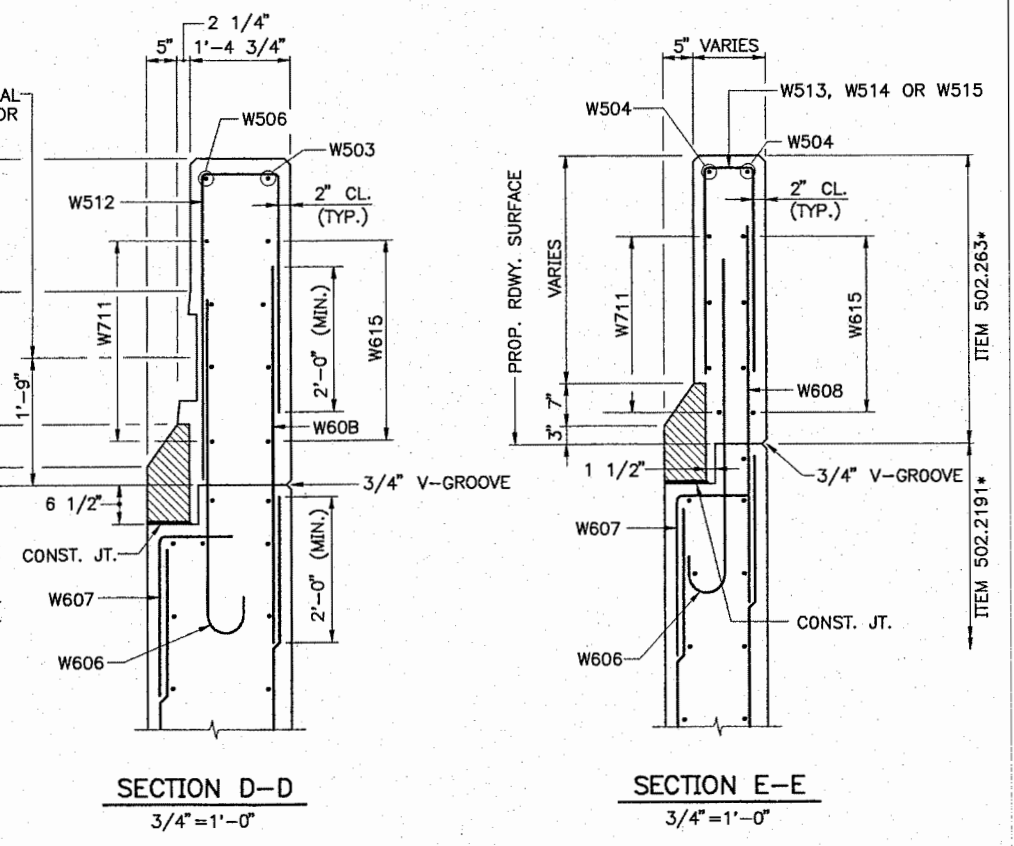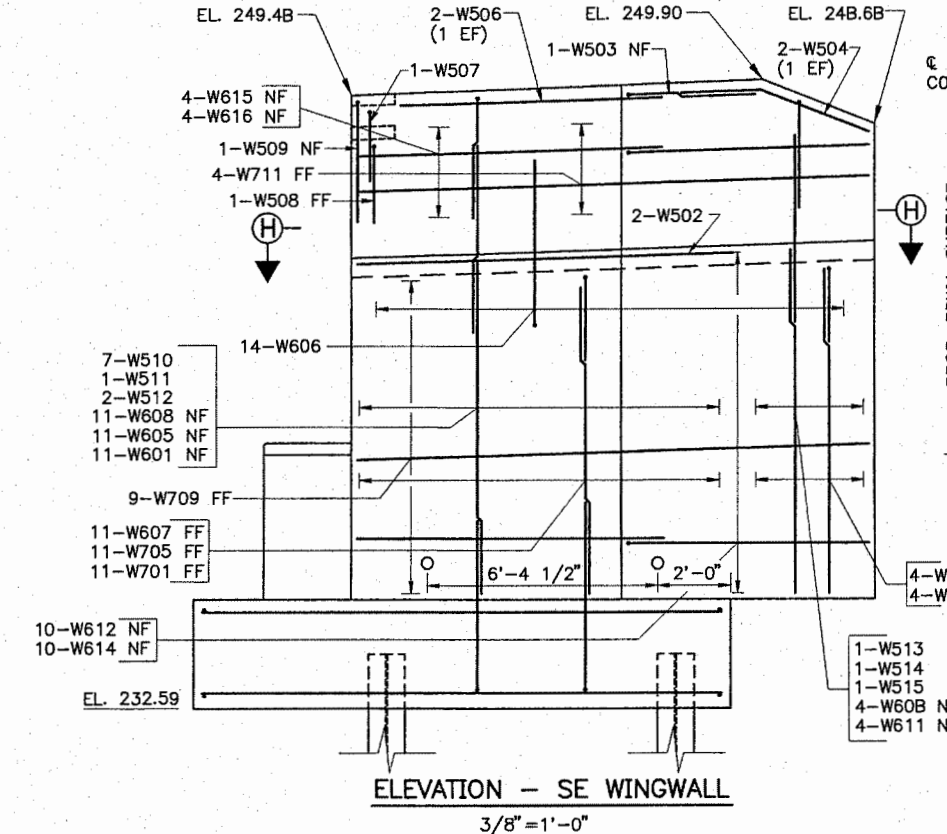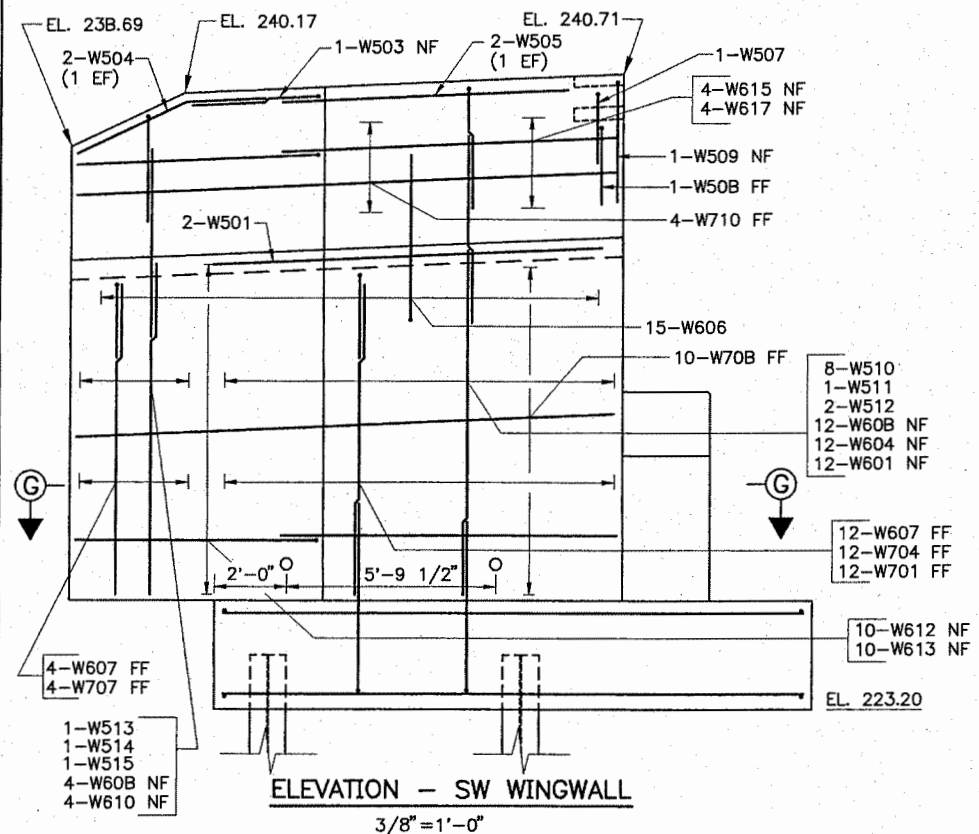

M:\14335\003\001\SSWING\SI.OWG 04/03/02 11:01

Scale: AS NOTED

No.	Revision	By	Date

Designed by:

HNTB
ARCHITECTS ENGINEERS PLANNERS

By	Date	Checked	By	Date
AD	1/02	AAD	AD	3/02
AD	1/02	In Charge of	RAL	3/02


HNTB CORPORATION
2 Thomas Drive
Westbrook, ME 04092
TEL (207) 774-5155
FAX (207) 772-7410

MAINE TURNPIKE AUTHORITY



CONTRACT: 2002.25

SABATTUS INTERCHANGE/
ROUTE 9
WINGWALL DETAILS I



SHEET NUMBER: SI-8
41 OF 63

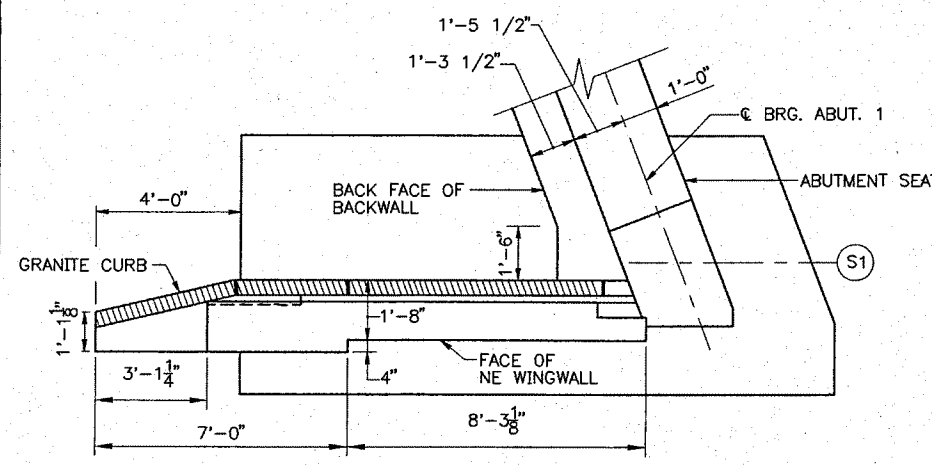



PLAN
3/8" = 1'-0"

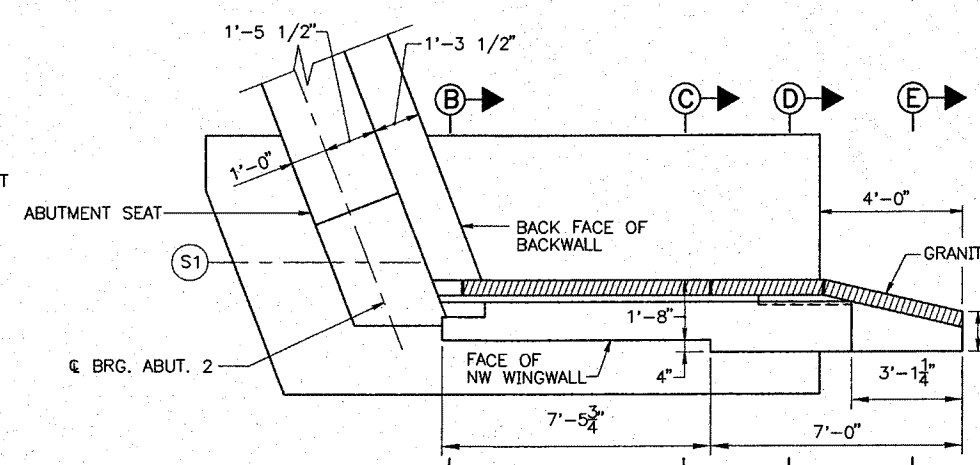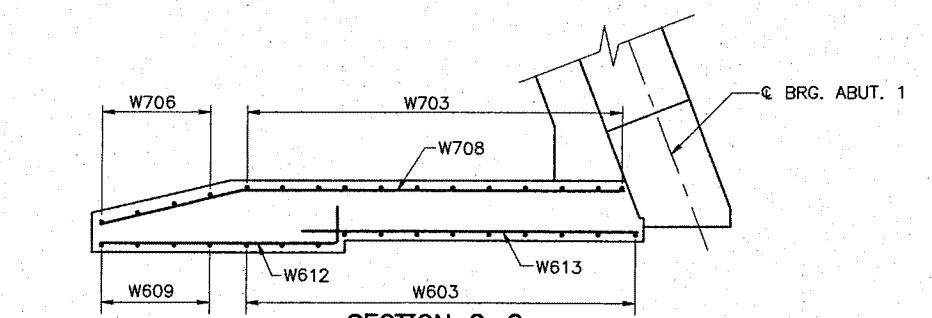


PLAN
3/8" = 1'-0"

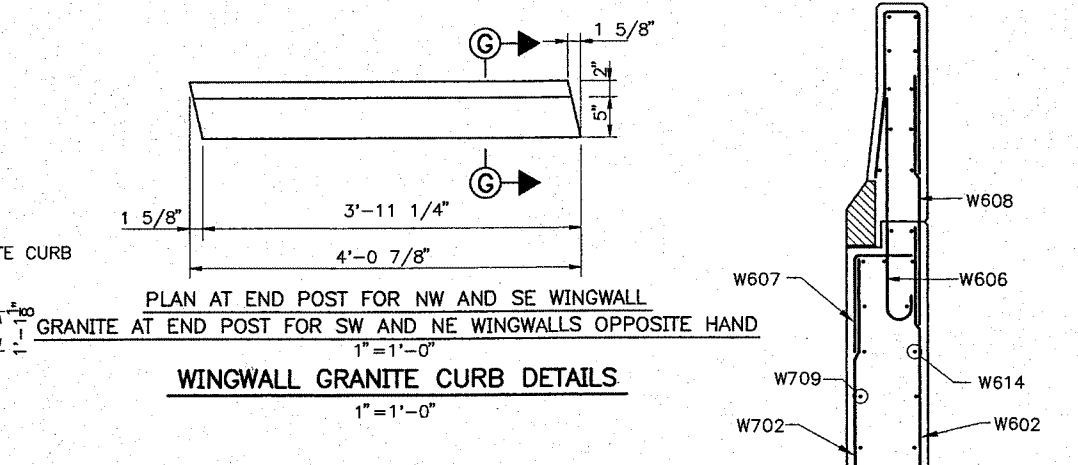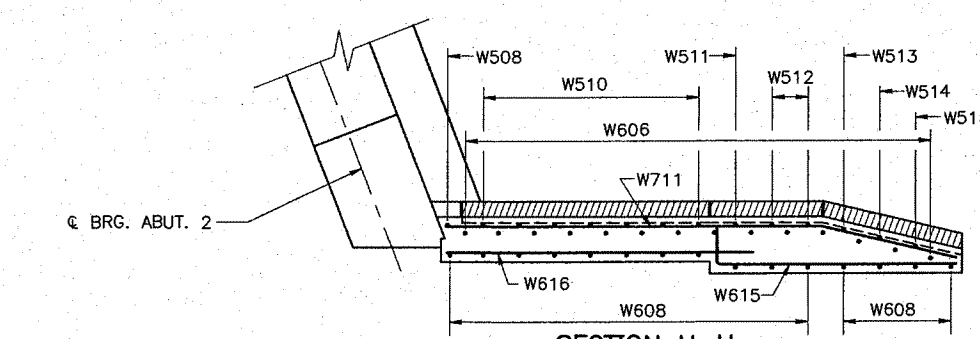



WINGWALL GRANITE CURB DETAILS

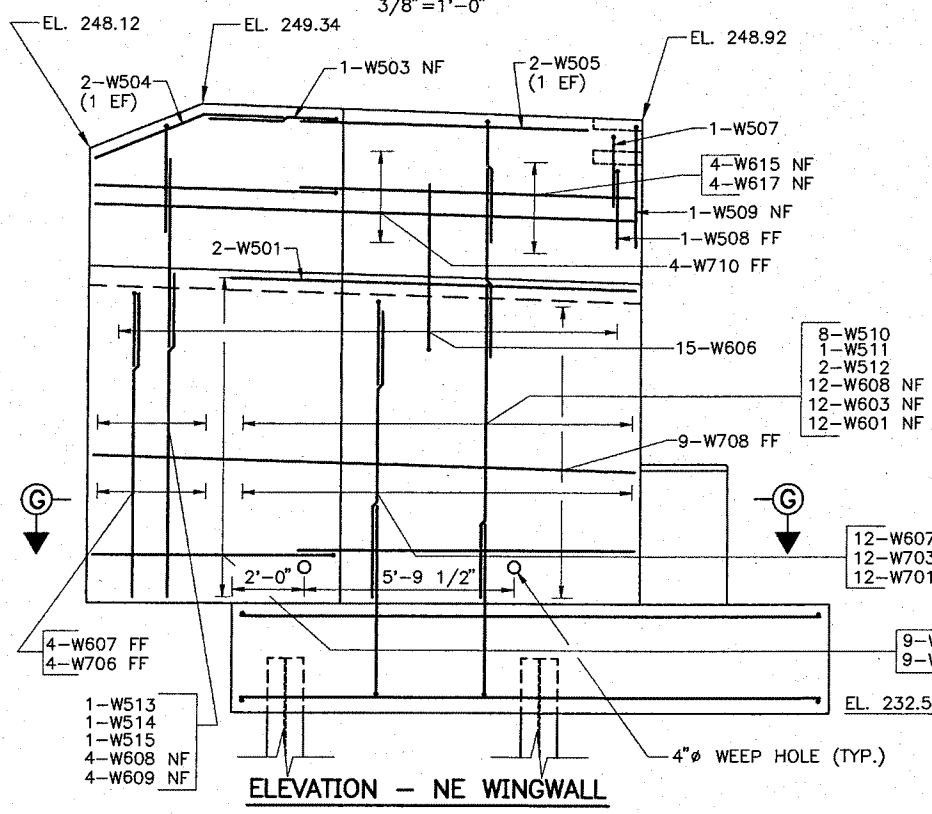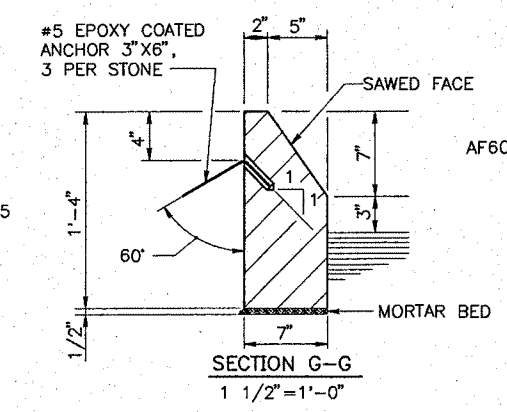

ELEVATION - NE WINGWALL
3/8" = 1'-0"

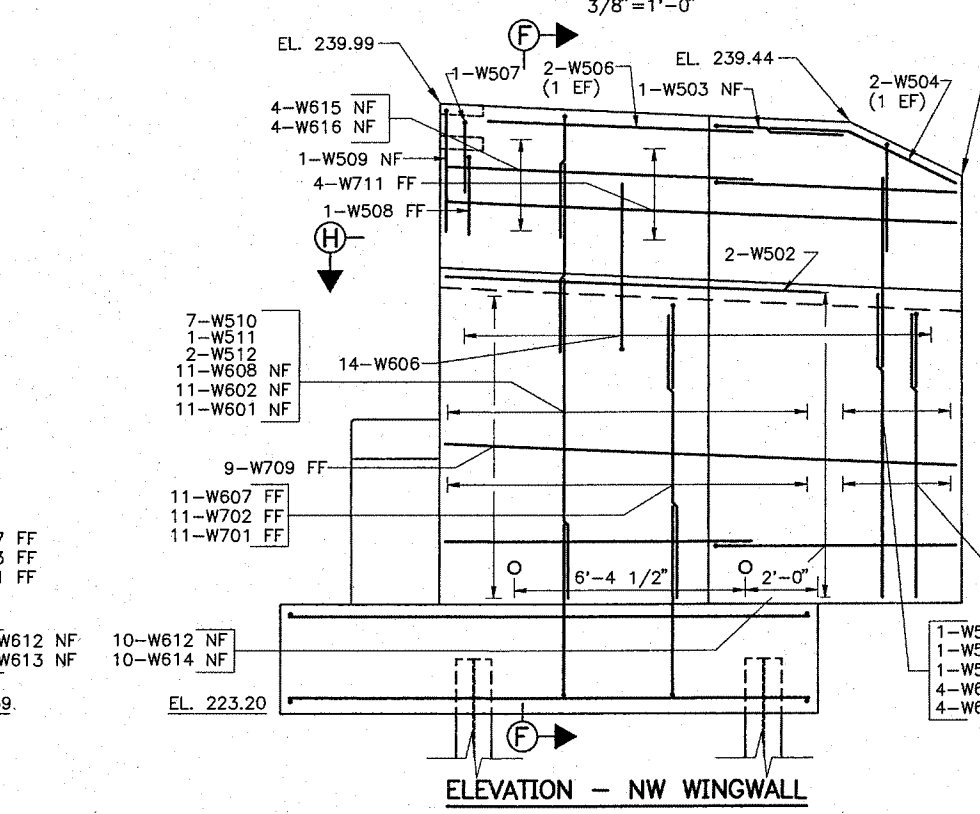

ELEVATION - NW WINGWALL
3/8" = 1'-0"

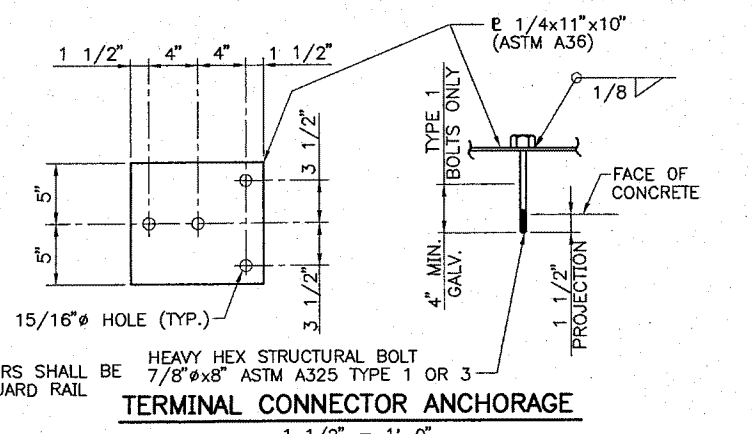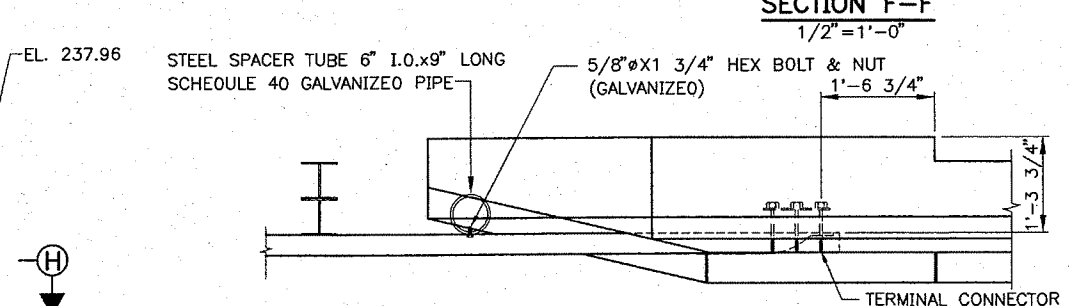

THE W-BEAM TERMINAL CONNECTORS SHALL BE INCIDENTAL TO ITEM 606.1735, GUARD RAIL ATTACHMENT-TYPE A.

M:\14335\003\001\SSWING251.DWG 01/16/02 11:53

Scale: AS NOTED

No.	Revision	By	Date

Designed by:

HNTB
ARCHITECTS ENGINEERS PLANNERS

By	Date	By	Date
AD	1/02	AAD	3/02
AD	1/02	RAL	3/02


HNTB CORPORATION
2 Thomas Drive
Westbrook, ME 04092
TEL (207) 774-5155
FAX (207) 772-7410

MAINE TURNPIKE AUTHORITY
MODERNIZATION AND WIDENING PROJECT

SABATTUS INTERCHANGE/
ROUTE 9
WINGWALL DETAILS II

CONTRACT: 2002.25

SHEET NUMBER: SI-9
42 OF 63

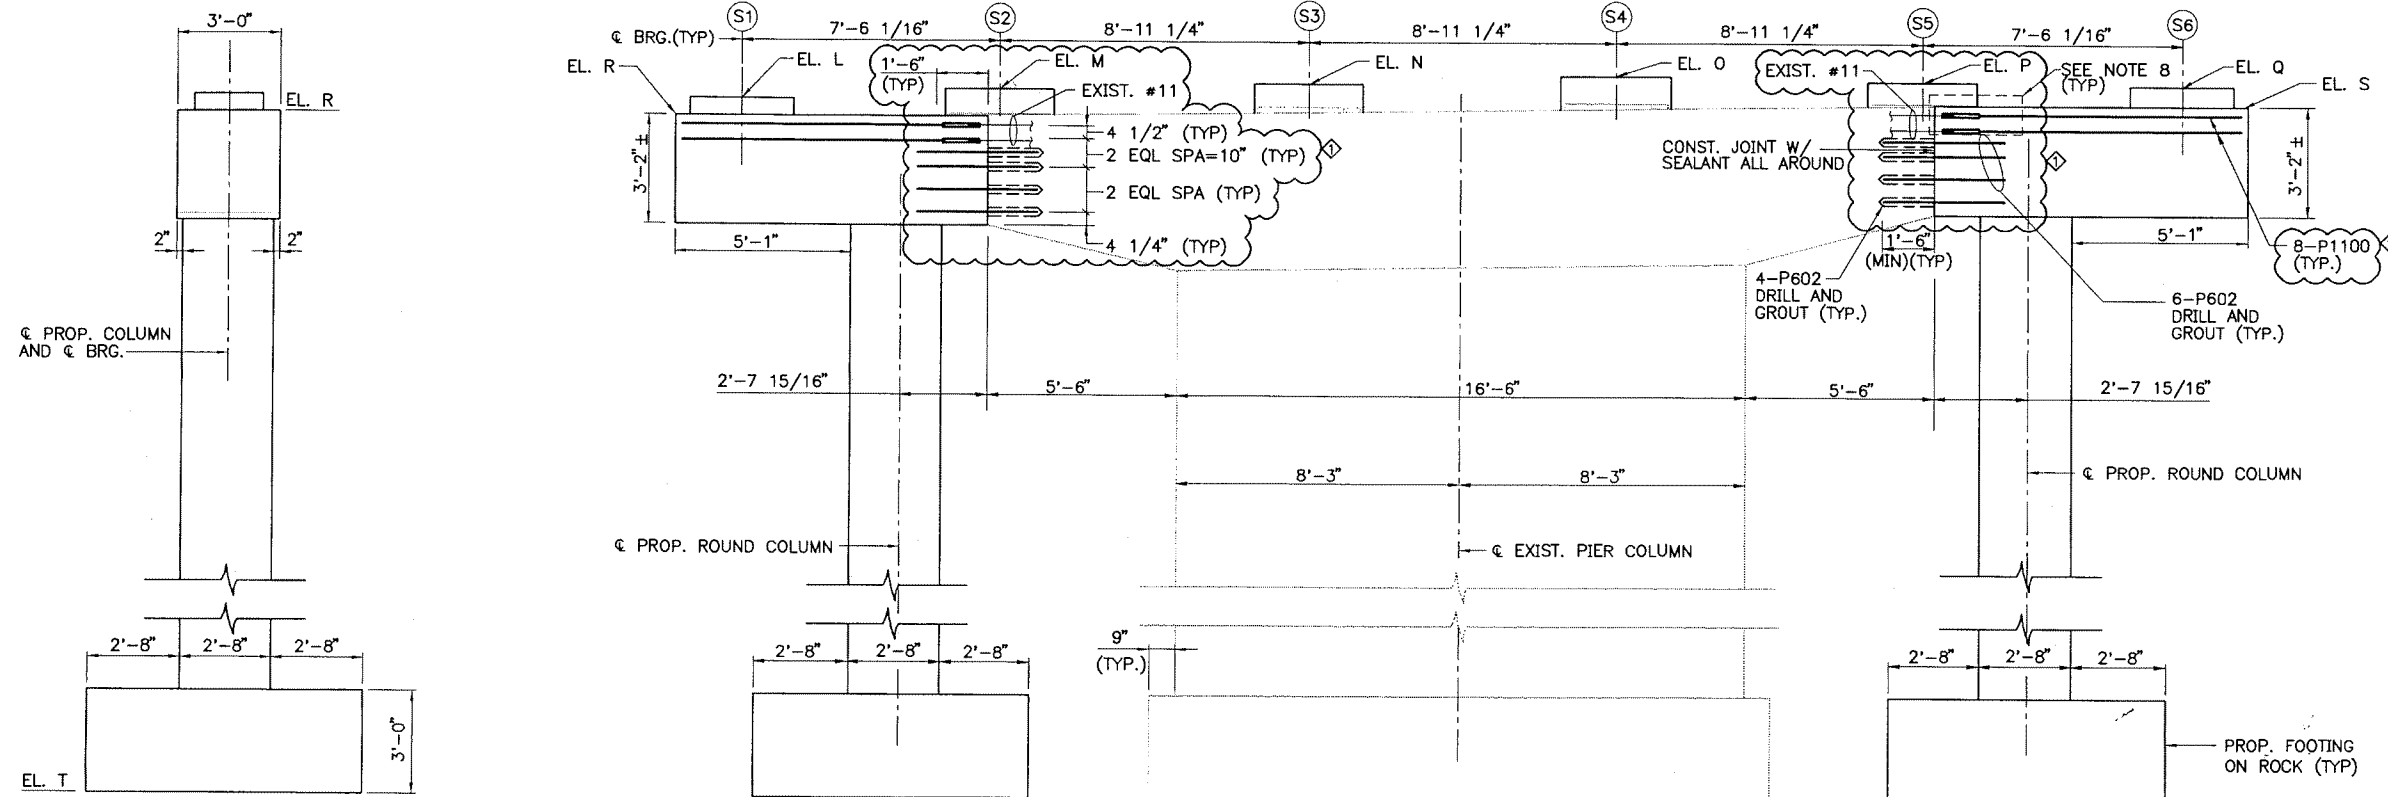


PIER ELEVATIONS			
POINT	PIER 1	PIER 2	PIER 3
L	238.11	235.88	233.25
M	238.50	236.29	233.66
N	238.81	236.61	233.99
O	238.94	236.74	234.14
P	238.88	236.69	234.10
Q	238.69	236.51	233.92
R*	237.24	235.00	232.03
S*	237.88	235.58	232.86
T*	211.00	214.00	210.00


NOTE
 * ELEVATIONS ARE APPROXIMATE.
 ACTUAL ELEVATION SHALL BE
 DETERMINED IN THE FIELD.

END ELEVATION - PIER 1
 3/8" = 1'-0"

ELEVATION - PIER 1 (PIER 2, 3 SIMILAR)
 (LOOKING UPSTATION)
 3/8" = 1'-0"

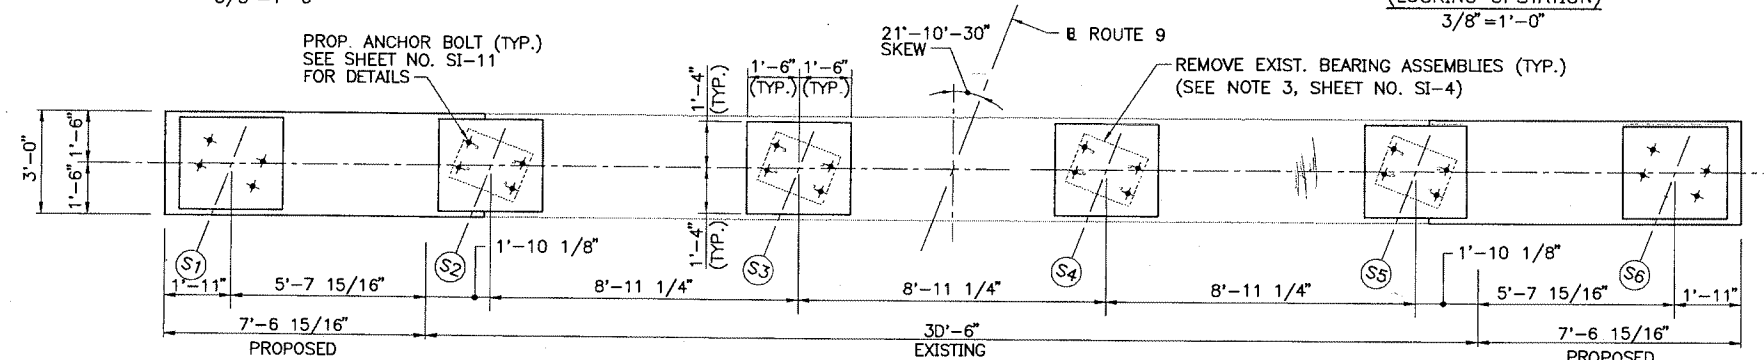

PLAN - PIER 2
 3/8" = 1'-0"

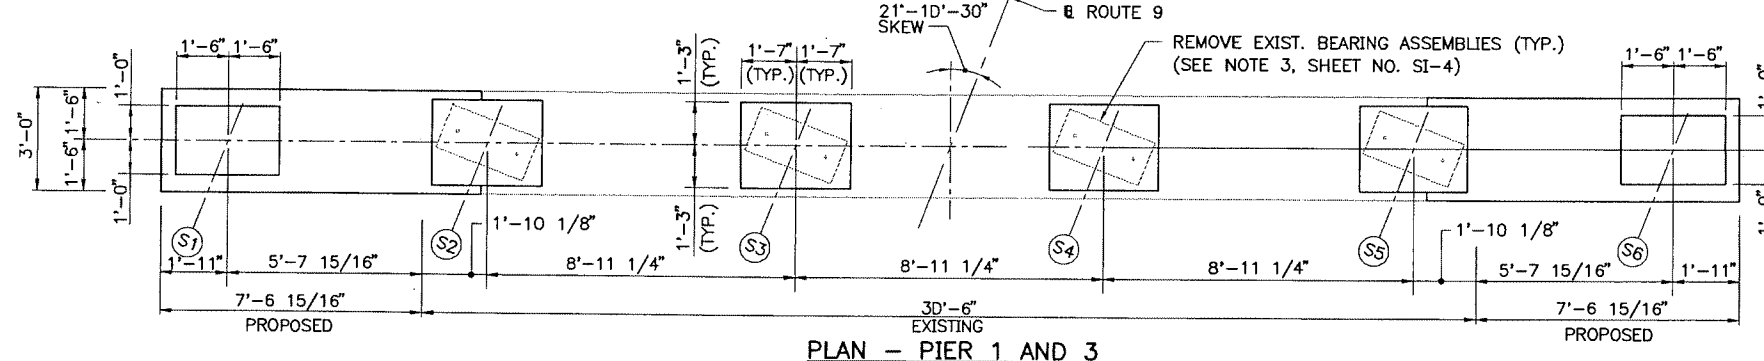

PLAN - PIER 1 AND 3
 3/8" = 1'-0"

NOTES

- REINFORCING SHOWN IS TYPICAL FOR ALL PIERS, UNLESS OTHERWISE NOTED.
- THE CONTRACTOR SHALL EXPOSE THE TOP LAYER OF THE EXISTING PIER CAP REINFORCING STEEL, PRIOR TO DRILLING AND GROUTING ANY DOWELS. THE CONTRACTOR SHALL REPORT INTERFERENCE OF DOWELS WITH EXISTING REINFORCING STEEL TO THE ENGINEER. CARE SHALL BE TAKEN NOT TO DAMAGE THE EXISTING REINFORCING STEEL. (DRILLING AND GROUTING HOLES SHALL BE INCIDENTAL TO ITEM 502.239).
- THE CONTRACTOR SHALL SET THE ANCHOR BOLTS IN PLACE AT THE SAME TIME AS THE REINFORCEMENT IS SET FOR THE PEDESTALS. REINFORCEMENT SHALL BE PLACED TO AVOID REQUIRED ANCHOR BOLT LAYOUT.
- SEE SHEET NO. SI-26 FOR REINFORCING STEEL SCHEDULE.
- REMOVE ALL DETERIORATED OR LOOSE CONCRETE AT EACH OF THE EXISTING CONCRETE PEDESTALS. CLEAN AND ROUGHEN ALL CONCRETE SURFACES TO ELIMINATE BOND INHIBITING MATERIALS, INCLUDING LOCATIONS OF ALL BUILT-UP PEDESTAL AREAS ON TOP OF THE PIER CAPS. CLEAN ALL EXPOSED REINFORCING STEEL USING AN ACCEPTABLE METHOD APPROVED OF BY THE ENGINEER, THEN APPLY AN EPOXY COATING TO BARS. APPLY A BONDING AGENT TO THE EXISTING SUBSTRATE BY FOLLOWING THE MANUFACTURER'S INSTRUCTIONS AND APPROVED OF BY THE ENGINEER, PRIOR TO PLACEMENT OF NEW CONCRETE. (PAYMENT SHALL BE INCIDENTAL TO ITEM 502.239).
- LIMIT OF PIER EXCAVATION SHALL BE 1'-6" BEYOND THE EDGE OF THE PROPOSED PIER-FOOTINGS AND BE PAID FOR UNDER ITEM 206.10.
- ALL PROPOSED CONCRETE SURFACES, ABOVE FINISHED GRADE, SHALL BE COATED WITH PROTECTIVE COATING, ITEM 515.201, EXCEPT NON-TRAFFIC SIDE OF PIERS 1 AND 3 ONLY.
- SELECT DEMOLITION METHOD SUCH THAT EXISTING #11 BARS ARE NOT DAMAGED.

Scale: AS NOTED

No.	Revision	By	Date
1	REINFORCING STEEL DETAILS	AD	5/26/02

Designed by:

HNTB
 ARCHITECTS ENGINEERS PLANNERS

Designed	By	Date	Checked	By	Date
	AAD	12/01		ML	1/02
Drawn	AMR	1/02	In Charge of	RAL	3/02

HNTB CORPORATION
 2 Thomas Drive
 Westbrook, ME 04092
 TEL (207) 774-5155
 FAX (207) 772-7410

MAINE TURNPIKE AUTHORITY











Transpass

SABATTUS INTERCHANGE/
 ROUTE 9
 PIER MODIFICATIONS I

SHEET NUMBER: SI-10
 CONTRACT: 2002.25
 43 OF 63

M:\14335\003\001\SSPIERSI.DWG 04/03/02 15:01

M:\14335\003\001\SSPIERSI.DWG 06/27/02 09:57

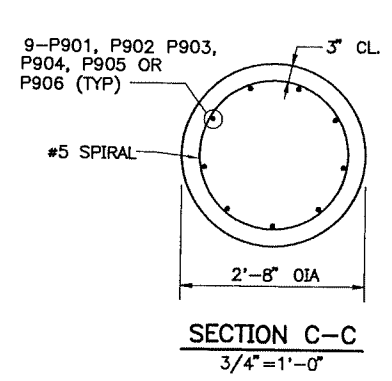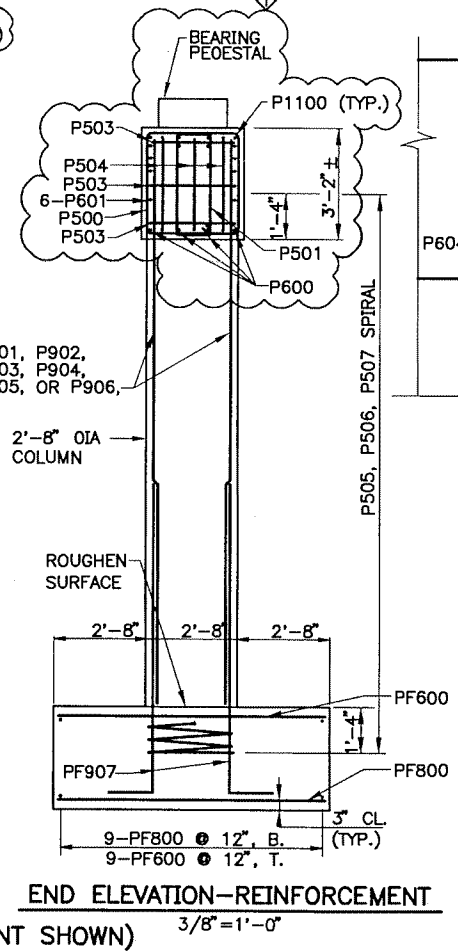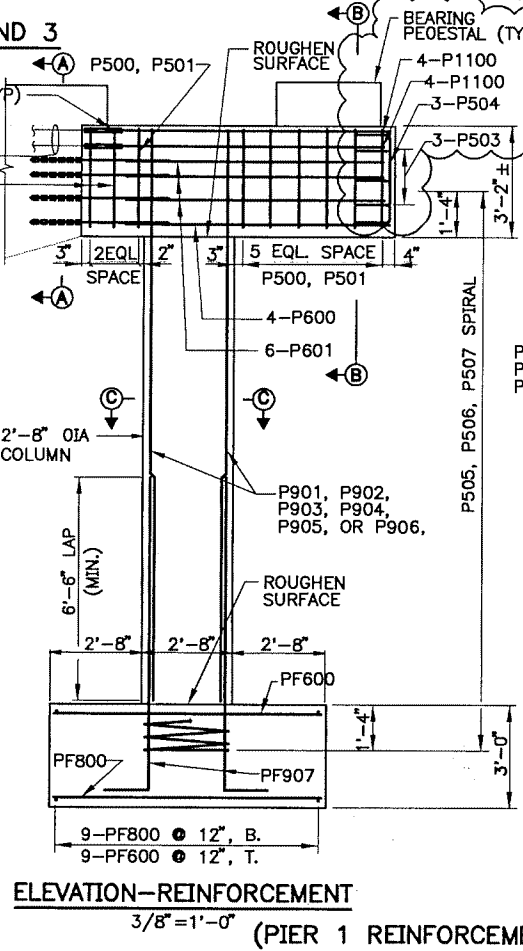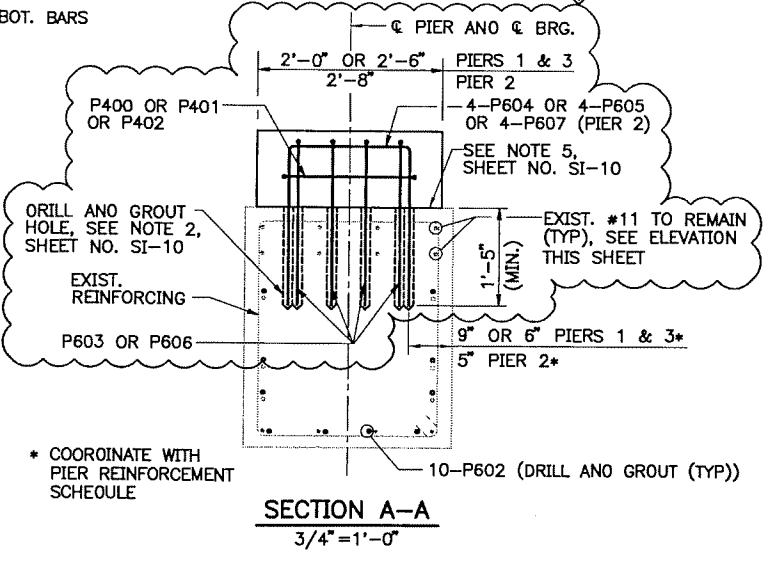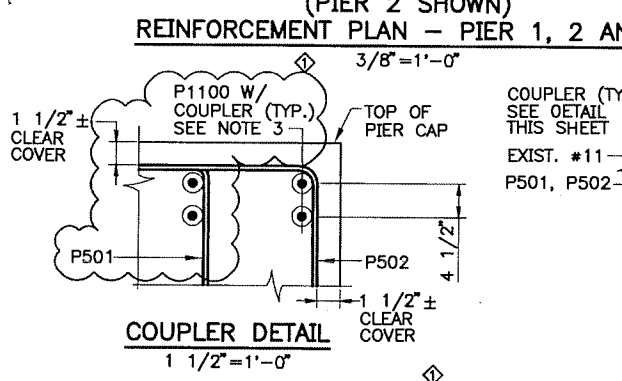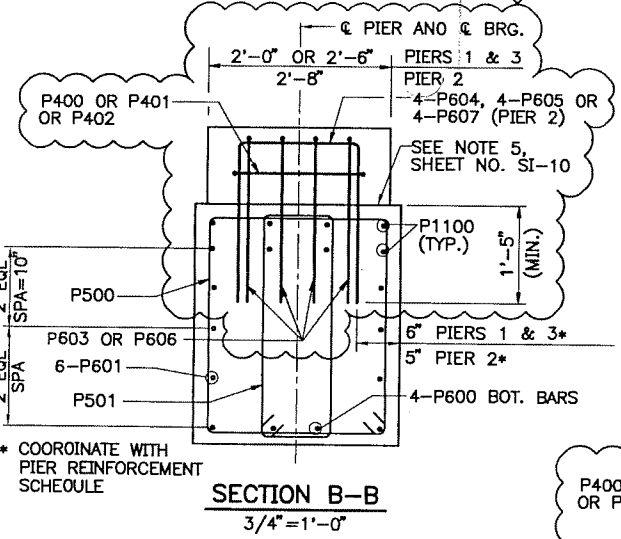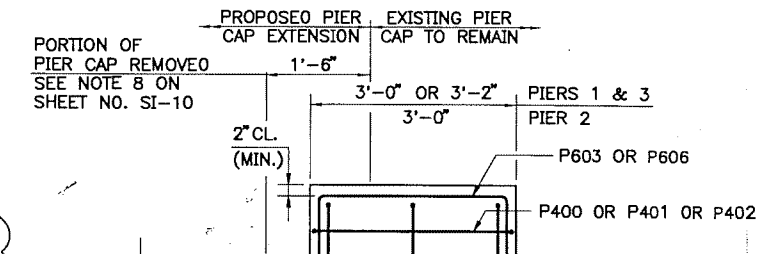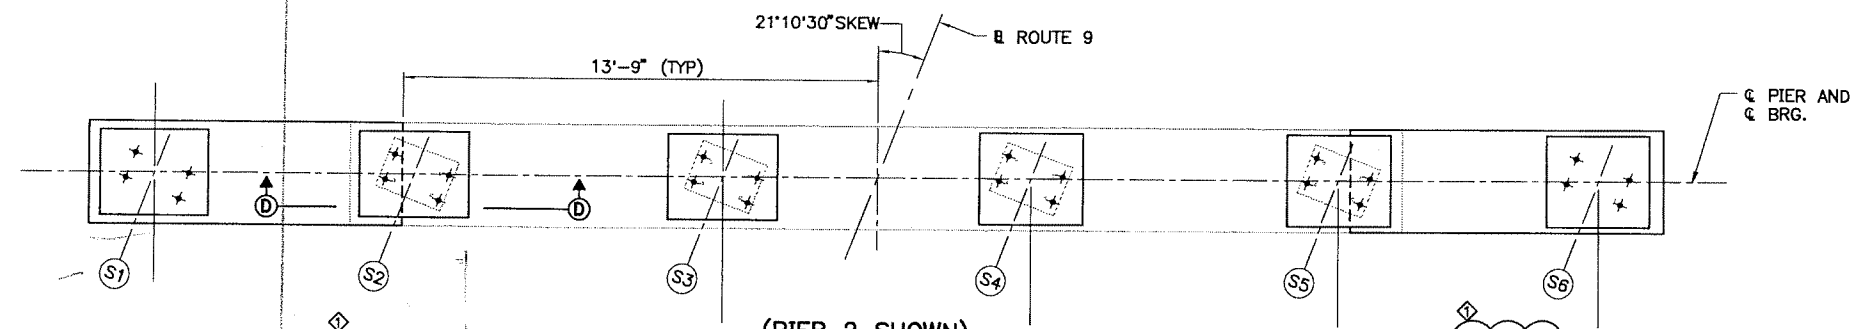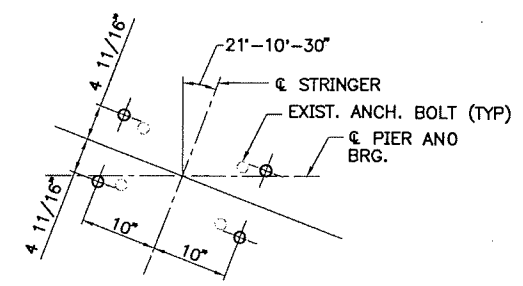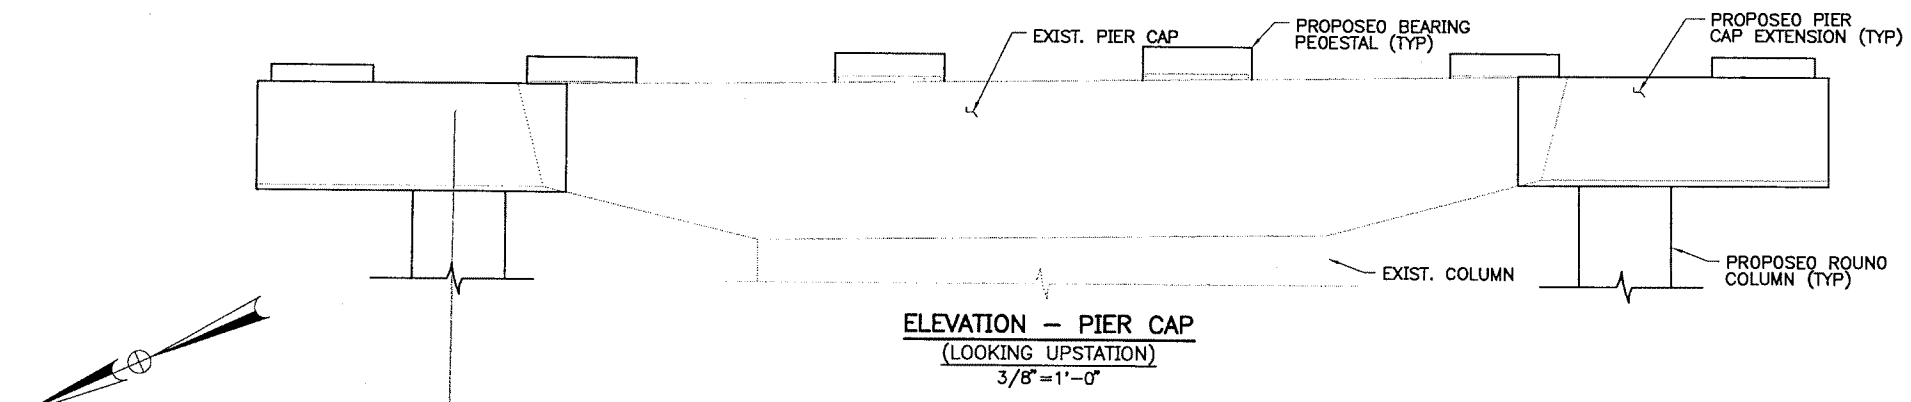

- NOTES**
1. REINFORCING SHOWN IS TYPICAL FOR ALL PIERS, UNLESS OTHERWISE NOTED.
 2. FOR PIERS 2 AND 3 PILE LAYOUT AND PILE CAP REINFORCEMENT, SEE SHEET SI-12.
 3. USE ERICO CAOWELD MECHANICAL SPLICE COUPLER OR APPROVED EQUAL. THE COUPLERS SHALL BE INCIDENTAL TO REINFORCING STEEL ITEM 503.12. THE #11 BARS AND COUPLERS SHALL BE EPOXY PAINTED AFTER INSTALLATION.

Scale: AS NOTED

No.	Revision	By	Date
1	REINFORCING STEEL DETAILS	AD	5/26/02

Designed by:

HNTB
ARCHITECTS ENGINEERS PLANNERS


By	Date	Checked	By	Date
Designed AAD	12/01	Checked ML	ML	1/02
Drawn LL	12/01	In Charge of RAL	RAL	3/02

HNTB CORPORATION
2 Thomas Drive
Westbrook, ME 04092
TEL (207) 774-5155
FAX (207) 772-7410

MAINE TURNPIKE AUTHORITY




SABATTUS INTERCHANGE/
ROUTE 9
PIER MODIFICATIONS II

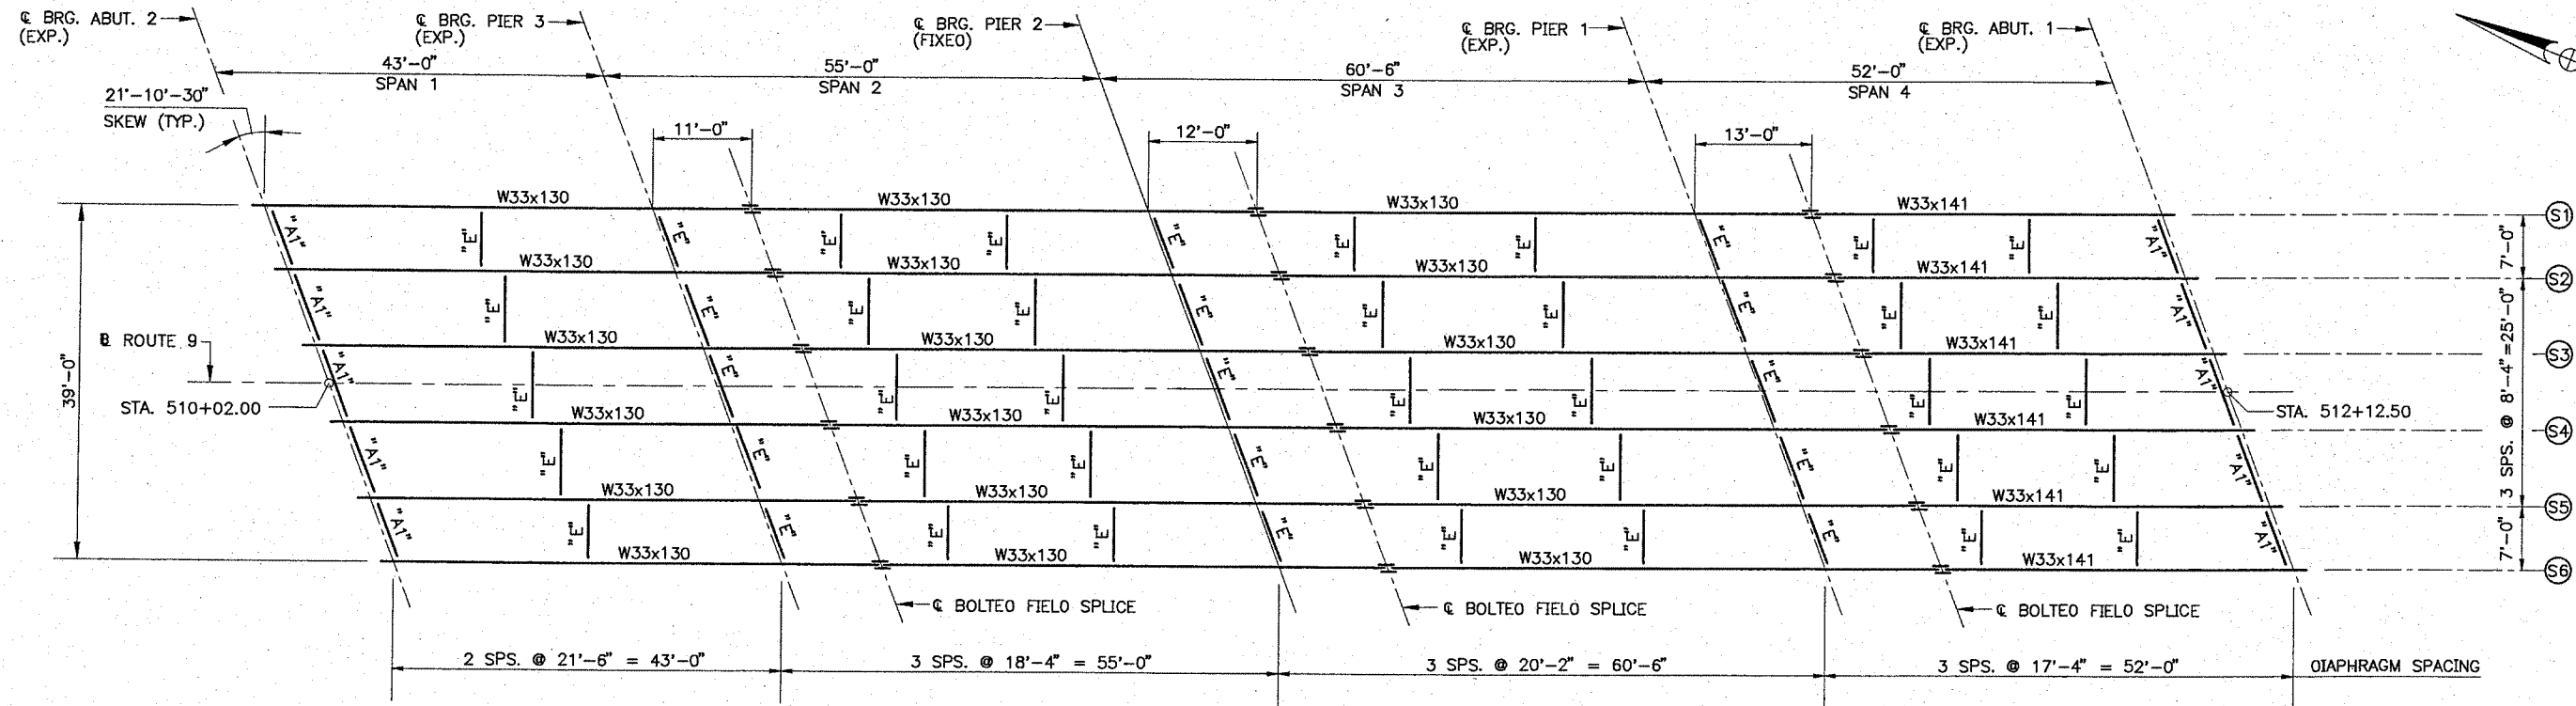

FRAMING PLAN
1"=10'

NOTE
THE CONNECTION PLATES AND DIAPHRAGM LENGTHS FOR TYPE "E" DIAPHRAGM (SKEWED) AT PIER LOCATIONS WILL BE DIFFERENT THAN TYPICAL TYPE "E" DIAPHRAGM ALONG SPAN WITH NO SKEW.

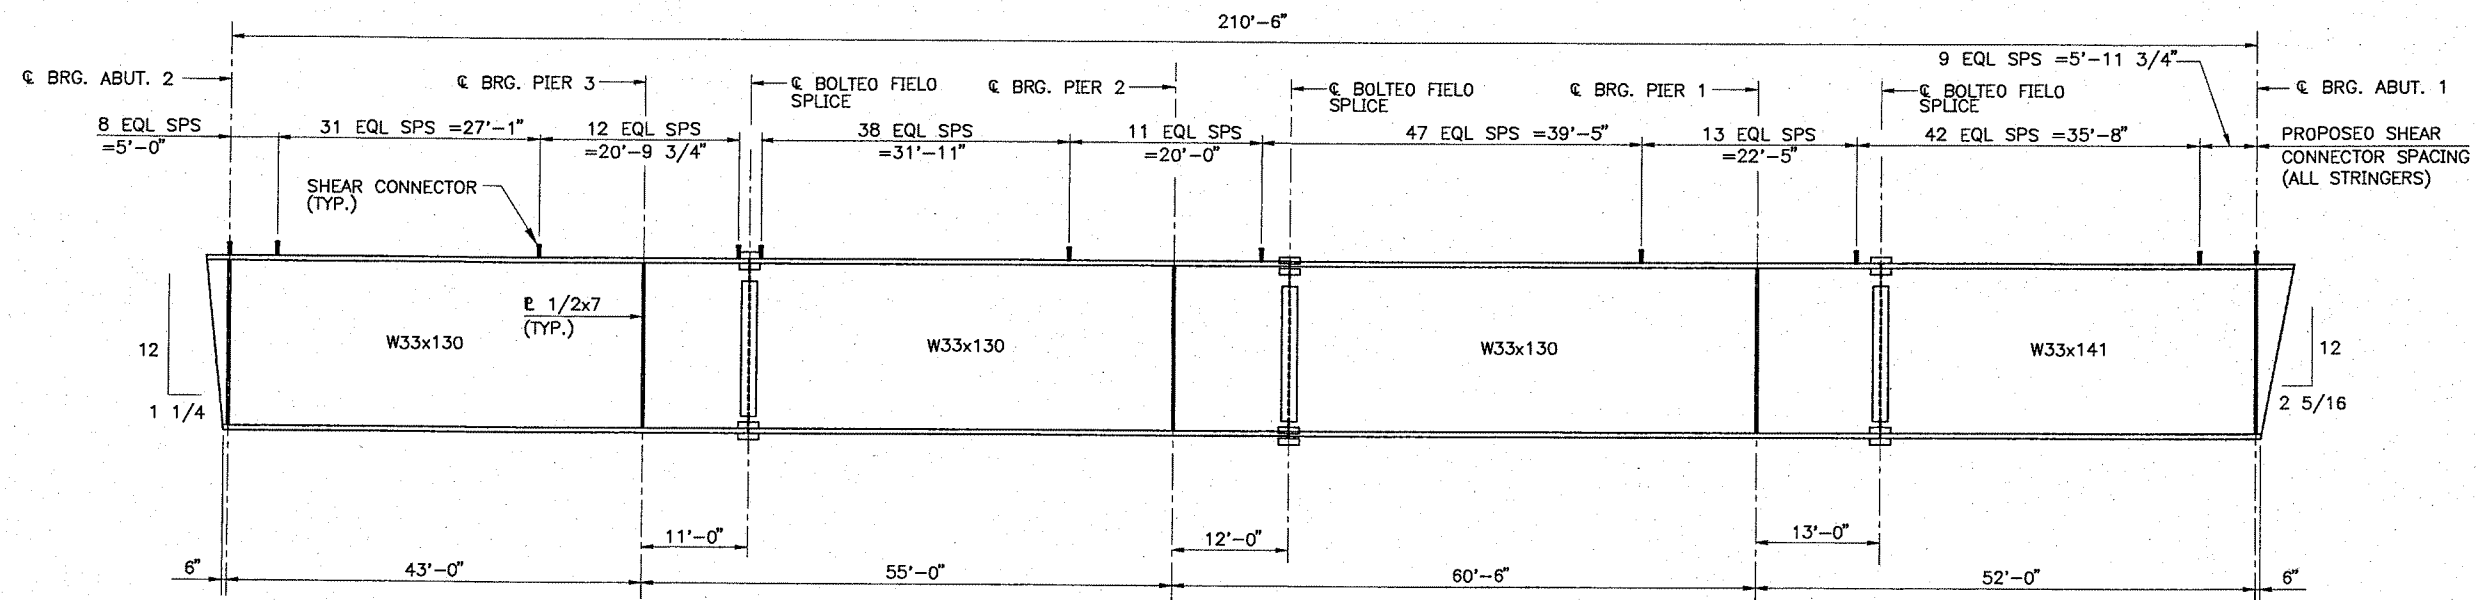

(S1) - (S6) STRINGER ELEVATION
1"=10' (HORIZONTAL)

NOTE
FOR NOTES, SEE SHEET NO. SI-14.

M:\14335\003\001\SI\FRMS1.DWG 04/03/02 16:00

Scale: AS NOTED

No.	Revision	By	Date

Designed by:

HNTB
ARCHITECTS ENGINEERS PLANNERS

By	Date	By	Date
ML	11/01	AAD	12/01
AR	11/01	RAL	3/02


HNTB CORPORATION
2 Thomas Drive
Westbrook, ME 04092
TEL (207) 774-5155
FAX (207) 772-7410

MAINE TURNPIKE AUTHORITY


Transpass

SABATTUS INTERCHANGE/
ROUTE 9
FRAMING PLAN AND
STRINGER ELEVATION

SHEET NUMBER: SI-13
CONTRACT: 2002.25
46 OF 63

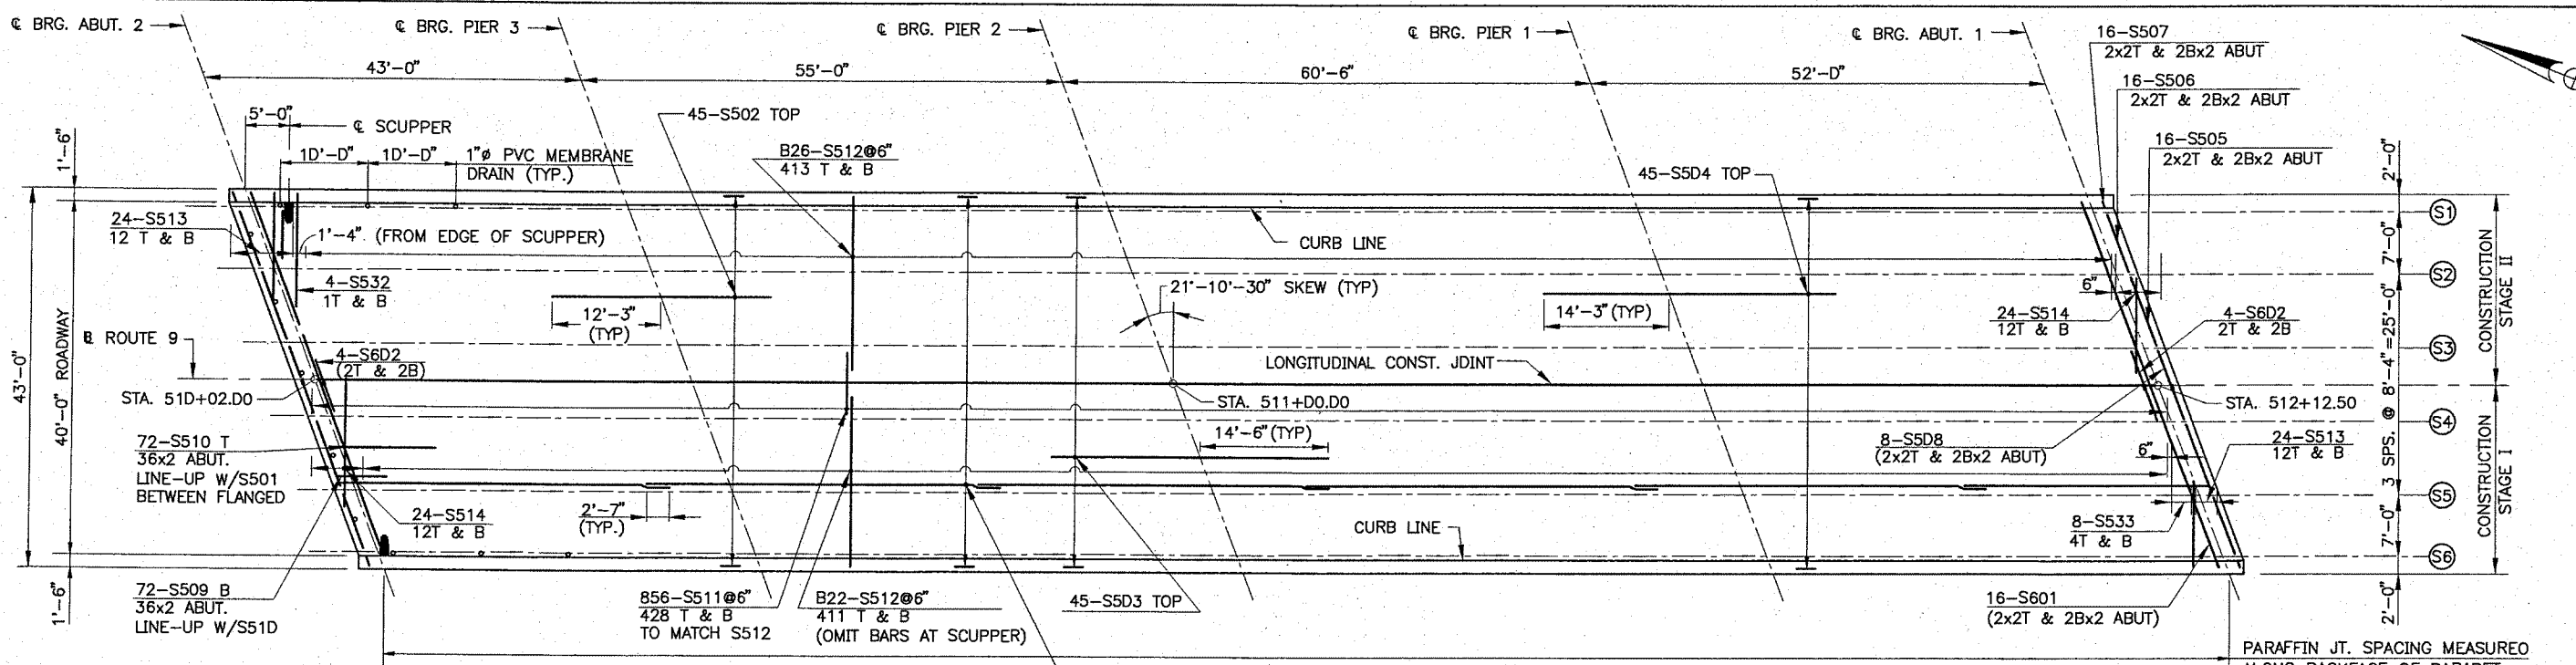

- SUPERSTRUCTURE NOTES**
1. THE CONCRETE DECK SHALL BE GIVEN A SMOOTH BULL FLOAT OR WOOD FLOAT FINISH.
 2. FOR SLAB DETAILS, SEE SHEET NOS. SI-17 AND SI-18.
 3. FOR ROADWAY EXPANSION JOINT DETAILS, SEE SHEET NOS. SI-19, SI-20 AND SI-21.
 4. FOR REINFORCING STEEL SCHEDULE, SEE SHEET SI-26.
 5. ONLY OWEL BAR SPLICERS SHALL BE USED WITHIN CONCRETE DECK SLAB FOR STAGE I CONSTRUCTION AT THE LONGITUDINAL CONSTRUCTION JOINT. OWEL-IN BARS SHALL THEN BE USED WITHIN CONCRETE DECK SLAB FOR STAGE II CONSTRUCTION.
 6. 1" PVC MEMBRANE DECK DRAINS SHALL BE INSTALLED SUCH THAT THEY DO NOT DRAIN ONTO A STRINGER FLANGE, DIAPHRAGMS OR BRIDGE SEAT.
 7. FOR DECK SLAB REINFORCING STEEL AT SCUPPERS, SEE SHEET NO. SI-17.
- B. FOR DECK PLACEMENT SEQUENCE, SEE SHEET NO. SI-18.

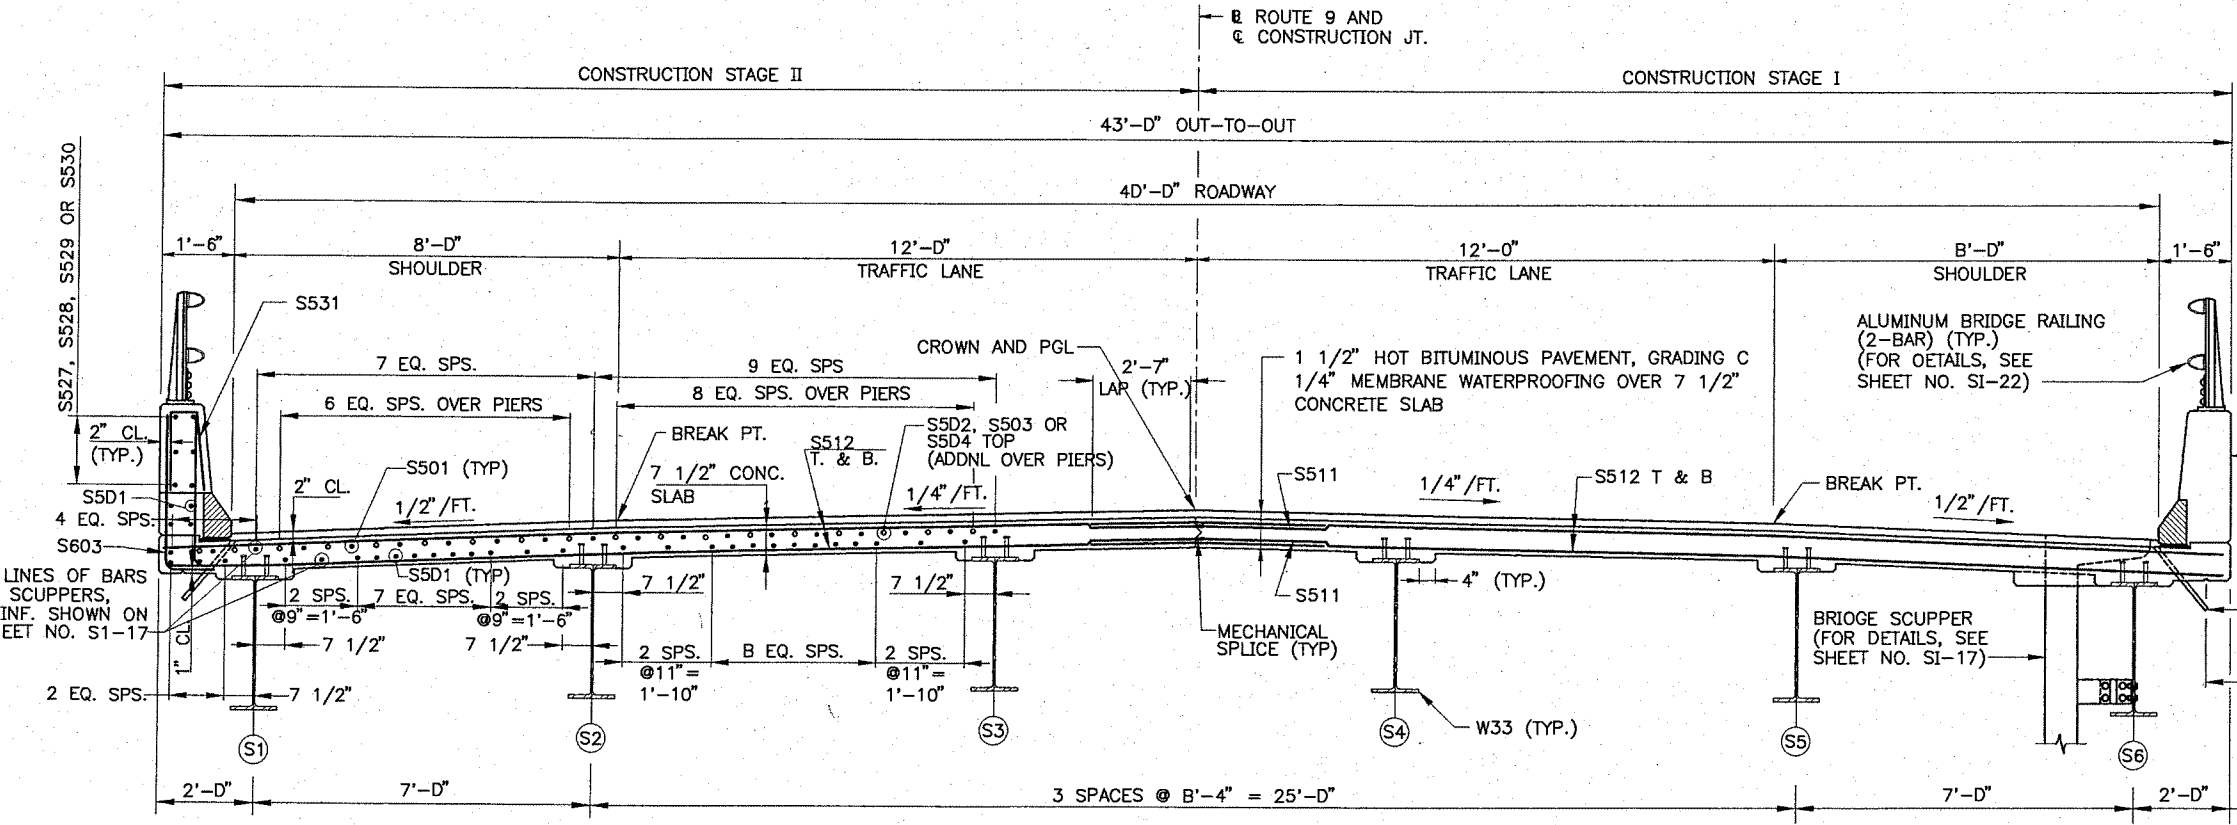

M:\14335\003\001\SI\DC\SI.DWG 04/03/02 11:03

Scale: AS NOTED

No.	Revision	By	Date

Designed by:

HNTB
ARCHITECTS ENGINEERS PLANNERS

	By	Date		By	Date
Designed	ML	10/01	Checked	AAD	12/01
Drawn	AR	10/01	In Charge of	RAL	3/02




HNTB CORPORATION
2 Thomas Drive
Westbrook, ME 04092
TEL (207) 774-5155
FAX (207) 772-7410

MAINE TURNPIKE AUTHORITY



MAINE TURNPIKE **Transpass**

SABATTUS INTERCHANGE/
ROUTE 9
DECK PLAN AND TYPICAL SECTION






SHEET NUMBER: SI-16
CONTRACT: 2002.25
49 OF 63

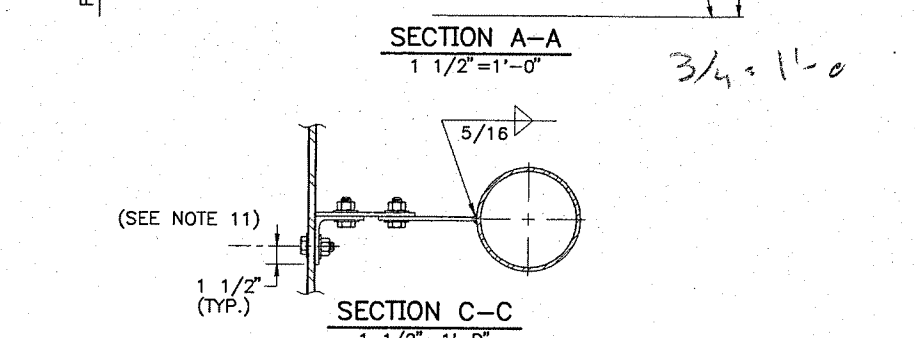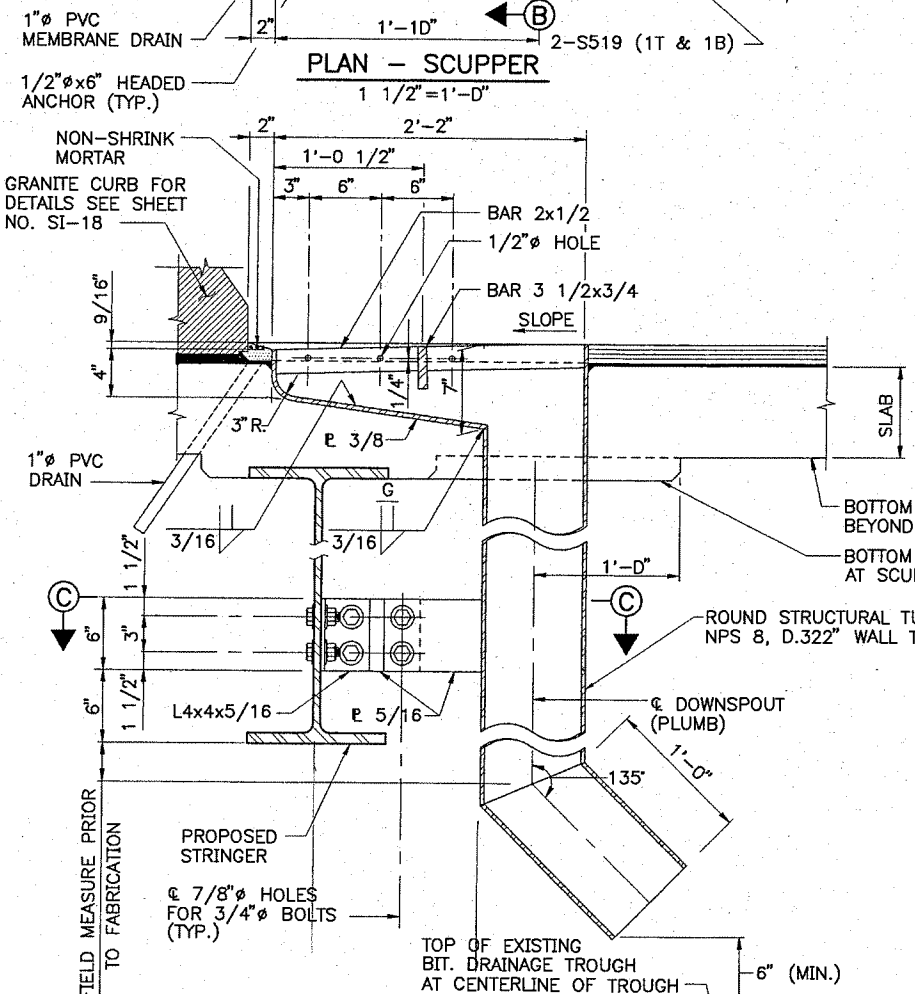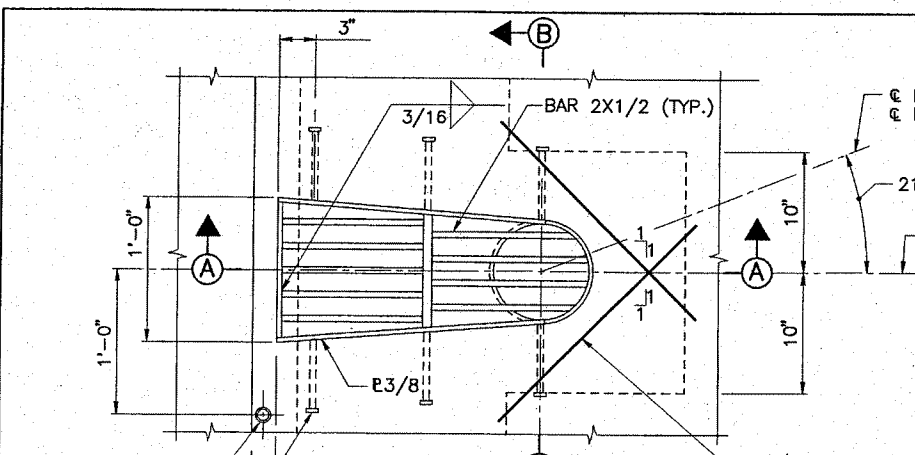

ROUGHEN SURFACE, BLAST CLEAN, THEN APPLY A NEAT CEMENT GROUT OR OTHER SUITABLE BONDING MATERIAL IMMEDIATELY PRIOR TO PLACING ADJACENT CONCRETE.

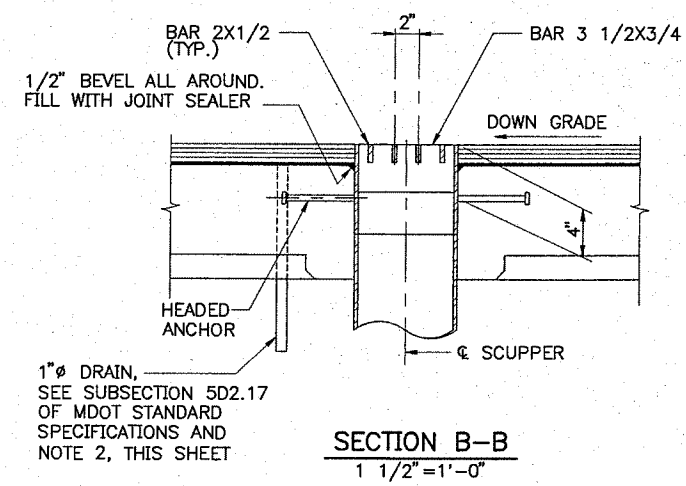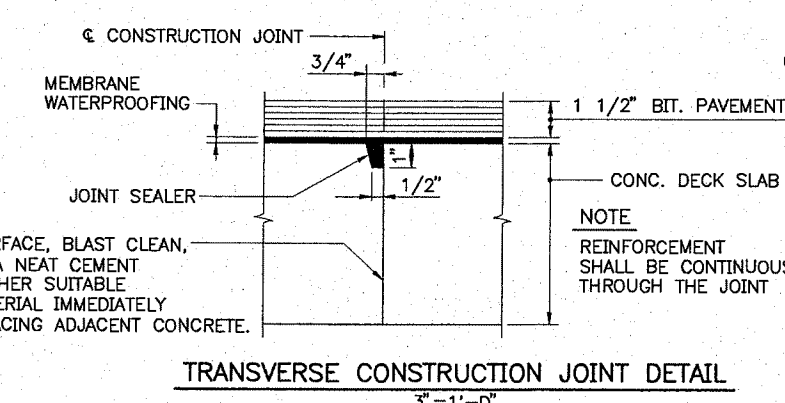

- SCUPPER NOTES**
- ALL WELDS TO BE CONTINUOUS 1/4" FILLET WELDS EXCEPT AS NOTED.
 - DO NOT COVER DECK DRAINS WITH MEMBRANE WATERPROOFING. DEPRESS DRAINS 1/2" BELOW TOP OF SLAB, PROVIDE 23 GAUGE GALVANIZED SCREENS (1/4" MESH) OVER DRAINS.
 - SCUPPERS TO BE GALVANIZED AFTER FABRICATION. GALVANIZING SHALL CONFORM TO ASTM A153.
 - ALL PLATES SHALL CONFORM TO ASTM A709, GRADE 36.
 - DOWNSPUT AND FLARE SHALL CONFORM TO ASTM A501.
 - PAYMENT FOR SCUPPERS, PVC DRAINS AND SCREENS SHALL BE INCIDENTAL TO ITEM 5D2.263.
 - FOR LOCATION OF SCUPPERS AND 1" DRAINS, SEE SHEET NO. SI-16.
 - FIELD MEASUREMENT IS REQUIRED TO DETERMINE THE LENGTH OF DOWNSPUT BEYOND THE BOTTOM FLANGE AND SHALL BE SUBMITTED TO THE ENGINEER FOR APPROVAL PRIOR TO FABRICATION.
 - FIELD REPAIR GALVANIZING WITH ZINC-RICH PAINT ACCORDING TO SECTION 5D6 OF THE SPECIAL PROVISIONS. (PAYMENT INCIDENTAL TO ITEM 5D2.263)
 - GRATING SHALL BE A COMMERCIAL HEAVY-DUTY GRATING.
 - HOLES THROUGH WEB SHALL BE FIELD DRILLED, THEN PAINTED TO THE SATISFACTION OF THE ENGINEER PRIOR TO INSTALLING BOLTS.

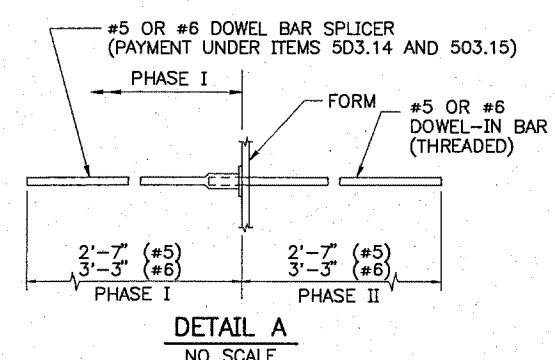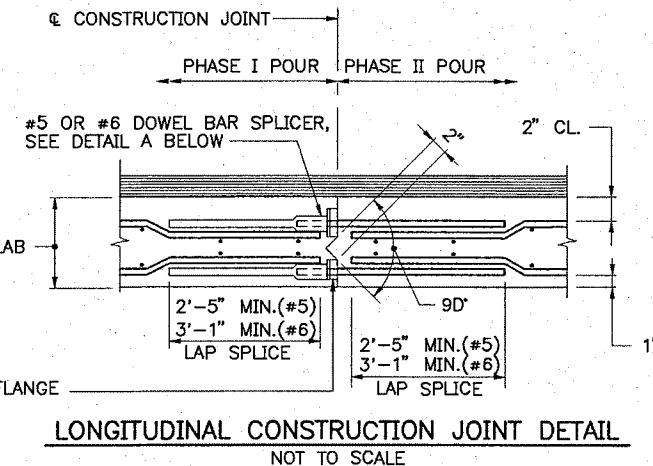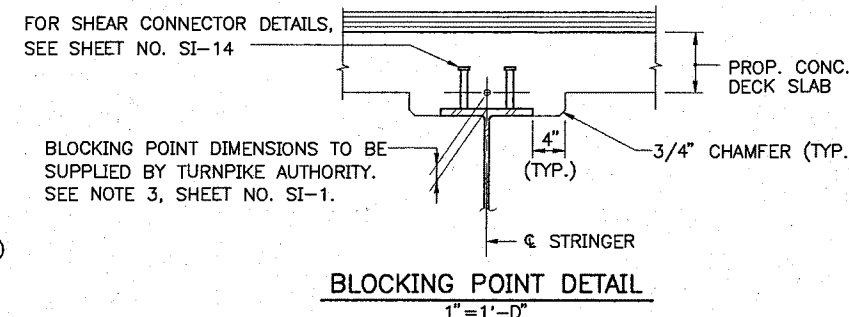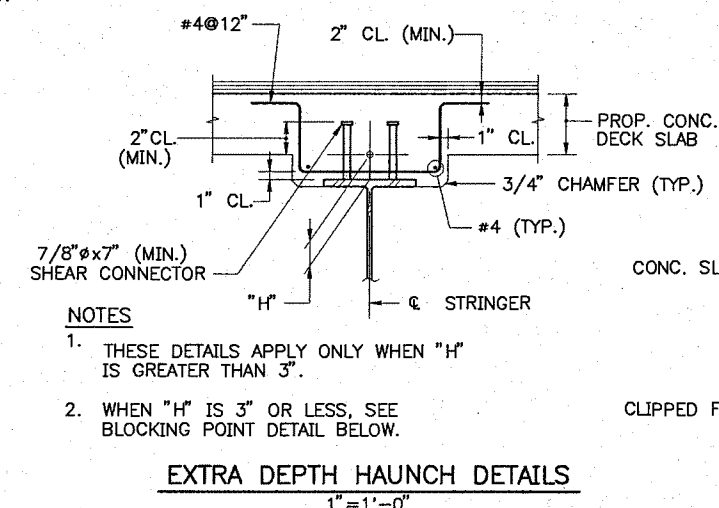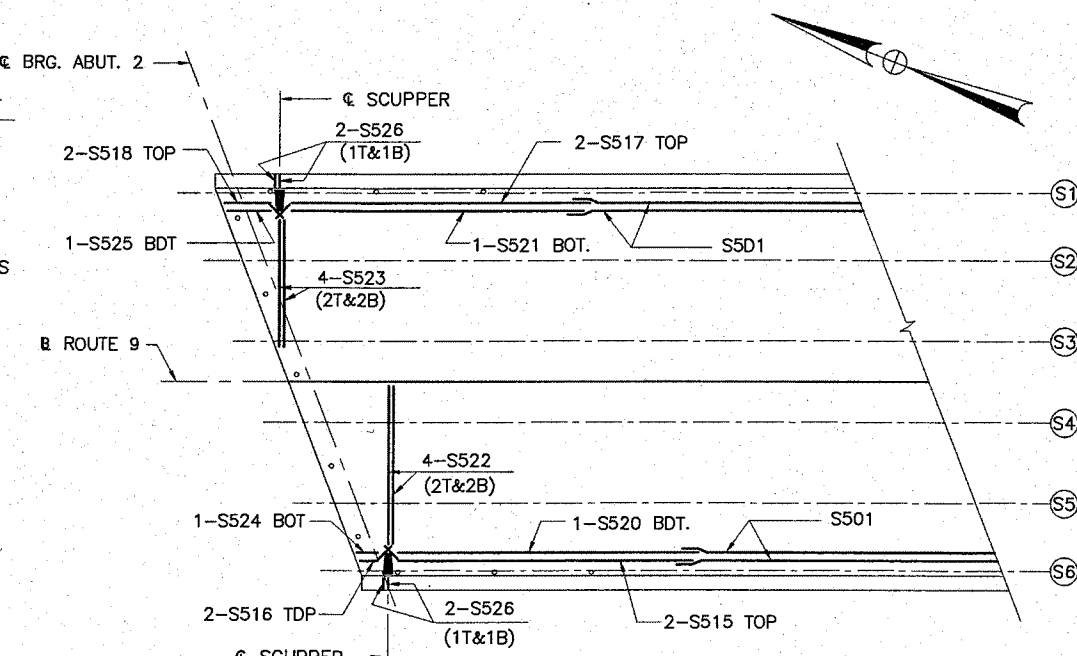

M:\14335\003\001\SSSLB01\SI.DWG 04/03/02 15:25

Scale: AS NOTED

No.	Revision	By	Date

Designed by:

HNTB
ARCHITECTS ENGINEERS PLANNERS




By	Date	Checked	By	Date
AD	10/01	ML	ML	1/02
AMR	10/01	In Charge of	RAL	3/02

HNTB CORPORATION
2 Thomas Drive
Westbrook, ME 04092
TEL (207) 774-5155
FAX (207) 772-7410


MAINE TURNPIKE AUTHORITY

SABATTUS INTERCHANGE/
ROUTE 9
SLAB DETAILS I


SHEET NUMBER: SI-17
CONTRACT: 2002.25
95 OF 63

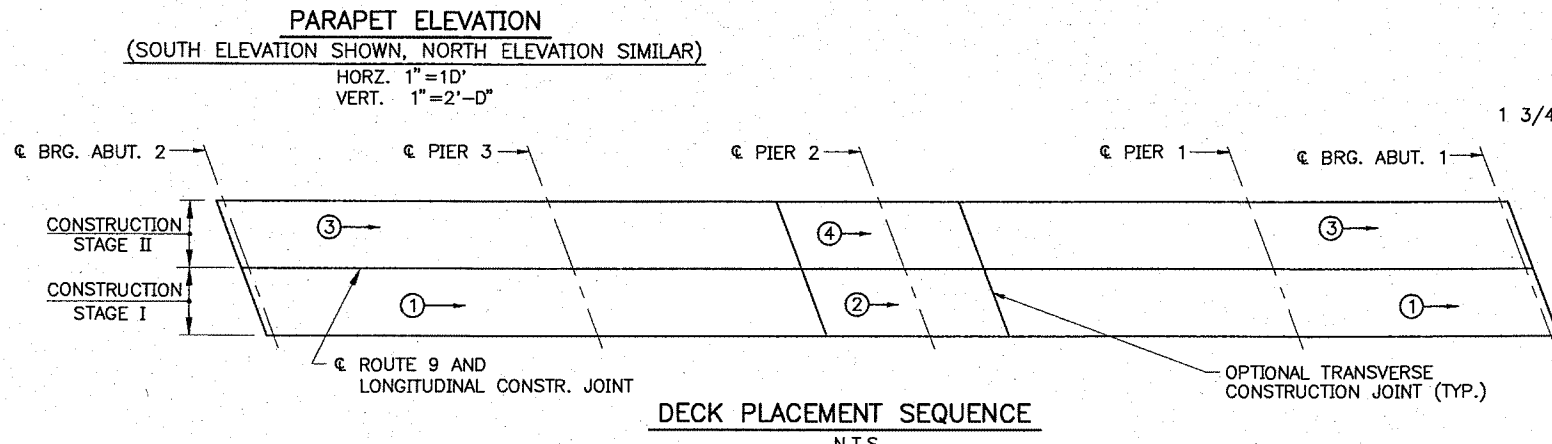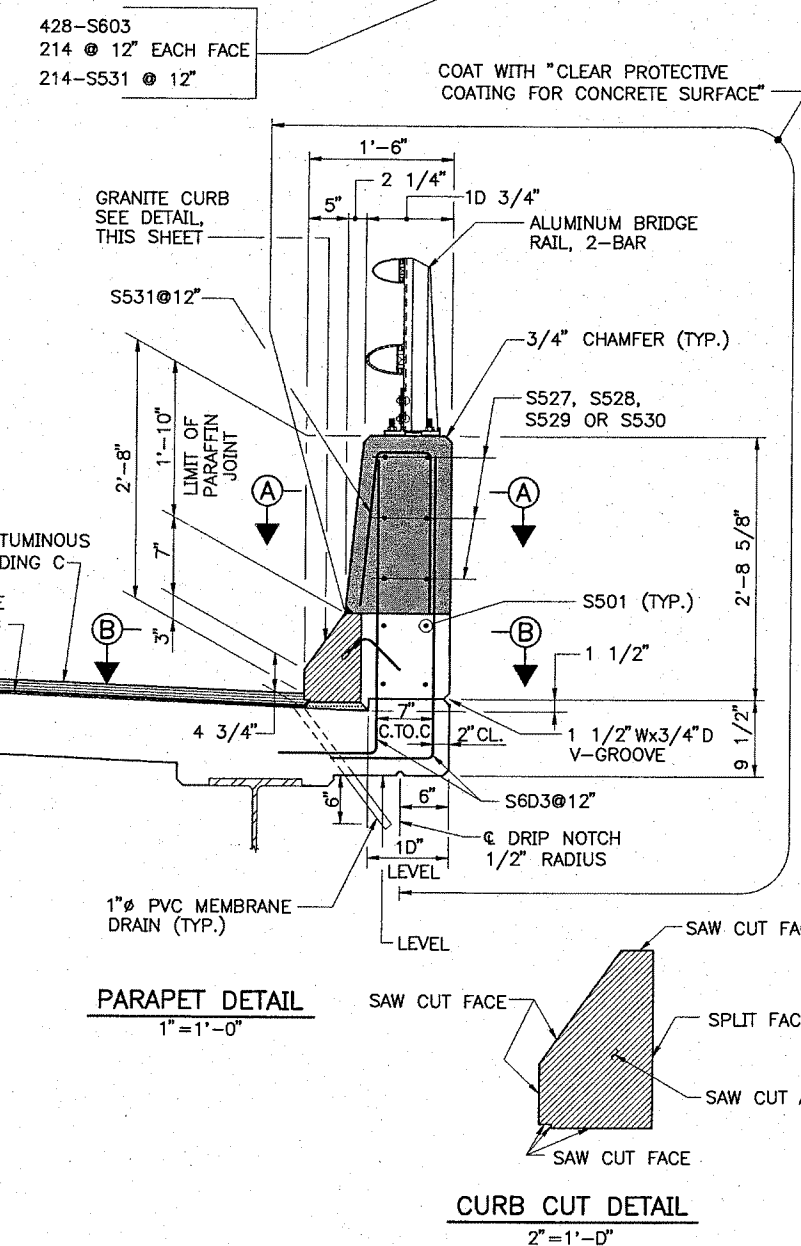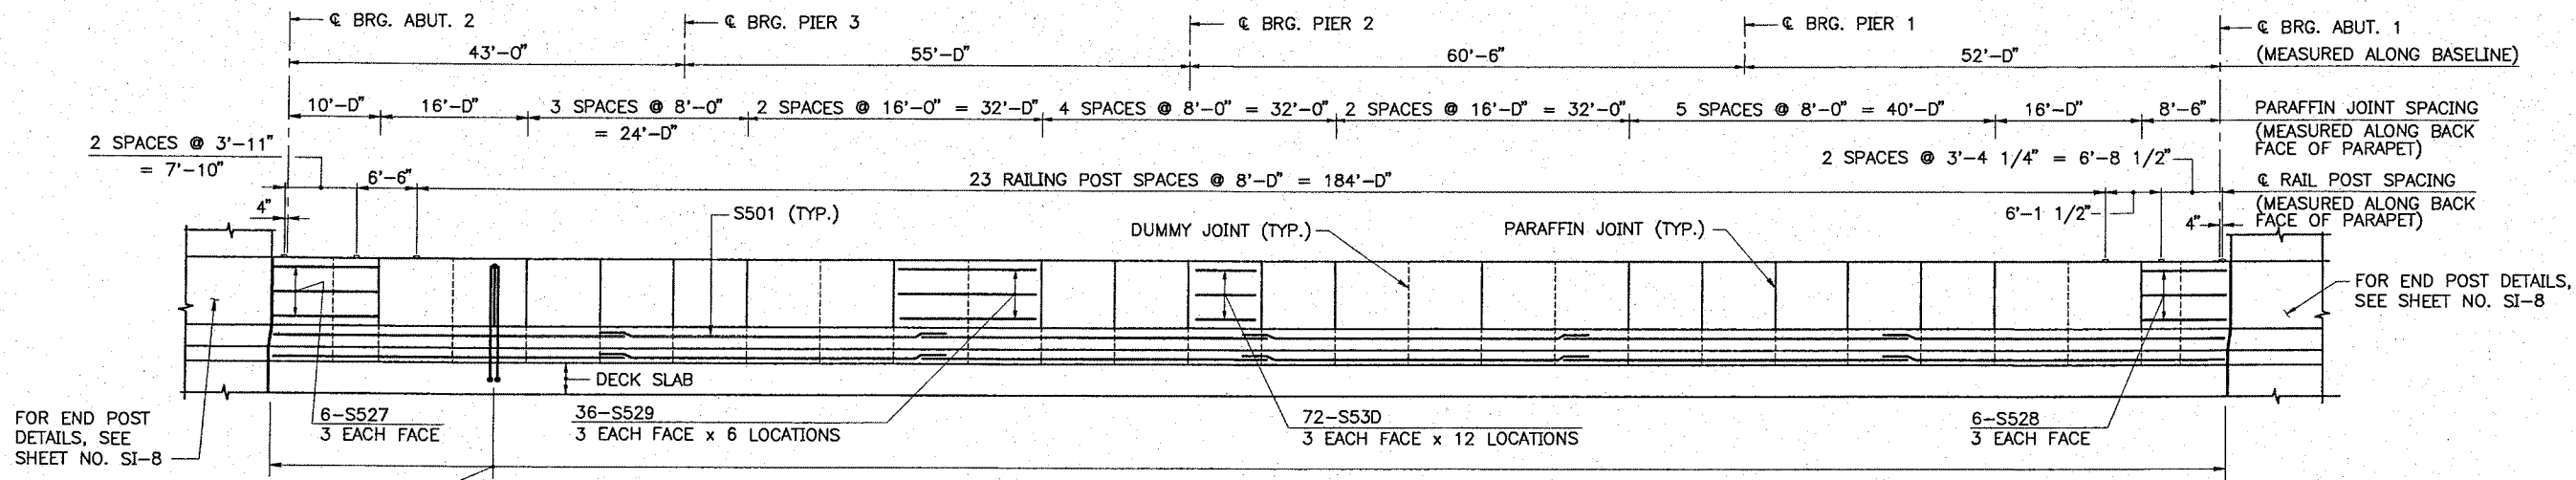

- PLACEMENT NOTES**
1. THE NUMBERS IN CIRCLES INDICATE PLACING SEQUENCE. THE ARROWS INDICATE DIRECTION OF PLACEMENT.
 2. BEGIN PLACEMENT AT THE LOW END OF THE BLOCK.
 3. THE FORMWORK FOR THE CONSTRUCTION JOINTS SHALL REMAIN IN PLACE UNTIL MINIMUM OF 48 HOURS HAS ELAPSED AFTER PLACEMENT OF THE SLAB. AFTER WHICH, REMOVAL OF FORMWORK MEETING THE REQUIREMENTS FOR FORM REMOVAL OF SECTION 5D2 (STRUCTURAL CONCRETE) OF THE STANDARD SPECIFICATIONS, MAY PROCEED.
 4. PLACEMENTS DESIGNATED BY THE SAME NUMBER DO NOT NECESSARILY HAVE TO BE PLACED THE SAME DAY. A WAITING PERIOD OF 72 HOURS IS NECESSARY BETWEEN ADJACENT POURS.
 5. STAY-IN-PLACE FORMS SHALL NOT BE USED.
 6. THE TRANSVERSE CONSTRUCTION JOINTS MAY BE OMITTED, IF APPROVED BY THE ENGINEER AND PROVIDED THAT THE CONCRETE OF THE ENTIRE DECK SLAB REMAINS PLASTIC UNTIL THE COMPLETION OF THE LAST PLACEMENT AND ALL OTHER SPECIFICATIONS ARE FOLLOWED. A WRITTEN REQUEST TO OMIT THE TRANSVERSE CONSTRUCTION JOINTS MUST BE SUBMITTED TO THE ENGINEER FOR APPROVAL.



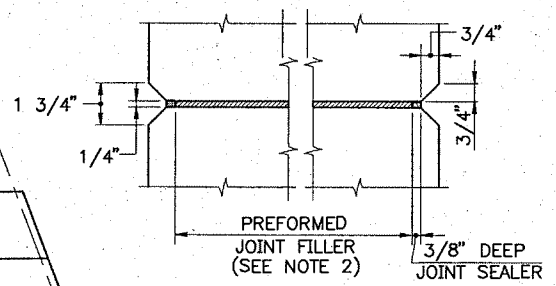


SECTION A-A
3"=1'-0"

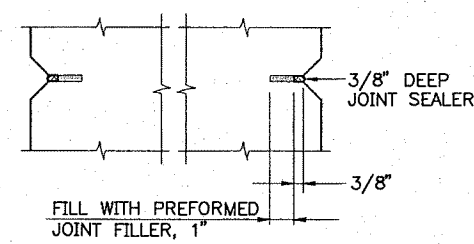

SECTION B-B
3"=1'-0"

- PARAFFIN AND DUMMY JOINT NOTES**
1. CONCRETE SHALL BE PLACED SIMULTANEOUSLY ON BOTH SIDES OF JOINT. ASPHALT TYPE JOINT FILLER SHALL NOT BE USED. ONLY CERAMAR OR CORK TYPE SHALL BE PERMITTED.
 2. PREFORMED JOINT FILLER SHALL CONFORM TO ASTM DESIGNATION D 1752 AND MAY BE SUPPORTED WITH A THIN STEEL PLATE. REMOVE PLATE CAREFULLY WHILE CONCRETE IS PLASTIC.
 3. SECTION B-B ALSO APPLIES TO DUMMY JOINT LOCATIONS.
 4. JOINT SEALER SHALL BE SIKAFLEX-1A.
 5. PREFORMED JOINT FILLER AND JOINT SEALER SHALL BE INCIDENTAL TO ITEM 502.264, STRUCTURAL CONCRETE PARAPETS.
 6. GRANITE CURB JOINTS SHALL BE ALIGNED WITH PARAFFIN AND DUMMY JOINTS.

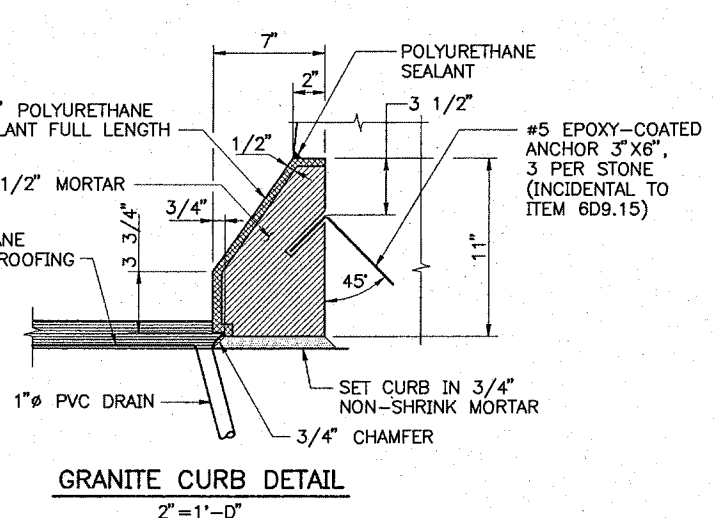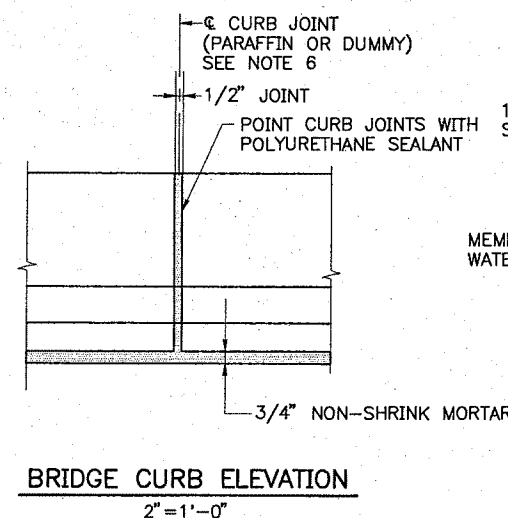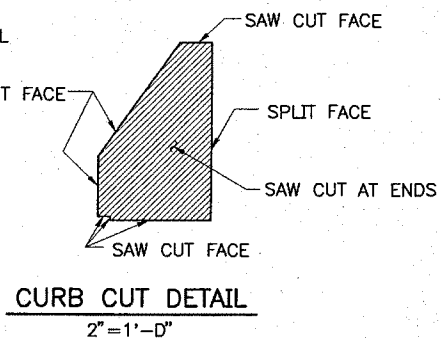

M:\14335\003\001\SSSLBT2SI.DWG 04/03/02 11:04

Scale: AS NOTED

No.	Revision	By	Date

Designed by:

HNTB
ARCHITECTS ENGINEERS PLANNERS


By	Date	By	Date
AD	10/01	ML	1/02
AMR	10/01	RAL	3/02

HNTB CORPORATION
2 Thomas Drive
Westbrook, ME 04092
TEL (207) 774-5155
FAX (207) 772-7410


MAINE TURNPIKE AUTHORITY




SABATTUS INTERCHANGE/
ROUTE 9
SLAB DETAILS II

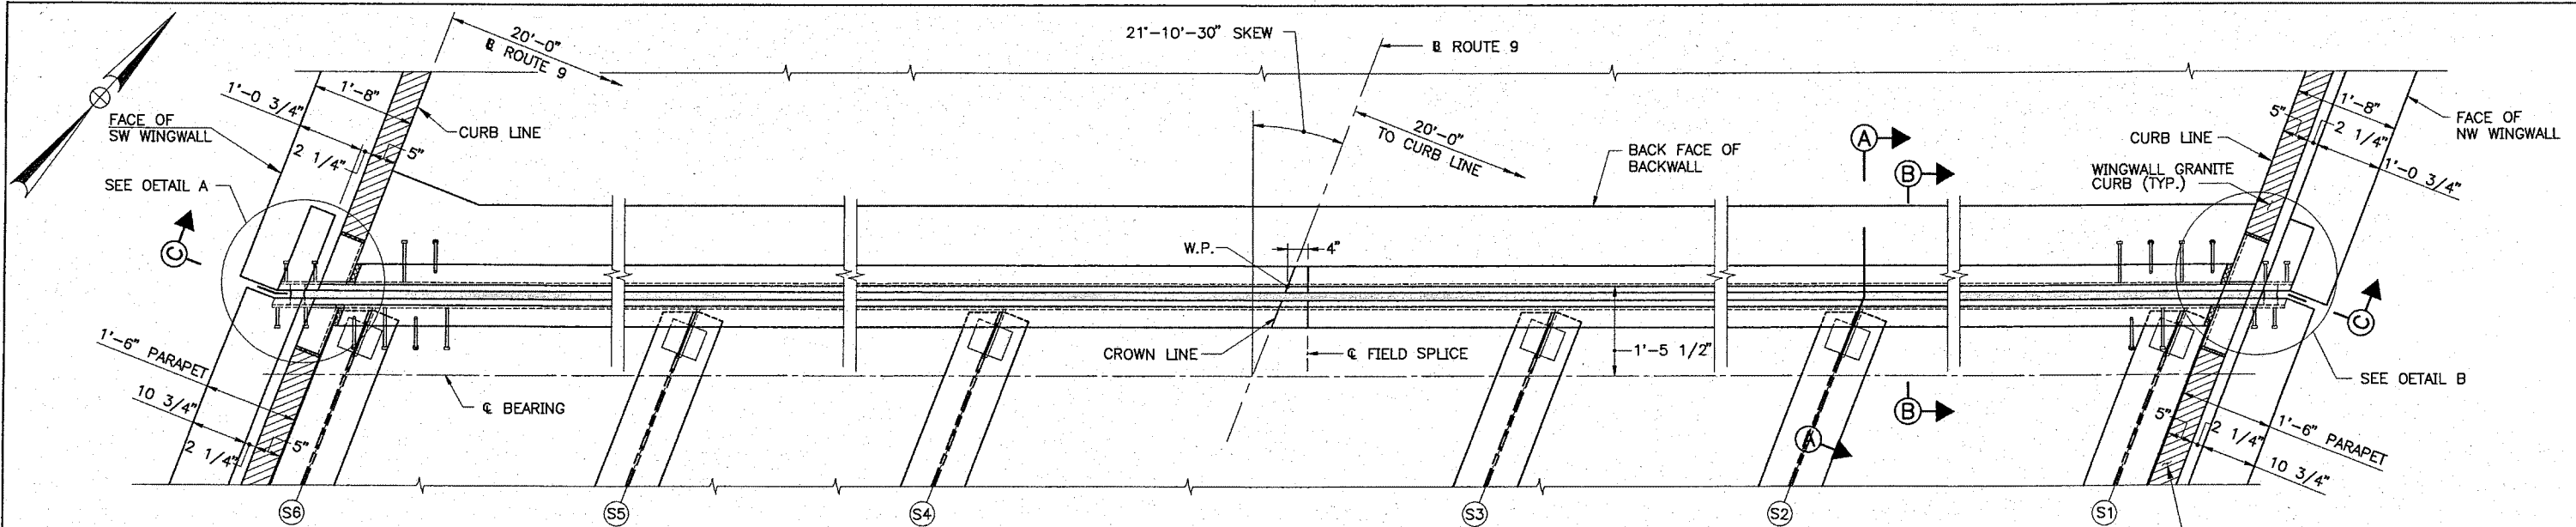

PLAN - ABUTMENT 2
3/4" = 1'-0"

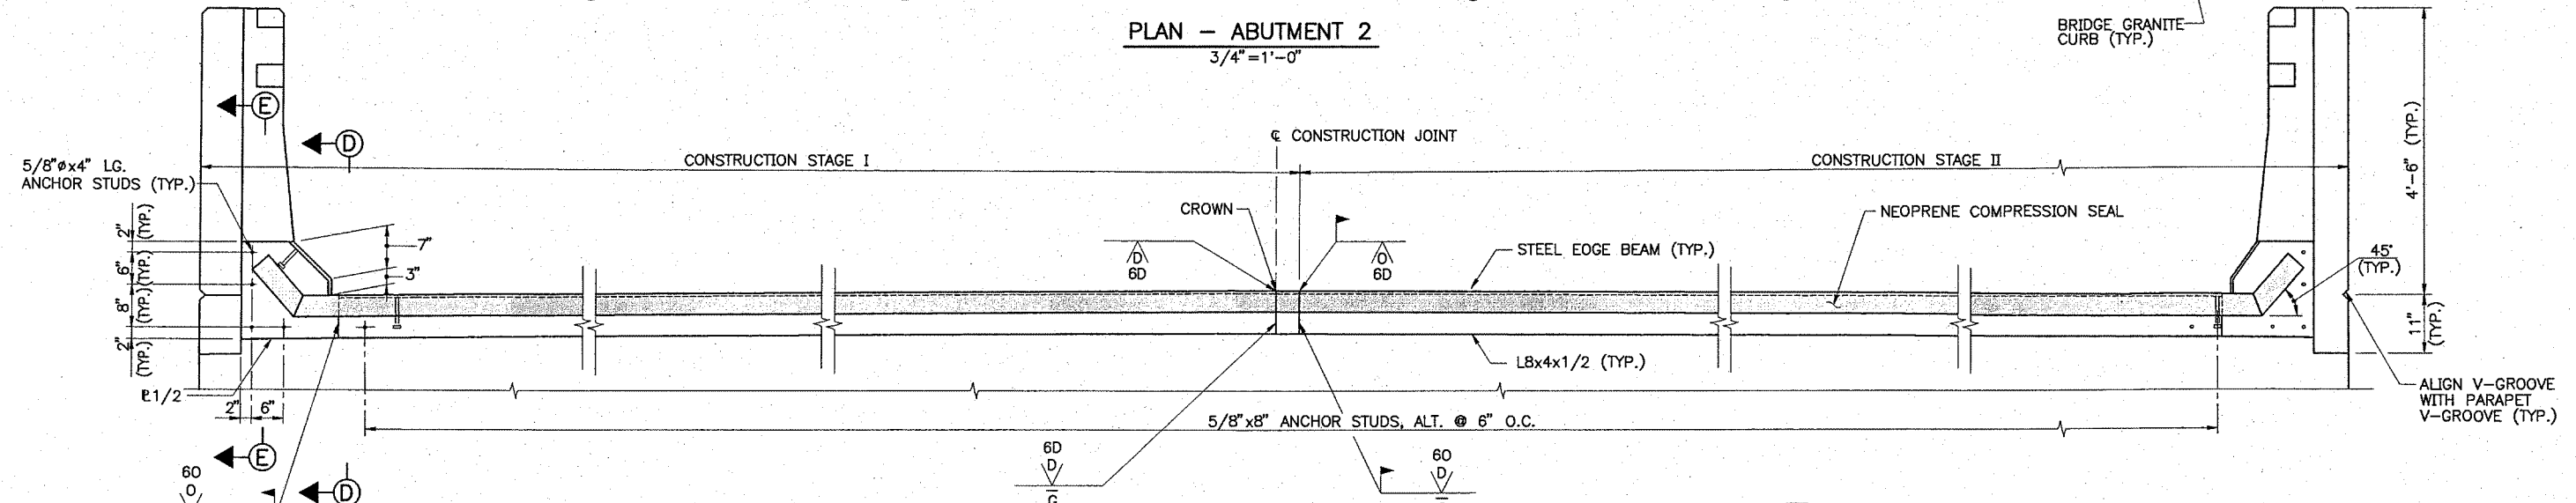


SECTION C-C
3/4" = 1'-0"

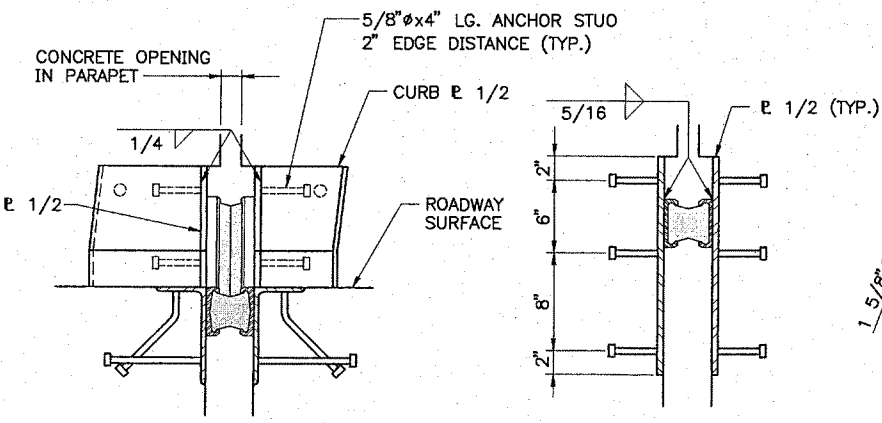

SECTION D-D
1 1/2" = 1'-0"

SECTION E-E
1 1/2" = 1'-0"

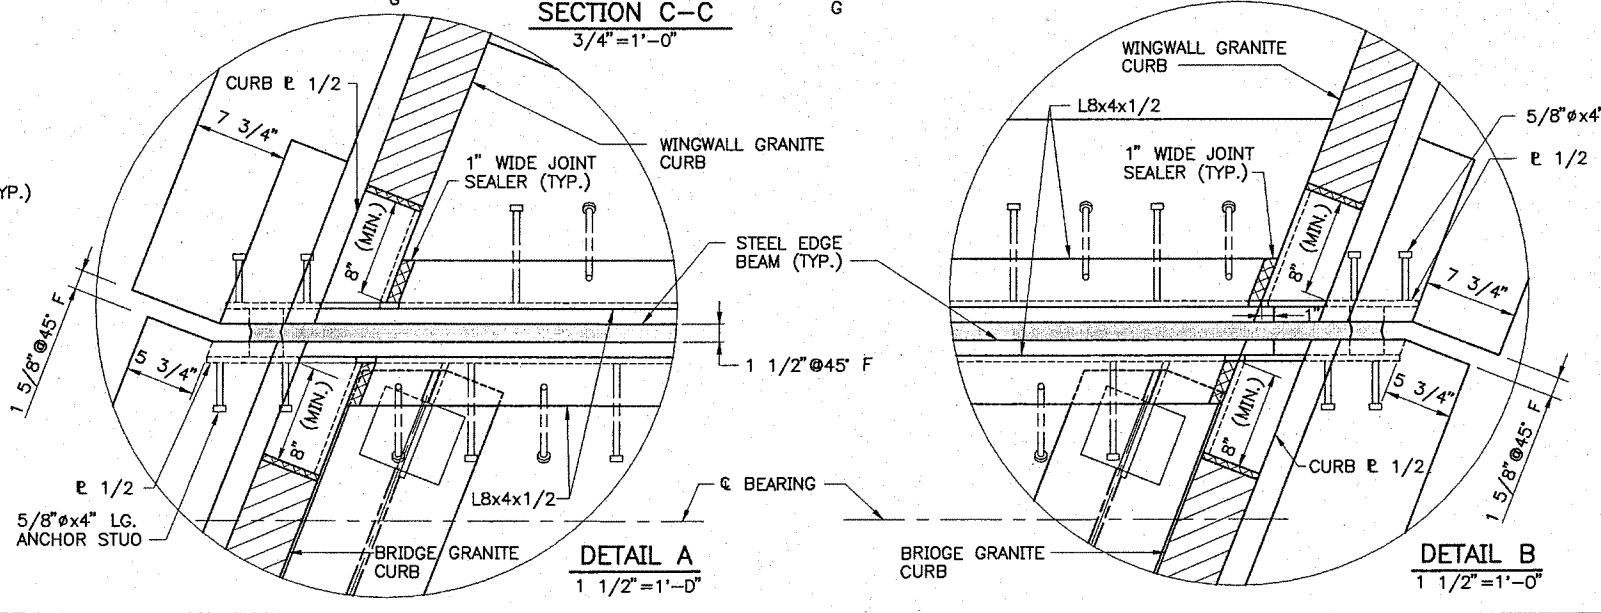

DETAIL A
1 1/2" = 1'-0"

DETAIL B
1 1/2" = 1'-0"

NOTES

1. CONSTRUCTION STAGES, SHOWN, RELATE TO THE EXPANSION JOINT ONLY. THE CONCRETE DECK AND THE ABUTMENT BACKWALL SHALL BE CONSTRUCTED ACCORDING TO THE STAGE CONSTRUCTION AS SHOWN ON SHEET NO. SI-3 AND SI-5.
2. THE ANGLES, LBx4x1/2, AND STEEL EDGE BEAMS SHALL BE FABRICATED BY CONFORMING TO THE TOP OF BACKWALL ELEVATIONS FOR ABUTMENT 2, WHICH ARE SHOWN ON SHEET NO. SI-5.
3. FOR SECTIONS A-A AND B-B, SEE SHEET NO. SI-21.

M:\14335\003\001\SS\EXP1.SI.DWG 04/03/02 11:05

Scale: AS NOTED

No.	Revision	By	Date

Designed by:

HNTB
ARCHITECTS ENGINEERS PLANNERS

By	Date	Checked	By	Date
AD	10/01	AAD		1/02
AMR	10/01	RAL		3/02


HNTB CORPORATION
2 Thomas Drive
Westbrook, ME 04092
TEL (207) 774-5155
FAX (207) 772-7410

MAINE TURNPIKE AUTHORITY


CONTRACT: 2002.25

SABATTUS INTERCHANGE/
ROUTE 9
EXPANSION JOINT DETAILS I


SHEET NUMBER: SI-19
52 OF 63

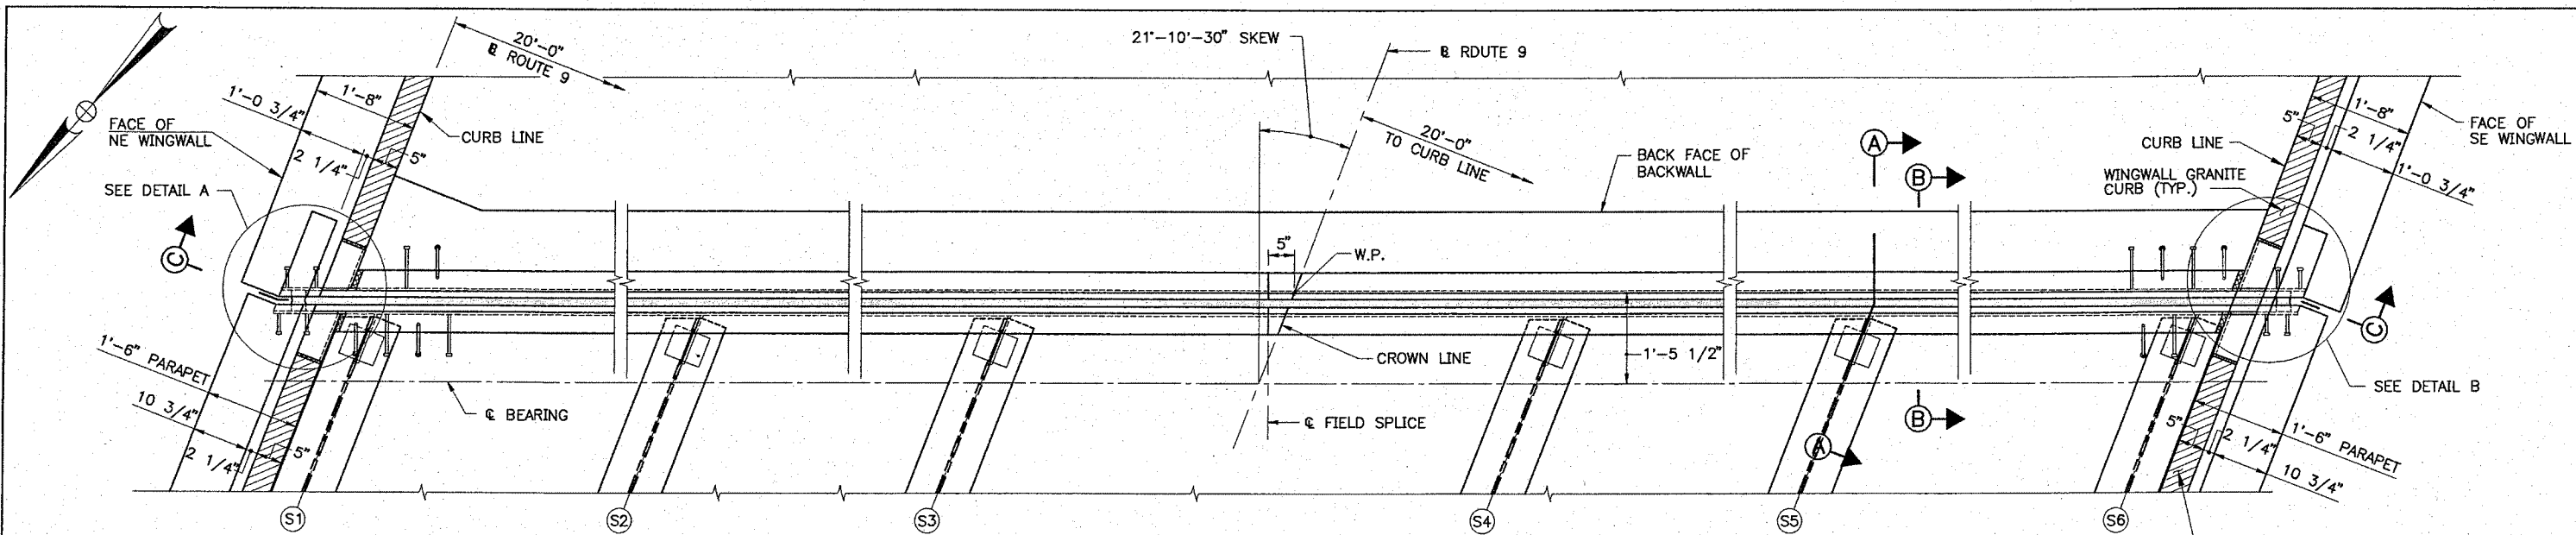

PLAN - ABUTMENT 1
3/4"=1'-0"

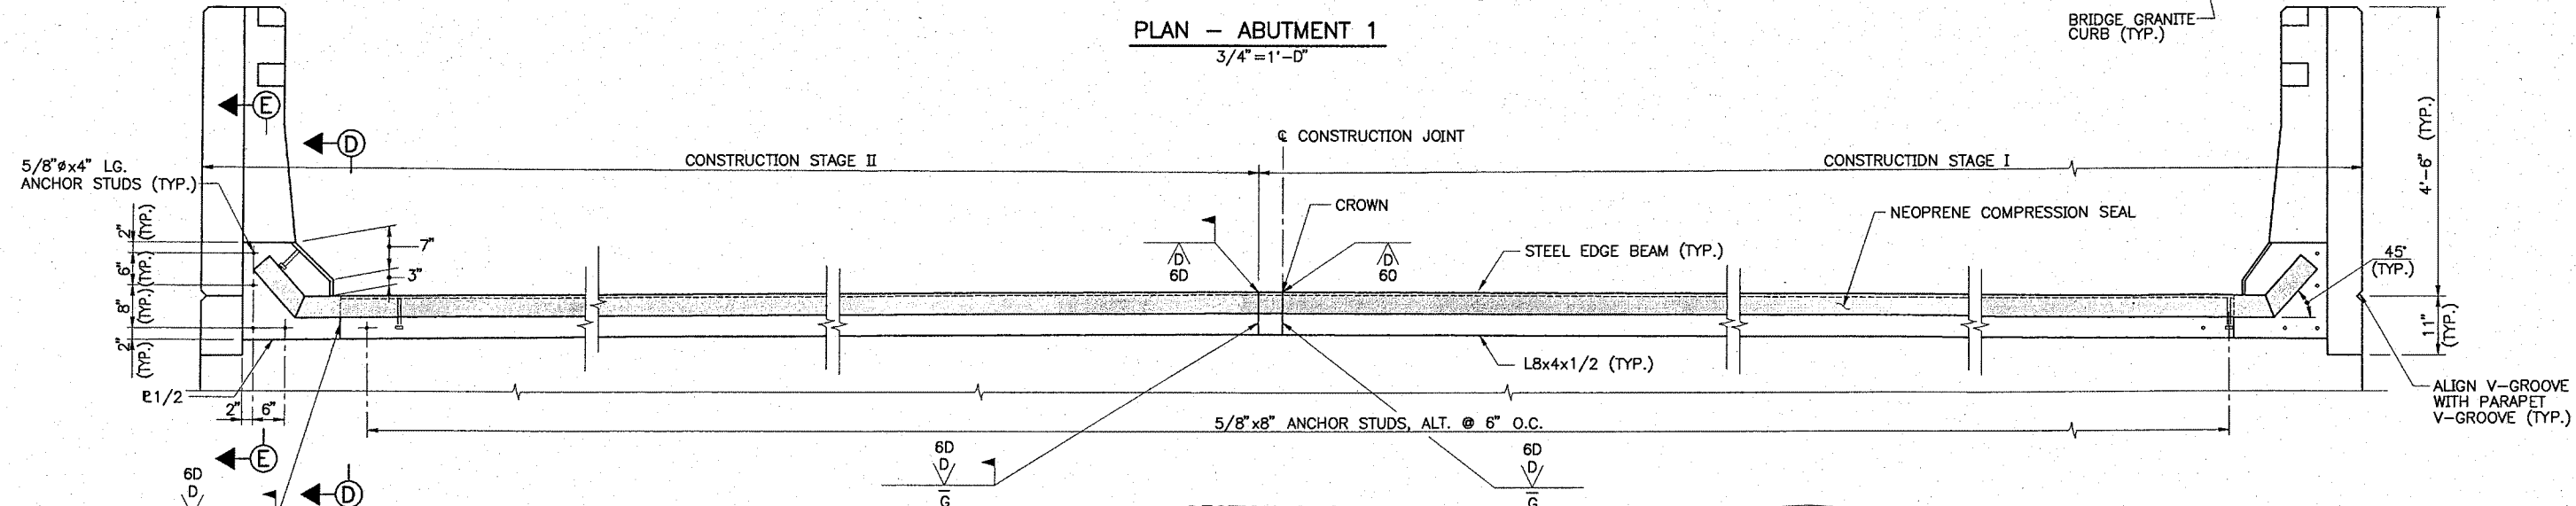


SECTION C-C
3/4"=1'-0"

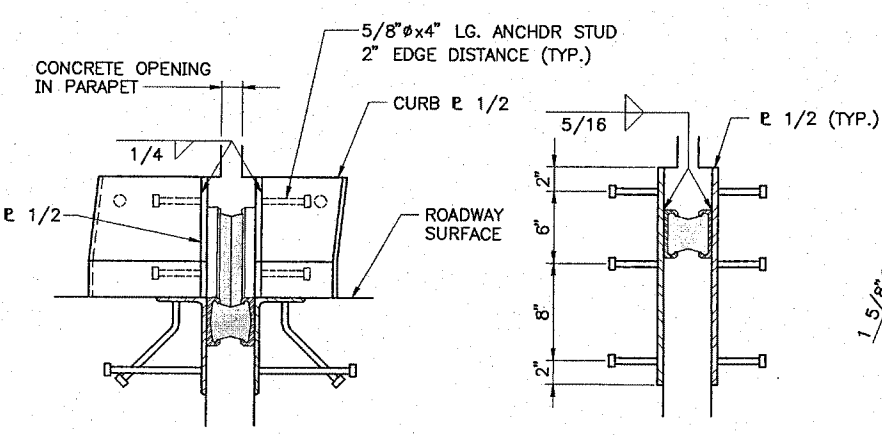

SECTION D-D
1 1/2"=1'-0"

SECTION E-E
1 1/2"=1'-0"

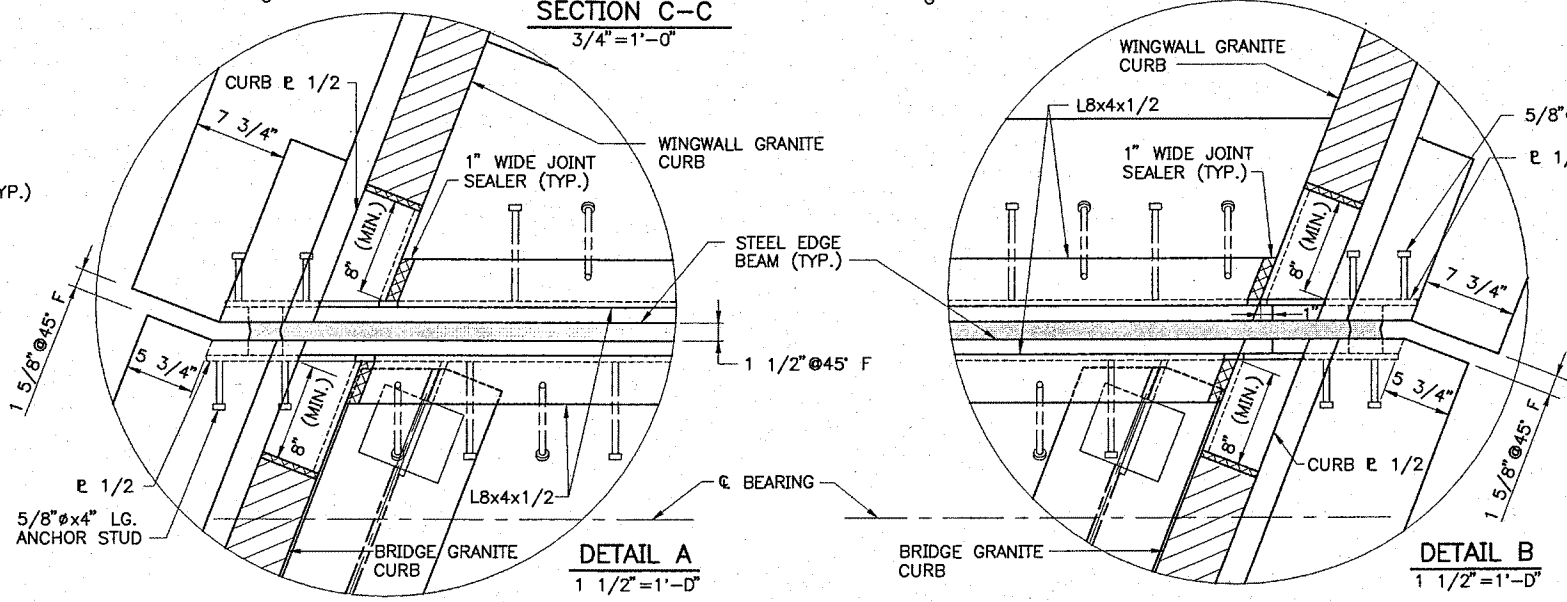

DETAIL A
1 1/2"=1'-0"

DETAIL B
1 1/2"=1'-0"

NOTES

1. CONSTRUCTION STAGES, SHOWN, RELATE TO THE EXPANSION JOINT ONLY. THE CONCRETE DECK AND THE ABUTMENT BACKWALL SHALL BE CONSTRUCTED ACCORDING TO THE STAGE CONSTRUCTION AS SHOWN ON SHEET NO. SI-3 AND SI-6.
2. THE ANGLES, L8x4x1/2, AND STEEL EDGE BEAMS SHALL BE FABRICATED BY CONFORMING TO THE TOP OF BACKWALL ELEVATIONS FOR ABUTMENT 1, WHICH ARE SHOWN ON SHEET NO. SI-6.
3. FOR SECTIONS A-A AND B-B, SEE SHEET NO. SI-21.

M:\14335\003\001\55EXP2SI.DWG 04/03/02 11:06

Scale: AS NOTED

Designed by:



ARCHITECTS ENGINEERS PLANNERS

HNTB CORPORATION
2 Thomas Drive
Westbrook, ME 04092
TEL (207) 774-5155
FAX (207) 772-7410

MAINE TURNPIKE AUTHORITY



SABATTUS INTERCHANGE/
ROUTE 9
EXPANSION JOINT DETAILS II


No.	Revision	By	Date

	By	Date		By	Date
Designed	AD	10/01	Checked	AAD	1/02
Drawn	AMR	10/01	In Charge of	RAL	3/02


CONTRACT: 2002.25

SHEET NUMBER: SI-20


53 OF 63

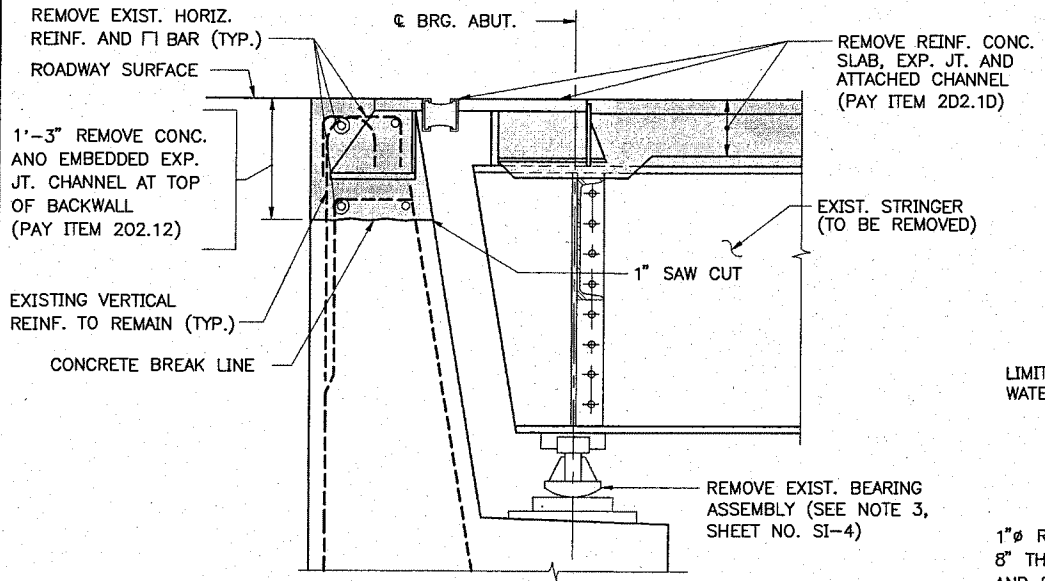


EXISTING SECTION A-A
1" = 1'-0"

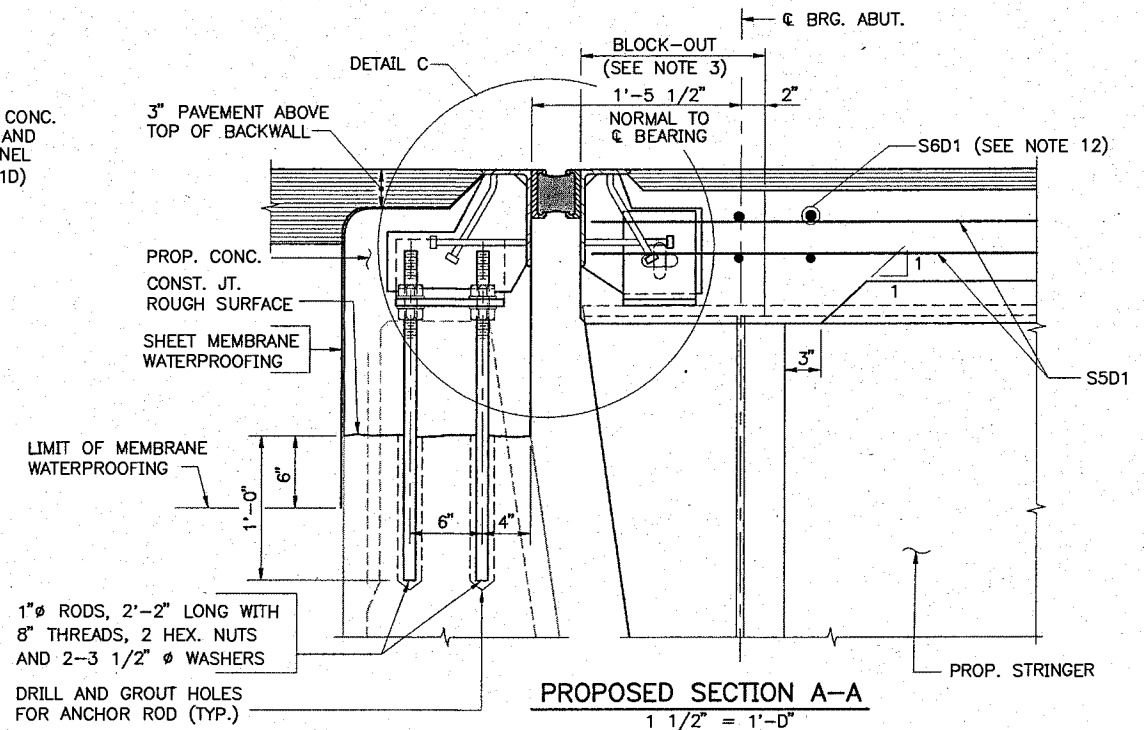


PROPOSED SECTION A-A
1 1/2" = 1'-0"

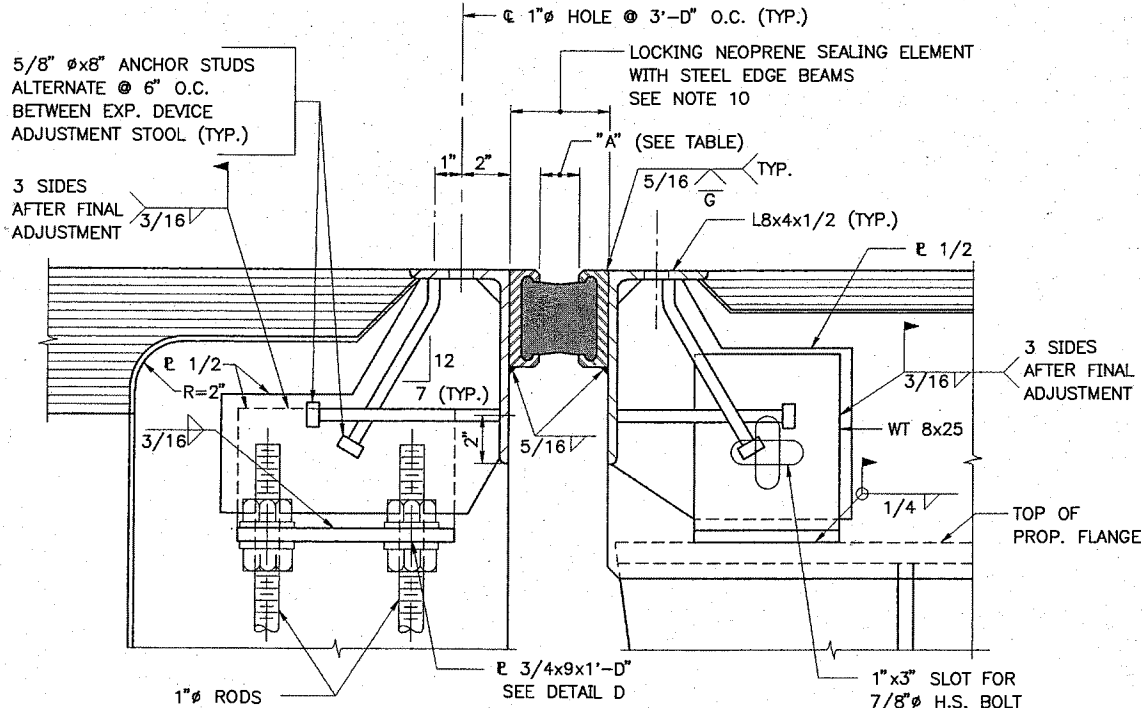


DETAIL C
3" = 1'-0"

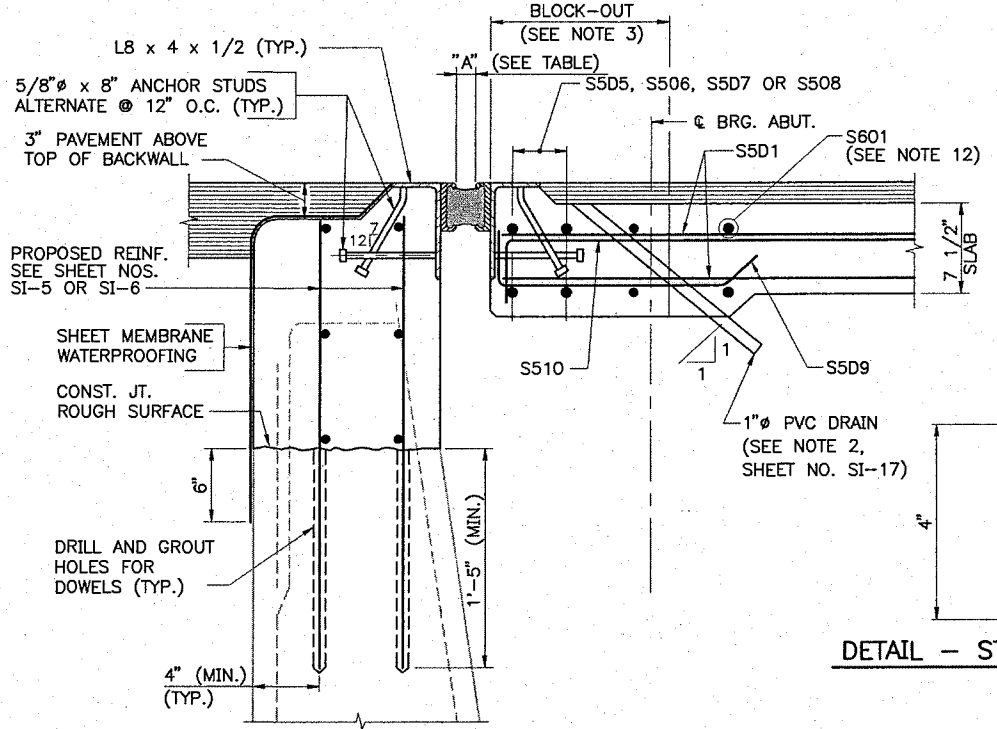

PROPOSED SECTION B-B
1 1/2" = 1'-0"

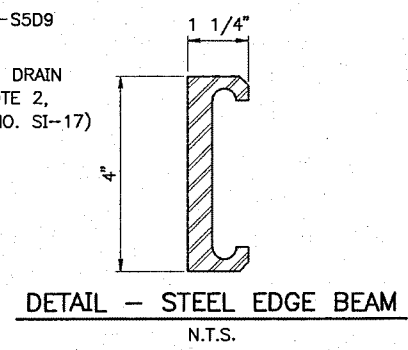


DETAIL - STEEL EDGE BEAM
N.T.S.

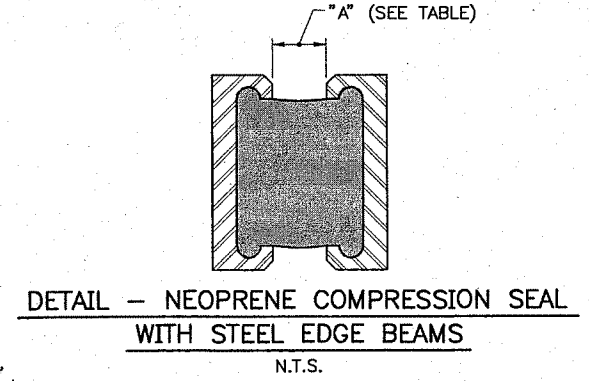

DETAIL - NEOPRENE COMPRESSION SEAL WITH STEEL EDGE BEAMS
N.T.S.

SEAL OPENING TABLE (DIM. "A")								
TEMPERATURE	0°F	15°F	30°F	45°F	60°F	75°F	90°F	105°F
ABUTMENT 2	1 7/8"	1 3/4"	1 5/8"	1 1/2"	1 3/8"	1 1/4"	1 1/8"	1 1/16"
ABUTMENT 1	1 7/8"	1 3/4"	1 5/8"	1 1/2"	1 3/8"	1 1/4"	1 1/8"	1"

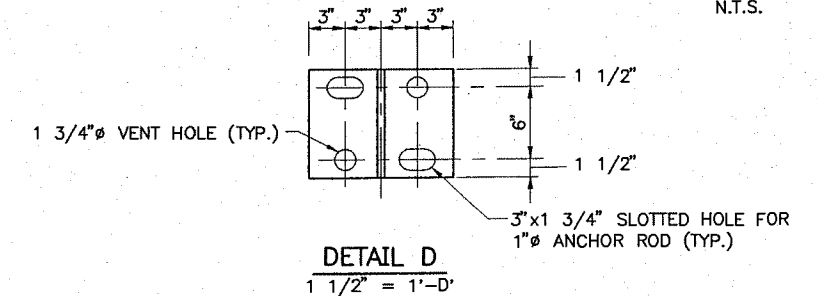

DETAIL D
1 1/2" = 1'-0"

EXPANSION DEVICE NOTES

- SHOP DRAWINGS OF THE EXPANSION DEVICE SHALL BE SUBMITTED FOR APPROVAL BY THE ENGINEER.
- THE EXPANSION DEVICE SHALL BE SET TO AN OPENING OF 1 1/2 INCHES IN THE FABRICATION SHOP AND SHALL BE SECURED TO THE STRINGER AND/OR ANCHOR BOLTS WHEN THE AMBIENT TEMPERATURE IS BETWEEN 40°F AND 80°F. THE OPENING SHALL BE ADJUSTED TO REFLECT THE TEMPERATURE OF THE STRUCTURE AT THE TIME OF INSTALLATION. SEE TABLE FOR OPENING DIMENSIONS. OPENING IS TO BE MEASURED PARALLEL TO THE CENTER LINE OF CONSTRUCTION.
- THE SLAB CONCRETE SHALL BE IN PLACE BEFORE THE EXPANSION DEVICE IS FIXED IN POSITION. NO ALLOWANCE FOR MOVEMENT DUE TO DEAD LOAD DEFLECTION IS NECESSARY. CONTRACTOR SHALL APPLY AN EPOXY BONDING AGENT, APPROVED BY THE ENGINEER, TO ALL VERTICAL SURFACES OF THE BLOCK-OUT BEFORE THE CONCRETE IS PLACED. SEE SECTION 520.D6 OF THE STANDARD SPECIFICATIONS.
- THE FABRICATOR'S ATTENTION IS DIRECTED TO THE NECESSITY OF FABRICATING AND INSTALLING EACH DEVICE IN TWO SECTIONS.
- DIRECTION AND LOCATION OF FIELD SPLICES MAY BE ADJUSTED IF REQUIRED TO FACILITATE CONSTRUCTION.
- ALL EXPOSED SURFACES OF ANGLES AND STEEL EDGE BEAMS SHALL BE FIELD PAINTED.
- ALL STEEL COMPONENTS SHALL BE AASHTO M27D GRADE 36, UNLESS OTHERWISE NOTED.
- ALL WELDS ARE 5/16" CONTINUOUS FILLETS, EXCEPT AS NOTED.
- ALL STEEL SURFACES THAT WILL BE EMBEDDED IN CONCRETE SHALL BE COATED WITH AN EPOXY BONDING COMPOUND.
- THE NEOPRENE COMPRESSION SEALS TO BE FURNISHED SHALL HAVE A MINIMUM MOVEMENT RATING OF:
ABUTMENT 1 = 3 INCHES
ABUTMENT 2 = 3 INCHES
- FOR LOCATION OF SECTIONS A-A AND B-B, SEE SHEET NOS. SI-19 AND SI-20.
- ONLY BARS PARALLEL TO THE ABUTMENT ARE SHOWN. BARS PERPENDICULAR TO STRINGERS ARE NOT SHOWN FOR CLARITY.
- CONCRETE USED FOR FILLING BLOCK-OUT SHALL BE OF THE SAME CLASS AND STRENGTH AS THAT USED FOR THE DECK.
- NO REINFORCING STEEL, UNLESS NOTED OTHERWISE, SHALL BE CUT TO CLEAR THE BRIDGE EXPANSION DEVICE WITHOUT PRIOR APPROVAL OF THE ENGINEER.
- END DIAPHRAGM, TYPE A1, NOT SHOWN IN SECTIONS.

M:\14335\003\001\SEEXP3SI.DWG 04/03/02 16:01

Scale: AS NOTED

No.	Revision	By	Date

Designed by:


HNTB
ARCHITECTS ENGINEERS PLANNERS

	By	Date		By	Date
Designed	AD	10/01	Checked	AAD	1/02
Drawn	LS	10/01	In Charge of	RAL	3/02

HNTB CORPORATION
2 Thomas Drive
Westbrook, ME 04092
TEL (207) 774-5155
FAX (207) 772-7410


MAINE TURNPIKE AUTHORITY

SABATTUS INTERCHANGE/
ROUTE 9
EXPANSION JOINT DETAILS III

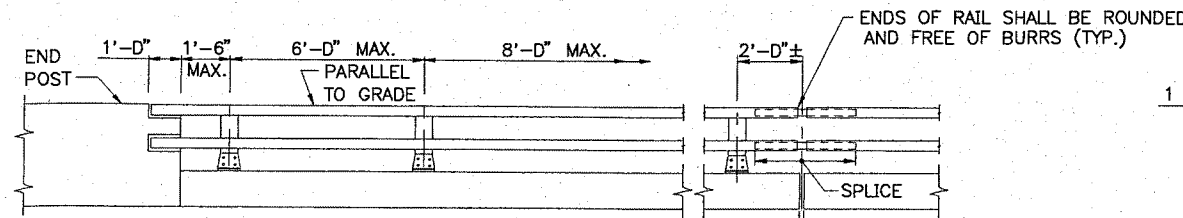


NOTE
LENGTHS OF RAIL SHALL BE ATTACHED TO A MIN. OF FOUR (4) RAIL POST WHENEVER POSSIBLE, AND IN ANY CASE NEVER LESS THAN TWO (2). RAIL POST ARE TO BE SET NORMAL TO GRADE UNLESS OTHERWISE SHOWN ON THE BRIDGE PLANS.


RAILING - ELEVATION
3"=1'-0"

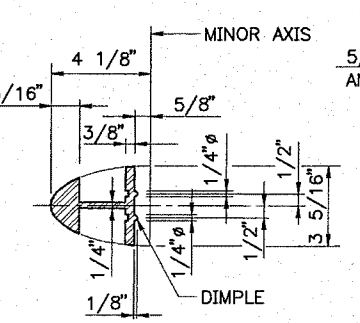


SECTION A-A (RAIL)
3"=1'-0"

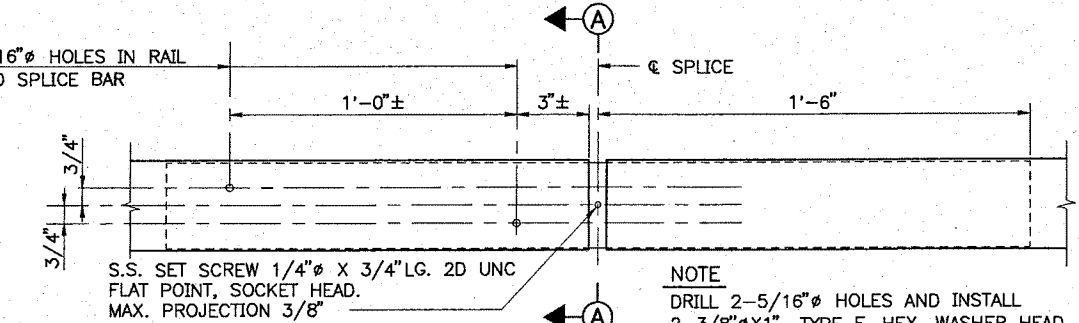


SPlice DETAIL
3"=1'-0"

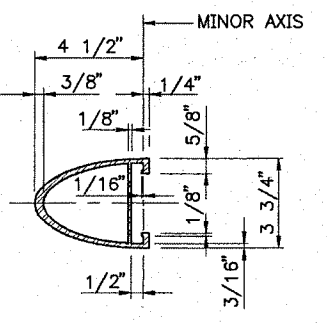


RAIL MEMBER
3"=1'-0"

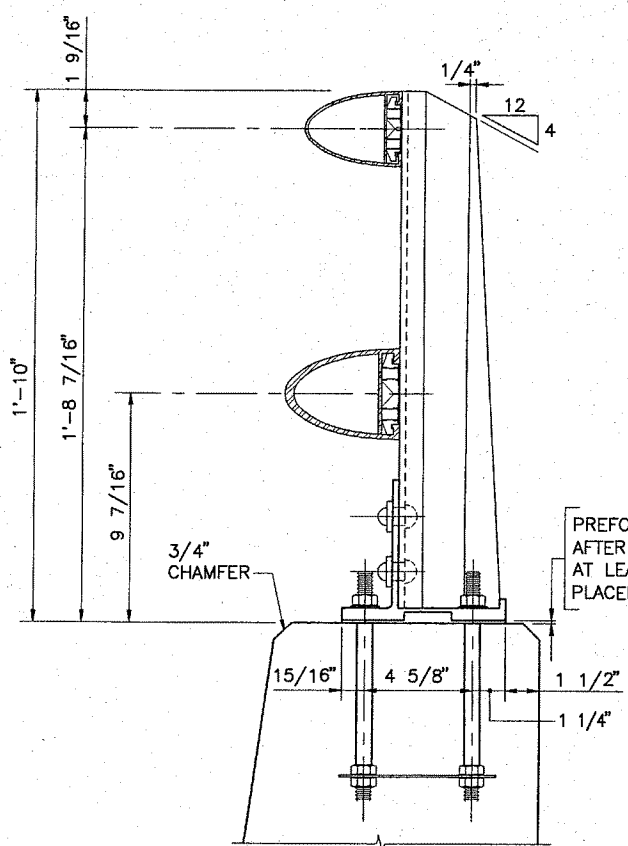

BRIDGE RAILING (ASSEMBLY)
3"=1'-0"

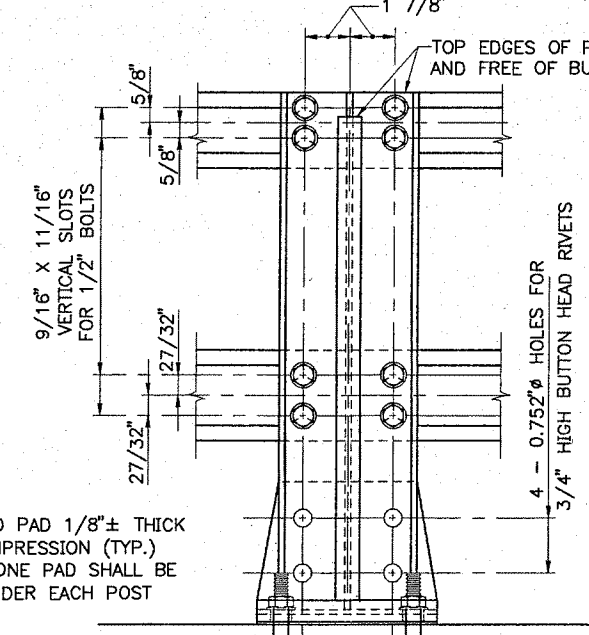


OUTSIDE ELEVATION OF POST
3"=1'-0"

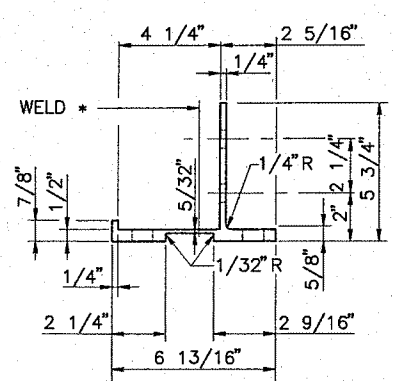


POST BASE SECTION
3"=1'-0"


NOTE
* ONE-PIECE BASE PLATE MAY BE SUBSTITUTED, PROVIDED THAT THE REQUIRED LENGTH IS CUT FROM A ONE-PIECE EXTRUSION AND HAS THE GEOMETRIC SHAPE OF THE TWO-PIECE BASE PLATE.

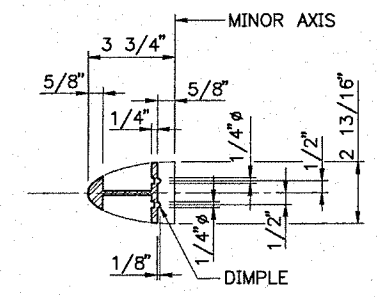


SECTION A-A (HANDRAIL)
3"=1'-0"

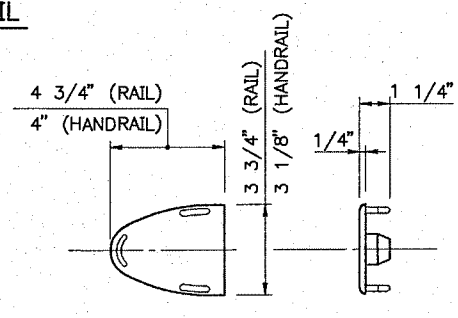


CAST ALUMINUM DRIVE FIT RAIL CAP
3"=1'-0"

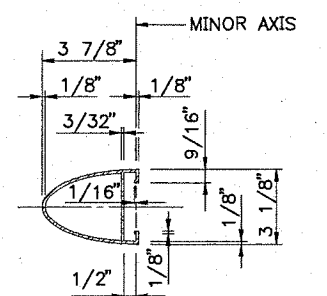


HANDRAIL MEMBER
3"=1'-0"

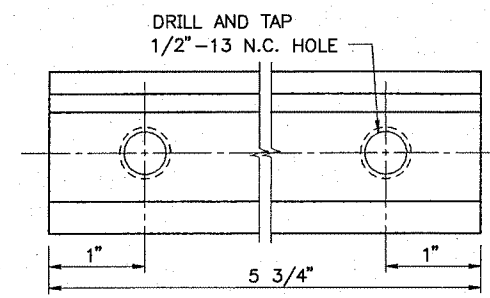


FOR RAIL MEMBER

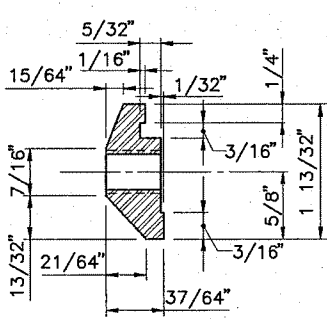


FOR HANDRAIL

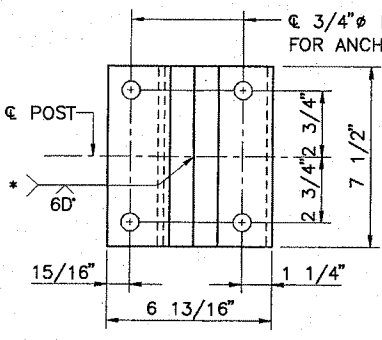


POST BASE (BOTTOM VIEW)
3"=1'-0"

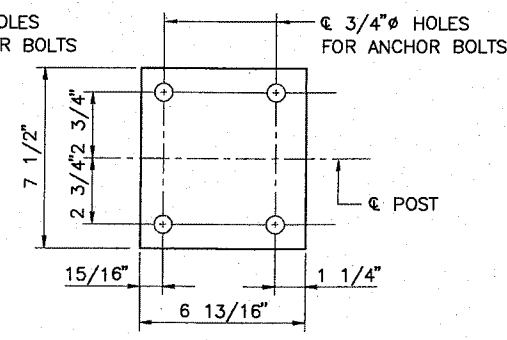


PREFORMED PAD
3"=1'-0"

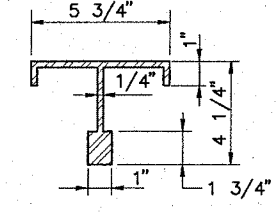

POST SECTION
3"=1'-0"

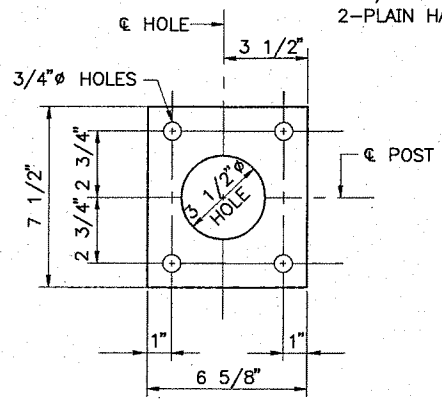


STEEL SPACER PLATE (FOR ANCHORAGE)
3"=1'-0"

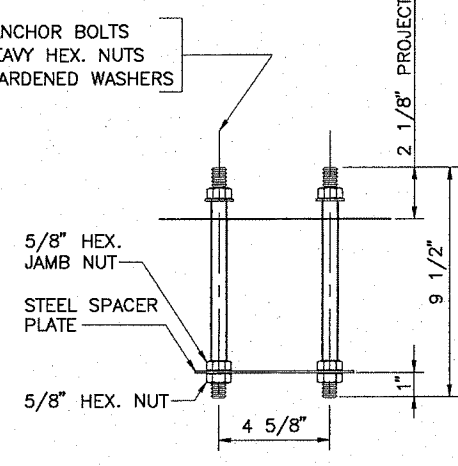

RAIL POST ANCHORAGE (ASSEMBLY)
3"=1'-0"

CLAMP BAR DETAILS
FULL SIZE

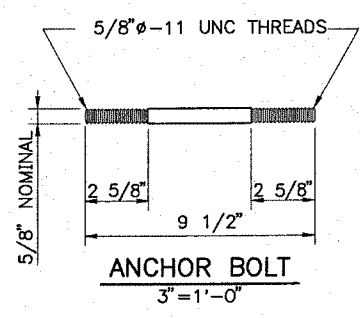

ANCHOR BOLT
3"=1'-0"

NOTE
IF CUT THREADS ARE USED, BODY DIAMETER SHALL BE NOT LESS THAN NOMINAL DIAMETER. IF ROLLED THREADS ARE USED, BODY DIAMETER SHALL BE NOT LESS THAN PITCH DIAMETER OF THE THREADS.

NOTE
FOUR (4) BOLT, NUT AND WASHER SETS ARE REQUIRED PER ASSEMBLY. ALL HARDWARE AND ANCHOR BOLTS SHALL BE GALVANIZED.

M:\14335\003\001\SSRALIS1.DWG 04/03/02 11:07

Scale: AS NOTED

No.	Revision	By	Date

Designed by:

HNTB
ARCHITECTS ENGINEERS PLANNERS

Designed	By	Date	Checked	By	Date
	AD	10/01		ML	1/02
Drawn	By	Date	In Charge of	By	Date
	LS	10/01		RAL	3/02

HNTB CORPORATION
2 Thomas Drive
Westbrook, ME 04092
TEL (207) 774-5155
FAX (207) 772-7410

MAINE TURNPIKE AUTHORITY



SABATTUS INTERCHANGE/
ROUTE 9
ALUMINUM BRIDGE RAILING DETAILS

CONTRACT: 2002.25

SHEET NUMBER: SI-22

55 OF 63