
MAINE TURNPIKE

THE GOLD STAR MEMORIAL HIGHWAY

MAINE TURNPIKE AUTHORITY

GERARD P. CONLEY, CHAIRMAN
LUCIEN B. GOSSELIN, VICE CHAIRMAN
EARL L. ADAMS, MEMBER
HARLAND C. GOODWIN, MEMBER
RICHARD E. VALENTINO, MEMBER
DOUGLAS A. VOLK, MEMBER
GREGORY G. NADEAU, MEMBER EX–OFFICIO

PAUL E. VIOLETTE, EXECUTIVE DIRECTOR

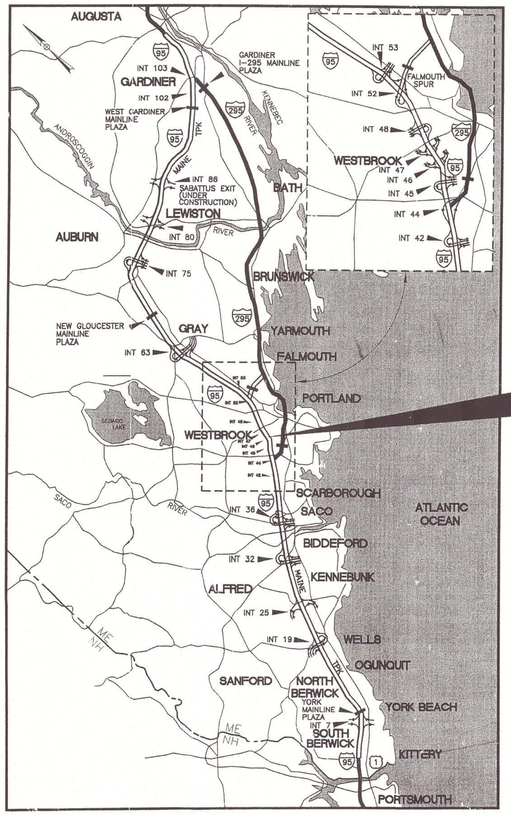

LOCATION MAP

CONTRACT 2007.07
MAINE TURNPIKE AUTHORITY
ADMINISTRATION BUILDING

CONTRACT 2007.07
MAINE TURNPIKE AUTHORITY
ADMINISTRATION BUILDING
SET 1 OF 2

STATE OF MAINE
DEPARTMENT OF TRANSPORTATION

COMMISSIONER _____ DATE _____

BUREAU DIRECTOR AND CHIEF ENGINEER _____ DATE _____

GENERAL CONTRACTOR

BUSINESS NAME _____

OFFICER _____ TITLE _____

DATE _____

APPROVED:


MAINE TURNPIKE AUTHORITY

_____ CHAIRMAN

_____ EXECUTIVE DIRECTOR

DATE _____

CONTRACT 2007.07

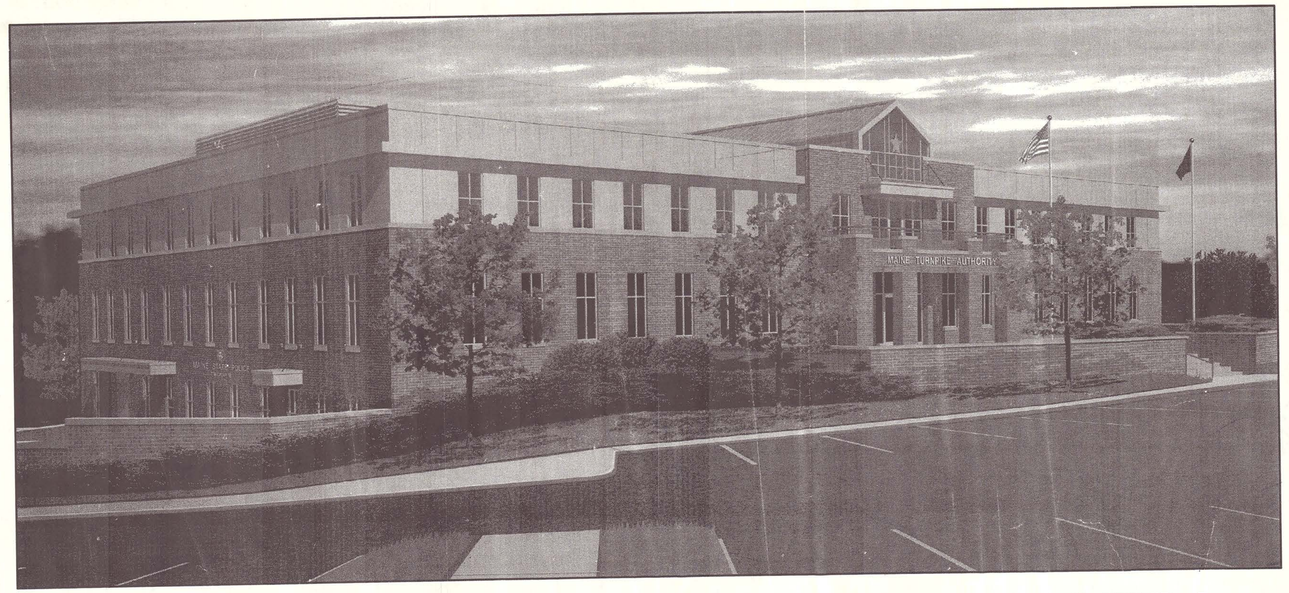

MAINE TURNPIKE AUTHORITY ADMINISTRATION BUILDING

PORTLAND, MAINE

GENERAL NOTES:

1. FIELD VERIFY ALL DIMENSIONS AND LAYOUT PRIOR TO PROCEEDING WITH WORK. NOTIFY ARCHITECT IN WRITING OF ANY DISCREPANCIES OR INCONSISTENCIES. FAILURE TO REPORT ANY DISCREPANCIES WITHIN THESE CONSTRUCTION DOCUMENTS TO THE ARCHITECT WILL NOT BE GROUNDS FOR ADDITIONAL COST OR CHANGE ORDERS.
2. CONTRACTOR SHALL BE RESPONSIBLE FOR PROVIDING ALL MATERIALS (UNLESS NOTED OTHERWISE), AND WORKMANSHIP IN ACCORDANCE WITH FEDERAL, STATE, CITY AND LOCAL BUILDING CODES AND THEIR REQUIREMENTS.
3. CONTRACTOR AND ALL TRADES SHALL NOTE REQUIREMENTS OF "GENERAL NOTES" ON ALL SHEETS.
4. EACH TRADE TO PROVIDE SMOKE OR FIRE SEALANT AT PENETRATIONS AS REQUIRED FOR WALL TYPE. ALL SEALANT, FIRE STOPPING, AND SMOKE STOPPING ASSEMBLIES SHALL BE U.L. RATED.
5. DIMENSIONS ARE FACE OF CONCRETE, FACE OF MASONRY, AND CENTERLINE OF STUD PARTITIONS, UNLESS INDICATED OTHERWISE.
6. REFER TO ALL CONSTRUCTION DOCUMENTS FOR REQUIREMENTS WHICH MAY AFFECT THE WORK IN ANOTHER DISCIPLINE AND COORDINATE WORK.
7. SEE G1003 FOR TYPICAL MOUNTING HEIGHTS OF PLUMBING FIXTURES, BATHROOM ACCESSORIES AND MISC. ITEMS.
8. REFER TO DETAILS FOR ADDITIONAL DIMENSIONAL INFORMATION.
9. DOOR JAMBS SHALL BE LOCATED 6" FROM CORNER IN STUD PARTITIONS AND 8" FROM CORNER IN MASONRY PARTITIONS, UNLESS INDICATED OTHERWISE.
10. PROVIDE BLOCKING IN WALLS AS NECESSARY WHERE CASEWORK, SHELVES, HANDRAILS, AND MISC. EQUIPMENT ARE LOCATED.
11. DO NOT SCALE DRAWINGS.
12. "PROVIDE" MEANS "FURNISH AND INSTALL".
13. ELEVATIONS INDICATED ON THE GENERAL, ARCHITECTURAL, STRUCTURAL, MECHANICAL, ELECTRICAL, FIRE PROTECTION AND PLUMBING DRAWINGS ARE BASED ON AN ASSIGNED REFERENCE ELEVATION OF THE FIRST FLOOR = 100'-0". ACTUAL FIRST FLOOR ELEVATION BASED ON USGS DATUM INDICATED ON DRAWING CP201.


AS BUILT
Owner Copy

SMRT
ARCHITECTURE ENGINEERING PLANNING
SMRT
144 Fore Street / P.O. Box 618
Portland, Maine 04104
tel. (207) 772-3846
fax. (207) 772-1070

STATE OF MAINE
SCOTT L BENSON
No. 1772
REGISTERED PROFESSIONAL ARCHITECT

PROJECT NORTH
MAG NORTH

LOCATION MAP:

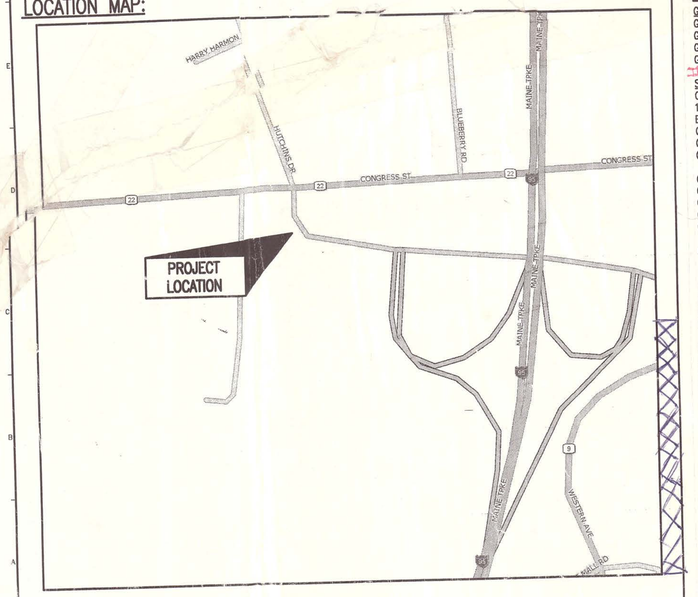

DRAWING LIST:

GENERAL		**ARCHITECTURAL CONT.**		**ARCHITECTURAL CONT.**		**STRUCTURAL CONT.**	
G1000	COVER SHEET	AE111	FIRST FLOOR LAYOUT PLAN	AE531	BUILDING AND WALL SECTION DETAILS	S5.0	STEEL BRACING ELEVATIONS & DETAILS
G1001	TITLE SHEET	AE112	SECOND FLOOR LAYOUT PLAN	AE532	BUILDING AND WALL SECTION DETAILS	S5.1	COLUMN SCHEDULE
G1002	GENERAL INFORMATION	AE113	THIRD FLOOR LAYOUT PLAN	AE533	BUILDING AND WALL SECTION DETAILS	S5.2	STEEL FRAMING SECTIONS & DETAILS
G1003	GENERAL INFORMATION			AE534	BUILDING AND WALL SECTION DETAILS	S5.3	STEEL FRAMING SECTIONS & DETAILS
		AE121	FIRST FLOOR REFLECTED CEILING PLAN	AE535	BUILDING AND WALL SECTION DETAILS	S5.4	STEEL FRAMING SECTIONS & DETAILS
SITE		AE122	SECOND FLOOR REFLECTED CEILING PLAN			S5.5	STEEL FRAMING SECTIONS & DETAILS
C001	NOTES AND LEGEND	AE123	THIRD FLOOR REFLECTED CEILING PLAN	AE541	STAIR SECTIONS	S5.6	STEEL FRAMING SECTIONS & DETAILS
1 OF 1	PROPERTY AND RIGHT-OF-WAY PLAN			AE542	STAIR DETAILS	S5.7	STEEL FRAMING SECTIONS & DETAILS
B1	EXISTING CONDITIONS PLAN	AE131	ROOF PLAN	AE543	STAIR DETAILS		
CP101	LAYOUT PLAN			AE544	RAILING DETAILS	**FIRE PROTECTION**	
CP201	DETAIL LAYOUT PLAN	AE201	EXTERIOR ELEVATIONS			FP101	FIRST FLOOR FIRE PROTECTION PLAN
CP202	DETAIL LAYOUT PLAN	AE202	EXTERIOR ELEVATIONS	AE601	FIRST FLOOR ROOM FINISH SCHEDULE	FP102	SECOND FLOOR FIRE PROTECTION PLAN
				AE602	SECOND FLOOR ROOM FINISH SCHEDULE	FP103	THIRD FLOOR FIRE PROTECTION PLAN
CG101	GRADING PLAN	AE211	INTERIOR ELEVATIONS	AE603	THIRD FLOOR ROOM FINISH SCHEDULE		
CG201	DETAIL GRADING PLAN	AE212	INTERIOR ELEVATIONS			FP501	FIRE PROTECTION DETAILS
CG202	DETAIL GRADING PLAN	AE213	INTERIOR ELEVATIONS	AE611	FIRST FLOOR DOOR SCHEDULE		
CG203	SITE GRADING DETAILS	AE214	INTERIOR ELEVATIONS	AE612	SECOND FLOOR DOOR SCHEDULE	**MECHANICAL**	
CG301	UNDERDRAIN SOIL FILTER AND DETENTION POND PLANS AND DETAILS	AE215	INTERIOR ELEVATIONS	AE613	THIRD FLOOR DOOR SCHEDULE	M-001	LEGEND AND ABBREVIATIONS
		AE216	INTERIOR ELEVATIONS				
CG302	UNDERDRAIN SOIL FILTER AND DETENTION POND PLANS AND DETAILS	AE217	INTERIOR ELEVATIONS	AE621	DOOR AND WINDOW ELEVATIONS	MH101	FIRST FLOOR HVAC DUCTWORK PLAN
		AE218	INTERIOR ELEVATIONS	AE622	DOOR AND WINDOW ELEVATIONS	MH102	SECOND FLOOR HVAC DUCTWORK PLAN
		AE219	INTERIOR ELEVATIONS	AE623	DOOR AND WINDOW DETAILS	MH103	THIRD FLOOR HVAC DUCTWORK PLAN
CU101	UTILITY PLAN	AE220	INTERIOR ELEVATIONS	AE624	DOOR AND WINDOW DETAILS	MH104	ROOF HVAC DUCTWORK PLAN
CU201	SEWER PLAN AND PROFILE			AE625	DOOR AND WINDOW DETAILS		
CU202	SEWER DETAILS SHEET 1	AE301	BUILDING SECTIONS	AE626	DOOR AND WINDOW DETAILS	MP101	FIRST FLOOR HVAC PIPING PLAN
CU203	SEWER DETAILS SHEET 2			AE627	DOOR AND WINDOW DETAILS	MP102	SECOND FLOOR HVAC PIPING PLAN
		AE311	WALL SECTIONS	AE628	DOOR AND WINDOW DETAILS	MP103	THIRD FLOOR HVAC PIPING PLAN
LP101	LANDSCAPE PLAN	AE312	WALL SECTIONS				
LP201	DETAIL LANDSCAPE PLAN	AE313	WALL SECTIONS	AF101	FIRST FLOOR FINISH PLAN	MP111	FIRST FLOOR RADIANT FLOOR PIPING PLAN
LP202	DETAIL LANDSCAPE PLAN	AE314	WALL SECTIONS	AF102	SECOND FLOOR FINISH PLAN	MP111A	FIRST FLOOR INSLAB RADIANT FLOOR PIPING PLAN
LP501	LANDSCAPE DETAILS/PLANT LIST	AE315	WALL SECTIONS	AF103	THIRD FLOOR FINISH PLAN	MP112	SECOND FLOOR RADIANT FLOOR PIPING PLAN
		AE316	WALL SECTIONS			MP113	THIRD FLOOR RADIANT FLOOR PIPING PLAN
C-301	SITE WALL ELEVATIONS			**STRUCTURAL**			
C-501	SITE DETAILS	AE401	ENLARGED PARTIAL PLANS	S1.0	GENERAL STRUCTURAL NOTES	M-401	MECHANICAL ROOM PART PLAN
C-502	SITE DETAILS	AE402	MAINTENANCE BUILDING PLANS & ELEVATIONS	S1.1	GENERAL STRUCTURAL NOTES		
C-503	SITE DETAILS					M-501	DETAILS
C-504	SITE DETAILS	AE501	TYPICAL SECTIONS & DETAILS	S2.0	FOUNDATION PLAN	M-502	DETAILS
						M-503	DETAILS
CS301	EROSION/SEDIMENT CONTROL PLAN	AE511	PLAN SECTIONS & DETAILS	S3.0	FOUNDATION SECTIONS & DETAILS	M-504	DETAILS
CS302	EROSION/SEDIMENT CONTROL NOTES	AE512	PLAN SECTIONS & DETAILS	S3.1	FOUNDATION SECTIONS & DETAILS		
CS501	EROSION/SEDIMENT CONTROL DETAILS	AE513	PLAN SECTIONS & DETAILS	S3.2	FOUNDATION SECTIONS & DETAILS	M-601	SCHEDULES
CS502	EROSION/SEDIMENT CONTROL DETAILS	AE514	PLAN SECTIONS & DETAILS	S3.3	FOUNDATION SECTIONS & DETAILS	M-602	SCHEDULES
		AE515	PLAN SECTIONS & DETAILS	S3.4	FOUNDATION PIERS & DETAILS	M-603	SCHEDULES
ARCHITECTURAL				S3.5	FOUNDATION SECTIONS & DETAILS	M-651	SCHEMATICS
AE001	CODE COMPLIANCE INFORMATION	AE521	INTERIOR ELEVATION SECTIONS & DETAILS	S3.6	BRICKSHELF ELEVATION PLAN	M-652	SCHEMATICS
AE101	FIRST FLOOR PLAN	AE522	INTERIOR ELEVATION SECTIONS & DETAILS			M-653	SCHEMATICS
AE102	SECOND FLOOR PLAN	AE523	INTERIOR ELEVATION SECTIONS & DETAILS	S4.0	SECOND FLOOR FRAMING PLAN		
AE103	THIRD FLOOR PLAN			S4.1	THIRD FLOOR FRAMING PLAN		
				S4.2	ROOF FRAMING PLAN		

PLUMBING			
PL101	FIRST FLOOR DWV PIPING PLAN		
PL102	SECOND FLOOR DWV PIPING PLAN		
PL103	THIRD FLOOR DWV PIPING PLAN		
PL111	FIRST FLOOR SUPPLY PIPING PLAN		
PL112	SECOND FLOOR SUPPLY PIPING PLAN		
PL113	THIRD FLOOR SUPPLY PIPING PLAN		
PL401	MECHANICAL & TOILET ROOM PART PLANS		
PL501	DETAILS		
PL502	DETAILS		
PL601	SCHEDULES		
PL651	RISER DIAGRAM		
ELECTRICAL			
E-001	LEGEND AND GENERAL NOTES		
ES101	ELECTRICAL SITE PLAN		
ES301	DUCT BANK DETAILS		
ES302	DUCT BANK DETAILS		
ES401	ENLARGED ELECTRICAL SITE PLAN		
EG101	GROUNDING & CONDUIT PLAN		
EP101	FIRST FLOOR POWER PLAN		
EP102	SECOND FLOOR POWER PLAN		
EP103	THIRD FLOOR POWER PLAN		
EP104	ROOF POWER PLAN		
EP401	ENLARGED POWER PLANS		
EP402	ENLARGED POWER PLANS		
EPE01	PANEL SCHEDULES		
EP602	PANEL SCHEDULES		
EP603	PANEL SCHEDULES		
EP651	ELECTRICAL ONE LINE DIAGRAM		
EL101	FIRST FLOOR LIGHTING PLAN		
EL102	SECOND FLOOR LIGHTING PLAN		
EL103	THIRD FLOOR LIGHTING PLAN		
EL401	ENLARGED LIGHTING PLANS		
EL651	LIGHTING FIXTURE SCHEDULE		
EL651	LIGHTING DETAILS		
EL652	LIGHTING CONTROL SCHEDULES & RISER		
EL653	LIGHTING DETAILS AND RISERS		
EY101	FIRST FLOOR SYSTEMS PLAN		
EY102	SECOND FLOOR SYSTEMS PLAN		
EY1	THIRD FLOOR SYSTEMS PLAN		
EY65	FIRE ALARM RISER DIAGRAM		
	SYSTEMS RISER DIAGRAMS		

PROJECT TITLE: MAINE TURNPIKE AUTHORITY ADMINISTRATION BUILDING PORTLAND, MAINE

CURRENT ISSUE STATUS: ISSUED FOR BIDDING/CONSTRUCTION 7-3-07

NO.	DESCRIPTION	DATE
0	BIDDING/CONSTRUCTION	7-9-07

GRAPHIC SCALE: 0" 1"

SCALE:	AS NOTED
PROJECT MANAGER:	SLB
AS/DRAWN BY:	TCM/TCM
M/E OF RECORD:	N/A
CAD FILE:	G100-0606
PROJECT NO:	00016
DATE:	7-9-07

SHEET TITLE: TITLE SHEET

SHEET No. G100.1

ABBREVIATIONS

AB	ANCHOR BOLT
AC, A/C	AIR CONDITIONING
ACCU	AIR CONDITIONING CONDENSER UNIT
ACPLAS	ACOUSTICAL PLASTER
ACT	ACOUSTIC CEILING TILE
AFF	ABOVE FINISHED FLOOR
AGG	AGGREGATE
ALT	ALTERNATE
AP	ACCESS PANEL
APROX	APPROXIMATE
ARCH	ARCHITECTURAL
BCX	BOTTOM CHORD EXTENSION
BD	BOARD
BIT	BITUMINOUS
BLDG	BUILDING
BLP	BORROWED LIGHT PANEL
BO	BOTTOM OF
BOF	BOTTOM OF FOOTING
BOS	BOTTOM OF STEEL
BOT	BOTTOM
BRDG	BRIDGING
BRG	BEARING
BS	BOTH SIDES
BSE	BRICK SHELF ELEVATION
C	CHANNEL
CB	CATCH BASIN; CHALKBOARD
CEM BD	CEMENTITIOUS BACKER BOARD
CFM	CUBIC FEET PER MINUTE
CIP	CAST IN PLACE
CJ	CONTROL JOINT; CONSTRUCTION JOINT
CL	CENTER LINE
CLL	CONTRACT LIMIT LINE
CLR	CLEAR
CMU	CONCRETE MASONRY UNIT
COL	COLUMN
CONC	CONCRETE
CONT	CONTINUOUS
CT	CERAMIC TILE
CUH	CABINET UNIT HEATER
D	DIAMETER
DBL	DOUBLE
DF	DRINKING FOUNTAIN
DL	DEAD LOAD
DR	DISPLAY RAIL
DTL	DETAIL
DW	DISHWASHER
DWG	DRAWING
EA	EACH
EF	EXHAUST FAN; EACH FACE
EJ	EXPANSION JOINT
EL	ELEVATION
ELEC	ELECTRICAL
EOP	EDGE OF PAVEMENT
EPDM	ETHYLENE PROPYLENE DIENE MONOMER
EQ	EQUAL
EW	EACH WAY
EWC	ELECTRIC WATER COOLER
EXIST	EXISTING
EXP	EXPANSION
EXT	EXTERIOR
F.R.P.	FABRICATED FIBERGLASS REINFENFORCED PLASTIC
FB	FLAT BAR
FBO	FURNISHED BY OTHERS
FCO	FLOOR CLEAN-OUT
FD	FLOOR DRAIN
FE	FIRE EXTINGUISHER
FF	FINISHED FLOOR; FAR FACE
FFE	FINISHED FLOOR ELEVATION
FO	FRAMED OPENING
FRP	FIBERGLASS REINFORCED PLASTIC
FS	FAR SIDE
FTG	FOOTING
GA	GAUGE
GALV	GALVANIZED
GB	GRAB BAR
GC	GENERAL CONTRACTOR
GDT	GYPSUM DROP-IN TILE
GV	GRAVITY VENT
GWB	GYPSUM WALL BOARD
H	HORIZONTAL
HC	HANDICAPPED; HOLLOW CORE
HORIZ	HORIZONTAL
HM	HOLLOW METAL
HRU	HEAT RECOVERY UNIT
H&V	HEATING AND VENTILATING
HVAC	HEATING, VENTILATING AND AIR CONDITIONING
I	INCLUDED ANGLE
ID	INSIDE DIAMETER
IF	INSIDE FACE
IJ	ISOLATION JOINT
IMP	IMPACT RESISTANT
INS	INSULATED
INV	INVERT
JS	JOIST SUBSTITUTE
K	KIPS
L	ANGLE; LENGTH
LF	LEFT
LINO	SHEET LINOLEUM
LL	LIVE LOAD
LLH	LONG LEG HORIZONTAL
LLV	LONG LEG VERTICAL
LP	LIGHTING PANEL; LIQUIFIED PROPANE
MAX	MAXIMUM
MB	MARKER BOARD
MDO	MEDIUM DENSITY OVERLAY
MECH	MECHANICAL
MFR	MANUFACTURER
MIN	MINIMUM
MISC	MISCELLANEOUS
MO	MASONRY OPENING
MR	MOISTURE-RESISTANT
MUA	MAKE-UP AIR
N	NOSING
NCB	NEW CATCH BASIN
NDMH	NEW DRAIN MANHOLE
NFM	NEW FORCE MAIN
NIC	NOT IN CONTRACT
NS	NEAR SIDE
NSD	NEW STORM DRAIN LINE
NSS	NEW SANITARY SEWER LINE
NTS	NOT TO SCALE
NW	NEW WATER LINE
OC	ON CENTER
OF	OUTSIDE FACE
OH	OVERHEAD
PA	PUBLIC ADDRESS
PAF	POWDER-ACTUATED FASTENER
PDU	POOL DEHUMIDIFICATION UNIT
PL	PLATE; PROPERTY LINE
PLAM	PLASTIC LAMINATE
PLF	POUNDS PER LINEAR FOOT
PP	POWER PANEL
PSF	POUNDS PER SQUARE FOOT
PSI	POUNDS PER SQUARE INCH
PT	PRESSURE-TREATED
PVC	POLYVINYL CHLORIDE
PVMT	PAVEMENT
R	RISER; RADIUS
RB	RESILIENT BASE
RD	ROOF DRAIN
REINF	REINFORCED
REQ'D	REQUIRED
RT	RIGHT
RO	ROUGH OPENING
ROW	RIGHT OF WAY
RR	RUB-RAIL
RTU	ROOFTOP UNIT (HVAC)
SACT	SUSPENDED ACOUSTIC EQUAL CEILING TILE
SC	SOLID CORE
SF	SQUARE FOOT; SUPPLY FAN
SHT	SHEET
SIM	SIMILAR
SK	SHEAR KEY
SN	SANITARY NAPKIN (DISPENSER)
SP	SPECIAL
SS	STAINLESS STEEL
STA	STATION
STL	STEEL
STRUC	STRUCTURAL
T	TREAD
TB	TACKBOARD
T&B	TOP AND BOTTOM
TBM	TEMPORARY BENCHMARK
TCE	TOP CHORD EXTENSION
TJ	TIE JOIST
TO	TOP OF
TOC	TOP OF CONCRETE
TOF	TOP OF FOOTING
TOM	TOP OF MASONRY
TOP	TOP OF PIER
TOS	TOP OF STEEL; TOP OF SLAB
TOW	TOP OF WALL
TP	TOILET PAPER (DISPENSER); TEST PIT
TS	TUBE STEEL
TYP	TYPICAL
UH	UNIT HEATER
UNO	UNLESS NOTED OTHERWISE
V	VENT PIPE; VERTICAL
VB	VAPOR BARRIER
VCT	VINYL COMPOSITION TILE
VERT	VERTICAL
VP	VISION PANEL
VTR	VENT THROUGH THE ROOF
W/	WITH
WC	WATER CLOSER
WF	WIDE FLANGE
WH	WATER HEATER
W/O	WITHOUT
WP	WORKING POINT
WS	WEB STIFFENER
WWF	WELDED WIRE FABRIC

See RFI 179 For Interior Wall Types (Type X Gens Armour Plus Type X

PARTITION LEGEND

S1 PARTITION:
3-5/8" METAL STUDS @ 16" O.C. TO DECK. (1) LAYER 5/8" GWB TO DECK EACH SIDE, BATT INSULATION.

S2 PARTITION:
3-5/8" METAL STUDS @ 16" O.C. TO 6" ABOVE CEILING. (1) LAYER 5/8" GWB TO 6" ABOVE CEILING EACH SIDE, BATT INSULATION.

S3 PARTITION:
3-5/8" METAL STUDS @ 16" O.C. TO 6" ABOVE CEILING. (1) LAYER 5/8" GWB TO 6" ABOVE CEILING EACH SIDE.

S4 SMOKE PARTITION:
SIMILAR TO S1 EXCEPT SEAL PERIMETER AND ALL PENETRATIONS W/ FIRESTOPPING SEALANT.

S5 1 HOUR FIRE RATED PARTITION: UL DESIGN U419
20 GAGE 3-5/8"x1-1/4" FLOOR AND CEILING RUNNERS FASTENED @ 24" O.C. MAX. WITH 3-5/8"x1-5/8" 20 GAGE STUDS WITH 3/8" RETURNS SPACED 16" O.C. FASTEN (1) LAYER 5/8"x4' TYPE 'X' GWB TO BOTH SIDES OF STUDS & TRACKS WITH 1" TYPE S SELF TAPPING SCREWS AT 8" O.C. ALONG EDGES & 12" O.C. INFIELD. APPLY 2" PAPER JOINTS AND FINISH W/2 COATS OF JOINT COMPOUND. SEAL PERIMETER AND ALL PENETRATIONS W/ FIRESTOPPING SEALANT. BLANKET INSULATION IN STUD CAVITIES.

S6 PARTITION:
SIMILAR TO S1 EXCEPT (2) LAYERS 5/8" GWB TO DECK EACH SIDE.

S7 SMOKE PARTITION:
SIMILAR TO S4 EXCEPT (2) LAYERS 5/8" GWB TO DECK EACH SIDE.

S8 1 HOUR FIRE RATED PARTITION: UL DESIGN U419:
SIMILAR TO S5 EXCEPT (2) LAYERS 5/8" GWB TO DECK EACH SIDE.

S9 PARTITION:
6" METAL STUDS @ 16" O.C. TO DECK. (1) LAYER 5/8" GWB TO DECK EACH SIDE. BATT INSULATION.

S10 SMOKE PARTITION:
SIMILAR TO S9 EXCEPT SEAL PERIMETER AND ALL PENETRATIONS W/ FIRESTOPPING SEALANT.

S11 1 HOUR FIRE RATED PARTITION: UL DESIGN U419
20 GAGE 6"x1-1/4" FLOOR AND CEILING RUNNERS FASTENED @ 24" O.C. MAX. WITH 6"x1-5/8" 20 GAGE STUDS WITH 3/8" RETURNS SPACED 16" O.C. FASTEN (1) LAYER 5/8"x4' TYPE 'X' GWB TO BOTH SIDES OF STUDS & TRACKS WITH 1" TYPE S SELF TAPPING SCREWS AT 8" O.C. ALONG EDGES & 12" O.C. INFIELD. APPLY 2" PAPER JOINTS AND FINISH W/2 COATS OF JOINT COMPOUND. SEAL PERIMETER AND ALL PENETRATIONS W/ FIRESTOPPING SEALANT. BLANKET INSULATION IN STUD CAVITIES.

S12 1 HOUR RATED SHAFT WALL: UL DESIGN U415-SYSTEM A
4" 22 GAGE 'J' SHAPED FLOOR AND CEILING RUNNERS ATTACHED TO STRUCTURAL SUPPORTS 2" (MAX) FROM EDGE AND 24" (MAX) O.C. 22 GAGE 4" 'C-H' SHAPED STUDS SPACED 24" O.C. (MAX). 1" GWB LINER PANELS INSERTED INTO 'H' SECTION OF 'C-H' STUDS, ATTACH TO LONG LEG OF 'J' SHAPE WITH 1-5/8" TYPE S SELF DRILLING, SELF TAPPING SCREWS 12" O.C. (MAX). FASTEN (1) LAYER 5/8" TYPE X GWB TO OUTER FACE OF 'C' PORTION OF 'C-H' STUDS WITH 1" TYPE S SELF TAPPING SCREWS AT 8" O.C. ALONG EDGES & 12" O.C. INFIELD. INSTALL BOARD WITH VERTICAL JOINTS STAGGERED. APPLY 2" PAPER JOINTS AND FINISH W/2 COATS OF JOINT COMPOUND. SEAL TIGHT TO STRUCTURE AND DECK. PROVIDE FULL THICKNESS BATT INSULATION IN PARTITION.

S13 1 HOUR RATED SHAFT WALL: UL DESIGN U415-SYSTEM A
SIMILAR TO S12 EXCEPT ADD (1) FINISH LAYER OF 5/8" GWB TAGGED SIDE. SEAL PERIMETER AND ALL PENETRATIONS W/ FIRESTOPPING SEALANT.
TAGGED SIDE

C1 CHASE WALL:
5/8" GWB TO DECK, 3-5/8" METAL STUDS TO DECK, 2 PIECES 24" HIGH GYPSUM PANEL BRACING, A SECOND ROW OF 3-5/8" METAL STUDS TO DECK, 5/8" GWB TO DECK. REFER TO ROOM FINISH SCHEDULE FOR APPLIED FINISHES SUCH AS TILE. PROVIDE SPECIFIED WALL FINISH SUBSTRATE IN PLACE OF GYPSUM BOARD WHERE TILE IS SCHEDULED.

C2 SMOKE CHASE WALL:
SIMILAR TO C1 EXCEPT SEAL PERIMETER AND ALL PENETRATIONS W/ FIRESTOPPING SEALANT.

C3 1 HOUR FIRE RATED CHASE WALL: UL DESIGN 420
5/8" TYPE 'X' GWB TO DECK, 3-5/8" METAL STUDS TO DECK, 2 PIECES 24" HIGH GYPSUM PANEL BRACING, A SECOND ROW OF 3-5/8" METAL STUDS TO DECK, 5/8" TYPE 'X' GWB TO DECK. SEAL PERIMETER AND ALL PENETRATIONS W/ FIRESTOPPING SEALANT. REFER TO PLANS FOR WALL THICKNESS. CONSTRUCT WALL TO COMPLY WITH NO LESS THAN THE REQUIREMENTS OF UL DESIGN #U420. REFER TO FINISH SCHEDULE FOR APPLIED FINISHES SUCH AS TILE. PROVIDE SPECIFIED WALL FINISH SUBSTRATE IN PLACE OF GYPSUM BOARD WHERE TILE IS SCHEDULED.

F1 FURRING:
1 5/8" METAL STUDS @ 16" O.C. TO 6" ABOVE CEILING. (1) LAYER 5/8" GWB TO 6" ABOVE CEILING TAGGED SIDE. EXPOSED STUDS OPPOSITE SIDE, BATT INSULATION.
TAGGED SIDE

F2 FURRING:
3-5/8" METAL STUDS @ 16" O.C. TO 6" ABOVE CEILING. (1) LAYER 5/8" GWB TO 6" ABOVE CEILING TAGGED SIDE. EXPOSED STUDS OPPOSITE SIDE, BATT INSULATION.
TAGGED SIDE

F3 2" 'Z' FURRING CHANNELS @ 24" O.C. TO DECK. 2" RIGID INSULATION BETWEEN CHANNELS TO DECK. (1) LAYER 5/8" GWB TO DECK, TAGGED SIDE.
TAGGED SIDE

M1 MASONRY WALL:
1 5/8" METAL STUDS @ 16" O.C. TO 6" ABOVE CEILING. (1) LAYER 5/8" GWB TO 6" ABOVE CEILING. 8"x8"x16" CMU TO DECK LAID IN FULL 3/8" MORTAR BED WITH VERTICAL JOINTS STAGGERED. REFER TO STRUCTURAL FOR REQUIRED REINFORCING. 1 5/8" METAL STUDS @ 16" O.C. TO 6" ABOVE CEILING. (1) LAYER 5/8" GWB TO 6" ABOVE CEILING.

M2 1 HOUR FIRE RATED MASONRY WALL (SEE PARTITION NOTE 6)
8"x8"x16" CMU TO DECK LAID IN FULL 3/8" MORTAR BED WITH VERTICAL JOINTS STAGGERED. SEAL TIGHT TO BOTTOM OF DECK. REFER TO STRUCTURAL FOR REQUIRED REINFORCING. BULLNOSE BLOCK AT ALL MASONRY OPENING EXPOSED CORNERS, TOPS AND SIDES.

M3 1 HOUR FIRE RATED MASONRY WALL (SEE PARTITION NOTE 6)
SAME AS M2 EXCEPT 1 5/8" METAL STUDS @ 16" O.C. TO 6" ABOVE CEILING. (1) LAYER 5/8" GWB TO 6" ABOVE CEILING TAGGED SIDE ONLY.
TAGGED SIDE

NOTES:
- (X)MR = MOISTURE RESISTANT GWB ON TAGGED SIDE ONLY
- (X)AR = 5/8" ABUSE RESISTANT GWB TO 8'-0" AFF, 5/8" GWB BEYOND TAGGED SIDE ONLY.
- (X)WM = (1) LAYER OF WIRE MESH INSTALLED BETWEEN STUDS AND GWB TAGGED SIDE ONLY, CREATING A SECURE BOUNDARY.
- (X)PLY = 5/8" FIRE RATED EXTERIOR GRADE PLYWOOD APPLIED TO SUBSTRATE TO 4'-0" AFF TAGGED SIDE ONLY. PAINT TO MATCH FINISH ABOVE.

EXTERIOR WALL LEGEND

W1
FACE BRICK, SEE ELEVATIONS
MASONRY ANCHOR, TYP.
AIR SPACE
2" FOAM-PLASTIC BOARD INSULATION
AIR/WATER BARRIER
5/8" GLASS-MAT GYPSUM WALL SHEATHING
6" METAL STUDS
6" GLASS FIBER BLANKET INSULATION
VAPOR RETARDER MEMBRANE
5/8" INTERIOR GYPSUM WALL BOARD
1'-10"
EXTERIOR
5 1/8"
2 5/8"
8"
INTERIOR

W2
METAL-COMPOSITE WALL PANEL, SEE ELEVATIONS
2" 'Z' FURRING
2" FOAM-PLASTIC BOARD INSULATION
AIR/WATER BARRIER
5/8" GLASS-MAT GYPSUM SHEATHING
6" METAL STUDS
6" GLASS FIBER BLANKET INSULATION
VAPOR RETARDER MEMBRANE
5/8" INTERIOR GYPSUM WALL BOARD
EXTERIOR
10 3/4"
1 1/2"
2 5/8"
INTERIOR

ROOF ASSEMBLY LEGEND

R1
SINGLE PLY THERMOPLASTIC MEMBRANE
1/4" GLASS-MAT GYPSUM COVER BOARD
1/4"/FOOT TAPERED RIGID INSULATION
5" RIGID INSULATION
5/8" GLASS-MAT TYPE X GYPSUM FIRE BARRIER BOARD
1-1/2" STEEL DECK, RE: STRUCTURAL
STEEL ROOF FRAMING, RE: STRUCTURAL
1/4"
5"
5/8"
1 1/2"

R2
SHEET METAL ROOFING
SELF-ADHERING SHEET UNDERLAYMENT
5/8" FIRE RATED EXTERIOR GRADE PLYWOOD
2x FIRE RATED EXTERIOR GRADE SLEEPERS @ 16" O.C., VENT SPACE BETWEEN.
1/4" GLASS-MAT GYPSUM COVER BOARD
5" RIGID INSULATION
5/8" GLASS-MAT TYPE X GYPSUM FIRE BARRIER BOARD
1-1/2" STEEL DECK, RE: STRUCTURAL
STEEL ROOF FRAMING, RE: STRUCTURAL
RFI-84 For Grade of Plywood (Fire Rated)
5/8"
1 1/2"
1/4"
5"
5/8"
1 1/2"

R3
ROOF PAVERS
PAVER SUPPORTS (P.T. BLOCKING BELOW TPO MEMBRANE)
SINGLE PLY THERMOPLASTIC MEMBRANE
1/4" GLASS-MAT GYPSUM COVER BOARD
1/4"/FOOT TAPERED RIGID INSULATION
2" RIGID INSULATION
5" CONCRETE SLAB, RE: STRUCTURAL
2"
5"

R4
SINGLE PLY THERMOPLASTIC MEMBRANE
1/4" GLASS-MAT GYPSUM COVER BOARD
1/4"/FOOT TAPERED RIGID INSULATION
STEEL ROOF FRAMING, RE: STRUCTURAL
1/4"
1 1/2"

GENERAL NOTES:

1. SEE GI001 FOR PROJECT GENERAL NOTES.

PARTITION NOTES:

1. PARTITION TYPE DRAWINGS ARE GRAPHIC REPRESENTATION ONLY, THEY ARE NOT TO SCALE TYPICAL.
2. MORTAR USED IN THE RATED ASSEMBLIES SHALL HAVE SAND TO CEMENT RATIO BETWEEN 2.25 & 3.5, AND HYDRATED LIME TO CEMENT RATIO LESS THAN 0.5.
3. ALL BATT INSULATION IS TO BE FULL THICKNESS AND FULL HEIGHT UNLESS NOTED OTHERWISE.
4. REFER TO FINISH SCHEDULE FOR EXTENT OF FINISHES APPLIED TO WALLS.
5. BRACE WALLS WHICH DO NOT EXTEND FULL HEIGHT TO STRUCTURE FOR ALL WALL LENGTHS GREATER THAN 8' BETWEEN CORNERS. BRACE WITH 45° STUD TO STRUCTURE AT 8'-0" ON CENTER MAX.
6. FIRE ENDURANCES FOR CMU ASSEMBLIES HAVE BEEN DESIGNED PER CALCULATIONS INDENTIFIED IN "ANALYTICAL METHODS OF DETERMINING FIRE ENDURANCE OF CONCRETE AND MASONRY – MODEL CODE APPROVED PROCEDURES" AS PUBLISHED BY THE CONCRETE AND MASONRY INDUSTRY FIRESAFETY COMMITTEE. BY CALCULATION, ALL ASSEMBLIES MEET OR EXCEED THE REQUIREMENT. SOLID GROUT WALLS AS REQUIRED TO PROVIDE AN EQUIVALENT THICKNESS OF NOT LESS THAN 2.8" THICKNESS FOR 1 HOUR PROTECTION.

PARTITION KEY:

- (S#) INTERIOR STUD PARTITION
- (C#) CHASE WALL SYSTEM
- (F#) FURRED WALL SYSTEM
- (M#) INTERIOR MASONRY PARTITION
- (W#) EXTERIOR WALL SYSTEM
- (R#) ROOF SYSTEM

AS BUILT Owner Copy

SYMBOL LEGEND

- A00 / AE000 — BUILDING SECTION
- A00 / AE000 — SECTION
- A00 / AE000 — DETAIL
- A00 / AE000 — EXTERIOR ELEVATION
- X — INTERIOR ELEVATION
- LEVEL LINE
- 8 — CIRCLE NOTE
- 8 — WINDOW TAG
- 8 — PARTITION TAG
- 402 — DOOR TAG
- MAIN LOBBY / A402 — ROOM NAME / ROOM NUMBER
- A — COLUMN BUBBLE AND CENTER LINE

GRID NO.	TITLE
SCALE	REFERENCE SHEET

1 HOUR FIRE RATED WALL
1 HOUR SMOKE BARRIER
LATERAL BRACING, RE: STRUCTURAL

A5	PARTITION, EXTERIOR WALL, & ROOF ASSEMBLY LEGEND
N.T.S.	

SMRT
ARCHITECTURE ENGINEERING PLANNING
SMRT
144 Fore Street / P.O. Box 618
Portland, Maine 04104
tel. (207) 772-3846
fax. (207) 772-1070

STATE OF MAINE SCOTT L BENSON No. 1772 REGISTERED PROFESSIONAL ARCHITECT

PROJECT TITLE: MAINE TURNPIKE AUTHORITY ADMINISTRATION BUILDING PORTLAND, MAINE


CURRENT ISSUE STATUS: ISSUED FOR BIDDING/CONSTRUCTION 7-9-07

NO.	DESCRIPTION	DATE
0	BIDDING/CONSTRUCTION	7-9-07


GRAPHIC SCALE: 0" 1"

SCALE:	AS NOTED
PROJECT MANAGER:	SLB
JIC/DRAWN BY:	TCM/TCM
A/E OF RECORD:	SLB
CAD FILE:	GI002-06016
PROJECT NO:	06016
DATE:	7-9-07
SHEET TITLE:	GENERAL INFORMATION
SHEET No.	GI002


© COPYRIGHT 2007 SMRT INC.

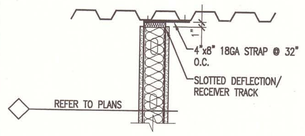


GYPSUM WALL (NON-RATED)
(PARALLEL TO DECK FLUTES)

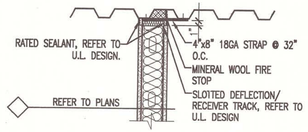


GYPSUM WALL (RATED)
(PARALLEL TO DECK FLUTES)
U.L. DESIGN-HW-D-0027
(1 HOUR, REFER TO U.L. DESIGN FOR SPECIFIC REQUIREMENTS)

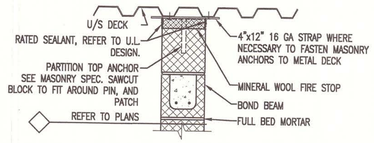


MASONRY WALL (RATED)
(PARALLEL TO DECK FLUTES)
U.L. DESIGN-HW-D-0098
ALTERNATE UL DESIGN HW-D-0081
(1 HOUR, REFER TO U.L. DESIGN FOR SPECIFIC REQUIREMENTS)

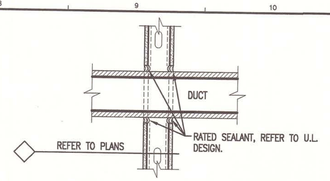


GYPSUM WALL PENETRATION (RATED)
U.L. DESIGN-W-L-7028
NOTE:
REFER TO U.L. DESIGN DESCRIPTION FOR DUCT SIZE & MATERIAL LIMITATIONS

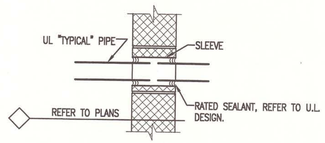

MASONRY WALL PENETRATION (RATED)
U.L. DESIGN-W-L-1479
NOTE:
REFER TO U.L. DESIGN DESCRIPTION FOR DUCT SIZE & MATERIAL LIMITATIONS

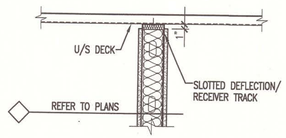


GYPSUM WALL (NON-RATED)
(PERPENDICULAR TO DECK FLUTES)

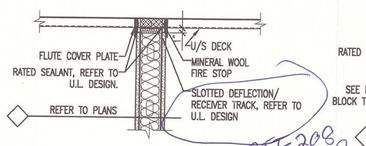


RFI-208 for Slotted Track

GYPSUM WALL (RATED)
(PERPENDICULAR TO DECK FLUTES)
U.L. DESIGN-HW-D-0027
(1 HOUR, REFER TO U.L. DESIGN FOR SPECIFIC REQUIREMENTS)

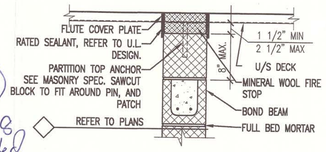

MASONRY WALL (RATED)
(PERPENDICULAR TO DECK FLUTES)
U.L. DESIGN-HW-D-0098
(1 HOUR, REFER TO U.L. DESIGN FOR SPECIFIC REQUIREMENTS)

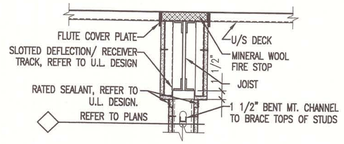


GYPSUM WALL (RATED)
(PERPENDICULAR TO DECK FLUTES)
U.L. DESIGN-HW-D-0027
(1 HOUR, REFER TO U.L. DESIGN FOR SPECIFIC REQUIREMENTS)


H5 TYPICAL TOP OF WALL AND THROUGH WALL PENETRATION DETAILS

1" = 1'-0"


Owner Toilet Accessories RFI-215

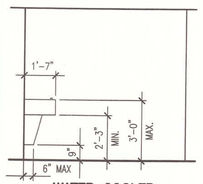


WATER COOLER

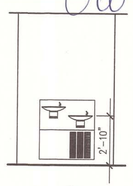


HIGH/LOW ELECTRIC WATER COOLER

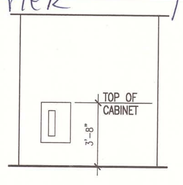


FIRE EXTINGUISHER CABINET (FEC)

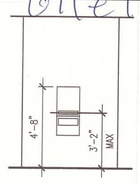


PAPER TOWEL DISPENSER/ RECEPTACLE

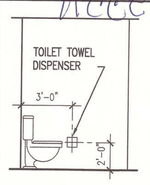


TOILET TISSUE DISPENSER

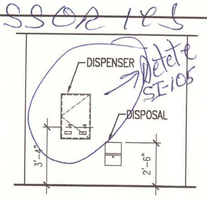


SANITARY NAPKIN DISPENSER/DISPOSAL

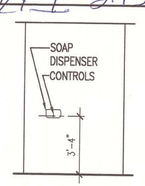


SOAP DISPENSERS

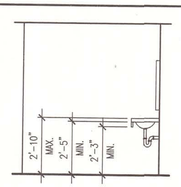


COUNTER HEIGHT

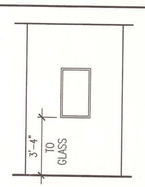


MIRROR

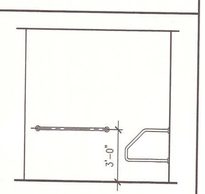


GRAB BARS

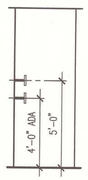


ROBE HOOKS

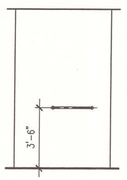

TOWEL BAR

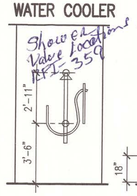


SHOWER BAR

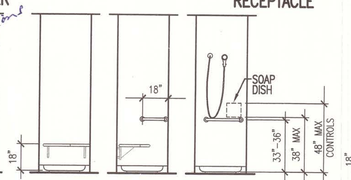


SHOWER


RFI 239 Shower Valve Locations

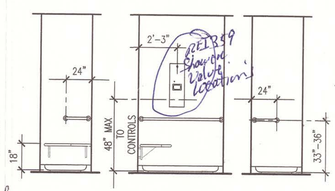


ADA SHOWER

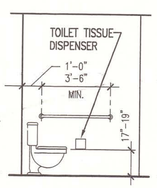


SIDE WALL GRAB BAR

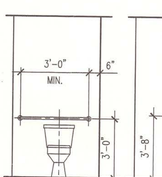


BACK WALL GRAB BAR

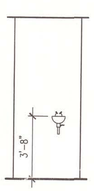


EYE WASH

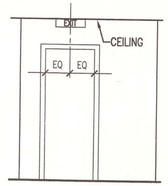


CEILING MOUNTED EXIT LIGHT

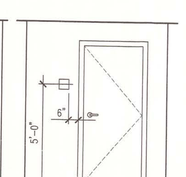

FOR ADA COMPLIANCE SIGNS

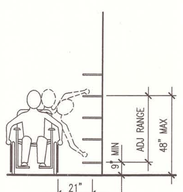


SHELVES

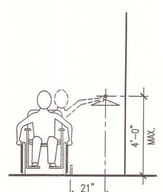


CLOSETS

RFI 42 Faucets Locations

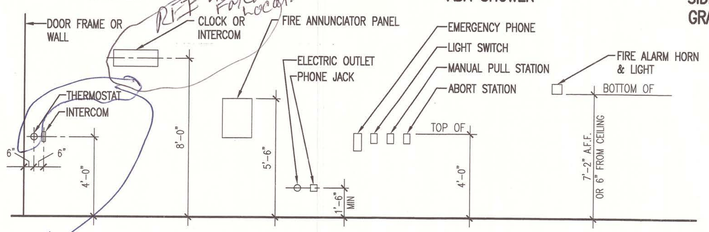


RFI 246


ELECTRICAL & FIRE PROTECTION DEVICES TYPICAL UNLESS NOTED OTHERWISE

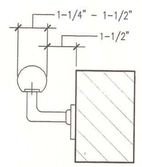

HANDRAIL

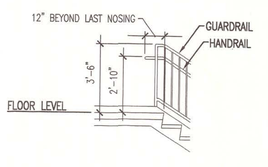

HANDRAIL EXTENSION @ TOP OF RUN WITH MOUNTING HEIGHTS FOR GUARD & HAND RAILS

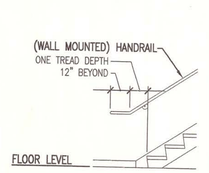

HANDRAIL EXTENSION @ BOTTOM OF RUN

A1 TYPICAL MOUNTING HEIGHTS

N.T.S.

GENERAL NOTES:

1. SEE G1001 FOR PROJECT GENERAL NOTES.

Owner, toilet Accessories see RFI-215

AS BUILT Owner Copy

SMRT
ARCHITECTURE ENGINEERING PLANNING
SMRT
144 Fore Street/P.O. Box 618
Portland, Maine 04104
tel. (207) 772-3846
fax. (207) 772-1070

STATE OF MAINE SCOTT L BENSON No. 1772 REGISTERED PROFESSIONAL ARCHITECT

PROJECT TITLE:
MAINE TURNPIKE AUTHORITY
ADMINISTRATION BUILDING
PORTLAND, MAINE

CURRENT ISSUE STATUS:
ISSUED FOR BIDDING/CONSTRUCTION
7-9-07

REV	DESCRIPTION	DATE
0	BIDDING/CONSTRUCTION	7-9-07


GRAPHIC SCALE: 0" 1"

SCALE:	AS NOTED
PROJECT MANAGER:	SLB
JC/DRAWN BY:	TCM/TCM
A/E OF RECORD:	SLB
CAD FILE:	G1003-06016
PROJECT NO:	06016
DATE:	7-9-07

SHEET TITLE:
GENERAL INFORMATION

SHEET No.
G1003

©COPYRIGHT 2007 SMRT INC

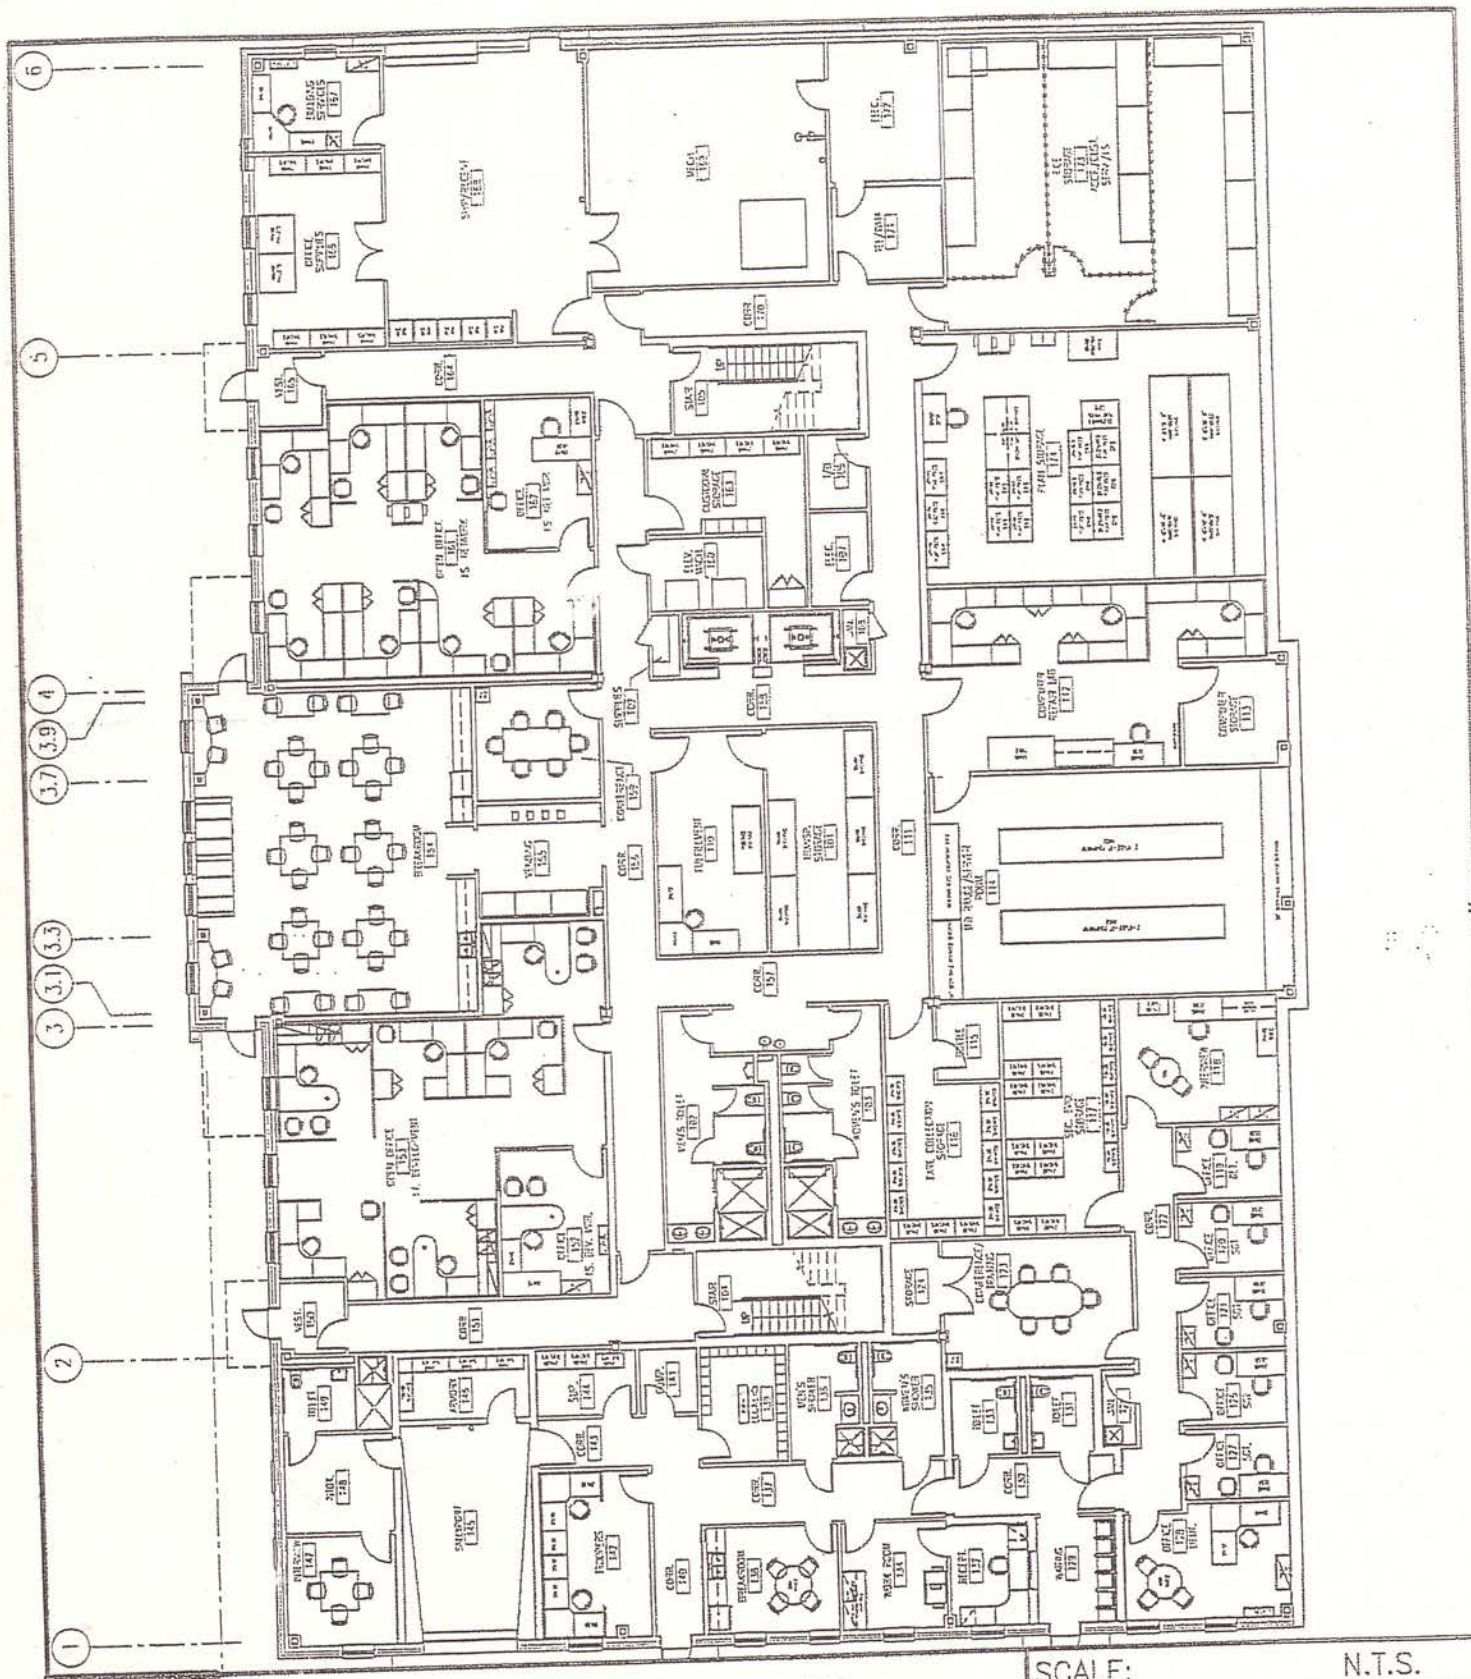

SM

ARCHITECTURE ENGINEERING PLANNING

SMRT
144 Fore Street/P.O.Box 618 PORTLAND, MAINE 04104
tel. (207) 772-3846 / fax. (207) 772-1070

MAINE TURNPIKE AUTHORITY
ADMINISTRATION BUILDING
FIRST FLOOR FURNITURE PLAN
FOR REFERENCE ONLY

SCALE:	N.T.S.
CAD FILE:	IF101-06016
PROJECT No.	06016
REF. SHEET:	IF101
PM:	SLB
A/E:	SLB
DATE:	8-10-07

ADDENDUM No. ADD-4

SKETCH No. A-11

© COPYRIGHT 2007 SMRT INC.

DEMO NOTES:

1. ALL PRE-EXISTING STRUCTURES WITHIN THE PROPOSED BUILDING FOOTPRINT, UNDER AREAS PROPOSED FOR PAVING, AND ALONG PROPOSED UTILITY ROUTES ARE TO BE COMPLETELY REMOVED AND REPLACED WITH COMPACTED STRUCTURAL FILL.
2. STRUCTURES IN THE DEVELOPED AREA TO BE LANDSCAPED ARE TO BE REMOVED TO A DEPTH OF 24" MIN (OR AS DIRECTED) BELOW PROPOSED FINISHED GRADE AND BACKFILLED WITH APPROVED FILL.
6. ALL CONFLICTING ITEMS WITHIN THE DEVELOPMENT AREA NOT OTHERWISE NOTED SHALL BE REMOVED.

LAYOUT NOTES:

1. DO NOT SCALE THE DRAWINGS. ALL DIMENSIONS SHALL BE VERIFIED IN THE FIELD BY THE CONTRACTOR PRIOR TO CONSTRUCTION. ANY OMISSIONS IN DIMENSIONING SHALL BE REPORTED IMMEDIATELY TO THE ARCHITECT FOR DECISION. ANY DISCREPANCIES BETWEEN DRAWINGS, DETAILS, NOTES, AND SPECIFICATIONS SHALL IMMEDIATELY BE REPORTED TO THE ARCHITECT FOR FURTHER DIRECTION AND RESOLUTION BEFORE ANY ADDITIONAL WORK PROCEEDS.
2. ALL ANGLES ARE 90 DEGREES UNLESS OTHERWISE NOTED.
3. ALL PAVING, CURBS, AND STRUCTURES SHALL BE STAKED OUT BY THE CONTRACTOR AND REVIEWED BY THE ARCHITECT PRIOR TO CONSTRUCTION.
4. ALL DIMENSIONS FROM BUILDING ARE TO FACE OF BUILDING FOUNDATION. ALL DIMENSIONS FROM CURBS ARE TO FACE OF CURB.
5. PROVIDE A SMOOTH TRANSITION WHERE NEW WORK MEETS EXISTING WORK.
6. CONTRACTOR SHALL NOTIFY DIG-SAFE (1-888-344-7233) AND LOCAL UTILITY COMPANIES TO VERIFY LOCATION OF ALL EXISTING UTILITIES PRIOR TO EXCAVATION.
7. CONTRACTOR SHALL SECURE ALL NECESSARY PERMITS FOR WORK SHOWN ON THESE PLANS.
8. ALL WORK SHALL COMPLY WITH ALL LOCAL, STATE, AND FEDERAL SAFETY REGULATIONS AND MEET OR EXCEED CITY OF PORTLAND STANDARDS.
9. PROVIDE TAPERED END SECTIONS (2' MIN.) AT ALL CURB ENDS.
10. EXISTING CONDITIONS AND TOPOGRAPHIC DATA ARE BASED UPON PRELIMINARY TOPOGRAPHIC SURVEY BY HNTB, WESTBROOK, MAINE.

GRADING NOTES:

1. SOIL DISTURBANCE IS TO BE KEPT TO A MINIMUM AND ALL DISTURBED AREAS SHALL BE STABILIZED (WITH PERMANENT OR TEMPORARY MEASURES) AS QUICKLY AS POSSIBLE.
2. ALL DISTURBED AREAS NOT OTHERWISE TREATED SHALL BE LOAMED AND SEEDED (6" DEPTH).
3. ALL EROSION AND SEDIMENTATION CONTROL MEASURES SHALL BE MAINTAINED ON A REGULAR BASIS AND AS REQUIRED AFTER STORM EVENTS. SEE SPECIFICATIONS FOR DETAILS.
4. GULLIES OR OTHERWISE ERODED AREAS IN SEEDED AREAS SHALL BE RESTORED AS SOON AS POSSIBLE FOLLOWING OBSERVATION, USING EROSION CONTROL MESH TO STABILIZE AS REQUIRED.

UTILITY NOTES:

1. PROVIDE AND INSTALL MATERIALS NECESSARY TO COMPLETE UTILITY FEATURES AND DESIGN UNLESS OTHERWISE INDICATED.
2. ALL WORK SHALL MEET OR EXCEED STANDARDS OF THE CITY OF PORTLAND.
3. COORDINATE EXACT UTILITY SERVICE ENTRANCE/ EXIT LOCATION WITH MECHANICAL DRAWINGS.
4. UTILITY LOCATIONS SHOWN ARE APPROXIMATE AND SHALL BE VERIFIED BY CONTRACTOR PRIOR TO CONSTRUCTION.
5. CONTRACTOR SHALL NOTIFY DIG-SAFE (1-888-344-7233) AND LOCAL UTILITY COMPANIES TO VERIFY LOCATION OF ALL EXISTING UTILITIES PRIOR TO EXCAVATION.
6. ALL EXISTING UTILITY LOCATIONS SHOWN ARE APPROXIMATE AND HAVE BEEN DETERMINED BY SURFACE EVIDENCE AND/OR PREVIOUSLY GENERATED PLANS. NO GUARANTEE IS MADE THAT ALL UTILITIES ARE SHOWN OR WILL BE FOUND IN LOCATIONS INDICATED. THIS INFORMATION IS PROVIDED FOR REFERENCE AND THE CONTRACTOR SHALL VERIFY LOCATION OF ALL UTILITIES AND POINTS OF CONNECTION IN THE FIELD. CONTRACTOR SHALL BE RESPONSIBLE FOR REPAIR AND RESTORATION OF ALL UTILITIES DISTURBED DURING CONSTRUCTION.

LANDSCAPING NOTES:

1. THE LANDSCAPE CONTRACTOR SHALL SUPPLY AND INSTALL ALL PLANTS IN SUFFICIENT QUANTITIES TO COMPLETE THE WORK AS SHOWN ON THE DRAWINGS. DISCREPANCIES BETWEEN QUANTITIES SHOWN ON THE DRAWINGS AND THE PLANT LIST SHALL BE REPORTED IMMEDIATELY TO THE ARCHITECT AND SHALL NOT ENTITLE THE CONTRACTOR TO ADDITIONAL REMUNERATION.
2. THE LANDSCAPE CONTRACTOR IS ADVISED THAT BELOW GROUND UTILITIES EXIST ON SITE, THE LOCATIONS OF WHICH SHALL BE VERIFIED BY THE CONTRACTOR PRIOR TO COMMENCEMENT OF OPERATIONS. SHOULD THE LOCATION OF ANY PROPOSED PLANTING CONFLICT WITH ANY UTILITY, THE ARCHITECT SHALL BE NOTIFIED IMMEDIATELY FOR DECISION.
3. ANY AND ALL PAVING, CURBING, UTILITIES, LAWNS, ETC., DAMAGED AS A RESULT OF THE LANDSCAPE CONTRACTOR'S OPERATIONS SHALL BE REPLACED OR REPAIRED BY THE CONTRACTOR AT NO ADDITIONAL COST TO THE OWNER.
4. ALL PLANTING BEDS INCLUDING TREE AND SHRUB PITS AS INDICATED SHALL RECEIVE 3" APPROVED CLEAN, UNIFORMLY GROUND OR SHREDDED PINE OR HEMLOCK BARK MULCH.
5. LOCATIONS OF PROPOSED PLANTINGS AND BED LINES SHALL BE REVIEWED BY THE ARCHITECT PRIOR TO INSTALLATION.
6. THE LANDSCAPE CONTRACTOR SHALL RELOCATE ANY PLANT ACCORDING TO THE DIRECTION OF THE ARCHITECT.
7. ALL PLANT MATERIALS CALLED FOR AND INSTALLED SHALL MEET OR EXCEED SPECIFICATIONS OF THE "AMERICAN STANDARDS FOR NURSERY STOCK" (LATEST EDITION) AS SET FORTH BY THE AMERICAN ASSOCIATION OF NURSERYMEN.
8. ALL PLANTING BEDS SHALL BE DEFINED BY A NEAT, SHOVEL-CUT BED LINE. BED LINES SHALL BE TRUE TO FORM AS SHOWN ON THE DRAWINGS, CONSISTING OF SMOOTH CURVES AND SHARP LINES AND CORNERS.
9. IF, BECAUSE OF CULTURE REQUIREMENTS, AVAILABILITY, OR OTHER CIRCUMSTANCES, THE LANDSCAPE CONTRACTOR BELIEVES A PARTICULAR PLANT CALLED FOR IS INAPPROPRIATE, THE LANDSCAPE CONTRACTOR SHALL REPORT THE SITUATION IMMEDIATELY TO THE ARCHITECT FOR DECISION.
10. ALL DISTURBED AREAS NOT OTHERWISE COVERED SHALL RECEIVE 6" LOAM AND SEED.

SITE ABBREVIATION:

AGG = AGGREGATE
ALT = ALTERNATE
ARCH = ARCHITECTURAL
APROX = APPROXIMATE
BC = BOTTOM OF CURB ELEVATION
BIT = BITUMINOUS
BS = TOP OF STEP ELEVATION
CIP = CAST-IN-PLACE
CL = CENTER LINE
CLR = CLEAR
CLL = CONTRACT LIMITS LINE
CONT = CONTINUOUS
D = DIAMETER
ELEC = ELECTRICAL
EOP = EDGE OF PAVEMENT
EXT = EXTERIOR
FFE = FINISHED FLOOR ELEVATION
GA = GAUGE
GV = GATE VALVE
HC = HANDICAP
HP = HIGH POINT ELEVATION
I = INCLUDED ANGLE
ID = INSIDE DIAMETER
L = LENGTH
LF = LEFT
MECH = MECHANICAL
MFR = MANUFACTURER
MISC = MISCELLANEOUS
NCB = NEW CATCH BASIN
NDMH = NEW DRAIN MANHOLE
NFM = NEW FORCE MAIN
NOE = NEW OVERHEAD ELECTRIC
NOT= NEW UNDERGROUND TELECOM
NSD = NEW STORM DRAIN LINE
NSS = NEW SANITARY SEWER LINE
NTS = NOT TO SCALE
NUD = NEW UNDERDRAIN
NUE = NEW UNDERGROUND ELETRIC
NUT = NEW UNDERGROUND TELECOM
NW = NEW WATER LINE
OC = ON CENTER
PL = PROPERTY LINE
PVMT = PAVEMENT
R = RADIUS
ROW = RIGHT-OF-WAY
RT = RIGHT
S = SLOPE
SHT = SHEET
STA. = STATION
STRUCT = STRUCTURAL
TP = TEST PIT
TC = TOP OF CURB ELEVATION
TS = TOP OF STEP ELEVATION
W/ = WITH
W/O = WITHOUT

SITE DATA

ZONE: IM, MODERATE IMPACT INDUSTRIAL ZONE
FAA RPZ, RUNWAY PROTECTION ZONE
USE: OFFICE BUILDING, PERMITTED USE
PARCEL SIZE: 6.78 AC. PARCEL ID#: 233-A004-001
233-A008-001

SPACE STANDARDS	REQUIRED	PROPOSED
MINIMUM LOT SIZE	NONE	6.78 AC.
MINIMUM STREET FRONTAGE	60 FEET	204.06'
MAXIMUM BUILDING HEIGHT	75 FEET	48'
MINIMUM FRONT YARD	48'	353'
MINIMUM REAR & SIDE YARDS	25'	141'+
PAVEMENT SETBACK	10'	25'+
BUILDING AREA	---	54,817 SF
PARKING SPACES	138	192
IMPERVIOUS SURFACE	75% MAX	47%

CIVIL LEGEND:

PROPOSED ITEM	SYMBOL:
EDGE OF BUILDING W/DOOR	
CHAINLINK FENCE	X
BITUMINOUS DRIVE	
GRAVEL DRIVE	
BITUMINOUS WALK	
GRANITE CURB (VERTICAL)	
CONCRETE (C.I.P.)	
GRANITE CURB (SLOPED)	
WETLAND BOUNDARY	
RIP RAP INLET/OUTLET	
BOLLARD LIGHT	
LIGHT POLES	
FIRE HYDRANT	
CONC. BOLLARD	
STORM DRAIN PIPE (W/ SIZE)	6" NSD
UNDER DRAIN (W/ SIZE)	4" NUD
WATER PIPE (W/ SIZE)	4" NW
UNDERGROUND ELEC. & COMM.	NUE/C
FORCE MAIN PIPE (W/ SIZE)	4" NFM
OVERHEAD ELECTRIC	NOE
OVERHEAD COMMUNICATIONS	NOC
UNDERGROUND ELECTRIC	NUE
UNDERGROUND COMMUNICATIONS	NUC
SEWER PIPE (W/ SIZE)	4" NSS
CATCH BASIN	NCB
DRAIN INLET	NDI
SANITARY MANHOLE	NSMH
DRAIN MANHOLE	NDMH
ORNAMENTAL FENCE	
CHAINLINK SECURITY FENCE	
UTILITY POLE	∅ NUP
WATER GATE	⋈ GV
PROPERTY LINE	
EASEMENT, RIGHT-OF-WAY, SETBACK	
BOTTOM OF STEP ELEV.	+BS
TOP OF STEP ELEV.	+TS
TOP OF CURB ELEV.	+TC-OR-144.5/
BOTTOM OF CURB ELEV.	+BC-OR-/144.0
HIGH POINT ELEV.	+HP
LOW POINT ELEV.	+LP
SEDIMENT BARRIER BERM	SB
SILT FENCE	SF
SLOPE IS 1.3%	S=.013
CONTOURS	379
PLUNGE POOL	
DIRECTION OF FLOW	
STONE CHECK DAM	
EROSION CONTROL MESH	
TEST PIT W/ REFERENCE	TS TP B-3
TRAFFIC CONTROL SIGN	
STRIPING ON PAVEMENT	
DRIP STRIP	
TRANSFORMER & CONCRETE PAD	T
LIMIT OF WORK	

NOTE:
THIS LEGEND IS FOR REFERENCE ONLY AND APPLIES ONLY TO THE CIVIL DRAWINGS. NOT ALL ITEMS SHOWN HEREIN MAY APPEAR ON THE DRAWINGS, OR BE INCORPORATED IN THE DESIGN.

AS BUILT
Owner Copy

SMRT
ARCHITECTURE ENGINEERING PLANNING
SMRT
144 Fore Street/P.O. Box 618
Portland, Maine 04104
tel. (207) 772-3846
fax. (207) 772-1070

LICENSED LANDSCAPE ARCHITECT
MARK G. JOHNSON
NO. 1857
STATE OF MAINE
7/9/07

PROJECT TITLE:
MAINE TURNPIKE AUTHORITY
ADMINISTRATION BUILDING
PORTLAND, MAINE

ISSUED FOR BIDDING/CONSTRUCTION
7-9-07

REV	DESCRIPTION	DATE
0	BIDDING/CONSTRUCTION	7-9-07


GRAPHIC SCALE: 0" 1"


SCALE:	SHOWN
PROJECT MANAGER:	SLB
JC/DRAWN BY:	TCM/PAF
A/E OF RECORD:	MGJ
CAD FILE:	06016-C001
PROJECT NO:	06016
DATE:	7-9-07

SHEET TITLE:
NOTES AND LEGEND

SHEET No.
C001

© COPYRIGHT 2007 SMRT INC.

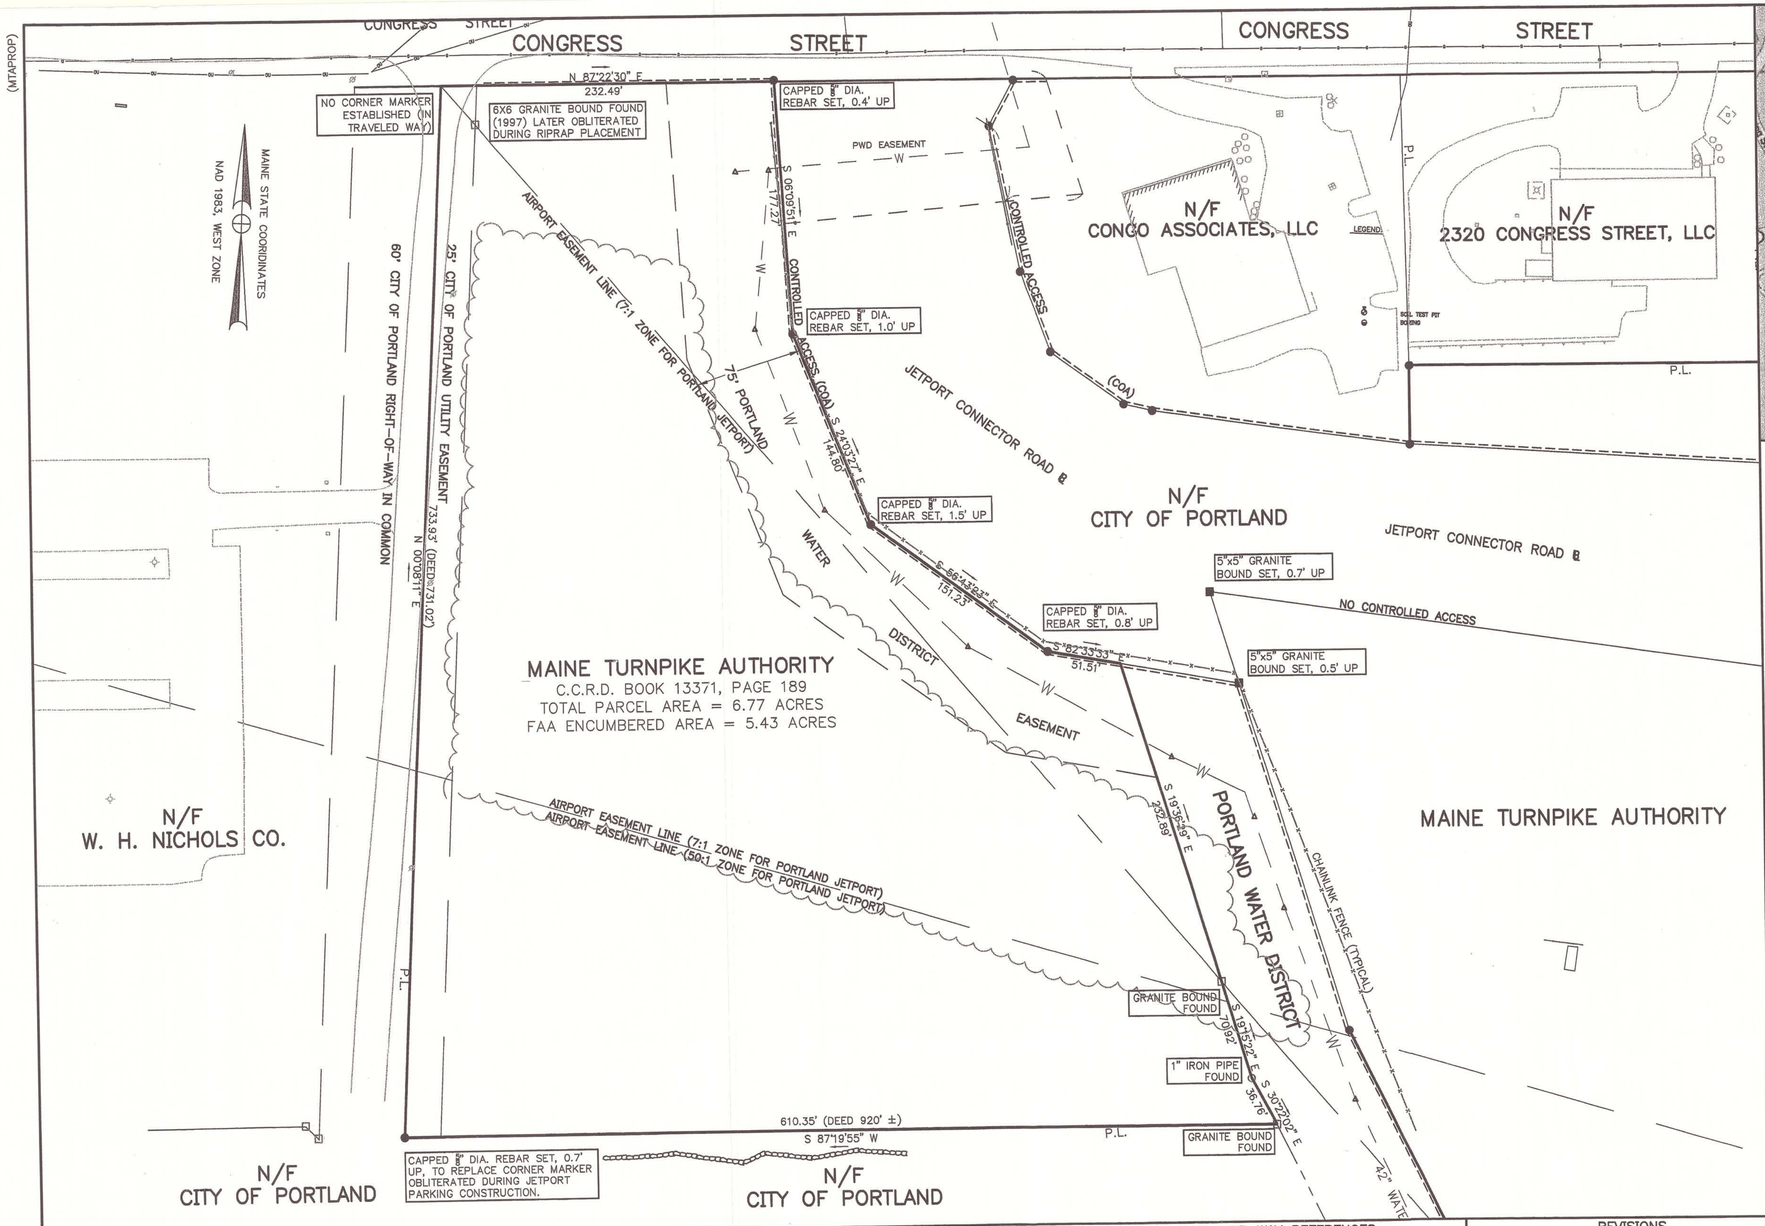

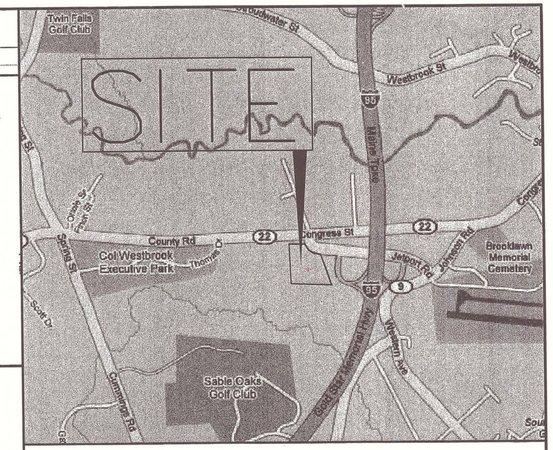

NOTES:

SEE ALSO THE PROPERTY AND RIGHT-OF-WAY REFERENCES BELOW.

1. DEED FROM W. H. NICHOLS COMPANY TO PORTLAND WATER DISTRICT DATED APRIL 4, 1967 AND RECORDED IN THE C.C.R.D BOOK 2990, PAGE 627.
2. DEED FROM HARRY A. HARMON AND GEORGE M. HUTCHINS TO PORTLAND WATER DISTRICT DATED 1979 AND RECORDED IN THE C.C.R.D BOOK 4514, PAGE 130.
3. DEED FROM PORTLAND WATER DISTRICT TO THE CITY OF PORTLAND DATED JULY 17, 2002 AND RECORDED IN THE C.C.R.D BOOK 17855, PAGE 214.

PLAN REFERENCE:

1. PLAN OF FAR PART 77 ANALYSIS OF PRECISION APPROACH TO RUNWAY 11 FOR PORTLAND INTERNATIONAL JETPORT BY DUFRESNE-HENRY DATED JUNE 2004.
2. PLAN OF STANDARD BOUNDARY SURVEY FOR THE CITY OF PORTLAND (PORTLAND INTERNATIONAL JETPORT) BY DUFRESNE-HENRY DATED OCTOBER 30, 1997.
3. PLAN OF JETPORT INTERCHANGE PROJECT, PROPERTY AND RIGHT-OF-WAY PLAN FOR THE MAINE TURNPIKE AUTHORITY BY HNTB CORPORATION SHEETS 1 & 4 OF 11, SUPPLEMENTAL SHEETS DATED FEBRUARY 1997.
4. PLAN OF PROPOSED UTILITY AND ACCESS EASEMENT DATED JULY 12, 1979.

AS BUILT
Owner Copy

LEGEND

NEW R/W	EXISTING RIGHT OF WAY	MONUMENTATION
UT UT UNDERGROUND WIRE OR CABLE	W W WATER LINE or MAIN	O I.P.F. (IRON PIPE or PIN) FOUND
CONSTRUCTION LIMIT LINE — LIMIT OF HIGHWAY EASEMENT	S S SEWER LINE	□ S.B.F. (STONE/CONCRETE BOUND) FOUND
GRADING LIMITS — GRADING RIGHTS (TOE OF SLOPE)	P.L. PROPERTY LINE	● I.P. (IRON PIPE or PIN) TO BE SET
		■ S.B. (STONE/CONCRETE BOUND) TO BE SET

RECORDING

CUMBERLAND,ss Registry of Deeds

Received _____

At _____h _____m _____M

Filed _____

Attest _____

_____Registrar

CONTROLLED ACCESS LIMIT (COA)

CONTROLLED ACCESS LIMIT LINE ALONG R/W LINE — R/W LINE

CONTROLLED ACCESS LIMIT LINE NOT ON R/W LINE

NOTE:
NO ACCESS WILL BE PERMITTED TO OR FROM THE MAINE TURNPIKE AND ADJOINING PROPERTIES WITHIN BOUNDARIES DEFINED BY CONTROLLED ACCESS LIMIT LINES.

PROPERTY AND RIGHT-OF-WAY REFERENCES

GRANTOR	COUNTY RECORD			
	INSTRUMENT	DATE	BOOK	PAGE
S. B. HOLDINGS	QUITCLAIM DEED	10/10/97	13371	189
PORTLAND WATER DISTRICT	QUITCLAIM DEED	1/19/99	14481	191
PORTLAND WATER DISTRICT	EASEMENT	12/3/98	14359	320
C & A PROPERTIES	QUITCLAIM DEED	9/21/99	15057	16
MAINE TURNPIKE AUTHORITY	QUITCLAIM DEED	9/21/99	15057	10
GEORGE M. HUTCHINS	NOTICE OF L&T	3/31/97	13008	18

MATCH WITH ROW04

REVISIONS

NO.	DESCRIPTION	BY	DATE
1	UPDATED REFERENCES, NOTES, ETC.	PPD	1/10/07

MTA CONTRACT NO.: 2007.XX

DATE: FEBRUARY 1997

50 0 50 100 150

SCALE: 1" = 50'

SHEET NO.: 1 OF 1 DRAWING NO.: SUPPLEMENTAL 105

E-ZPass

	By	Date
Designed:	DOH	12/96
Drawn:	PPD	2/97
Checked:	PPD	3/97
In Charge Of:	RAL	

STATE OF MAINE PAUL P. DANFORTH 2278 REGISTERED PROFESSIONAL LAND SURVEYOR

MAINE TURNPIKE AUTHORITY

MAINE TURNPIKE

PROPERTY AND RIGHT-OF-WAY PLAN

SECTION 1 – KITTERY TO PORTLAND

ADMINISTRATION BUILDING


2360 CONGRESS STREET, CITY OF PORTLAND, CUMBERLAND COUNTY, MAINE

RECOMMENDED BY: HNTB ARCHITECTS ENGINEERS PLANNERS

ROLAND A. LAVALLEE PROJECT MANAGER

APPROVED BY: MAINE TURNPIKE AUTHORITY

PAUL E. VIOLETTE EXECUTIVE DIRECTOR

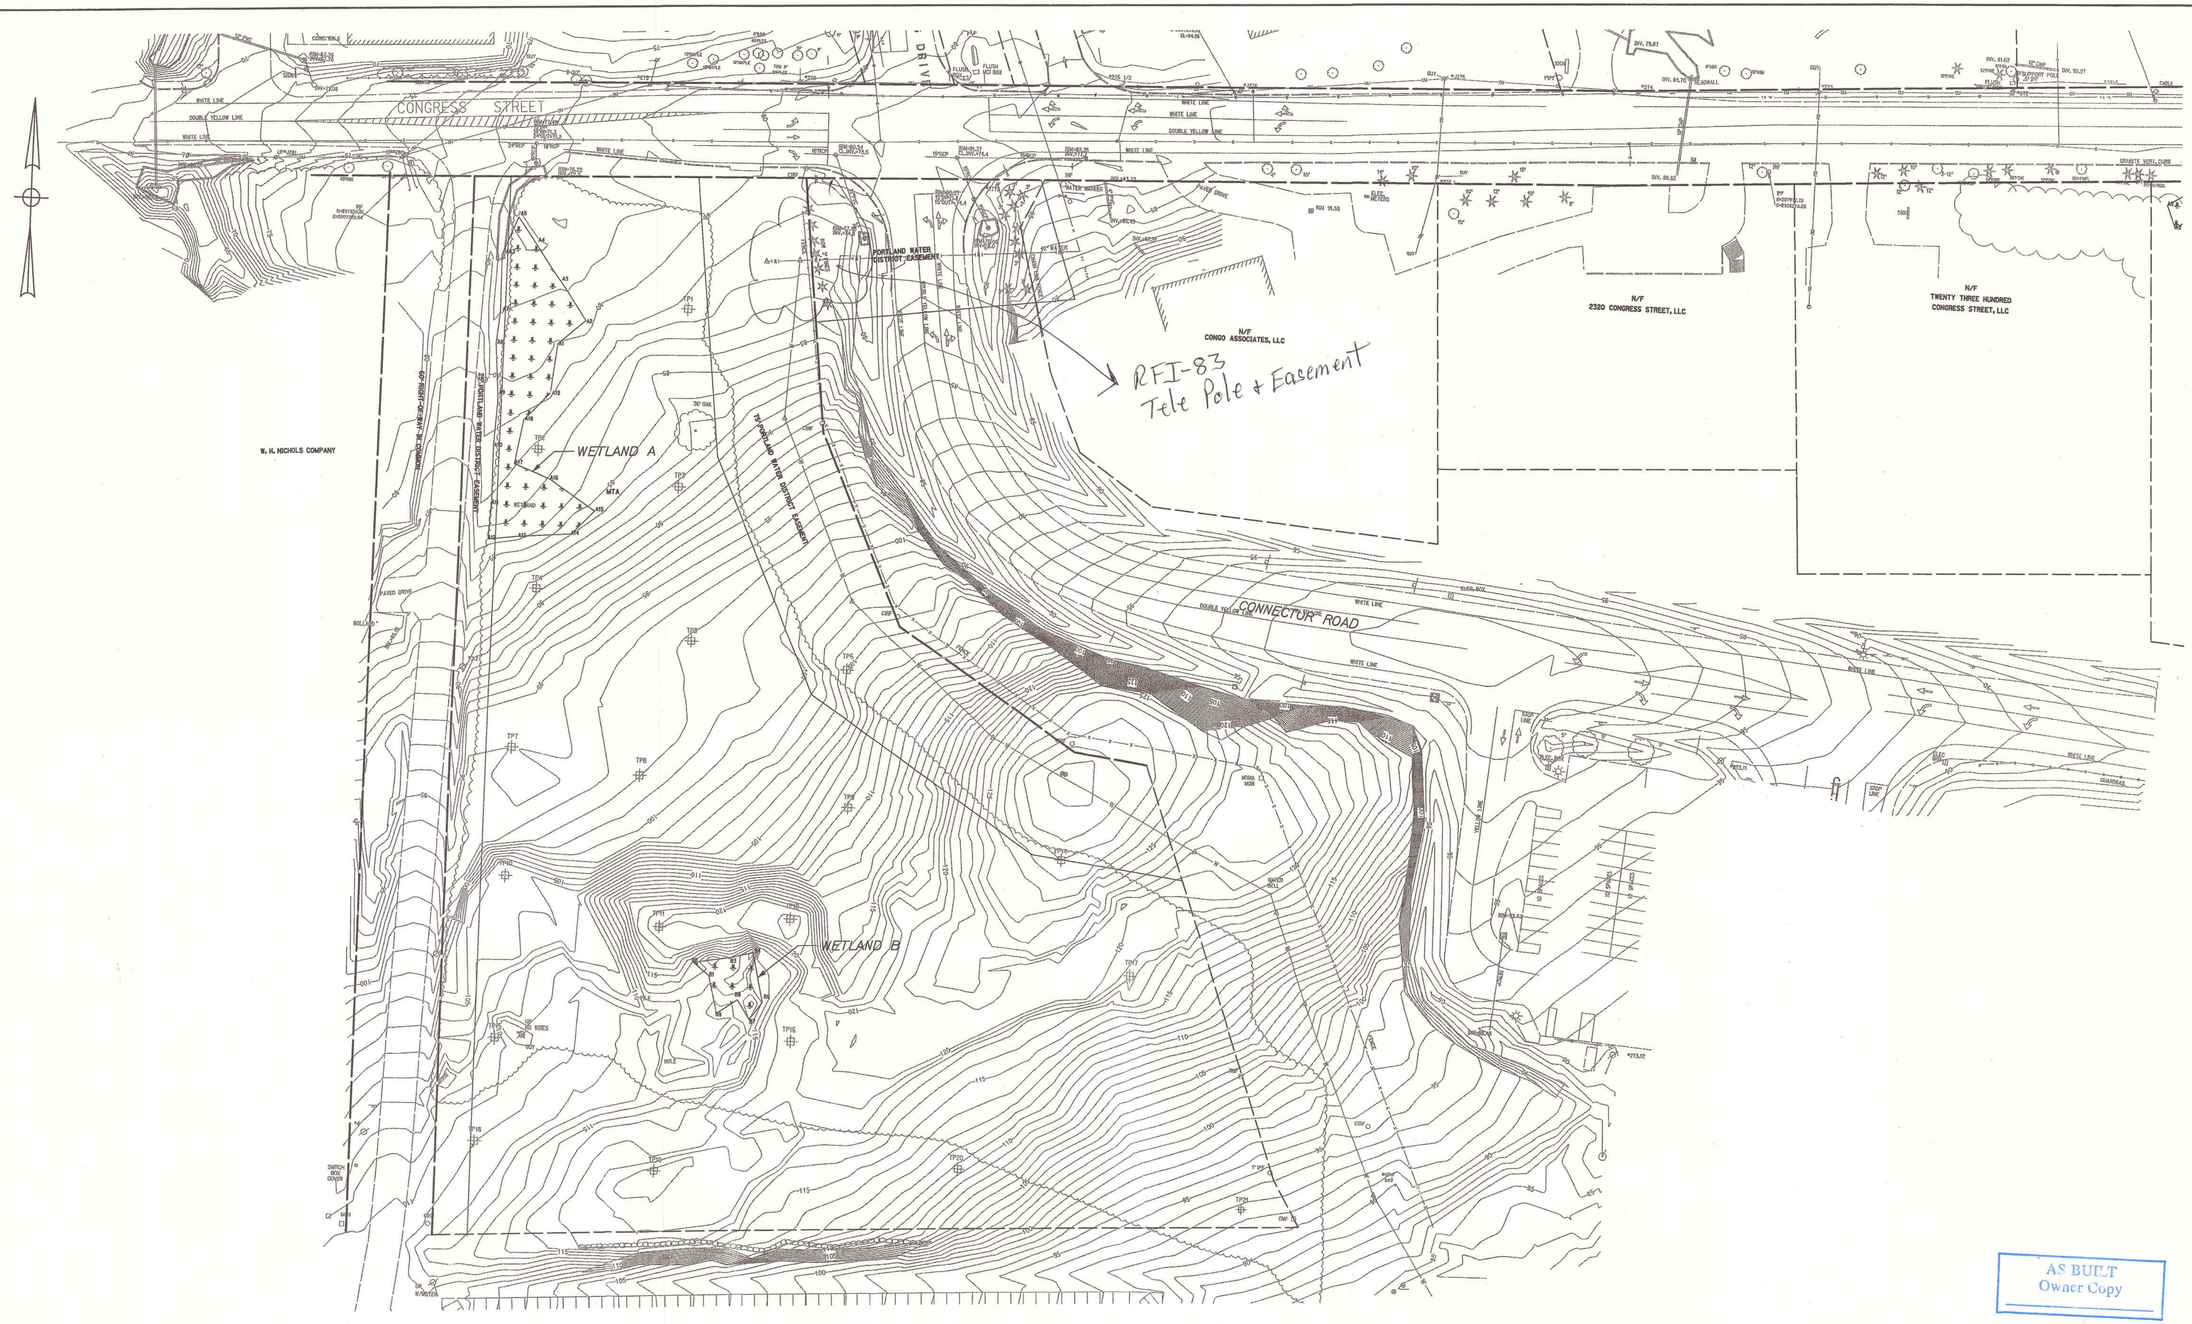

AS BUILT
Owner Copy

Scale: 50 0 50 00
SCALE

No.	Revision	By	Date

Designed by: HNTB

	By	Date		By	Date
Designed	WRF	01/07	Checked	GAB	01/07
Drawn	MPC	01/07	In Charge of	RAL	01/07

PE Stamp: STATE OF MAINE — ROLAND A. LAVALLEE No. 6452 — LICENSED PROFESSIONAL ENGINEER

HNTB
2 Thomas Drive
Westbrook, ME 04092
TEL (207) 774-5155
FAX (207) 772-7410


MAINE TURNPIKE
THE GOLD STAR MEMORIAL HIGHWAY

TURNPIKE HEADQUARTERS

EXISTING CONDITIONS PLAN

CONTRACT: 2007.07

Filename: ...\CAD\002_ExistCond.dgn
Date:1/18/2007

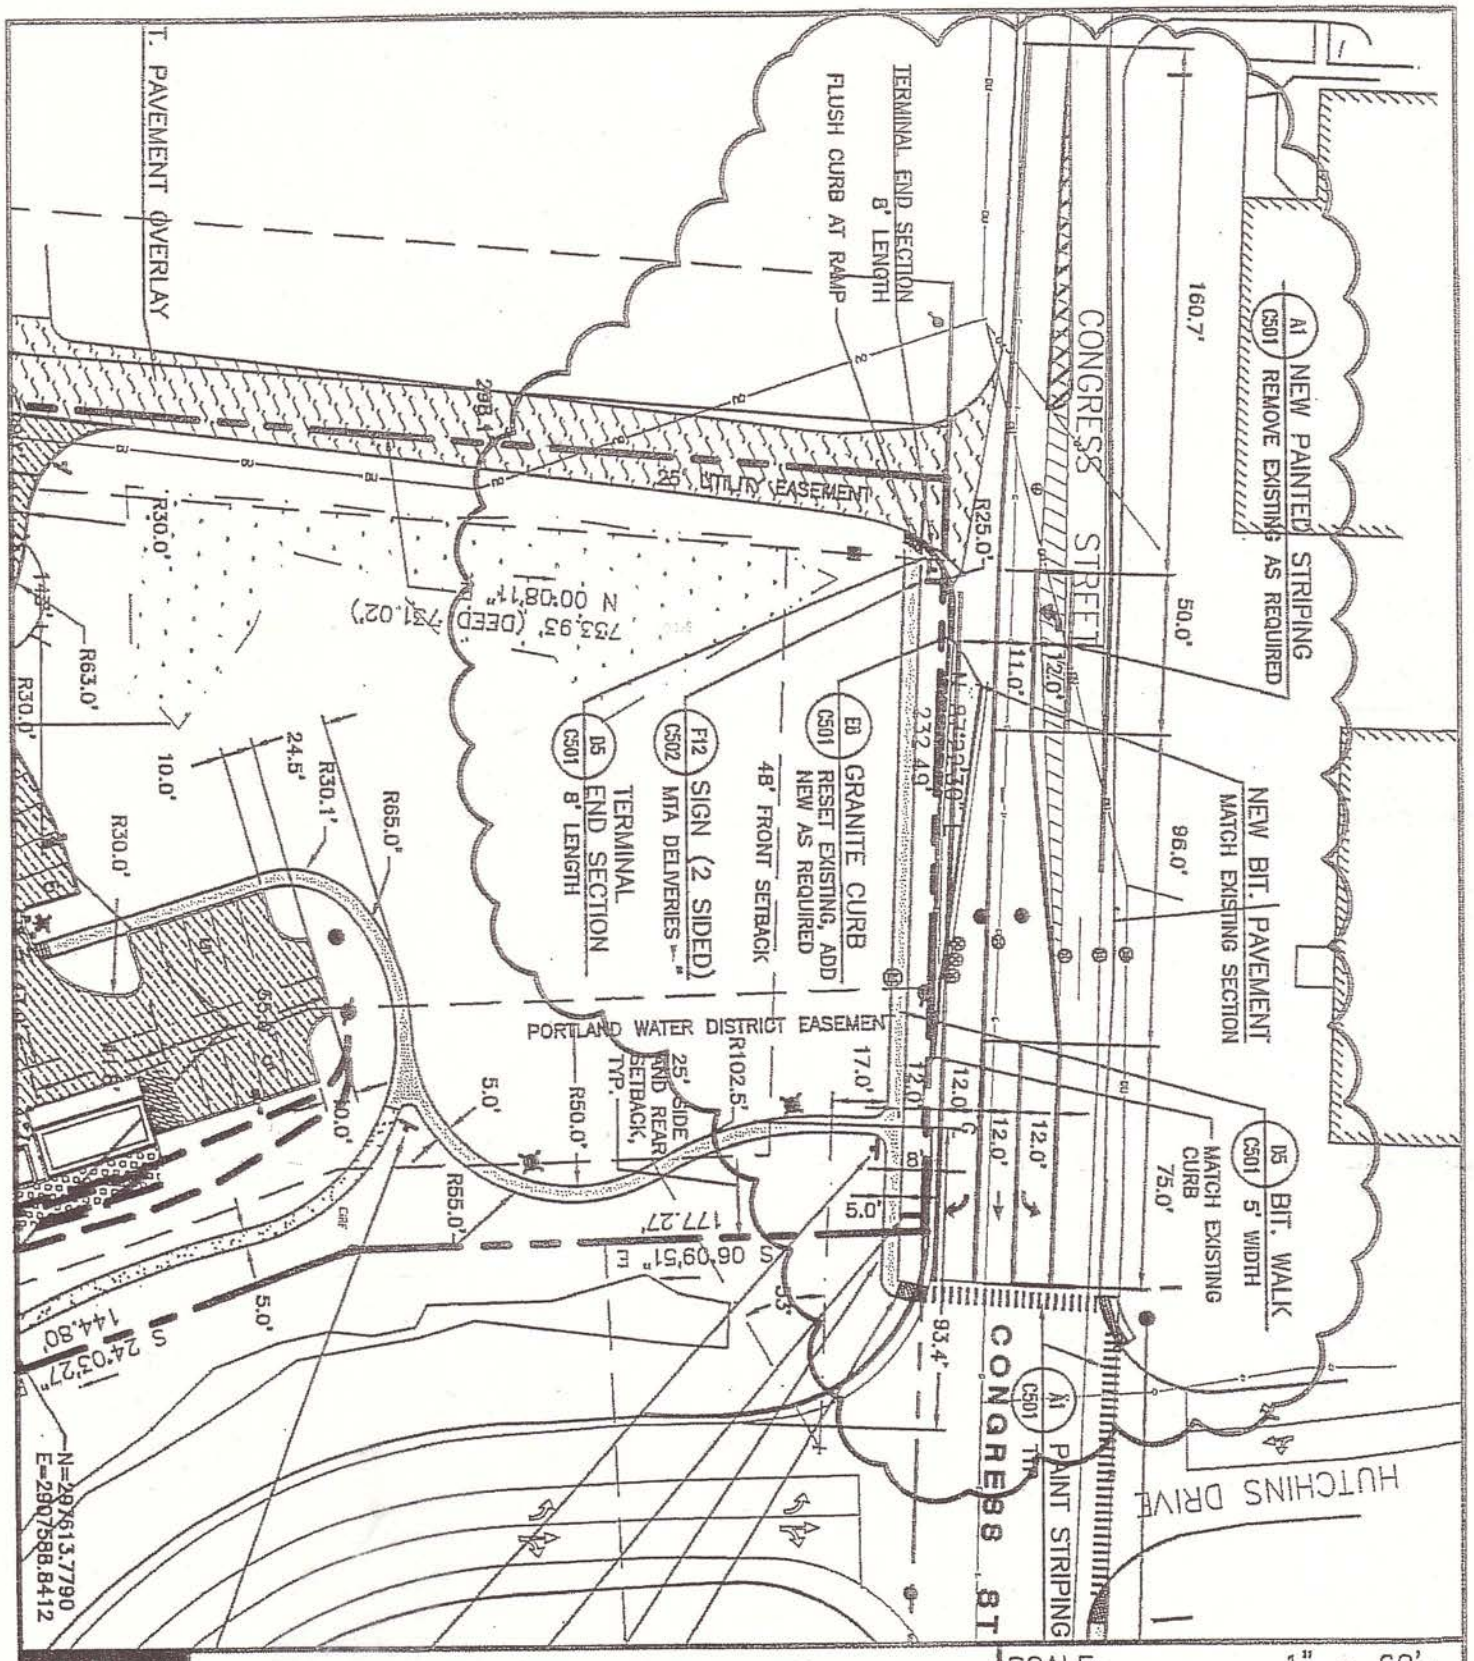

SMRT

ARCHITECTURE ENGINEERING PLANNING


SMRT
144 Fore Street/P.O.Box 618 PORTLAND, MAINE 04104
tel. (207) 772-3846 / fax. (207) 772-1070

SCALE:	1" = 60'
CAD FILE:	CP101–06016
PROJECT No.	06016
REF. SHEET:	CP101
PM: SLB	ADDENDUM No. ADD–4
A/E: MGJ	SKETCH No. C–1
DATE: 8–10–07	

PROJECT: MAINE TURNPIKE AUTHORITY ADMINISTRATION BUILDING

SUBJECT: CONGRESS STREET & DISTRICT ROAD INTERSECTION IMPROVEMENTS

© COPYRIGHT 2007 SMRT INC.

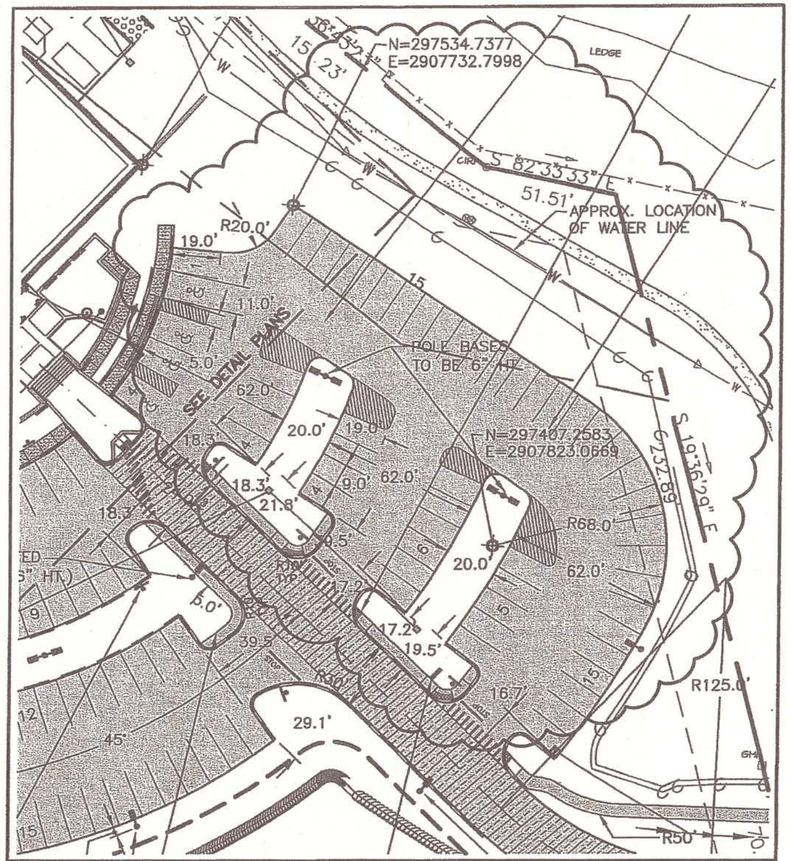

SMRT	ARCHITECTURE ENGINEERING PLANNING SMRT 144 Fore Street/P.O. Box 618 PORTLAND, MAINE 04104 tel. (207) 772-3846 / fax. (207) 772-1070	SCALE:	1" = 40'
		CAD FILE:	CP101-06016
		PROJECT No.	06016
		REF. SHEET:	CP101
PROJECT:	MAINE TURNPIKE AUTHORITY ADMINISTRATION BUILDING	PM: SLB	SUPPLEMENTAL INSTRUCTION CCD-1
SUBJECT:	PARKING LOT @ LEDGE RECONFIGURATION	A/E: MGJ	SKETCH No. C-1
		DATE: 11-30-07	© COPYRIGHT 2007 SMRT INC.

CONGRESS STREET

48' FRONT SETBACK

N 87°22'30" E 232.49'

F12 C502 SIGN (2 SIDED) MTA DELIVERIES ←"

D5 C501 BIT. WALK 5' WIDTH

F5 C502 BIT. PAVEMENT OVERLAY

25' UTILITY EASEMENT

N 00°08'11" E 733.95' (DEED 733.02')

PORTLAND WATER DISTRICT EASEMENT 17.0'

A1 C501 PAINT STRIPING TYP.

CONGRESS STREET

S 06°09'51" E 177.27'

R102.5'

25' SIDE AND REAR SETBACK, TYP.

R50.0'

R55.0'

R65.0'

R30.1'

24.5'

10.0'

5.0'

R30.0'

R63.0'

G PERP. TO EXISTING ROAD

F12 C502 SIGN (1 SIDED) "MTA DELIVERIES →"

A5 C501 HEAVY DUTY PAVING TYP.

A5 C502 SIGN "STOP" W/ STOP BAR TYP.

N=297483.2937 E=2907483.0225

A5 C502 SIGN (1 SIDED) "STATE POLICE PARKING ONLY →"

A1 C501 PAINT STRIPING NIC

A5 C502 SIGN (1 SIDED) "STATE POLICE PARKING ONLY ←"

N=297415.2674 E=2907566.9059

A5 C502 SIGN "VISITOR PARKING— STATE POLICE →"

A5 C502 SIGN "VISITOR PARKING— STATE POLICE ←"

E8 C501 GRANITE CURB TYP.

A1 C501 PAINT STRIPING NIC

LEDGE CUT, TYP.

610.35' (DEED 920' ±) S 87°19'55" W

A5 C502 SIGN "MTA VISITORS ONLY" (EA. W/ ARROW POINTING IN)

TYP. UNPROTECTED POLE BASE (3' HT.)

3' TYP. (PARKING)

TYP. PROTECTED POLE BASE (6" HT.)

PROPOSED HEADQUARTERS

DISTRICT ROAD

N=297613.7790 E=2907588.8412

F9 C502 GRAVEL TERRACE

N=297545.7527 E=2907672.7246

S 56°43'23" E 151.23'

N=297548.7170 E=2907730.2346

S 24°03'27" E 144.80'

R20.0' NUEJC

S 82°33'33" E 51.51'

N=297470.4463 E=2907872.0715

S 19°36'29" E 232.89'

R125.0'

S 19°15'22" E 70.92'

R100.0'

R50'

R83'

5.0'

18.0'

12.6'

5.0' TYP.

48.5'

36.76'

S 30°32'0

F12 C502 SIGN (1 SIDED) "MTA/EZPASS STATE POLICE DELIVERIES →"

D5 C501 BITUMINOUS WALK TYP.

POLE BASES TO BE 3' HT. POLES TO BE 20' HT.

V5 C502 SIGN "PRIVATE PATHWAY FOR MTA EMPLOYEES ONLY"

LOCATE LIGHTS 5' O.C. FROM EDGE OF DRIVES (TYP.)

POLE BASES TO BE 6" HT.

SEE DETAIL PLANS

AIRPORT CONNECTOR ROAD

UPGRADE TRAFFIC SIGNALS WITH "COUNT—DOWN" PEDESTRIAN SIGNAL HEADS FOR NEW CROSSWALKS.

D5 C501 BIT. WALK 5' WIDTH (RESET CURB FOR HC RAMPS)

CONSTRUCT A 5—FOOT WIDE SIDEWALK ALONG THE NORTH SIDE OF CONGRESS STREET, AS SHOWN ON PLAN. THE SIDEWALK SHALL BE CONSTRUCTED OF BITUMINOUS ASPHALT ACCORDING TO THE DESIGN STANDARDS ADOPTED BY THE DEPT. OF PUBLIC WORKS, AND BE COMPLETED WITHIN ONE YEAR OF THE ISSUANCE OF A CO. MTA SHALL SUBMIT A PLAN TO THE CITY ENGINEER SHOWING A RIGHT—OF—WAY SURVEY AND TOPOGRAPHIC SURVEY OF THE SIDEWALK CONSTRUCTION AREA AND THE PROPOSED SIDEWALK LOCATION FOR THE REVIEW AND APPROVAL BY THE CITY ENGINEER.

A8 C501 HC RAMPS TYP.

RELOCATE EXISTING SIGN (COORDINATE LOCATION WITH CITY)

F12 C502 SIGN (2 SIDED) "MTA OFFICES/EZPASS STATE POLICE ←"

A5 C502 SIGN "MTA STATE POLICE ↓"

A5 C502 SIGN "PRIVATE PATHWAY FOR MTA EMPLOYEES ONLY"

A1 C501 PAINT STRIPING NIC

A8 C501 HC RAMP TYP.

A5 C501 BIT. PAVING TYP.

RELOCATE EXISTING TURNPIKE SIGN

NEW LOCATION FOR EXISTING TURNPIKE SIGN

F1 C501 ENTRY SIGN 'A'

F12 C502 SIGN (1 SIDED) "PARK/RIDE→ MTA↓ EZPASS STATE POLICE"

COORDINATE SIGN AND WALL LOCATION IN FIELD W/ LANDSCAPE ARCHITECT

COORDINATE WALK ALIGNMENT IN FIELD W/ LANDSCAPE ARCHITECT

STONE DUST PATH— 6" COMPACTED ON SUBGRADE

A5 C502 SIGN "MTA STATE POLICE ↓"

A5 C501 HEAVY DUTY PAVING

A1 C501 PAINT STRIPING TYP.

K12 C501 BIT. PAVEMENT MATCH

D5 C501 BIT. WALK TYP.

LOCATE LIGHTS 5' O.C. FROM EDGE OF DRIVES (TYP.)

RFI-52 Land Survey Discrepencies

AS BUILT Owner Copy

Scale: 1"=40'

0' 20' 40' 80'

SMRT

ARCHITECTURE ENGINEERING PLANNING

SMRT
144 Fore Street / P.O. Box 618
Portland, Maine 04104
tel. (207) 772-3846
fax. (207) 772-1070

LICENSED LANDSCAPE ARCHITECT MARK G. JOHNSON NO. 1857

NORTH

PROJECT TITLE:
MAINE TURNPIKE AUTHORITY
ADMINISTRATION BUILDING
PORTLAND, MAINE

ISSUED FOR BIDDING/CONSTRUCTION
7-9-07

REV	DESCRIPTION	DATE
0	BIDDING/CONSTRUCTION	7-9-07

GRAPHIC SCALE: 0" 1"

SCALE:	SHOWN
PROJECT MANAGER:	SLB
JC/DRAWN BY:	TCM/PAF
A/E OF RECORD:	MGJ
CAD FILE:	06016-CP101
PROJECT NO:	06016
DATE:	7-9-07

SHEET TITLE:
LAYOUT PLAN

SHEET No.
CP101

© COPYRIGHT 2007 SMRT INC.

CARD READER ON POST – NIC

RFI-67 Card Reader

FLUSH CURB @ RAMPS

A8 C501 CURB RAMP TYP

PROPOSED HEADQUARTERS
FFE(1) 92.53' = 100.00 F.F.
FFE(2) 105.86'
FFE(3) 119.19'

H8 C501 CONC. WALK TYP

A1 C504 PLAN DETAIL – ENTRY PAVING

FROST SLAB, TYP.
RE: STRUCTURAL A1/S2.0
FINISH TO MATCH WALK

ALIGN CONCRETE JOINT WITH CENTERLINE OF DOOR– TYPICAL AT SIMILAR CONDITIONS

WALL BETWEEN BLDG WINDOWS
RE: AE201

A12 C502 FLAGPOLES (2)

E8 C501 GRANITE EDGE TYP

F12 C504 RETAINING WALL

H8 C501 CONC. WALK TYP

E8 C501 GRANITE CURB TYP

A1 C501 PAINT STRIPING TYP

A12 C504 RET. WALL NOTE

E8 C501 GRANITE EDGE NOTE

A5 C502 SIGN "MTA VISITORS ONLY"

WALL MOUNTED SIGN
"STATE POLICE – " – BY ALLOWANCE

G1 C504 GRANITE STEPS

A12 C501 CONC. PAVERS

A8 C501 CURB RAMP TYP

BENCHES (6) – NIC

H8 C501 CONC. WALK TYP

TIP–DOWN CURB
11' TYP. BOTH SIDES

A12 C501 CONC. PAVERS

FLUSH CURB

WALL MOUNTED SIGN
"MTA/EZPASS" – BY ALLOWANCE

G1 C502 BOLLARD SIGNS (4)
"HC PARKING"

REF-332 + REF-339 Pavement Below Pavers


CCD-1

Special Supp 1 Book REF 203

Salt Guard REF 300

Concrete Below Pavers - REF 384

Motor for Stairs REF-385

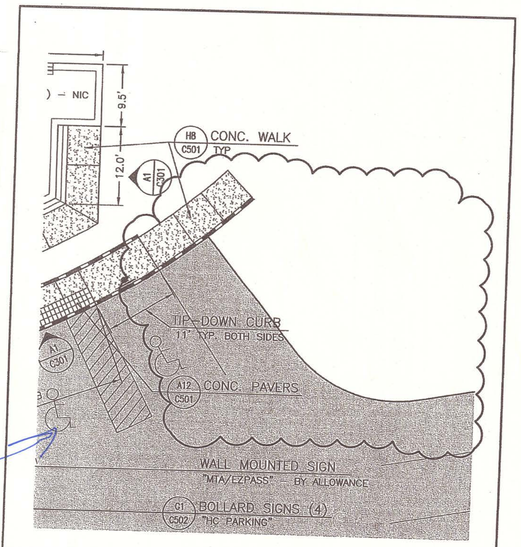

SMRT
ARCHITECTURE ENGINEERING PLANNING
SMRT
144 Fore Street/P.O. Box 618
Portland, Maine 04104
tel. (207) 772-3846
fax. (207) 772-1070

LANDSCAPE ARCHITECT
MARK G. JOHNSON
NO. 1857
STATE OF MAINE

PROJECT:	MAINE TURNPIKE AUTHORITY ADMINISTRATION BUILDING PARKING LOT @ LEDGE RECONFIGURATION
SUBJECT:	

SCALE:	1" = 10'
CAD FILE:	CP201–06016
PROJECT No.	06016
REF. SHEET:	CP201
PM:	SLB
A/E:	MGJ
DATE:	11–30–07
SUPPLEMENTAL INSTRUCTION	CCD–1
SKETCH No.	C–2

© COPYRIGHT 2007 SMRT INC.


AS BUILT Owner Copy

Scale: 1"=10'

0' 5' 10' 20'

SCALE:	SHOWN
PROJECT MANAGER:	SLB
JC/DRAWN BY:	TCM/PAF
A/E OF RECORD:	MGJ
CAD FILE:	06016–CP201
PROJECT NO:	06016
DATE:	7–9–07
SHEET TITLE:	DETAIL LAYOUT PLAN
SHEET No.	CP201

© COPYRIGHT 2007 SMRT INC.

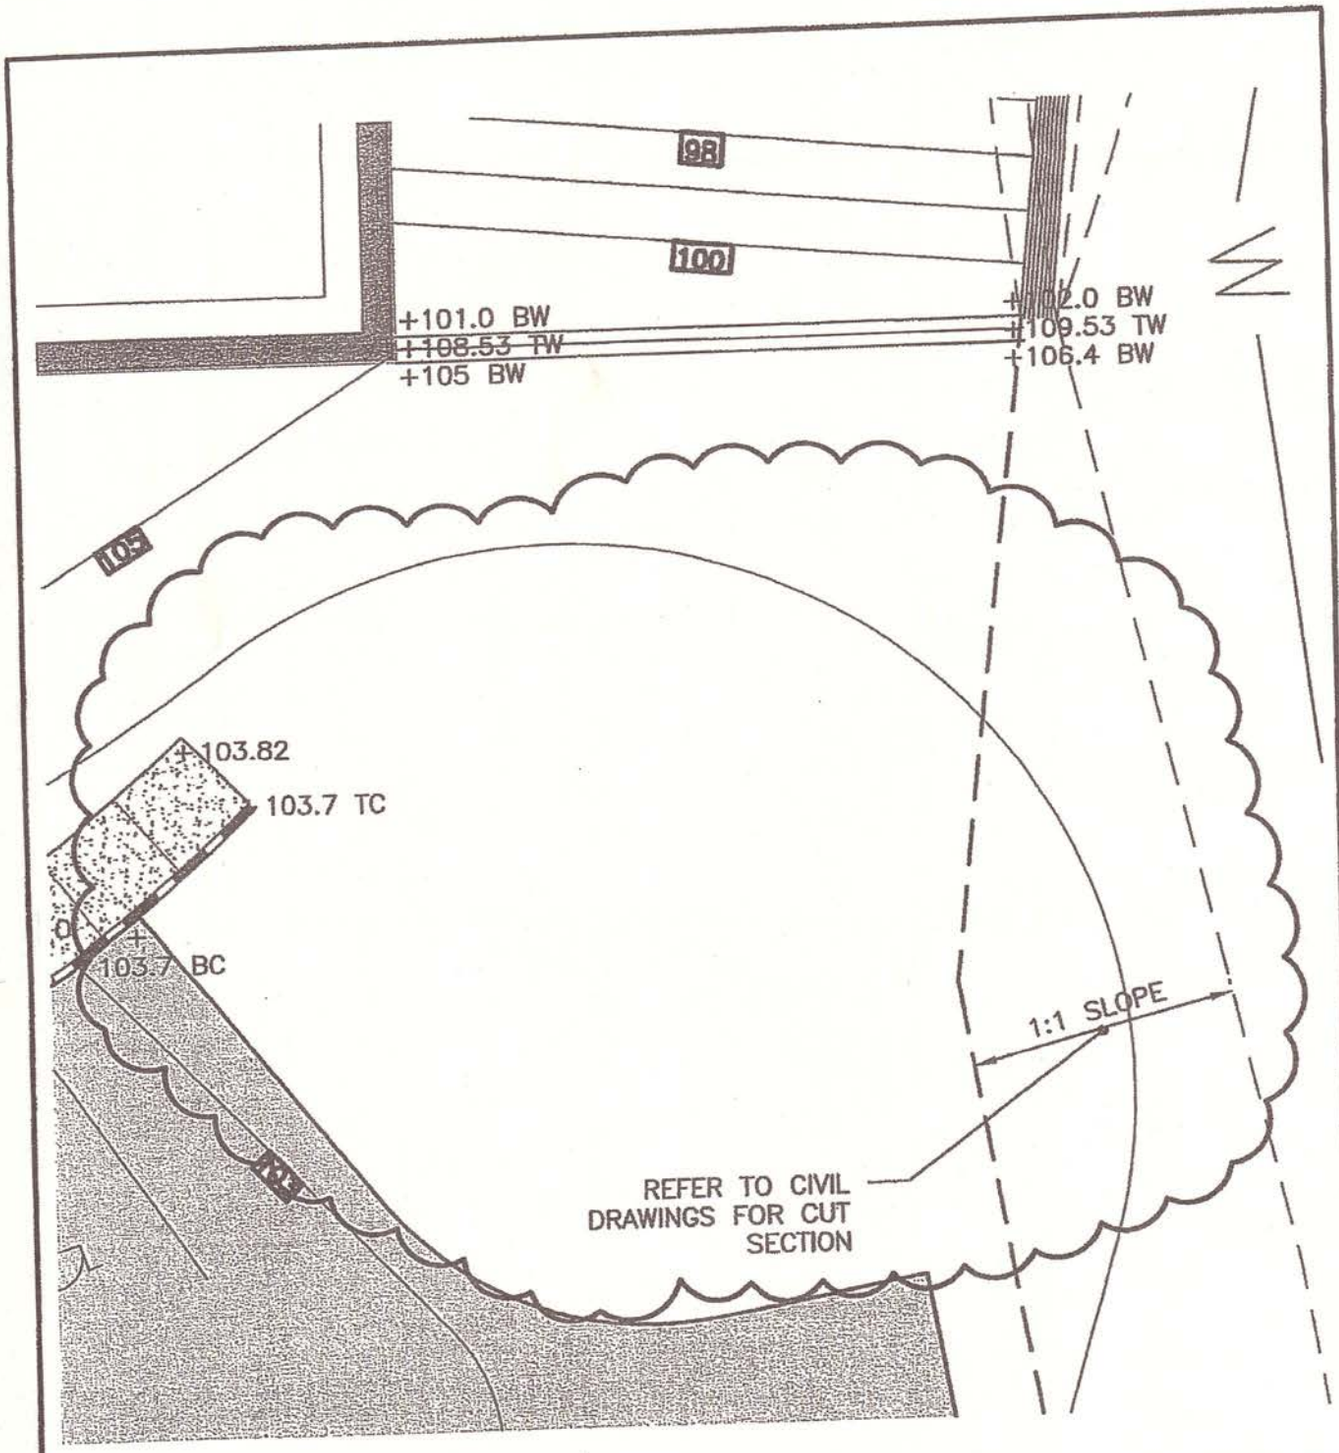

SMRT

ARCHITECTURE ENGINEERING PLANNING

SMRT
144 Fore Street/P.O.Box 618 PORTLAND, MAINE 04104
tel. (207) 772-3846 / fax. (207) 772-1070

PROJECT:	MAINE TURNPIKE AUTHORITY ADMINISTRATION BUILDING
SUBJECT:	PARKING LOT @ LEDGE RECONFIGURATION

SCALE:	1" = 10'
CAD FILE:	CG201-06016
PROJECT No.	06016
REF. SHEET:	CG201/CG202
PM: SLB	SUPPLEMENTAL INSTRUCTION CCD-1
A/E: MGJ	SKETCH No. C-3
DATE: 11-30-07	© COPYRIGHT 2007 SMRT INC.

A12 C502 FLAGPOLES (2)

E8 C501 GRANITE CURB TYP

G1 C502 BOLLARD SIGN (2) "HC PARKING"

A8 C501 TIP–DOWN CURB 11' TYP BOTH SIDES

H8 C501 CONC. WALK TYP

F12 C502 SIGN "MTA/STATE POLICE SERVICE"

A12 C504 RETAINING WALL

BRICK & GRANITE CORNER RE: ARCH.

A5 C502 SIGN "FUEL EFFICIENT VEHICLE PARKING"

J9 C502 BOLLARDS (2)

A8 C501 CURB RAMP TYP

A8 C501 TIP–DOWN CURB 6' TYP/ BOTH SIDES

H8 C501 CONC. WALK TYP

F1 C503 CONC. STAIR W/ RAILS

J9 C502 BOLLARDS (3) STANDARD

MAINTENANCE BUILDING RE: ARCHITECTURAL

J5 C502 CONC. PAD

D12 C501 METAL GATE TYP

BIKE RACK

F9 C502 GRAVEL TERRACE

H8 C501 CONC. WALK TYP

E8 C501 GRANITE EDGE TYP

J9 C502 BOLLARDS (3) STANDARD

ALIGN CENTER OF STEPS WITH CENTER OF BUILDING ENTRANCE

J5 C502 DUMPSTER PAD 10' x 12'

A9 C502 TRANSFORMER PAD

D12 C501 METAL FENCE

J5 C502 DUMPSTER PAD 10' x 12'

J9 C502 BOLLARDS (2) STAINLESS STEEL

FROST SLAB, TYP. RE: STRUCTURAL

CONTROL JOINT– TYP

LOADING DOCK RE: STRUCTURAL AND ARCHITECTURAL

EQUIPMENT PADS AND SLAB RE: STRUCTURAL

PROPOSED HEADQUARTERS
FFE(1) 92.53'
FFE(2) 105.86'
FFE(3) 119.19'

6" CRUSHED STONE TO LEDGE FACE (1–1/2" DIA. MINUS)

AS BUILT Owner Copy

Scale: 1"=10'

SMRT
ARCHITECTURE ENGINEERING PLANNING
SMRT
144 Fore Street/P.O. Box 618
Portland, Maine 04104
tel. (207) 772-3846
fax. (207) 772-1070

MARK G. JOHNSON 1557 LICENSED LANDSCAPE ARCHITECT

NORTH

PROJECT TITLE:
MAINE TURNPIKE AUTHORITY
ADMINISTRATION BUILDING
PORTLAND, MAINE

ISSUED FOR BIDDING/CONSTRUCTION
7-9-07

REV	DESCRIPTION	DATE
0	BIDDING/CONSTRUCTION	7-9-07


GRAPHIC SCALE: 0" 1"

SCALE:	SHOWN
PROJECT MANAGER:	SLB
JC/DRAWN BY:	TCM/PAF
A/E OF RECORD:	MGJ
CAD FILE:	06016–CP202
PROJECT NO:	06016
DATE:	7-9-07

SHEET TITLE: DETAIL LAYOUT PLAN

SHEET No. CP202


© COPYRIGHT 2007 SMRT INC.

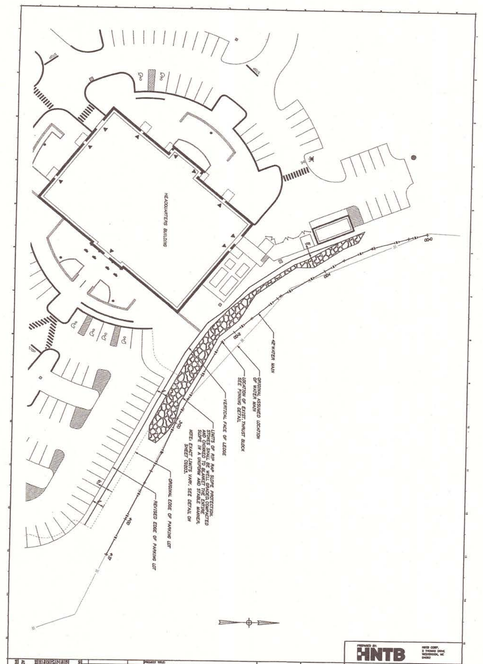
HEADQUARTERS BUILDING
PROPOSED EDGE OF PAVING
PROPOSED EDGE OF PAVING
PROPOSED EDGE OF PAV

UTILITY OFFSETS


For UNDERGROUND WATER	Job No.	Sheet No.
Made by JHT	Checked by	Backchecked by
Date 4-9-08	Date	Date

HNTB

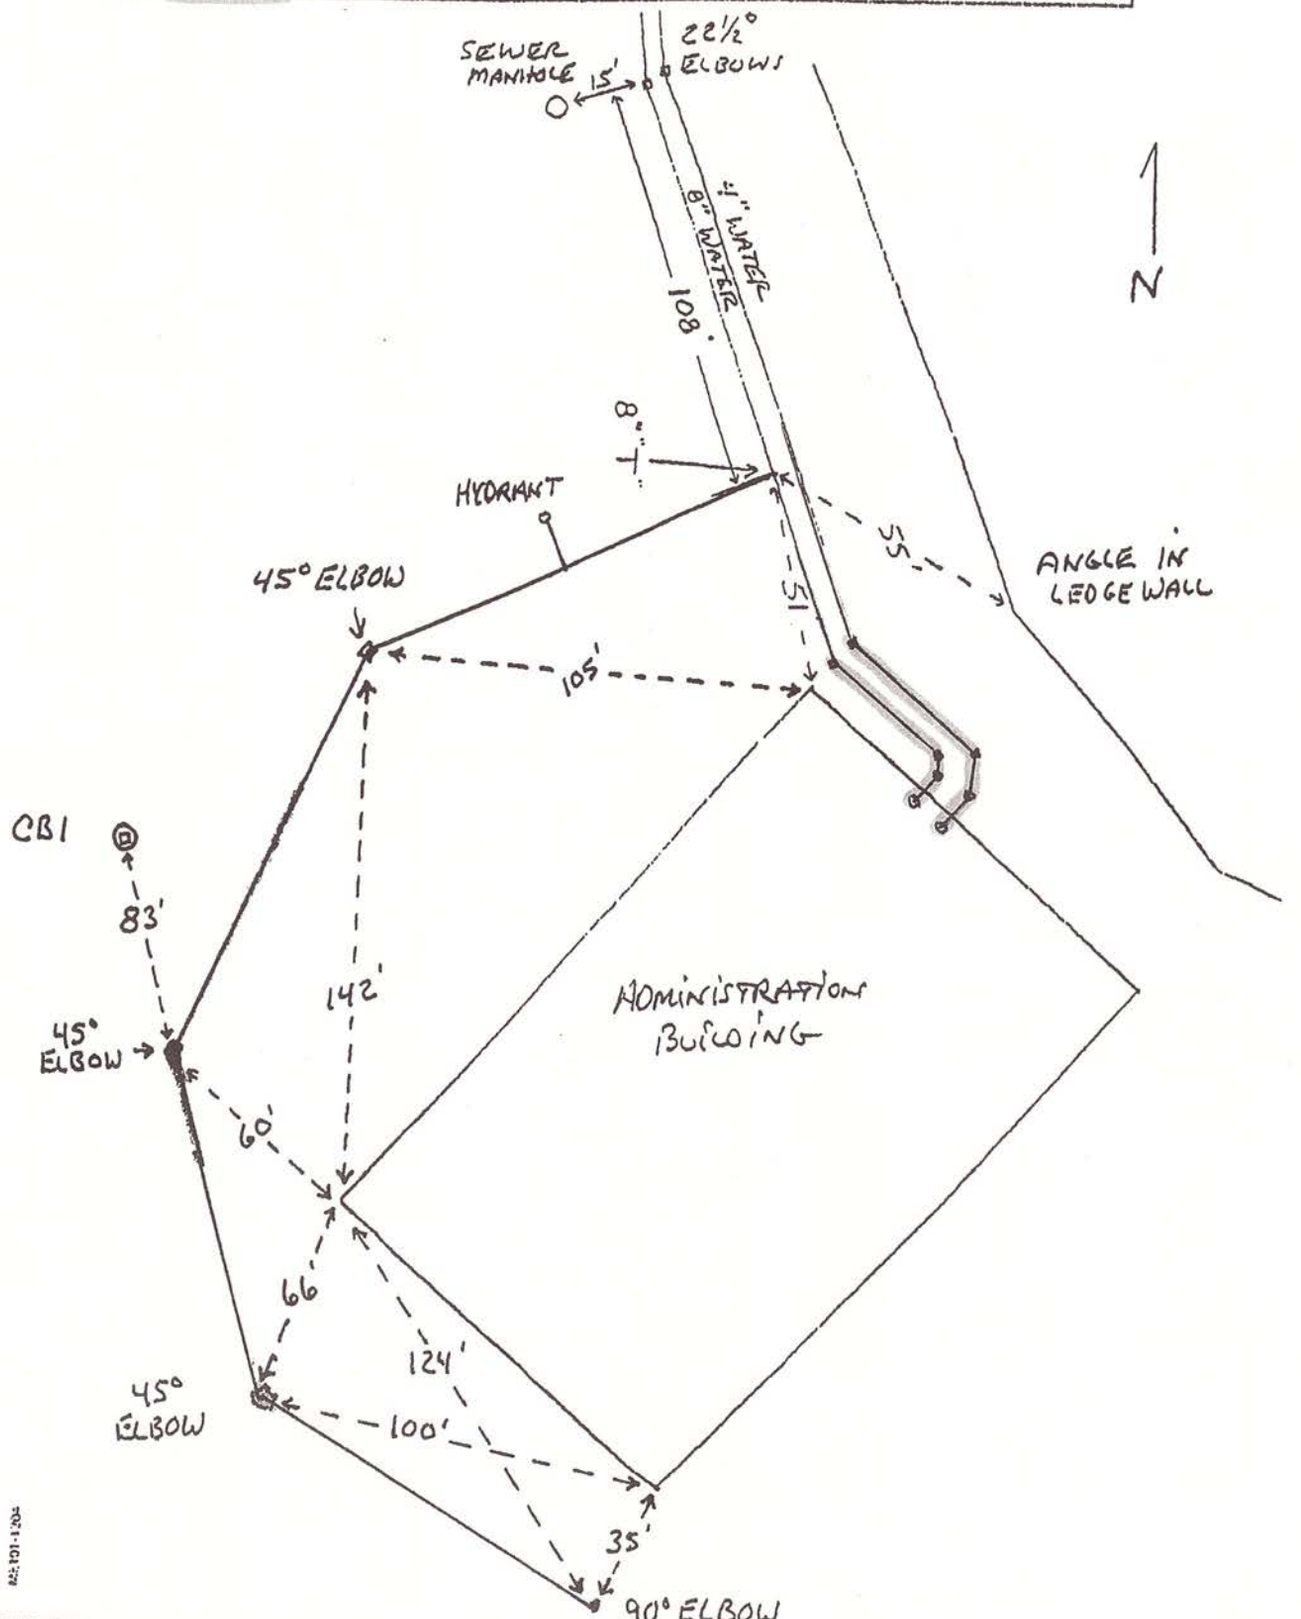


1-I
PC
Portland, Maine office
207 772-3846
207 772-1070
www.smrtinc.com

cc: Robert Driscoll; Scott Warchol; Derek Converse; SLB; File 06016/46.1

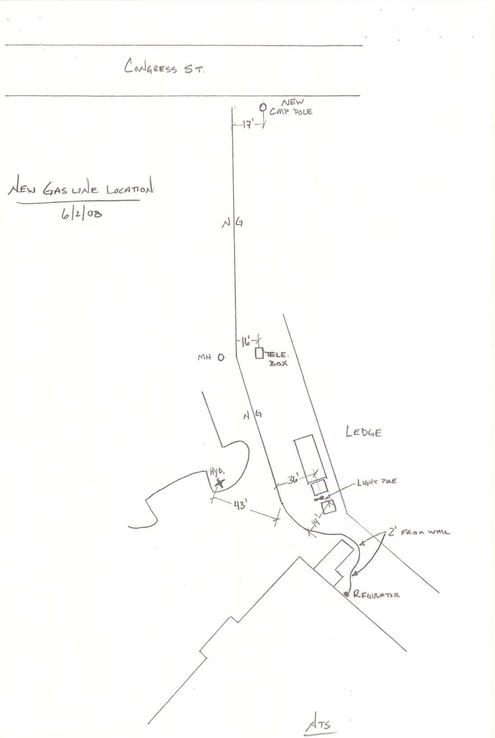

CONGRESS ST.
NEW GAS LINE LOCATION
6/2/08
17'
N G
16'
MH O
TELE. BOX
N G
LEDGE
36'
LIGHT POLE
43'
14'
2' FROM WALL
REGULATOR
ATS

Calculations For NTA HQ - Utility Exits	Job No.	Sheet No.
Made by	Date 5/2/08	
Checked by	Date	
Backchecked by	Date	

HNTB

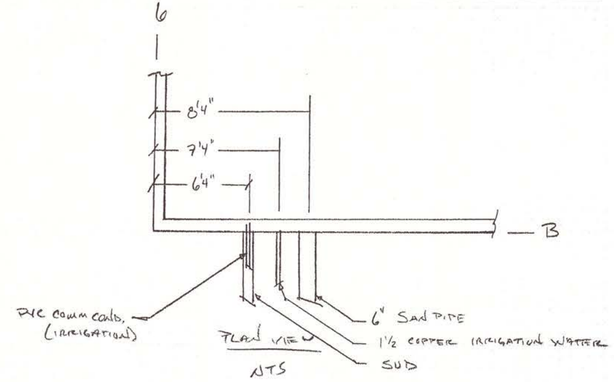


PLAN VIEW
NTS

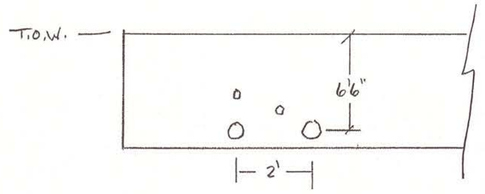

ELEVATION VIEW NTS

Calculations For 6" SAN EXIT	Job No. 2007.07	Sheet No.
Made by JRD	Date 5/13/09	
Checked by	Date	
Backchecked by	Date	


HNTB

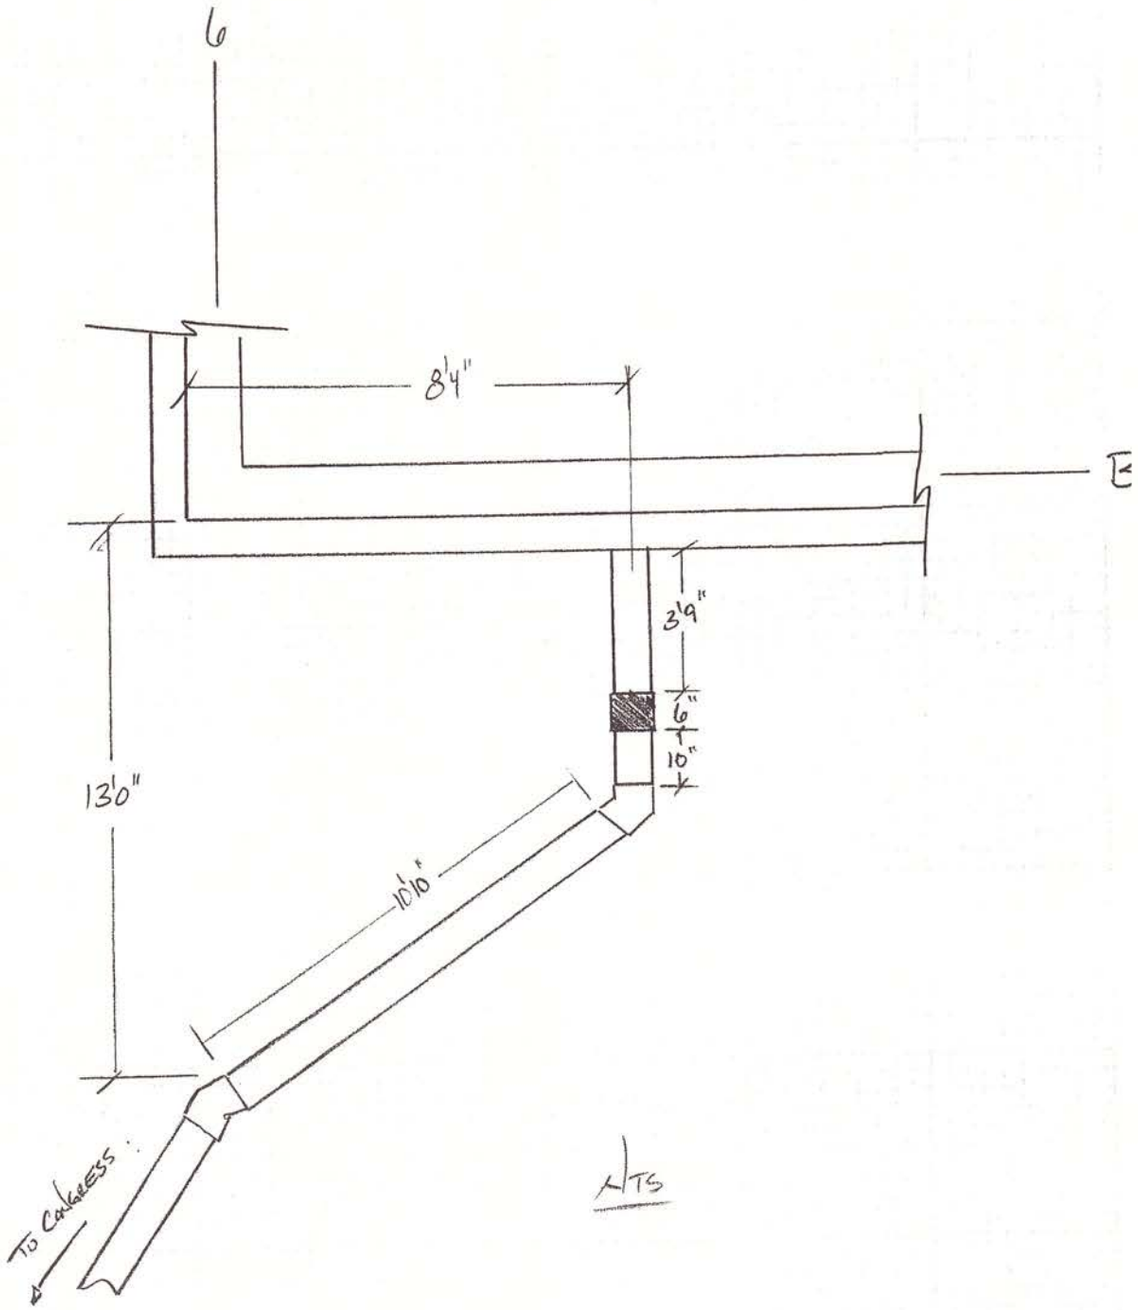

For EXIT 46 W	Job No.	Sheet No.
Made by JHT	Checked by	Backchecked by
Date 3-6-08	Date	Date

HNTB


NEW 2" WATERLINE PUT IN SERVICE AT 1000 HRS.
OLD 2" " TAKEN OUT OF SERVICE

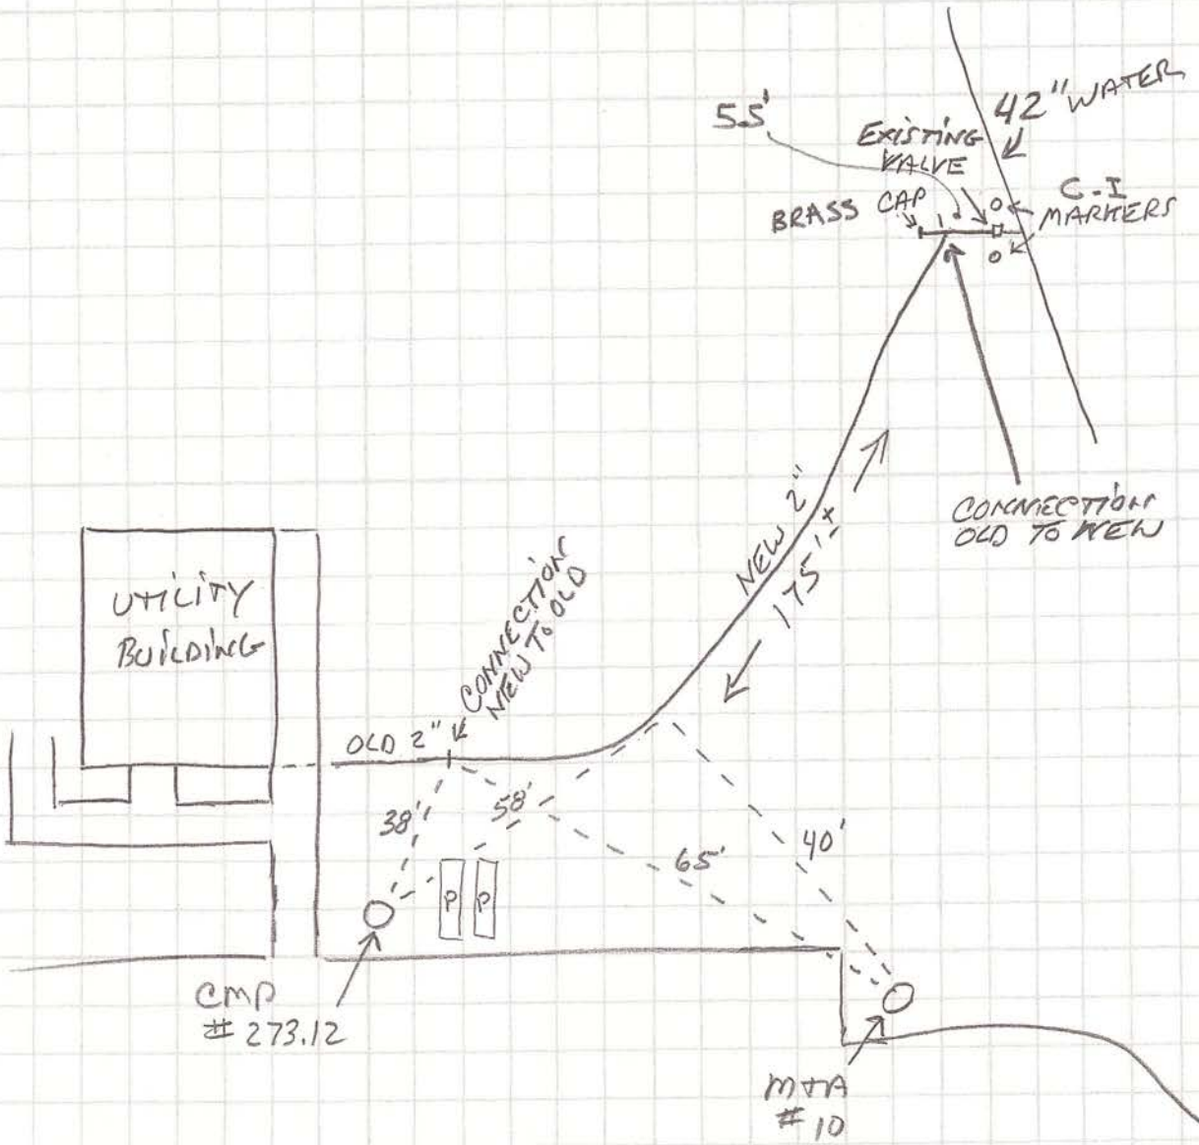

101-1204

For	MTA HEADQUARTER	Job No.	Sheet No.
Made by	CFM	Checked by	Backchecked by
Date	3/19	Date	Date

HNTB

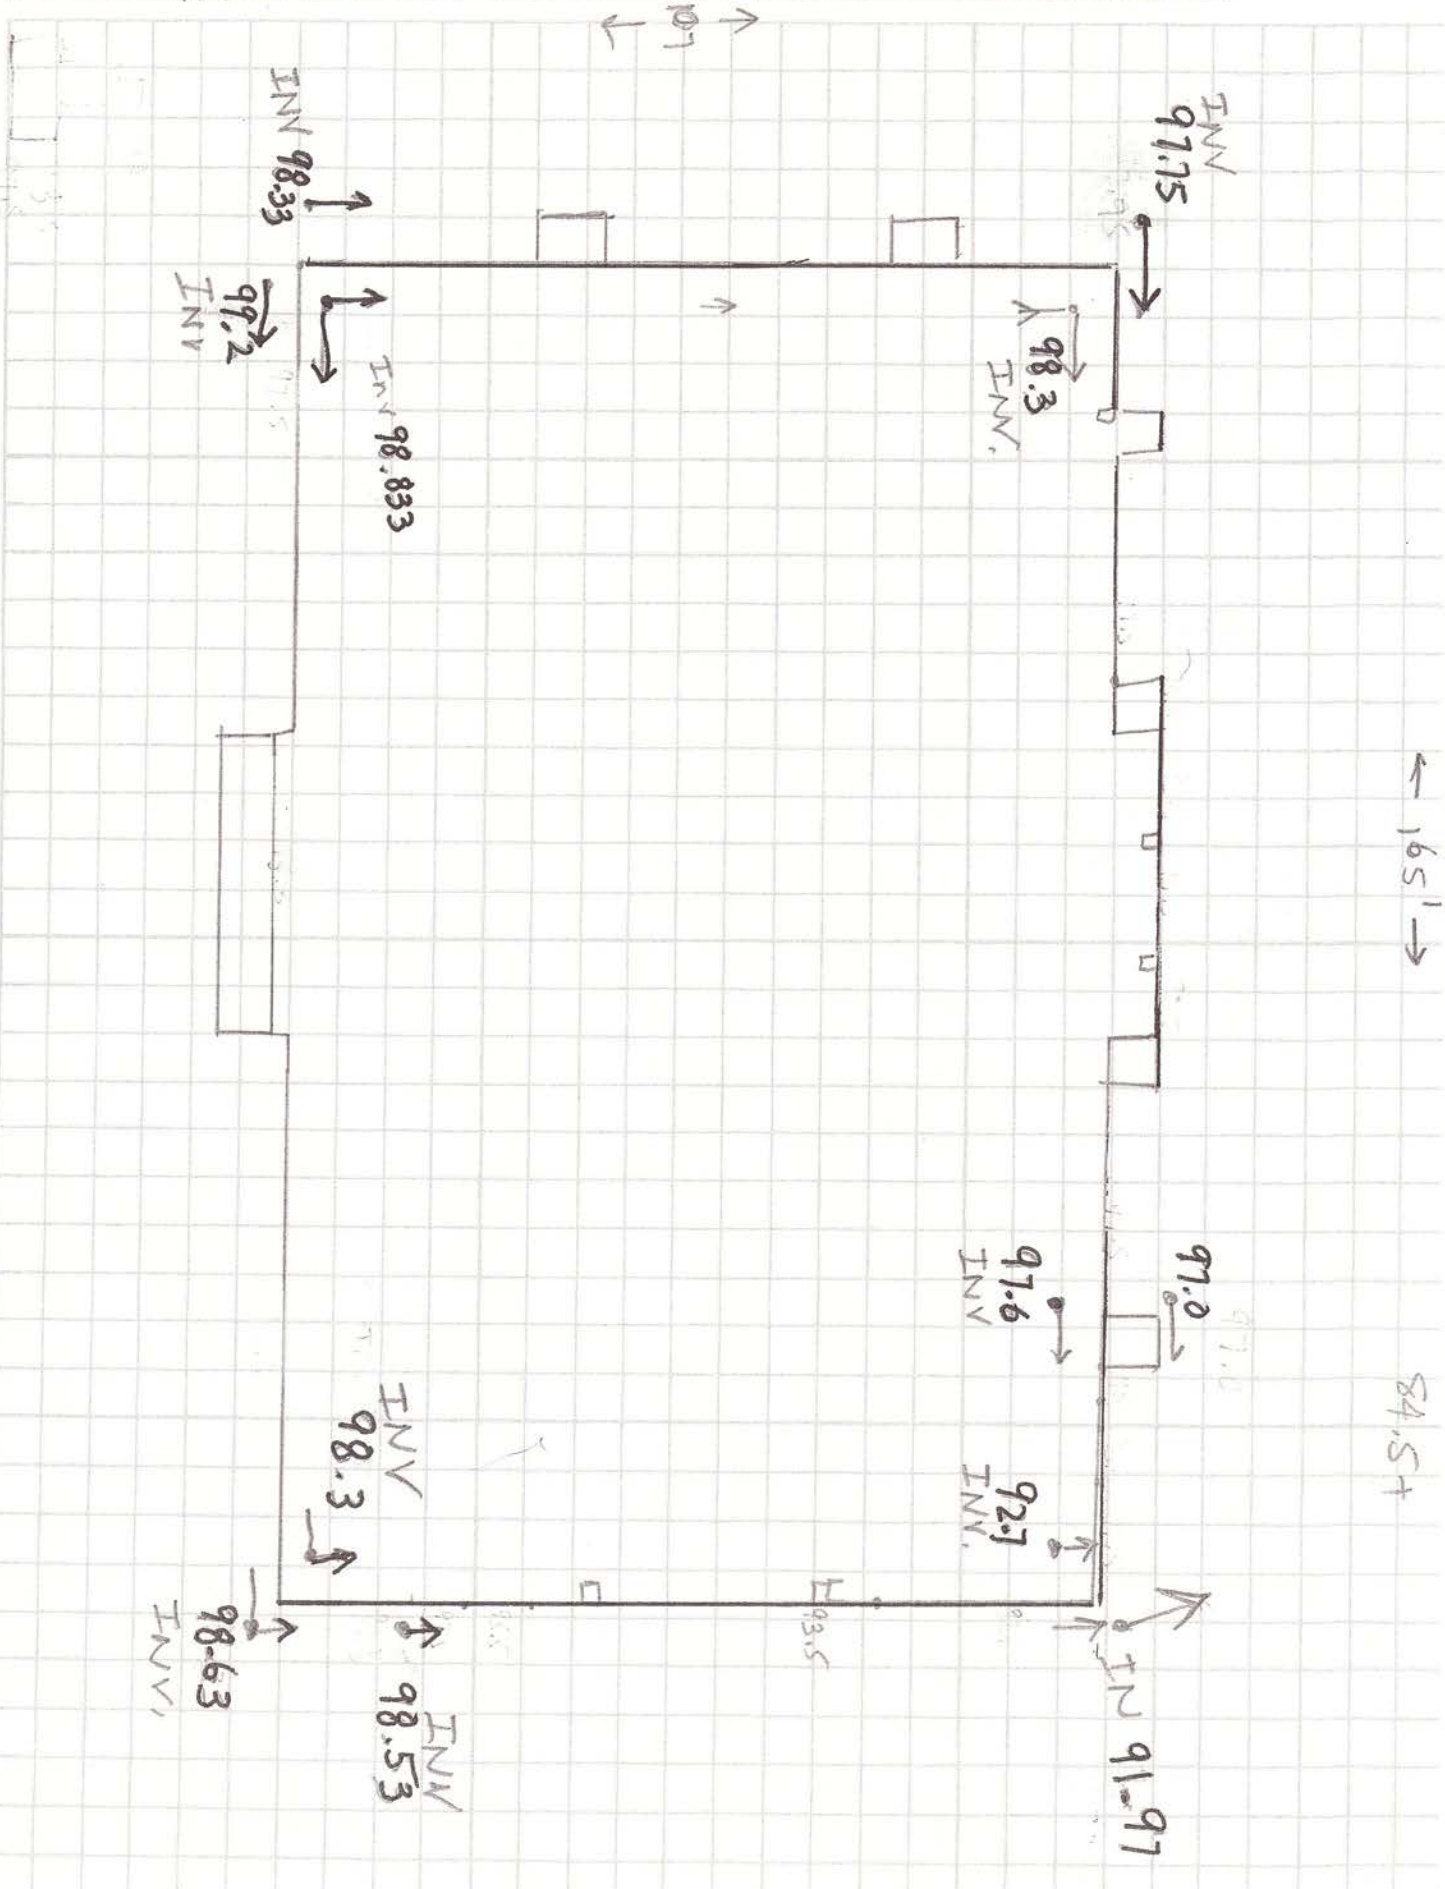

IE101-1204

MATCH LINE - SEE DETAIL INSET

CONGRESS STREET

N 87°22'30" E 252.49'

S/F

SILT FENCE

CLEARING LIMIT AND SILT FENCE PLACEMENT TO MATCH LIMIT OF DISTURBANCE

W. H. NICHOLS COMPANY

60' RIGHT-OF-WAY IN COMMON

28' PORTLAND WATER DISTRICT EASEMENT

UNDERDRAIN SOIL FILTER AND DETENTION POND #1

MTA

SEDIMENT FOREBAY

PAVED DRIVE

ROAD

DISTRICT

PROPOSED HEADQUARTERS

PORTLAND WATER DISTRICT EASEMENT

PORTLAND WATER DISTRICT

PORTLAND WATER DISTRICT EASEMENT

S 24°37'21" E 144.80'

S 96°43'21" E 151.23'

S 82°33'33" E 51.51'

S 19°36'09" E 177.27'

733.35' (DEED ± 731.02')

N 00°01'41" E

610.35' (DEED 620' ±)

S 87°19'55" W

LEDGE TO BE OVERBLOWN ALONG THE LIMITS OF THE HATCHED AREA FOR FUTURE WATER MAIN. SEE TYPICAL SECTION AND DETAILS ON SHEET CG203

LEDGE TO BE PRE-SPLIT ALONG THIS FACE WITHIN THE LIMITS OF THE ARROWHEADS OR AS DIRECTED BY THE ENGINEER.

LEDGE TO BE PRE-SPLIT ALONG THIS FACE WITHIN THE LIMITS OF THE ARROWHEADS OR AS DIRECTED BY THE ENGINEER.

SEE PLAN DETAILS FOR WORK IN THIS AREA

N/F CONGO ASSOCIATES, L' C

N/F 2320 CONGRESS STREET, LLC

INSET

MATCH LINE

CONGRESS STREET

HUTCHINS DRIVE

FLUSH

S/F

LEGEND

- S/F — SILT FENCE OR WOOD WASTE BERM
- → → UNDERDRAIN
- CLL — CLEARING LIMIT LINE
- C — C CUT LINE
- F — F FILL LINE
- RIPRAP
- HIGH PERFORMANCE TURF REINFORCEMENT MAT (HPTRM)

TOP OF SLOPE

TOE OF SLOPE

TOP FACE OF LEDGE

BOTTOM FACE OF LEDGE. SEE TYPICAL SECTION ON SHEET CG203.

UNDERDRAIN SOIL FILTER AND DETENTION POND #2

SEDIMENT FOREBAY

Scale: 1"=40'

0' 20' 40' 80'

NORTH

AS BUILT
Owner Copy

RFI-91 For Trench BackFill

RFI-87 + SI-27 for Riprap Slope

SI-63 Swale Boulder Area

SI-63 for Seed Mix & Filter

Pond Liner RFI-252

RFI-116 Slope at Chatter

RFI-124 Drainage Pipe

RFI-88 SI-27 Drainage Pipe

SI-63 for Swale Boulder Area

RFI-124 + SI-27 Drainage Pipe

RFI-116 Slope at Chatter

PREPARED BY: HNTB

HNTB CORP.
2 THOMAS DRIVE
WESTBROOK, ME
04092

SMRT

ARCHITECTURE ENGINEERING PLANNING

SMRT
144 Fore Street/P.O. Box 618
Portland, Maine 04104
tel. (207) 772-3846
fax. (207) 772-1070

STATE OF MAINE — ROLAND LAVALLEE No. 6452 — REGISTERED PROFESSIONAL ENGINEER

PROJECT TITLE:
MAINE TURNPIKE AUTHORITY
ADMINISTRATION BUILDING
PORTLAND, MAINE

ISSUED FOR BIDDING/CONSTRUCTION
7-9-07

REV	DESCRIPTION	DATE
4	DOCS FOR OWNER REVIEW	6-11-07
3	ISSUED FOR CITY REVIEW	5-03-07
2	100% OWNER REVIEW	3-23-07
1	ISSUED FOR PERMITTING	2-09-07
0	PRE-SUBMITTAL	1-16-07

GRAPHIC SCALE: 0" 1"

SCALE:	AS NOTED
PROJECT MANAGER:	GAB
JC/DRAWN BY:	MPC
A/E OF RECORD:	GAB
CAD FILE:	X
PROJECT NO:	2007.07
DATE:	01/07

SHEET TITLE:
GRADING PLAN

SHEET No.
CG101

©COPYRIGHT 2006 SMRT INC.

PROPOSED HEADQUARTERS
FFE(1) 92.53'
FFE(2) 105.86'
FFE(3) 119.19'

+92.28

92.05+ BC 92.27 TC 92.5+

92.14+ 92.25 BC 92.27 TC 92.5+

92.5+ 92.6 FLUSH 92.30 95.6+ 92.80 92.20 BC 91.53 TC 92.5+

95.6 97.0 91.9 97.0 98.3 92.5+ FLUSH

98.3 99.6 99.6 101.0 +92.10 BC 92.43 TC 92.83+

101.0 102.8 +92.8 BW 93.0 TW 101.0+ 99.5+

SPECIAL "STAR" DRAIN GRATE – SEE SPEC.

SPECIAL "STAR" DRAIN GRATE – SEE SPEC.

102.3

105.7 105.7 105.7 105.1 105.2 105.0 108.53 TW 103.0 BW 105.5 105.36 104.9 104.9 104.4 104.3 103.82 103.7 TC 103.2 BC 103.10 102.60 102.05

RFI-332

RFI-339 Pavement Below Pavers

See SI 24 For Grades

See SI 24 For New Grading Plan

TS 105.13 5@ 8"x14" BS102.63 102.57

5% MAX

TC 102.27 BC 102.15

102.37 101.87

102.0 TC 101.5 BC 102.0 TC +101.5 BC

LP 101.4

+101.0 BW +108.53 TW +105 BW

AS BUILT Owner Copy

Scale: 1"=10'
0' 5' 10' 20'

SMRT

ARCHITECTURE ENGINEERING PLANNING

SMRT
144 Fore Street/P.O. Box 618
Portland, Maine 04104
tel. (207) 772-3846
fax. (207) 772-1070

LICENSED LANDSCAPE ARCHITECT MARK G. JOHNSON NO. 1557 MAINE

PROJECT TITLE:
MAINE TURNPIKE AUTHORITY ADMINISTRATION BUILDING
PORTLAND, MAINE

ISSUED FOR BIDDING/CONSTRUCTION
7-9-07

REV	DESCRIPTION	DATE
0	BIDDING/CONSTRUCTION	7-9-07

GRAPHIC SCALE: 0" 1"

SCALE:	SHOWN
PROJECT MANAGER:	SLB
JC/DRAWN BY:	TCM/PAF
A/E OF RECORD:	MGJ
CAD FILE:	06016-CG201
PROJECT NO:	06016
DATE:	7-9-07

SHEET TITLE:
DETAIL GRADING PLAN

SHEET No.
CG201

©COPYRIGHT 2007 SMRT INC.

SPECIAL "STAR" DRAIN GRATE — SEE SPEC.

+HP 91.7

BC 90.6 + TC 90.5

+BC 90.1 TC 90.6

90.55 TC 91.05 BC

+91.9 BW 93.5 TW

+ 91.8

91.9 BW + 93.5 TW

90.2

6' TIPDOWN

+88.5

+HP 90.2

BC 89.0 +TC 89.5

88.0

90.7+

+ TC/BC FLUSH

91.2 TC 90.7 BC

+91.3 TC +90.8 BC

+HP 93.2

+HP 90.5

2%

2%

ST-74R

92.35

SI-74 Delete Peastone + Change to Precast Pavers

92.35

89.85

89.75+

TC 92.76 BC 92.43+

TC 92.76 BC 92.43

92.35

FLUSH

FLUSH

FLUSH

FLUSH

92.53

+HP 93.1

92.2

92.5+

+ 88.4

+ 88.53

+ 88.53

5 RISERS @ 6" EA. = 2.5'

See SI 24 For New Grading

RFI-339 Pavement Below Pavers

+92.53

92.53 +

+92.0

+HP 92.0

92.0

94

96

98

100

+BW 101

+TW 108.53

+100.5

PROPOSED HEADQUARTERS

FFE(1) 92.53' = 100.00 FF

FFE(2) 105.86'

FFE(3) 119.19'

AS BUILT Owner Copy

Scale: 1"=10'

0' 5' 10' 20'

105

SMRT

ARCHITECTURE ENGINEERING PLANNING

SMRT
144 Fore Street/P.O. Box 618
Portland, Maine 04104
tel. (207) 772-3846
fax. (207) 772-1070

LICENSED LANDSCAPE ARCHITECT MARK G. JOHNSON NO. 1857 STATE OF MAINE

NORTH

PROJECT TITLE:

MAINE TURNPIKE AUTHORITY ADMINISTRATION BUILDING
PORTLAND, MAINE

ISSUED FOR BIDDING/CONSTRUCTION 7-9-07

REV	DESCRIPTION	DATE
0	BIDDING/CONSTRUCTION	7-9-07

GRAPHIC SCALE: 0" 1"

SCALE:	SHOWN
PROJECT MANAGER:	SLB
JC/DRAWN BY:	TCM/PAF
A/E OF RECORD:	MGJ
CAD FILE:	06016-CG202
PROJECT NO:	06016
DATE:	7-9-07


SHEET TITLE:

DETAIL GRADING PLAN


SHEET No.

CG202


©COPYRIGHT 2007 SMRT INC.

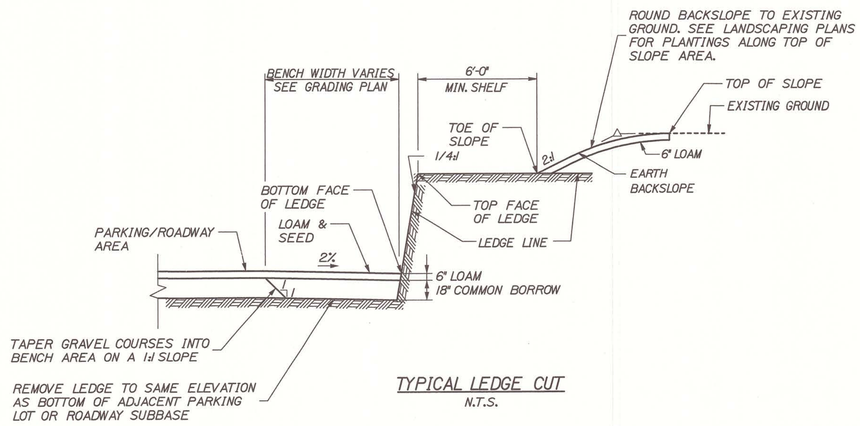

TYPICAL LEDGE CUT
N.T.S.

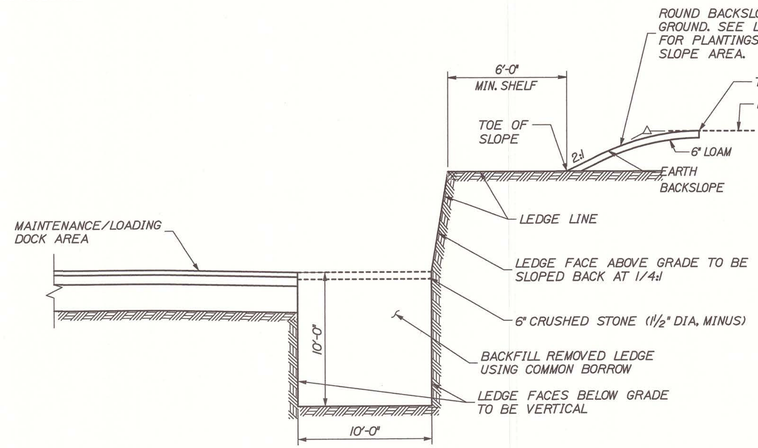

TYPICAL LEDGE CUT FOR FUTURE WATER MAIN
N.T.S.

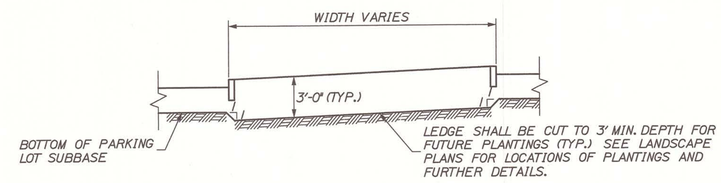

TYPICAL LEDGE CUT AT PARKING LOT ISLANDS
N.T.S.

AS BUILT
Owner Copy

PREPARED BY:
HNTB
HNTB CORP.
2 THOMAS DRIVE
WESTBROOK, ME
04092

SMRT
ARCHITECTURE ENGINEERING PLANNING
SMRT
144 Fore Street/P.O. Box 618
Portland, Maine 04104
tel. (207) 772-3846
fax. (207) 772-1070

STATE OF MAINE
ROLAND A. LAVALLEE
No. 9482
LICENSED PROFESSIONAL ENGINEER

PROJECT TITLE:
MAINE TURNPIKE AUTHORITY
ADMINISTRATION BUILDING
PORTLAND, MAINE

ISSUED FOR BIDDING/CONSTRUCTION
7-9-07

REV	DESCRIPTION	DATE
4	DOCS FOR OWNER REVIEW	6-11-07
3	ISSUED FOR CITY REVIEW	5-03-07
2	100% OWNER REVIEW	3-23-07
1	ISSUED FOR PERMITTING	2-09-07
0	PRE-SUBMITTAL	1-16-07


GRAPHIC SCALE: 0" 1"

SCALE:	AS NOTED
PROJECT MANAGER:	GAB
JC/DRAWN BY:	MPC
A/E OF RECORD:	GAB
CAD FILE:	X
PROJECT NO:	2007.07
DATE:	01/07


SHEET TITLE:
SITE GRADING DETAILS

SHEET No.
CG203


© COPYRIGHT 2006 SMRT INC.

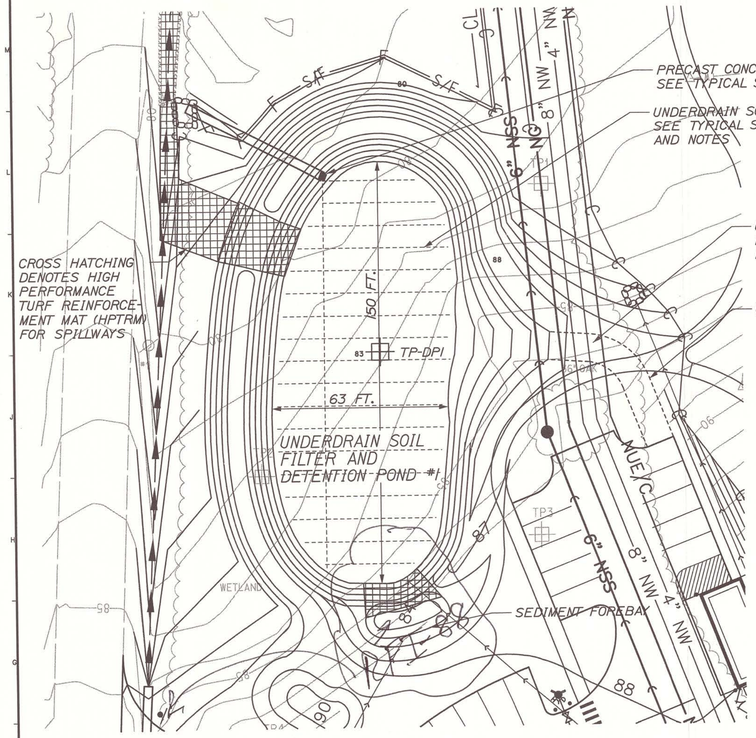


POND 1
SCALE: 1" = 25'

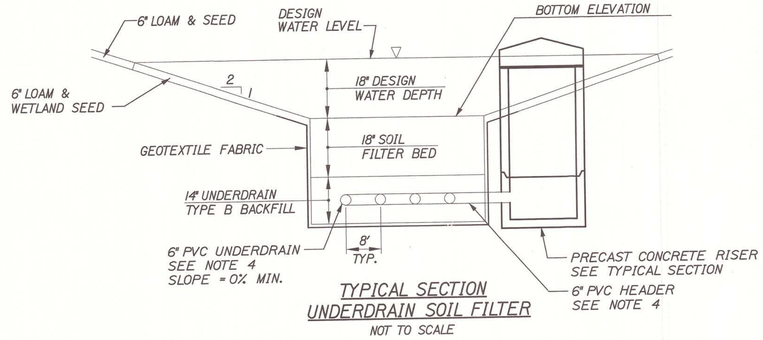


TYPICAL SECTION
UNDERDRAIN SOIL FILTER
NOT TO SCALE

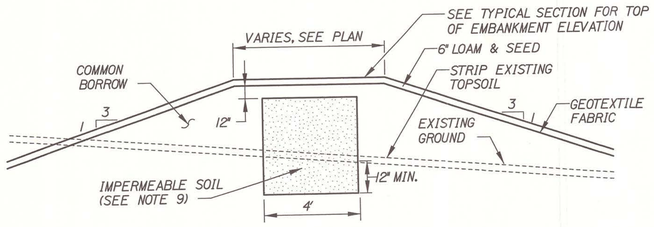

USF BASIN
TYPICAL SECTION AT EMBANKMENTS
NOT TO SCALE

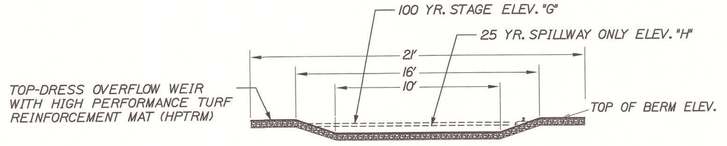


TYPICAL EMERGENCY
SPILLWAY CONFIGURATION
NOT TO SCALE

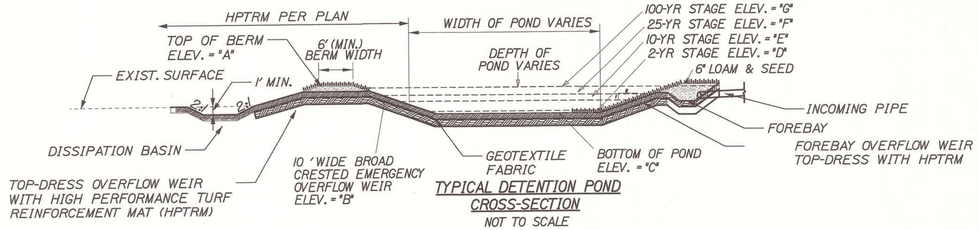

TYPICAL DETENTION POND
CROSS-SECTION
NOT TO SCALE

TABLE 1	SPILLWAY CROSS SECTION							
	A	B	C	D	E	F	G	H
POND #1	88.00	86.50	83.00	85.06	86.08	86.22	86.46	86.80
POND #2	90.00	89.00	86.00	87.69	88.57	88.68	88.79	89.21

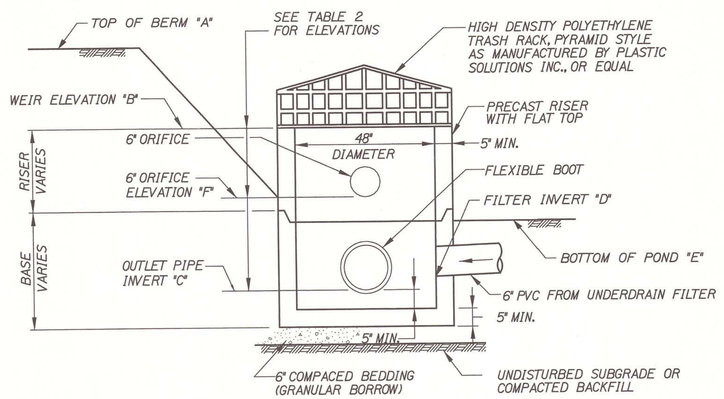

PRECAST CONCRETE RISER
TYPICAL SECTION N.T.S.

TABLE 2	OUTLET STRUCTURE ELEVATIONS					
	A	B	C	D	E	F
POND #1	87.00	85.90	80.30	80.60	83.00	84.50
POND #2	90.00	88.50	83.30	83.60	86.00	87.50

RISER NOTES:

1. MANHOLE SECTIONS AND STEEL REINFORCEMENT SHALL CONFORM TO ASTM C478, AND BE SUITABLE FOR HS-20 LOADINGS (TYP.).
2. 2 COATS BITUMINOUS DAMPROOFING

NOTES:

1. SOIL FILTER BED MATERIAL SHALL BE A LIGHTLY COMPACTED THOROUGHLY BLENDED MIXTURE OF THE FOLLOWING:
   - SILTY SAND (75-80% BY VOLUME): MEDOT SPEC. 703.01 (FINE AGGREGATE FOR CONCRETE). SOIL SHALL HAVE NO GREATER THAN 2% CLAY CONTENT.
   - MULCH (20-25% BY VOLUME): MODERATELY FINE SHREDDED BARK MULCH OR WOOD FIBER MULCH.
   - TOTAL MIXTURE SHALL HAVE A RANGE OF 8-10% PASSING #200 SIEVE.
2. UNDERDRAIN BACKFILL (BEDDING) SHALL BE WELL GRADED, CLEAN, COARSE GRAVEL MEETING MEDOT SPECIFICATION 703.22, TYPE B UNDERDRAIN BACKFILL. NO MORE THAN 2% BY WEIGHT SHALL PASS THE #200 SIEVE.
3. GEOTEXTILE FABRIC SHALL BE MEDOT SPECIFICATION 722.02, CLASS A DESIGNATION.
4. UNDERDRAIN PIPE SHALL BE PVC CONFORMING TO ASTM D3034, SDR 35. (UNDERDRAIN LATERALS SHALL BE 6 INCH SLOTTED PVC. 6 INCH PVC HEADER/OUTLET PIPE SHALL NOT BE SLOTTED.)
5. STONE DITCH PROTECTION FOR PIPE OUTLET/DITCH PROTECTION SHALL BE MEDOT SPECIFICATION 703.29, WITH 90-100% WEIGHT OF ROCK PASSING AN 8 INCH SIEVE AND 0-15% PASSING A 4 INCH SIEVE.
6. SURFACE OF SOIL FILTER SHALL BE PLANTED WITH WETLAND SEED "NEW ENGLAND EROSION CONTROL/RESTORATION MIX" AS SUPPLIED BY NEW ENGLAND WETLAND PLANTS, INC. SEED MIX SHALL BE APPLIED AT DOUBLE THE MANUFACTURERS APPLICATION RATE. SURFACE SHALL BE STABILIZED WITH AN APPROVED EROSION CONTROL MATTING.
7. STORMWATER FILTER SHALL BE CONSTRUCTED TO THE LIMITS AND DETAILS SHOWN ON THE PLANS AND THE ABOVE SPECIFICATIONS UNLESS OTHERWISE APPROVED BY THE ENGINEER. IF LEDGE IS ENCOUNTERED IN THE EXCAVATION FOR EITHER POND, THE CONTRACTOR SHALL REMOVE THE LEDGE TO ALLOW FOR A 1' SEPARATION BETWEEN THE EXPOSED BEDROCK AND THE BOTTOM OF THE UNDERDRAIN SOIL FILTER. BACKFILL UP TO THE BOTTOM OF THE UNDERDRAIN SOIL FILTER WITH SUITABLE, COMPACTED CLAY MATERIAL (SEE NOTE 9).
8. HIGH PERFORMANCE TURF REINFORCEMENT MATS (HPTRM) SHALL MEET THE SPECIFICATIONS OF LANDLOK PYRAMAT HPTRM OR APPROVED EQUAL.
9. IMPERMEABLE SOIL FOR EMBANKMENT CORE AND BEDROCK COVER SHALL MEET MEDOT SPECIFICATION 203.245, CLAY BORROW. ON-SITE CLAY MATERIAL MAY BE USED IF IT MEETS THE SPECIFICATION.
10. STORMWATER FILTER SHALL BE CONSTRUCTED TO THE LIMITS AND DETAILS SHOWN ON THE PLANS AND THE ABOVE SPECIFICATIONS UNLESS OTHERWISE APPROVED BY THE ENGINEER.
11. FILTER BED MATERIAL SHALL NOT BE PLACED IN USF BASINS UNTIL THE TRIBUTARY DRAINAGE AREA IS PERMANENTLY STABILIZED AGAINST EROSION.

AS BUILT
Owner Copy

PREPARED BY:
HNTB
HNTB CORP.
2 THOMAS DRIVE
WESTBROOK, ME
04092

SMRT
ARCHITECTURE ENGINEERING PLANNING
SMRT
144 Fore Street/P.O. Box 618
Portland, Maine 04104
tel. (207) 772-3846
fax. (207) 772-1070

STATE OF MAINE
ROLAND A. LAVALLEE
No. 8452
LICENSED PROFESSIONAL ENGINEER

PROJECT TITLE:
MAINE TURNPIKE AUTHORITY
ADMINISTRATION BUILDING
PORTLAND, MAINE

ISSUED FOR BIDDING/CONSTRUCTION
7-9-07

REV	DESCRIPTION	DATE
4	DOCS FOR OWNER REVIEW	6-11-07
3	ISSUED FOR CITY REVIEW	5-03-07
2	100% OWNER REVIEW	3-23-07
1	ISSUED FOR PERMITTING	2-09-07
0	PRE-SUBMITTAL	1-16-07


GRAPHIC SCALE: 0" 1"

SCALE:	AS NOTED
PROJECT MANAGER:	GAB
JC/DRAWN BY:	MPC
A/E OF RECORD:	GAB
CAD FILE:	X
PROJECT NO:	2007.07
DATE:	01/07


SHEET TITLE:
UNDERDRAIN SOIL FILTER
AND DETENTION POND
PLANS AND DETAILS

SHEET No. CG301

©COPYRIGHT 2006 SMRT INC.

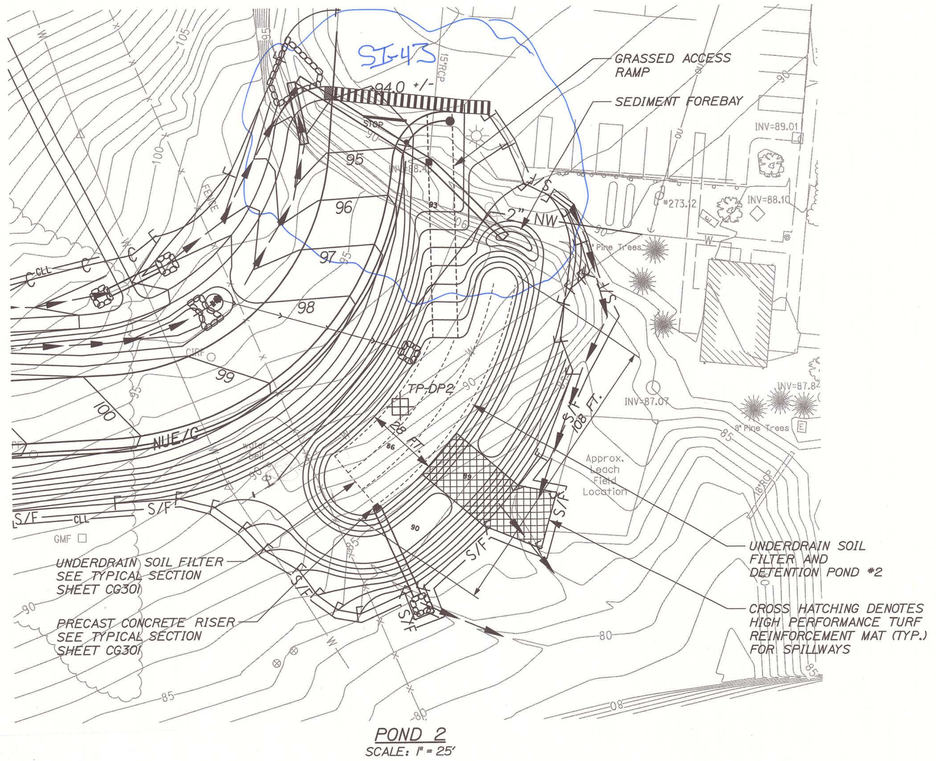

POND 2
SCALE: 1" = 25'

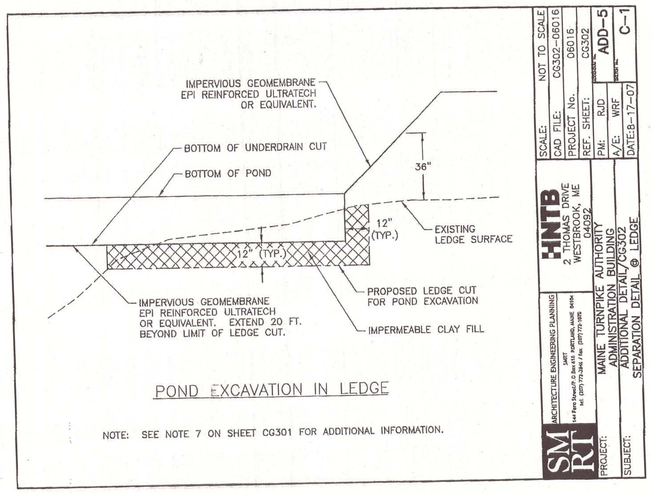

POND EXCAVATION IN LEDGE

NOTE: SEE NOTE 7 ON SHEET CG301 FOR ADDITIONAL INFORMATION.

AS BUILT
Owner Copy

NOTE:
FOR NOTES, SEE SHEET CG301.

P.16-18
AUG-17-2007 15:41
MAINE TURNPIKE

PREPARED BY:
HNTB
HNTB CORP.
2 THOMAS DRIVE
WESTBROOK, ME
04092

SMRT
ARCHITECTURE ENGINEERING PLANNING
SMRT
144 Fore Street/P.O. Box 618
Portland, Maine 04104
tel. (207) 772-3846
fax. (207) 772-1070

STATE OF MAINE
ROLAND A. LAVALLEE
No. 6458
REGISTERED PROFESSIONAL ENGINEER

PROJECT TITLE:
MAINE TURNPIKE AUTHORITY
ADMINISTRATION BUILDING
PORTLAND, MAINE

ISSUED FOR BIDDING/CONSTRUCTION
7-9-07

REV	DESCRIPTION	DATE
4	DOCS FOR OWNER REVIEW	6-11-07
3	ISSUED FOR CITY REVIEW	5-03-07
2	100% OWNER REVIEW	3-23-07
1	ISSUED FOR PERMITTING	2-09-07
0	PRE-SUBMITTAL	1-16-07

GRAPHIC SCALE: 0" 1"

SCALE:	AS NOTED
PROJECT MANAGER:	GAB
JC/DRAWN BY:	MPC
A/E OF RECORD:	GAB
CAD FILE:	X
PROJECT NO:	2007.07
DATE:	01/07

SHEET TITLE:
UNDERDRAIN SOIL FILTER AND DETENTION POND PLANS AND DETAILS

SHEET No.
CG302

©COPYRIGHT 2006 SMRT INC.

SCALE: NOT TO SCALE
CAD FILE: CG302-08016
PROJECT No. 08015
REF. SHEET: CG302
PM: RJD
A/E: WRF
DATE: 8-17-07
SHEET No. ADD-5
C-1

HNTB
2 THOMAS DRIVE
WESTBROOK, ME
04092

ARCHITECTURE ENGINEERING PLANNING
SMRT
144 Fore Street/P.O. Box 618 Portland, Maine 04104
tel. (207) 772-3846 / fax. (207) 772-3070

PROJECT: MAINE TURNPIKE AUTHORITY ADMINISTRATION BUILDING

SUBJECT: ADDITIONAL DETAIL/CG302 SEPARATION DETAIL @ LEDGE

CU101

Maine Turnpike Authority
Portland, Maine

Addendum No. 1
07-27-07

Catch Basins and Manholes

	Rim Elevation	Type
B-CB1	92.00	F-6
B-CB2	91.80	F-5
B-CB3	91.90	F-3
B-CB4	104.90	B1-C
B-CB5	104.90	F-5
CB1	89.00	60" Flat Top B1-C
CB2	91.50	60" Flat Top B1-C
CB3	92.50	60" Flat Top B1-C
CB4	97.50	60" Flat Top B1-C
CB5	100.75	Flat Top B1-C
CB6	102.75	B1-C
CB7	103.50	F-5
CB8	96.50	F-4
CB9	91.75	F-5
CB10	95.50	B1-C
CB11	100.50	B1-C
CB12	77.00	REBUILD EX. CB
CB13	86.50	B1-C
MH1	93.70	MANHOLE

Storm Drain Pipes

Pipe	Size	Length (ft.)	Inv. In	Inv. Out	Slope %
SD1	24"	104.20	84.00	83.50	0.48%
SD2	24"	134.60	86.35	84.25	1.56%
SD3	24"	66.00	87.00	86.50	0.76%
SD4	24"	152.00	92.00	87.50	2.96%
SD5	18"	149.50	96.50	92.25	2.86%
SD6	15"	77.80	98.75	96.75	2.57%
SD7	12"	113.60	87.50	85.25	2.00%
SD8	12"	60.50	99.50	98.50	1.65%
SD9	18"	70.00	82.50	89.00	5.00%
SD10	12"	38.00	87.75	86.50	3.29%
SD11	15"	25.00	90.50	87.50	12.00%
SD12	15"	20.00	95.50	93.00	12.50%
SD13	15"	26.50	75.28	73.00	1.00%
SD14	18"	54.00	80.30	79.00	2.41%
SD15	18"	36.00	83.30	82.00	3.61%
BSD1	12"	157.00	85.70	84.00	1.08%
BSD2	12"	65.00	87.00	86.00	1.52%
BSD3	12"	58.00	100.90	100.60	0.52%
BSD4	12"	86.00	97.50	92.22	6.00%
BSD5	12"	78.00	89.60	88.50	1.79%
BSD6	12"	18.00	87.80	86.65	6.39%
BSD7	6"	145.00	84.50	83.50	0.70%

Culverts

Pipe	Size	Length (ft.)	Inv. In	Inv. Out	Slope %
C1	18"	68.00	88.00	84.00	5.88%
C2	18"	20.00	98.50	98.00	2.50%
C3	18"	24.00	94.50	91.00	14.58%
C4	18"	55.00	91.00	88.50	4.55%
C5	24"	40.00	88.25	87.00	3.13%

06016

BSD6	12"	18	90.2	87.65	3.67%
BSD7	6"	145	84.5	83.5	0.70%
Culverts					
Pipe	Size	Length (ft.)	Inv. In	Inv. Out	Slope %
C1	18"	68	88	84	5.88%
C2	18"	16	98.5	98	3.13%
C3	18"	24	94.5	91	14.58%
C4	18"	55	91	88.5	4.55%
C5	24"	40	88.25	87	3.13%

NOTES:
1. SEE SEWER PLAN AND PROFILE FOR ADDITIONAL DETAILS.

2. IRRIGATION TO BE PROVIDED BY OTHERS. CONTRACTOR TO COORDINATE LOCATION OF SLEEVES FOR IRRIGATION LINES UNDER PAVEMENTS WITH IRRIGATION CONTRACTOR PRIOR TO PLACEMENT OF PAVING.

3. SEE SHEET ES101, ELECTRICAL SITE PLAN FOR ADDITIONAL REQUIREMENTS, INCLUDING SITE LIGHTING.

CROSS HATCHING DENOTES AREAS COVERED WITH PYRAMAT HPTRM

Scale: 1"=50'
0' 25' 50' 100'

PREPARED BY: HNTB
HNTB CORP.
2 THOMAS DRIVE
WESTBROOK, ME
04092

SMRT
ARCHITECTURE ENGINEERING PLANNING
SMRT
144 Fore Street P.O. Box 618
Portland, Maine 04104
tel. (207) 772-3846
fax. (207) 772-1070

STATE OF MAINE
ROLAND A. LAVALLEE
No. 9462
LICENSED PROFESSIONAL ENGINEER

PROJECT TITLE:
MAINE TURNPIKE AUTHORITY
ADMINISTRATION BUILDING
PORTLAND, MAINE

ISSUED FOR BIDDING/CONSTRUCTION
7-9-07

REV	DESCRIPTION	DATE
4	DOCS FOR OWNER REVIEW	6-11-07
3	ISSUED FOR CITY REVIEW	5-03-07
2	100% OWNER REVIEW	3-23-07
1	ISSUED FOR PERMITTING	2-09-07
0	PRE-SUBMITTAL	1-16-07

GRAPHIC SCALE: 0" 1"


SCALE:	AS NOTED
PROJECT MANAGER:	GAB
JC/DRAWN BY:	MPC
A/E OF RECORD:	GAB
CAD FILE:	X
PROJECT NO:	2007.07
DATE:	01/07

SHEET TITLE: UTILITIES PLAN

SHEET No. CU101

AS BUILT
Owner Copy

© COPYRIGHT 2006 SMRT INC

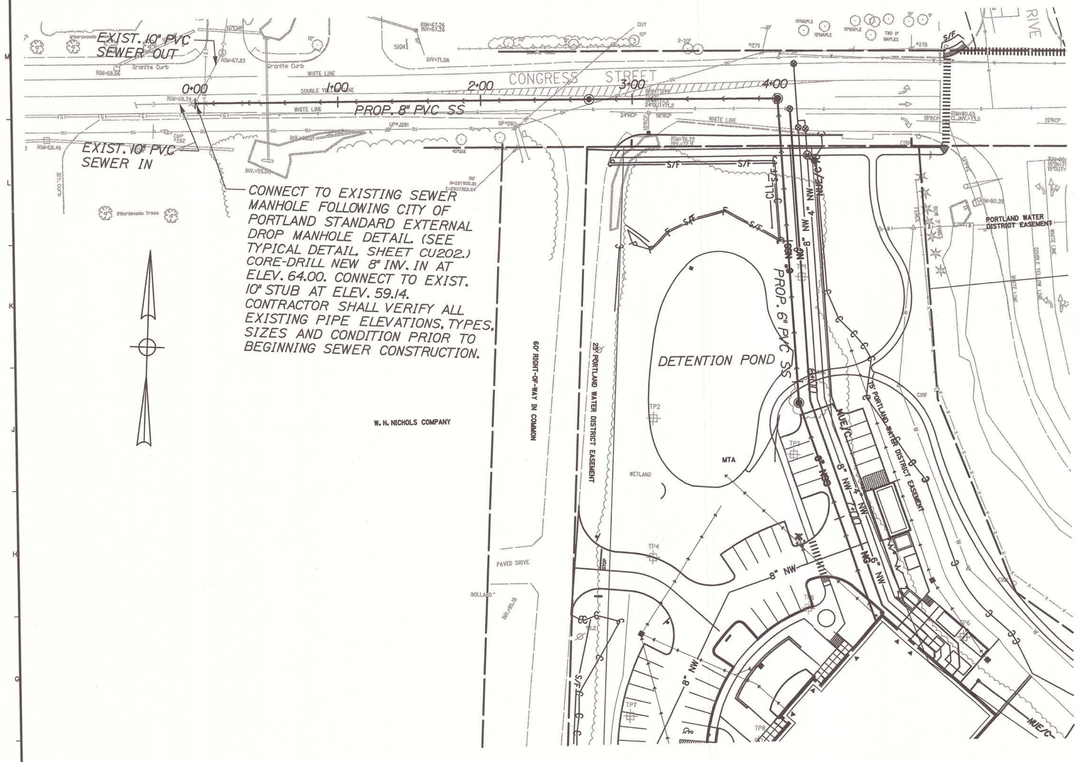

PLAN
1" = 50'

GENERAL NOTES FOR SEWERAGE CONSTRUCTION:

1. LOCATION OF ALL EXISTING UTILITIES ARE APPROXIMATE.

2. IT SHALL BE THE CONTRACTOR'S RESPONSIBILITY TO HAVE ALL THE UTILITIES LOCATE THEIR FACILITIES PRIOR TO THE START OF CONSTRUCTION.

3. PRIOR TO THE BEGINNING OF CONSTRUCTION, THE CONTRACTOR SHALL SECURE A STREET OPENING PERMIT FROM THE PORTLAND PUBLIC WORKS DEPARTMENT.

4. EXISTING PAVEMENT SHALL BE SAW CUT AND BUTTED TO THE NEW PAVEMENT. NO FEATHERING OF PAVEMENT WILL BE PERMITTED. THIS WORK SHALL BE CONSIDERED INCIDENTAL TO THE INSTALLATION OF SEWER PIPE IN THAT AREA. SEE TRENCH DETAILS ON SHEET CU202.

5. EXISTING DRAINAGE STRUCTURES SHALL NOT BE DISTURBED UNLESS OTHERWISE NOTED.

6. BEFORE CONNECTING NEW PIPES TO AN EXISTING SEWER LINE, THE CONTRACTOR SHALL NOTIFY THE SEWER MAINTENANCE DIVISION OF THE PORTLAND PUBLIC WORKS DEPARTMENT. NO WORK SHALL BE DONE WITHOUT THEIR APPROVAL.


7. THE CONTRACTOR SHALL BE RESPONSIBLE FOR REPAIRING ANY TRENCH PAVEMENT THAT HAS EXPERIENCED EXCESSIVE SETTLEMENT, CRACKING, OR OPENING OF JOINTS. REPAIRS MAY INCLUDE OVERLAY, REMOVAL OF UNACCEPTABLE MATERIALS, COMPLETE REPLACEMENT, JOINT SEALING, OR REBUTTING PAVEMENT AS REQUIRED. THIS WORK MAY BE NECESSARY AFTER FINAL ACCEPTANCE OF WORK OR PRIOR TO THE END OF THE ONE YEAR GUARANTEE. THIS WORK SHALL BE AT THE CONTRACTOR'S EXPENSE.

8. ALL MANHOLE FRAMES SHALL BE SUPPLIED WITH SOLID MANHOLE COVERS; SEE STANDARD DETAILS.


9. NO ADDITIONAL PAYMENT WILL BE MADE FOR THE REMOVAL OF EXISTING PIPES.

10. PROPOSED RIM ELEVATIONS SHOWN ARE INTERPOLATED FROM PROPOSED AND EXISTING GRADING INFORMATION. ACTUAL RIM ELEVATIONS SHALL BE BASED ON FINAL FIELD GRADING. ULTIMATE BUILDING ELEVATIONS AND RELATIVE POSITION OF RIM AS SHOWN ON THE DETAILS.

11. LOCATION OF PROPOSED UTILITIES SHALL BE IN ACCORDANCE WITH THE CITY OF PORTLAND STREET DESIGN STANDARDS, AND ALL APPLICABLE INDUSTRY/UTILITY CODES.

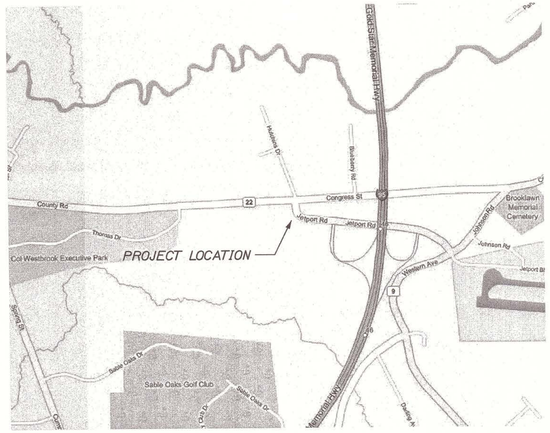

LOCUS MAP

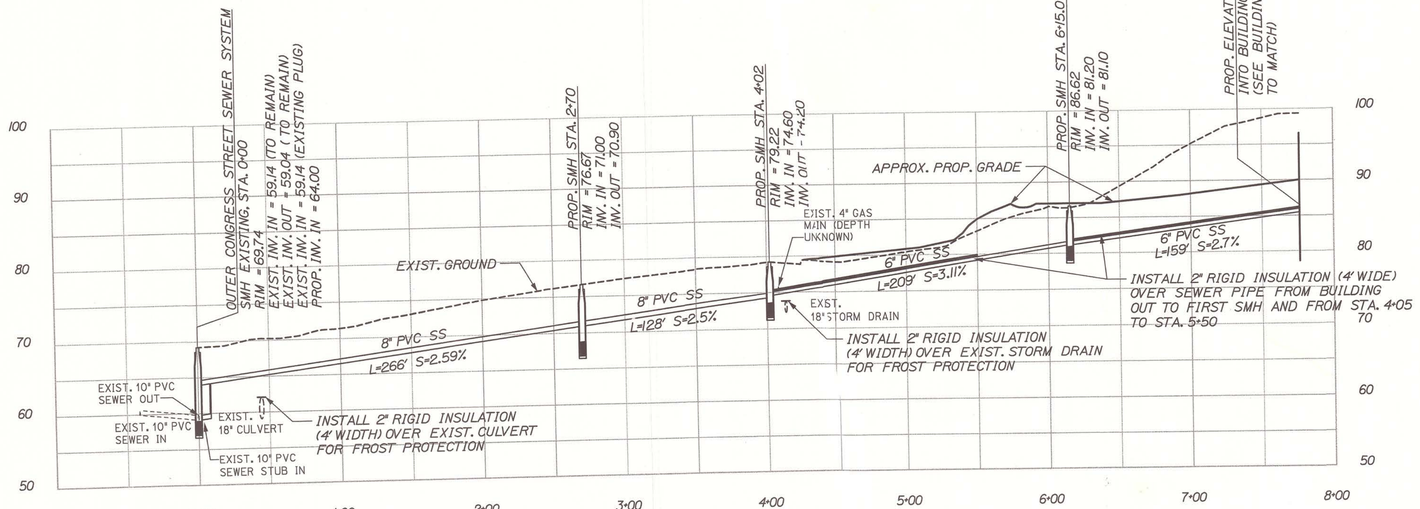

PROFILE
SCALE V: 1" = 10'
SCALE H: 1" = 50'

AS BUILT
Owner Copy

PREPARED BY:
HNTB

HNTB CORP.
ONE THOMAS DRIVE
WESTBROOK, ME
04092

SMRT
ARCHITECTURE ENGINEERING PLANNING
SMRT
144 Fore Street/P.O. Box 618
Portland, Maine 04104
tel. (207) 772-3846
fax. (207) 772-1070

STATE OF MAINE
ROLAND A. LAVALLEE
No. 9482
REGISTERED PROFESSIONAL ENGINEER
CIVIL

PROJECT TITLE:
MAINE TURNPIKE AUTHORITY
ADMINISTRATION BUILDING
PORTLAND, MAINE

ISSUED FOR BIDDING/CONSTRUCTION
7-9-07

REV	DESCRIPTION	DATE
3	DOCS FOR OWNER REVIEW	6-11-07
2	ISSUED FOR CITY REVIEW	5-03-07
1	100% OWNER REVIEW	3-23-07
0	ISSUED FOR PERMITTING	1-16-07


GRAPHIC SCALE: 0" 1"

SCALE:	AS NOTED
PROJECT MANAGER:	GAB
JC/DRAWN BY:	MPC
A/E OF RECORD:	GAB
CAD FILE:	X
PROJECT NO:	2007.07
DATE:	01/07

SHEET TITLE:
SEWER PLAN AND PROFILE


SHEET No.
CU201

©COPYRIGHT 2006 SMRT INC.

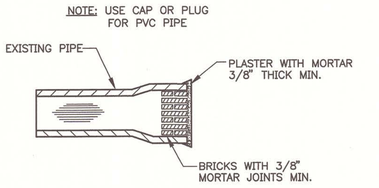


1 MASONRY PLUG DETAIL

N.T.S.

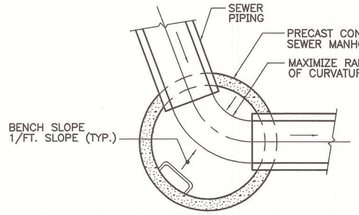

PLAN SECTION

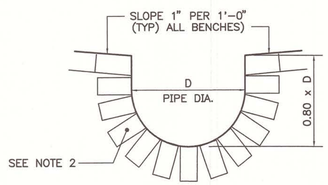


CHANNEL SECTION

NOTES:

1. CHANNEL SHALL BE SMOOTH, WITH UNIFORM SECTIONS, RADIUS AND SLOPE.
2. CHANNEL TO BE INVERTED ARCH FORMED FROM SEWER BRICK PER ASTM C32, GRADE SM.

2 MANHOLE INVERT CHANNEL

N.T.S.

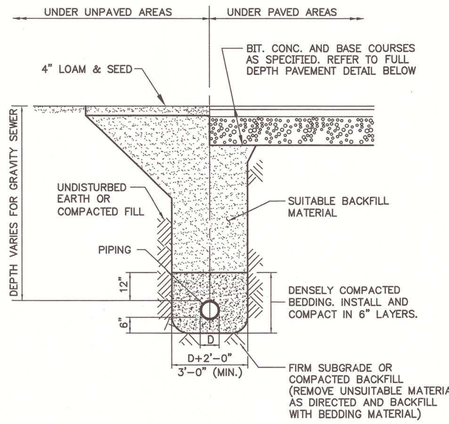

NOTES:


1. GRANULAR BEDDING SHALL BE COMPACTED TO A MINIMUM 95% STANDARD PROCTOR DENSITY. USE HAND TAMPERS OR VIBRATORY COMPACTORS.
2. FILTER FABRIC SHALL BE INSTALLED AGAINST THE TRENCH WALLS IN THE HAUNCHING AND BEDDING ZONES WHEN FINE SANDS, SILT, CLAY, OR ORGANIC MATERIALS ARE ENCOUNTERED AT THE TRENCH BOTTOM.
3. CONTRACTOR SHALL SHORE TRENCH SIDES WHEN REQUIRED OR AS ORDERED BY THE ENGINEER.

3 PIPE TRENCH
TYPICAL SECTION


N.T.S.

NOTE:

EXISTING MANHOLE SHALL BE CORE DRILLED FOR PIPE INSTALLATION UNLESS PLUG EXISTS. THE NEW OPENING MUST THEN BE SEALED AND MADE WATERTIGHT BOTH INSIDE AND OUTSIDE THE STRUCTURE.

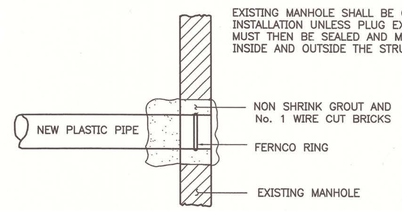


NEW PIPE INTO EXISTING STRUCTURE

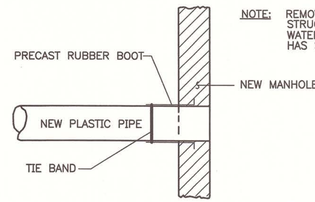

NEW CONSTRUCTION


4 PIPE CONNECTION DETAIL

N.T.S.

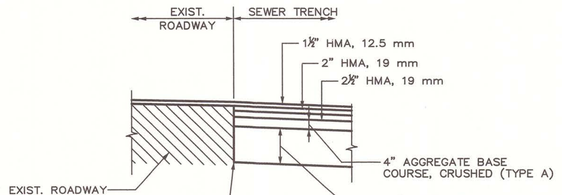

6 CONGRESS STREET TRENCH REPAIR DETAIL
TYPICAL SECTION

N.T.S.

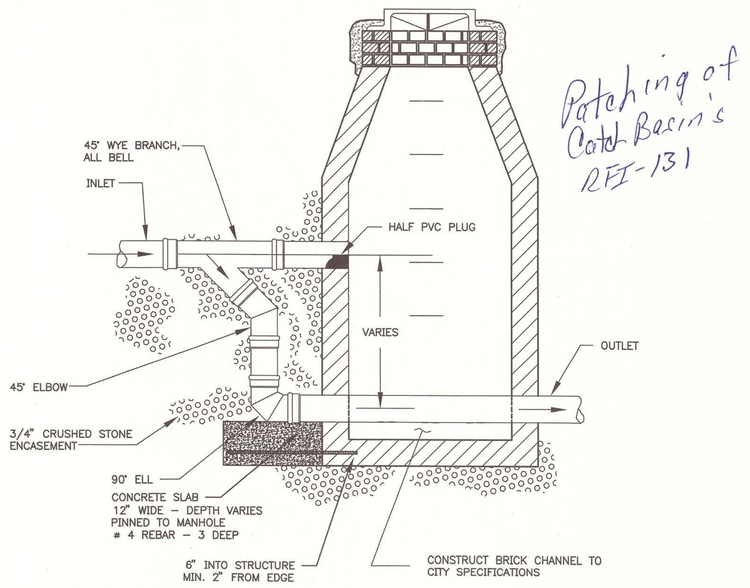

Patching of Catch Basins RFI-131

5 TYPICAL OUTSIDE DROP MANHOLE
TYPICAL SECTION

N.T.S.

AS BUILT
Owner Copy

PREPARED BY:
HNTB
HNTB CORP.
2 THOMAS DRIVE
WESTBROOK, ME
04092

SMRT
ARCHITECTURE ENGINEERING PLANNING
SMRT
144 Fore Street/P.O. Box 618
Portland, Maine 04104
tel. (207) 772-3846
fax. (207) 772-1070

STATE OF MAINE
ROLAND A LAVALLEE
No. 6462
REGISTERED PROFESSIONAL ENGINEER

PROJECT TITLE:
MAINE TURNPIKE AUTHORITY
ADMINISTRATION BUILDING
PORTLAND, MAINE

ISSUED FOR BIDDING/CONSTRUCTION
7-9-07

REV	DESCRIPTION	DATE
1	ISSUED FOR CITY REVIEW	5-03-07

GRAPHIC SCALE: 0" 1"

SCALE:	AS NOTED
PROJECT MANAGER:	GAB
JC/DRAWN BY:	MPC
A/E OF RECORD	GAB
CAD FILE:	X
PROJECT NO:	2007.07
DATE:	05/07

SHEET TITLE:
SEWER DETAILS
SHEET 1

SHEET No. CU202

© COPYRIGHT 2007 SMRT INC.


M:\JOBS\09009\967 BUILDINGS AND MAINTENANCE AREAS\041 NEW ADMINISTRATION BUILDING\CAD\DETAIL SHEETS.DWG 06/29/07 13:35


Patching Catch Basin S-131 RFI


NOTE:
MANHOLE CHANNELS REQUIRING CHANGE OF ALIGNMENT, TO BE BUILT ON SMOOTH RADIUS. CHANNEL TO BE SHAPED TO ACCEPT ADDITIONAL INLET PIPES.


SEWER MANHOLE LOCATIONS


MANHOLE	COORDINATES	
	NORTHING	EASTING
SMH 1 (EXISTING)	297953.5395	2907095.4069
SMH 2	297965.2958	2907371.0969
SMH 3	297970.3011	2907503.0420
SMH 4	297758.3340	2907525.5049

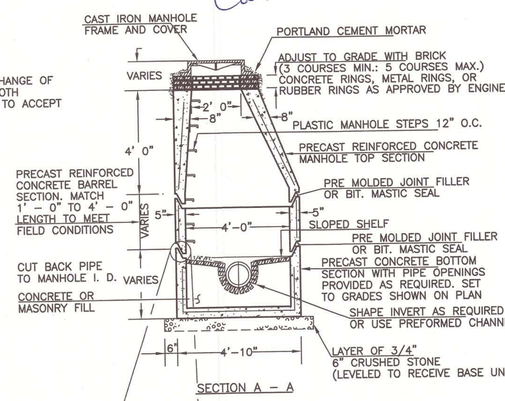

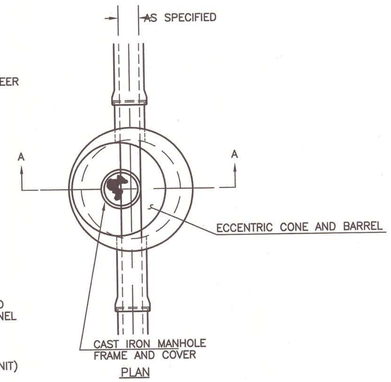


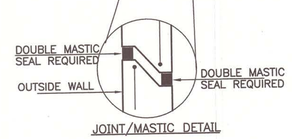

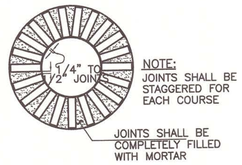


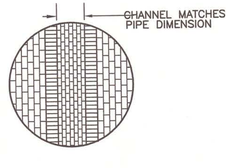



1 PRECAST CONCRETE SEWER MANHOLE
TYPICAL SECTION
N.T.S.

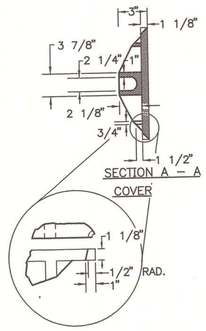




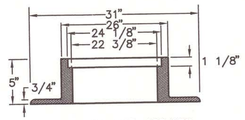

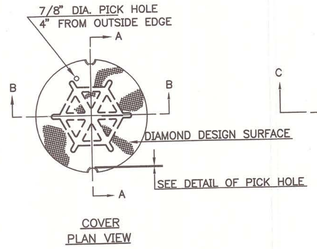

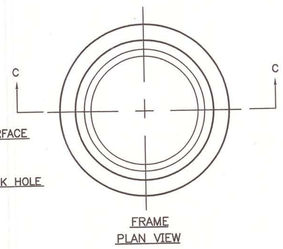

2 TYPE "A" CAST IRON MANHOLE COVER AND FRAME
N.T.S.

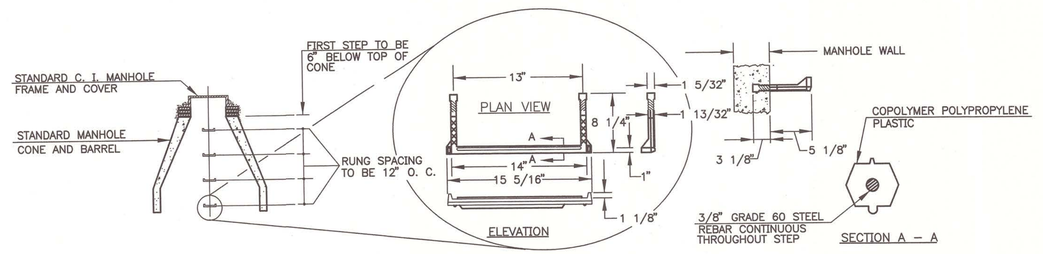

3 PLASTIC MANHOLE STEPS
N.T.S.

AS BUILT
Owner Copy

PREPARED BY:
HNTB
HNTB CORP.
2 THOMAS DRIVE
WESTBROOK, ME
04092

ARCHITECTURE ENGINEERING PLANNING
SMRT
144 Fore Street P.O. Box 618
Portland, Maine 04104
tel. (207) 772-3846
fax. (207) 772-1070

STATE OF MAINE
ROLAND A. LAVALLEE
No. 6462
REGISTERED PROFESSIONAL ENGINEER
Roland A. Lavallee

PROJECT TITLE:
MAINE TURNPIKE AUTHORITY
ADMINISTRATION BUILDING
PORTLAND, MAINE

ISSUED FOR BIDDING/CONSTRUCTION
7-9-07

REV	DESCRIPTION	DATE
1	ISSUED FOR CITY REVIEW	5-03-07


GRAPHIC SCALE:
0" 1"

SCALE:	AS NOTED
PROJECT MANAGER:	GAB
JC/DRAWN BY:	MPC
A/E OF RECORD	GAB
CAD FILE:	X
PROJECT NO:	2007.07
DATE:	05/07

SHEET TITLE:
SEWER DETAILS
SHEET 2


SHEET NO.
CU203
COPYRIGHT 2007 SMRT INC.

M:\JOBS\09009\967 BUILDINGS AND MAINTENANCE AREAS\041 NEW ADMINISTRATION BUILDING\CAD\DETAIL SHEETS.DWG 06/29/07 13:35

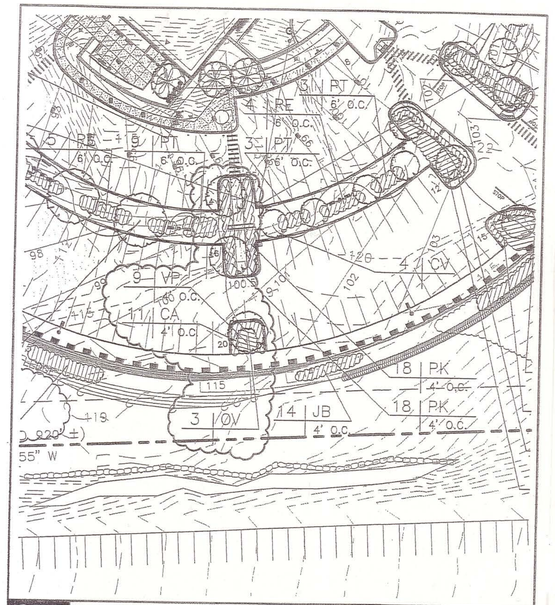


SMRT	ARCHITECTURE ENGINEERING PLANNING SMRT 144 Fore Street/P.O.Box 618 PORTLAND, MAINE 04104 tel. (207) 772-3846 / fax. (207) 772-1070
PROJECT:	MAINE TURNPIKE AUTHORITY ADMINISTRATION BUILDING
SUBJECT:	PLANT CLARIFICATION AREA 1

SCALE:	1" = 40'
CAD FILE:	LP101-06016
PROJECT No.	06016
REF. SHEET:	LP101
PM: SLB	ADDENDUM No. ADD-4
A/E: MGJ	SHEET No. L-1
DATE: 8-10-07	© COPYRIGHT 2007 SMRT INC.

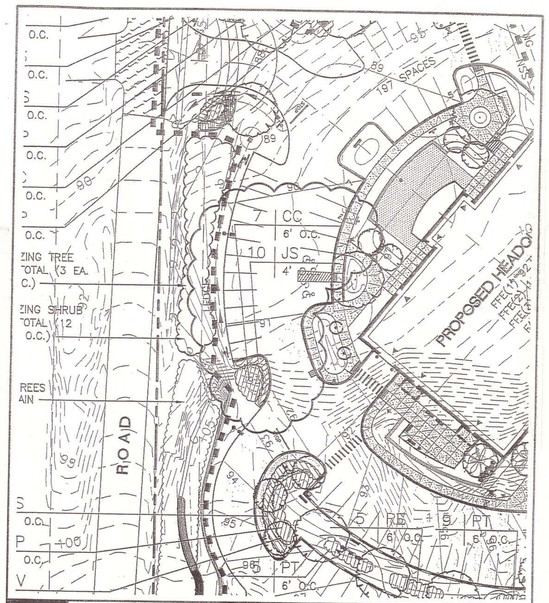


SMRT	ARCHITECTURE ENGINEERING PLANNING SMRT 144 Fore Street/P.O.Box 618 PORTLAND, MAINE 04104 tel. (207) 772-3846 / fax. (207) 772-1070
PROJECT:	MAINE TURNPIKE AUTHORITY ADMINISTRATION BUILDING
SUBJECT:	PLANT CLARIFICATION AREA 2

SCALE:	1" = 40'
CAD FILE:	LP101-06016
PROJECT No.	06016
REF. SHEET:	LP101
PM: SLB	ADDENDUM No. ADD-4
A/E: MGJ	SHEET No. L-2
DATE: 8-10-07	© COPYRIGHT 2007 SMRT INC.

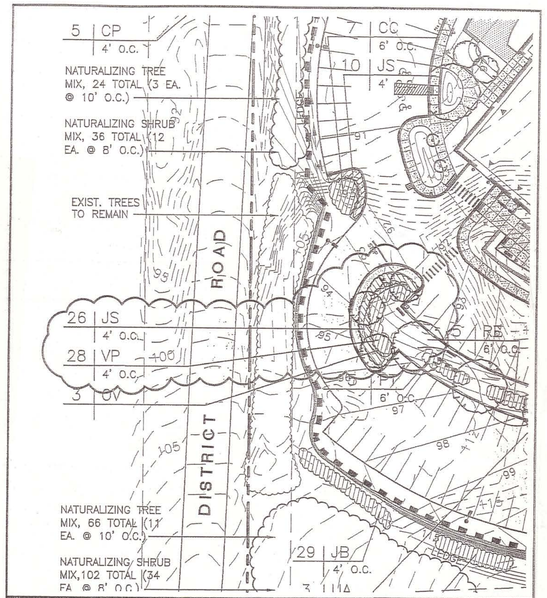


SMRT	ARCHITECTURE ENGINEERING PLANNING SMRT 144 Fore Street/P.O.Box 618 PORTLAND, MAINE 04104 tel. (207) 772-3846 / fax. (207) 772-1070
PROJECT:	MAINE TURNPIKE AUTHORITY ADMINISTRATION BUILDING
SUBJECT:	PLANT CLARIFICATION AREA 3

SCALE:	1" = 40'
CAD FILE:	LP101-06016
PROJECT No.	06016
REF. SHEET:	LP101
PM: SLB	ADDENDUM No. ADD-4
A/E: MGJ	SHEET No. L-3
DATE: 8-10-07	© COPYRIGHT 2007 SMRT INC.

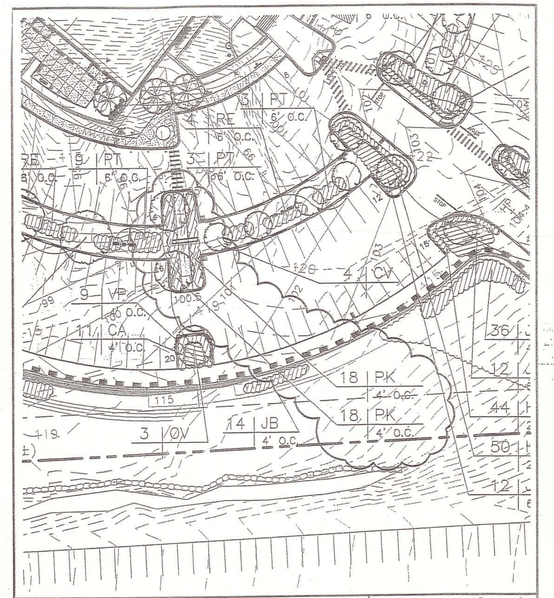


SMRT	ARCHITECTURE ENGINEERING PLANNING SMRT 144 Fore Street/P.O.Box 618 PORTLAND, MAINE 04104 tel. (207) 772-3846 / fax. (207) 772-1070
PROJECT:	MAINE TURNPIKE AUTHORITY ADMINISTRATION BUILDING
SUBJECT:	PLANT CLARIFICATION AREA 4

SCALE:	1" = 40'
CAD FILE:	LP101-06016
PROJECT No.	06016
REF. SHEET:	LP101
PM: SLB	ADDENDUM No. ADD-4
A/E: MGJ	SHEET No. L-4
DATE: 8-10-07	© COPYRIGHT 2007 SMRT INC.

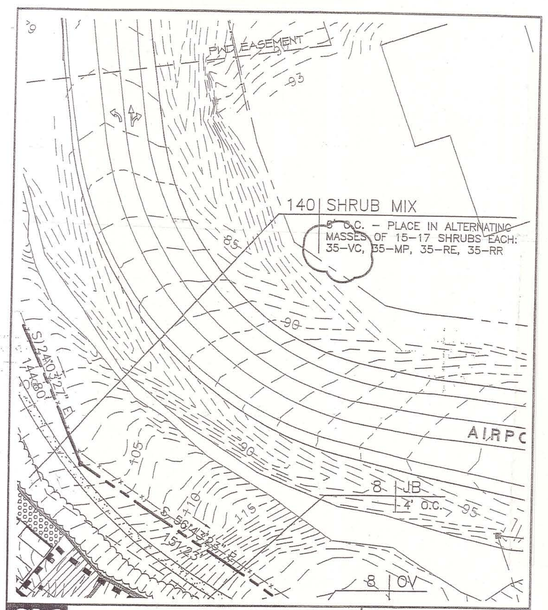

SMRT	ARCHITECTURE ENGINEERING PLANNING SMRT 144 Fore Street/P.O.Box 618 PORTLAND, MAINE 04104 tel. (207) 772-3846 / fax. (207) 772-1070
PROJECT:	MAINE TURNPIKE AUTHORITY ADMINISTRATION BUILDING
SUBJECT:	PLANT CLARIFICATION AREA 5

SCALE:	1" = 40'
CAD FILE:	LP101-06016
PROJECT No.	06016
REF. SHEET:	LP101
PM: SLB	ADDENDUM No. ADD-4
A/E: MGJ	SHEET No. L-5
DATE: 8-10-07	© COPYRIGHT 2007 SMRT INC.

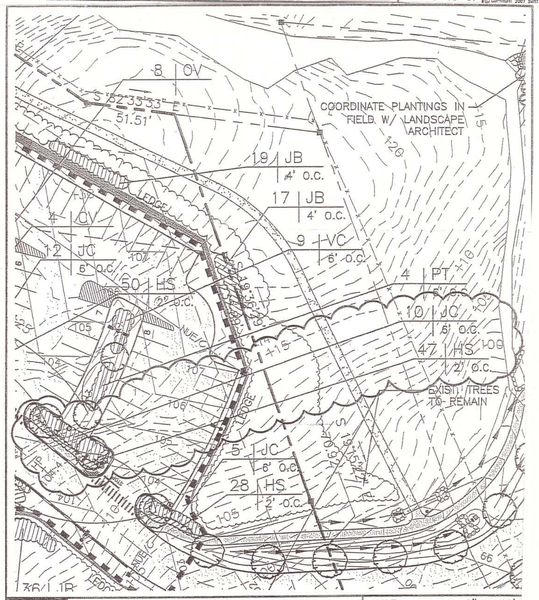

SMRT	ARCHITECTURE ENGINEERING PLANNING SMRT 144 Fore Street/P.O.Box 618 PORTLAND, MAINE 04104 tel. (207) 772-3846 / fax. (207) 772-1070
PROJECT:	MAINE TURNPIKE AUTHORITY ADMINISTRATION BUILDING
SUBJECT:	PLANT CLARIFICATION AREA 6

SCALE:	1" = 40'
CAD FILE:	LP101-06016
PROJECT No.	06016
REF. SHEET:	LP101
PM: SLB	ADDENDUM No. ADD-4
A/E: MGJ	SHEET No. L-6
DATE: 8-10-07	© COPYRIGHT 2007 SMRT INC.

LANDSCAPING NOTES:


1. PLANTING AREA WITHIN LIMITS SHOWN TO BE IRRIGATED. CONTRACTOR TO COORDINATE LOCATION OF SLEEVES FOR IRRIGATION LINES UNDER PAVEMENTS WITH IRRIGATION CONTRACTOR PRIOR TO PLACEMENT OF PAVING.

   LIMIT OF IRRIGATION

2. IN LEDGE CUTS, ALL PLANTING BEDS TO BE 3' DEEP, MIN. IN AREAS ADJACENT TO BUILDING NOT IN LEDGE CUTS, PLANTING BEDS TO BE 2' DEEP, MIN.

SMRT	ARCHITECTURE ENGINEERING PLANNING SMRT 144 Fore Street/P.O.Box 618 PORTLAND, MAINE 04104 tel. (207) 772-3846 / fax. (207) 772-1070
PROJECT:	MAINE TURNPIKE AUTHORITY ADMINISTRATION BUILDING
SUBJECT:	IRRIGATION NOTATION CLARIFICATION

SCALE:	1" = 40'
CAD FILE:	LP101-06016
PROJECT No.	06016
REF. SHEET:	LP101
PM: SLB	ADDENDUM No. ADD-4
A/E: MGJ	SHEET No. L-7
DATE: 8-10-07	© COPYRIGHT 2007 SMRT INC.

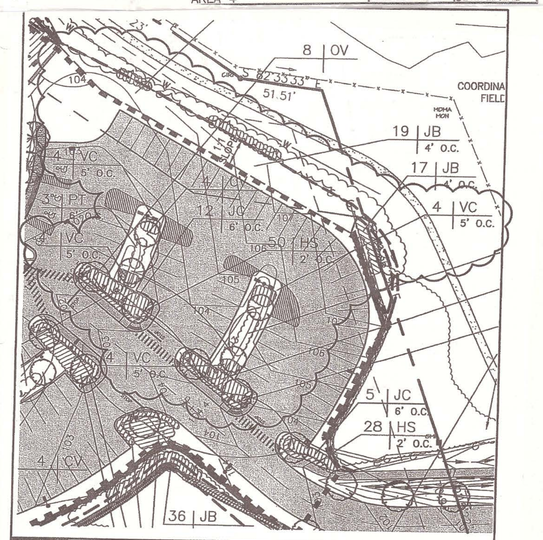

SMRT	ARCHITECTURE ENGINEERING PLANNING SMRT 144 Fore Street/P.O.Box 618 PORTLAND, MAINE 04104 tel. (207) 772-3846 / fax. (207) 772-1070
PROJECT:	MAINE TURNPIKE AUTHORITY ADMINISTRATION BUILDING
SUBJECT:	PARKING LOT @ LEDGE PLANTING RECONFIGURATION

SCALE:	1" = 40'
CAD FILE:	LP101-06016
PROJECT No.	06016
REF. SHEET:	LP101
PM: SLB	ADDITIONAL SHEET No. CCD-1
A/E: MGJ	SHEET No. L-1
DATE:11-30-07	© COPYRIGHT 2007 SMRT INC.

CONGRESS STREET

CONGRESS STREET

EXIST. TREES TO REMAIN

25' UTILITY EASEMENT

PORTLAND WATER DISTRICT EASEMENT

COORDINATE PLANTINGS IN FIELD W/ LANDSCAPE ARCHITECT

PWD EASEMENT

5 | VL | 11' O.C.
27 | MP | 8' O.C.
1 | LD | AS SHOWN
47 | CP | 4' O.C.
6 | IVw | 6' O.C.
2 | IVs | one each group
7 | AR
3 | VC
58 | CP
5 | UA
12 | AV | 5' O.C.
12 | JS | 4' O.C.
36 | HS | 2' O.C.
5 | CP | 4' O.C.
27 | VC | 4' O.C.
5 | CP | 4' O.C.

15 | CP | 4' O.C.
1 | LD | AS SHOWN

140 | SHRUB MIX
6' O.C. – PLACE IN ALTERNATING MASSES OF 15–17 SHRUBS EACH: 35–UC, 35–MP, 35–RE, 35–RR

AIRPORT CONNECTOR ROAD

8 | JB | 4' O.C.

6 | LA | as shown
6 | RR | 6' O.C.
3 | JP | 5' O.C.

8 | OV

COORDINATE PLANTINGS IN FIELD W/ LANDSCAPE ARCHITECT

19 | JB | 4' O.C.
17 | JB | 4' O.C.
9 | VC | 6' O.C.
4 | PT | 6' O.C.
10 | JC | 6' O.C.
47 | HS | 2' O.C.
EXIST. TREES TO REMAIN
5 | JC | 6' O.C.
28 | HS | 2' O.C.

PROPOSED HEADQUARTERS

10 | JS | 4' O.C.
7 | VC | 6' O.C.
4 | CV
12 | JC | 6' O.C.
3 | PT | 6' O.C.
50 | HS | 2' O.C.
3 | PT | 6' O.C.
4 | RE | 6' O.C.
5 | RE | 6' O.C.
9 | PT | 6' O.C.
3 | PT | 6' O.C.
5 | PT | 6' O.C.
4 | CV
4' O.C.

DISTRICT ROAD

26 | JS | 4' O.C.
28 | VP | 4' O.C.
3 | OV

NATURALIZING TREE MIX, 24 TOTAL (3 EA. @ 10' O.C.)

NATURALIZING SHRUB MIX, 36 TOTAL (12 EA. @ 8' O.C.)

EXIST. TREES TO REMAIN

NATURALIZING TREE MIX, 66 TOTAL (11 EA. @ 10' O.C.)

NATURALIZING SHRUB MIX,102 TOTAL (34 EA. @ 8' O.C.)

29 | JB | 4' O.C.
3 | UA
25 | JB | 4' O.C.
3 | OV
14 | JB | 4' O.C.
18 | PK | 4' O.C.
18 | PK | 4' O.C.
36 | JB | 4' O.C.
12 | JC | 6' O.C.
44 | HS | 2' O.C.
50 | HS | 2' O.C.
12 | JC | 6' O.C.
22 | FE | 35' O.C.

See CCD-1 on approach to L-1

PLANT LEGEND

- DECIDUOUS SHADE TREE
- DECIDUOUS FLOWERING TREE
- EVERGREEN TREE
- SHRUB MASS
- PERENNIAL BED

Irrigation System - REI-107

REI-104 on Irrigation Line Sleeves under Pavement

LANDSCAPING NOTES:

1. IRRIGATION TO BE PROVIDED BY OTHERS. CONTRACTOR TO COORDINATE LOCATION OF SLEEVES FOR IRRIGATION LINES UNDER PAVEMENTS WITH IRRIGATION CONTRACTOR PRIOR TO PLACEMENT OF PAVING.

LIMIT OF IRRIGATION

2. IN LEDGE CUTS, ALL PLANTING BEDS TO BE 3' DEEP, MIN. IN AREAS ADJACENT TO BUILDING NOT IN LEDGE CUTS, PLANTING BEDS TO BE 2' DEEP, MIN.

SEE SK's L1-L7 OPP. PAGE FOR PLANT MATERIAL REQUIREMENTS

AS BUILT Owner Copy

Relocate Trees RFI-117

NORTH

Scale: 1"=40'

0' 20' 40' 80'

SMRT
ARCHITECTURE ENGINEERING PLANNING
SMRT
144 Fore Street/P.O. Box 618
Portland, Maine 04104
tel. (207) 772-3846
fax. (207) 772-1070

LICENSED LANDSCAPE ARCHITECT MARK G. JOHNSON NO. 1857 STATE OF MAINE

7-9-07

PROJECT TITLE:
MAINE TURNPIKE AUTHORITY
ADMINISTRATION BUILDING
PORTLAND, MAINE

ISSUED FOR BIDDING/CONSTRUCTION
7-9-07

REV	DESCRIPTION	DATE
0	BIDDING/CONSTRUCTION	7-9-07


GRAPHIC SCALE: 0" 1"

SCALE:	SHOWN
PROJECT MANAGER:	SLB
JC/DRAWN BY:	TCM/PAF
A/E OF RECORD:	MGJ
CAD FILE:	06016-LP101
PROJECT NO:	06016
DATE:	7-9-07

SHEET TITLE:
LANDSCAPE PLAN

SHEET No. LP101

©COPYRIGHT 2007 SMRT INC

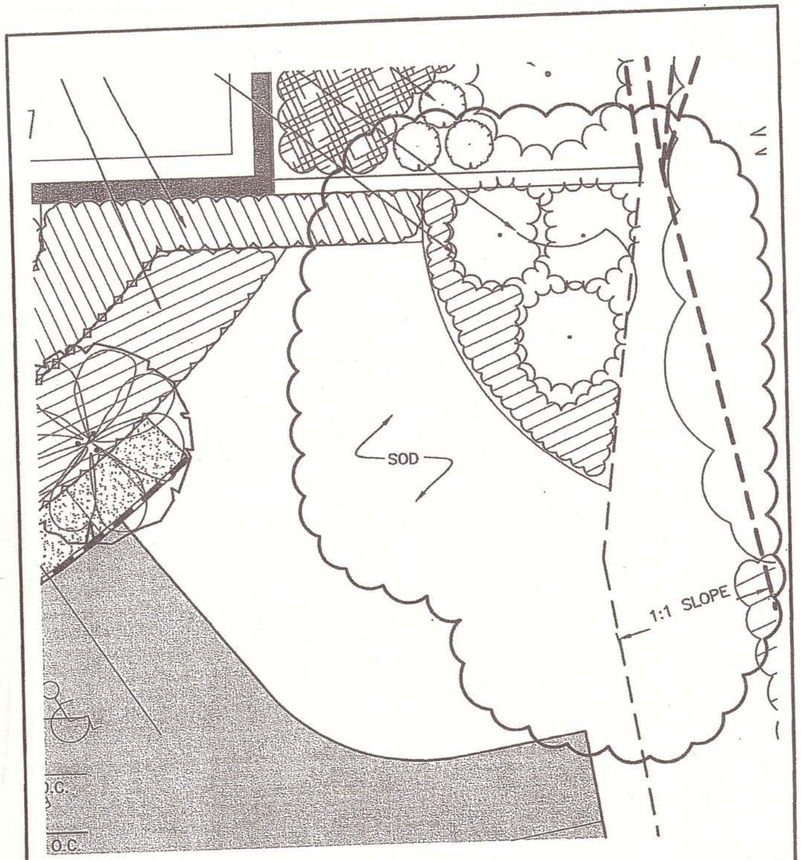

SMRT


ARCHITECTURE ENGINEERING PLANNING

SMRT
144 Fore Street/P.O.Box 618 PORTLAND, MAINE 04104
tel. (207) 772-3846 / fax. (207) 772-1070

PROJECT:	MAINE TURNPIKE AUTHORITY ADMINISTRATION BUILDING
SUBJECT:	PARKING LOT @ LEDGE PLANTING RECONFIGURATION

SCALE:	1" = 10'
CAD FILE:	LP201-06016
PROJECT No.	06016
REF. SHEET:	LP201
PM: SLB	SUPPLEMENTAL INSTRUCTION CCD-1
A/E: MGJ	SKETCH No. L-2
DATE:11-30-07	

© COPYRIGHT 2007 SMRT INC.

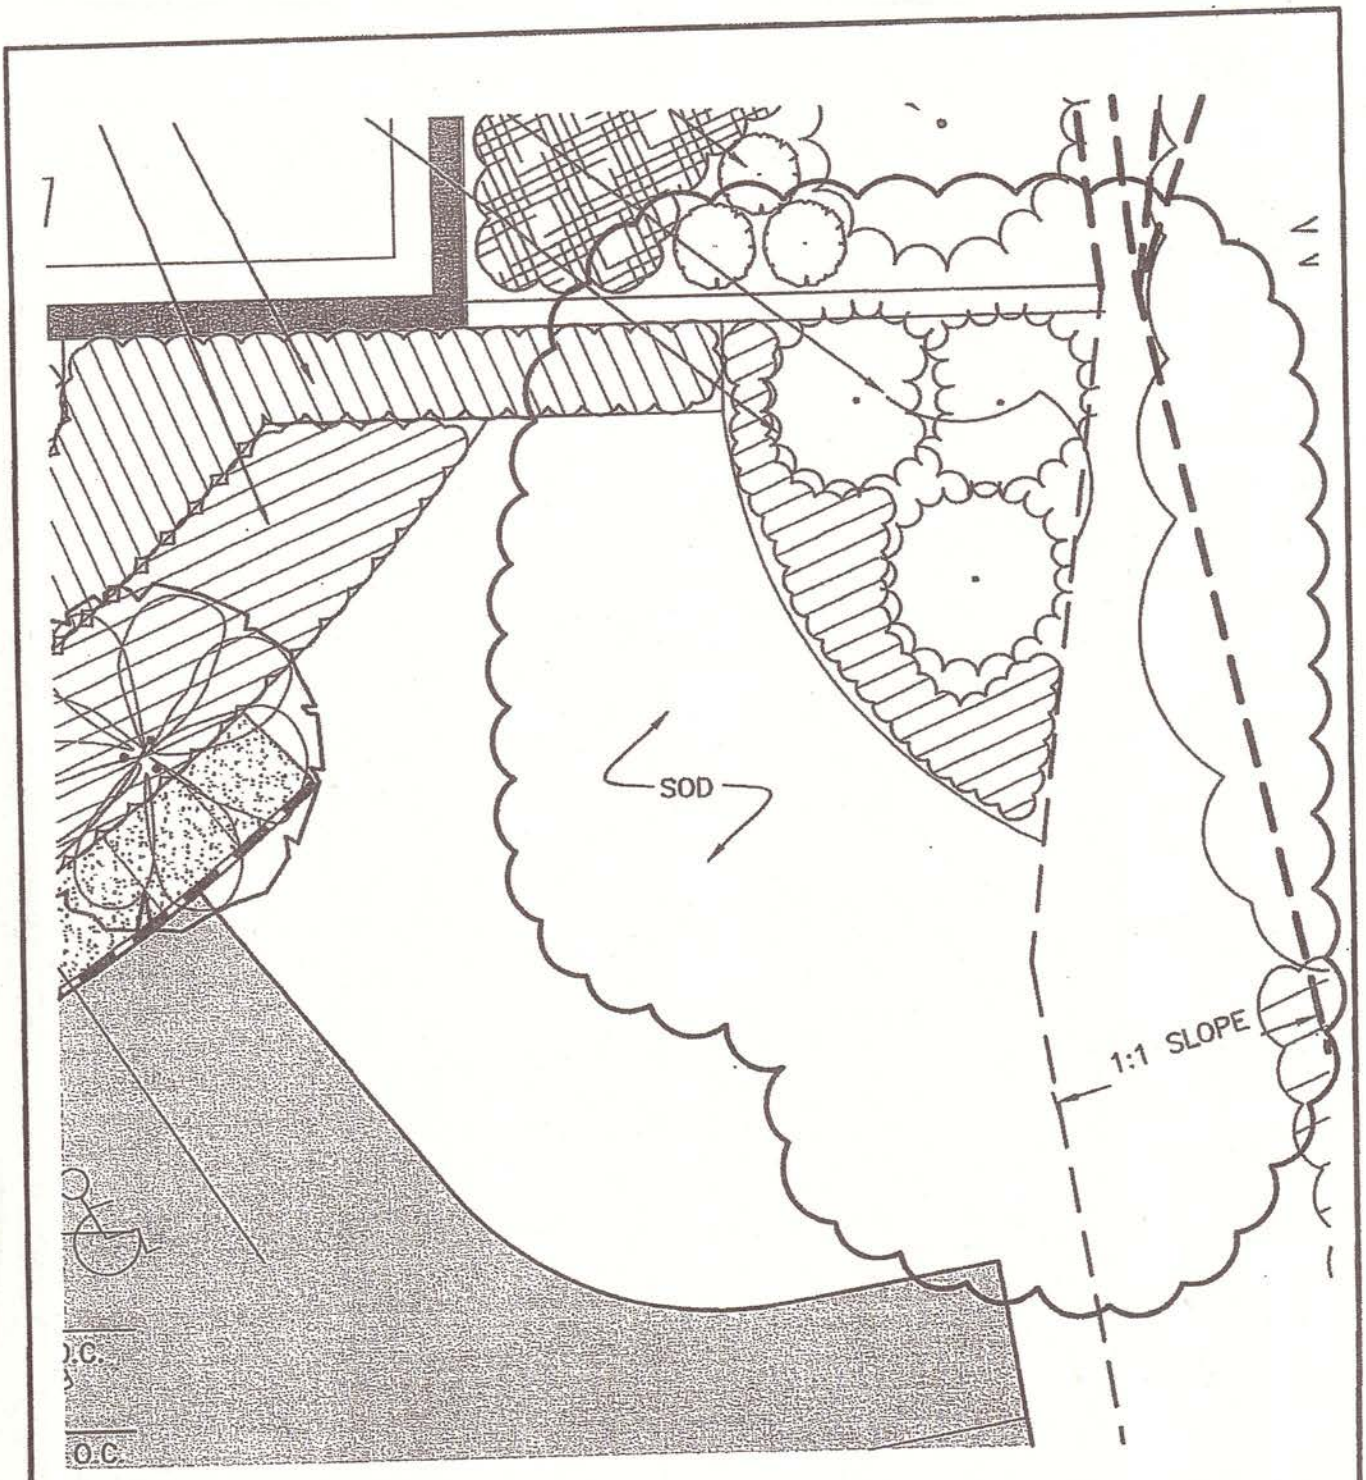

SMRT

ARCHITECTURE ENGINEERING PLANNING

SMRT
144 Fore Street/P.O.Box 618 PORTLAND, MAINE 04104
tel. (207) 772-3846 / fax. (207) 772-1070

SCALE:	1" = 10'
CAD FILE:	LP201-06016
PROJECT No.	06016
REF. SHEET:	LP201
PM: SLB	SUPPLEMENTAL INSTRUCTION CCD-1
A/E: MGJ	SKETCH No. L-2
DATE: 11-30-07	

PROJECT: MAINE TURNPIKE AUTHORITY ADMINISTRATION BUILDING

SUBJECT: PARKING LOT @ LEDGE PLANTING RECONFIGURATION

© COPYRIGHT 2007 SMRT INC.

52 | HE | 18" O.C.
3 | RK | 4' O.C.
3 | KT | 4' O.C.
6 | HT | 18" O.C.
6 | HA | 18" O.C.
3 | AA | 2' O.C.
7 | DC | 4' O.C.
17 | LM | 18" O.C.
3 | KT | 4' O.C.
6 | HT | 18" O.C.
6 | HA | 18" O.C.
3 | AA | 18" O.C.
27 | AS | 18" O.C.
3 | KT | 4' O.C.
3 | KT | 4' O.C.
6 | MS | 2.5' O.C.

3 | DC | 4' O.C.
1 | PA | 2' O.C.
6 | PV | 2.5' O.C.
10 | LS | 18" O.C.
8 | EE | 18" O.C.

8 | SF | 2.25' O.C.
6 | RT | 3' O.C.
2 | TO

1 | PA | 2' O.C.
6 | PV | 2.5' O.C.
10 | LS | 18" O.C.
8 | EE | 18" O.C.

1 | AV
2 | KT
1 | PO
100 | LG | 2.5' O.C.
3 | KT
3 | PM
14 | SI | 4' O.C.
22 | FC | 4' O.C.
22 | JS | 4' O.C.
3 | DC | 4' O.C.

20 | CA | 4' O.C.
1 | BP
20 | FC | 4' O.C.

SOD

11 | CA | 4' O.C.
13 | IS | 18" O.C.
44 | HE | 18" O.C.
3 | RW | 4' O.C.

5 | SF | 3' O.C.
18 | JS | 4' O.C.
2 | PS

2 | PS
11 | CA | 4' O.C.
13 | IS | 18" O.C.
44 | HE | 18" O.C.
3 | RW | 4' O.C.

SOD

SOD

see CCD #1 opposite page L-2

AS BUILT
Owner Copy

PLANT LEGEND

- DECIDUOUS SHADE TREE
- DECIDUOUS FLOWERING TREE
- EVERGREEN TREE
- SHRUB MASS
- PERENNIAL BED
- FERN
- ORNAMENTAL GRASS

NORTH

Scale: 1"=10'
0' 5' 10' 20'

SMRT
ARCHITECTURE ENGINEERING PLANNING
SMRT
144 Fore Street/P.O. Box 618
Portland, Maine 04104
tel.: (207) 772-3846
fax.: (207) 772-1070

LICENSED LANDSCAPE ARCHITECT
MARK G. JOHNSON
ANDOVER, MAINE

PROJECT TITLE:
MAINE TURNPIKE AUTHORITY
ADMINISTRATION BUILDING
PORTLAND, MAINE

ISSUED FOR BIDDING/CONSTRUCTION
7-9-07

REV	DESCRIPTION	DATE
0	BIDDING/CONSTRUCTION	7-9-07


GRAPHIC SCALE: 0" 1"

SCALE:	SHOWN
PROJECT MANAGER:	SLB
JC/DRAWN BY:	TCM/PAF
A/E OF RECORD:	MGJ
CAD FILE:	06016-LP201
PROJECT NO:	06016
DATE:	7-9-07

SHEET TITLE:
DETAIL LANDSCAPE PLAN

SHEET No.
LP201

© COPYRIGHT 2007 SMRT INC.

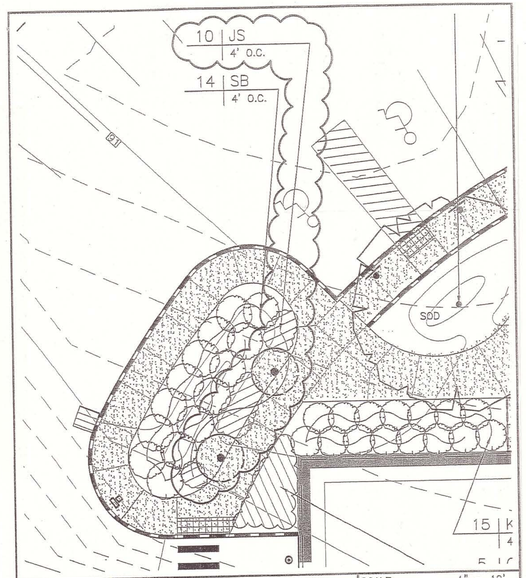

SMRT


ARCHITECTURE ENGINEERING PLANNING

SMRT
144 Fore Street/P.O.Box 618 PORTLAND, MAINE 04104
tel. (207) 772-3846 / fax. (207) 772-1070

PROJECT: MAINE TURNPIKE AUTHORITY
ADMINISTRATION BUILDING

SUBJECT: PLANT CLARIFICATION

SCALE:	1" = 10'
CAD FILE:	LP202-06016
PROJECT No.	06016
REF. SHEET:	LP202
PM: SLB	ADDENDUM No. ADD-4
A/E: MGJ	SHEET No. L-8
DATE: 8-10-07	

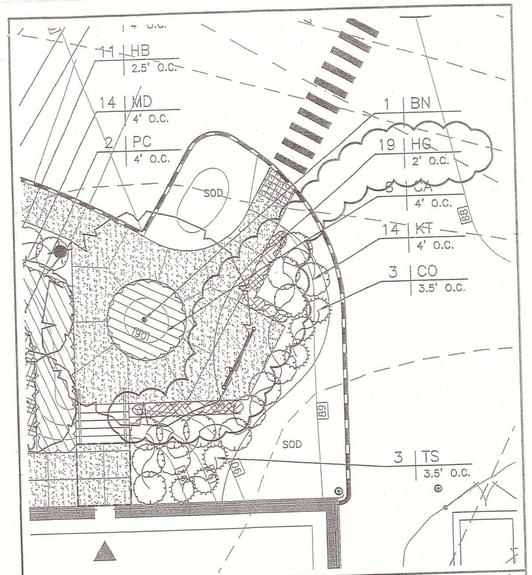

SMRT

ARCHITECTURE ENGINEERING PLANNING

SMRT
144 Fore Street/P.O.Box 618 PORTLAND, MAINE 04104
tel. (207) 772-3846 / fax. (207) 772-1070

PROJECT: MAINE TURNPIKE AUTHORITY
ADMINISTRATION BUILDING

SUBJECT: PLANT CLARIFICATION

SCALE:	1" = 10'
CAD FILE:	LP202-06016
PROJECT No.	06016
REF. SHEET:	LP202
PM: SLB	ADDENDUM No. ADD-4
A/E: MGJ	SHEET No. L-9
DATE: 8-10-07	

PLANT LEGEND

- DECIDUOUS SHADE TREE
- DECIDUOUS FLOWERING TREE
- EVERGREEN TREE
- SHRUB MASS
- PERENNIAL BED
- FERN
- ORNAMENTAL GRASS

NOTE: LOAM AND SEED ALL AREAS NOT OTHERWISE DESIGNATED FOR PLANTING

10 | JS | 4' o.c.
14 | SB | 4' o.c.

3 | RL | 4' o.c.
14 | RK | 4' o.c.
14 | MD | 4' o.c.
11 | HB | 2.5' o.c.
1 | BN
2 | PC
4 | HA | 4' o.c.

15 | KT | 4' o.c.
5 | CA | 4' o.c.

12 | KT | 4' o.c.
3 | RL | 4' o.c.
4 | HA | 4' o.c.
11 | HB | 2.5' o.c.
14 | MD | 4' o.c.
2 | PC | 4' o.c.

1 | BN
16 | HG | 4' o.c.
6 | CA | 4' o.c.
14 | KT | 4' o.c.
3 | CO | 3.5' o.c.

3 | TS | 3.5' o.c.

SOD

ALUMINUM LANDSCAPE EDGE

SEE SK'S L-8, 9 OPP. PAGE FOR PLANT MATERIAL REQ'MNTS

AS BUILT
Owner Copy

Scale: 1"=10'
0' 5' 10' 20'

SMRT
ARCHITECTURE ENGINEERING PLANNING
SMRT
144 Fore Street P.O. Box 618
Portland, Maine 04104
tel. (207) 772-3846
fax. (207) 772-1070

LICENSED LANDSCAPE ARCHITECT
MARK G. JOHNSON
No. 457
STATE OF MAINE
7-9-07

NORTH

PROJECT TITLE:
MAINE TURNPIKE AUTHORITY
ADMINISTRATION BUILDING
PORTLAND, MAINE

ISSUED FOR BIDDING/CONSTRUCTION
7-9-07

REV	DESCRIPTION	DATE
0	BIDDING/CONSTRUCTION	7-9-07

GRAPHIC SCALE: 0" 1"

SCALE:	SHOWN
PROJECT MANAGER:	SLB
JC/DRAWN BY:	TCM/PAF
A/E OF RECORD:	MGJ
CAD FILE:	06016-LP202
PROJECT NO:	06016
DATE:	7-9-07

SHEET TITLE:
DETAIL LANDSCAPE PLAN

SHEET No. LP202

© COPYRIGHT 2007 SMRT INC

PLANT LIST: NATURALIZING MIX

QUANT.	MARK	SCIENTIFIC NAME / COMMON NAME	SIZE CAL.	SIZE HT.	ROOT	REMARKS
14	TREE MIX	Acer rubrum / Red Maple	–	5–6'	container	Full
14		Betula papyrifera 'Rennaissance Reflection' / White Birch	–	5–6'	container	Full
14		Fraxinus pennsylvanica / Green Ash	–	5–6'	container	Full
14		Juniperus virginiana / Eastern Red Cedar	–	2–3'	container	Full
14		Pinus resinosa / Red Pine	–	2–3'	container	Full
14		Pinus strobus / White Pine	–	2–3'	container	Full
46	SHRUB MIX	Aronia arbutifolia / Black chokecherry	–	12–15"	container	Full
46		Lindera benzoin / Spicebush	–	12–15"	container	Full
46		Symphoricarpus alba / Common Snowberry	–	12–15"	container	Full

PLANT LIST: SHRUBS

QUANT.	MARK	SCIENTIFIC NAME / COMMON NAME	SIZE CAL.	SIZE HT.	ROOT	REMARKS
13	AV	Azalea vaseyi / Pinkshell Azalea	–	3–4'	B&B	Full
64	CA	Cotoneaster apiculata / Cranberry Cotoneaster	–	18–24"	B&B	Full
7	CC	Cotinus coggygria 'Royal Purple'	–	3–4'	B&B	Full
3	CO	Chamaecyparis obtusa 'Compacta' / Dwarf Hinoki Cypress	–	4–5'	B&B	Full
126	CP	Comptonia peregrina/Sweetfern	–	#1	Cont.	Full
13	DC	Daphne 'Carol Mackii' / Daphne	–	18–24"	B&B	Full
42	FC	Forsythia courtasol 'Weekend' / Forsythia	–	12–18"	B&B	Full
8	HA	Hydrangea arborescens 'Annabelle' / Hydrangea	–	2–2 1/2'	B&B	Full
2	IVs	Ilex verticillata v. 'Southern Gentleman'/Winterberry	–	3–4'	B&B	Male
6	IVw	Ilex verticillata v. 'Winter Red'/Winterberry	–	3–4'	B&B	Female
148	JB	Juniperus 'Bar Harbor' / Bar Harbor Juniper	–	–	B&B	Full
86	JC	Juniperus chinensis 'Seagreen' / Seagreen Juniper	–	2–2 1/2'	B&B	Full
95	JS	Juniperus sargenti / Sargent Juniper	–	12–18"	B&B	Full
58	KT	Kalmia 'Tiddlywinks' / Mountain Laurel	–	18–24"	B&B	Full
28	MD	Microbiota decussata / Siberian Carpet Cypress	–	–	B&B	Full
62	MP	Myrica pensylvanica/Northern Bayberry	–	#3	Cont.	Full
2	PA	Picea abies 'Nidiformis' / Birdsnest Spruce	–	12–18"	B&B	Full
36	PK	Potentilla 'Katharine Dykes' / Potentilla	–	18–24"	B&B	Full
3	PM	Pinus Mugo 'Mugo' / Dwarf Mugo Pine	–	2–2 1/2'	B&B	Full
26	PT	Prunus maritima/ Beach Plum	–	#3	Cont.	Full
20	RK	Rhododendron yakusimanum 'Ken Janek' / Rhododendron	–	18–24"	B&B	Full
6	RL	Rhododendron laetevirens / Wilson Rhododendron	–	18–24"	B&B	Full
6	RT	Rhododendron 'Tottenham' / Rhododendron	–	12–18"	B&B	Full
6	RW	Rhododendron 'Windbeam' / Rhododendron	–	18–24"	B&B	Full
44	RE	Rhus typhina 'Tiger Eyes'/Tiger Eyes Sumac	–	#5	Cont.	Full
41	RR	Rosa rugosa/Rugosa Rose	–	2–3'	Cont.	Full
14	SB	Spiraea x bumalda 'Anthony Waterer' / Spiraea	–	2–2 1/2'	B&B	Full
13	SF	Spiraea fritschiana 'Wilma' / Pink Parasols Spiraea	–	18–24"	B&B	Full
14	SI	Stephanandra incisa 'Crispa' / Cutleaf stephanandra	–	12–18"	B&B	Full
2	TO	Thuja occidentalis 'Sherwood Moss' / Arborvitae	–	2–2 1/2'	B&B	Matching
3	TS	Thuja occidentalis 'Smaragd' / Emerald Green Arborvitae	–	3–4'	B&B	Full
19	VC	Viburnum carlesii/Koreanspice viburnum	–	2–2 1/2'	Cont.	Full
5	VL	Viburnum lentago/Nannyberry Viburnum	–	#5	Cont.	Full
37	VP	Viburnum plic. tomen. 'Summer Snowflake' / Viburnum	–	2–2 1/2'	B&B	Full

PLANT LIST: TREES


QUANT.	MARK	SCIENTIFIC NAME / COMMON NAME	SIZE CAL.	SIZE HT.	ROOT	REMARKS
7	AR	Acer rubrum / Red Maple	2 1/2"	–	B&B	Full
2	BN	Betula nigra / River Birch	–	10–12'	B&B	Multi–stem
1	BP	Betula papyrifera 'Rennaissance Reflection' / White Birch	–	8–10'	B&B	Multi–stem
8	CV	Crataegus viridis 'Winter King' / Hawthorne	2 1/2"	–	B&B	Full
22	FE	Fraxinus excelsior 'Aureafolia' / Gold. Des. European Ash	2 1/2"	–	B&B	Full
3	JP	Juniperus communis 'Pencil Point'/Pencil Point Juniper	–	6–7'	B&B	Full
2	LD	Larix deciduo 'Pendula'/Weeping Larch	–	7'–8'	B&B	Full
14	OV	Ostrya virginiana / Hophornbeam	2 1/2"	–	B&B	Full
4	PC	Pyrus calleryana 'Cleveland' / Callery Pear	2 1/2"	–	B&B	Matching
1	PO	Picea Omorika / Serbian Spruce	–	2 1/2'	B&B	Full
4	PS	Prunus 'Snow Goose' / Snow Goose Cherry	2 1/2"	–	B&B	Matching
8	UA	Ulmus americana 'Pioneer' / American Elm hybrid	2 1/2"	–	B&B	Full

PLANT LIST: PERENNIALS


QUANT.	MARK	SCIENTIFIC NAME / COMMON NAME	SIZE CAL.	SIZE HT.	ROOT	REMARKS
6	AA	Astilbe arendsii 'Burgundy' / False Spiraea	–	–	1 gal. cont.	Full
27	AS	Astilbe simplicifolia 'Sprite' / False Spiraea	–	–	1 gal. cont.	Full
16	EE	Euphorbia epithymoides / Cushion Spurge	–	–	1 gal. cont.	Full
22	HB	Hosta 'Big Mama' / Plantain Lily	–	–	1 gal. cont.	Full
140	HE	Hemerocallis mixture	–	–	1 gal. cont.	Staggered blooms
28	HG	Heuchera americana 'Greenspice' / Coralbells	–	–	1 gal. cont.	Full
255	HS	Hemerocallis 'Stella d'Oro' / Daylily	–	–	1 gal. cont.	Staggered blooms
12	HT	Hosta tardiana 'Halcyon' / Plantain Lily	–	–	1 gal. cont.	Full
26	IS	Iberis sempervirens / Candytuft	–	–	1 gal. cont.	Full
20	LC	Leucanth. superbum 'Chris Hagemann' / Shasta Daisy	–	–	1 gal. cont.	Full
100	LG	Lamiastrum galeob. 'Herman's Pride' / Yellow Archangel	–	–	1 gal. cont.	Full
17	LM	Lamium maculatum 'Red Nancy' / Dead Nettle	–	–	1 gal. cont.	Full
X	LA	Leymus arenarius/Blue Lyme Grass	–	–	1 gal. cont.	Full
20	LS	Lavandula augustifolia 'Hidcote Superior'/Hidcote Superior English Lavender	–	–	1 gal. cont.	Full
6	MS	Matteuccia struthiopteris / Ostrich Fern	–	–	1 gal. cont.	Full
12	PV	Panicum virgatum 'Shenandoah' / Shenan. Switch Grass	–	–	1 gal. cont.	Full

LS – Lavandula angustifolia 'Hidcote Superior' / Hidcote Superior English Lavender – 1 gal. pot – full."

NOTE:
ALL PERENNIALS TO BE 1 GAL. CONT., MIN.

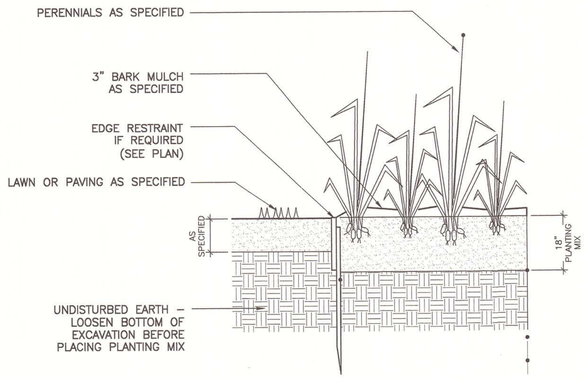


M7 PERENNIAL PLANTING DETAIL
NTS *

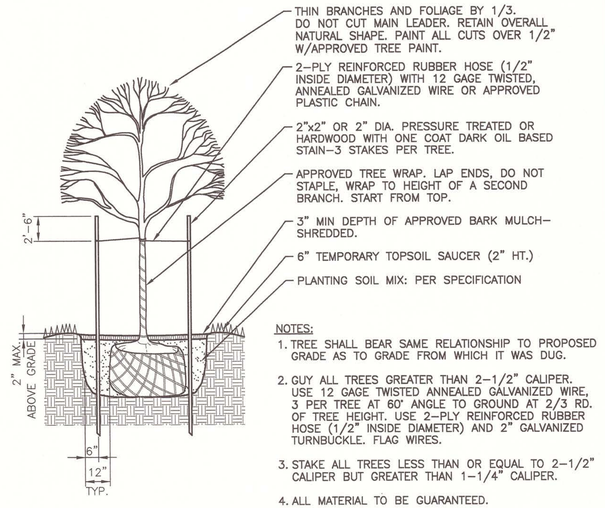


NOTES:
1. TREE SHALL BEAR SAME RELATIONSHIP TO PROPOSED GRADE AS TO GRADE FROM WHICH IT WAS DUG.
2. GUY ALL TREES GREATER THAN 2–1/2" CALIPER. USE 12 GAGE TWISTED ANNEALED GALVANIZED WIRE, 3 PER TREE AT 60° ANGLE TO GROUND AT 2/3 RD. OF TREE HEIGHT. USE 2–PLY REINFORCED RUBBER HOSE (1/2" INSIDE DIAMETER) AND 2" GALVANIZED TURNBUCKLE. FLAG WIRES.
3. STAKE ALL TREES LESS THAN OR EQUAL TO 2–1/2" CALIPER BUT GREATER THAN 1–1/4" CALIPER.
4. ALL MATERIAL TO BE GUARANTEED.

M13 DECIDUOUS TREE PLANTING DETAIL
NTS *

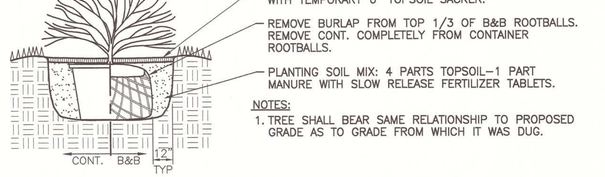

NOTES:
1. TREE SHALL BEAR SAME RELATIONSHIP TO PROPOSED GRADE AS TO GRADE FROM WHICH IT WAS DUG.

J13 SHRUB PLANTING DETAIL
NTS *

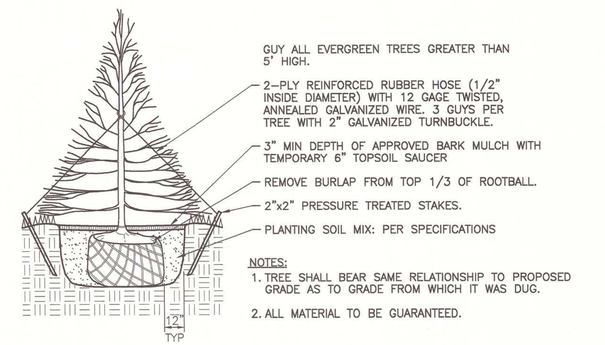

NOTES:
1. TREE SHALL BEAR SAME RELATIONSHIP TO PROPOSED GRADE AS TO GRADE FROM WHICH IT WAS DUG.
2. ALL MATERIAL TO BE GUARANTEED.

E13 EVERGREEN TREE PLANTING DETAIL
NTS *

SMRT
ARCHITECTURE ENGINEERING PLANNING
SMRT
144 Fore Street/P.O. Box 618
Portland, Maine 04104
tel. (207) 772-3846
fax. (207) 772-1070

LICENSED LANDSCAPE ARCHITECT MARK G. JOHNSON NO. 1857 STATE OF MAINE 7-9-07

AS BUILT
Owner Copy

PROJECT TITLE:
MAINE TURNPIKE AUTHORITY ADMINISTRATION BUILDING
PORTLAND, MAINE

ISSUED FOR BIDDING/CONSTRUCTION 7-9-07

REV	DESCRIPTION	DATE
0	BIDDING/CONSTRUCTION	7-9-07


GRAPHIC SCALE: 0" 1"

SCALE:	NTS
PROJECT MANAGER:	SLB
JC/DRAWN BY:	TCM/PAF
A/E OF RECORD:	MGJ
CAD FILE:	06016–LP501
PROJECT NO:	06016
DATE:	7–9–07

SHEET TITLE:
LANDSCAPE DETAILS /PLANT LISTS

SHEET No. LP501

© COPYRIGHT 2007 SMRT INC.

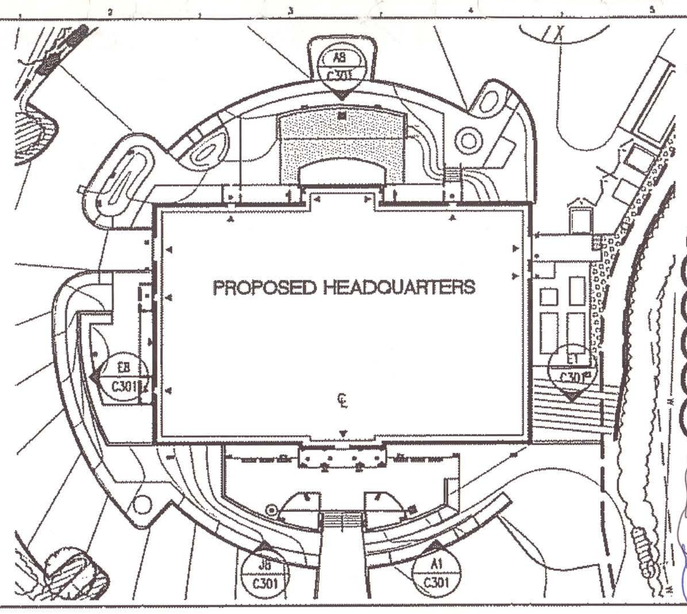

NOTES:

1 SEE ARCHITECTURAL FOR GRANITE CAP DETAILS

2 BRICK SHELVES TO BE 2 COURSES MINIMUM BELOW FINISHED GRADE

3 ALL ELEVATIONS BASED ON SITE FFE 92.53' (GROUND FLOOR)

SHEET ISSUED FOR SI-26R
ALL WALL ELEVATIONS HAVE BEEN REVISED;
INDIVIDUAL CHANGES NOT CLOUDED

RFI-103 on Retaining Wall Elevation's + Brick Shelf elevation's

RFI-108 Retaining Wal Control Sts


Retaining Wall Water Proofing RFI-143

J1 KEY MAP: WALL LOCATIONS

1" = 40'


J8 WALL ELEVATION 'C': MAIN ENTRY LEFT

1/8" = 1'-0"

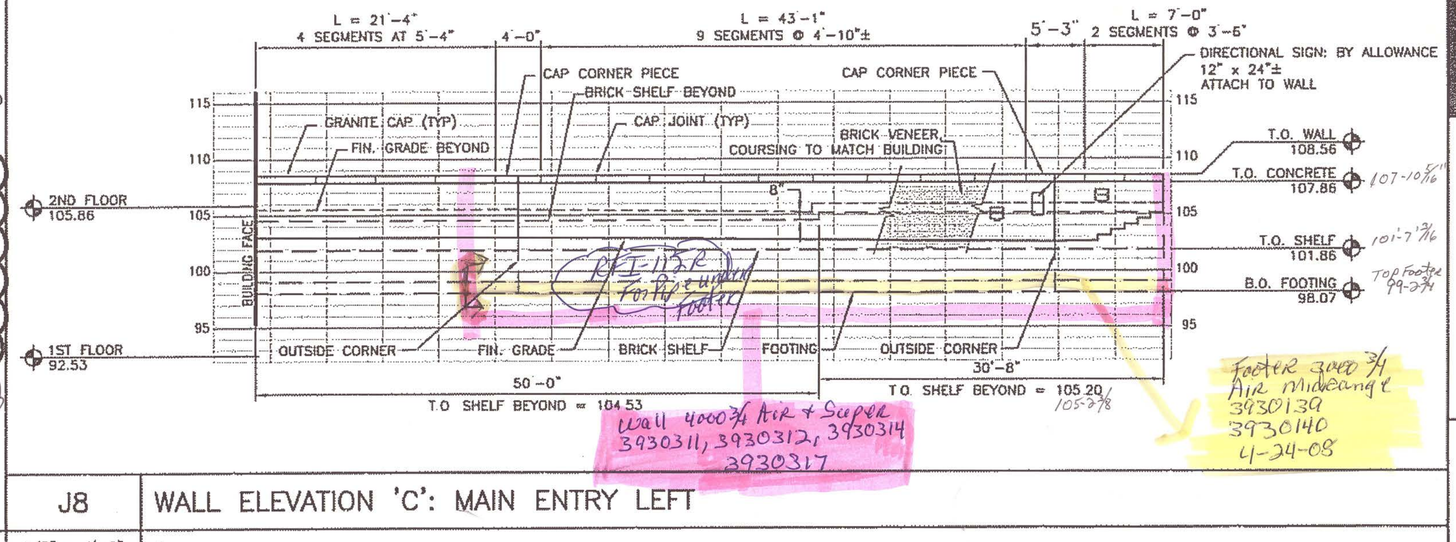

E1 WALL ELEVATION 'A': SERVICE AREA

1/8" = 1'-0"

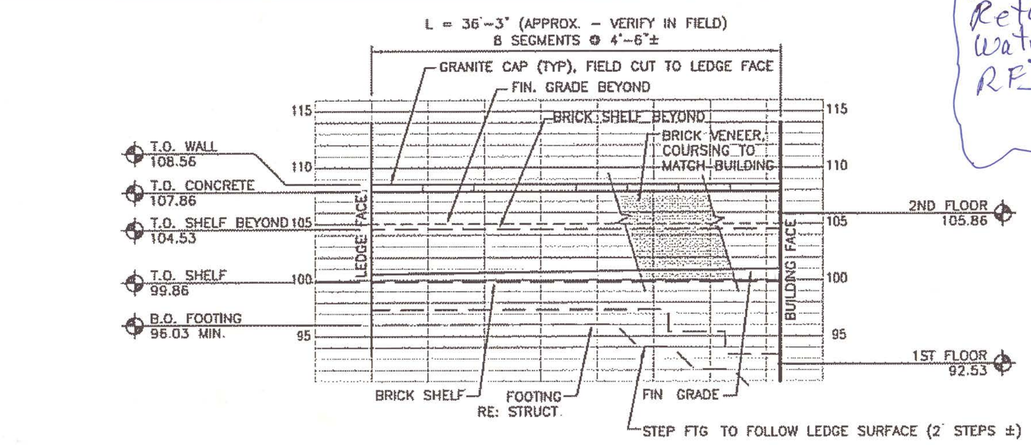


A1 WALL ELEVATION 'B': MAIN ENT[illegible]T

1/8"


E8 WALL ELEVATION 'D': SIDE TERRACE

1/8" = 1'-0"

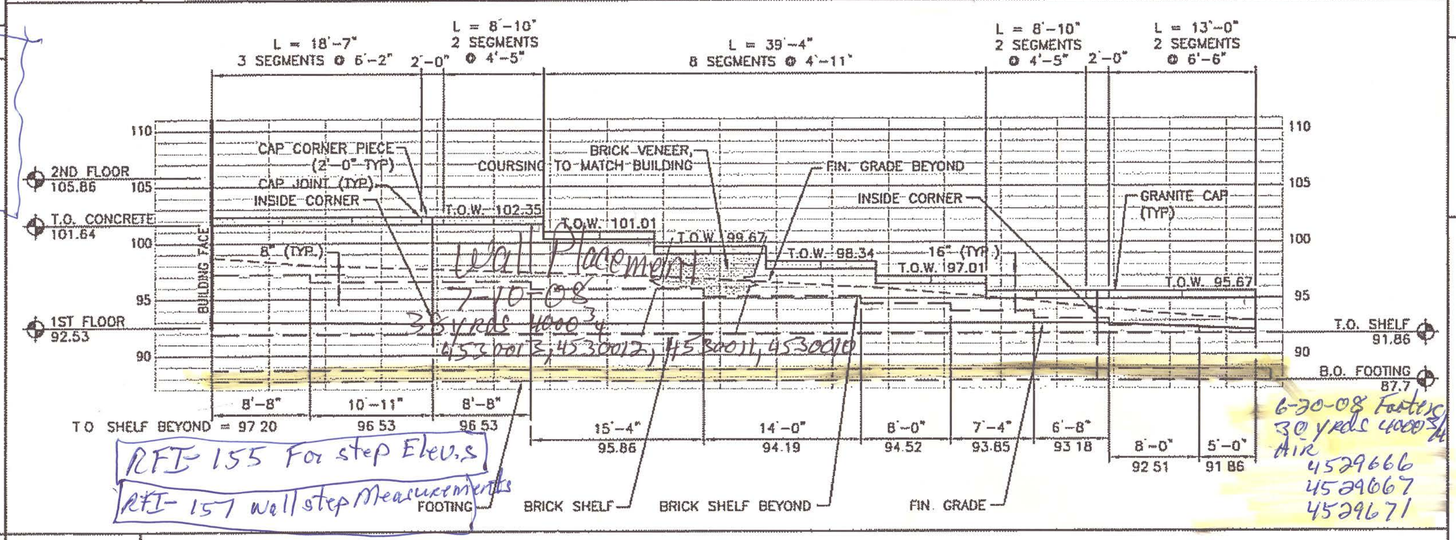




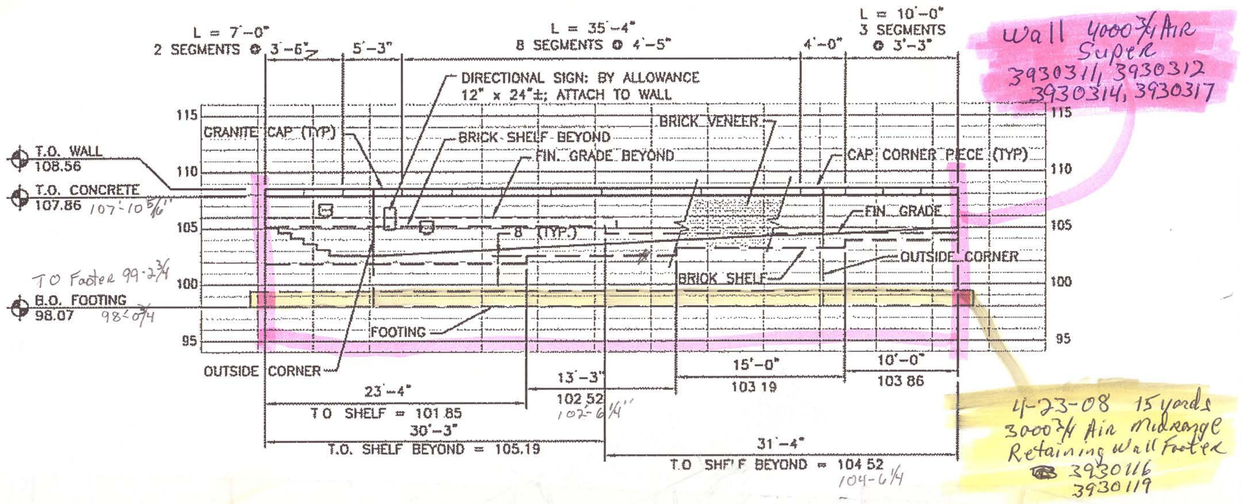

A8 WALL ELEVATION 'E': REAR TERRACE

1/8" = 1'-0"

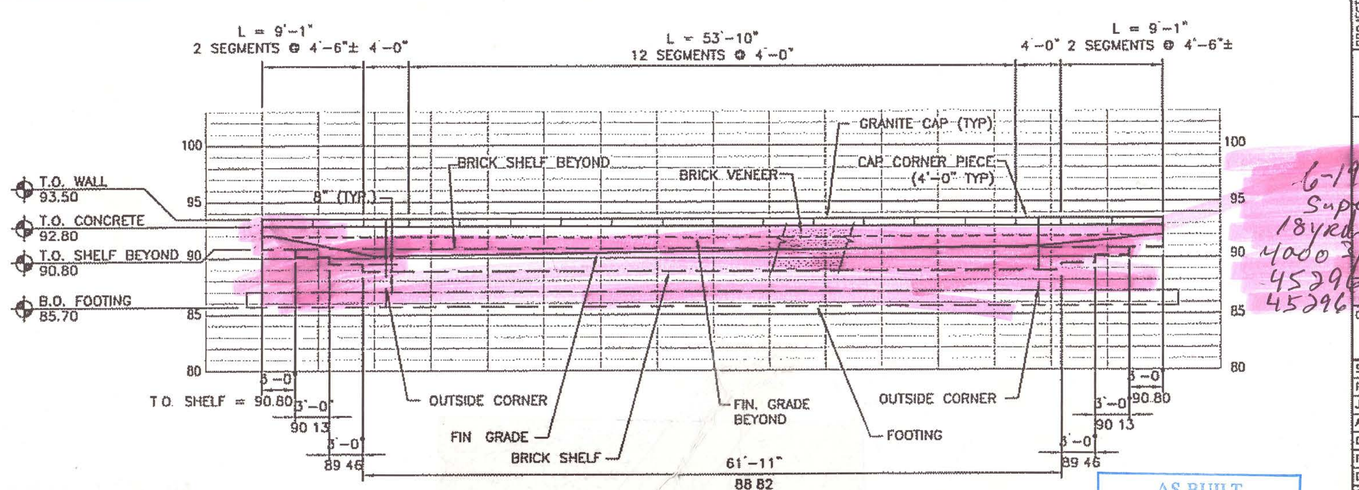

SMRT
ARCHITECTURE ENGINEERING PLANNING
144 Fore Street / P.O. Box 618
Portland, Maine 04104
tel. (207) 772-3846
fax. (207) 772-1070

PROJECT NORTH
MAG NORTH

PROJECT TITLE:
MAINE TURNPIKE AUTHORITY
ADMINISTRATION BUILDING
PORTLAND, MAINE

REISSUED FOR SI-26R
4-16-08

REV	DESCRIPTION	DATE
0	BIDDING/CONSTRUCTION	7-9-07
1	REISSUED FOR SI-26R	4-16-08


GRAPHIC SCALE: 0" 1"

SCALE:	SHOWN
PROJECT MANAGER:	SLB
JC/DRAWN BY:	TCM/PAF
A/E OF RECORD:	MOJ
CAD FILE:	06016-C3101
PROJECT NO:	06016
DATE:	7-9-07

SHEET TITLE:
SITE WALL ELEVATIONS

SHEET No. C301

©Copyright SMRT Inc. 2007

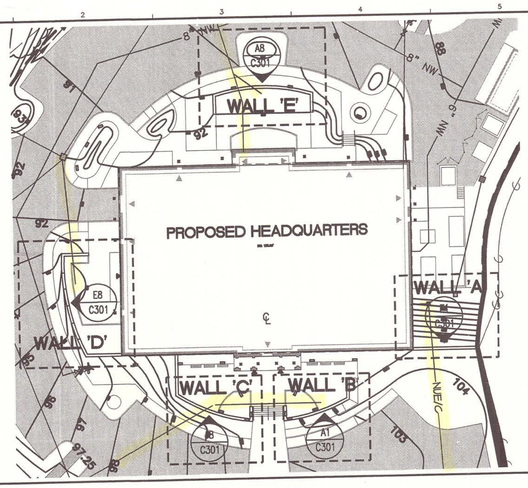

NOTES:


1. SEE ARCHITECTURAL FOR GRANITE CAP DETAILS.
2. BRICK SHELVES TO BE 2 COURSES MINIMUM BELOW FINISHED GRADE.

Brick Coursing Elevs. RFI-95 SI 26+ SI26R

Elev. + wall Stems RFI-101


RFI-103 on Elev. on Footers, T.O.W. + Brick Shelfs

J1	KEY MAP: WALL LOCATIONS
1" = 40'	*

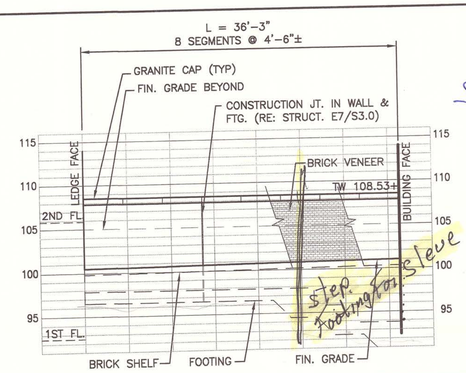


See ST-30 For new Elevations


E1	WALL ELEVATION 'A': SERVICE AREA
1/8" = 1'-0"	*

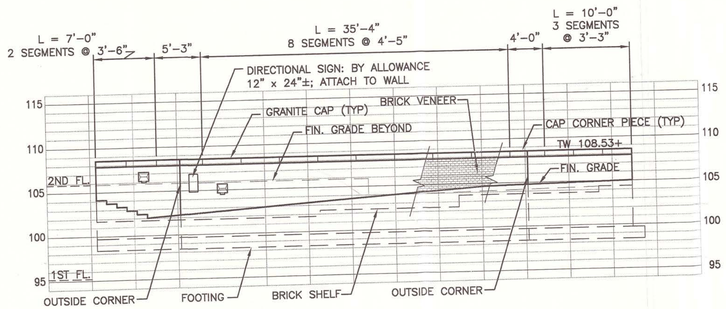


A1	WALL ELEVATION 'B': MAIN ENTRY RIGHT
1/8" = 1'-0"	*

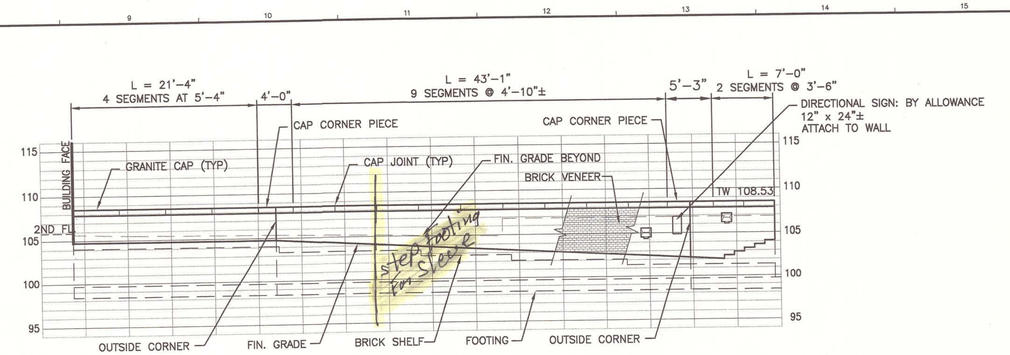

J8	WALL ELEVATION 'C': MAIN ENTRY LEFT
1/8" = 1'-0"	*

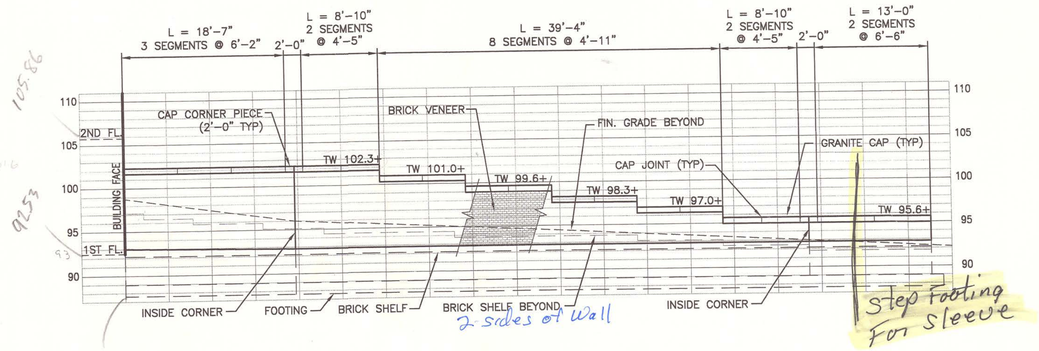

E8	WALL ELEVATION 'D': SIDE TERRACE
1/8" = 1'-0"	*

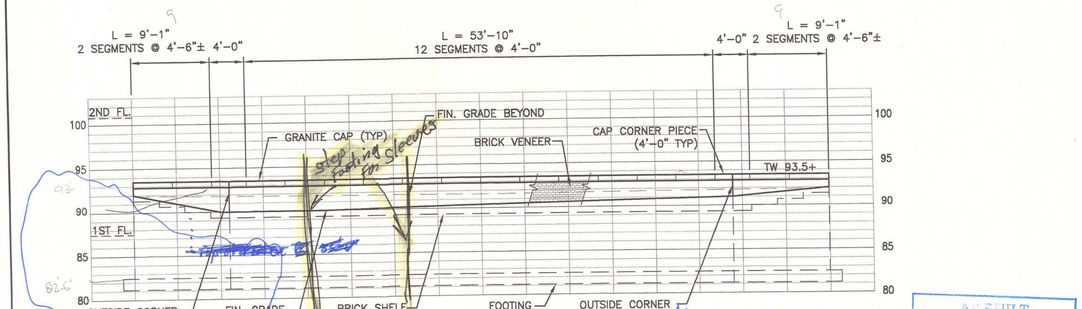

AS BUILT Owner Copy

A8	WALL ELEVATION 'E': REAR TERRACE
1/8" = 1'-0"	*

SMRT
ARCHITECTURE ENGINEERING PLANNING
144 Fore Street/P.O. Box 618
Portland, Maine 04104
tel. (207) 772-3846
fax. (207) 772-1070

LICENSED LANDSCAPE ARCHITECT MARK G. JOHNSON (NO.) 1657

PROJECT TITLE: MAINE TURNPIKE AUTHORITY ADMINISTRATION BUILDING PORTLAND, MAINE

ISSUED FOR BIDDING/CONSTRUCTION 7-9-07

REV	DESCRIPTION	DATE
0	BIDDING/CONSTRUCTION	7-9-07

GRAPHIC SCALE: 0" 1"

SCALE:	SHOWN
PROJECT MANAGER:	SLB
JC/DRAWN BY:	TCM/PAF
A/E OF RECORD:	MGJ
CAD FILE:	06016-C3101
PROJECT NO:	06016
DATE:	7-9-07

SHEET TITLE: SITE WALL ELEVATIONS

SHEET No. C301

© COPYRIGHT 2007 SMRT INC.

Rick Paulison

From: Craig Hill [chill@wright-ryan.com]
Sent: Monday, November 17, 2008 11:00 AM
To: Rick Paulison
Cc: 'Bruce Brown'
Subject: RE: Sidewalk pavers

Yes, it came in last week. Shaw should have seen it in the mail by now, but if not "Oak Blend" was selected.

From: Rick Paulison
Sent: Monday, November 17, 2008 7:04 AM
To: Craig Hill
Cc: 'Bruce Brown'
Subject: Sidewalk pavers


Craig I could of sworn that the sidewalk paver color was answered.I cannot find it. Can you verify so Shaw's can do the work.


No virus found in this outgoing message.
Checked by AVG.
Version: 7.5.549 / Virus Database: 270.9.4/1793 - Release Date: 11/16/2008 7:58 PM


Internal Virus Database is out of date.
Checked by AVG - http://www.avg.com
Version: 8.0.175 / Virus Database: 270.9.2/1783 - Release Date: 11/12/2008 10:01 AM

No virus found in this incoming message.
Checked by AVG.
Version: 7.5.549 / Virus Database: 270.9.4/1794 - Release Date: 11/17/2008 8:48 AM


NOTE:
ALL SIGN AND WALL ASSOCIATED CONSTRUCTION SHALL BE INCLUDED IN CONTRACT UNLESS OTHERWISE NOTED.

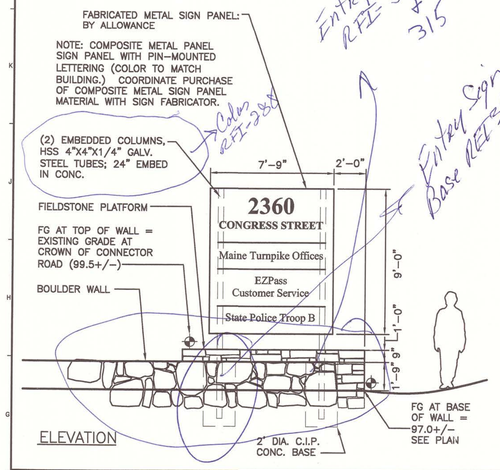

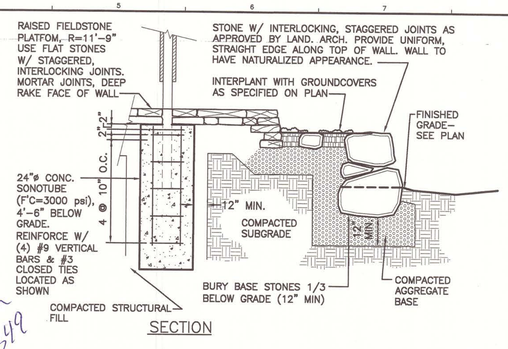


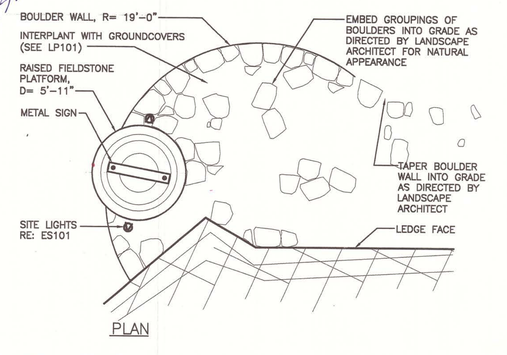


F1	ENTRY SIGN AND WALL
NTS	CP101

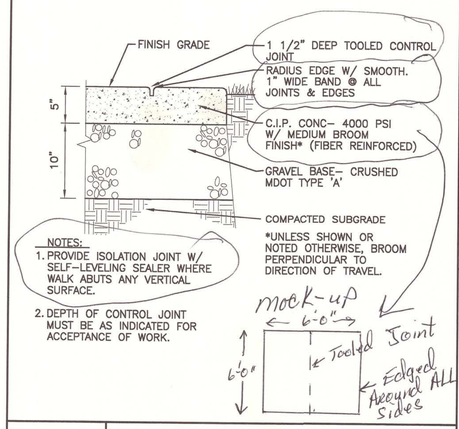


H8	C.I.P. CONCRETE WALK DETAIL
NTS	CP201

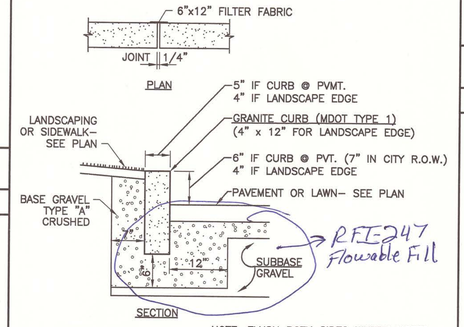


E8	GRANITE CURB DETAIL
NTS	CP101

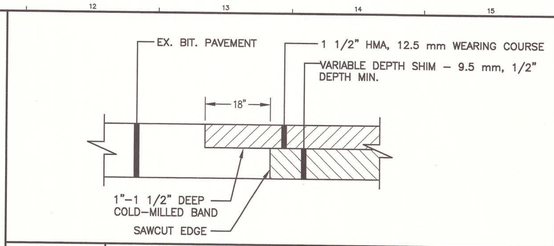


K12	BIT. PAVEMENT MATCHING DETAIL
NTS	CP101

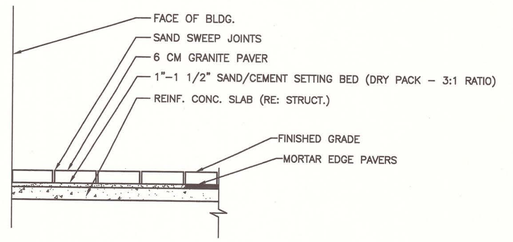


H12	PAVERS AT ENTRY CANOPY
NTS	A1/C504

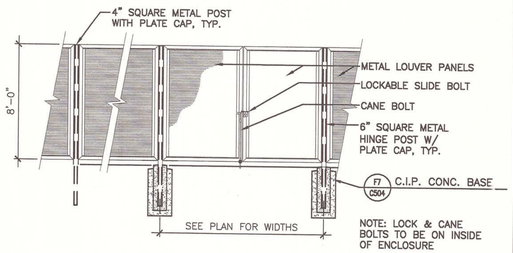


D12	METAL SCREEN FENCE AND GATE DETAIL
NTS	CP202

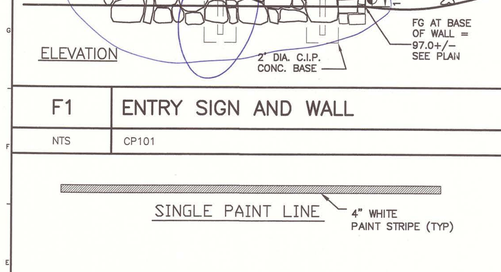


A1	PAINTED STRIPING DETAIL
NTS	CP101

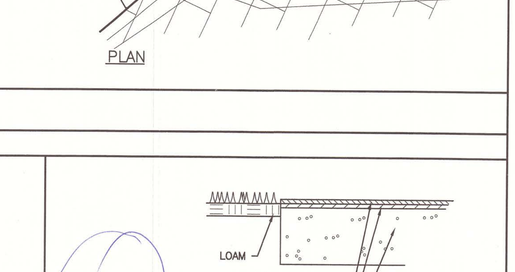


D5	BITUMINOUS WALK DETAIL
NTS	CP101

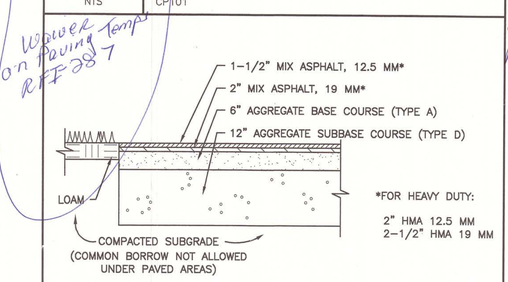

A5	BITUMINOUS DRIVE DETAIL
NTS	CP101

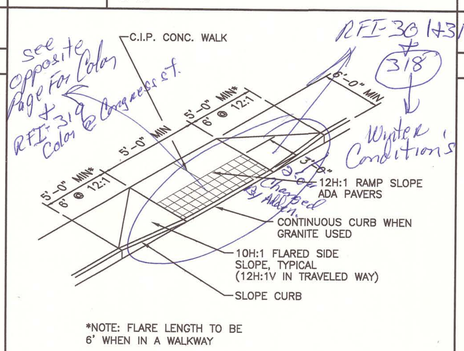

A8	CURB RAMP DETAIL
NTS	CP101

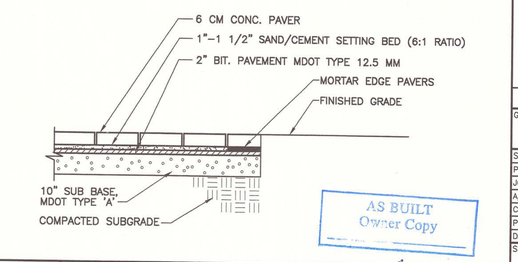

A12	CONCRETE PAVER DETAIL
NTS	CP201

SMRT
ARCHITECTURE ENGINEERING PLANNING
SMRT
144 Fore Street / P.O. Box 618
Portland, Maine 04104
tel. (207) 772-3846
fax. (207) 772-1070

LICENSED LANDSCAPE ARCHITECT
MARK G. JOHNSON
NO. 1857
STATE OF MAINE

PROJECT TITLE:
MAINE TURNPIKE AUTHORITY
ADMINISTRATION BUILDING
PORTLAND, MAINE

ISSUED FOR BIDDING/CONSTRUCTION
7-9-07

REV	DESCRIPTION	DATE
1	BIDDING/CONSTRUCTION	7-09-07
0	ISSUED FOR PERMITTING	1-16-07


GRAPHIC SCALE: 0" 1"

SCALE:	SHOWN
PROJECT MANAGER:	SLB
JC/DRAWN BY:	TCM/PAF
A/E OF RECORD:	MGJ
CAD FILE:	06016-C501
PROJECT NO:	06016
DATE:	7-9-07

SHEET TITLE:
SITE DETAILS


SHEET No.
C501

© COPYRIGHT 2007 SMRT INC.

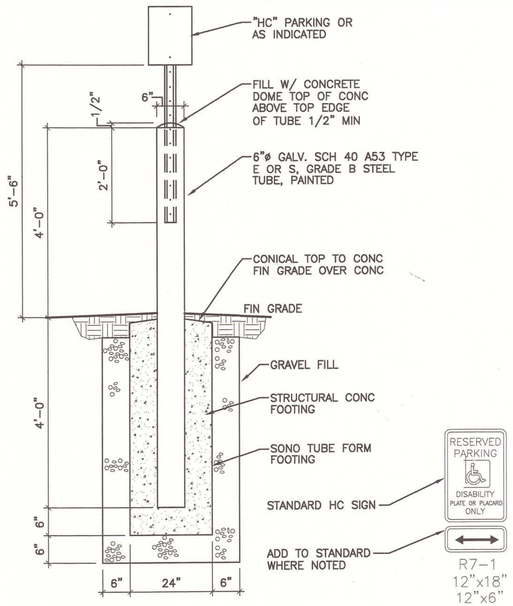


G1	BOLLARD SIGN DETAIL
NTS	CP201, CP202

FIXTURE TYPE (SEE ES101)	LAMP ELEVATION (ABOVE FINISH GRADE)	BASE DIAMETER *	EMBEDMENT
AA (1 LAMP) BB (1 LAMP)	25'–0"	30" 24" 18"	4'–6" 6'–9" 10'–9"
CC (1 LAMP)	12'–0"	30" 24" 18"	4'–6" 4'–6" 6'–6"
AA (2 LAMP) BB (2 LAMP)	25'–0"	36" 30" 24"	4'–6" 5'–9" 8'–6"

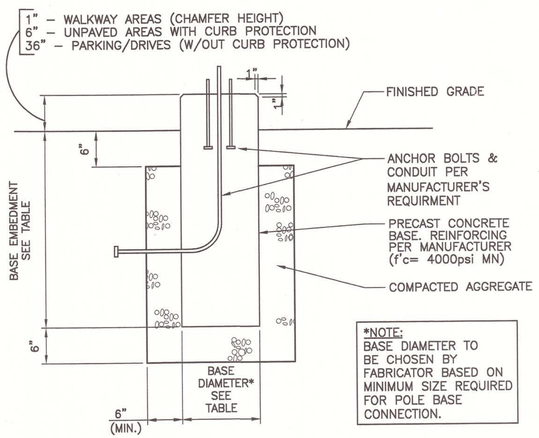


*NOTE:
BASE DIAMETER TO BE CHOSEN BY FABRICATOR BASED ON MINIMUM SIZE REQUIRED FOR POLE BASE CONNECTION.

A1	LIGHT POLE BASE DETAIL
NTS	RE: STRUCTURAL FOR POLE BASE DETAIL ON BEDROCK A11/S3.4

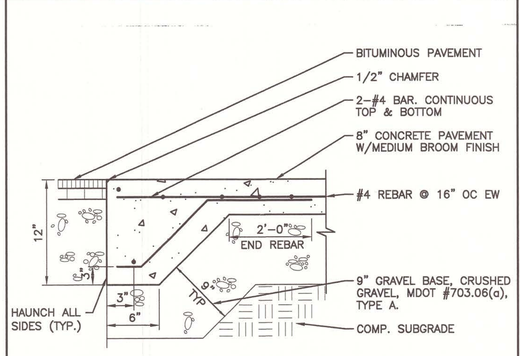


J5	CONCRETE DUMPSTER PAD DETAIL
NTS	CP202


F5	BIT. PAVEMENT OVERLAY DETAIL
NTS	CP101

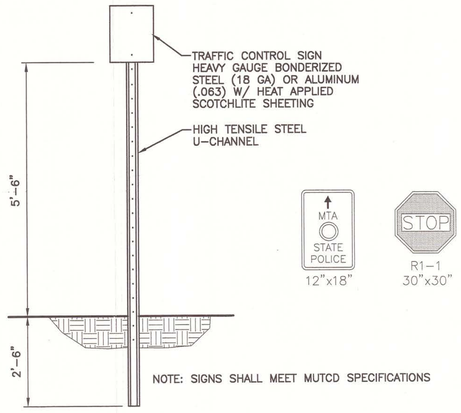


A5	SIGN DETAIL
NTS	*

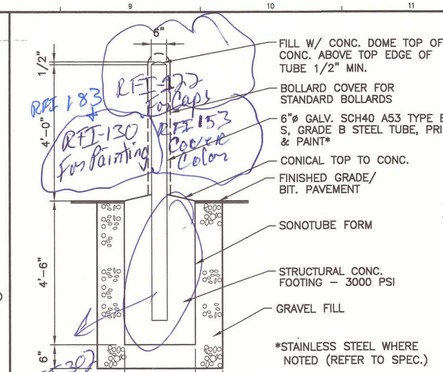


J9	BOLLARD DETAIL
NTS	CP201, CP202

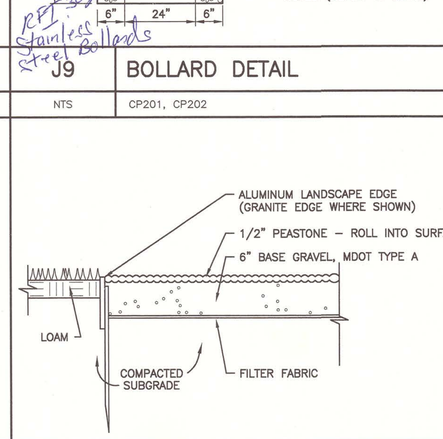


F9	GRAVEL TERRACE DETAIL
NTS	CP101

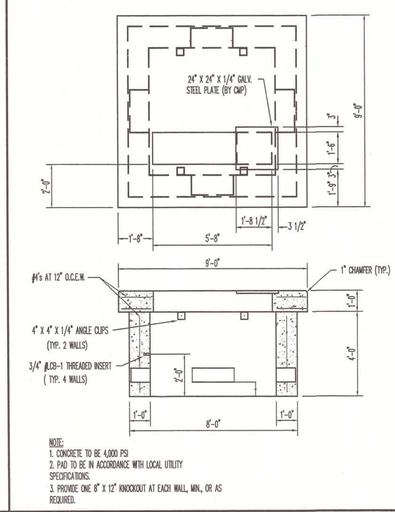

A9	TRANSFORMER PAD DETAIL
NTS	CP202

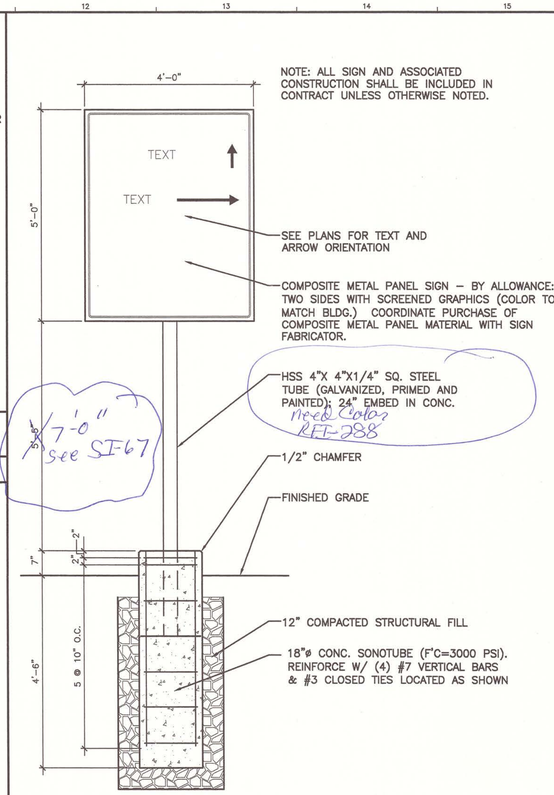

F12	DIRECTIONAL SIGN DETAIL
NTS	*

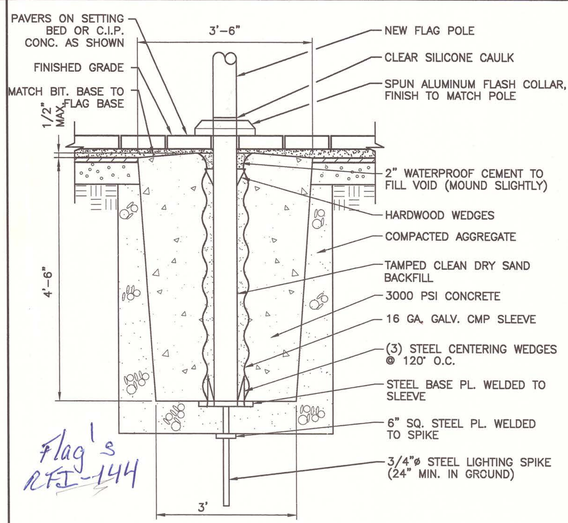

A12	FLAGPOLE BASE DETAIL
NTS	CP201, CP202

SMRT
ARCHITECTURE ENGINEERING PLANNING
SMRT
144 Fore Street P.O. Box 618
Portland, Maine 04104
tel. (207) 772-3846
fax. (207) 772-1070

AS BUILT
Owner Copy

LICENSED LANDSCAPE ARCHITECT MARK G. JOHNSON 1557 STATE OF MAINE 12/14/07

PROJECT TITLE:
MAINE TURNPIKE AUTHORITY
ADMINISTRATION BUILDING
PORTLAND, MAINE

ISSUED FOR BIDDING/CONSTRUCTION
7-9-07

REV	DESCRIPTION	DATE
0	BIDDING/CONSTRUCTION	7-9-07


GRAPHIC SCALE: 0" 1"

SCALE:	SHOWN
PROJECT MANAGER:	SLB
JC/DRAWN BY:	TCM/PAF
A/E OF RECORD:	MGJ
CAD FILE:	06016–C502
PROJECT NO:	06016
DATE:	7-9-07


SHEET TITLE:
SITE DETAILS

SHEET No. C502

© COPYRIGHT 2007 SMRT INC.

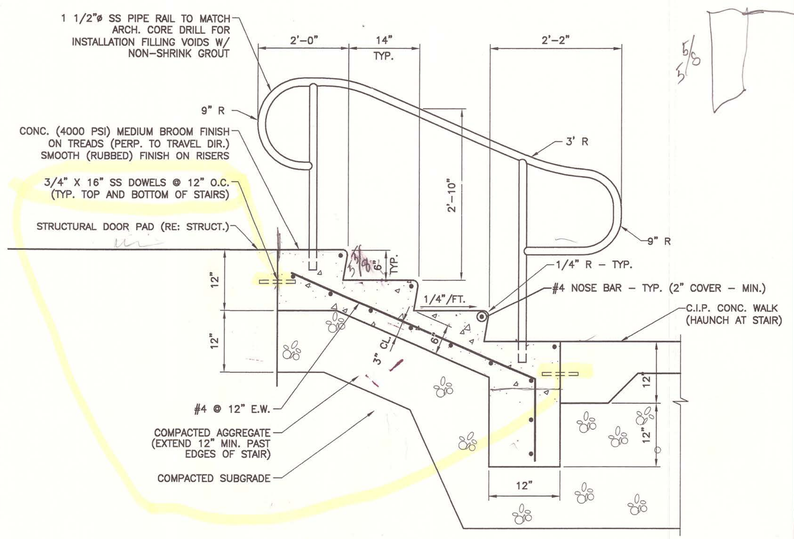

G1	CONCRETE STAIRS
NTS	CP201

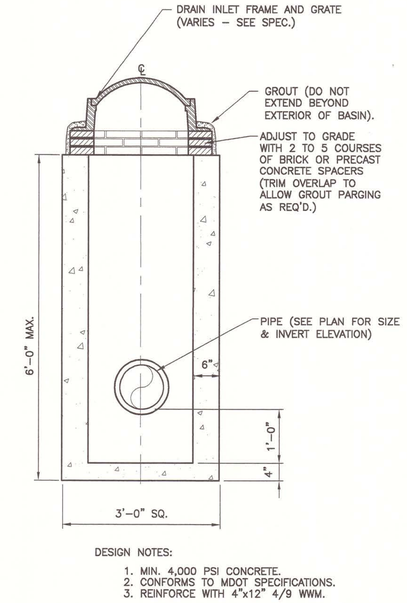


DESIGN NOTES:


1. MIN. 4,000 PSI CONCRETE.
2. CONFORMS TO MDOT SPECIFICATIONS.
3. REINFORCE WITH 4"x12" 4/9 WWM.

G7	DRAIN INLET DETAIL
NTS	*

SIZE	A	B	C	D	E	F	G	H
12 In.	11-1/2	17	22	8	5 1/2	17	12-1/2	13 3/8
15 In.	14-1/2	21-3/4	22-3/4	10-1/4	7	20-1/2	14-3/4	15-3/4

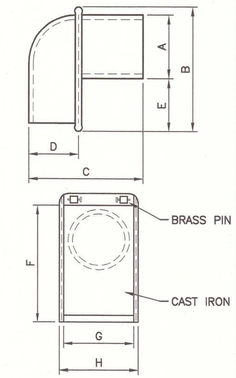

J11	CASCO TRAP
NTS	*

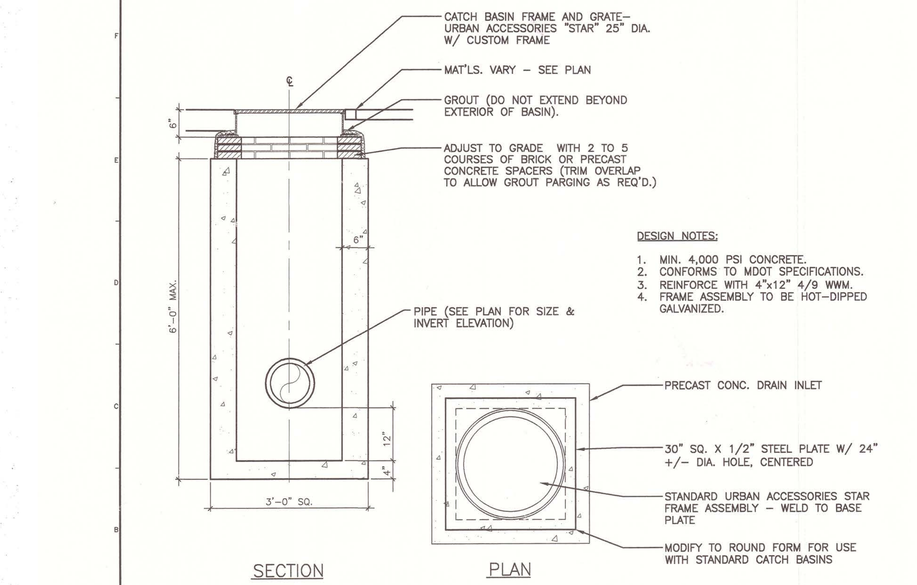


SECTION PLAN

DESIGN NOTES:

1. MIN. 4,000 PSI CONCRETE.
2. CONFORMS TO MDOT SPECIFICATIONS.
3. REINFORCE WITH 4"x12" 4/9 WWM.
4. FRAME ASSEMBLY TO BE HOT-DIPPED GALVANIZED.


G7	CATCH BASIN DETAIL
NTS	*

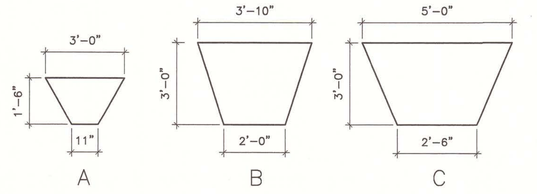

A = SMALL (.26 YDS) HT = 24"
B = MEDIUM (.97 YDS) HT = 36"
C = LARGE (1.74 YDS) HT = 50"

TYPICAL USES

PIPE SIZES	4"&6"	8"	10"	12"
90° BEND	A	B	C	C
45° BEND	A	A	B	B
22.5° BEND	A	A	A	A
BEND	A	A	A	A
END/TEE	A	B	B	C

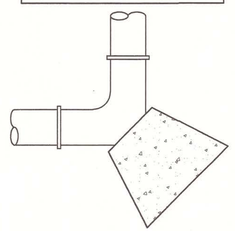


NOTES:

1. POUR EACH BLOCK TO BEAR ON SUITABLE UNDISTURBED SOIL.
2. UNSUITABLE OR DISTURBED SOIL SHALL BE REMOVED AND REPLACED WITH APPROVED CRUSHED STONE OR GRAVEL AND COMPACTED TO 95% MAX. DRY DENSITY.
3. DO NOT ENCASE OR OTHERWISE OBSTRUCT MECHANICAL JOINTS AND APPURTENANCES WITH CONCRETE.
4. PRE-CAST CONCRETE THRUST BLOCKS MAY BE USED WITH PRIOR APPROVAL.
5. THE BLOCK SIZES SHOWN ARE MINIMUM. REQUIREMENTS OF UTILITY AUTHORITY HAVING JURISDICTION SHALL APPLY TO ALL ASPECTS OF WATER SUPPLY INSTALLATION.

A1	THRUST BLOCKS DETAIL
NTS	*

E11	*
NTS	*

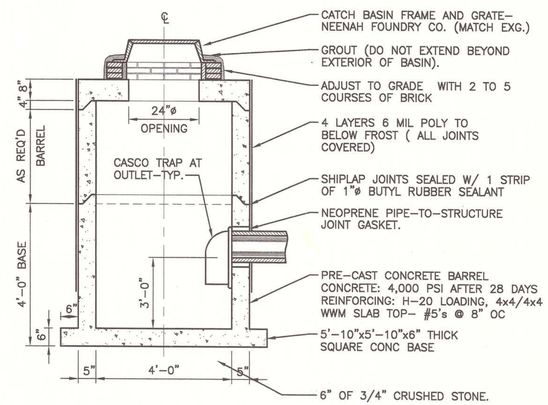

A11	CATCH BASIN DETAIIL
NTS	*

SMRT

ARCHITECTURE ENGINEERING PLANNING

SMRT
144 Fore Street/P.O. Box 618
Portland, Maine 04104
tel. (207) 772-3846
fax. (207) 772-1070

LICENSED LANDSCAPE ARCHITECT MARK G. JOHNSON NO. 1057 STATE OF MAINE

AS BUILT
Owner Copy

PROJECT TITLE:
MAINE TURNPIKE AUTHORITY ADMINISTRATION BUILDING
PORTLAND, MAINE

ISSUED FOR BIDDING/CONSTRUCTION
7-9-07

REV	DESCRIPTION	DATE
0	BIDDING/CONSTRUCTION	7-9-07


GRAPHIC SCALE: 0" 1"

SCALE:	SHOWN
PROJECT MANAGER:	SLB
JC/DRAWN BY:	TCM/PAF
A/E OF RECORD:	MGJ
CAD FILE:	06016-C503
PROJECT NO:	06016
DATE:	7-9-07


SHEET TITLE:
SITE DETAILS

SHEET No. C503

© COPYRIGHT 2007 SMRT INC.

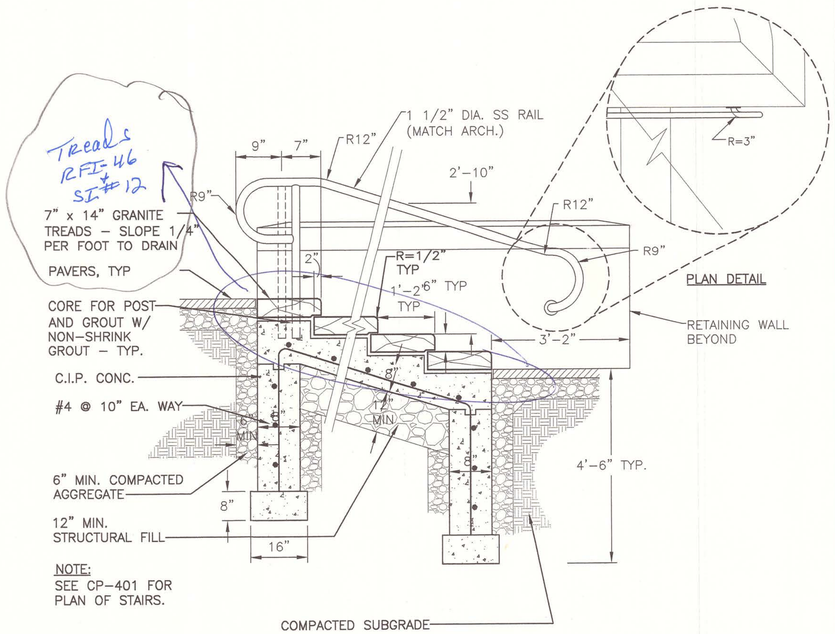


G1	GRANITE STEP AND RAIL DETAIL
NTS	*

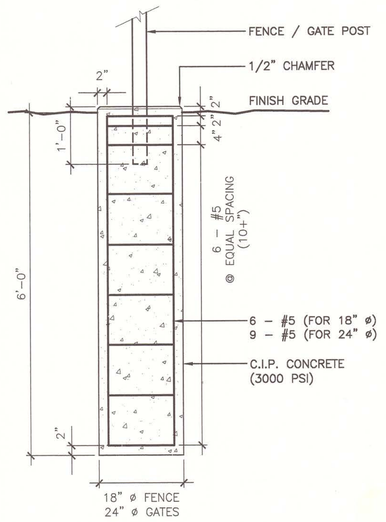

F7	METAL SCREEN FENCE & GATE BASE DETAIL
NTS	CP202



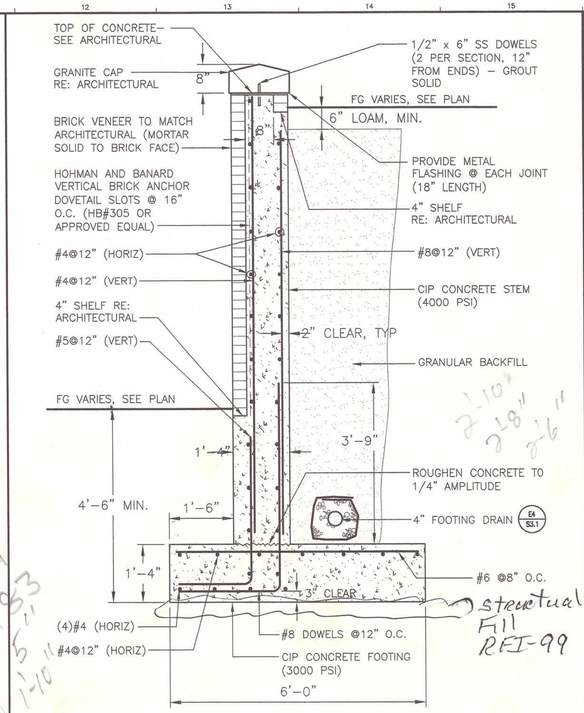


2'-10" 3'-9" 2'-6"

Structural Fill RFI-99

F12	RETAINING WALL (OVER 4' HEIGHT)
NTS	*

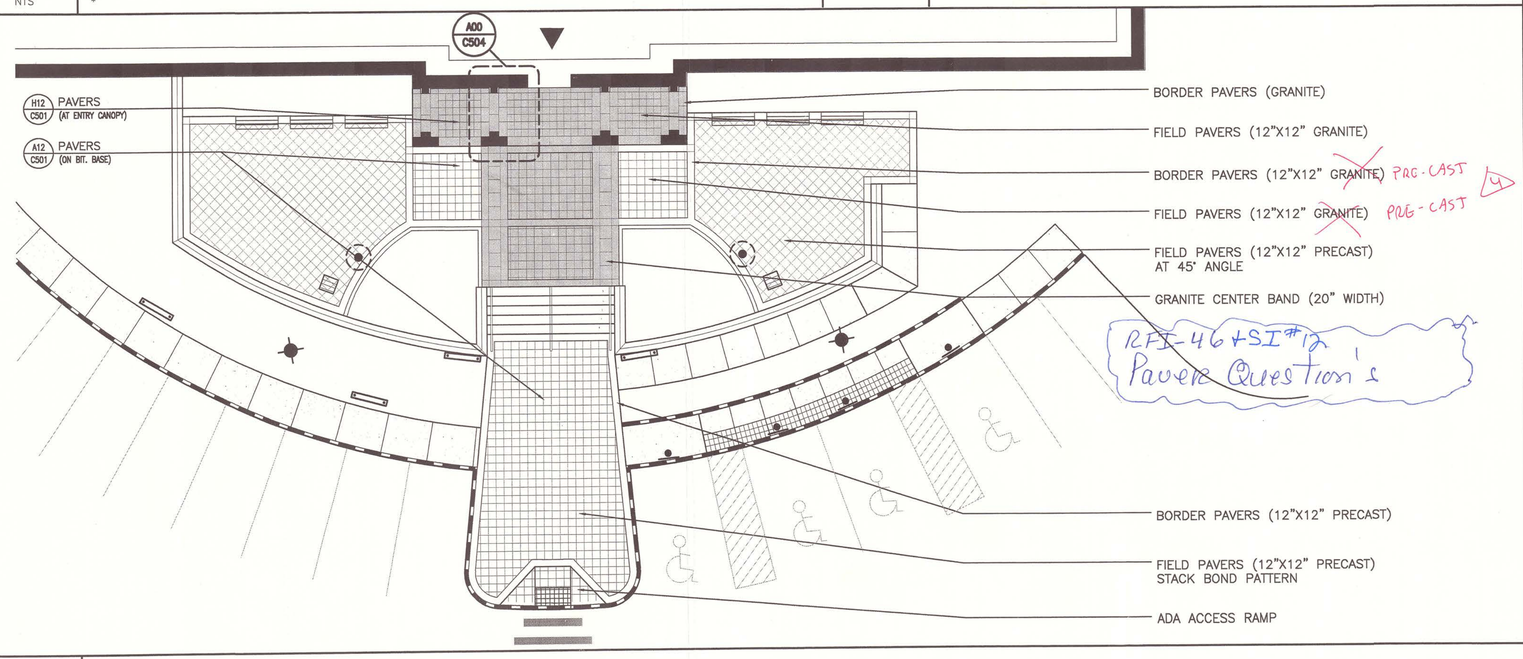

A1	PAVING DETAIL AT FRONT ENTRY
1" = 10'	–

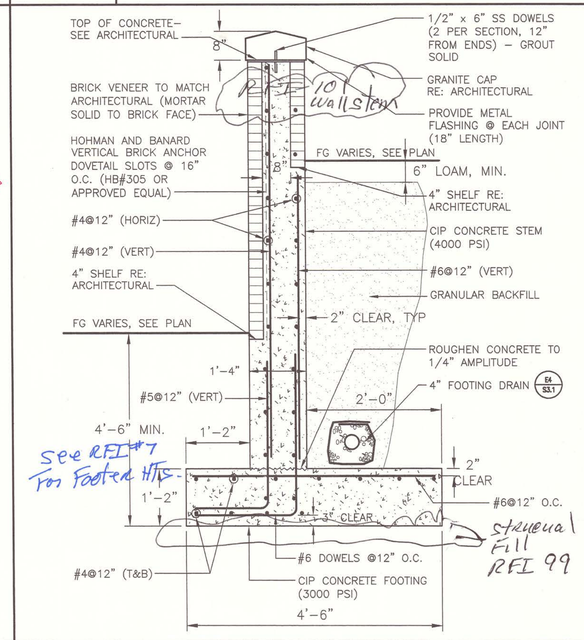

A12	RETAINING WALL (UNDER 4' HEIGHT)
NTS	*

SMRT
ARCHITECTURE ENGINEERING PLANNING
SMRT
144 Fore Street/P.O. Box 618
Portland, Maine 04104
tel. (207) 772-3846
fax. (207) 772-1070

LICENSED LANDSCAPE ARCHITECT MARK G. JOHNSON NO. 657 STATE OF MAINE

AS BUILT Owner Copy

PROJECT TITLE:
MAINE TURNPIKE AUTHORITY ADMINISTRATION BUILDING
PORTLAND, MAINE

ISSUED FOR BIDDING/CONSTRUCTION 7-9-07

REV	DESCRIPTION	DATE
0	BIDDING/CONSTRUCTION	7-9-07

GRAPHIC SCALE: 0" 1"

SCALE:	SHOWN
PROJECT MANAGER:	SLB
JC/DRAWN BY:	TCM/PAF
A/E OF RECORD:	MGJ
CAD FILE:	06016-C504
PROJECT NO:	06016
DATE:	7-9-07

SHEET TITLE:
SITE DETAILS

SHEET No.
C504

© COPYRIGHT 2007 SMRT INC.

INSTALL HAY BALES AROUND EXIST. BASIN

STONE CHECK DAM (TYP. EVERY 100')

CLEARING LIMIT AND SILT FENCE PLACEMENT TO MATCH LIMIT OF DISTURBANCE

MATCH LINE - SEE DETAIL INSET

CONGRESS STREET

CONNECTOR ROAD

HUTCHINS DRIVE

MATCH LINE

INSET

TO BE LOCATED BY RESIDENT IN THE FIELD

AS BUILT
Owner Copy

LEGEND

- S/F — SILT FENCE OR WOOD WASTE BERM
- STONE CHECK DAM
- HAY BALE
- STABILIZED CONSTRUCTION ENTRANCE

NORTH

Scale: 1"=40'

0' 20' 40' 80'

PREPARED BY:
HNTB

HNTB CORP.
2 THOMAS DRIVE
WESTBROOK, ME
04092

SMRT
ARCHITECTURE ENGINEERING PLANNING
SMRT
144 Fore Street P.O. Box 618
Portland, Maine 04104
tel. (207) 772-3846
fax. (207) 772-1070

ROLAND A. LAVALLEE
No. 5452
REGISTERED PROFESSIONAL ENGINEER
STATE OF MAINE

PROJECT TITLE:
MAINE TURNPIKE AUTHORITY
ADMINISTRATION BUILDING
PORTLAND, MAINE

ISSUED FOR BIDDING/CONSTRUCTION
7-9-07

REV	DESCRIPTION	DATE
4	DOCS FOR OWNER REVIEW	6-11-07
3	ISSUED FOR CITY REVIEW	5-03-07
2	100% OWNER REVIEW	3-23-07
1	ISSUED FOR PERMITTING	2-09-07
0	PRE-SUBMITTAL	1-16-07

GRAPHIC SCALE: 0" 1"

SCALE:	AS NOTED
PROJECT MANAGER:	GAB
JC/DRAWN BY:	MPC
A/E OF RECORD:	GAB
CAD FILE:	X
PROJECT NO:	2007.07
DATE:	01/07

SHEET TITLE:
EROSION AND SEDIMENT CONTROL PLAN

SHEET No.
CS301

© COPYRIGHT 2006 SMRT INC.

EROSION AND SEDIMENTATION CONTROL NOTES

1. CONTRACTOR SHALL FOLLOW BEST MANAGEMENT PRACTICES OF THE CUMBERLAND COUNTY SOIL CONSERVATION SERVICE AND THE MAINE DOT BEST MANAGEMENT PRACTICES HANDBOOK.

GENERAL EROSION AND SEDIMENTATION CONTROL PRACTICES

1. EROSION/SEDIMENT CONTROL DEVICES. THE FOLLOWING EROSION SEDIMENTATION CONTROL DEVICES ARE PROPOSED FOR CONSTRUCTION ON THIS PROJECT. INSTALL THESE DEVICES AS INDICATED ON THE PLANS.

1.1 SILT FENCE: SILT FENCE WILL BE INSTALLED ALONG THE DOWN GRADIENT EDGES OF DISTURBED AREAS TO TRAP RUNOFF BORN SEDIMENTS UNTIL THE SITE IS STABILIZED. IN AREAS WHERE STORMWATER DISCHARGES, THE SILT FENCE WILL BE REINFORCED WITH HAY BALES TO HELP MAINTAIN THE INTEGRITY OF THE SILT FENCE AND TO PROVIDE ADDITIONAL TREATMENT. UPSTREAM GRADIENT FROM SILT FENCE SHALL NOT EXCEED 200 LINEAR FEET PER LINEAR FOOT OF TEMPORARY FENCE. WOOD WASTE COMPOST/BARK FILTER BERMS MAY BE USED IN LIEU OF SILT FENCE, AS APPROVED BY THE RESIDENT ENGINEER.

1.2 HAY BALES ARE TO BE PLACED IN LOW FLOW DRAINAGE SWALES AND PATHS TO TRAP SEDIMENTS AND REDUCE RUNOFF VELOCITIES. DO NOT PLACE HAY BALES IN FLOWING WATER OR STREAMS. DUMPED STONE CHECK DAMS MAY BE USED IN LIEU OF HAY BALES TO ACHIEVE THE SAME RESULT.

1.3 RIPRAP: PROVIDE RIPRAP IN AREAS WHERE CULVERTS DISCHARGE OR AS SHOWN ON THE PLANS.

1.4 LOAM, SEED, & MULCH: ALL DISTURBED AREAS, WHICH ARE NOT OTHERWISE TREATED, SHALL RECEIVE PERMANENT SEEDING AND MULCH TO STABILIZE THE DISTURBED AREAS. THE DISTURBED AREAS WILL BE REVEGETATED WITHIN 5 DAYS OF FINAL GRADING. SEEDING REQUIREMENTS ARE PROVIDED AT THE END OF THIS SPECIFICATION.

2. TEMPORARY EROSION/SEDIMENTATION CONTROL MEASURES. PROVIDE THE FOLLOWING TEMPORARY EROSION/SEDIMENT CONTROL MEASURES DURING CONSTRUCTION OF THE FACILITY.

2.1 PLACE SILTATION FENCE OR FILTER BERM ALONG THE DOWNGRADIENT SIDE OF THE ROADWAY AND PARKING AREAS AND OF ALL FILL SECTIONS. THE FENCE OR BERM WILL REMAIN IN PLACE UNTIL THE SITE IS 85% REVEGETATED.

2.2 HAY BALES PLACED AT KEY LOCATIONS TO SUPPLEMENT THE SILT FENCE

2.3 PROTECT TEMPORARY STOCKPILES OF STUMPS, GRUBBINGS, OR COMMON EXCAVATION AS FOLLOWS;
- A. SOIL STOCKPILE SIDE SLOPES SHALL NOT EXCEED 2:1.
- B. AVOID PLACING TEMPORARY STOCKPILES IN AREAS WITH SLOPES OVER 10 PERCENT, OR NEAR DRAINAGE SWALES. SEE ITEM 3 IN CONSTRUCTION PHASE NOTES BELOW.
- C. STABILIZE STOCKPILES WITHIN 15 DAYS BY TEMPORARILY SEEDING WITH HYDROSEED OR BY COVERING THE STOCKPILE.
- D. SURROUND STOCKPILE SOIL WITH SILT FENCE AT BASE OF PILE.

2.4 ALL DENUDED AREAS WHICH HAVE BEEN ROUGH GRADED AND ARE NOT LOCATED WITHIN THE BUILDING PAD, OR PARKING AND DRIVEWAY SUBBASE AREAS SHALL RECEIVE MULCH WITHIN 30 DAYS OF INITIAL DISTURBANCE OF SOIL OR WITHIN 15 DAYS AFTER COMPLETING THE ROUGH GRADING OPERATIONS. IN THE EVENT THE CONTRACTOR COMPLETES FINAL GRADING AND INSTALLATION OF LOAM AND SEED WITHIN THE TIME PERIODS PRESENTED ABOVE, INSTALLATION OF MULCH AND NETTING, WHERE APPLICABLE, IS NOT REQUIRED.

2.5 IF WORK IS CONDUCTED BETWEEN OCTOBER 15 AND APRIL 15, ALL DENUDED AREAS ARE TO BE COVERED WITH HAY MULCH, APPLIED AT TWICE THE NORMAL APPLICATION RATE, AND ANCHORED WITH FABRIC NETTING. THE PERIOD BETWEEN FINAL GRADING AND MULCHING SHALL BE REDUCED TO A 15 DAY MAXIMUM.

2.6 TEMPORARY EROSION CONTROL MEASURES SHALL BE REMOVED ONCE THE SITE HAS BEEN STABILIZED OR IN AREAS WHERE PERMANENT EROSION CONTROL MEASURES HAVE BEEN INSTALLED.

3. PERMANENT EROSION CONTROL MEASURES. THE FOLLOWING PERMANENT CONTROL MEASURES ARE REQUIRED BY THIS EROSION/SEDIMENTATION CONTROL PLAN.

3.1 ALL AREAS DISTURBED DURING CONSTRUCTION BUT NOT SUBJECT TO OTHER RESTORATION (PAVING, RIPRAP, ETC.) WILL BE LOAMED, LIMED, FERTILIZED AND SEEDED. NATIVE TOPSOIL SHALL BE STOCKPILED AND REUSED FOR FINAL RESTORATION WHEN IT IS OF SUFFICIENT QUALITY.

3.2 NON-LEDGE SLOPES GREATER THAN 2:1 WILL RECEIVE RIPRAP.

CONSTRUCTION PHASE

THE FOLLOWING GENERAL PRACTICES WILL BE USED TO PREVENT EROSION DURING CONSTRUCTION OF THIS PROJECT.

1. ONLY THOSE AREAS UNDER ACTIVE CONSTRUCTION WILL BE CLEARED AND LEFT IN AN UNTREATED OR UNVEGETATED CONDITION. IF FINAL GRADING, LOAMING AND SEEDING WILL NOT OCCUR WITHIN 15 DAYS, SEE ITEM NO. 4.

2. PRIOR TO THE START OF CONSTRUCTION IN A SPECIFIC AREA, SILT FENCING, FILTER BERMS AND/OR HAY BALES WILL BE INSTALLED AT THE TOE OF SLOPE AND IN AREAS AS LOCATED ON THE PLANS TO PROTECT AGAINST ANY CONSTRUCTION RELATED EROSION. IMMEDIATELY FOLLOWING CONSTRUCTION OF CULVERTS AND SWALES, RIP RAP APRONS SHALL BE INSTALLED, AS SHOWN ON THE PLANS.

3. TOPSOIL WILL BE STOCKPILED WHEN NECESSARY IN AREAS WHICH HAVE MINIMUM POTENTIAL FOR EROSION AND WILL BE KEPT AS FAR AS POSSIBLE FROM THE EXISTING DRAINAGE COURSE. NO STOCKPILE SHALL BE CLOSER THAN 100' OF A RESOURCE INCLUDING, BUT NOT LIMITED TO, WETLANDS, STREAMS AND OPEN WATER BODIES. ALL STOCKPILES SHALL HAVE A SILT FENCE BELOW THEM REGARDLESS OF TIME OF PRESENCE. ALL STOCKPILES EXPECTED TO REMAIN LONGER THAN 15 DAYS SHALL BE:
- A. TREATED WITH ANCHORED MULCH (WITHIN 5 DAYS OF THE LAST DEPOSIT OF STOCKPILED SOIL).
- B. SEEDED WITH CONSERVATION MIX AND MULCH IMMEDIATELY.
- C. INSTALL SILT FENCE AROUND STOCKPILE AT BASE OF PILE.

4. ALL DISTURBED AREAS EXPECTED TO REMAIN LONGER THAN 30 DAYS SHALL BE EITHER:
- A. TREATED WITH ANCHORED MULCH IMMEDIATELY, OR
- B. SEEDED WITH CONSERVATION MIX OF ANNUAL RYE GRASS (0.9 LBS/1000 SQ. FT) AND MULCHED IMMEDIATELY.

5. ALL NON-LEDGE GRADING WILL BE HELD TO A MAXIMUM 2:1 SLOPE WHERE PRACTICAL. ALL SLOPES WILL BE STABILIZED WITH PERMANENT SEEDING, OR WITH STONE, WITHIN 5 DAYS AFTER FINAL GRADING IS COMPLETE. (SEE POST-CONSTRUCTION REVEGETATION FOR SEEDING SPECIFICATION.)

6. ALL CULVERTS WILL BE PROTECTED WITH STONE RIPRAP (D50=6" UNLESS OTHERWISE SPECIFIED) AT INLETS AND OUTLETS.

POST-CONSTRUCTION REVEGETATION

THE FOLLOWING GENERAL PRACTICES WILL BE USED TO PREVENT EROSION AS SOON AS AN AREA IS READY TO UNDERGO FINAL GRADING:

1. A MINIMUM OF 4" OF LOAM WILL BE SPREAD OVER DISTURBED AREAS AND GRADED TO A UNIFORM DEPTH AND NATURAL APPEARANCE, OR STONE WILL BE PLACED ON SLOPES TO STABILIZE SURFACES.

2. IF FINAL GRADING IS REACHED DURING THE NORMAL GROWING SEASON (4/15 TO 9/15), PERMANENT SEEDING WILL BE DONE AS SPECIFIED BELOW. PRIOR TO SEEDING, LIMESTONE SHALL BE APPLIED AT A RATE OF 138 LBS/100 SQ. FT. AND 10:20:20 FERTILIZER AT A RATE OF 18.4 LBS/100 SQ. FT. WILL BE APPLIED. BROADCAST SEEDING AT THE FOLLOWING RATES.

LAWNS	SWALES
KENTUCKY BLUE GRASS 0.46 LBS/1000 SF	RED TOP 0.05 LBS/1000 SF.
CREEPING RED FESCUE 0.46 LBS/1000 SF	TALL FESCUE 0.46 LBS/1000 SF.
PERENNIAL RYE GRASS 0.11 LB/1000 SF.	

3. AN AREA SHALL BE MULCHED IMMEDIATELY AFTER IT HAS BEEN SEEDED. MULCHING SHALL CONSIST OF HAY MULCH, HYDRO-MULCH, JUTE NET OVER MULCH, PRE-MANUFACTURED EROSION MATS OR ANY SUITABLE SUBSTITUTE DEEMED ACCEPTABLE BY THE RESIDENT ENGINEER.
- A. HAY MULCH SHALL BE APPLIED AT THE RATE OF 2 TONS PER ACRE. HAY MULCH SHALL BE SECURED BY EITHER;
  - I. BEING DRIVEN OVER BY TRACKED CONSTRUCTION EQUIPMENT ON GRADES OF 5% AND LESS.
  - II. BLANKETED BY TACKED PHOTODEGRADABLE/BIODEGRADABLE NETTING OR WITH SPRAY-ON
  - III. SEE NOTE 6, GENERAL NOTES, AND NOTE 8, WINTER CONSTRUCTION.
- B. HYDRO-MULCH SHALL CONSIST OF A MIXTURE OR EITHER ASPHALT, WOOD FIBER OR PAPER FIBER AND WATER SPRAYED OVER A SEEDED AREA. HYDRO-MULCH SHALL NOT BE USED BETWEEN 9/15 AND 4/15.

4. CONSTRUCTION SHALL BE PLANNED TO ELIMINATE THE NEED FOR SEEDING BETWEEN SEPTEMBER 15 AND APRIL 15. SHOULD SEEDING BE NECESSARY BETWEEN SEPTEMBER 15 AND APRIL 15 THE FOLLOWING PROCEDURE SHALL BE FOLLOWED. ALSO REFER TO NOTE 9 OF WINTER CONSTRUCTION.
- A. ONLY UNFROZEN LOAM SHALL BE USED.
- B. LOAMING, SEEDING AND MULCHING WILL NOT BE DONE OVER SNOW OR ICE COVER. IF SNOW EXISTS, IT MUST BE REMOVED PRIOR TO PLACEMENT OF SEED.
- C. WHERE PERMANENT SEEDING IS NECESSARY, ANNUAL WINTER RYE (1.2 LBS/1000 SQ. FT.) SHALL BE ADDED TO THE PREVIOUSLY NOTED AREAS
- D. WHERE TEMPORARY SEEDING IS REQUIRED, ANNUAL WINTER RYE (2.6 LBS/1000 SQ. FT) SHALL BE SOWN INSTEAD OF THE PREVIOUSLY NOTED SEEDING RATE.
- E. FERTILIZING, SEEDING AND MULCHING SHALL BE APPLIED TO LOAM THE DAY THE LOAM IS SPREAD BY MACHINERY
- F. ALTERNATIVE HAY MULCH SHALL BE SECURED WITH PHOTODEGRADABLE/BIODEGRADABLE NETTING. TRACKING BY MACHINERY ALONE WILL NOT SUFFICE.

5. FOLLOWING FINAL SEEDING, THE SITE WILL BE INSPECTED EVERY 30 DAYS UNTIL 85% COVER HAS BEEN ESTABLISHED. RESEEDING WILL BE CARRIED OUT BY THE CONTRACTOR WITHIN 10 DAYS OF NOTIFICATION BY THE ENGINEER THAT THE EXISTING CATCH IS INADEQUATE.

MONITORING SCHEDULE

THE CONTRACTOR IS RESPONSIBLE FOR INSTALLING, MONITORING, MAINTAINING, REPAIRING, REPLACING AND REMOVING ALL OF THE EROSION AND SEDIMENTATION CONTROLS OR APPOINTING A QUALIFIED SUBCONTRACTOR TO DO SO. MAINTENANCE MEASURES WILL BE APPLIED AS NEEDED DURING THE ENTIRE CONSTRUCTION CYCLE. AFTER EACH RAINFALL, A VISUAL INSPECTION WILL BE MADE OF ALL EROSION AND SEDIMENTATION CONTROLS AS FOLLOWS.

1. HAY BALE BARRIERS, SILT FENCE, FILTER BERMS AND STONE CHECK DAMS SHALL BE INSPECTED AND REPAIRED ONCE A WEEK OR IMMEDIATELY FOLLOWING ANY SIGNIFICANT RAINFALL. SEDIMENT TRAPPED BEHIND THESE BARRIERS SHALL BE EXCAVATED WHEN IT REACHES A DEPTH OF 6" AND REDISTRIBUTED TO AREAS UNDERGOING FINAL GRADING. SHOULD THE HAY BALE BARRIERS PROVE TO BE INEFFECTIVE, THE CONTRACTOR SHALL INSTALL SILT FENCE BEHIND THE HAY BALES.

2. VISUALLY INSPECT RIPRAP ONCE A WEEK OR AFTER EACH SIGNIFICANT RAINFALL AND REPAIR AS NEEDED. REMOVE SEDIMENT TRAPPED BEHIND THESE DEVICES ONCE IT ATTAINS A DEPTH EQUAL TO ½ THE HEIGHT OF THE DAM OR RISER. DISTRIBUTE REMOVED SEDIMENT OFF-SITE OR TO AN AREA UNDERGOING FINAL GRADING.

3. REVEGETATION OF DISTURBED AREAS WITHIN 25 FT. OF DRAINAGE-COURSE/STREAM WILL BE SEEDED WITH 'MEADOW AREA MIX' AND INSPECTED ON A WEEKLY BASIS OR AFTER EACH SIGNIFICANT RAINFALL AND RESEEDED AS NEEDED. EXPOSED AREAS WILL BE RESEEDED AS NEEDED UNTIL THE AREA HAS OBTAINED 100% GROWTH RATE. PROVIDE PERMANENT RIPRAP FOR SLOPES IN EXCESS OF 3:1 AND WITHIN 25' OF DRAINAGE COURSE.

WINTER MEASURES

1. WINTER CONSTRUCTION PERIOD: NOVEMBER 1 THROUGH APRIL 15.

2. WINTER EXCAVATION AND EARTHWORK SHALL BE COMPLETED SUCH THAT NO MORE THAN 1 ACRE OF THE SITE IS WITHOUT STABILIZATION AT ANY ONE TIME.

3. EXPOSED AREA SHALL BE LIMITED TO THOSE AREAS TO BE MULCHED IN ONE DAY PRIOR TO ANY SNOW EVENT. AT THE END OF EACH WORK WEEK NO AREAS MAY BE LEFT UNSTABILIZED OVER THE WEEKEND.

4. CONTINUATION OF EARTHWORK OPERATIONS ON ADDITIONAL AREAS SHALL NOT BEGIN UNTIL THE EXPOSED SOIL SURFACE ON THE AREA BEING WORKED HAS BEEN STABILIZED, SUCH THAT NO LARGER AREA OF THE SITE IS WITHOUT EROSION CONTROL PROTECTION AS LISTED IN ITEM 2 ABOVE.

5. AN AREA SHALL BE CONSIDERED TO HAVE BEEN STABILIZED WHEN EXPOSED SURFACES HAVE BEEN EITHER MULCHED WITH STRAW OR HAY AT A RATE OF 150 LB. PER 1000 SF (WITH OR WITHOUT SEEDING) OR DORMANT SEED, MULCHED AND ANCHORED SUCH THAT THE SOIL SURFACE IS NOT VISIBLE THROUGH THE MULCH. NOTE: AN AREA IS ALSO CONSIDERED STABLE IF SODDED, COVERED WITH GRAVEL (ROADWAY AND PARKING LOTS) OR STRUCTURAL SAND.

6. BETWEEN THE DATES OF OCTOBER 15 AND APRIL 1, LOAM OR SEED WILL NOT BE REQUIRED. DURING PERIODS OF ABOVE FREEZING TEMPERATURES THE SLOPES SHALL BE FINE GRADED AND EITHER PROTECTED WITH MULCH OR TEMPORARILY SEEDED AND MULCHED UNTIL SUCH TIME AS THE FINAL TREATMENT CAN BE APPLIED. IF THE DATE IS AFTER NOVEMBER 1 AND IF THE EXPOSED AREA HAS BEEN LOAMED, FINAL GRADED WITH A UNIFORM SURFACE, THEN THE AREA MAY BE DORMANT SEEDED AT A RATE OF 3 TIMES HIGHER THAN SPECIFIED FOR PERMANENT SEED AND THEN MULCHED. IF CONSTRUCTION CONTINUES DURING FREEZING WEATHER, ALL EXPOSED AREAS SHALL BE CONTINUOUSLY GRADED BEFORE FREEZING, AND THE SURFACE TEMPORARILY PROTECTED FROM EROSION BY THE APPLICATION OF MULCH. SLOPES SHALL NOT BE LEFT UNEXPOSED OVER THE WINTER OR ANY OTHER EXTENDED TIME OF WORK SUSPENSION, UNLESS TREATED IN THE ABOVE MANNER. UNTIL SUCH TIME AS WEATHER CONDITIONS ALLOW, DITCHES TO BE FINISHED WITH THE PERMANENT SURFACE TREATMENT. EROSION SHALL BE CONTROLLED BY THE INSTALLATION OF BALES OF HAY, SILT FENCE OR STONE CHECK DAMS IN ACCORDANCE WITH THE STANDARD DETAILS SHOWN ON THE DESIGN DRAWINGS. NOTE: DORMANT SEEDING SHOULD NOT BE ATTEMPTED UNLESS SOIL TEMPERATURE REMAINS BELOW 50 DEGREES AND DAY TIME TEMPERATURES REMAIN IN THE 30'S.

7. MULCH NETTING SHALL BE USED TO ANCHOR MULCH IN ALL DRAINAGE WAYS WITH A SLOPE GREATER THAN 3% FOR SLOPES EXPOSED TO DIRECT WINDS AND FOR ALL OTHER SLOPES GREATER THAN 8%. VEGETATED DRAINAGE SWALES SHALL BE LINED WITH EXCELSIOR OR CURLEX.

8. MULCH NETTING SHALL BE USED TO ANCHOR MULCH IN ALL DRAINAGE WAYS WITH SLOPES GREATER THAN 15%. AFTER OCTOBER 1 THE SAME APPLIES FOR ALL SLOPES GREATER THAN 8%.

9. BETWEEN THE DATES OF OCTOBER 15 TO NOVEMBER 1 WINTER RYE IS RECOMMENDED FOR STABILIZATION. AFTER NOVEMBER 1, WINTER RYE IS NOT EFFECTIVE. AROUND NOVEMBER 15 OR LATER, ONCE TEMPERATURES OF THE AIR AND SOIL PERMIT, DORMANT SEEDING IS EFFECTIVE.

10. IN THE EVENT OF SNOWFALL (FRESH OR CUMULATIVE) GREATER THAN 1 INCH DURING WINTER CONSTRUCTION PERIOD, ALL SNOW SHALL BE REMOVED FROM THE AREAS OF SEEDING AND MULCHING PRIOR TO PLACEMENT.

SITE INSPECTION AND MAINTENANCE

1. WEEKLY INSPECTIONS, AS WELL AS ROUTINE INSPECTIONS FOLLOWING RAIN FALLS, SHALL BE CONDUCTED BY THE GENERAL CONTRACTOR OF ALL TEMPORARY AND PERMANENT EROSION CONTROL DEVICES UNTIL FINAL ACCEPTANCE OF THE PROJECT (85% GRASS CATCH). NECESSARY REPAIRS SHALL BE MADE TO CORRECT UNDERMINING OR DETERIORATION. FINAL ACCEPTANCE SHALL INCLUDE A SITE INSPECTION TO VERIFY THE STABILITY OF ALL DISTURBED AREAS AND SLOPES. UNTIL FINAL INSPECTION, ALL EROSION AND SEDIMENTATION CONTROL MEASURES SHALL IMMEDIATELY BE CLEANED, AND REPAIRED BY THE GENERAL CONTRACTOR AS REQUIRED. DISPOSAL OF ALL TEMPORARY EROSION AND CONTROL DEVICES SHALL BE THE RESPONSIBILITY OF THE GENERAL CONTRACTOR.

2. SHORT-TERM SEDIMENTATION MAINTENANCE SHALL BE THE RESPONSIBILITY OF THE CONTRACTOR TO CLEAN OUT ALL SWALES AND STRUCTURES PRIOR TO TURNING PROJECT OVER.

3. LONG-TERM PROVISIONS FOR PERMANENT MAINTENANCE OF ALL EROSION AND SEDIMENTATION CONTROL DEVICES AFTER ACCEPTANCE OF THE PROJECT SHALL BE THE RESPONSIBILITY OF THE OWNER.

AS BUILT
Owner Copy

PREPARED BY:
HNTB
HNTB CORP.
2 THOMAS DRIVE
WESTBROOK, ME
04092

SMRT
ARCHITECTURE ENGINEERING PLANNING
SMRT
144 Fore Street/P.O. Box 618
Portland, Maine 04104
tel. (207) 772-3846
fax. (207) 772-1070

STATE OF MAINE
ROLAND A. LAVALLEE
No. 6452
REGISTERED PROFESSIONAL ENGINEER

PROJECT TITLE:
MAINE TURNPIKE AUTHORITY
ADMINISTRATION BUILDING
PORTLAND, MAINE

ISSUED FOR BIDDING/CONSTRUCTION
7-9-07

REV	DESCRIPTION	DATE
3	DOCS FOR OWNER REVIEW	8-11-07
2	ISSUED FOR CITY REVIEW	5-03-07
1	100% OWNER REVIEW	3-23-07
0	ISSUED FOR PERMITTING	2-09-07


GRAPHIC SCALE: 0" 1"

SCALE:	AS NOTED
PROJECT MANAGER:	GAB
JC/DRAWN BY:	MPC
A/E OF RECORD:	GAB
CAD FILE:	X
PROJECT NO:	2007.07
DATE:	01/07

SHEET TITLE:
EROSION AND SEDIMENT CONTROL NOTES


SHEET No.
CS302

© COPYRIGHT 2006 SMRT INC

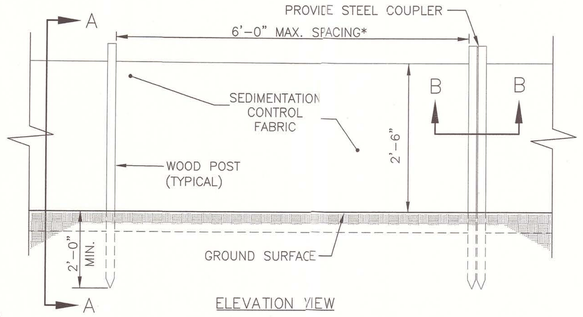


ELEVATION VIEW

***NOTE:**
THE SILT FENCE SHOULD HAVE A MAXIMUM STAKING DISTANCE OF 6' UNLESS THE FENCE IS SUPPORTED BY WIRE FENCE REINFORCEMENT A MAXIMUM 14 GAUGE AND WITH A MINIMUM MESH SPACING OF 6".

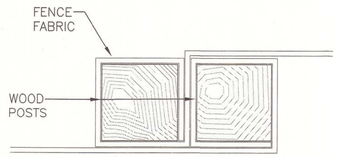

SECTION B–B

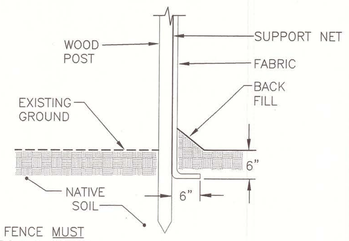


NOTE:
BOTTOM OF SILT FENCE MUST BE TOED INTO GROUND OR NO PAYMENT SHALL BE MADE.


SECTION A–A

F1 SILTATION FENCE


NTS *

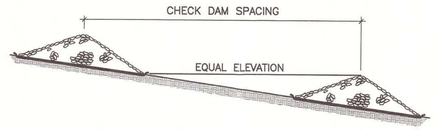

SPACING BETWEEN CHECK DAMS

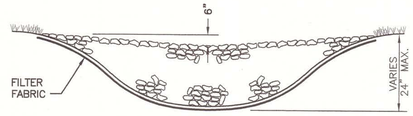

FRONT VIEW

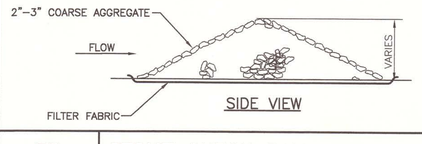


SIDE VIEW

SPACING GUIDE	
SLOPE (FT./FT.)	LENGTH (FT./FT.)
.020	100
.030	66
.040	50
.050	40
.080	25
.100	20
.120	17
.150	13


F6 STONE CHECK DAM

NTS *

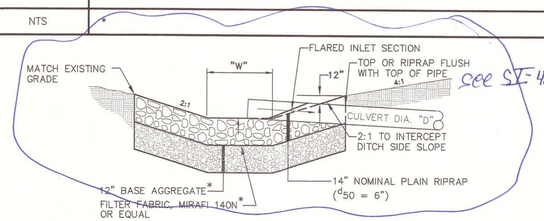

*DELETE ON ROCK SUBGRADE


SECTION VIEW

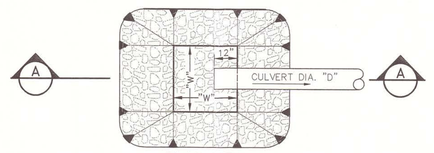


PLAN VIEW

SCHEDULE			
CULVERT DIAMETER (D)	WIDTH (W)	STONE d_{50}	RIPRAP THICKNESS
10"	4'	6"	14"
12"	4'	6"	14"
TWIN 18"	10'	6"	14"
TWIN 24"	10'	6"	14"
36"	9'	6"	14"

NOTE:
REINFORCEMENT BLANKET STAPLE SIZE AND DISTRIBUTION PER MANUFACTURERS SPECIFICATIONS.

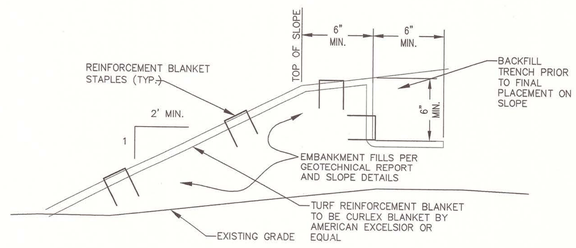


SECTION VIEW

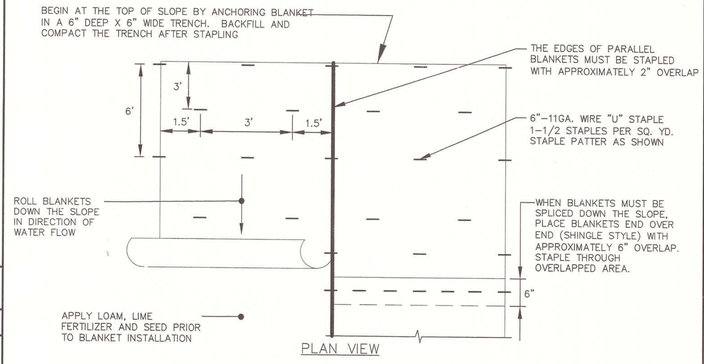

PLAN VIEW

E10 EROSION CONTROL BLANKET DETAIL

NTS *

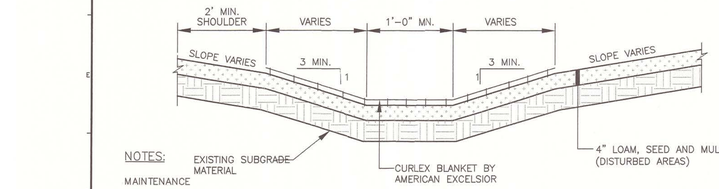

NOTES:

MAINTENANCE


MAINTENANCE OF THE VEGETATION IN THE GRASSED WATERWAY IS EXTREMELY IMPORTANT IN ORDER TO PREVENT RILLING, EROSION, AND FAILURE OF THE WATERWAY. MOWING SHOULD BE DONE FREQUENTLY ENOUGH TO CONTROL ENCROACHMENT OF WEEDS AND WOODY VEGETATION AND TO KEEP THE GRASSES IN A VIGOROUS CONDITION. THE VEGETATION SHOULD NOT BE MOWED TOO CLOSELY SO AS TO REDUCE THE EROSION RESISTANCE IN THE WATERWAY. THE WATERWAY SHOULD BE INSPECTED PERIODICALLY AND AFTER EVERY MAJOR STORM TO DETERMINE THE CONDITION OF THE WATERWAY. RILLS AND DAMAGED AREAS SHOULD BE PROMPTLY REPAIRED AND RE–VEGETATED AS NECESSARY TO PREVENT FURTHER DETERIORATION. PERIODIC APPLICATONS OF LIME AND FERTILIZER MAY BE NEEDED TO MAINTAIN VIGOROUS GROWTH.

CONSTRUCTION SPECIFICATIONS

1. THE FOUNDATION AREA OF THE WATERWAY SHALL BE CLEARED AND GRUBBED OF ALL TRESS, BRUSH, STUMPS, AND OTHER OBJECTIONABLE MATERIAL. MATERIALS REMOVED SHALL BE DISPOSED OF SO THEY WILL NOT INTERFERE WITH THE CONSTRUCTION OR PROPER FUNCTIONING OF THE WATERWAY.
2. THE WATERWAY SHALL BE EXCAVATED OR SHAPED TO LINE, GRADE, AND CROSS SECTION AS REQUIRED TO MEET THE DESIGN CRITERIA. THE WATERWAY SHALL BE FREE OF IRREGULARITIES WHICH WILL IMPEDE NORMAL FLOW.
3. EARTH FILLS REQUIRED TO MEET SUBGRADE REQUIRMENTS BECAUSE OF OVER EXCAVATION OR TOPOGRAPHY SHALL BE COMPACTED TO THE SAME DENSITY AS THE SURROUNDING SOIL TO PREVENT UNEQUAL SETTLEMENT THAT COULD CAUSE DAMAGE TO THE COMPLETED WATERWAY. EARTH REMOVED AND NOT NEEDED IN CONSTRUCTION SHALL BE SPREAD OR DISPOSED OF SO IT WILL NOT INTERFERE WITH THE FUNCTIONING OF THE WATERWAY.
4. STONE AND BEDDING FOR ROCK LINED WATERWAYS SHALL MEET THE GRADATION REQUIREMENTS OF THE DESIGN AND SHALL BE DURABLE AND FREE OF SOIL AND OTHER DEBRIS.
5. CONSTRUCTION OPERATIONS SHALL BE CARRIED OUT IN SUCH A MANNER AS TO MINIMIZE EROSION AND AIR AND WATER POLLUTION. ALL APPROPRIATE STATE AND LOCAL LAWS AND REGULATIONS SHALL BE COMPLIED WITH FOR DESIGN AND INSTALLATION.
6. THE WATERWAY SHALL BE STABILIZED USING THE APPROPRIATE BEST MANAGEMENT PRACTICES FOR VEGETATIVE MEASURES OR STONE CENTER.

A1 VEGETATED DRAINAGE SWALE

NTS *

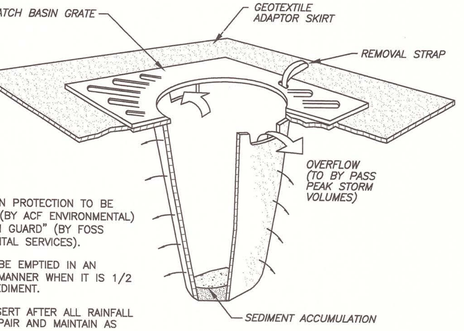

NOTES

1. CATCH BASIN PROTECTION TO BE "SILTSACK" (BY ACF ENVIRONMENTAL) OR "STREAM GUARD" (BY FOSS ENVIRONMENTAL SERVICES).
2. INSERT TO BE EMPTIED IN AN APPROVED MANNER WHEN IT IS 1/2 FULL OF SEDIMENT.
3. INSPECT INSERT AFTER ALL RAINFALL EVENTS, REPAIR AND MAINTAIN AS REQUIRED.

AS BUILT Owner Copy

A6 RIPRAP INLET APRON DETAIL

NTS *

A10 INLET PROTECTION DETAIL

NTS *

SMRT
ARCHITECTURE ENGINEERING PLANNING
SMRT
144 Fore Street / P.O. Box 618
Portland, Maine 04104
tel. (207) 772-3846
fax. (207) 772-1070

LICENSED LANDSCAPE ARCHITECT MARK G. JOHNSON No. 1857 REGISTERED 7/9/07

PROJECT TITLE:
MAINE TURNPIKE AUTHORITY ADMINISTRATION BUILDING
PORTLAND, MAINE

ISSUED FOR BIDDING/CONSTRUCTION 7-9-07

REV	DESCRIPTION	DATE
0	BIDDING/CONSTRUCTION	7-9-07


GRAPHIC SCALE: 0" 1"

SCALE:	SHOWN
PROJECT MANAGER:	SLB
JC/DRAWN BY:	TCM/PAF
A/E OF RECORD:	MGJ
CAD FILE:	06016–C504
PROJECT NO:	06016
DATE:	7–9–07

SHEET TITLE:
EROSION/SEDIMENT CONTROL DETAILS


SHEET No. CS501


© COPYRIGHT 2007 SMRT INC.

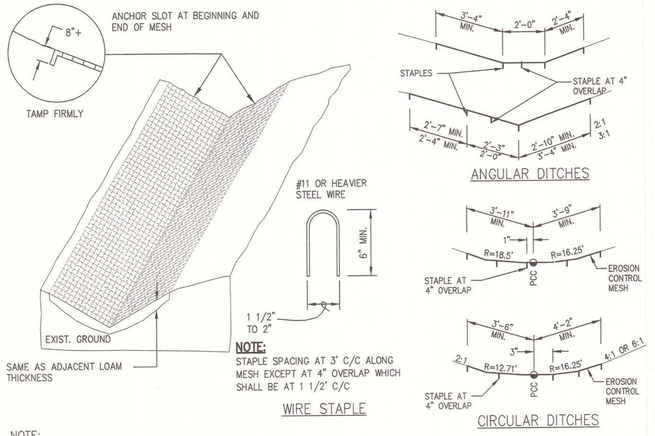

NOTE:
LOCATE STAPLES AT EDGES, AT QUARTER POINTS, & AT 4" OVERLAP.

F1	EROSION CONTROL MESH DETAIL
NTS	*

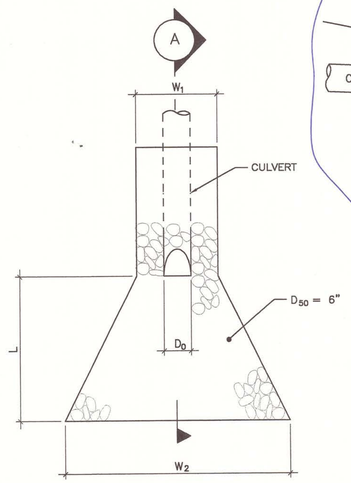


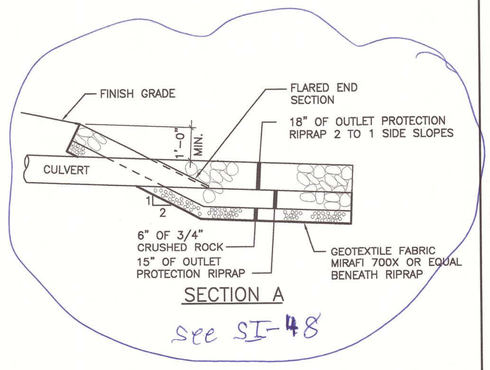

APRON SIZING SCHEDULE


DIAMETER, D_0	WIDTH AT CULVERT, W_1	WIDTH AT END, W_2	LENGTH, L
10"	4.0 FEET	6.0 FEET	6.0 FEET
12"	4.0 FEET	6.0 FEET	6.0 FEET
TWIN 18"	12.0 FEET	12.0 FEET	25.0 FEET
TWIN 24"	12.0 FEET	12.0 FEET	25.0 FEET
36"	6.0 FEET	12.0 FEET	25.0 FEET

F6	RIPRAP OUTLET APRON DETAIL
NTS	*

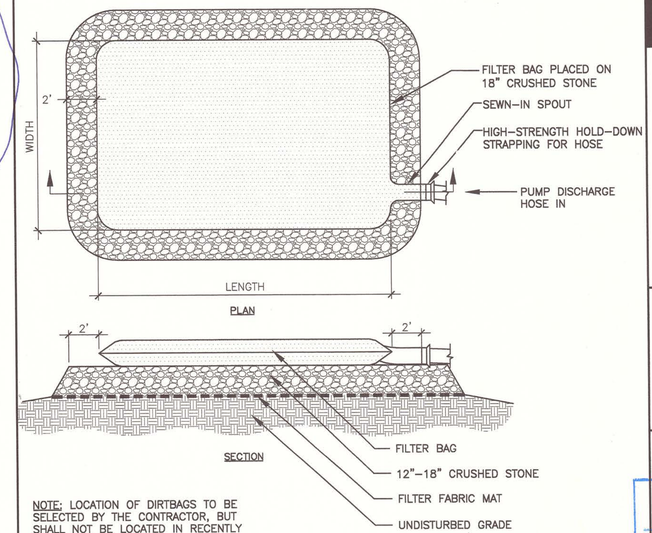

NOTE: LOCATION OF DIRTBAGS TO BE SELECTED BY THE CONTRACTOR, BUT SHALL NOT BE LOCATED IN RECENTLY DISTURBED OR UNSTABILIZED AREAS.


F11	DIRT BAG
NTS	*

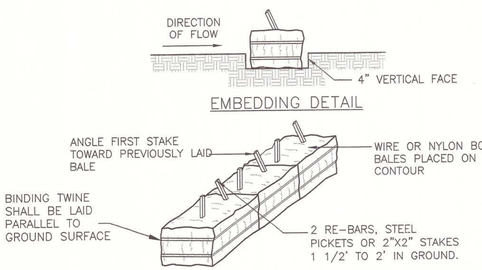

CONSTRUCTION SPECIFICATIONS

1. BALES SHALL BE PLACED IN A ROW WITH ENDS TIGHTLY ABUTTING THE ADJACENT BALES.
2. EACH BALE SHALL BE EMBEDDED IN THE SOIL A MINIMUM OF 4".
3. BALES SHALL BE SECURELY ANCHORED IN PLACE BY STAKES OR RE-BARS DRIVEN THROUGH THE BALES. THE FIRST STAKE IN EACH BALE SHALL BE ANGLED TOWARD PREVIOUSLY LAID BALE TO FORCE BALES TOGETHER.
4. INSPECTION SHALL BE FREQUENT AND REPAIR OR REPLACEMENT SHALL BE MADE PROMPTLY AS NEEDED.
5. BALES SHALL BE REMOVED WHEN THEY HAVE SERVED THEIR USEFULNESS SO AS NOT TO BLOCK OR IMPEDE STORM FLOW OR DRAINAGE.


A1	STRAW OR HAY BALE BARRIER
NTS	*

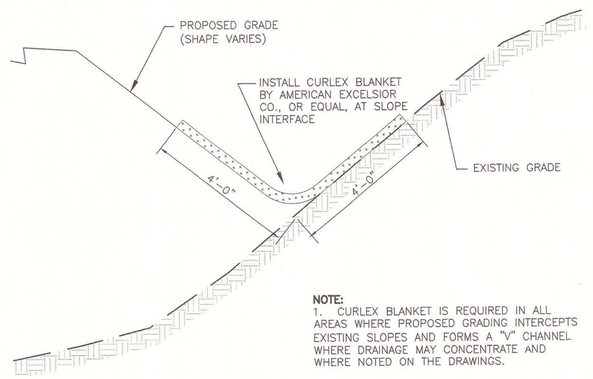

NOTE:
1. CURLEX BLANKET IS REQUIRED IN ALL AREAS WHERE PROPOSED GRADING INTERCEPTS EXISTING SLOPES AND FORMS A "V" CHANNEL WHERE DRAINAGE MAY CONCENTRATE AND WHERE NOTED ON THE DRAWINGS.

2. STAPLE SIZE AND DISTRIBUTION PER MANUFACTURERS SPECIFICATION.

A6	CURLEX BLANKET DETAIL
NTS	*

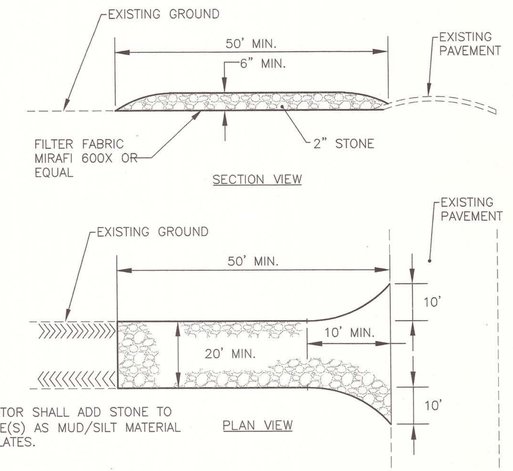

NOTE:
CONTRACTOR SHALL ADD STONE TO ENTRANCE(S) AS MUD/SILT MATERIAL ACCUMULATES.

A11	STABILIZED CONSTRUCTION ENTRANCE
NTS	*

SMRT
ARCHITECTURE ENGINEERING PLANNING
SMRT
144 Fore Street/P.O. Box 618
Portland, Maine 04104
tel. (207) 772-3846
fax. (207) 772-1070

LICENSED LANDSCAPE ARCHITECT MARK G. JOHNSON No. 1857 STATE OF MAINE

AS BUILT
Owner Copy

PROJECT TITLE:
MAINE TURNPIKE AUTHORITY
ADMINISTRATION BUILDING
PORTLAND, MAINE

ISSUED FOR BIDDING/CONSTRUCTION
7-9-07

REV	DESCRIPTION	DATE
0	BIDDING/CONSTRUCTION	7-9-07

GRAPHIC SCALE: 0" 1"

SCALE:	SHOWN
PROJECT MANAGER:	SLB
JC/DRAWN BY:	TCM/PAF
A/E OF RECORD:	MGJ
CAD FILE:	08016-C50
PROJECT NO:	08016
DATE:	7-9-07

SHEET TITLE:
EROSION/SEDIMENT CONTROL DETAILS

SHEET No.
CS502

© COPYRIGHT 2007 SMRT

CODES AND STANDARDS APPLICABLE TO SCOPE OF PROFESSIONAL SERVICES REQUESTED:

LIFE SAFETY CODE:
A. NFPA, INCLUDING:
101 LIFE SAFETY CODE, 2003 EDITION.
AUTHORITY HAVING JURISDICTION:
MAINE STATE DEPARTMENT OF PUBLIC SAFETY, STEVEN DODGE
PHONE: 207-624-8737
FAX: 207-624-8767

BUILDING CODE:
A. THE INTERNATIONAL BUILDING CODE, 2003 EDITION
AUTHORITY HAVING JURISDICTION: MIKE NUGENT
CITY OF PORTLAND BUILDING DEPARTMENT
PHONE: 207-XXX-XXXX
FAX: 207-XXX-XXXX

HANDICAPPED ACCESSIBILITY STANDARD:
A. AMERICANS WITH DISABILITIES ACT ACCESSIBILITY GUIDELINES
AUTHORITY HAVING JURISDICTION:
MAINE STATE DEPARTMENT OF PUBLIC SAFETY, STEPHEN DODGE
PHONE: 207-624-8737
FAX: 207-624-8767

OTHER REFERENCES:

NONE

BASIC LIFE SAFETY AND BUILDING CODE CRITERIA:

DESCRIPTION OF BUILDING FUNCTION:
NEW, MULTI-STORY, COMMERCIAL OFFICE BUILDING DESIGNED TO ACCOMMODATE A SINGLE TENANT. THE WORK OF THIS CONTRACT WILL INCLUDE BOTH SHELL AND CORE, AND FIT-UP FOR ALL THREE FLOORS.

OCCUPANT CLASSIFICATION(S):
NFPA 101:
NEW BUSINESS

USE GROUP CLASSIFICATION(S):
THE INTERNATIONAL BUILDING CODE:
BUSINESS

INCIDENTAL USE AREAS AND SPECIAL HAZARD PROTECTION AREAS:
THE INTERNATIONAL BUILDING CODE: TABLE 302.1.1

DESCRIPTION:	SEPARATION:
SHIP/RECEIVE	SPRINKLERS + SMOKE PARTITIONS
MECHANICAL RM.	SPRINKLERS + SMOKE PARTITIONS
ELECTRICAL ENTRANCE RM. (NFPA 70)	SPRINKLERS + 1 HOUR
ELEVATOR MACHINE ROOM	SPRINKLERS + 1 HOUR
SALLYPORT (ENCLOSED PARKING GARAGE)	SPRINKLERS + 1 HOUR
ARMORY	SPRINKLERS + 1 HOUR
SECURE EVIDENCE	SPRINKLERS + SMOKE PARTITIONS
TRANSPONDERS & FULFILLMENT	SPRINKLERS + SMOKE PARTITIONS
STORAGE RMS. > 100 SF.	SPRINKLERS + SMOKE PARTITIONS

SPECIAL USE AND OCCUPANCY:
NONE IDENTIFIED

OTHER PORTIONS OF THE BUILDING TO RECEIVE FIRE SEPARATION/PROTECTION MEASURES:

DESCRIPTION:	SEPARATION:
TEL/DATA ROOMS	SPRINKLERS + SMOKE PARTITIONS
SECONDARY ELECTRICAL ROOMS	SPRINKLERS + SMOKE PARTITIONS
COMPUTER SERVER ROOMS (NFPA75)	CLEAN AGENT FIRE PROT. + 1 HOUR

ACCESSORY USE AREAS:
THE INTERNATIONAL BUILDING CODE: 302.2
ASSEMBLY: (LESS THAN 10% OF THE AREA OF EACH STORY - NON-SEPARATED)
BREAKROOM
CONFERENCE ROOMS
AUTHORITY ROOM

COMMUNICATING SPACE(S):
NFPA 101: 8.6.6
THE INTERNATIONAL BUILDING CODE: 707.2, EXCEPTION 7

DESCRIPTION:	SEPARATION:
HALL	SPRINKLERS + SMOKE PARTITIONS
GALLERY	SPRINKLERS + SMOKE PARTITIONS

TYPE OF CONSTRUCTION:
CAST-IN-PLACE CONCRETE FOUNDATION AND SLAB-ON-GRADE. STRUCTURAL STEEL FRAME, METAL DECK, AND CONCRETE TOPPING AT ALL FLOORS WITH STEEL JOISTS, AND METAL DECK ROOF. BRICK MASONRY OVER METAL STUD BACK-UP WITH ALUMINUM STOREFRONT AND WINDOW SYSTEMS IN MASONRY OPENINGS AT LOWER PORTION OF EXTERIOR WALLS, AND COMPOSITE ALUMINUM PANELS WITH ALUMINUM WINDOW SYSTEMS AT UPPER PORTION OF EXTERIOR WALLS.
NFPA: NO REQUIREMENTS.
THE INTERNATIONAL BUILDING CODE: TYPE 2B

BUILDING WILL BE PROTECTED THROUGHOUT BY AUTOMATIC FIRE SPRINKLERS IN CONFORMANCE WITH NFPA 13, WITH THE EXCEPTION OF THOSE AREAS BEING PROTECTED BY CLEAN AGENT FIRE PROTECTION SYSTEMS IN CONFORMANCE WITH NFPA 2001 AND IBC, SECTION 904.

MINIMUM FIRE RESISTANCE RATINGS OF BUILDING ELEMENTS:
(THE INTERNATIONAL BUILDING CODE, TABLE 602 & NFPA 220, TABLE 3-1)
ELEMENT 2B/II(000)

STRUCTURAL FRAME	
COL., GIRDERS & TRUSSES	0 HR.
LOADBEARING EXTERIOR WALLS	0 HR.
LOADBEARING INTERIOR WALLS	0 HR.
NONBEARING EXTERIOR WALLS/PARTITIONS	0 HR.
NONBEARING INTERIOR WALLS/PARTITIONS	0 HR.
FIRE SEPARATION ASSEMBLIES:	
EXIT ENCLOSURES	1 HR.
SHAFTS & ELEV. HOISTWAYS	1 HR.
MIXED USE SEPARATIONS	(NA)
EXIT ACCESS CORRIDORS	0 HR. TABLE 1011.4
TENANT SPACES SEPARATION (MTA/S.P.)	1 HR. (NOT REQUIRED BY CODE))
SMOKE BARRIERS	0 HR.
FLOOR CONSTRUCTION INCLUDING BEAMS	0 HR.
ROOF/CEILING:	0 HR.

BUILDING HEIGHT:
ALLOWABLE: (THE INTERNATIONAL BUILDING CODE, TABLE 503)

TABLE 503	4 STORIES, 55 FEET
WITH SPRINKLER MODIFICATION	5 STORIES, 75 FEET
ACTUAL:	
3 STORIES, 41 FEET+/-	

BUILDING AREA:
ALLOWABLE: (THE BOCA, TABLE 503)

TABLE 503	23,000 SF
STREET FRONTAGE INCREASE	12,650 SF
SPRINKLER MODIFICATION	46,000 SF
MAX. ALLOWABLE AREA (FLOOR)	81,650 SF
MAX. BLDG. AREA	244,950 SF
ACTUAL:	
FLOOR	18,340 SF
BUILDING	54,716 SF

MEANS OF EGRESS:
OCCUPANT LOAD:

FIRST FLOOR:	284
SECOND FLOOR:	338
THIRD FLOOR:	340
	962

MINIMUM NUMBER: TWO, INCLUDING ALL ROOMS AND AREAS WITH OVER 50 OCCUPANTS.
CAPACITY:

EXIT ACCESS: ALLOWABLE MINIMUM WIDTH	44 IN.
DOORS: ALLOWABLE MINIMUM WIDTH	36 IN.

ARRANGEMENT:

MAX. ALLOWABLE DEAD-END CORRIDOR:	50 FT.
MAX. ALLOWABLE TRAVEL DISTANCE:	300 FT.
MAX. ALLOWABLE COMMON PATH OF TRAVEL	100 FT.

ILLUMINATION OF MEANS OF EGRESS:
EGRESS WILL BE ILLUMINATED BY LIGHT FIXTURES ON A CIRCUIT POWERED BY AN EMERGENCY GENERATOR CONFORMING WITH NFPA 110.

PROTECTION FROM HAZARDS:
WATER BASED AUTOMATIC FIRE PROTECTION SYSTEM CONFORMING WITH NFPA 13, TYPICAL THROUGHOUT THE BUILDING UNLESS NOTED OTHERWISE.

CLEAN AGENT AUTOMATIC FIRE PROTECTION SYSTEM CONFORMING WITH NFPA 2001 IN LIMITED AREAS AS DESCRIBED ON THE DRAWINGS.

SPECIAL HAZARD PROTECTION AREAS WILL BE FIRE OR SMOKE SEPARATED AS IDENTIFIED ABOVE.

PROTECTION OF VERTICAL OPENINGS:
VERTICAL OPENINGS WILL BE PROTECTED TO MAINTAIN THE INTEGRITY OF AREA SEPARATIONS. REFERENCE MINIMUM FIRE RESISTANCE RATINGS OF STRUCTURAL ELEMENTS ABOVE.

INTERIOR FINISH:
WALL AND CEILING FINISHES:

USE GROUP	EXITS	CORRIDORS	ROOMS
A			
FLAME SPREAD*:	0-25	0-25 TYP. 0-75 LOBBIES	0-75 CONF. & AUTH. RMS. 0-200 TYP.
SMOKE DEVELOPMENT**	0-450	0-450	0-450

*ASTM E84
**NFPA 255

FLOOR FINISHES:

USE GROUP	EXITS	CORRIDORS	ROOMS
CRITICAL RADIANT FLUX*	NO REQUIREMENTS		
ASTM E648**	CLASS II (0.22 WATTS/CM2)		

*NFPA 253
**IBC

DETECTION, ALARM AND COMMUNICATION SYSTEMS:
A FIRE ALARM SYSTEM WILL BE REQUIRED IN ACCORDANCE WITH NFPA 101, 9.6.

EXTINGUISHMENT:
PORTABLE EXTINGUISHERS IN ACCORDANCE WITH NFPA 101, 9.7.4.1.

END OF CODE COMPLIANCE STRATEGY REPORT

GENERAL NOTES:

1. SEE GI001 FOR PROJECT GENERAL NOTES.

AS BUILT
Owner Copy


LEGEND:

(LEGEND IS FOR THIS SHEET ONLY)


- HATCH INDICATES GENERAL AREAS OF HORIZONTAL STRUCTURAL STEEL TO RECEIVE SPRAY-ON FIREPROOFING AND VERTICAL AND DIAGONAL STRUCTURAL STEEL TO BE INDIVIDUALLY WRAPPED WITH GWB AND SEALED TIGHT. REFER TO STRUCTURAL DRAWINGS FOR ADDITIONAL INFORMATION.
- HATCH INDICATES AREAS OF 1 HOUR FIRE-RATED SHAFTS.
- HATCH INDICATES AREAS TO RECEIVE CLEAN AGENT FIRE PROTECTION.
- HATCH INDICATES AREAS TO RECEIVE DOUBLE PRE-ACTION DRY FIRE PROTECTION.
- SECURE 1 HOUR FIRE-RATED SEPARATION
- NON-SECURE 1 HOUR FIRE-RATED SEPARATION
- SMOKE BARRIER

F1	LIFE SAFETY AND BUILDING CODE COMPLIANCE STRATEGY REPORT
NONE	-


Fire Stopping Identification - REL-361 changed to Stencils

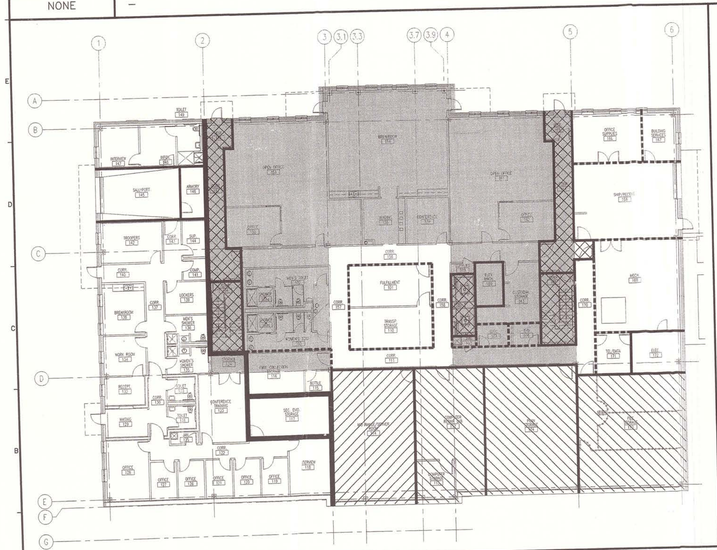

A1	FIRST FLOOR CODE DIAGRAM
1" = 20'-0"	-

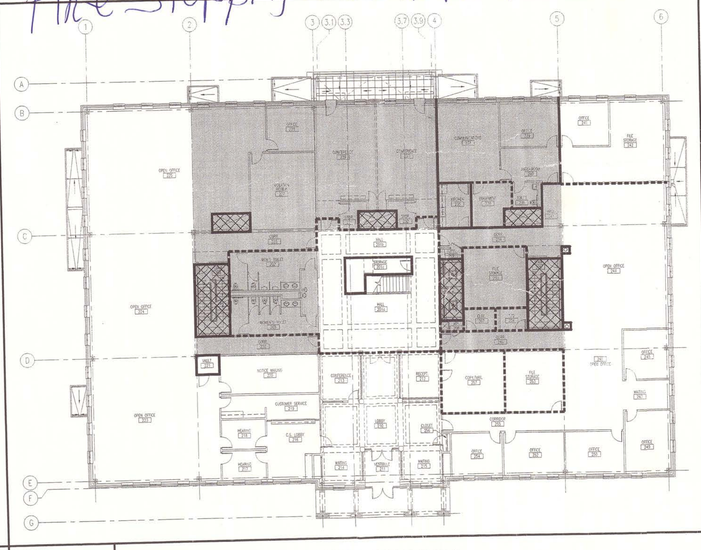

A6	SECOND FLOOR CODE DIAGRAM
1" = 20'-0"	-

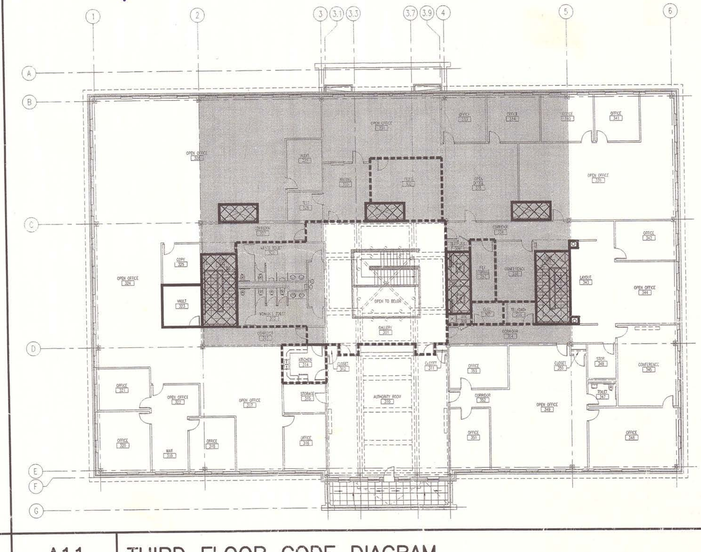

A11	THIRD FLOOR CODE DIAGRAM
1" = 20'-0"	-

SMRT
ARCHITECTURE ENGINEERING PLANNING
SMRT
144 Fore Street/P.O. Box 618
Portland, Maine 04104
tel. (207) 772-3846
fax. (207) 772-1070

STATE OF MAINE
SCOTT L BENSON
No. 1772
REGISTERED PROFESSIONAL ARCHITECT

PROJECT NORTH
MAG NORTH

PROJECT TITLE:
MAINE TURNPIKE AUTHORITY ADMINISTRATION BUILDING
PORTLAND, MAINE

CURRENT ISSUE STATUS:
ISSUED FOR BIDDING/CONSTRUCTION
7-9-07

REV	DESCRIPTION	DATE
0	BIDDING/CONSTRUCTION	7-9-07


GRAPHIC SCALE: 0" 1"

SCALE:	AS NOTED
PROJECT MANAGER:	SLB
JC/DRAWN BY:	TCM/TCM
A/E OF RECORD:	SLB
CAD FILE:	AE001-06016
PROJECT NO:	06016
DATE:	7-9-07

SHEET TITLE:
CODE COMPLIANCE INFORMATION

SHEET No.
AE001

© COPYRIGHT 2007 SMRT INC

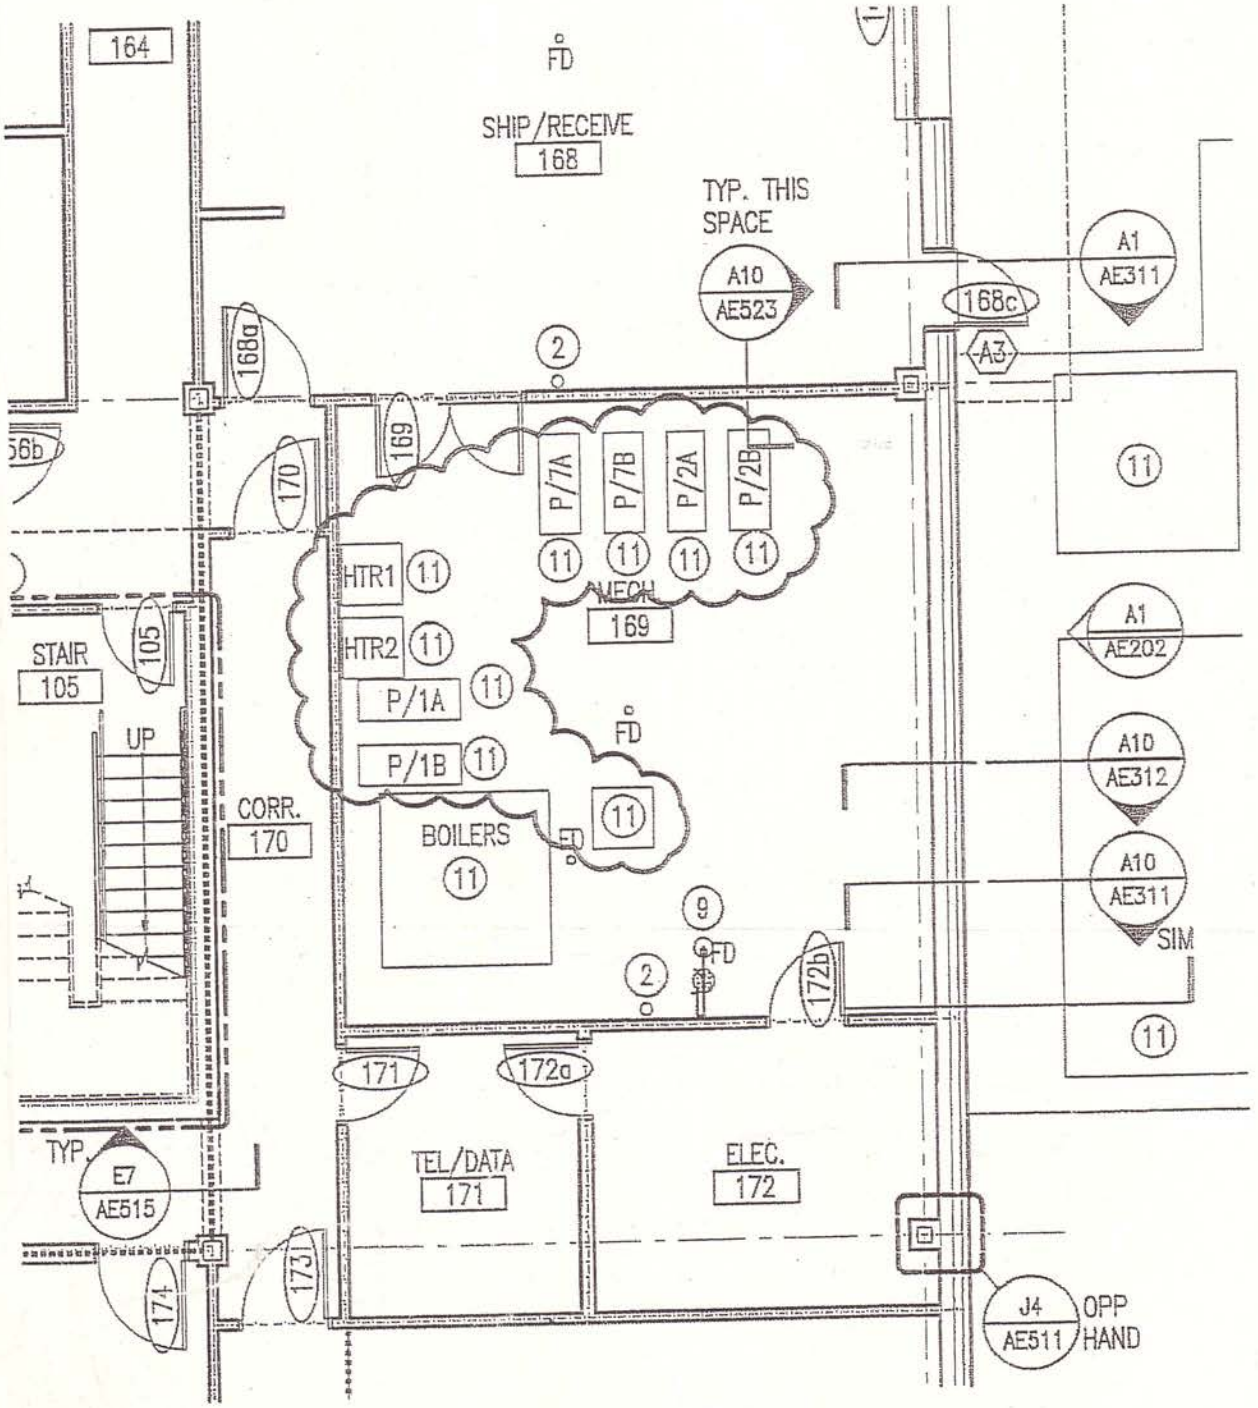

SMRT

ARCHITECTURE ENGINEERING PLANNING

SMRT
144 Fore Street/P.O.Box 618 PORTLAND, MAINE 04104
tel. (207) 772-3846 / fax. (207) 772-1070

PROJECT: MAINE TURNPIKE AUTHORITY
ADMINISTRATION BUILDING


SUBJECT: FIRST FLOOR PLAN
REVISED AS NOTED

SCALE:	1/8"=1'-0"
CAD FILE:	AE101-06016
PROJECT No.	06016
REF. SHEET:	AE101
PM:	SLB
A/E:	SLB
DATE:	8-10-07

ADDENDUM No. ADD-4

SKETCH No. A-14

© COPYRIGHT 2007 SMRT INC.

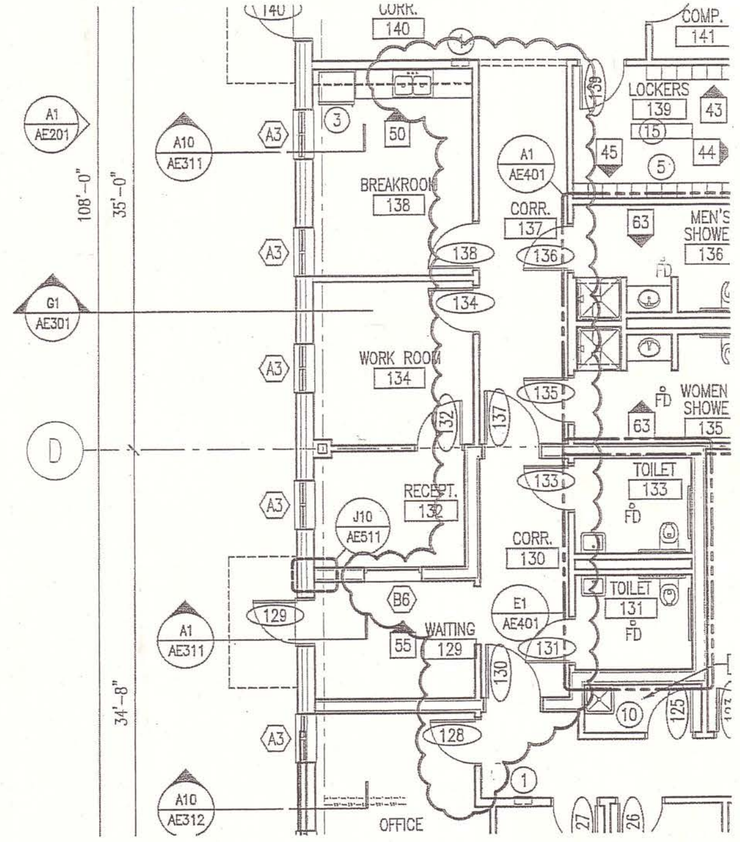


SMRT

ARCHITECTURE ENGINEERING PLANNING

SMRT
144 Fore Street/P.O.Box 618 PORTLAND, MAINE 04104
tel. (207) 772-3846 / fax. (207) 772-1070

PROJECT:	MAINE TURNPIKE AUTHORITY ADMINISTRATION BUILDING
SUBJECT:	FIRST FLOOR PLAN

SCALE:	1/8"=1'-0"
CAD FILE:	AE101-06016
PROJECT No.	06016
REF. SHEET:	AE101
PM: SLB	ADDENDUM No. ADD-4
A/E: SLB	SKETCH No. A-1
DATE: 8-10-07	

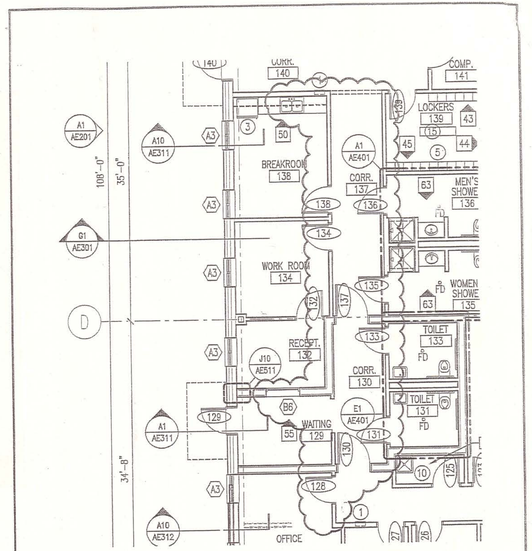


SM RT	ARCHITECTURE ENGINEERING PLANNING SMRT 144 Fore Street/P.O.Box 616 PORTLAND, MAINE 04104 tel.: (207) 772-3846 / fax: (207) 772-1070	SCALE: 1/8"=1'-0" CAD FILE: AE101-06016 PROJECT No. 06016 REF. SHEET: AE101
PROJECT:	MAINE TURNPIKE AUTHORITY ADMINISTRATION BUILDING	P.M.: SLB A/E: SLB DATE: 8-10-07
SUBJECT:	FIRST FLOOR PLAN	ADDENDUM No. ADD-4 SHEET No. A-1

GENERAL NOTES:

1. SEE GI001 FOR PROJECT GENERAL NOTES.

FLOOR PLAN NOTES:

1. REFER TO AE600 SERIES DRAWINGS FOR WINDOW AND DOOR TYPES.

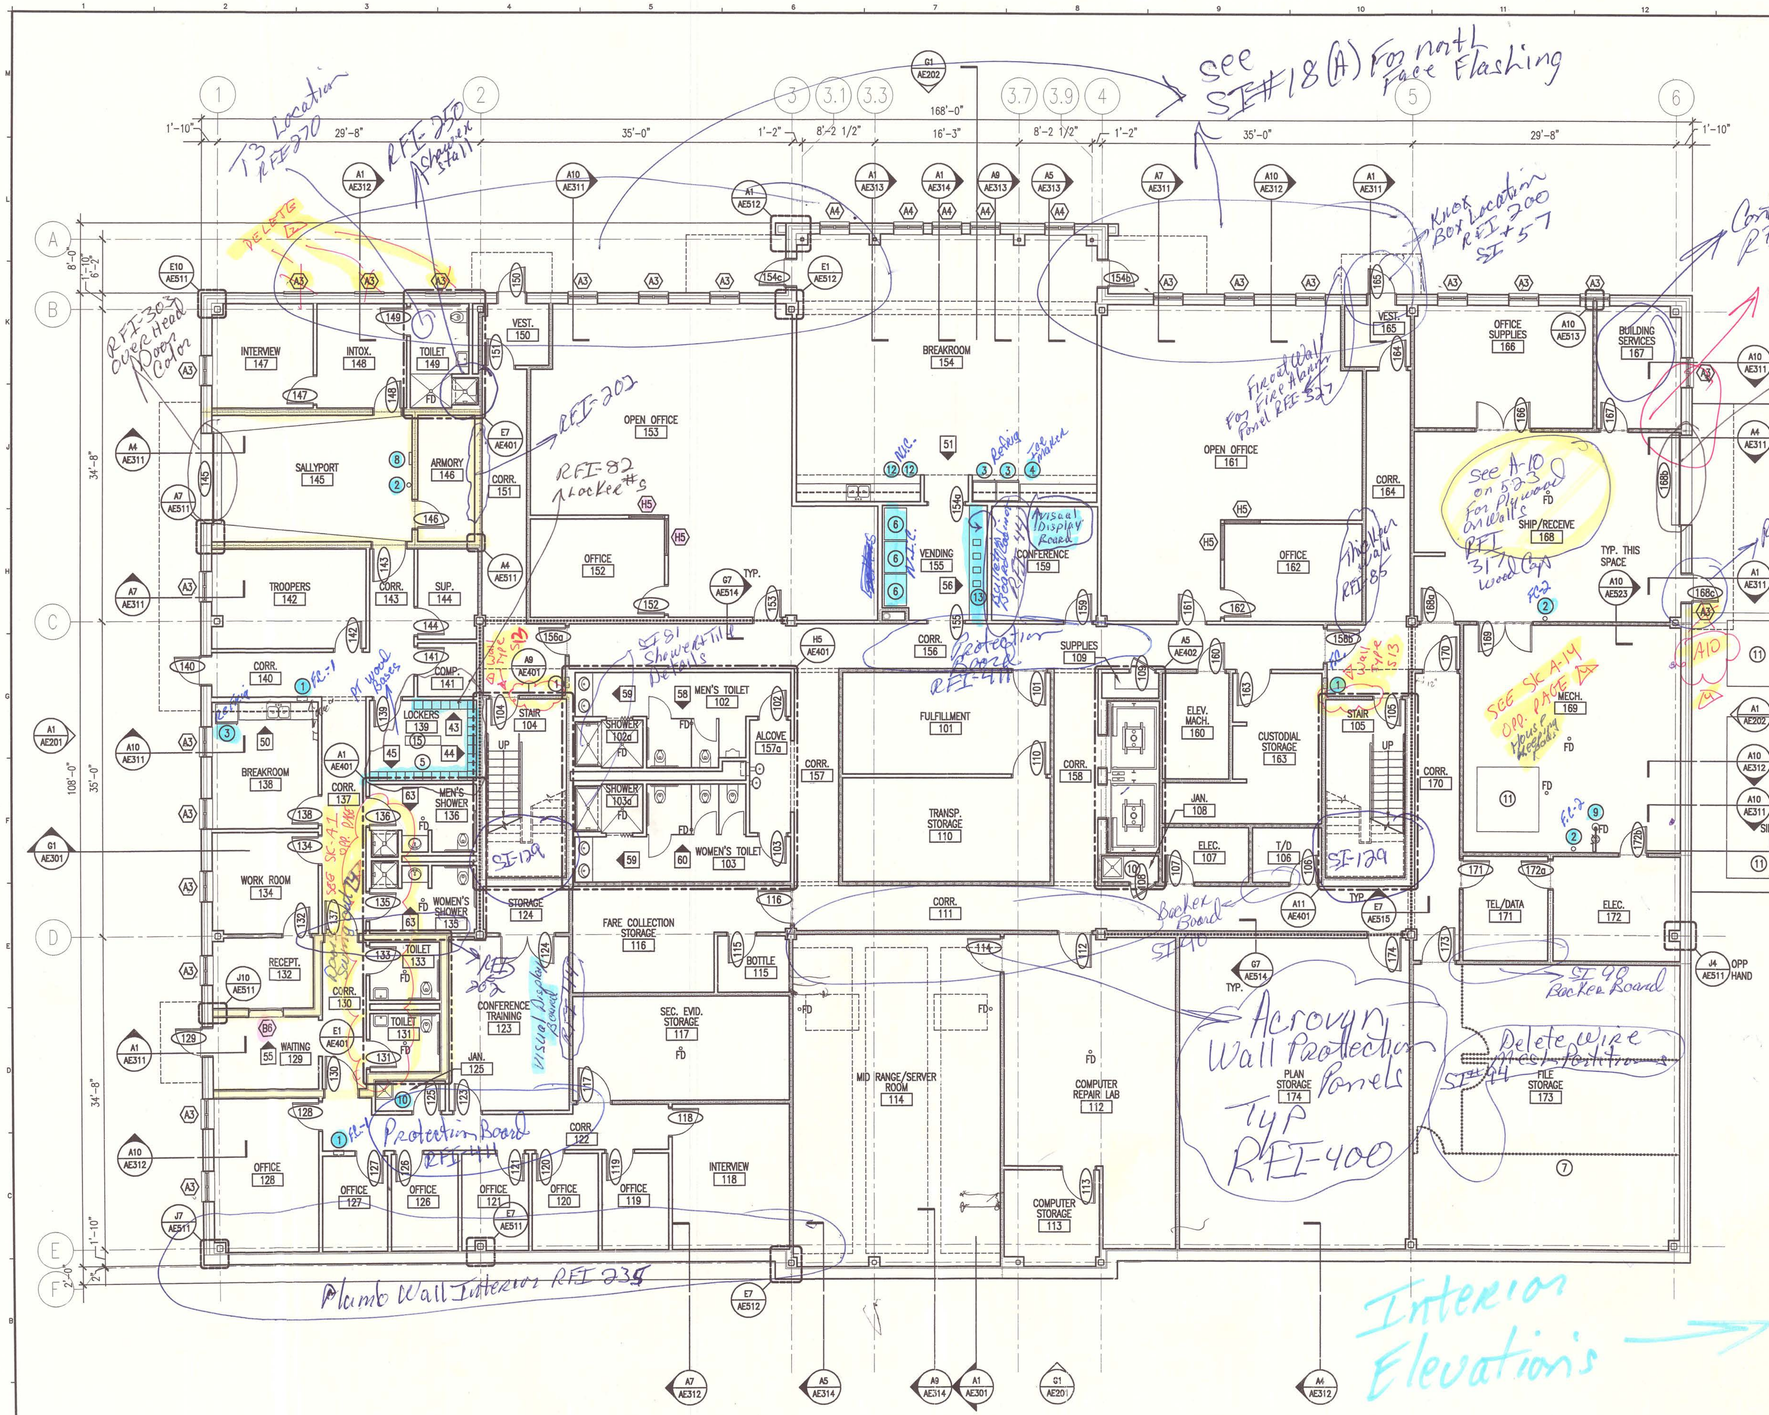

KEY NOTES:

1. FIRE EXTINGUISHER FE-1
2. FIRE EXTINGUISHER FE-2
3. REFRIGERATOR
4. ICE MAKER
5. LOCKERS
6. VENDING MACHINE, N.I.C.
7. WIRE MESH PARTITIONS
8. WALL MOUNTED EYE WASH
9. EYE WASH/EMERGENCY SHOWER
10. SLOP SINK W/ MOP RACK
11. HOUSEKEEPING PADS, RE: STRUCT.
12. COFFEE MAKER, N.I.C.
13. BULLETIN BOARD CABINET
14. AUTOMATED TELLER MACHINE, N.I.C.
15. FIXED BENCH
16. STEEL ROOF LADDER

(4) 10 ft high with 3 ft. 8 inches wide x 7 ft. high doors

INTERIOR ELEVATION SCHEDULE (X)

ELEVATION	ROOM NAME & NO.	WALL	ELEVATION REFERENCE
43	LOCKERS 139	N	J1/AE218
44	LOCKERS 139	E	J1/AE218
45	LOCKERS 139	S	J1/AE218
50	BREAKROOM 138	N	E9/AE218
51	BREAKROOM 154	S	A1/AE218
58	MEN'S SHOWER 102	S	J1/AE220
59	SHOWERS 102 & 103 (SINKS)	W	J6/AE220
60	WOMEN'S SHOWER 103	N	J6/AE220
63	SHOWERS 135 & 136	N/S	A1/AE220
55	Waiting 129	N	I31/AE219
56	Vending 155	E	I65/AE219
–	–	–	–

AS BUILT OWNER COPY

A1 | FIRST FLOOR PLAN

1/8" = 1'-0" | –

SMRT
ARCHITECTURE ENGINEERING PLANNING
SMRT
144 Fore Street/P.O. Box 618
Portland, Maine 04104
tel. (207) 772-3846
fax. (207) 772-1070

STATE OF MAINE SCOTT L BENSON No. 1772 REGISTERED PROFESSIONAL ARCHITECT

PROJECT NORTH
MAG. NORTH


PROJECT TITLE: MAINE TURNPIKE AUTHORITY ADMINISTRATION BUILDING PORTLAND, MAINE

CURRENT ISSUE STATUS: ISSUED FOR BIDDING/CONSTRUCTION 7-9-07

REV.	DESCRIPTION	DATE
0	BIDDING/CONSTRUCTION	7-9-07

GRAPHIC SCALE: 0" 1"

SCALE:	AS NOTED
PROJECT MANAGER:	SLB
JC/DRAWN BY:	TCM/TCM
A/E OF RECORD:	SLB
CAD FILE:	AE101--06016
PROJECT NO:	06016
DATE:	7-9-07
SHEET TITLE:	FIRST FLOOR PLAN
SHEET No.	AE101

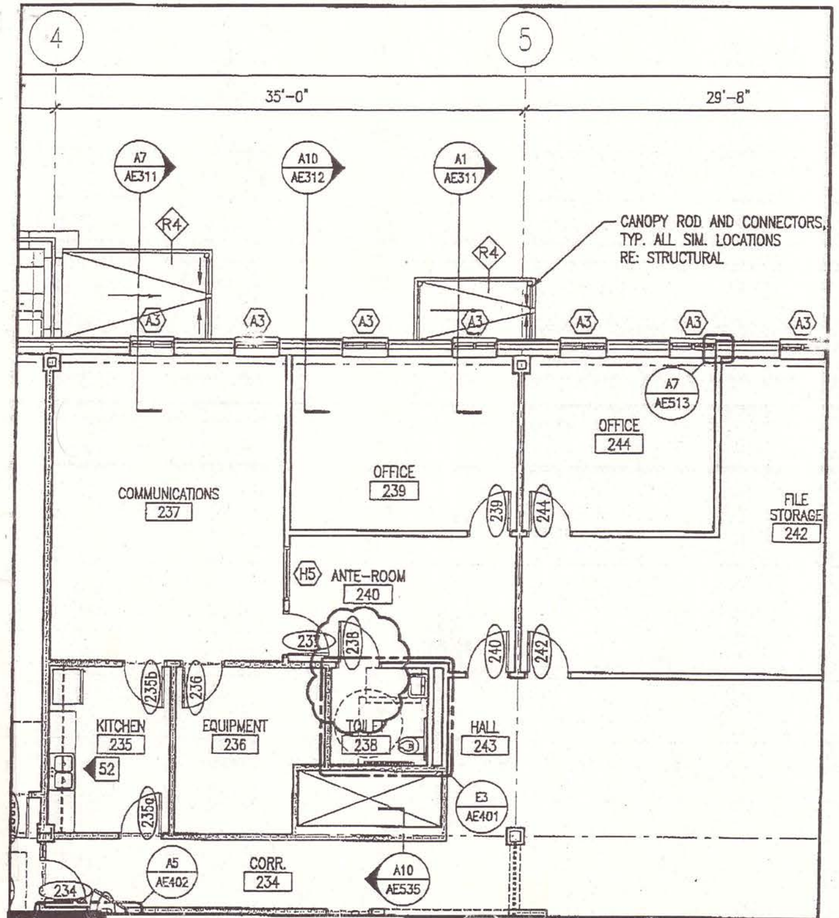

SMRT


ARCHITECTURE ENGINEERING PLANNING

SMRT
144 Fore Street/P.O.Box 618 PORTLAND, MAINE 04104
tel. (207) 772-3846 / fax. (207) 772-1070

PROJECT:	MAINE TURNPIKE AUTHORITY ADMINISTRATION BUILDING
SUBJECT:	REVISED DOOR SWING AT TOILET 238 SECOND FLOOR PLAN

SCALE:	1/8"=1'-0"
CAD FILE:	AE102-06016
PROJECT No.	06016
REF. SHEET:	AE102
PM: SLB	ADDENDUM No. ADD-5
A/E: SLB	SHEET No. A-1
DATE: 8-17-07	

© COPYRIGHT 2007 SMRT INC.

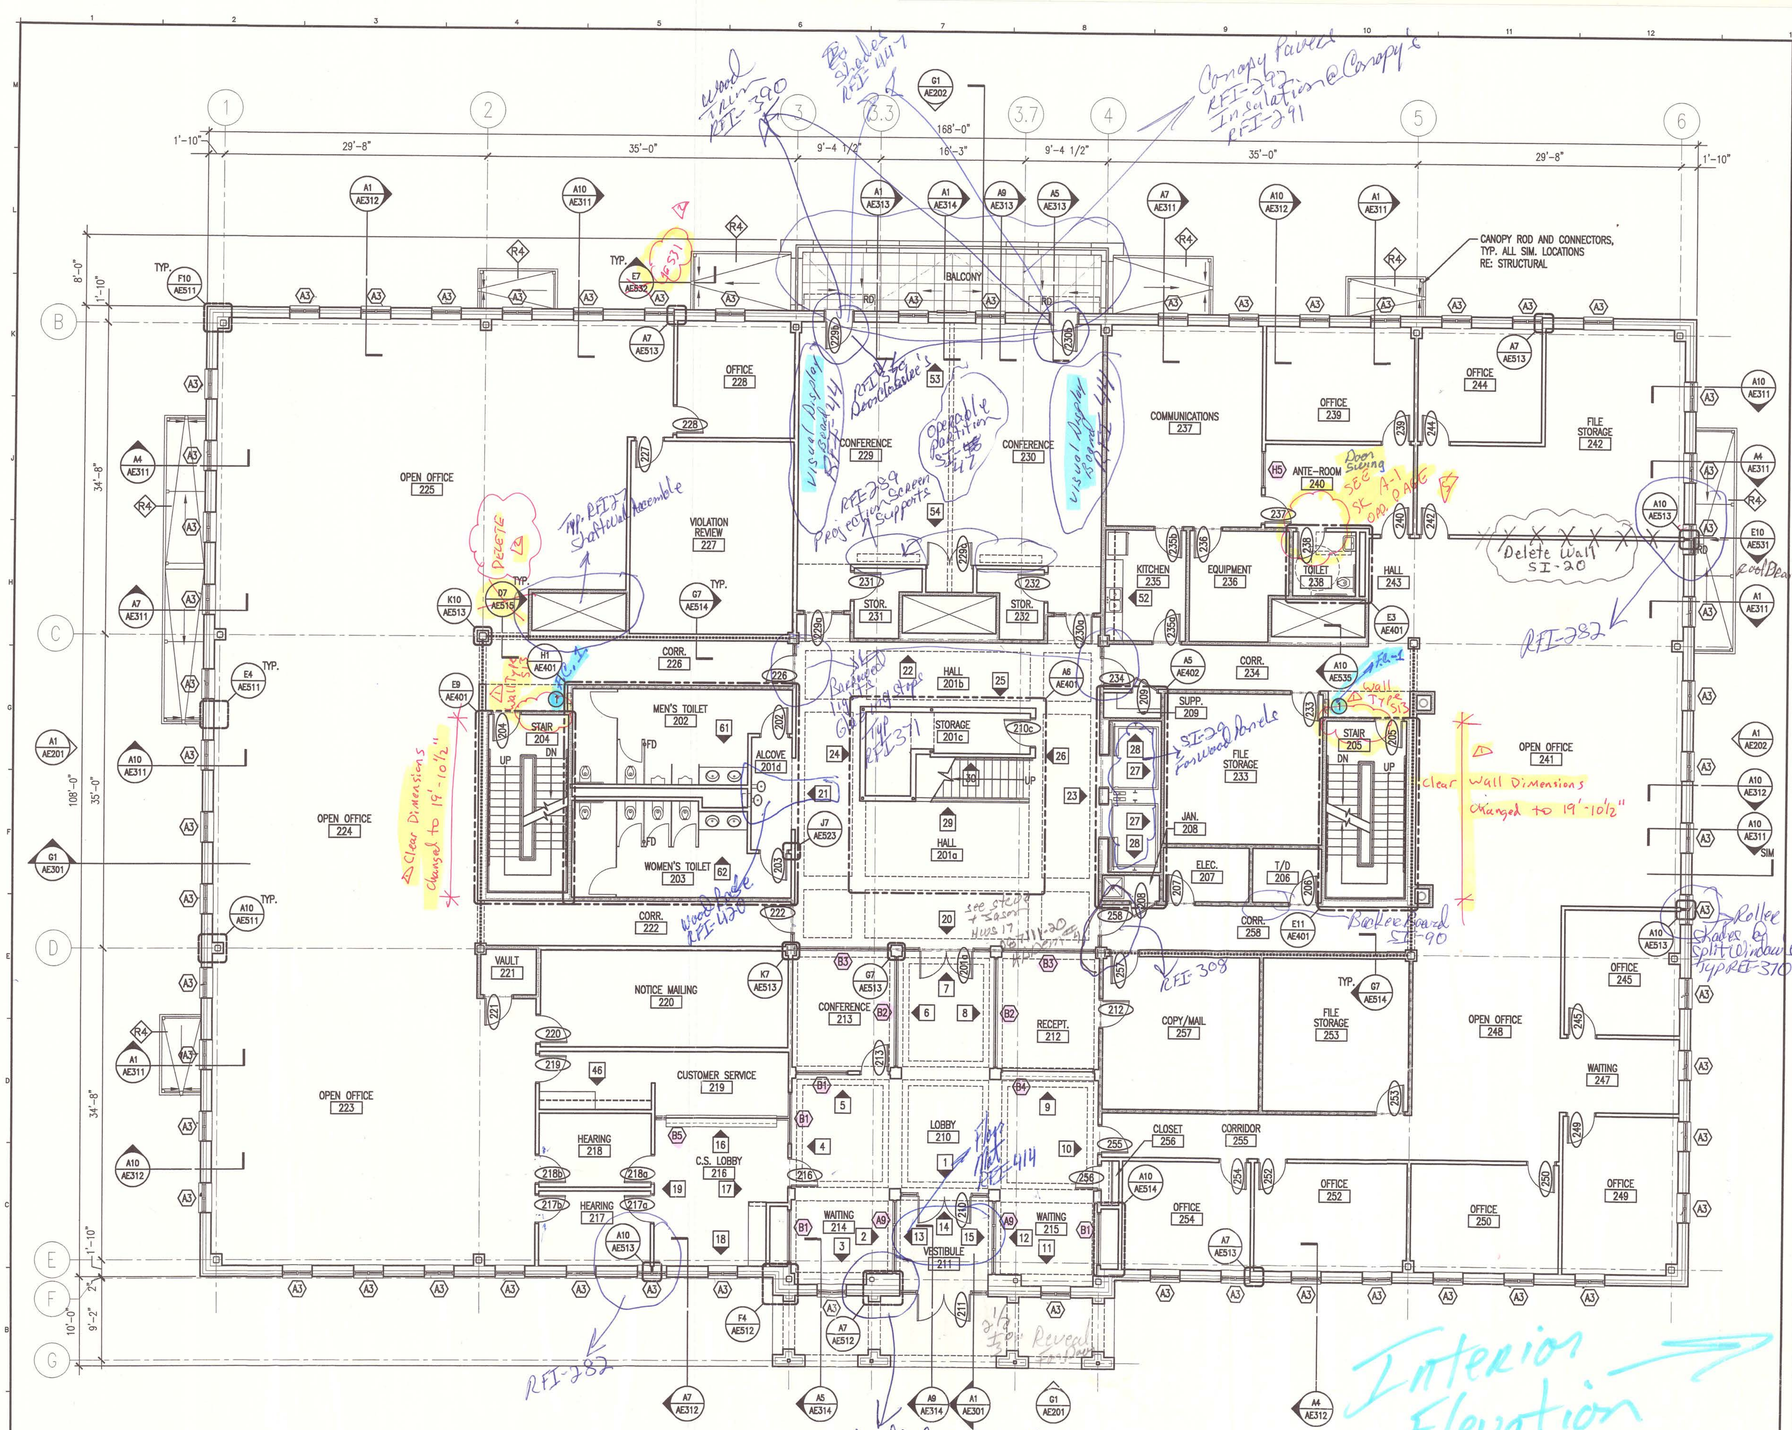

A1 — SECOND FLOOR PLAN

1/8" = 1'-0"

GENERAL NOTES:

1. SEE G1001 FOR PROJECT GENERAL NOTES.

FLOOR PLAN NOTES:

1. REFER TO AE600 SERIES DRAWINGS FOR WINDOW AND DOOR TYPES.
2. REFER TO AE112 FOR PARTITION TYPES AND PARTITION LOCATION.

KEY NOTES:

1. FIRE EXTINGUISHER FE-1
2. FIRE EXTINGUISHER FE-2
3. REFRIGERATOR
4. ICE MAKER
5. LOCKERS
6. VENDING MACHINE, N.I.C.
7. WIRE MESH PARTITIONS
8. WALL MOUNTED EYE WASH
9. EYE WASH/EMERGENCY SHOWER
10. SLOP SINK W/ MOP RACK
11. HOUSEKEEPING PADS, RE: STRUCT.
12. COFFEE MAKER, N.I.C.
13. BULLETIN BOARD CABINET
14. AUTOMATED TELLER MACHINE, N.I.C.
15. FIXED BENCH
16. STEEL ROOF LADDER

AS BUILT Owner Copy

INTERIOR ELEVATION SCHEDULE

ELEVATION	ROOM NAME & NO.	WALL	ELEVATION REFERENCE
1	LOBBY 210	S	J1/AE211
2	WAITING 214	E	J1/AE211
3	WAITING 214	S	J1/AE211
4	LOBBY 210/WAITING 214	W	J1/AE211
5	LOBBY 210	N	E1/AE211
6	LOBBY 210	W	E1/AE211
7	LOBBY 210	N	E1/AE211
8	LOBBY 210	E	E1/AE211
9	LOBBY 210	N	E1/AE211
10	LOBBY 210/WAITING 214	E	A1/AE211
11	WAITING 215	S	J1/AE211
12	WAITING 215	W	J1/AE211
13	VESTIBULE 211	W	A6/AE211
14	VESTIBULE 211	N	A6/AE211
15	VESTIBULE 211	E	A6/AE211
16	C.S. LOBBY 216	N	J1/AE212
17	C.S. LOBBY 216	E	J1/AE212
18	C.S. LOBBY 216	S	J1/AE212
19	C.S. LOBBY 216	W	E1/AE212
20	HALL 201a	S	E6/AE212
21	HALL 201a	W	A1/AE212
22	HALL 201b	N	A8/AE212
23	HALL 201a	E	J1/AE213
24	HALL 201a	E	J1/AE213
25	HALL 201b	S	E1/AE213
26	HALL 201a	W	E8/AE213
27	ELEVATOR	E	A1/AE213
28	ELEVATOR	N,S	A1/AE213
29	HALL 201a	N	J1/AE214
30	HALL 201a	N	J1/AE214
46	CUSTOMER SERVICE 219	S	J9/AE218
52	KITCHEN 235	W	A9/AE218
53	CONFERENCE 229 & 230	N	J1/AE219
54	CONFERENCE 229 & 230	S	J1/AE219
61	MEN'S TOILET 202	S	E1/AE220
62	WOMEN'S TOILET 203	N	E6/AE220

SMRT
ARCHITECTURE ENGINEERING PLANNING
SMRT
144 Fore Street/P.O. Box 618
Portland, Maine 04104
tel. (207) 772-3846
fax. (207) 772-1070

STATE OF MAINE SCOTT L BENSON No. 1772 REGISTERED PROFESSIONAL ARCHITECT

PROJECT NORTH
MAG NORTH

PROJECT TITLE:
MAINE TURNPIKE AUTHORITY ADMINISTRATION BUILDING
PORTLAND, MAINE

CURRENT ISSUE STATUS:
ISSUED FOR BIDDING/CONSTRUCTION
7-9-07

REV	DESCRIPTION	DATE
0	BIDDING/CONSTRUCTION	7-9-07


GRAPHIC SCALE: 0" 1"


SCALE:	AS NOTED
PROJECT MANAGER:	SLB
DC/DRAWN BY:	TCM/TCM
A/E OF RECORD:	SLB
CAD FILE:	AE102-06016
PROJECT NO:	06016
DATE:	7-9-07

SHEET TITLE: SECOND FLOOR PLAN

SHEET No. AE102

©COPYRIGHT 2007 SMRT INC

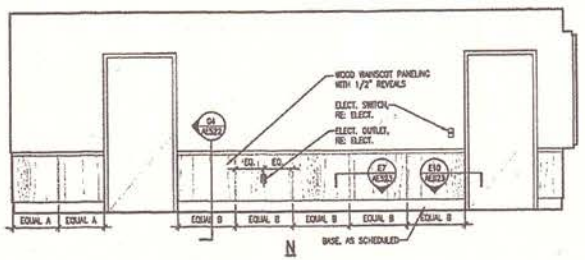


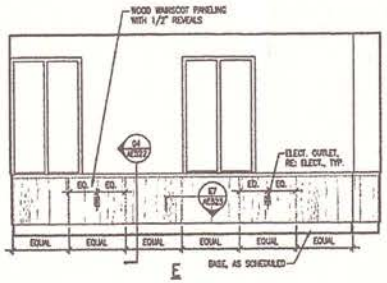


Rm# 346

J1 INTERIOR ELEVATION – OFFICE 346

3/8" = 1'-0"

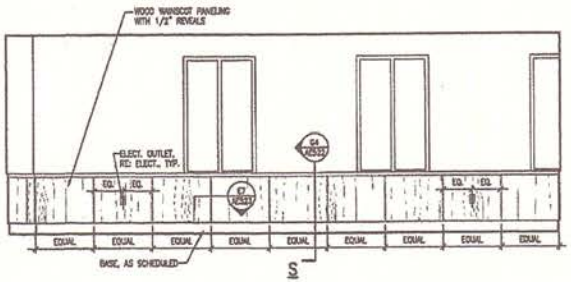

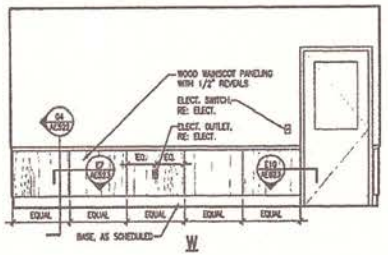


Rm# 346


E1 INTERIOR ELEVATION – OFFICE 346


3/8" = 1'-0"


#320

Rm

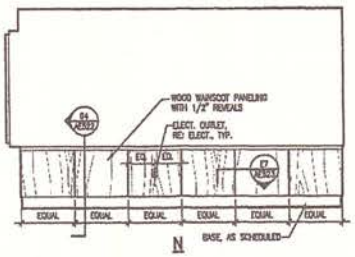

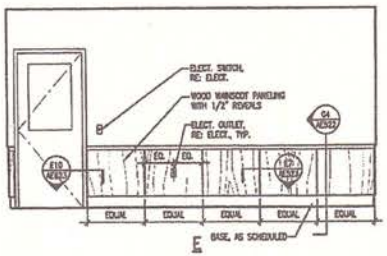

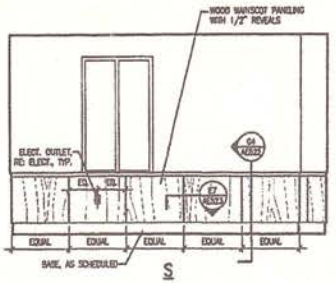

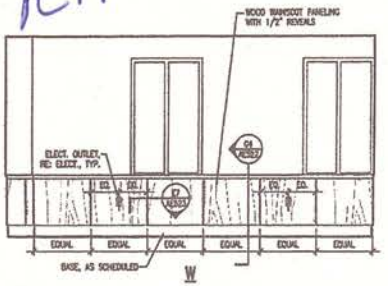

A1 INTERIOR ELEVATION – OFFICE 320

3/8" =1'-0"

GENERAL NOTES:

1. SEE G001 FOR PROJECT GENERAL NOTES.

SMRT
ARCHITECTURE ENGINEERING PLANNING
SMRT
144 Fore Street, P.O. Box 913
Portland, Maine 04104
tel. (207) 772-3846
fax. (207) 772-1870

PROJECT TITLE: MAINE TURNPIKE AUTHORITY ADMINISTRATION BUILDING PORTLAND, MAINE

CURRENT ISSUE STATUS: ISSUED FOR BIDDING/CONSTRUCTION 7-6-07


REV	DESCRIPTION	DATE
0	BIDDING/CONSTRUCTION	7-6-07

GRAPHIC SCALE: 0" 1"

SCALE:	AS NOTED
PROJECT MANAGER:	SLB
JIC/DRAWN BY:	TCM/TCM
A/E OF RECORD:	SLB
CAD FILE:	AE221-08018
PROJECT NO:	08018
DATE:	7-6-07

SHEET TITLE: INTERIOR ELEVATIONS

SHEET No. AE221

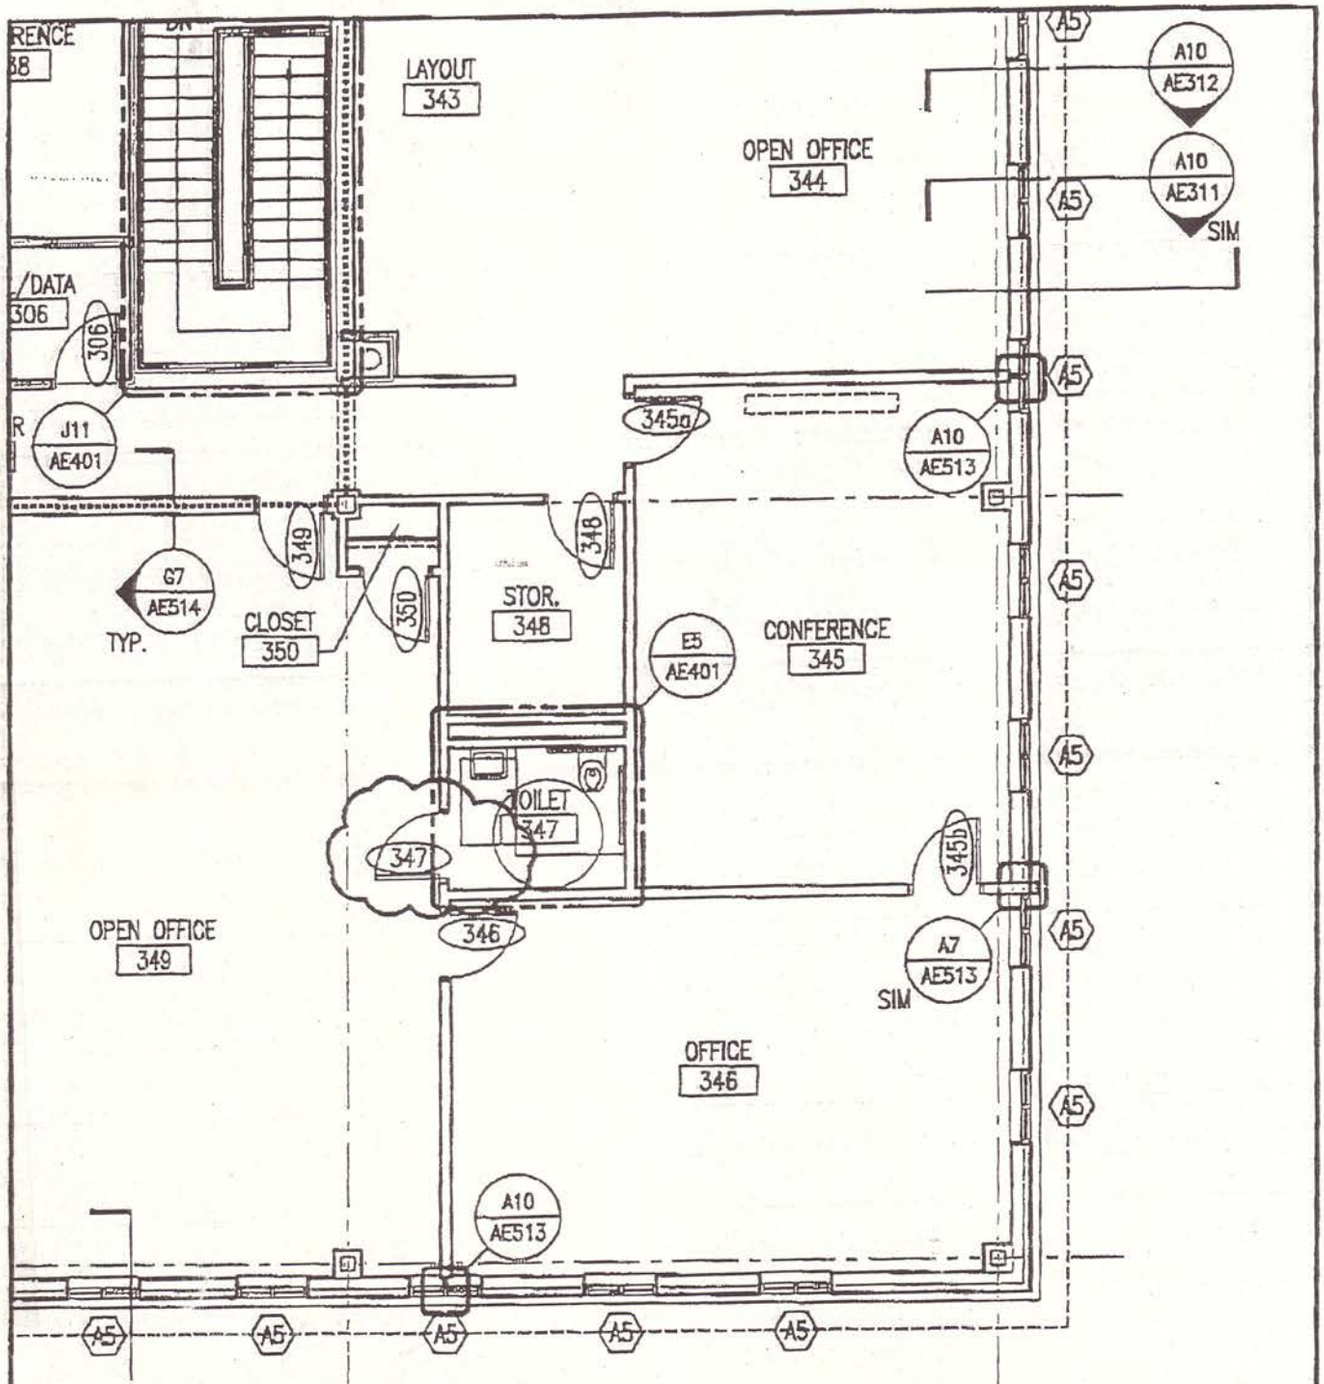

SMRT

ARCHITECTURE ENGINEERING PLANNING

SMRT
144 Fore Street/P.O.Box 618 PORTLAND, MAINE 04104
tel. (207) 772-3846 / fax. (207) 772-1070

SCALE:	1/8"=1'-0"
CAD FILE:	AE103-06016
PROJECT No.	06016
REF. SHEET:	AE103
PM: SLB	ADDENDUM No. ADD-5
A/E: SLB	SKETCH No. A-2
DATE: 8-17-07	

PROJECT: MAINE TURNPIKE AUTHORITY
ADMINISTRATION BUILDING

SUBJECT: REVISED DOOR SWING AT TOILET 347
THIRD FLOOR PLAN

© COPYRIGHT 2007 SMRT INC.

GENERAL NOTES:

1. SEE G1001 FOR PROJECT GENERAL NOTES.

FLOOR PLAN NOTES:

1. REFER TO AE600 SERIES DRAWINGS FOR WINDOW AND DOOR TYPES.
2. REFER TO AE113 FOR PARTITION TYPES & PARTITION LOCATIONS.

KEY NOTES:

1. FIRE EXTINGUISHER FE-1
2. FIRE EXTINGUISHER FE-2
3. REFRIGERATOR
4. ICE MAKER
5. LOCKERS
6. VENDING MACHINE, N.I.C.
7. WIRE MESH PARTITIONS
8. WALL MOUNTED EYE WASH
9. EYE WASH/EMERGENCY SHOWER
10. SLOP SINK W/ MOP RACK
11. HOUSEKEEPING PADS, RE: STRUCT.
12. COFFEE MAKER, N.I.C.
13. BULLETIN BOARD CABINET
14. AUTOMATED TELLER MACHINE, N.I.C.
15. FIXED BENCH
16. STEEL ROOF LADDER

AS BUILT
Owner Copy

INTERIOR ELEVATION SCHEDULE (X)

ELEVATION	ROOM NAME & NO.	WALL	ELEVATION REFERENCE
31	GALLERY 301	N	A1/AE214
32	GALLERY 301	E	A1/AE214
33	GALLERY 301	S	J6/AE215
34	GALLERY 301	W	A6/AE215
35	GALLERY 301	W	J1/AE216
36	GALLERY 301	N	J1/AE216
37	GALLERY 301	E	A1/AE216
38	GALLERY 301	S	A1/AE216
39	AUTHORITY ROOM 310	N	J1/AE217
40	AUTHORITY ROOM 310	E	J1/AE217
41	AUTHORITY ROOM 310	S	A1/AE217
42	AUTHORITY ROOM 310	W	A1/AE217
47	KITCHEN 314	S	E1/AE218
48	KITCHEN 314	W	E1/AE218
49	KITCHEN 314	N	E1/AE218
61	MEN'S TOILET 302	S	E1/AE220
62	WOMEN'S TOILET 303	N	E9/AE220
57	Waiting 330	N	E9/AE219

SMRT
ARCHITECTURE ENGINEERING PLANNING
SMRT
144 Fore Street/P.O. Box 618
Portland, Maine 04104
tel. (207) 772-3846
fax. (207) 772-1070

STATE OF MAINE
SCOTT L BENSON
No. 1772
REGISTERED PROFESSIONAL ARCHITECT

PROJECT NORTH
MAG NORTH

PROJECT TITLE:
MAINE TURNPIKE AUTHORITY
ADMINISTRATION BUILDING
PORTLAND, MAINE

CURRENT ISSUE STATUS:
ISSUED FOR BIDDING/CONSTRUCTION
7-9-07

REV	DESCRIPTION	DATE
0	BIDDING/CONSTRUCTION	7-9-07

GRAPHIC SCALE: 0" 1"

SCALE:	AS NOTED
PROJECT MANAGER:	SLB
JC/DRAWN BY:	TCM/TCM
A/E OF RECORD:	SLB
CAD FILE:	AE103-06016
PROJECT NO:	06016
DATE:	7-9-07


SHEET TITLE: THIRD FLOOR PLAN

SHEET No. AE103

©COPYRIGHT 2007 SMRT INC.

A1 THIRD FLOOR PLAN
1/8" = 1'-0"

A13 CLERESTORY PLAN
1/8" = 1'-0"

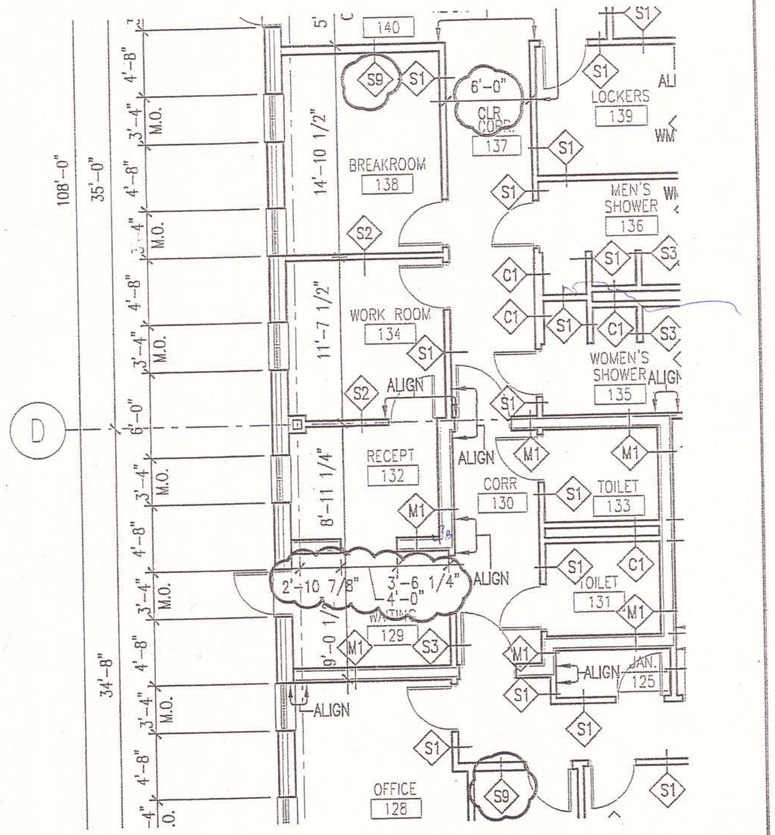

SMRT


ARCHITECTURE ENGINEERING PLANNING

SMRT
144 Fore Street/P.O.Box 618 PORTLAND, MAINE 04104
tel. (207) 772-3846 / fax. (207) 772-1070

PROJECT:	MAINE TURNPIKE AUTHORITY ADMINISTRATION BUILDING
SUBJECT:	FIRST FLOOR LAYOUT PLAN REVISED AS NOTED

SCALE:	1/8"=1'-0"
CAD FILE:	AE111-06016
PROJECT No.	06016
REF. SHEET:	AE111
PM: SLB	ADDENDUM No. ADD-4
A/E: SLB	SKETCH No. A-2
DATE: 8-10-07	

© COPYRIGHT 2007 SMRT INC.

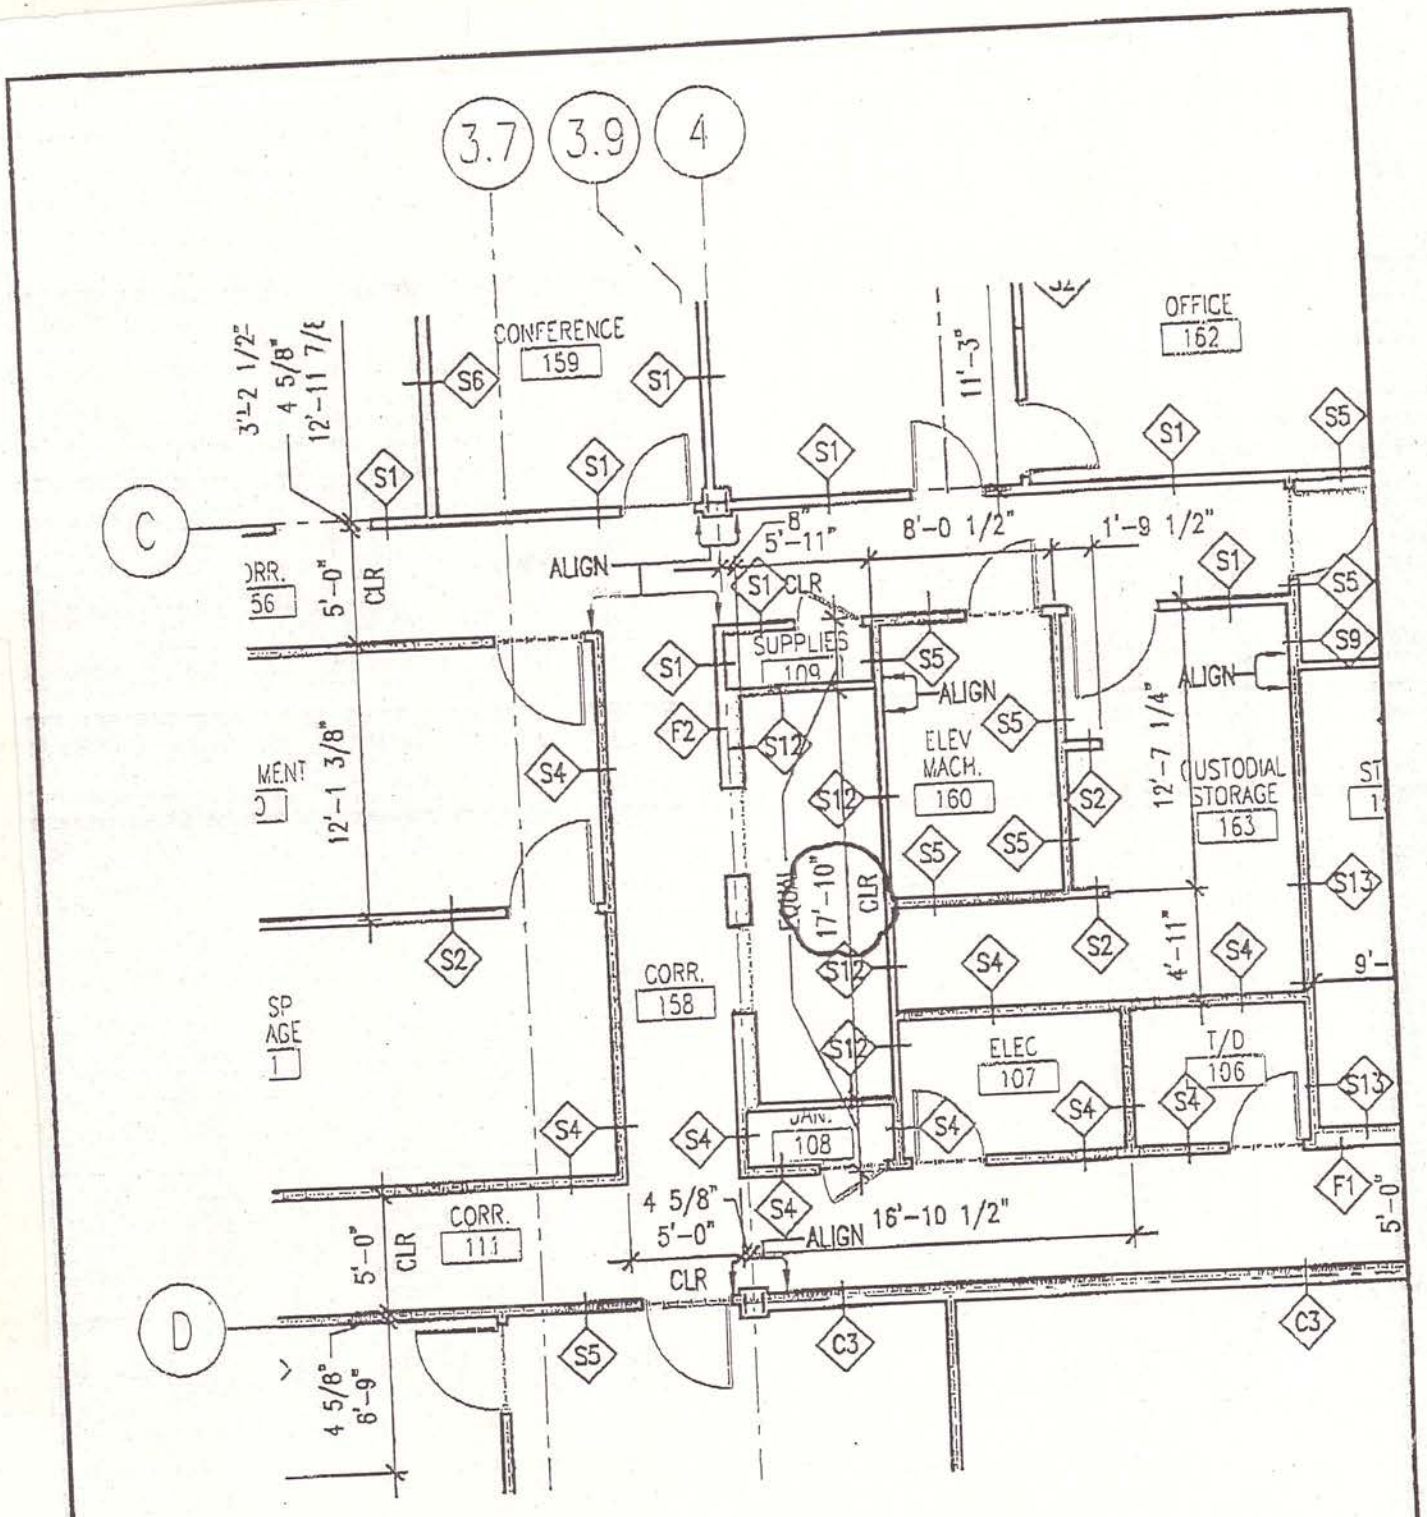

SMRT

ARCHITECTURE ENGINEERING PLANNING


SMRT
144 Fore Street/P.O.Box 618 PORTLAND, MAINE 04104
tel. (207) 772-3846 / fax. (207) 772-1070

PROJECT: MAINE TURNPIKE AUTHORITY
ADMINISTRATION BUILDING

SUBJECT: FIRST FLOOR LAYOUT PLAN
REVISED AS NOTED

SCALE:	1/8"=1'-0"
CAD FILE:	AE111-06016
PROJECT No.	06016
REF. SHEET:	AE111
PM: SLB	ADDENDUM No. ADD-6
A/E: SLB	SKETCH No. A-1
DATE: 8-23-07	

© COPYRIGHT 2007 SMRT INC.

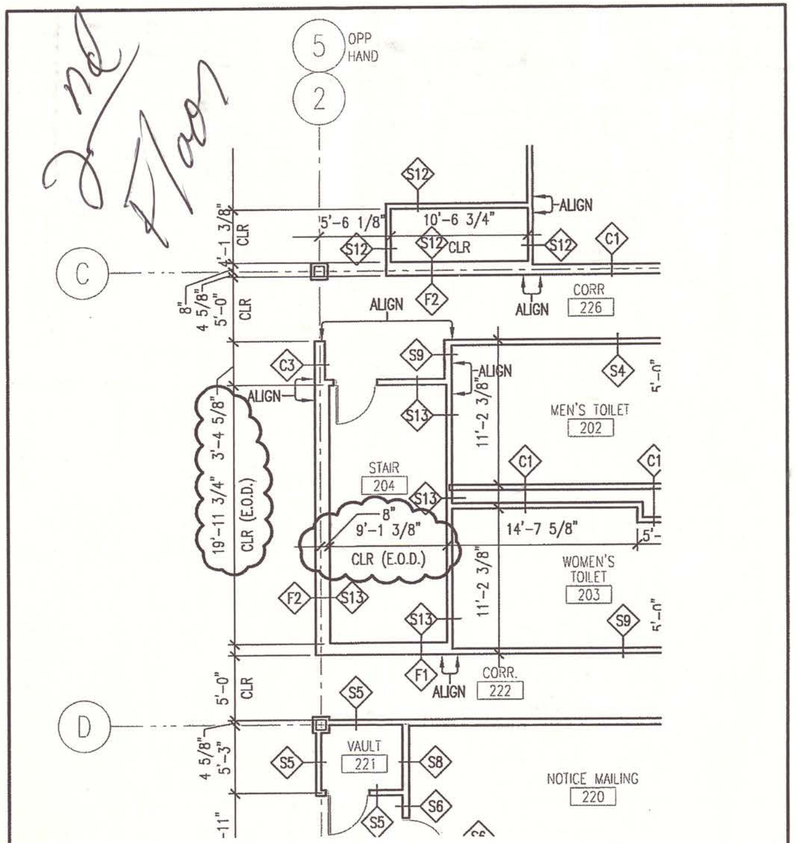

SMRT	ARCHITECTURE ENGINEERING PLANNING SMRT 144 Fore Street/P.O.Box 618 PORTLAND, MAINE 04104 tel. (207) 772-3846 / fax. (207) 772-1070	SCALE: 1/8" = 1'-0" CAD FILE: AE112-06016 PROJECT No. 06016 REF. SHEET: AE111-AE113
PROJECT:	MAINE TURNPIKE AUTHORITY ADMINISTRATION BUILDING	PM: SLB A/E: SLB
SUBJECT:	REVISED DIMENSIONS @ STAIR SHAFTS STAIRS 104,204,304 & 105,205,305(OPP. HAND)	DATE: SUPPLEMENTAL INSTRUCTION RFI #81-120 SKETCH No. A-1

© COPYRIGHT 2008 SMRT INC.

SEE STRUCTURAL DRAWINGS

GENERAL NOTES:

1. SEE G1001 FOR PROJECT GENERAL NOTES.

LAYOUT PLAN NOTES:

1. CHASE DIMENSIONS ARE FROM FACE OF SUBSTRATE BOARD
2. CLEAR DIMENSIONS ARE FROM FACE OF SUBSTRATE BOARD
3. MASONRY OPENINGS ARE INDICATED AS NOMINAL AND SHALL BE CONSTRUCTED TO MODULE (I.E. IF 3'-4", M.O. = 3'-4 3/8")
4. DIMENSIONS FOR SPACES WITHIN ENLARGED PLAN AREAS ARE SHOWN NO THE ENLARGED PLANS (AE400 SERIES) RE: FLOOR PLANS FOR THESE AREAS

AS BUILT
Owner Copy

A1	FIRST FLOOR LAYOUT PLAN
1/8" = 1'-0"	–

SMRT
ARCHITECTURE ENGINEERING PLANNING
SMRT
144 Fore Street/P.O. Box 618
Portland, Maine 04104
tel. (207) 772-3846
fax. (207) 772-1070

STATE OF MAINE
SCOTT L BENSON
No. 1772
REGISTERED PROFESSIONAL ARCHITECT

PROJECT NORTH
MAG NORTH

PROJECT TITLE:
MAINE TURNPIKE AUTHORITY
ADMINISTRATION BUILDING
PORTLAND, MAINE

CURRENT ISSUE STATUS:
ISSUED FOR BIDDING/CONSTRUCTION
7-9-07

REV	DESCRIPTION	DATE
0	BIDDING/CONSTRUCTION	7-9-07


GRAPHIC SCALE: 0" 1"

SCALE:	AS NOTED
PROJECT MANAGER:	SLB
JC/DRAWN BY:	TCM/TCM
A/E OF RECORD:	SLB
CAD FILE:	AE111-06016
PROJECT NO:	06016
DATE:	7-9-07

SHEET TITLE: FIRST FLOOR LAYOUT PLAN


SHEET No. AE111

©COPYRIGHT 2007 SMRT INC

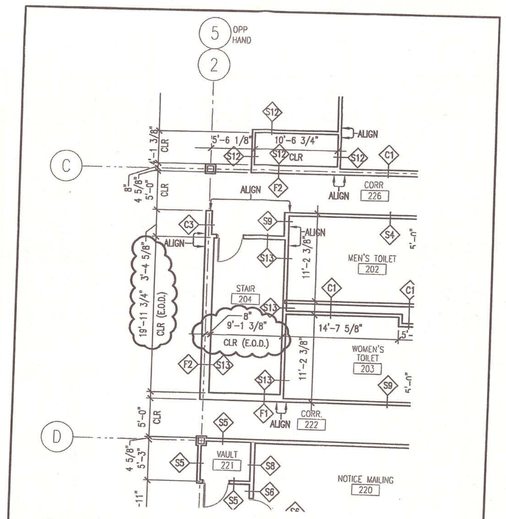


SMRT	ARCHITECTURE ENGINEERING PLANNING SMRT 144 Fore Street/P.O.Box 618 PORTLAND, MAINE 04104 tel. (207) 772-3846 / fax. (207) 772-1070	SCALE: 1/8" = 1'-0" CAD FILE: AE112-06016 PROJECT No. 06016 REF. SHEET: AE111-AE113 PM: SLB SUPPLEMENTAL INSTRUCTION RFI 89-120 A/E: SLB DRAWING No. A-1 DATE:
PROJECT:	MAINE TURNPIKE AUTHORITY ADMINISTRATION BUILDING	
SUBJECT:	REVISED DIMENSIONS @ STAIR SHAFTS STAIRS 104,204,304 & 105,205,305(OPP. HAND)	

© COPYRIGHT 2006 SMRT INC.

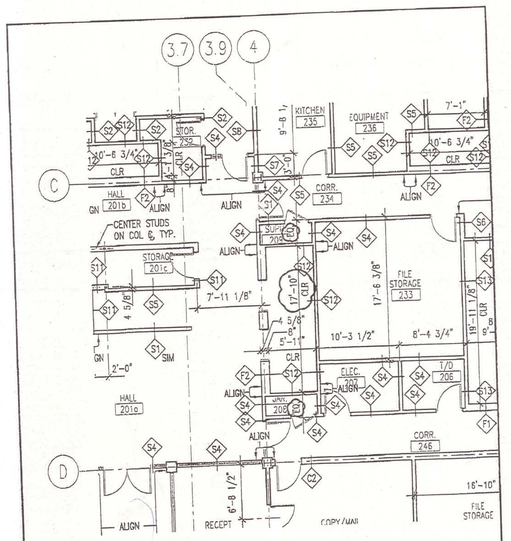

SMRT	ARCHITECTURE ENGINEERING PLANNING SMRT 144 Fore Street/P.O.Box 618 PORTLAND, MAINE 04104 tel. (207) 772-3846 / fax. (207) 772-1070	SCALE: 1/8"=1'-0" CAD FILE: AE112-06016 PROJECT No. 06016 REF. SHEET: AE112 PM: SLB ADDENDUM No. ADD-6 A/E: SLB DRAWING No. A-2 DATE: 8-23-07
PROJECT:	MAINE TURNPIKE AUTHORITY ADMINISTRATION BUILDING	
SUBJECT:	SECOND FLOOR LAYOUT PLAN REVISED AS NOTED	


© COPYRIGHT 2007 SMRT INC.

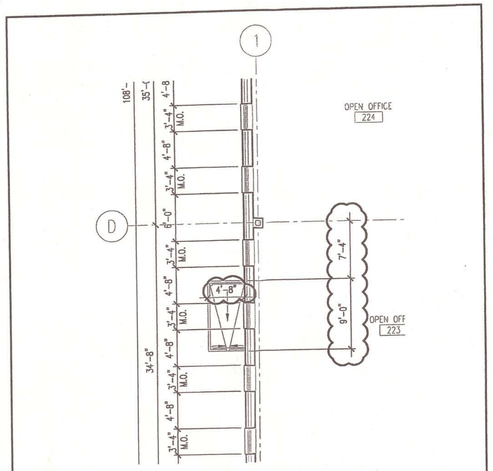

SMRT	ARCHITECTURE ENGINEERING PLANNING SMRT 144 Fore Street/P.O.Box 618 PORTLAND, MAINE 04104 tel. (207) 772-3846 / fax. (207) 772-1070	SCALE: 1/8" = 1'-0" CAD FILE: AE112-06016 PROJECT No. 06016 REF. SHEET: AE112 PM: SLB SUPPLEMENTAL INSTRUCTION SI-19 A/E: SLB DRAWING No. A-2 DATE: 3-11-08
PROJECT:	MAINE TURNPIKE AUTHORITY ADMINISTRATION BUILDING	
SUBJECT:	ADDED DIMENSIONS @ CANOPIES SECOND FLOOR LAYOUT PLAN	

© COPYRIGHT 2008 SMRT INC.

RFI 64

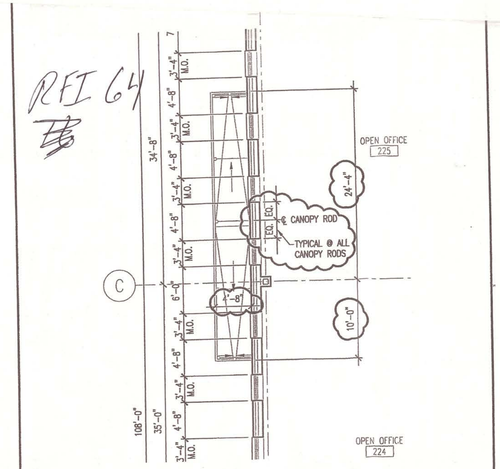

SMRT	ARCHITECTURE ENGINEERING PLANNING SMRT 144 Fore Street/P.O.Box 618 PORTLAND, MAINE 04104 tel. (207) 772-3846 / fax. (207) 772-1070	SCALE: 1/8" = 1'-0" CAD FILE: AE112-06016 PROJECT No. 06016 REF. SHEET: AE112 PM: SLB SUPPLEMENTAL INSTRUCTION SI-19 A/E: SLB DRAWING No. A-1 DATE: 3-11-08
PROJECT:	MAINE TURNPIKE AUTHORITY ADMINISTRATION BUILDING	
SUBJECT:	ADDED DIMENSIONS @ CANOPIES SECOND FLOOR LAYOUT PLAN	

© COPYRIGHT 2008 SMRT INC.

GENERAL NOTES:

1. SEE G1001 FOR PROJECT GENERAL NOTES.

LAYOUT PLAN NOTES:

1. CHASE DIMENSIONS ARE FROM FACE OF SUBSTRATE BOARD
2. CLEAR DIMENSIONS ARE FROM FACE OF SUBSTRATE BOARD
3. MASONRY OPENINGS ARE INDICATED AS NOMINAL AND SHALL BE CONSTRUCTED TO MODULE (I.E. IF 3'-4", M.O. = 3'-4 3/8")
4. DIMENSIONS FOR SPACES WITHIN ENLARGED PLAN AREAS ARE SHOWN NO THE ENLARGED PLANS (AE400 SERIES) RE: FLOOR PLANS FOR THESE AREAS

see RFI-64 + SI-19 posted opp. page

Control Jt's Sheet Rock SI-82

see opp. page For Measurements RFI-120

RFI 64 + SI-19 see opp page

Window Layout SI-64R

SI-49 For Layout

RFI 190

AS BUILT Owner Copy

SMRT
ARCHITECTURE ENGINEERING PLANNING
SMRT
144 Fore Street/P.O. Box 618
Portland, Maine 04104
tel.: (207) 772-3846
fax.: (207) 772-1070

STATE OF MAINE SCOTT L BENSON No. 1772 REGISTERED PROFESSIONAL ARCHITECT

PROJECT NORTH
MAG. NORTH

PROJECT TITLE:
MAINE TURNPIKE AUTHORITY ADMINISTRATION BUILDING
PORTLAND, MAINE

CURRENT ISSUE STATUS:
ISSUED FOR BIDDING/CONSTRUCTION 7-9-07

REV	DESCRIPTION	DATE
0	BIDDING/CONSTRUCTION	7-9-07

GRAPHIC SCALE: 0" 1"

SCALE:	AS NOTED
PROJECT MANAGER:	SLB
JC/DRAWN BY:	TCM/TCM
A/E OF RECORD:	SLB
CAD FILE:	AE112-06016
PROJECT NO:	06016
DATE:	7-9-07


SHEET TITLE: SECOND FLOOR LAYOUT PLAN

SHEET No. AE112

© COPYRIGHT 2007 SMRT INC

A1 SECOND FLOOR LAYOUT PLAN

1/8" = 1'-0"

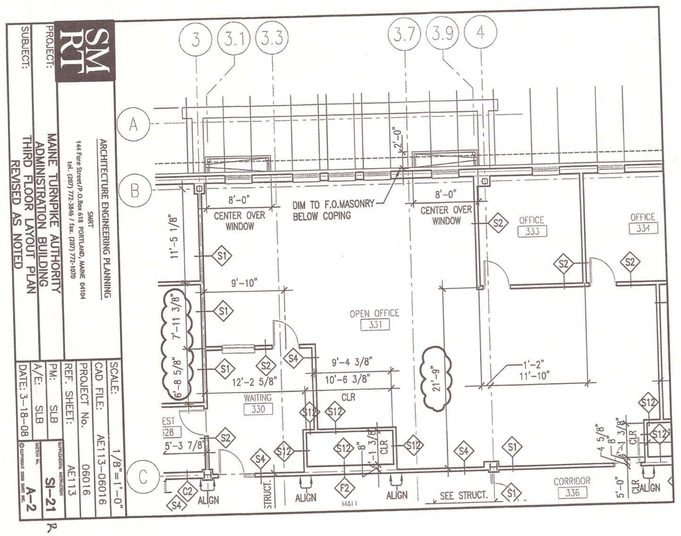


SMRT

ARCHITECTURE ENGINEERING PLANNING
SMRT
144 Fore Street/P.O.Box 618 PORTLAND, MAINE 04104
tel. (207) 772-3846 / fax. (207) 772-1070

PROJECT: MAINE TURNPIKE AUTHORITY
ADMINISTRATION BUILDING
SUBJECT: THIRD FLOOR PLAN
REVISED AS NOTED

SCALE:	1/8"=1'-0"
CAD FILE:	AE113-06016
PROJECT No.	06016
REF. SHEET:	AE113
PM: SLB	SUPPLEMENTAL INSTRUCTION SI-21
A/E: SLB	SHEET No. A-2
DATE: 3-18-08	© COPYRIGHT 2008 SMRT INC.

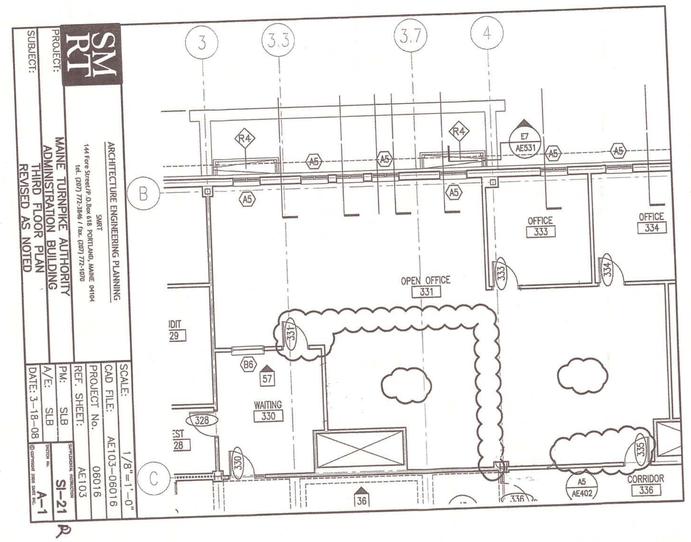


SMRT

ARCHITECTURE ENGINEERING PLANNING
SMRT
144 Fore Street/P.O.Box 618 PORTLAND, MAINE 04104
tel. (207) 772-3846 / fax. (207) 772-1070

PROJECT: MAINE TURNPIKE AUTHORITY
ADMINISTRATION BUILDING
SUBJECT: THIRD FLOOR PLAN
REVISED AS NOTED

SCALE:	1/8"=1'-0"
CAD FILE:	AE103-06016
PROJECT No.	06016
REF. SHEET:	AE103
PM: SLB	SUPPLEMENTAL INSTRUCTION SI-21
A/E: SLB	SHEET No. A-1
DATE: 3-18-08	© COPYRIGHT 2008 SMRT INC.

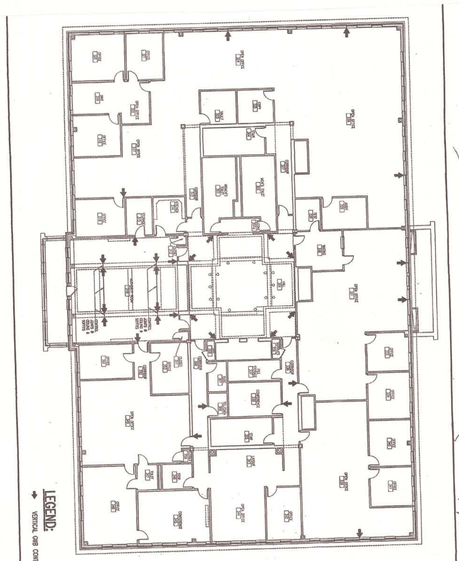


SI-76 Contains 3rd Floor

SCALE:	NTS
PROJECT MANAGER:	SLB
REF. SHEET:	
A/E OF RECORD:	SLB
CAD FILE:	
PROJECT No.	06016
DATE:	11-17-08

ARCHITECTURE ENGINEERING PLANNING
SMRT
144 Fore Street/P.O.Box 618 PORTLAND, MAINE 04104
tel. (207) 772-3846 / fax. (207) 772-1070

PROJECT: MAINE TURNPIKE AUTHORITY
ADMINISTRATION BUILDING
SUBJECT: LOCATE 3RD FLOOR GWB CONTROL JOINTS AS DESCRIBED

SMRT

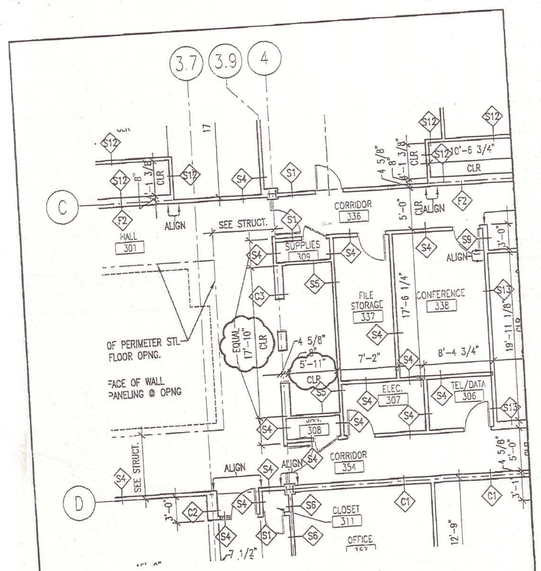


SMRT

ARCHITECTURE ENGINEERING PLANNING
SMRT
144 Fore Street/P.O.Box 618 PORTLAND, MAINE 04104
tel. (207) 772-3846 / fax. (207) 772-1070

PROJECT: MAINE TURNPIKE AUTHORITY
ADMINISTRATION BUILDING
SUBJECT: THIRD FLOOR LAYOUT PLAN
REVISED AS NOTED

SCALE:	1/8"=1'-0"
CAD FILE:	AE113-06016
PROJECT No.	06016
REF. SHEET:	AE113
PM: SLB	ADDENDUM No. ADD-6
A/E: SLB	SHEET No. A-3
DATE: 8-23-07	© COPYRIGHT 2007 SMRT INC.

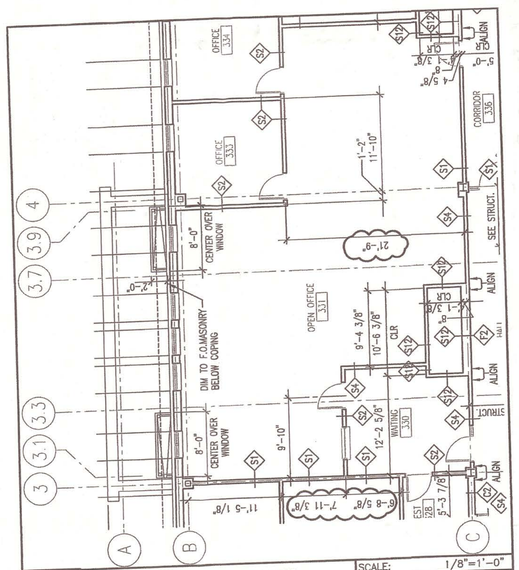


SMRT

ARCHITECTURE ENGINEERING PLANNING
SMRT
144 Fore Street/P.O.Box 618 PORTLAND, MAINE 04104
tel. (207) 772-3846 / fax. (207) 772-1070

PROJECT: MAINE TURNPIKE AUTHORITY
ADMINISTRATION BUILDING
SUBJECT: THIRD FLOOR LAYOUT PLAN
REVISED AS NOTED

SCALE:	1/8"=1'-0"
CAD FILE:	AE113-06016
PROJECT No.	06016
REF. SHEET:	AE113
PM: SLB	SUPPLEMENTAL INSTRUCTION SI-21
A/E: SLB	SHEET No. A-2
DATE: 3-18-08	© COPYRIGHT 2008 SMRT INC.

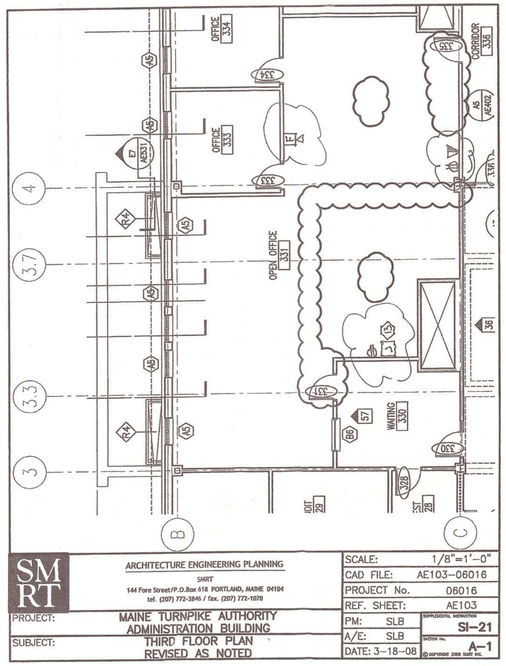

SMRT

ARCHITECTURE ENGINEERING PLANNING
SMRT
144 Fore Street/P.O.Box 618 PORTLAND, MAINE 04104
tel. (207) 772-3846 / fax. (207) 772-1070

PROJECT: MAINE TURNPIKE AUTHORITY
ADMINISTRATION BUILDING
SUBJECT: THIRD FLOOR PLAN
REVISED AS NOTED

SCALE:	1/8"=1'-0"
CAD FILE:	AE103-06016
PROJECT No.	06016
REF. SHEET:	AE103
PM: SLB	SUPPLEMENTAL INSTRUCTION SI-21
A/E: SLB	SHEET No. A-1
DATE: 3-18-08	© COPYRIGHT 2008 SMRT INC.

GENERAL NOTES:

1. SEE G1001 FOR PROJECT GENERAL NOTES.

LAYOUT PLAN NOTES:

1. CHASE DIMENSIONS ARE FROM FACE OF SUBSTRATE BOARD
2. CLEAR DIMENSIONS ARE FROM FACE OF SUBSTRATE BOARD
3. MASONRY OPENINGS ARE INDICATED AS NOMINAL AND SHALL BE CONSTRUCTED TO MODULE (I.E. IF 3'-4", M.O. = 3'-4 3/8")
4. DIMENSIONS FOR SPACES WITHIN ENLARGED PLAN AREAS ARE SHOWN NO THE ENLARGED PLANS (AE400 SERIES) RE: FLOOR PLANS FOR THESE AREAS

3rd Floor 1st Control Layouts See opposite Page SI # 76 + RFI 338

RFI 262 on wall Design

SI-214 2IRR opp Page into

SI-217 3IR opp Page

RFI 330 Framing Framing

Room 513 Add'd Wall Type

ADD'd

ST-96 Add Walls

Window Shades Fabric Rfi 330

AS BUILT Owner Copy

SMRT
ARCHITECTURE ENGINEERING PLANNING
SMRT
144 Fore Street/P.O. Box 618
Portland, Maine 04104
tel. (207) 772-3846
fax. (207) 772-1070

STATE OF MAINE SCOTT L BENSON No. 1772 REGISTERED PROFESSIONAL ARCHITECT

PROJECT NORTH

MAG NORTH

PROJECT TITLE: MAINE TURNPIKE AUTHORITY ADMINISTRATION BUILDING PORTLAND, MAINE

CURRENT ISSUE STATUS: ISSUED FOR BIDDING/CONSTRUCTION 7-9-07

REV	DESCRIPTION	DATE
0	BIDDING/CONSTRUCTION	7-9-07

GRAPHIC SCALE: 0" 1"

SCALE:	AS NOTED
PROJECT MANAGER:	SLB
JC/DRAWN BY:	TCM/TCM
A/E OF RECORD:	SLB
CAD FILE:	AE113-06(
PROJECT NO:	06016
DATE:	7-9-0


SHEET TITLE: THIRD FLOOR LAYOUT PLA

SHEET No: AE113

© COPYRIGHT 2007

A1 THIRD FLOOR LAYOUT PLAN

1/8" = 1'-0"

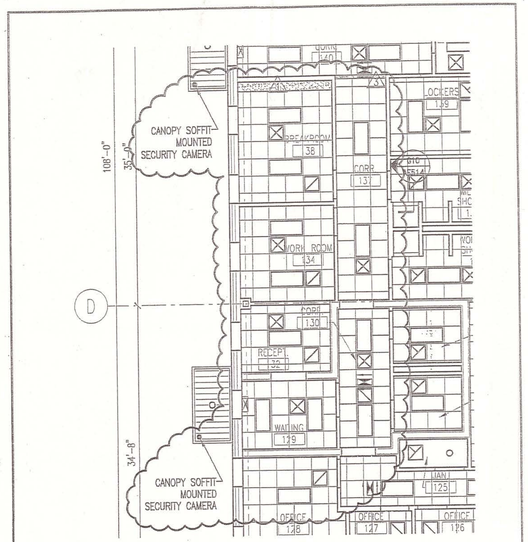

SMRT


ARCHITECTURE ENGINEERING PLANNING

SMRT
144 Fore Street/P.O.Box 618 PORTLAND, MAINE 04104
tel. (207) 772-3846 / fax. (207) 772-1070

PROJECT: MAINE TURNPIKE AUTHORITY
ADMINISTRATION BUILDING

SUBJECT: FIRST FLOOR REFLECTED CEILING PLAN

SCALE:	1/8"=1'-0"
CAD FILE:	AE121-06016
PROJECT No.	06016
REF. SHEET:	AE121
PM: SLB	ADDENDUM NO. ADD-4
A/E: SLB	SHEET No. A-3
DATE: 8-10-07	

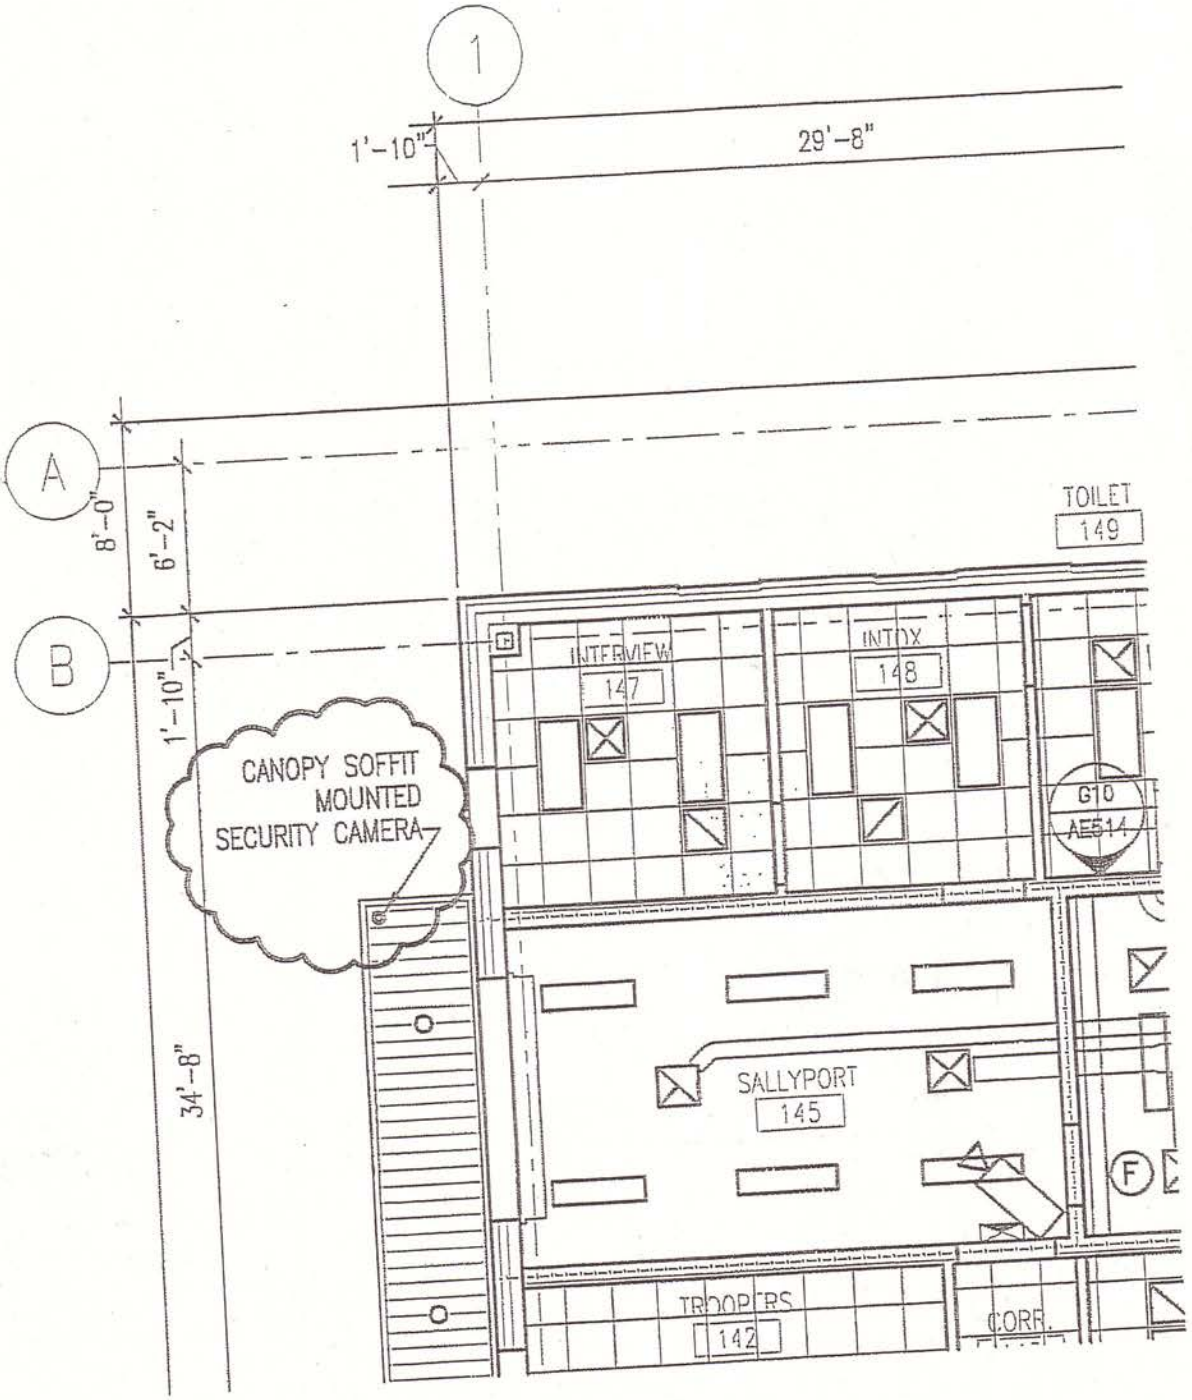

SMRT


ARCHITECTURE ENGINEERING PLANNING

SMRT
144 Fore Street/P.O.Box 618 PORTLAND, MAINE 04104
tel. (207) 772-3846 / fax. (207) 772-1070

PROJECT: MAINE TURNPIKE AUTHORITY
ADMINISTRATION BUILDING
FIRST FLOOR REFLECTED CEILING PLAN

SCALE:	1/8"=1'-0"
CAD FILE:	AE121-06016
PROJECT No.	06016
REF. SHEET:	AE121
PM: SLB	ADDENDUM No. ADD-4
A/E: SLB	SKETCH No. A-4
DATE: 8-10-07	

© COPYRIGHT 2007 SMRT INC.

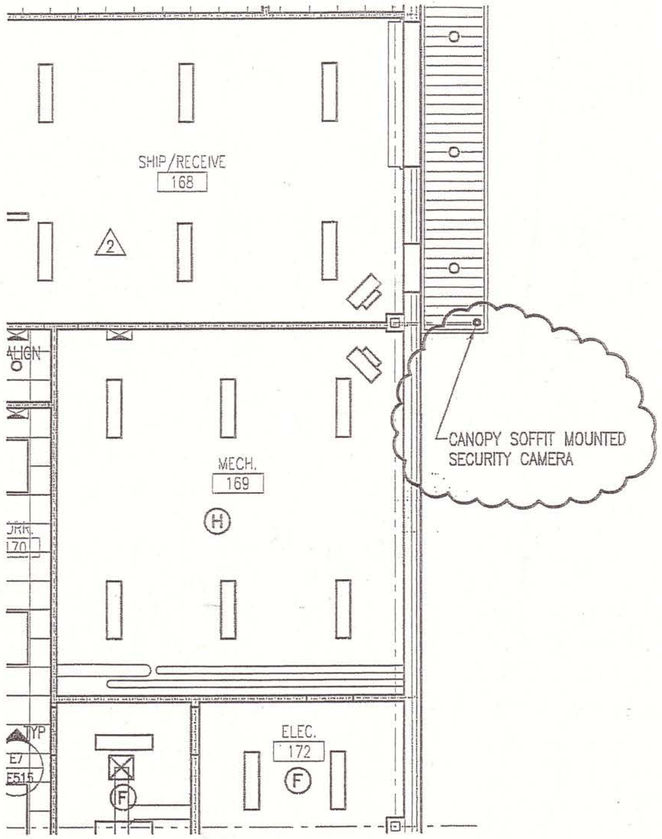

SMRT


ARCHITECTURE ENGINEERING PLANNING

SMRT
144 Fore Street/P.O.Box 618 PORTLAND, MAINE 04104
tel. (207) 772-3846 / fax. (207) 772-1070

SCALE:	1/8"=1'-0"
CAD FILE:	AE121-06016
PROJECT No.	06016
REF. SHEET:	AE121
PM: SLB	ADDENDUM No. ADD-4
A/E: SLB	SKETCH No. A-5
DATE: 8-10-07	

PROJECT: MAINE TURNPIKE AUTHORITY
ADMINISTRATION BUILDING

SUBJECT: FIRST FLOOR REFLECTED CEILING PLAN

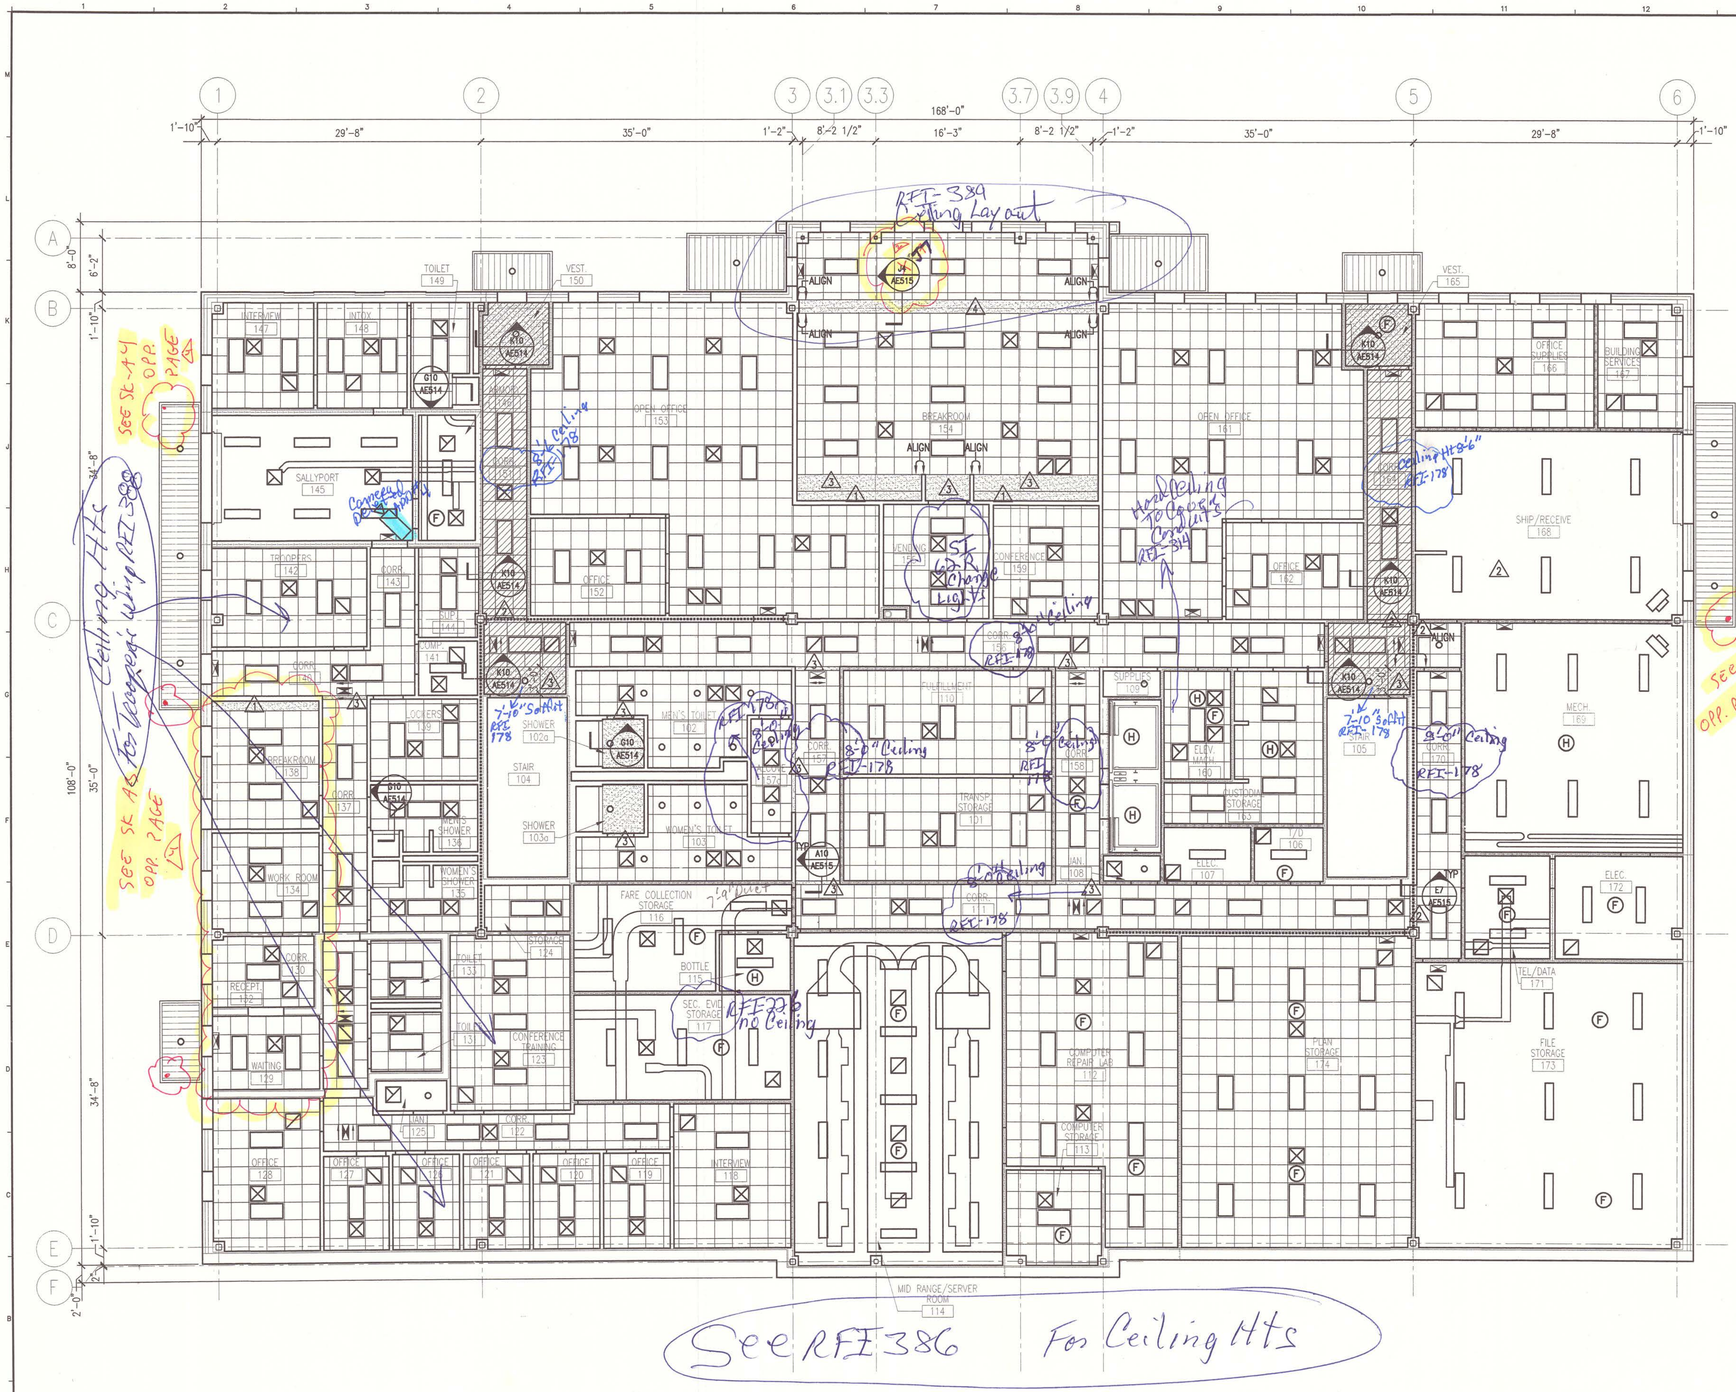

GENERAL NOTES:

1. SEE GI001 FOR PROJECT GENERAL NOTES.

REFLECTED CEILING PLAN NOTES:

1. REFERENCE ROOM FINISH SCHEDULE FOR CEILING HEIGHTS AND TYPES
2. FIRE SPRINKLERS SHALL BE LOCATED IN ALIGNMENT WITH OTHER CEILING ITEMS, TYPICALLY
3. FIRE SPRINKLERS SHALL BE CENTERED IN CEILING TILE
4. FIRE SPRINKLERS SHALL BE PLACED TO COORDINATE WITH LIGHT FIXTURE. POSITIONS INDICATED.
5. ALIGN CEILING ITEMS AS SHOWN, WITH COMMON CENTERLINES, TYPICALLY. CENTER ITEMS IN CEILINGS, OR IN AREA U.N.O
6. PROVIDE ACCESS PANELS AS REQUIRED IN GWB CEILINGS FOR ACCESS TO MECHANICAL VALVES/ CONTROLS. RE: MECHANICAL DRAWINGS

SOFFIT HEIGHT SCHEDULE

1. 7'-0" A.F.F.
2. 7'-6" A.F.F. RFI-178
3. 8'-0" A.F.F. See RFI-178 for Soffits Lowered to 7'-10"
4. 8'-6" A.F.F.
5. 11'-6" A.F.F.
6. 6'-10" A.F.F.

SYMBOL LEGEND

- AREA INDICATING LIMITS OF HORIZONTAL SHAFT ASSEMBLY ABOVE CEILING
- HANGING BRICK SOFFIT
- ALUMINUN SOFFIT/ CEILING SYSTEM
- 2x4 SUSPENDED CEILING PANEL AND GRID ASSEMBLY.
- 2x2 SUSPENDED CEILING PANEL AND GRID ASSEMBLY.
- GWB CEILING.
- 2x4 LAY-IN LIGHT FIXTURE.
- 1x4 PENDANT LIGHT FIXTURE.
- DOWN LIGHT.
- CEILING MOUNTED EXIT LIGHT.
- RETURN AIR GRILLE.
- SUPPLY AIR GRILLE.
- EXHAUST AIR GRILLE.
- SPRINKLER HEAD.
- CEILING MOUNTED SPEAKER.
- CEILING MOUNTED SMOKE DETECTOR.
- SLOT DIFFUSER.
- CEILING MOUNTED CAMERA (N.I.C.) DELETE
- CEILING MOUNTED HEAT DETECTOR
- CEILING MOUNTED OCCUPANCY SENSOR

A1	FIRST FLOOR REFLECTED CEILING PLAN
1/8" = 1'-0"	–

SMRT
ARCHITECTURE ENGINEERING PLANNING
SMRT
144 Fore Street/P.O. Box 618
Portland, Maine 04104
tel. (207) 772-3846
fax. (207) 772-1070

STATE OF MAINE
SCOTT L BENSON
No. 1772
REGISTERED PROFESSIONAL ARCHITECT

PROJECT NORTH
MAG. NORTH

PROJECT TITLE: MAINE TURNPIKE AUTHORITY ADMINISTRATION BUILDING PORTLAND, MAINE

CURRENT ISSUE STATUS: ISSUED FOR BIDDING/CONSTRUCTION 7-9-07

REV	DESCRIPTION	DATE
0	BIDDING/CONSTRUCTION	7-9-07


GRAPHIC SCALE: 0" 1"

SCALE:	AS NOTED
PROJECT MANAGER:	SLB
JC/DRAWN BY:	TCM/TCM
A/E OF RECORD:	SLB
CAD FILE:	AE121–06016
PROJECT NO:	06016
DATE:	7-9-07

SHEET TITLE: FIRST FLOOR REFLECTED CEILING PLAN

SHEET No. AE121

© COPYRIGHT 2007 SMRT INC.

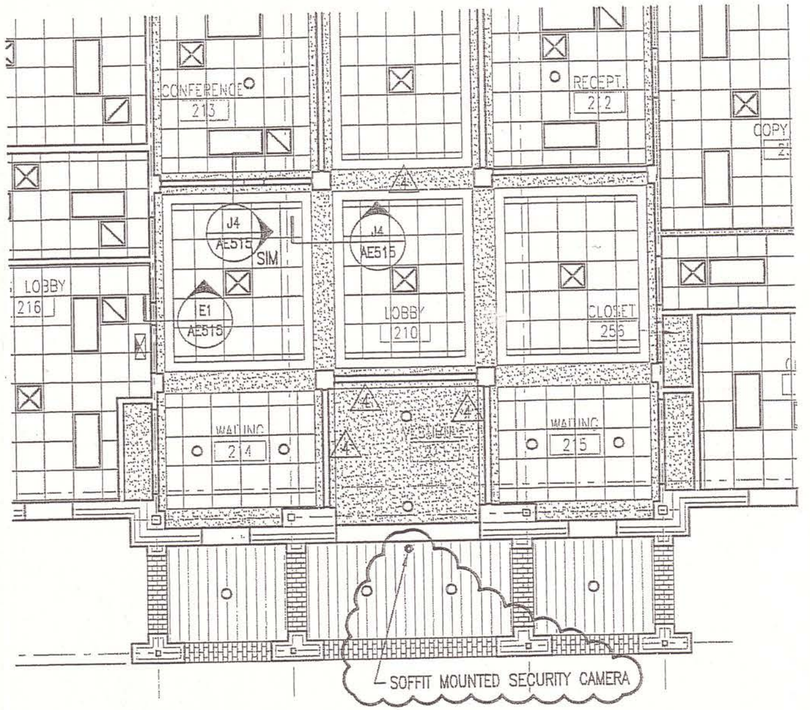

SMRT


ARCHITECTURE ENGINEERING PLANNING

SMRT
144 Fore Street/P.O.Box 618 PORTLAND, MAINE 04104
tel. (207) 772-3846 / fax. (207) 772-1070

PROJECT:	MAINE TURNPIKE AUTHORITY ADMINISTRATION BUILDING
SUBJECT:	SECOND FLOOR REFLECTED CEILING PLAN

SCALE:	1/8"=1'-0"
CAD FILE:	AE122-06016
PROJECT No.	06016
REF. SHEET:	AE122
PM: SLB	ADDENDUM No. ADD-4
A/E: SLB	SKETCH No. A-6
DATE: 8-10-07	

© COPYRIGHT 2007 SMRT INC.

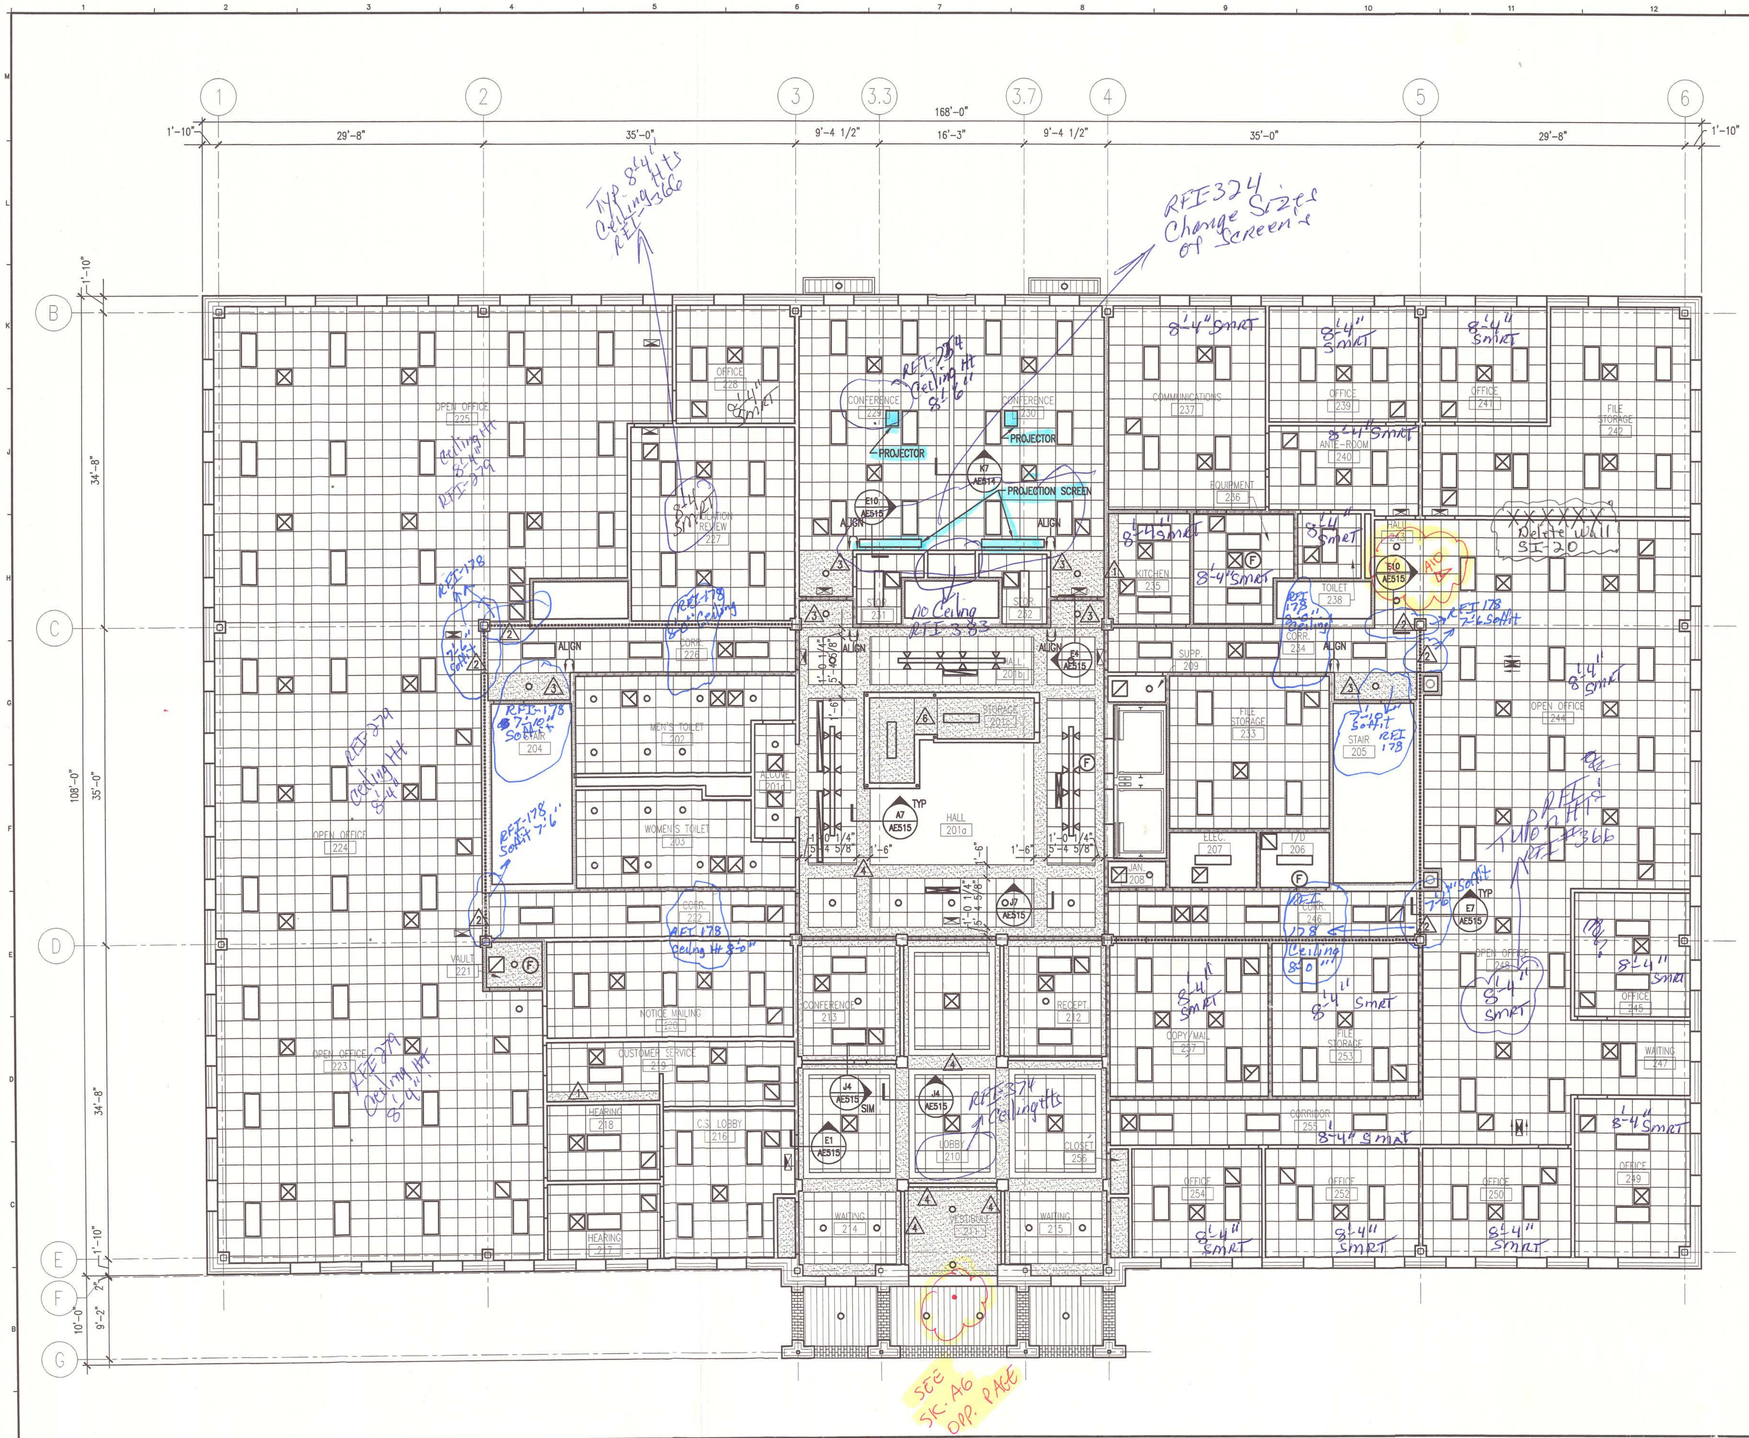
1
2
3
3.3
3.7
4
5
6
168'-0"
1'-10"
29'-8"
35'-0"
9'-4 1/2"
16'-3"
9'-4 1/2"
35'-0"
29'-8"
1'-10"
B
C
D
E
F
G
34'-8"
108'-0"
35'-0"
34'-8"
1'-10"
2'
10'-0"
9'-2"
Typ 8'4" Hts Ceiling RFI 366
RFI 324 Change Sizes of Screens
OFFICE 226
CONFERENCE 229
CONFERENCE 230
PROJECTOR
PROJECTOR
PROJECTION SCREEN
COMMUNICATIONS 237
OFFICE 239
OFFICE 241
FILE STORAGE 242
ANTE-ROOM 240
EQUIPMENT 236
OPEN OFFICE 225
RECEPTION REVIEW 227
KITCHEN 235
TOILET 238
CORR. 234
SUPP. 209
Delete Wall SI-20
OPEN OFFICE 244
STAIR 204
STOR. 231
STOR. 232
HALL 201
FILE STORAGE 233
STAIR 205
MEN'S TOILET 202
ALCOVE 201a
STORAGE 201b
WOMEN'S TOILET 203
ELEC. 207
I/D 206
JAN. 208
OPEN OFFICE 224
CORR. 222
VAULT 221
CONFERENCE 213
RECEPT. 212
COPY/MAIL 251
FILE STORAGE 253
OFFICE 245
WAITING 247
OPEN OFFICE 223
NOTICE MAILING 220
CUSTOMER SERVICE 219
HEARING 218
C.S. LOBBY 216
LOBBY 210
CLOSET 256
CORRIDOR 255
OFFICE 249
HEARING 217
WAITING 214
VESTIBULE 215
WAITING 215
OFFICE 254
OFFICE 252
OFFICE 250
8'-4" SMRT
7'-6" SOFFIT
RFI-178
RFI-178 Ceiling Ht 8'-6"
RFI-178 Ceiling Ht 8'-0"
RFI-178 Ceiling Ht 8'-4"
RFI-178 Ceiling Ht 8'-6"
RFI-178 7'-6" SOFFIT
RFI-178 7'-4" SOFFIT
RFI-178 7'-6" SOFFIT


Rick Paulison


From: Charles Myers [CMYERS@HNTB.com]
Sent: Thursday, December 18, 2008 6:10 AM
To: Rick Paulison
Cc: Craig Hill
Subject: FW. clg. ht.


Rick, as verbally requested yesterday afternoon, ceiling height changes for 325 / 323 are approved

-----Original Message-----
From: Scott Benson [mailto:SBenson@SMRTInc.com]
Sent: Wednesday, December 17, 2008 5:17 PM
To: Charles Myers
Cc: Mark Estabrook
Subject: clg. ht.

hi charlie: 8'-6" +/- shouldn't be a problem in 323 or 325. regards, scott

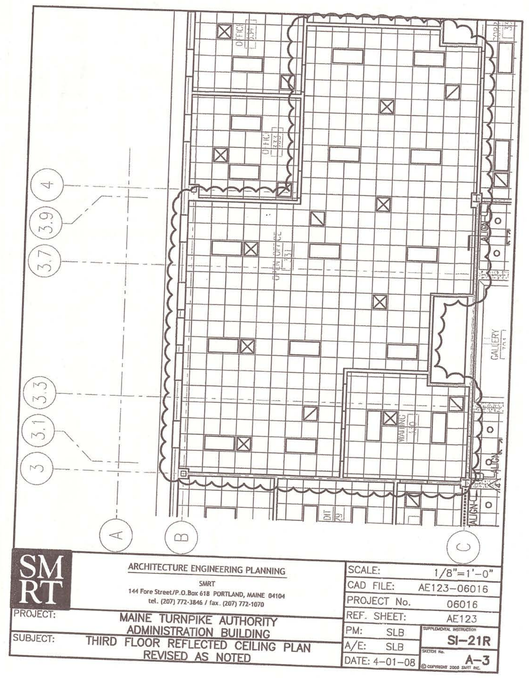
4
3.9
3.7
3.3
3.1
3
A
B
C
OFFICE
OFFICE
OFFICE

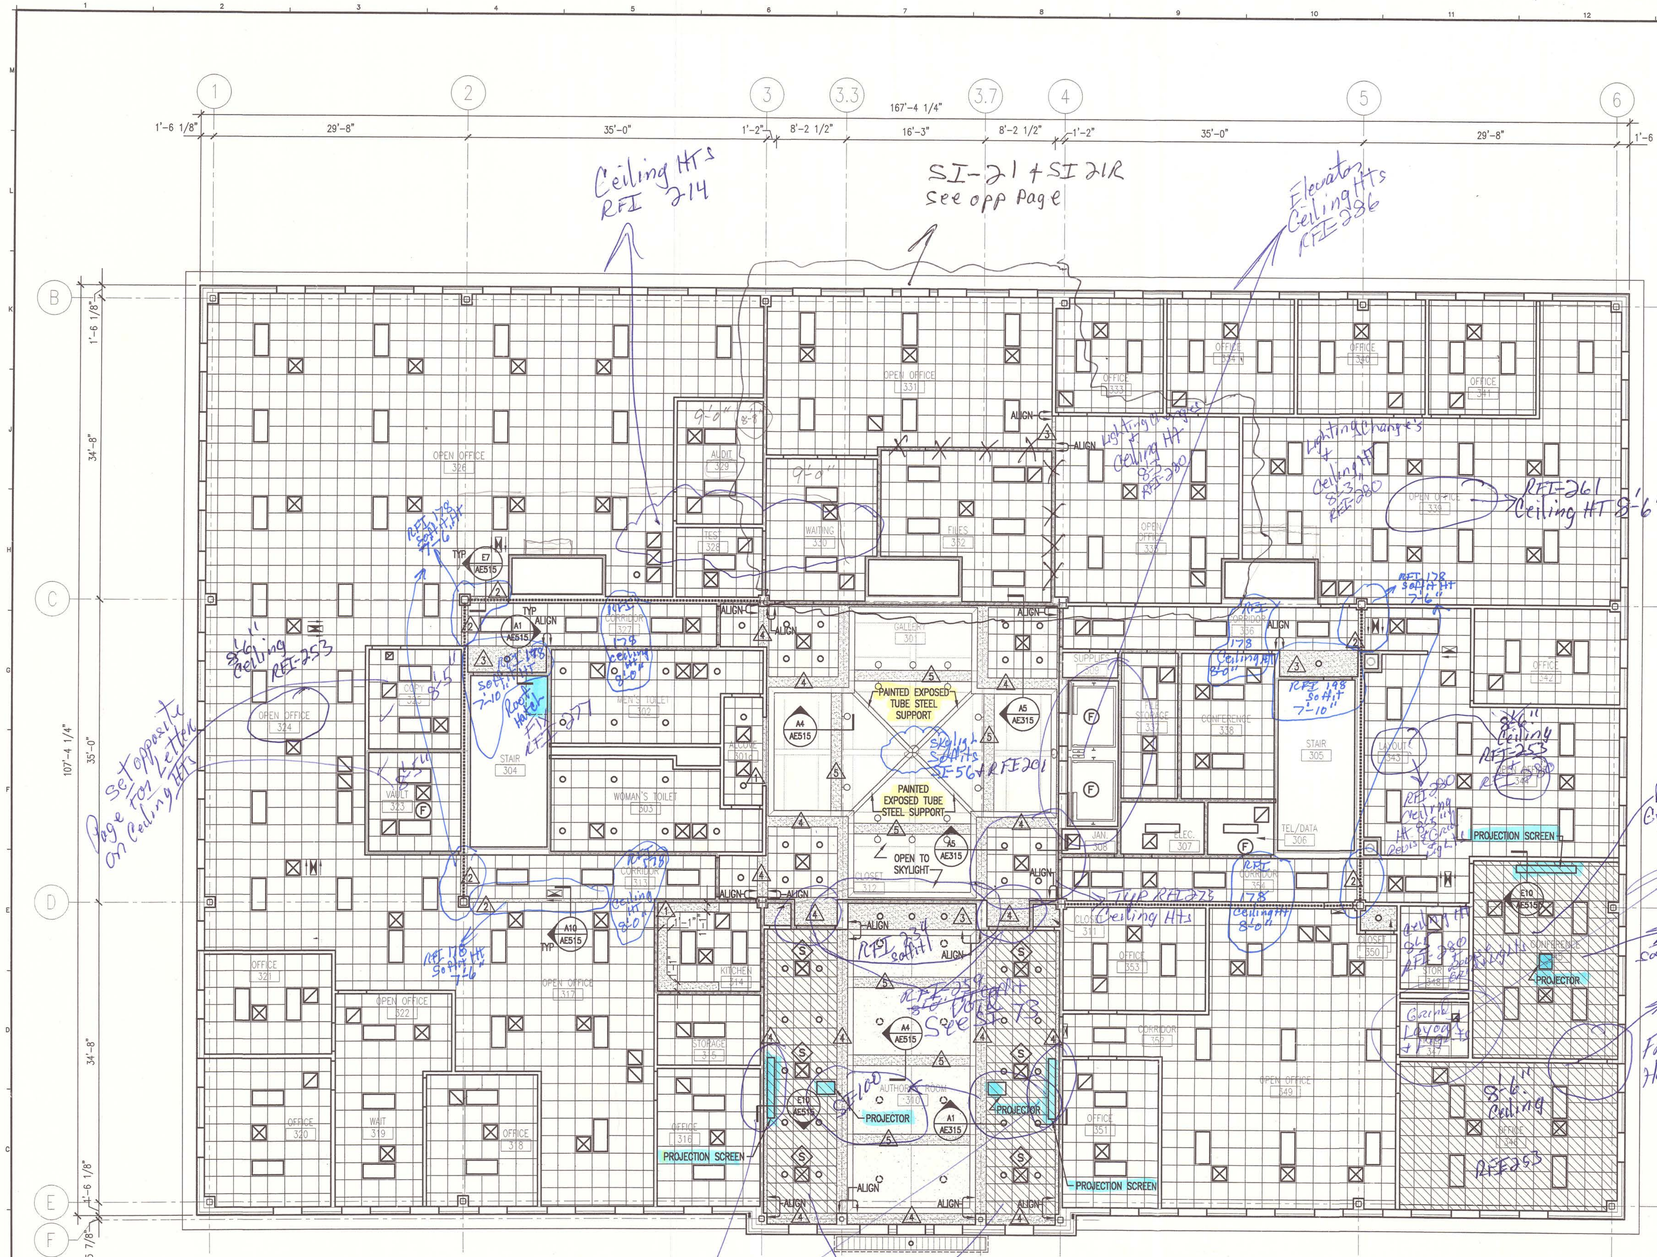
1'-6 1/8"
29'-8"
35'-0"
1'-2"
8'-2 1/2"
16'-3"
8'-2 1/2"
1'-2"
35'-0"
29'-8"
1'-6 1/8"
167'-4 1/4"
107'-4 1/4"
35'-0"
34'-8"
34'-8"
1'-6 1/8"
5 7/8"
Ceiling Hts RFI 214
SI-21 + SI 21R see opp Page
Elevator Ceiling Hts RFI 336
RFI-361 Ceiling HT 8'-6"
RFI-340 Ceiling HT 8'-6" Hard Ceiling
RFI-380 revise grid + Lights
RFI 310 Frame Hard Ceilings
RFI-321 For location
Set opposite Page for Letter on Ceiling HTs
OPEN OFFICE 328
OPEN OFFICE 324
OPEN OFFICE 322
OPEN OFFICE 317
OPEN OFFICE 349
OPEN OFFICE 331
OFFICE 333
OFFICE 329
OFFICE 325
OFFICE 341
OFFICE 339
OFFICE 342
AUDIT 329
TEST 328
WAITING 340
FILES 332
GALLERY 301
PAINTED EXPOSED TUBE STEEL SUPPORT
OPEN TO SKYLIGHT
MEN'S TOILET 302
WOMAN'S TOILET 303
STAIR 304
VAULT 323
STAIR 305
TEL/DATA 306E
ELEC. 307
CONFERENCE 338
STORAGE 337
JAN. 306
CLOSET 313
CLOSET 314
CLOSET 350
KITCHEN 316
OFFICE 320
OFFICE 318
WAIT 319
STORAGE 315
AUTHORS ROOM 310
OFFICE 353
OFFICE 351
OFFICE 348
CORRIDOR 350
CORRIDOR 336
CORRIDOR 305
CORRIDOR 317
CORRIDOR 327
CORRIDOR 326
PROJECTION SCREEN
PROJECTOR
ALIGN
TYP
A1 AE515
A4 AE515
A5 AE315
A10 AE515
E7 AE515
E10 AE515
F
S
Ceiling Hts
Soffit Hts
Lighting Changes + Ceiling HT
RFI-378
RFI-379
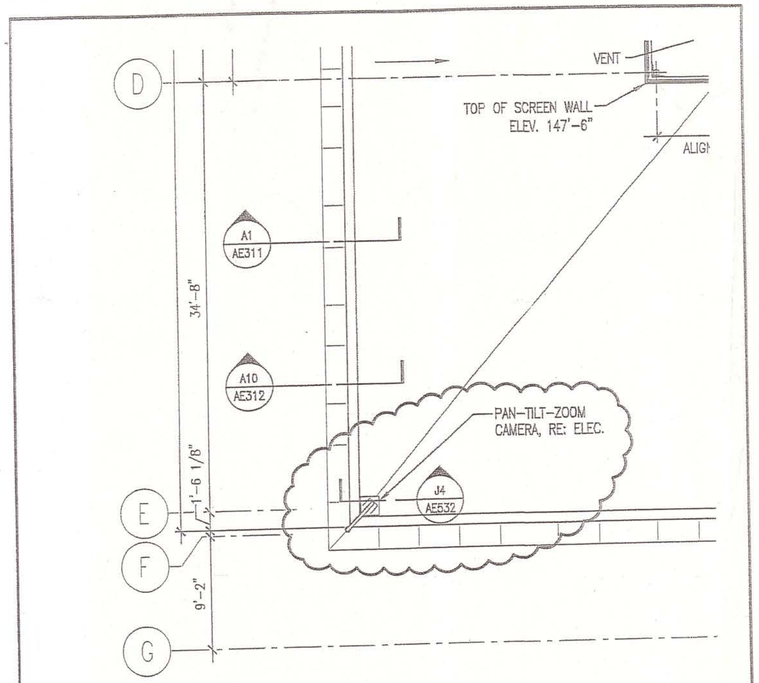

SMRT

ARCHITECTURE ENGINEERING PLANNING


SMRT
144 Fore Street/P.O.Box 618 PORTLAND, MAINE 04104
tel. (207) 772-3846 / fax. (207) 772-1070

PROJECT: MAINE TURNPIKE AUTHORITY
ADMINISTRATION BUILDING

SUBJECT: ROOF PLAN

SCALE:	1/8"=1'-0"
CAD FILE:	AE131-06016
PROJECT No.	06016
REF. SHEET:	AE131
PM:	SLB
A/E:	SLB
DATE:	8-10-07
ADDENDUM No.	ADD-4
SKETCH No.	A-7

© COPYRIGHT 2007 SMRT INC.

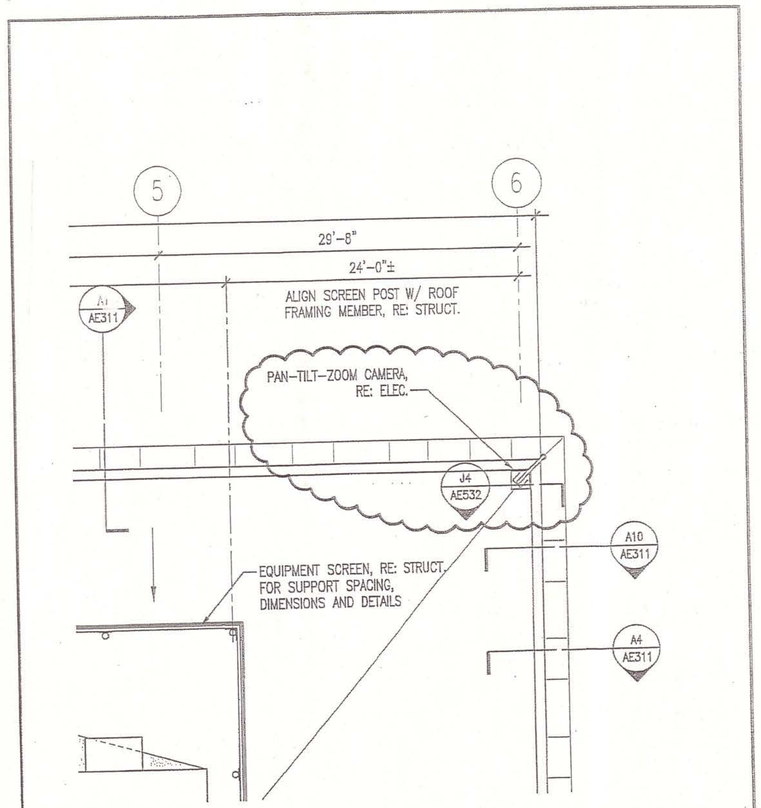

SMRT

ARCHITECTURE ENGINEERING PLANNING

SMRT
144 Fore Street/P.O.Box 618 PORTLAND, MAINE 04104
tel. (207) 772-3846 / fax. (207) 772-1070

PROJECT: MAINE TURNPIKE AUTHORITY
ADMINISTRATION BUILDING

SUBJECT: ROOF PLAN

SCALE:	1/8"=1'-0"
CAD FILE:	AE131-06016
PROJECT No.	06016
REF. SHEET:	AE131
PM:	SLB
A/E:	SLB
DATE:	8-10-07
ADDENDUM No.	ADD-4
SKETCH No.	A-8

© COPYRIGHT 2007 SMRT INC.

Submittal Review Memo

ject Name: MTA Admin HQ - CA & Proj Rep **Job #:** 0601608

o: Derek Converse
Wright-Ryan Construction
10 Danforth Street
Portland, ME 04101

Submittal #: 210-076100

Submittal Title: Sheet Metal Roofing Sample of "Slate Gray"

ACTION: Please take action below:

The review was performed for the limited purpose of determining general conformance with the design concept of the project and general compliance with the information given in the Contract Documents Modifications or comments made on the submittal during this review do not relieve the contractor from compliance with the requirements of the drawings and specifications. Approval of a specific item does not include approval of the assembly of which the item is a component. The Contractor is responsible for quantities and dimensions to be confirmed and correlated at the job site: information that pertains solely to the fabrication processes or to the means, methods, techniques sequences and procedures of construction:coordination of the work of all trades: and for performing all work in a safe and satisfactory manner

SMRT, Inc.

- [x] APPROVED
- [ ] PROVIDE AS NOTED
- [ ] REVISE AND RESUBMIT
- [ ] RESUBMIT SPECIFIC ITEM
- [ ] REJECTED:
  - [ ] Not a specified product
  - [ ] Incomplete
  - [ ] Other
- [ ] INFORMATIONAL SUBMITTAL FOR RECORD ONLY
- [ ] NOT A REQUIRED SUBMITTAL - NOT REVIEWED

REVIEW DATE: 5.11.08
BY: S.R

06016-08 # 210

Remarks:

Roofing Color

Provide sheet metal roofing in Slate Gray to match the color of sample provided.

This sample shall also serve as the "Architect's sample" for color matching all exterior metalwork with the exception of stainless steel, and items whose color is specifically noted otherwise in writing. Items this color shall include, but not necessarily be limited to: window frames, hollow metal doors and frames, storefront framing, composite metal panels, roof coping, overhead doors and soffits.

ROOFTOP EQUIPMENT SCREEN

GENERAL NOTES:

1. SEE GI001 FOR PROJECT GENERAL NOTES.

ROOF PLAN NOTES:

1. ROOF SLOPE, INDICATED THUS "——", IS 1/4" PER FOOT, TYPICAL UNLESS NOTED OTHERWISE.
2. REFER TO AE100 SERIES DRAWINGS FOR BALCONY AND CANOPY ROOF INFORMATION.
3. REFER TO AE501, AE531, AE533, AND AE534 FOR ADDITIONAL ROOF INFORMATION.
4. REFER TO MECHANICAL SCHEDULES FOR MECHANICAL EQUIPMENT CURB HEIGHTS.

PAN-TILT-ZOOM CAMERA, RE: ELEC.

ALIGN SCREEN POST W/ ROOF FRAMING MEMBER, RE: STRUCT.

10 EQUAL SPACES± (ALIGN SCREEN POSTS W/ ROOF FRAMING MEMBERS, RE: STRUCT.)

ALIGN SCREEN POST W/ ROOF FRAMING MEMBER, RE: STRUCT.

EQUIPMENT SCREEN, RE: STRUCT. FOR SUPPORT SPACING, DIMENSIONS AND DETAILS

ROOF TOP HUMIDIFIER, RE: MECH.

ROOF TOP AIR HANDLING UNIT, RE: MECH.

FLEXIBLE WALKWAY

INTAKE VENTILATOR, RE: MECH.

ROOF HATCH

EXHAUST FAN, RE: MECH.

FLEXIBLE CONDUIT PENETRATION, RE: ELEC.

VENT

TOP OF SCREEN WALL ELEV. 147'-6"

ALIGN SCREEN POSTS W/ ROOF FRAMING MEMBERS, RE: STRUCT.

BOILER STACKS, RE: MECH., TIE-DOWNS, RE: STRUCT.

VENTS

TAPERED INSULATION, SLOPE MIN. 1/4" PER FT. IN DIRECTION INDICATED, TYP. ALL SHADED AREAS AND OTHER AREAS AS MAY BE REQUIRED BY SPECIFICATIONS

FIBERGLASS SANDWICH PANEL SKYLIGHT ASSEMBLY

SHEET METAL ROOF

THERMOPLASTIC MEMBRANE, TYP. UNLESS NOTED OTHERWISE

PAN-TILT-ZOOM CAMERA, RE: ELEC.

T.O. METAL-FACED COMPOSITE WALL PANEL ASSEMBLY

Roof Crickets RFI-205

RFI-24 See Detail 3K-4 AE-501 For location

Roof Blocking Anchors RFI-142

Frames are needed when 1'-0" x 1'-0" or Larger

Paddle @ Roof Drains RFI-232

Unknown Pad Typ. RFI-258

Sprinkler RFI-175

Structural Steel Typ. RFI-184

Paint Boiler Stacks & Cables

SGG SE-48 OPP. PAGE 4

SEE SK-A7 OPP. PAGE 4

AS BUILT Owner Copy

SMRT

ARCHITECTURE ENGINEERING PLANNING
SMRT
144 Fore Street/P.O. Box 618
Portland, Maine 04104
tel. (207) 772-3846
fax. (207) 772-1070

STATE OF MAINE SCOTT L. BENSON No. 1772 REGISTERED PROFESSIONAL ARCHITECT

PROJECT NORTH
MAG NORTH

PROJECT TITLE:
MAINE TURNPIKE AUTHORITY
ADMINISTRATION BUILDING
PORTLAND, MAINE

CURRENT ISSUE STATUS:
ISSUED FOR BIDDING/CONSTRUCTION
7-9-07

REV	DESCRIPTION	DATE
0	BIDDING/CONSTRUCTION	7-9-07

GRAPHIC SCALE: 0" 1"

SCALE:	AS NOTED
PROJECT MANAGER:	SLB
JC/DRAWN BY:	TCM/TCM
A/E OF RECORD:	SLB
CAD FILE:	AE131-06016
PROJECT NO:	06016
DATE:	7-9-07


SHEET TITLE: ROOF PLAN

SHEET No. AE131

© COPYRIGHT 2007 SMRT INC

A1 ROOF PLAN

1/8" = 1'-0"

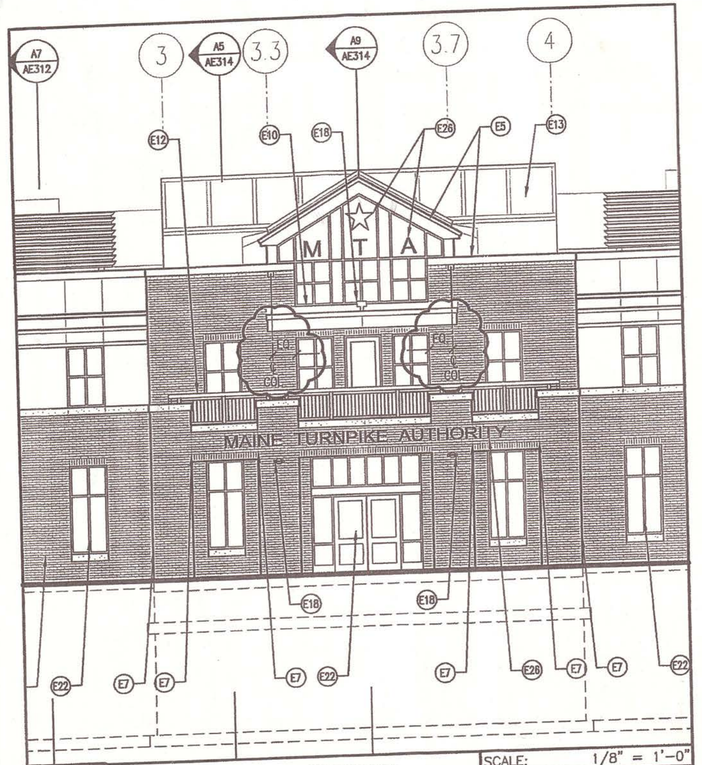

SM RT

ARCHITECTURE ENGINEERING PLANNING

SMRT
144 Fore Street/P.O.Box 618 PORTLAND, MAINE 04104
tel. (207) 772-3846 / fax. (207) 772-1070

PROJECT: MAINE TURNPIKE AUTHORITY
ADMINISTRATION BUILDING


SUBJECT: ADDED DIMENSIONS @ CANOPIES
EXTERIOR ELEVATIONS

SCALE:	1/8" = 1'-0"
CAD FILE:	AE201-06016
PROJECT No.	06016
REF. SHEET:	AE201
PM:	SLB
A/E:	SLB
DATE:	3-11-08

SUPPLEMENTAL INSTRUCTION SI-19

SKETCH No. A-5

© COPYRIGHT 2008 SMRT INC.

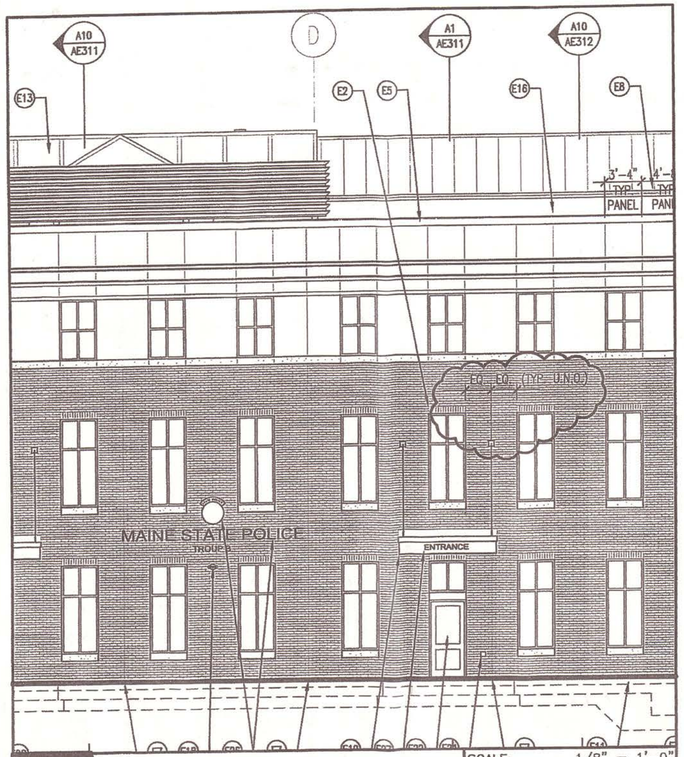

SM RT

ARCHITECTURE ENGINEERING PLANNING

SMRT
144 Fore Street/P.O.Box 618 PORTLAND, MAINE 04104
tel. (207) 772-3846 / fax. (207) 772-1070

PROJECT: MAINE TURNPIKE AUTHORITY
ADMINISTRATION BUILDING


SUBJECT: ADDED DIMENSIONS @ CANOPIES
EXTERIOR ELEVATIONS

SCALE:	1/8" = 1'-0"
CAD FILE:	AE201-06016
PROJECT No.	06016
REF. SHEET:	AE201
PM:	SLB
A/E:	SLB
DATE:	3-11-08

SUPPLEMENTAL INSTRUCTION SI-19

SKETCH No. A-4

© COPYRIGHT 2008 SMRT INC.

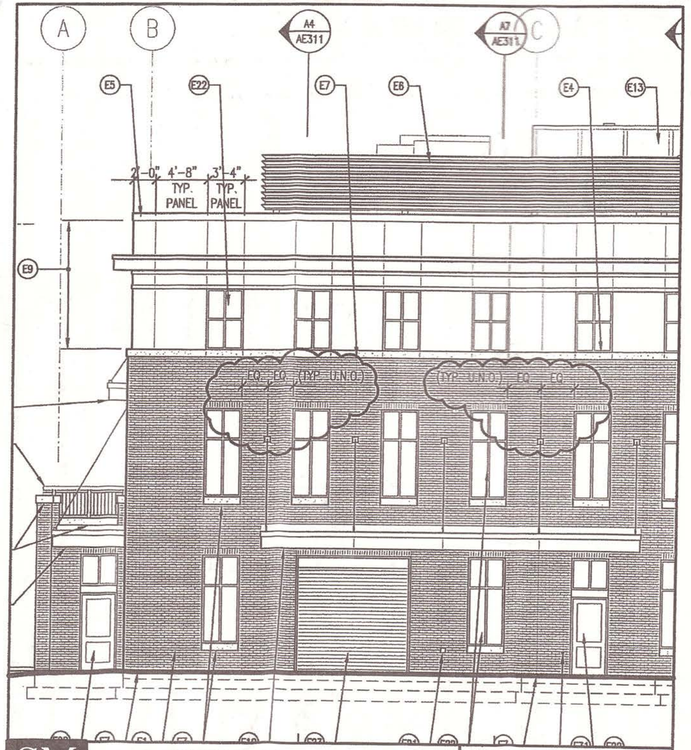

SM RT

ARCHITECTURE ENGINEERING PLANNING

SMRT
144 Fore Street/P.O.Box 618 PORTLAND, MAINE 04104
tel. (207) 772-3846 / fax. (207) 772-1070

PROJECT: MAINE TURNPIKE AUTHORITY
ADMINISTRATION BUILDING


SUBJECT: ADDED DIMENSIONS @ CANOPIES
EXTERIOR ELEVATIONS

SCALE:	1/8" = 1'-0"
CAD FILE:	AE201-06016
PROJECT No.	06016
REF. SHEET:	AE201
PM:	SLB
A/E:	SLB
DATE:	3-11-08

SUPPLEMENTAL INSTRUCTION SI-19


SKETCH No. A-3

© COPYRIGHT 2008 SMRT INC.

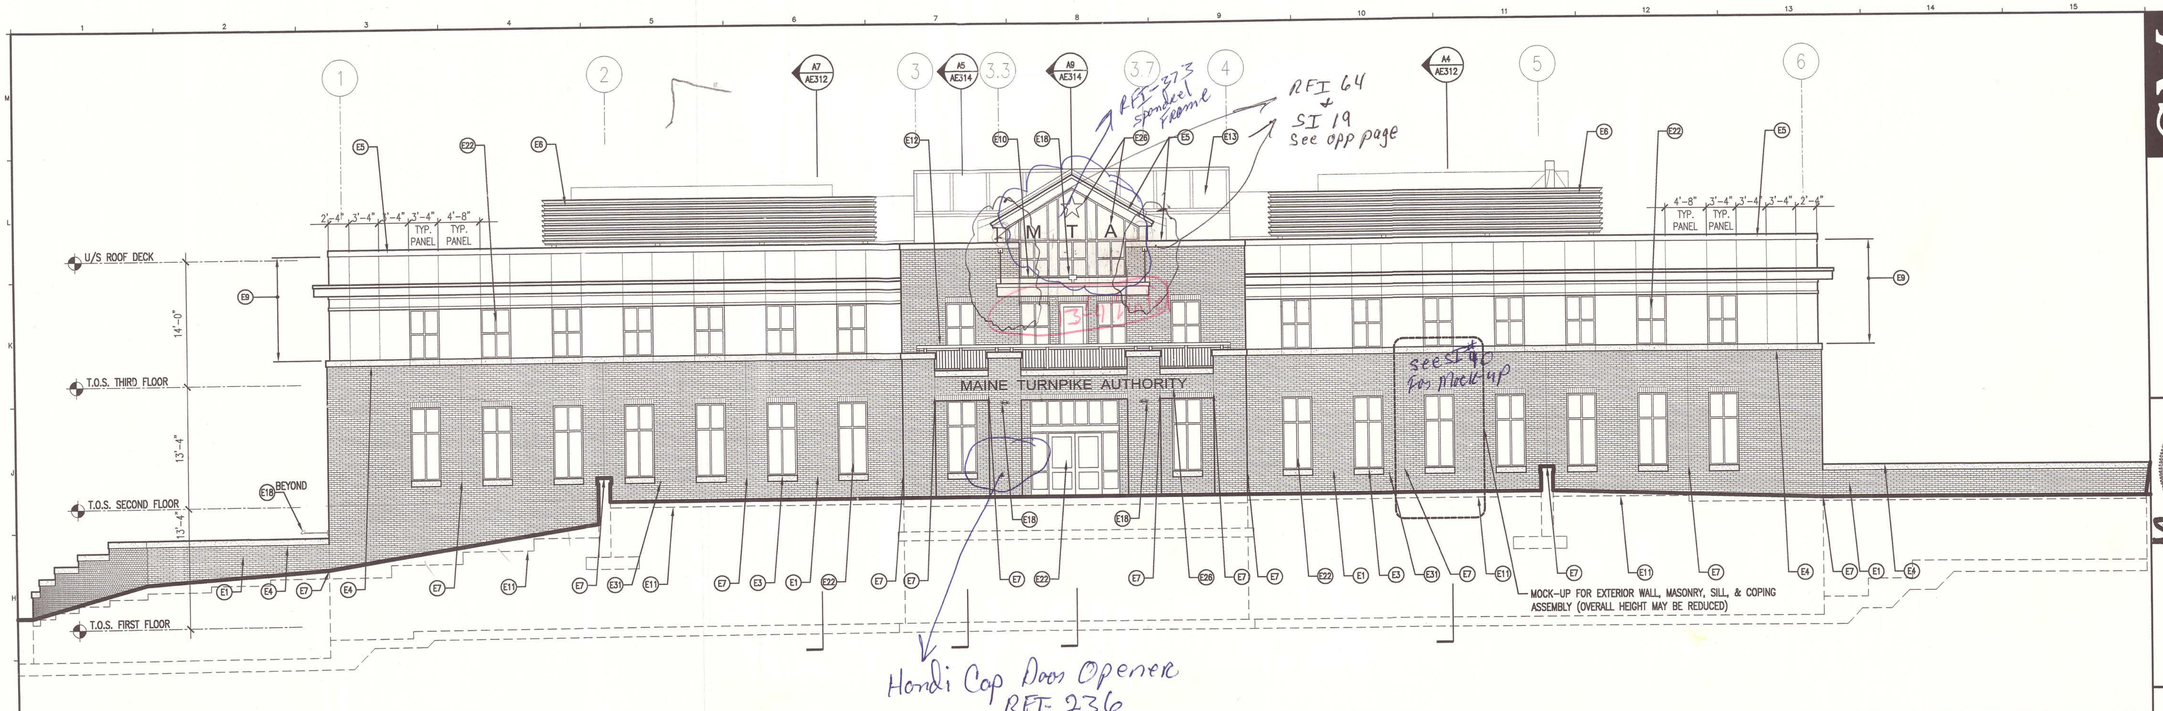

G1 EXTERIOR ELEVATION – SOUTH

1/8" = 1'-0"

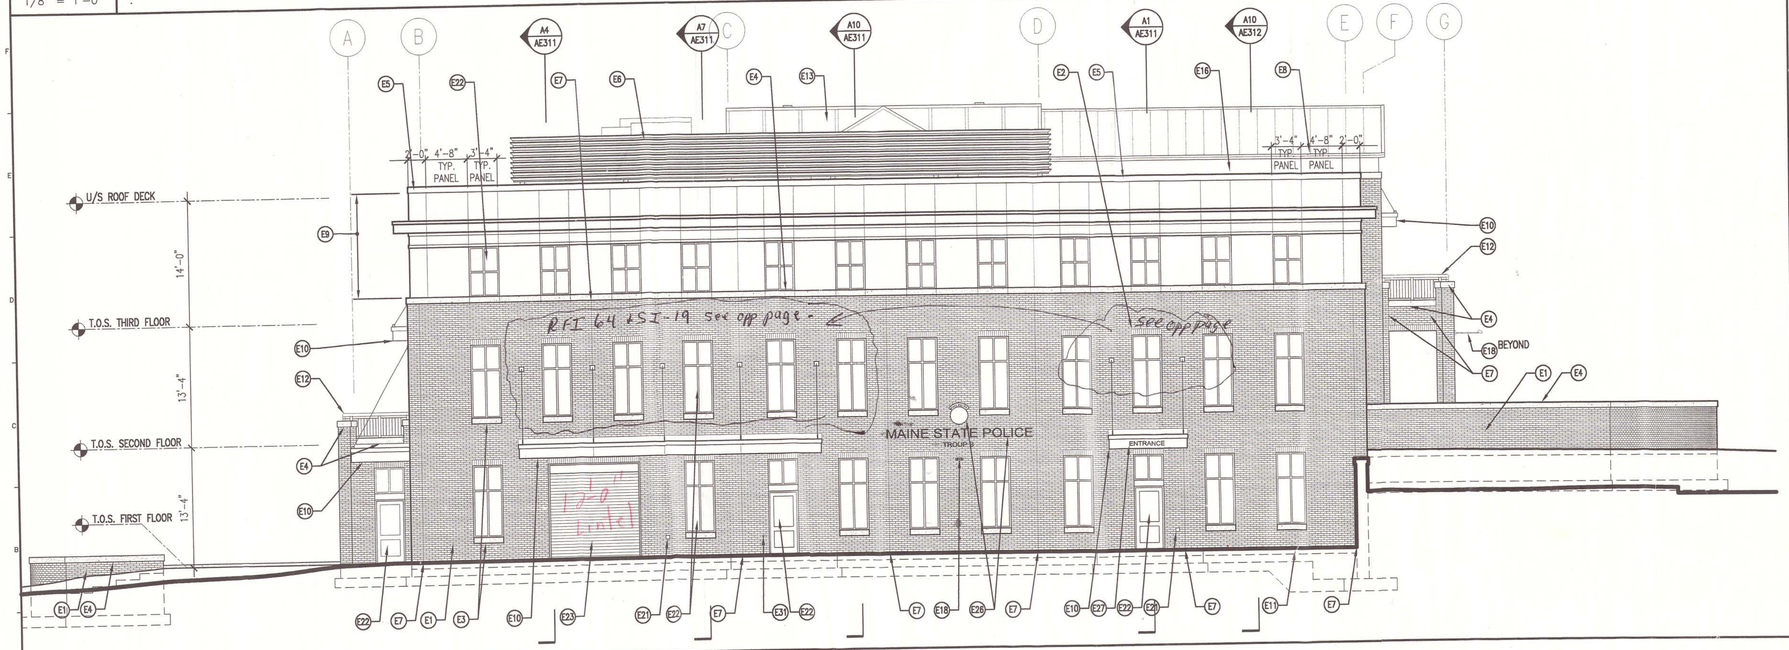

A1 EXTERIOR ELEVATION – WEST

1/8" = 1'-0"

GENERAL NOTES:

1. SEE G1001 FOR PROJECT GENERAL NOTES.

ELEVATION KEY NOTES:

- E1 FACE BRICK MASONRY
- E2 FACE BRICK SOLDIER COURSE
- E3 GRANITE SILL, RE: A7/AE532 FOR PROFILES
- E4 GRANITE COPING, RE: A7/AE532 FOR PROFILES
- E5 METAL FASCIA
- E6 MECHANICAL EQUIPMENT SCREEN
- E7 MASONRY EXPANSION JOINT
- E8 STANDING SEAM METAL ROOF
- E9 METAL-FACED COMPOSITE WALL PANEL ASSEMBLY
- E10 METAL-FACED COMPOSITE FASCIA
- E11 BRICK SHELF
- E12 METAL GUARDRAIL (HANDRAIL @ SITE STAIR), RE: A1/AE544 FOR BALCONY RAIL ELEVATIONS
- E13 FIBERGLASS SANDWICH PANEL SKYLIGHT ASSEMBLY
- E14 RECESSED FACE BRICK AT MASONRY OPENING
- E15 METAL FLASHING
- E16 METAL-FACED COMPOSITE WALL PANEL KNEEWALL
- E17 EQUIPMENT PAD
- E18 SURFACE-MOUNTED UPLIGHT FIXTURE
- E19 SANITARY DRAIN PENETRATION
- E20 STORM DRAIN PENETRATION
- E21 ELECTRICAL OUTLET
- E22 ALUMINUM-FRAMED STOREFRONT/ENTRANCE SYSTEM
- E23 OVERHEAD COILING DOOR
- E24 SUPPLY WATER PENETRATION
- E25 ELECTRICAL DUCT BANK
- E26 RAISED METAL SIGNAGE
- E27 APPLIED SIGNAGE
- E28 GAS METER
- E29 MECHANICAL CONNECTION
- E30 HOLLOW METAL DOOR & FRAME WITH ALUMINUM-FRAME TRANSOM ABOVE
- E31 WALL HYDRANT
- E32 FIRE DEPARTMENT CONNECTION & BELL
- E33 SITE IRRIGATION PENETRATION
- E34 FIRE PROTECTION PENETRATION
- E35 MECHANICAL AIR INTAKES
- E36 FIRE PROTECTION DRAIN
- E37 BRICK VENT
- E38 DOCK BUMPERS

AS BUILT Owner Copy

SMRT
ARCHITECTURE ENGINEERING PLANNING
SMRT
144 Fore Street/P.O. Box 618
Portland, Maine 04104
tel. (207) 772-3846
fax. (207) 772-1070

STATE OF MAINE SCOTT L. BENSON No. 1772 REGISTERED PROFESSIONAL ARCHITECT

PROJECT NORTH
MAG NORTH

PROJECT TITLE: MAINE TURNPIKE AUTHORITY ADMINISTRATION BUILDING PORTLAND, MAINE

CURRENT ISSUE STATUS: ISSUED FOR BIDDING/CONSTRUCTION 7-9-07

REV	DESCRIPTION	DATE
0	BIDDING/CONSTRUCTION	7-9-07

GRAPHIC SCALE: 0" 1"


SCALE:	AS NOTED
PROJECT MANAGER:	SLB
JC/DRAWN BY:	TCM/TCM
A/E OF RECORD:	SLB
CAD FILE:	AE201-06016
PROJECT NO:	06016
DATE:	7-9-07

SHEET TITLE: EXTERIOR ELEVATIONS

SHEET No. AE201

©COPYRIGHT 2007 SMRT INC

Mock-up

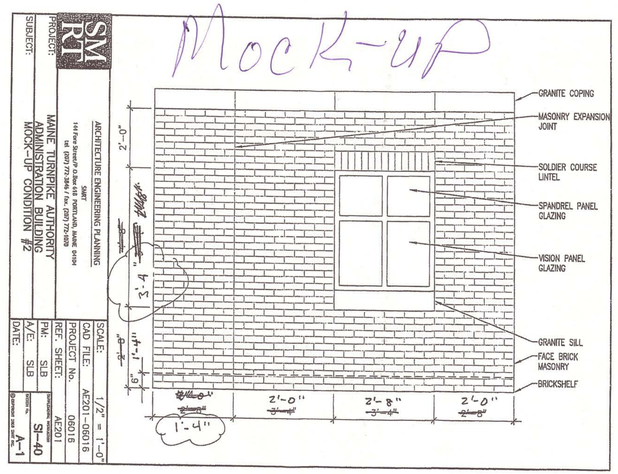

SM RT


ARCHITECTURE ENGINEERING PLANNING


SMRT
144 Fore Street/P.O.Box 618 PORTLAND, MAINE 04104
tel. (207) 772-3846 / fax. (207) 772-1070

PROJECT: MAINE TURNPIKE AUTHORITY ADMINISTRATION BUILDING

SUBJECT: MOCK-UP CONDITION #2


SCALE:	1/2" = 1'-0"
CAD FILE:	AE201-06016
PROJECT No.	06016
REF. SHEET:	AE201
PM: SLB	SUPPLEMENTAL INSTRUCTION SI-40
A/E: SLB	SHEET No. A-1
DATE:	

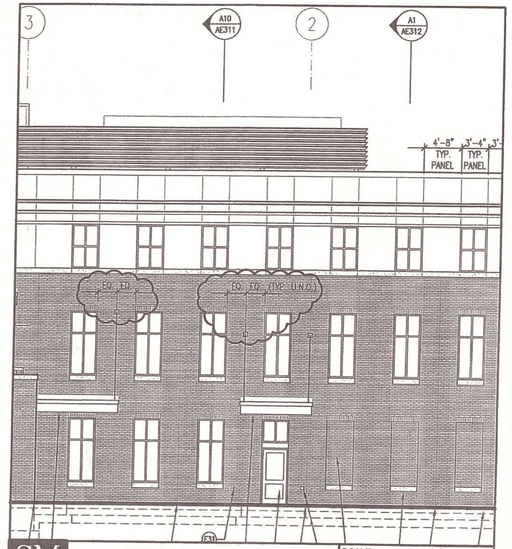
3
A10 AE311
2
A1 AE312
4'-8" TYP. PANEL
3'-4" TYP. PANEL
3'
EQ
EQ
EQ

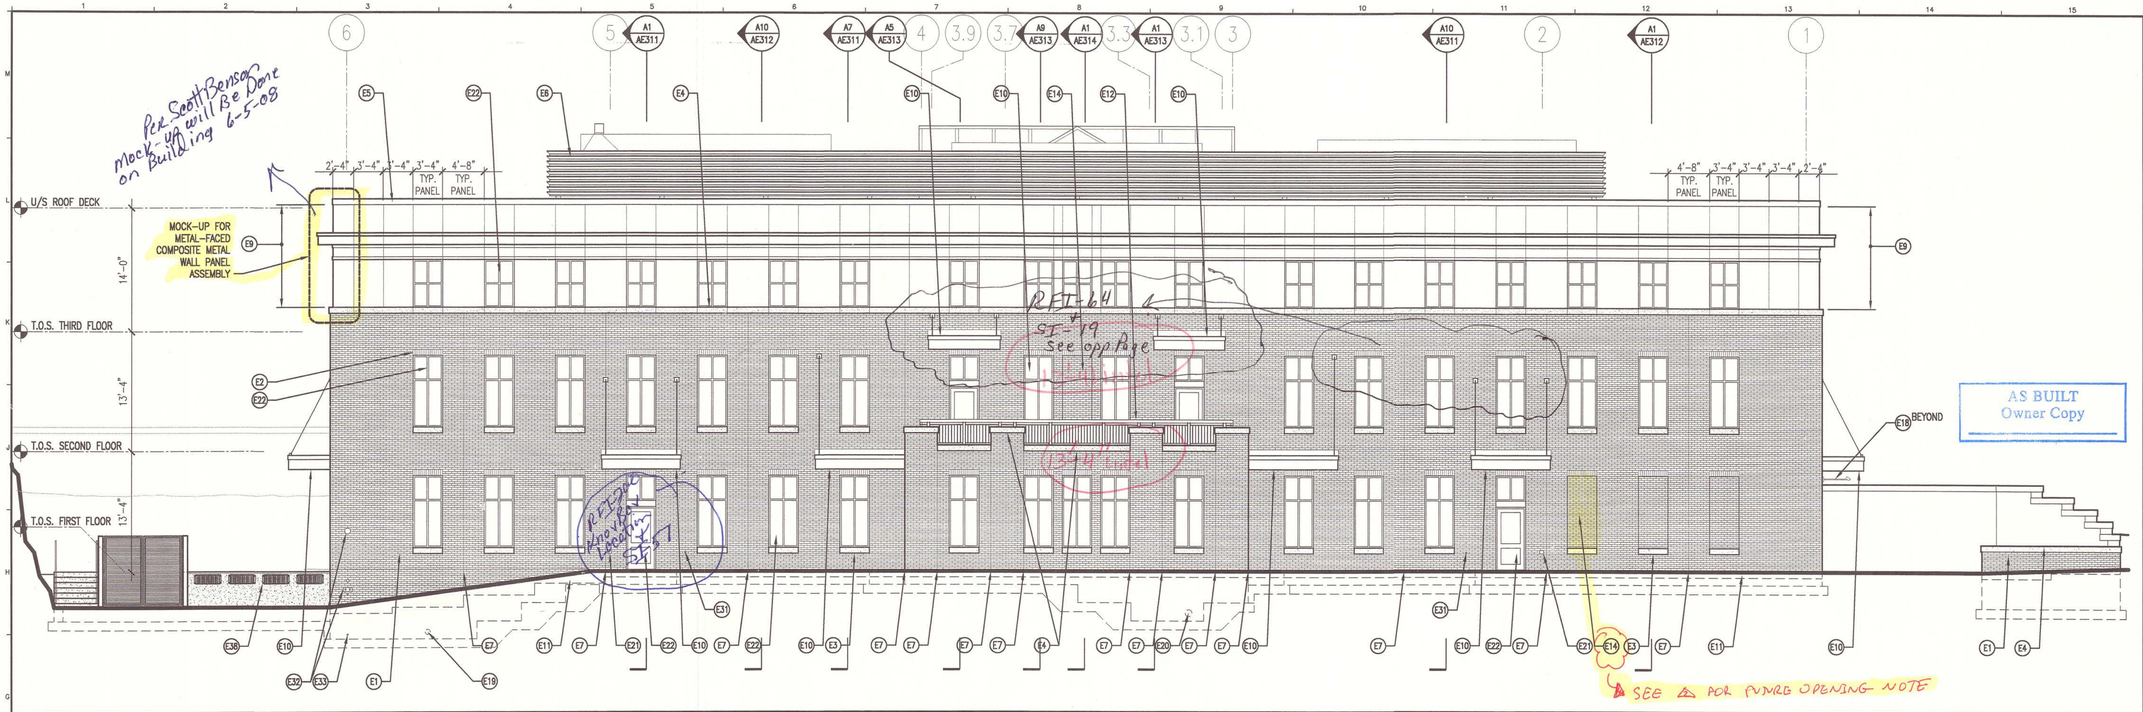

G1 EXTERIOR ELEVATION — NORTH

1/8" = 1'-0"

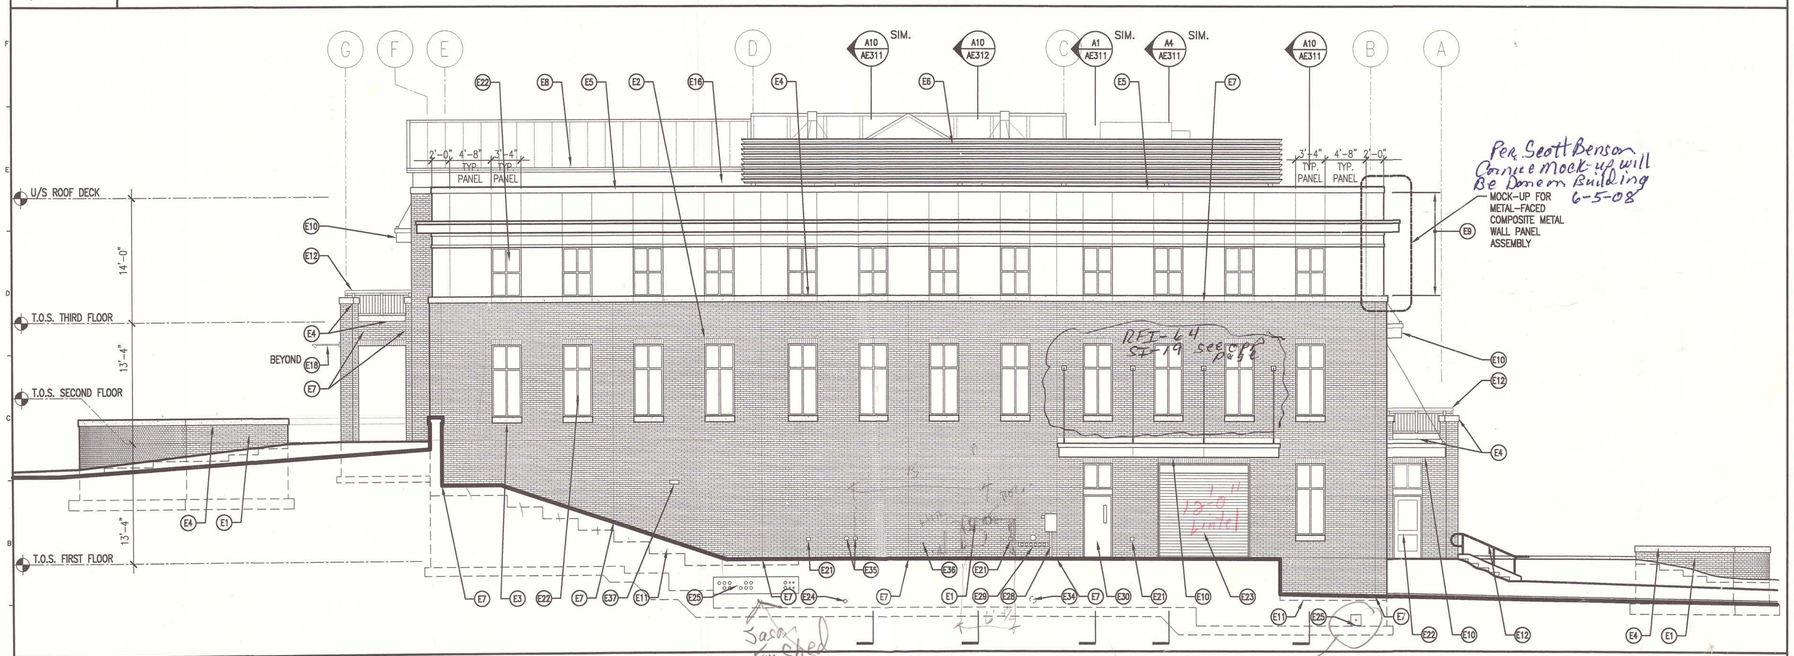

A1 EXTERIOR ELEVATION — EAST

1/8" = 1'-0"

GENERAL NOTES:

1. SEE G1001 FOR PROJECT GENERAL NOTES.

ELEVATION KEY NOTES:

- E1 FACE BRICK MASONRY
- E2 FACE BRICK SOLDIER COURSE
- E3 GRANITE SILL, RE: A7/AE532 FOR PROFILES
- E4 GRANITE COPING, RE: A7/AE532 FOR PROFILES
- E5 METAL FASCIA
- E8 MECHANICAL EQUIPMENT SCREEN
- E7 MASONRY EXPANSION JOINT
- E8 STANDING SEAM METAL ROOF
- E9 METAL-FACED COMPOSITE WALL PANEL ASSEMBLY
- E10 METAL-FACED COMPOSITE FASCIA
- E11 BRICK SHELF
- E12 METAL GUARDRAIL (HANDRAIL @ SITE STAIR), RE: A1/AE544 FOR BALCONY RAIL ELEVATIONS
- E13 FIBERGLASS SANDWICH PANEL SKYLIGHT ASSEMBLY
- E14 RECESSED FACE BRICK AT MASONRY OPENING
- E15 METAL FLASHING
- E16 METAL-FACED COMPOSITE WALL PANEL KNEEWALL
- E17 EQUIPMENT PAD
- E18 SURFACE-MOUNTED UPLIGHT FIXTURE
- E19 SANITARY DRAIN PENETRATION
- E20 STORM DRAIN PENETRATION
- E21 ELECTRICAL OUTLET
- E22 ALUMINUM-FRAMED STOREFRONT/ENTRANCE SYSTEM
- E23 OVERHEAD COILING DOOR
- E24 SUPPLY WATER PENETRATION
- E25 ELECTRICAL DUCT BANK
- E26 RAISED METAL SIGNAGE
- E27 APPLIED SIGNAGE
- E28 GAS METER
- E29 MECHANICAL CONNECTION
- E30 HOLLOW METAL DOOR & FRAME WITH ALUMINUM-FRAME TRANSOM ABOVE
- E31 WALL HYDRANT
- E32 FIRE DEPARTMENT CONNECTION & BELL
- E33 SITE IRRIGATION PENETRATION
- E34 FIRE PROTECTION PENETRATION
- E35 MECHANICAL AIR INTAKES
- E36 FIRE PROTECTION DRAIN
- E37 BRICK VENT
- E38 DOCK BUMPERS

SMRT
ARCHITECTURE ENGINEERING PLANNING
SMRT
144 Fore Street/P.O. Box 618
Portland, Maine 04104
tel. (207) 772-3846
fax. (207) 772-1070

STATE OF MAINE SCOTT L BENSON No. 1772 REGISTERED PROFESSIONAL ARCHITECT

PROJECT NORTH
MAG. NORTH

PROJECT TITLE: MAINE TURNPIKE AUTHORITY ADMINISTRATION BUILDING PORTLAND, MAINE

CURRENT ISSUE STATUS: ISSUED FOR BIDDING/CONSTRUCTION 7-9-07

REV	DESCRIPTION	DATE
0	BIDDING/CONSTRUCTION	7-9-07


GRAPHIC SCALE: 0" 1"

SCALE:	AS NOTED
PROJECT MANAGER:	SLB
JC/DRAWN BY:	TCM/TCM
A/E OF RECORD:	SLB
CAD FILE:	AE202-06016
PROJECT NO:	06016
DATE:	7-9-07


SHEET TITLE: EXTERIOR ELEVATIONS

SHEET No. AE202


©COPYRIGHT 2007 SMRT INC.

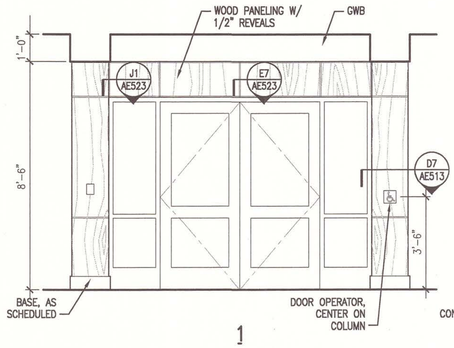


1

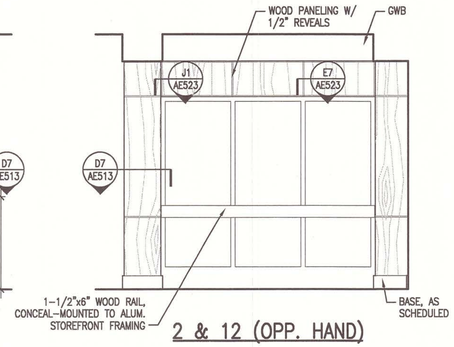

2 & 12 (OPP. HAND)

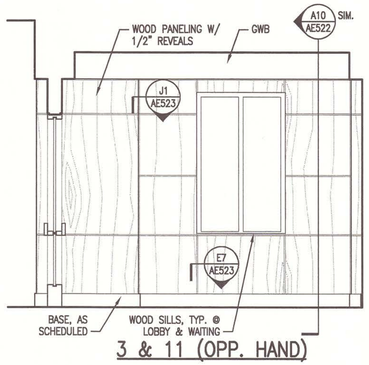


3 & 11 (OPP. HAND)

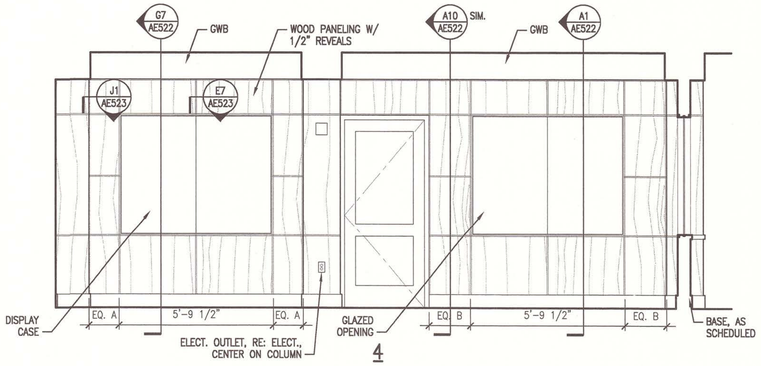


4

J1 INTERIOR ELEVATION – LOBBY 210 & WAITING 214/215

3/8" = 1'-0"

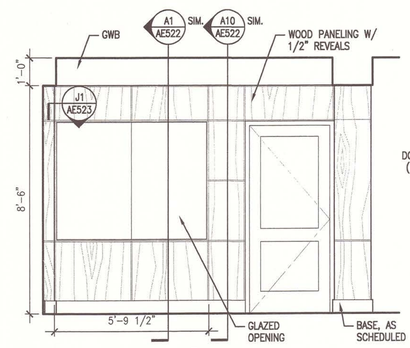


5

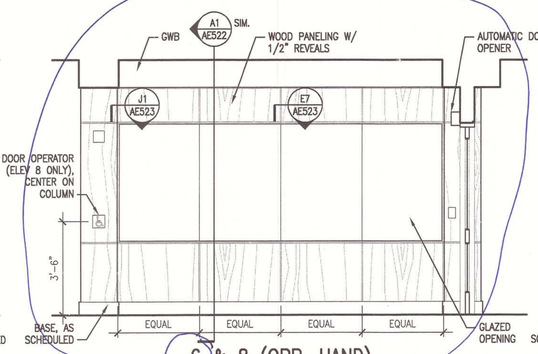


6 & 8 (OPP. HAND)

Revise Elev. See ST-64+64R

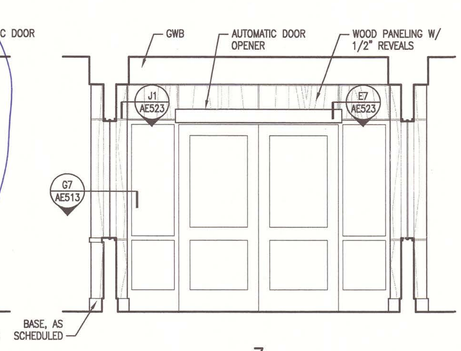


7

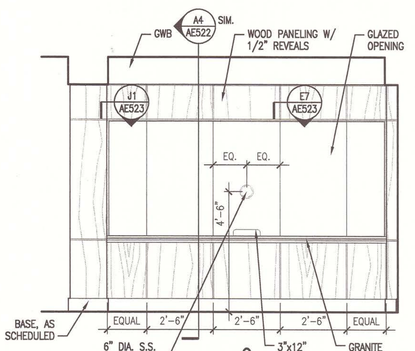

9

E1 INTERIOR ELEVATION – LOBBY 210


3/8" = 1'-0"

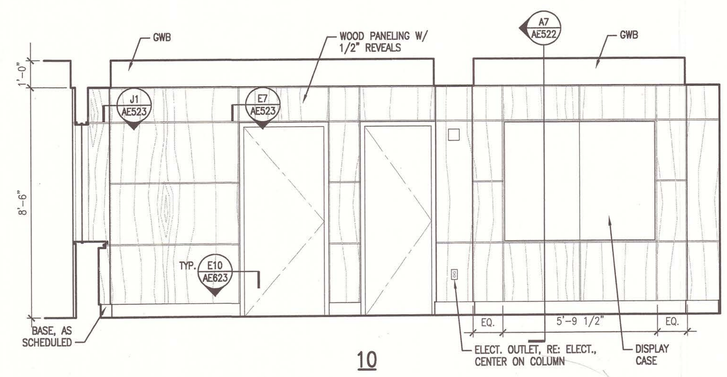


10

A1 INTERIOR ELEVATION – LOBBY 210 & WAITING 214


3/8" = 1'-0"

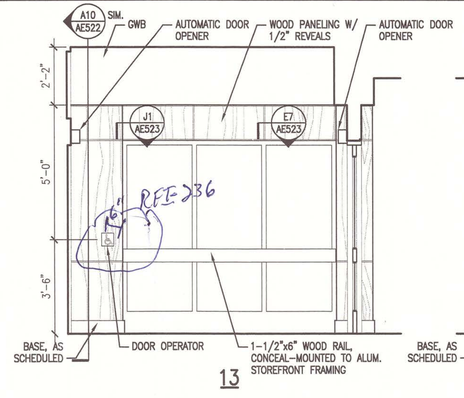

13

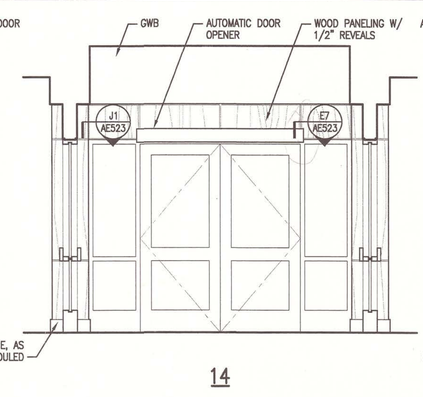

14

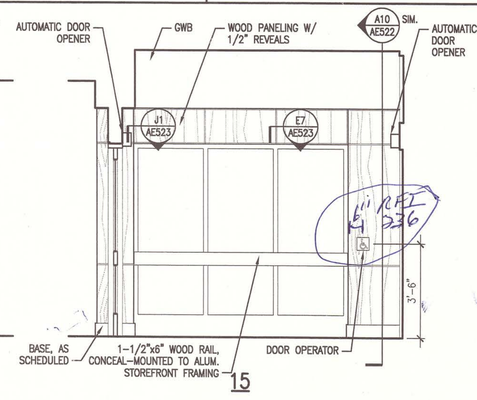

15

A6 INTERIOR ELEVATION – VESTIBULE 211

3/8" = 1'-0"

GENERAL NOTES:

1. SEE GI001 FOR PROJECT GENERAL NOTES.

SMRT
ARCHITECTURE ENGINEERING PLANNING
SMRT
144 Fore Street/P.O. Box 618
Portland, Maine 04104
tel. (207) 772-3846
fax. (207) 772-1070

STATE OF MAINE SCOTT L. BENSON No. 1772 REGISTERED PROFESSIONAL ARCHITECT

AS BUILT Owner Copy

PROJECT TITLE: MAINE TURNPIKE AUTHORITY ADMINISTRATION BUILDING PORTLAND, MAINE

CURRENT ISSUE STATUS: ISSUED FOR BIDDING/CONSTRUCTION 7-9-07

REV	DESCRIPTION	DATE
0	BIDDING/CONSTRUCTION	7-9-07


GRAPHIC SCALE: 0" 1"

SCALE:	AS NOTED
PROJECT MANAGER:	SLB
JC/DRAWN BY:	TCM/ DG
A/E OF RECORD:	SLB
CAD FILE:	AE211–06016
PRGJECT NO:	06016
DATE:	7-9-07


SHEET TITLE: INTERIOR ELEVATIONS

SHEET No. AE211

©COPYRIGHT 2007 SMRT INC.

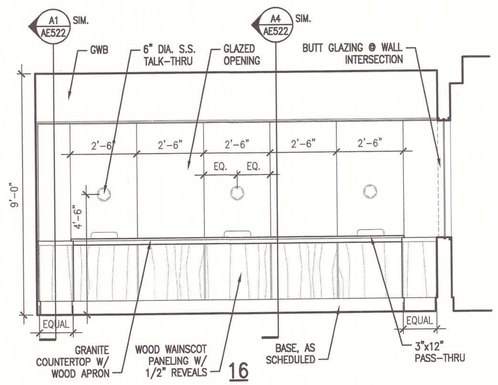

16

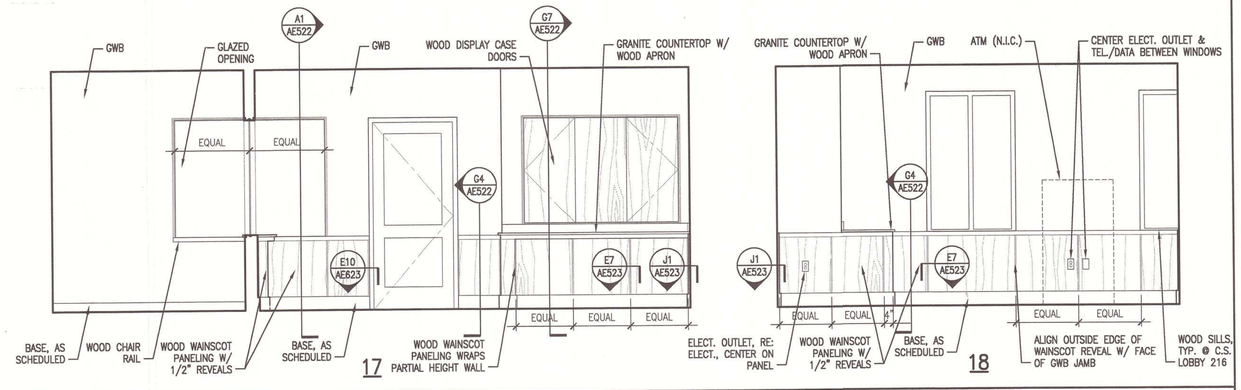


17


18

J1 | INTERIOR ELEVATION – C.S. LOBBY 216

3/8" = 1'-0" | –

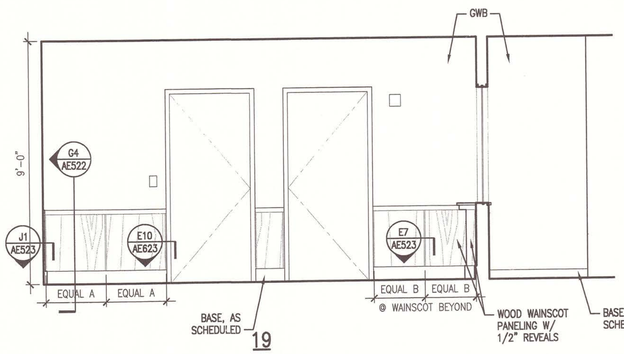

19

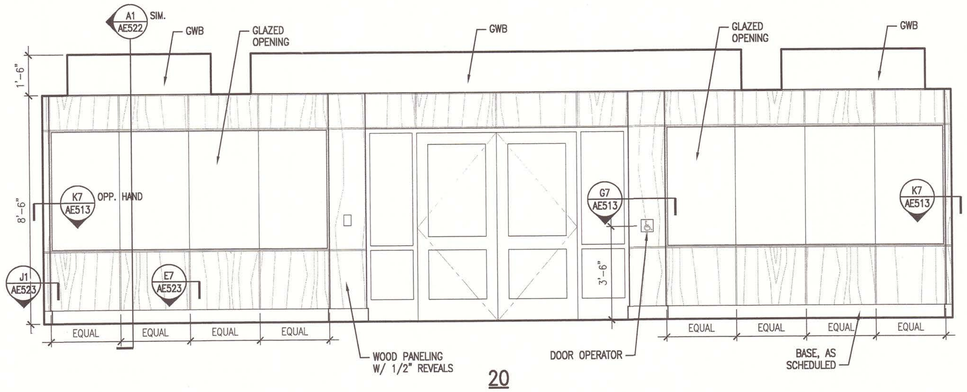


20

E1 | INTERIOR ELEVATION – C.S. LOBBY 216


3/8" = 1'-0" | –

E6 | INTERIOR ELEVATION – HALL 201a

3/8" = 1'-0" | –

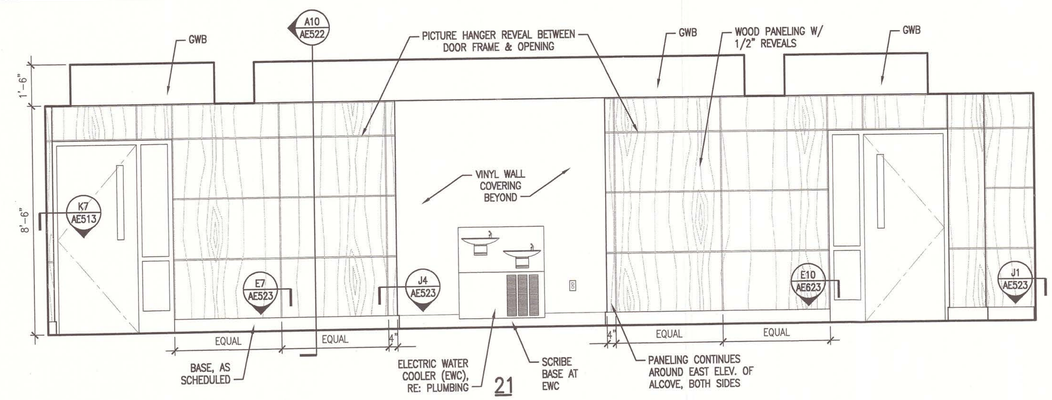

21

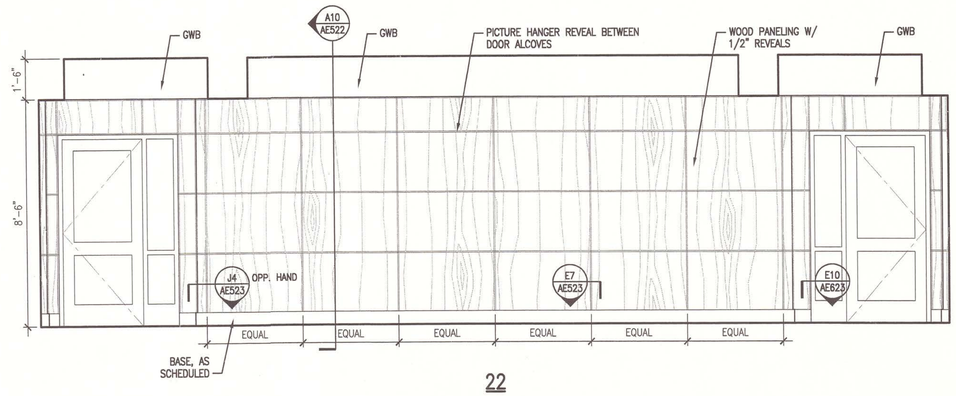

22

A1 | INTERIOR ELEVATION – HALL 201a

3/8" = 1'-0" | –

A8 | INTERIOR ELEVATION – HALL 201b

3/8" = 1'-0" | –

GENERAL NOTES:

1. SEE GI001 FOR PROJECT GENERAL NOTES.

SMRT
ARCHITECTURE ENGINEERING PLANNING
SMRT
144 Fore Street P.O. Box 618
Portland, Maine 04104
tel.: (207) 772-3846
fax: (207) 772-1070

STATE OF MAINE SCOTT L. BENSON No. 1772 REGISTERED PROFESSIONAL ARCHITECT

AS BUILT
Owner Copy

PROJECT TITLE:
MAINE TURNPIKE AUTHORITY ADMINISTRATION BUILDING
PORTLAND, MAINE

CURRENT ISSUE STATUS:
ISSUED FOR BIDDING/CONSTRUCTION
7-9-07

REV	DESCRIPTION	DATE
0	BIDDING/CONSTRUCTION	7-9-07

GRAPHIC SCALE: 0" 1"

SCALE:	AS NOTED
PROJECT MANAGER:	SLB
JC/DRAWN BY:	TCM/ DG
A/E OF RECORD:	SLB
CAD FILE:	AE212-06016
PROJECT NO:	06016
DATE:	7-9-07


SHEET TITLE:
INTERIOR ELEVATIONS

SHEET No.
AE212


© COPYRIGHT 2007 SMRT INC

J1 INTERIOR ELEVATION – HALL 201a

3/8" = 1'-0"

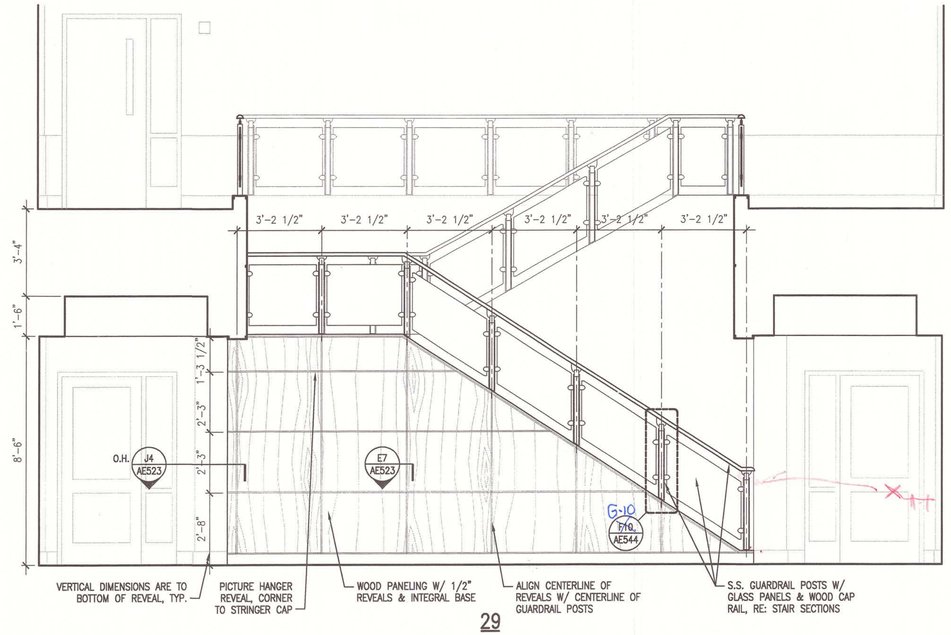


29

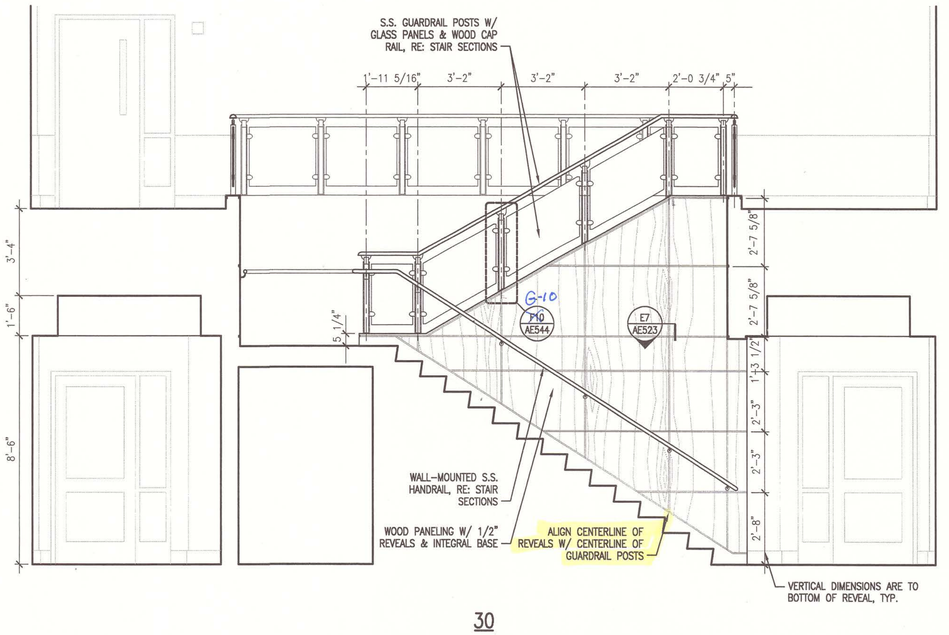


30

A1 INTERIOR ELEVATION – GALLERY 301

3/8" = 1'-0"

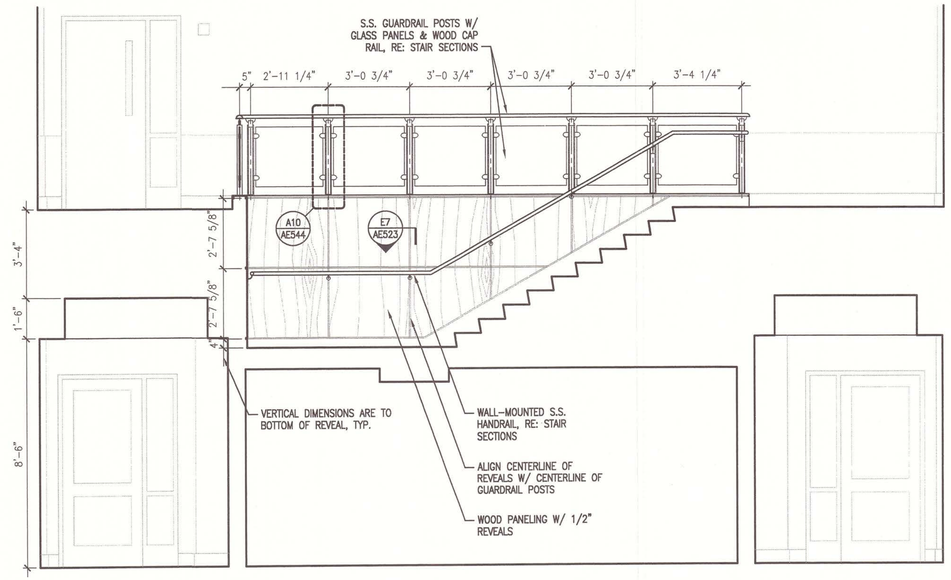

31

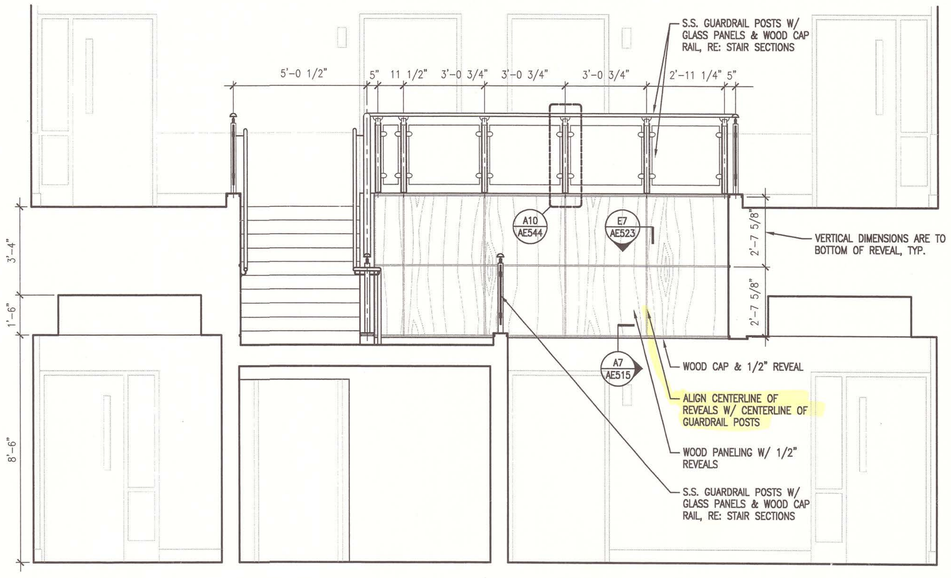

32

SMRT
ARCHITECTURE ENGINEERING PLANNING
SMRT
144 Fore Street / P.O. Box 618
Portland, Maine 04104
tel. (207) 772-3846
fax. (207) 772-1070

STATE OF MAINE
SCOTT L BENSON
No. 1772
REGISTERED PROFESSIONAL ARCHITECT

AS BUILT
Owner Copy

PROJECT TITLE:
MAINE TURNPIKE AUTHORITY
ADMINISTRATION BUILDING
PORTLAND, MAINE

CURRENT ISSUE STATUS:
ISSUED FOR BIDDING/CONSTRUCTION
7-9-07

REV	DESCRIPTION	DATE
0	BIDDING/CONSTRUCTION	7-9-07


GRAPHIC SCALE: 0" 1"

SCALE:	AS NOTED
PROJECT MANAGER:	SLB
JC/DRAWN BY:	TCM/ DG
A/E OF RECORD:	SLB
CAD FILE:	AE214-06016
PROJECT NO:	06016
DATE:	7-9-07

SHEET TITLE:
INTERIOR ELEVATIONS


SHEET No.
AE214

©COPYRIGHT 2007 SMRT INC

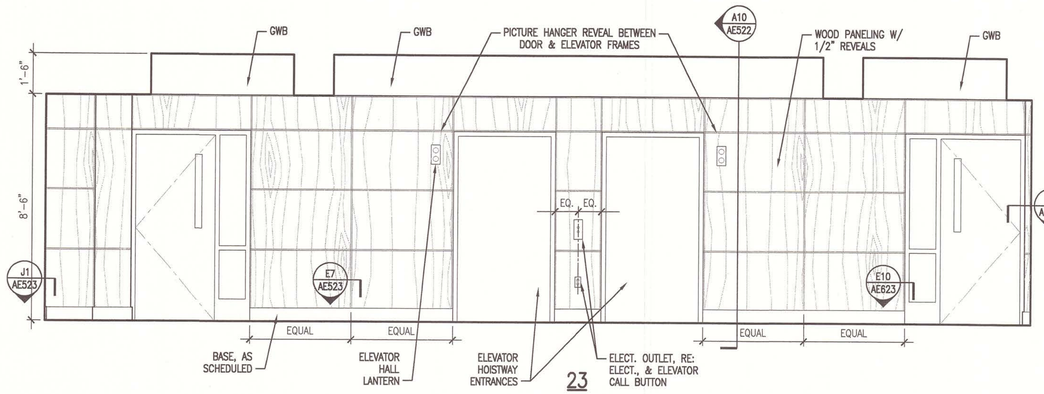


23

J1	INTERIOR ELEVATION – HALL 201a
3/8" = 1'-0"	–

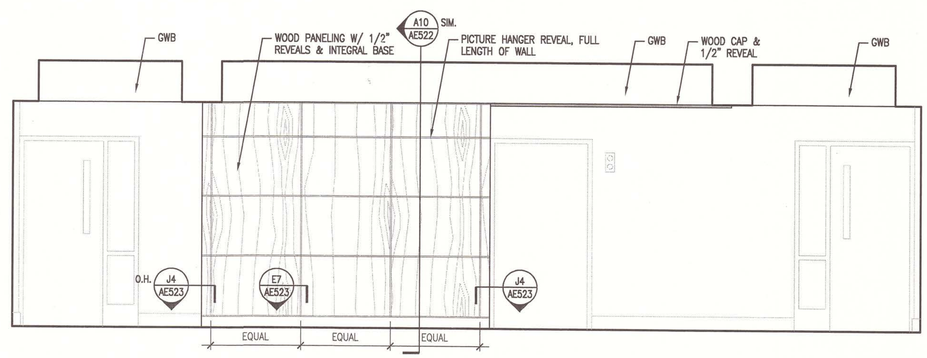


24

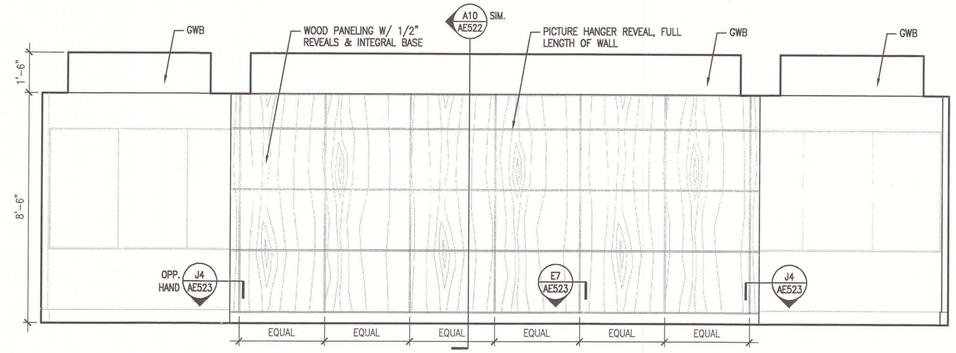

25

E1	INTERIOR ELEVATION – HALL 201b
3/8" = 1'-0"	–

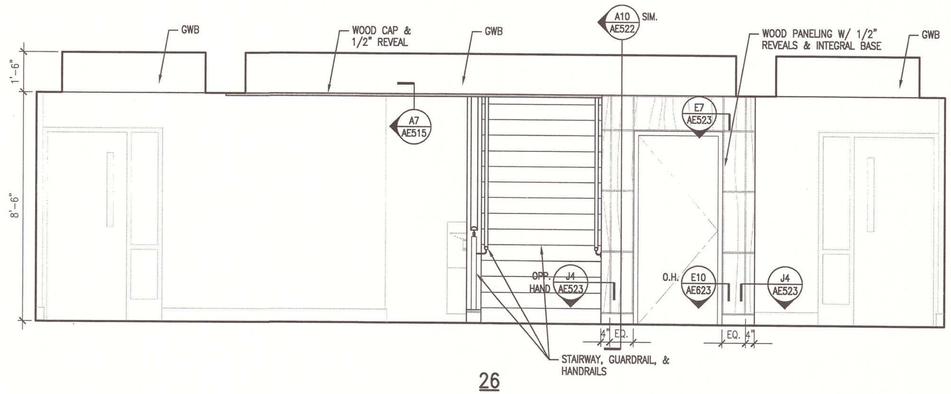

26

E8	INTERIOR ELEVATION – HALL 201a
3/8" = 1'-0"	–

For Elevator Wood Panels
see SI-29

GENERAL NOTES:

1. SEE GI001 FOR PROJECT GENERAL NOTES.
2. PANELS ARE DIMENSIONED TO BOTTOM OF JOINT. TYPICAL PANEL JOINT DIM. IS 1/2"

AS BUILT
Owner Copy

A1	INTERIOR ELEVATION – ELEVATOR
3/8" = 1'-0"	–

SMRT
ARCHITECTURE ENGINEERING PLANNING
SMRT
144 Fore Street/P.O. Box 618
Portland, Maine 04104
tel. (207) 772-3846
fax. (207) 772-1070

STATE OF MAINE
SCOTT L. BENSON
No. 1772
REGISTERED PROFESSIONAL ENGINEER

PROJECT TITLE: MAINE TURNPIKE AUTHORITY ADMINISTRATION BUILDING PORTLAND, MAINE

CURRENT ISSUE STATUS: ISSUED FOR BIDDING/CONSTRUCTION 7-9-07

REV	DESCRIPTION	DATE
0	BIDDING/CONSTRUCTION	7-9-07

GRAPHIC SCALE: 0" 1"


SCALE:	AS NOTED
PROJECT MANAGER:	SLB
JC/DRAWN BY:	TCM/ DG
A/E OF RECORD:	SLB
CAD FILE:	AE213-06016
PROJECT NO:	06016
DATE:	7-9-07

SHEET TITLE: INTERIOR ELEVATIONS

SHEET No. AE213


© COPYRIGHT 2007 SMRT INC

J1	–
*	–

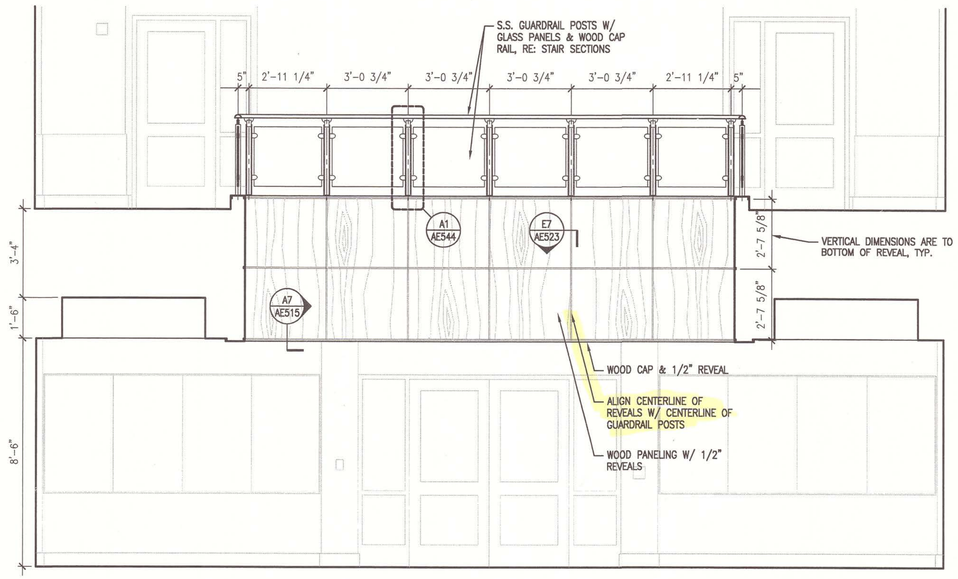

33

J6	INTERIOR ELEVATION – GALLERY 301
3/8" = 1'-0"	–

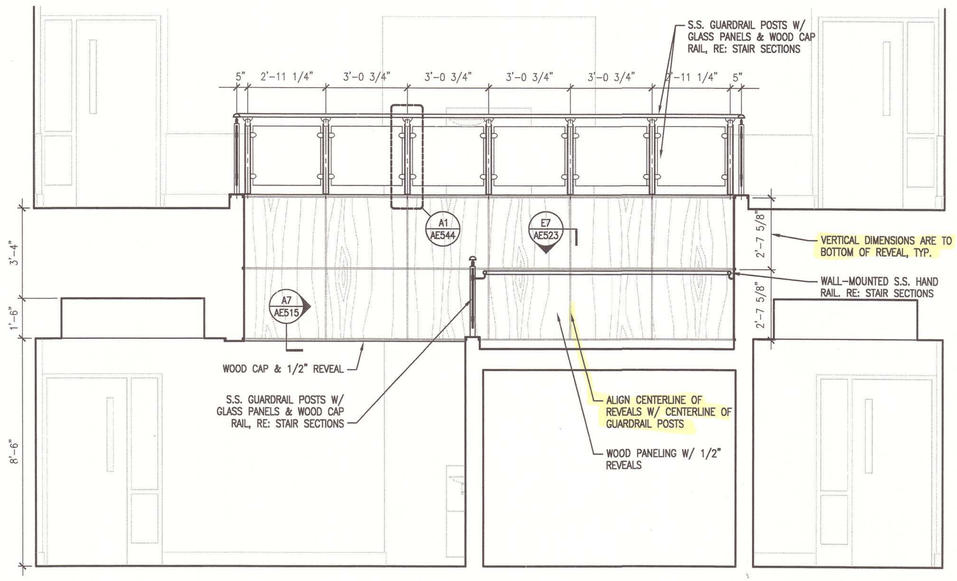

34

A6	INTERIOR ELEVATION – GALLERY 301
3/8" = 1'-0"	–

E1	–
*	–

A1	–
*	–

GENERAL NOTES:

1. SEE GI001 FOR PROJECT GENERAL NOTES.

SMRT
ARCHITECTURE ENGINEERING PLANNING
SMRT
144 Fore Street/ P.O. Box 618
Portland, Maine 04104
tel. (207) 772-3846
fax. (207) 772-1070

STATE OF MAINE
SCOTT L BENSON
No. 1772
REGISTERED PROFESSIONAL ARCHITECT

PROJECT TITLE:
MAINE TURNPIKE AUTHORITY
ADMINISTRATION BUILDING
PORTLAND, MAINE

CURRENT ISSUE STATUS:
ISSUED FOR BIDDING/CONSTRUCTION
7-9-07

REV	DESCRIPTION	DATE
0	BIDDING/CONSTRUCTION	7-9-07

GRAPHIC SCALE: 0" 1"


SCALE:	AS NOTED
PROJECT MANAGER:	SLB
JC/DRAWN BY:	TCM/ DG
A/E OF RECORD:	SLB
CAD FILE:	AE215-06016
PROJECT NO:	06016
DATE:	7-9-07


SHEET TITLE:
INTERIOR ELEVATIONS

SHEET No.
AE215

© COPYRIGHT 2007 SMRT INC.

AS BUILT
Owner Copy

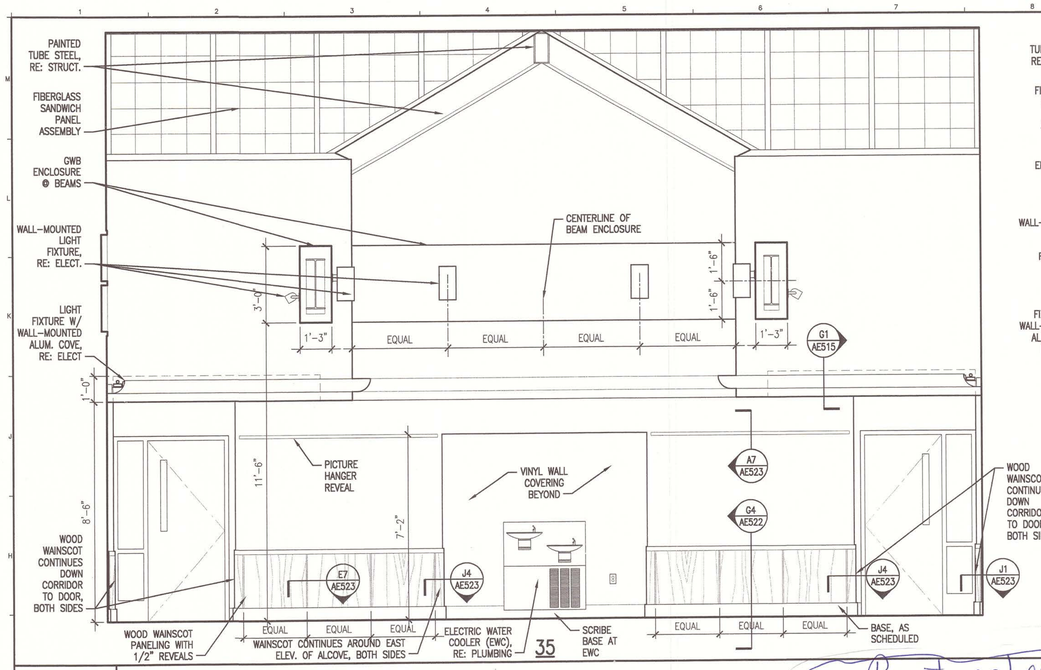


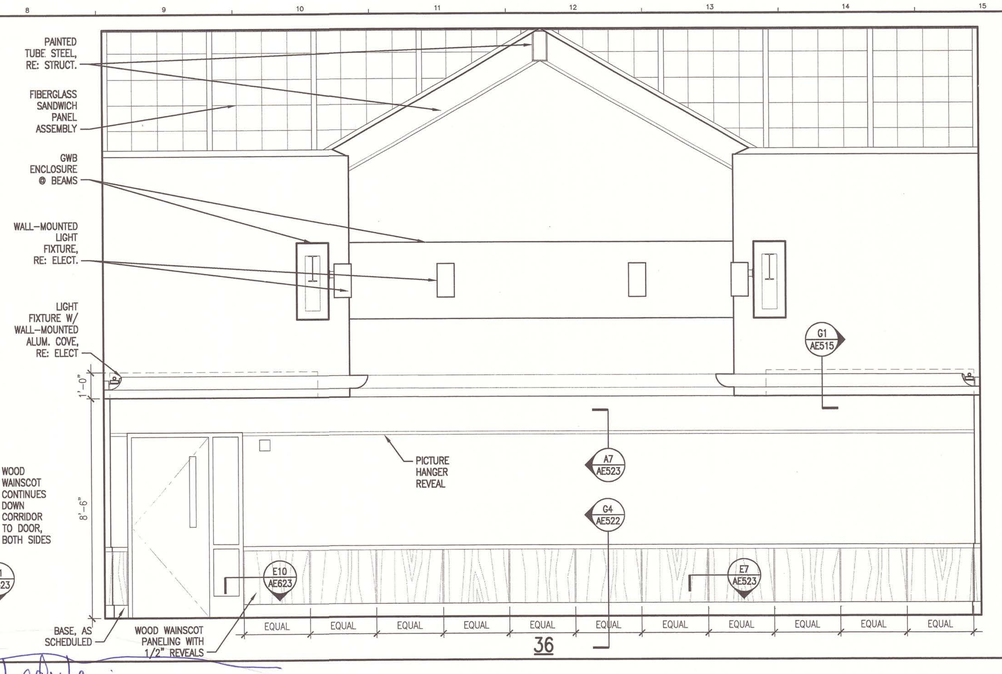


J1 | INTERIOR ELEVATIONS – GALLERY 301

3/8" = 1'-0"

Paint schedule
See SI #60

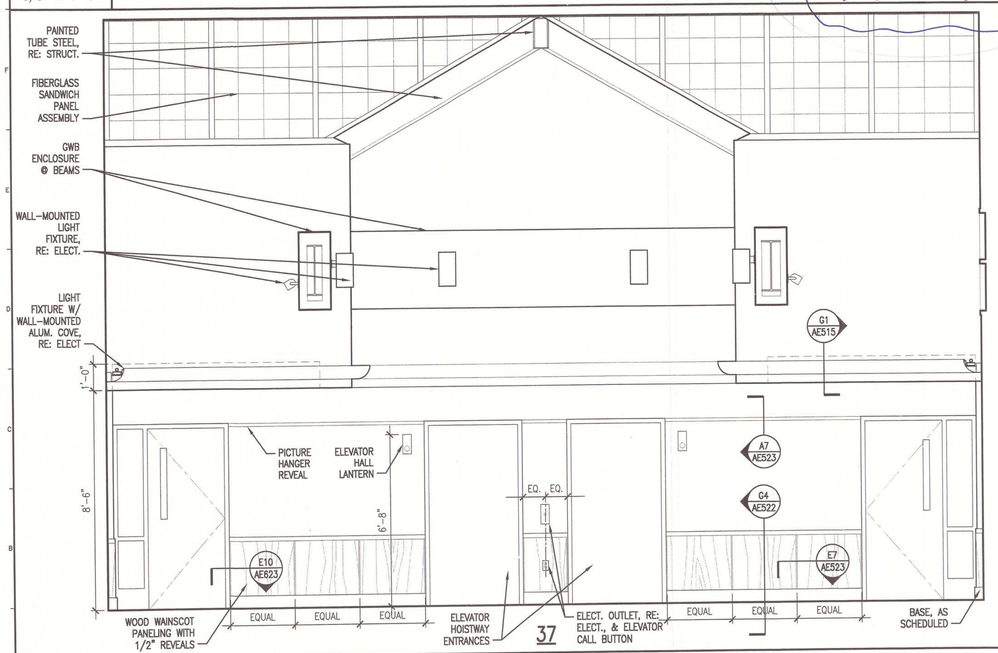

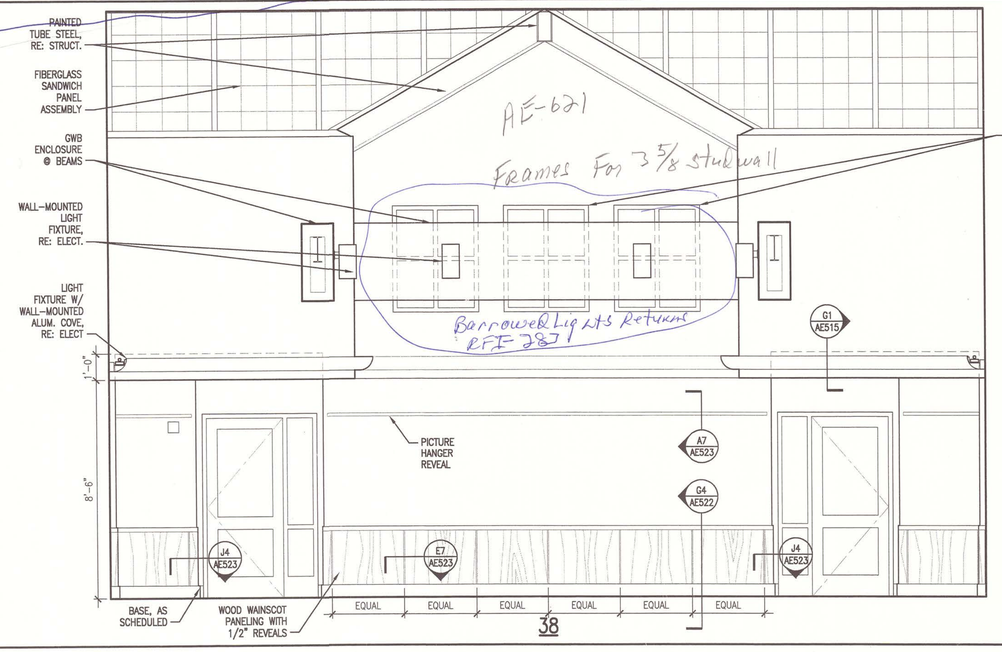

A1 | INTERIOR ELEVATIONS – GALLERY 301

3/8" = 1'-0"

SMRT
ARCHITECTURE ENGINEERING PLANNING
SMRT
144 Fore Street / P.O. Box 618
Portland, Maine 04104
tel. (207) 772-3846
fax. (207) 772-1070

STATE OF MAINE
SCOTT L. BENSON
No. 1772
REGISTERED PROFESSIONAL ARCHITECT

AS BUILT
Owner Copy

PROJECT TITLE:
MAINE TURNPIKE AUTHORITY
ADMINISTRATION BUILDING
PORTLAND, MAINE

CURRENT ISSUE STATUS:
ISSUED FOR BIDDING/CONSTRUCTION
7-9-07

NO	DESCRIPTION	DATE
0	BIDDING/CONSTRUCTION	7-9-07


GRAPHIC SCALE: 0" 1"


SCALE:	AS NOTED
PROJECT MANAGER:	SLB
JC/DRAWN BY:	TCM/ DG
A/E OF RECORD:	SLB
CAD FILE:	AE216-06016
PROJECT NO:	06016
DATE:	7-9-07

SHEET TITLE:
INTERIOR ELEVATIONS

SHEET No.
AE216


©COPYRIGHT 2007 SMRT INC.

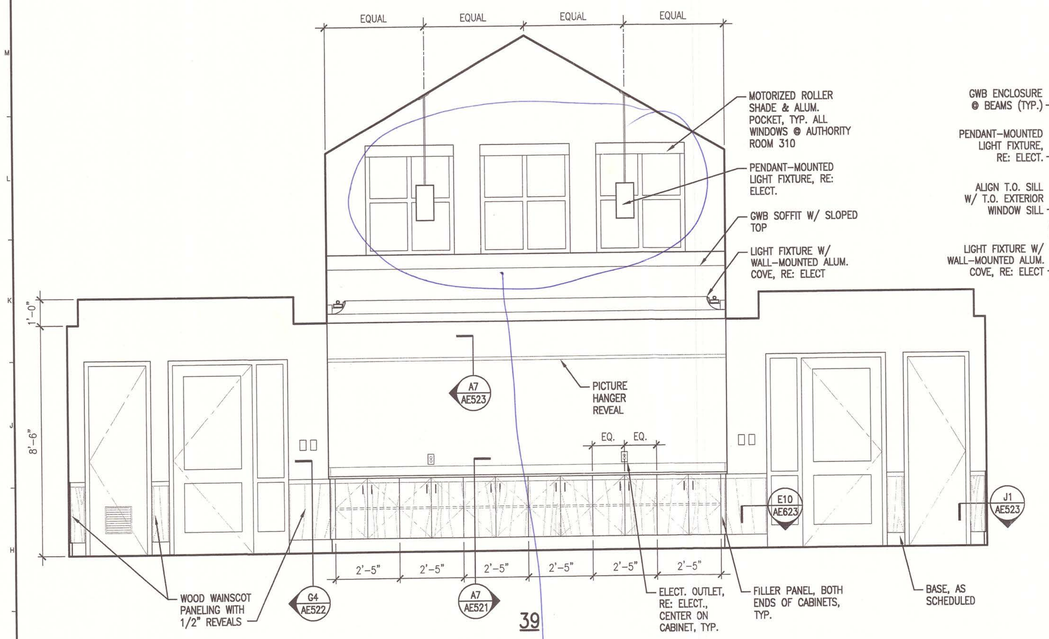


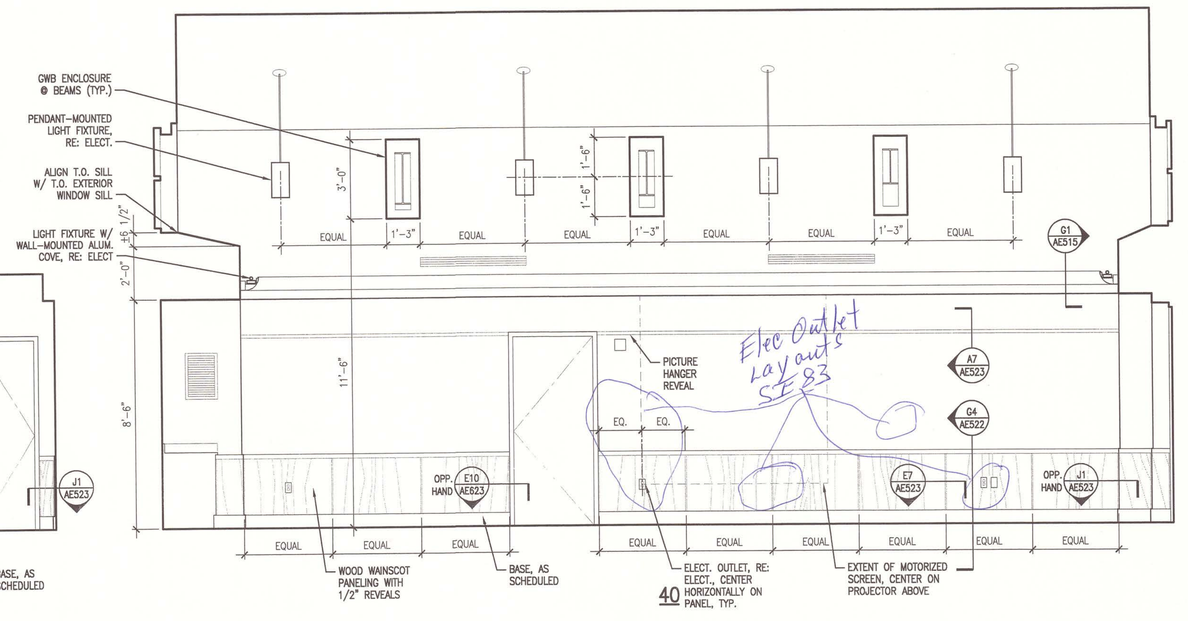

J1 INTERIOR ELEVATIONS – AUTHORITY ROOM 310

3/8" = 1'-0"

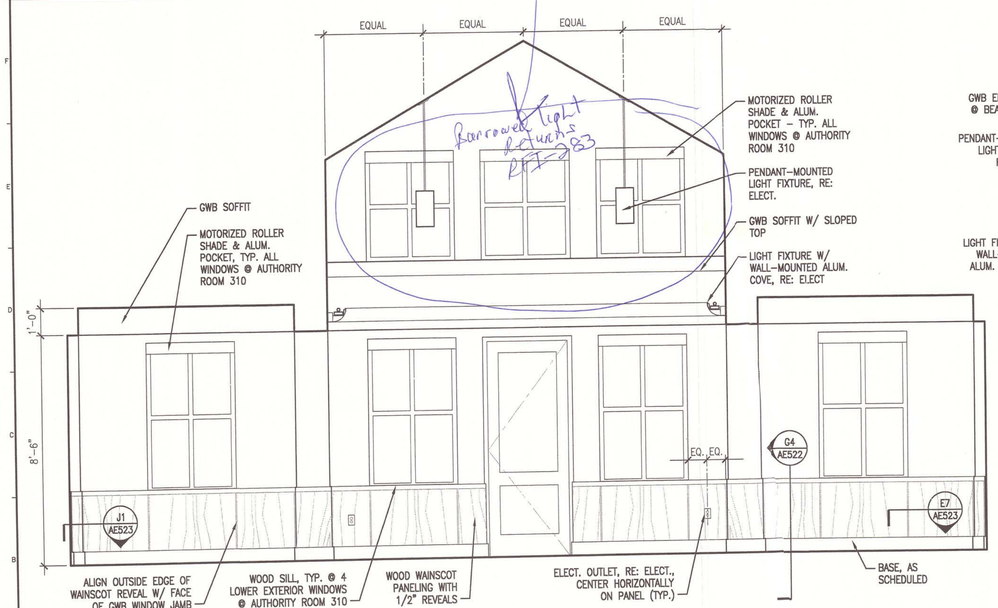

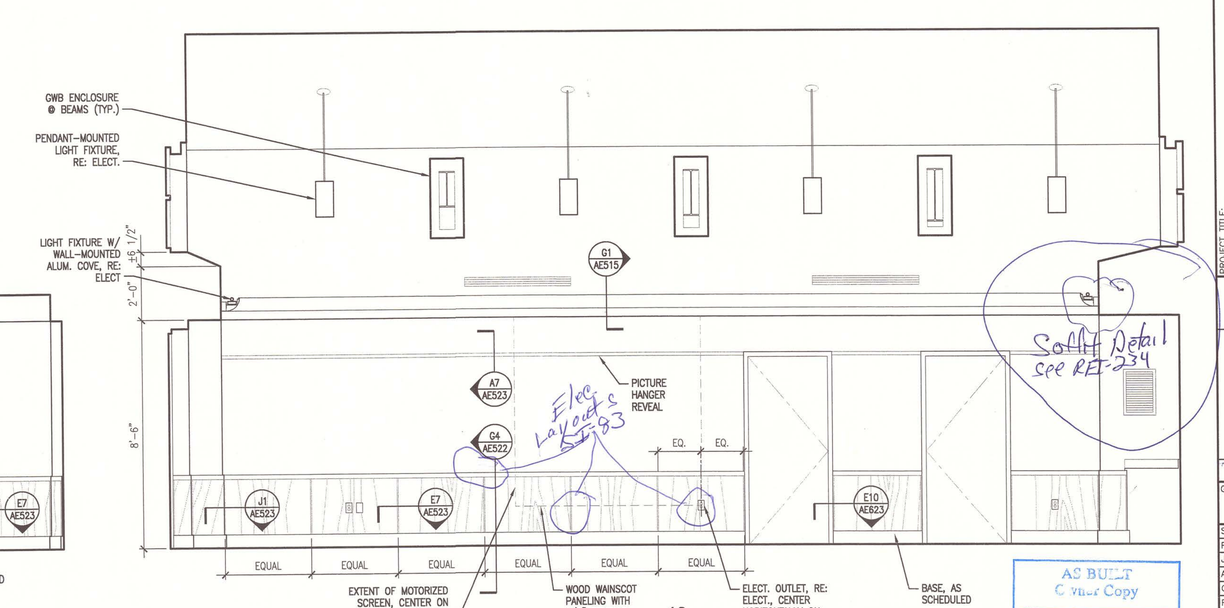

A1 INTERIOR ELEVATIONS – AUTHORITY ROOM 310

3/8" = 1'-0"

SMRT
ARCHITECTURE ENGINEERING PLANNING
SMRT
144 Fore Street/P.O. Box 618
Portland, Maine 04104
tel. (207) 772-3846
fax. (207) 772-1070

STATE OF MAINE SCOTT L BENSON No. 1772 REGISTERED PROFESSIONAL ARCHITECT

PROJECT TITLE:
MAINE TURNPIKE AUTHORITY ADMINISTRATION BUILDING
PORTLAND, MAINE

CURRENT ISSUE STATUS:
ISSUED FOR BIDDING/CONSTRUCTION 7-9-07

REV	DESCRIPTION	DATE
0	BIDDING/CONSTRUCTION	7-9-07


GRAPHIC SCALE: 0" 1"

SCALE:	AS NOTED
PROJECT MANAGER:	SLB
JC/DRAWN BY:	TCM/ DG
A/E OF RECORD:	SLB
CAD FILE:	AE217-06016
PROJECT NO:	06016
DATE:	7-9-07


SHEET TITLE: INTERIOR ELEVATIONS

SHEET No. AE217


© COPYRIGHT 2007 SMRT INC.

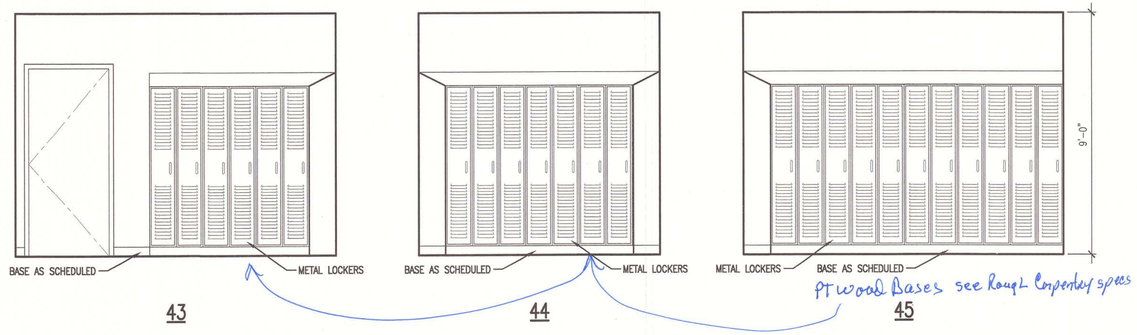


J1	INTERIOR ELEVATION – LOCKERS 139
3/8" = 1'-0"	.

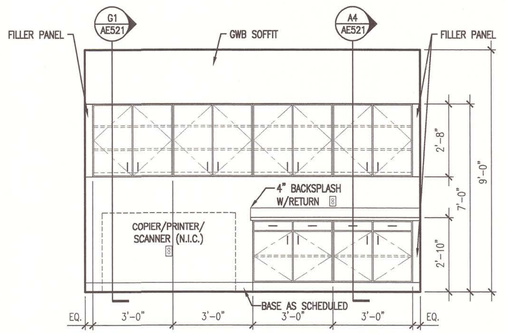


J9	INTERIOR ELEVATION – C.S. 219
3/8" = 1'-0"	.

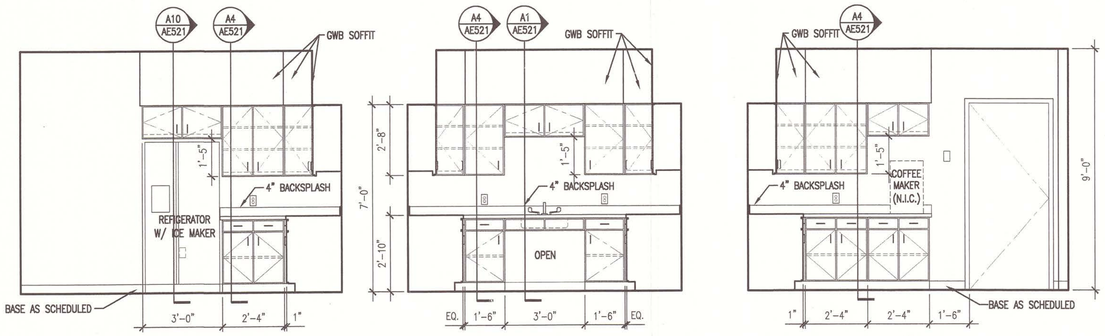


E1	INTERIOR ELEVATION – KITCHEN 314
3/8" = 1'-0"	.

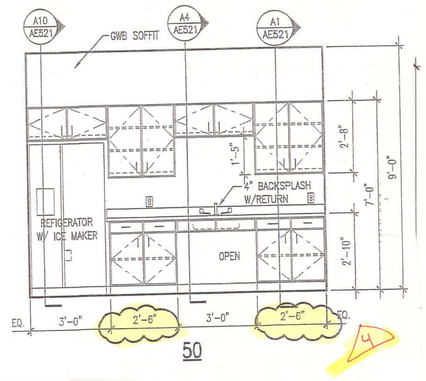

E9	INTERIOR ELEVATION – BREAK ROOM 138
3/8" = 1'-0"	.

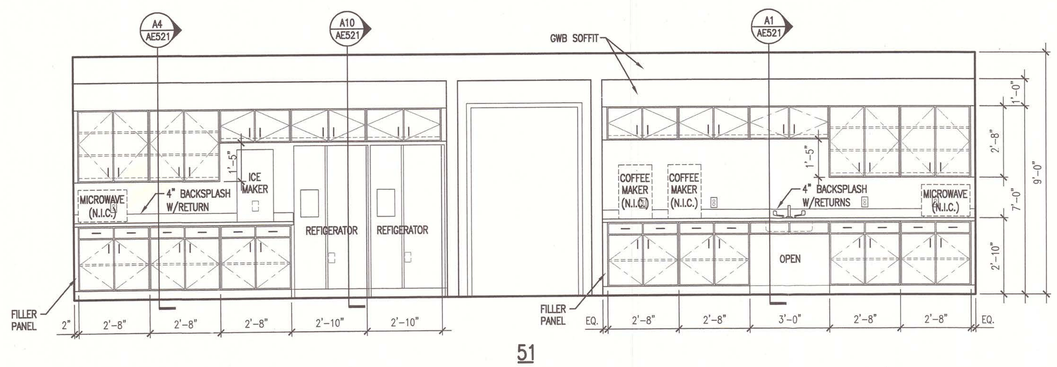

A1	INTERIOR ELEVATION – BREAK ROOM 154
3/8" = 1'-0"	.

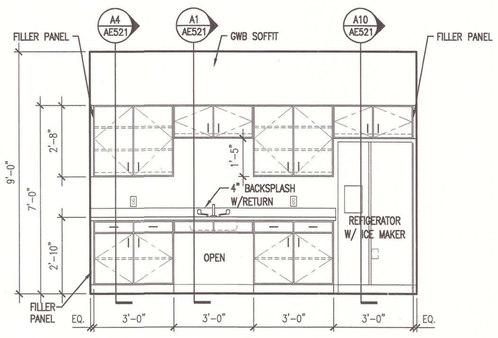

A9	INTERIOR ELEVATION – KITCHEN 235
3/8" = 1'-0"	.

GENERAL NOTES:

1. SEE GI001 FOR PROJECT GENERAL NOTES.

AS BUILT
Owner Copy

SMRT
ARCHITECTURE ENGINEERING PLANNING
SMRT
144 Fore Street P.O. Box 618
Portland, Maine 04104
tel. (207) 772-3846
fax. (207) 772-1070

STATE OF MAINE
SCOTT L BENSON
No. 1772
REGISTERED PROFESSIONAL ARCHITECT

PROJECT TITLE:
MAINE TURNPIKE AUTHORITY ADMINISTRATION BUILDING
PORTLAND, MAINE

CURRENT ISSUE STATUS:
ISSUED FOR BIDDING/CONSTRUCTION
7-9-07

REV	DESCRIPTION	DATE
0	BIDDING/CONSTRUCTION	7-9-07

GRAPHIC SCALE: 0" 1"


SCALE:	AS NOTED
PROJECT MANAGER:	SLB
JC/DRAWN BY:	TCM/TCM
A/E OF RECORD:	SLB
CAD FILE:	AE218-06016
PROJECT NO:	06016
DATE:	7-9-07

SHEET TITLE:
INTERIOR ELEVATIONS


SHEET No.
AE218

© COPYRIGHT 2007 SMRT INC.

Wood trim
AFI-390

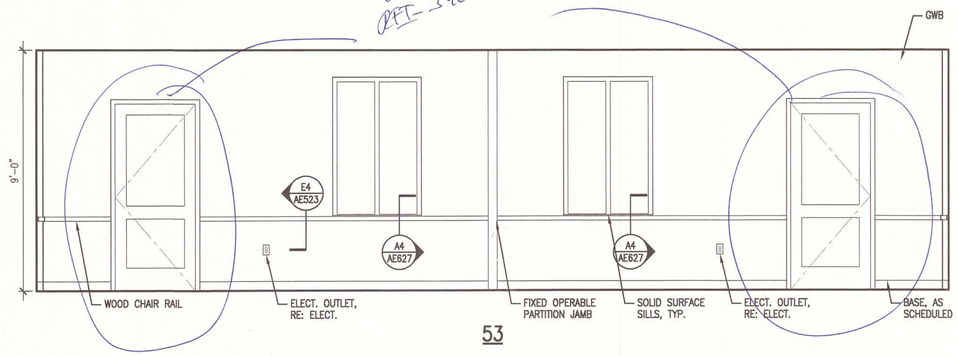


53

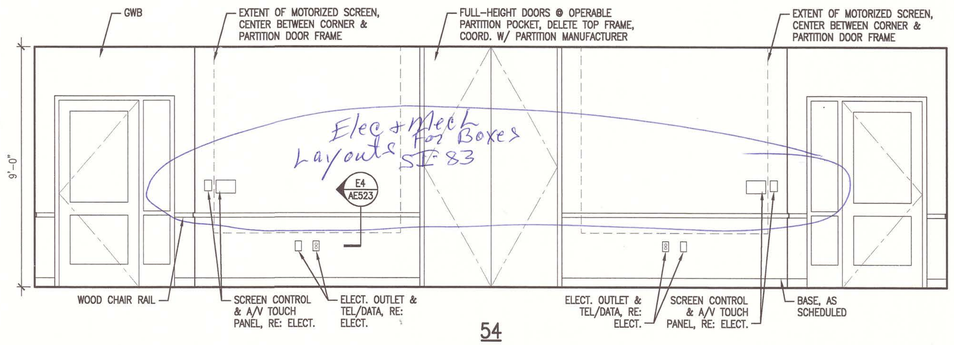


54


J1	INTERIOR ELEVATION – CONFERENCE 229 & 230
3/8" = 1'-0"	.

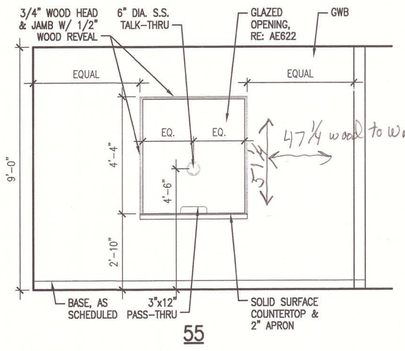

55

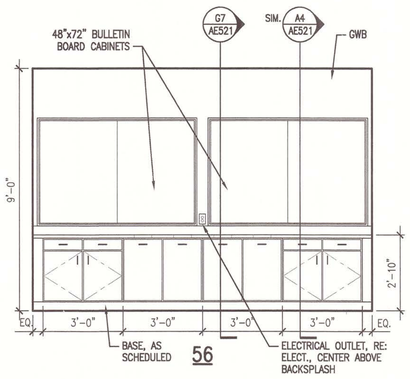

56

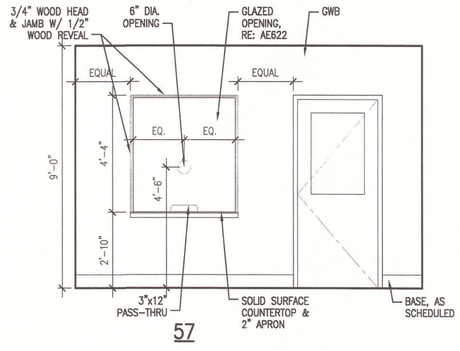

57

E1	INTERIOR ELEVATION – WAITING 129
3/8" = 1'-0"	.

E5	INTERIOR ELEVATION – VENDING 155
3/8" = 1'-0"	.

E9	INTERIOR ELEVATION – WAITING 330
3/8" = 1'-0"	.

GENERAL NOTES:

1. SEE GI001 FOR PROJECT GENERAL NOTES.

A1	–
*	.

AS BUILT
Owner Copy

SMRT
ARCHITECTURE ENGINEERING PLANNING
SMRT
144 Fore Street/P.O. Box 618
Portland, Maine 04104
tel. (207) 772-3846
fax. (207) 772-1070

STATE OF MAINE
SCOTT L BENSON
No. 1772
REGISTERED PROFESSIONAL ARCHITECT

PROJECT TITLE:
MAINE TURNPIKE AUTHORITY ADMINISTRATION BUILDING
PORTLAND, MAINE

CURRENT ISSUE STATUS:
ISSUED FOR BIDDING/CONSTRUCTION 7-9-07

REV	DESCRIPTION	DATE
0	BIDDING/CONSTRUCTION	7-9-07


GRAPHIC SCALE: 0" 1"

SCALE:	AS NOTED
PROJECT MANAGER:	SLB
JC/DRAWN BY:	TCM/ DG
A/E OF RECORD:	SLB
CAD FILE:	AE219-06016
PROJECT NO:	06016
DATE:	7-9-07

SHEET TITLE:
INTERIOR ELEVATIONS


SHEET No.
AE219

©COPYRIGHT 2007 SMRT INC.

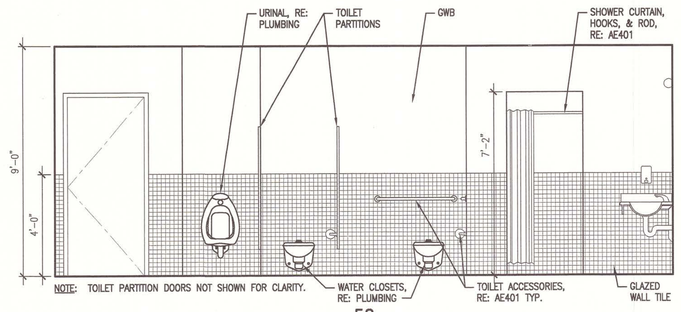


58

J1	INTERIOR ELEVATION MEN'S TOILET 102
3/8" = 1'-0"	.

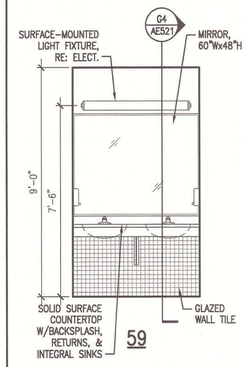


59

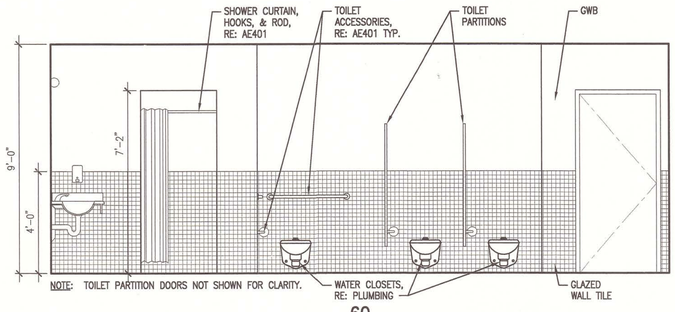


60

J6	INTERIOR ELEVATION WOMEN'S TOILET 103
3/8" = 1'-0"	.

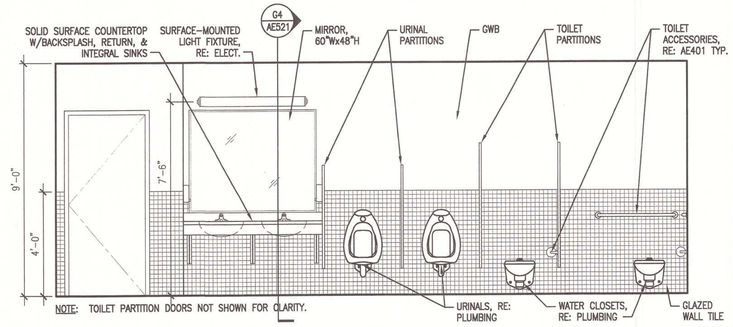


61

E1	INTERIOR ELEVATION MEN'S TOILET 202 & 302
3/8" = 1'-0"	.

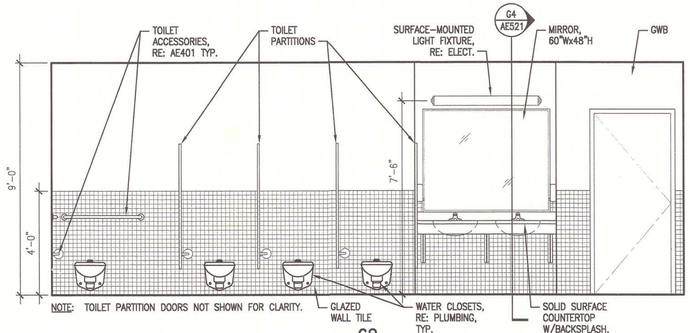

62

E6	INTERIOR ELEVATION WOMEN'S TOILET 203 & 303
3/8" = 1'-0"	.

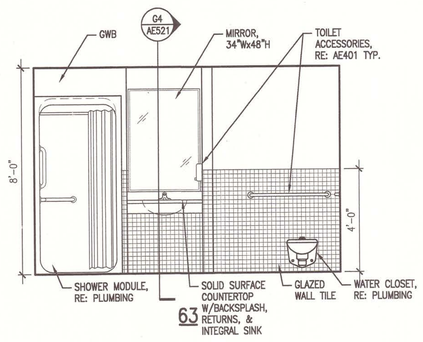

63

A1	INTERIOR ELEVATION WOMEN'S & MEN'S SHOWER 135 & 136
3/8" = 1'-0"	.

GENERAL NOTES:

1. REFER TO GI001 FOR PROJECT GENERAL NOTES.
2. REFER TO AE401 FOR ENLARGED TOILET ROOM PLANS & ACCESSORIES.
3. ALL WALLS IN ALL TOILET & SHOWER ROOMS TO RECEIVE 4'-0" H GLAZED TILE WAINSCOT, TYPICAL FOR BUILDING.

AS BUILT
Owner Copy

SMRT
ARCHITECTURE ENGINEERING PLANNING
SMRT
144 Fore Street/P.O. Box 618
Portland, Maine 04104
tel. (207) 772-3846
fax. (207) 772-1070

STATE OF MAINE
SCOTT L. BENSON
No. 11772
REGISTERED PROFESSIONAL ARCHITECT

PROJECT TITLE:
MAINE TURNPIKE AUTHORITY
ADMINISTRATION BUILDING
PORTLAND, MAINE

CURRENT ISSUE STATUS:
ISSUED FOR BIDDING/CONSTRUCTION
7-9-07

REV	DESCRIPTION	DATE
0	BIDDING/CONSTRUCTION	7-9-07


GRAPHIC SCALE: 0" 1"

SCALE:	AS NOTED
PROJECT MANAGER:	SLB
JC/DRAWN BY:	TCM/TCM
A/E OF RECORD:	SLB
CAD FILE:	AE220-06016
PROJECT NO:	06016
DATE:	7-9-07

SHEET TITLE:
INTERIOR ELEVATIONS


SHEET No.
AE220

© COPYRIGHT 2007 SMRT INC.

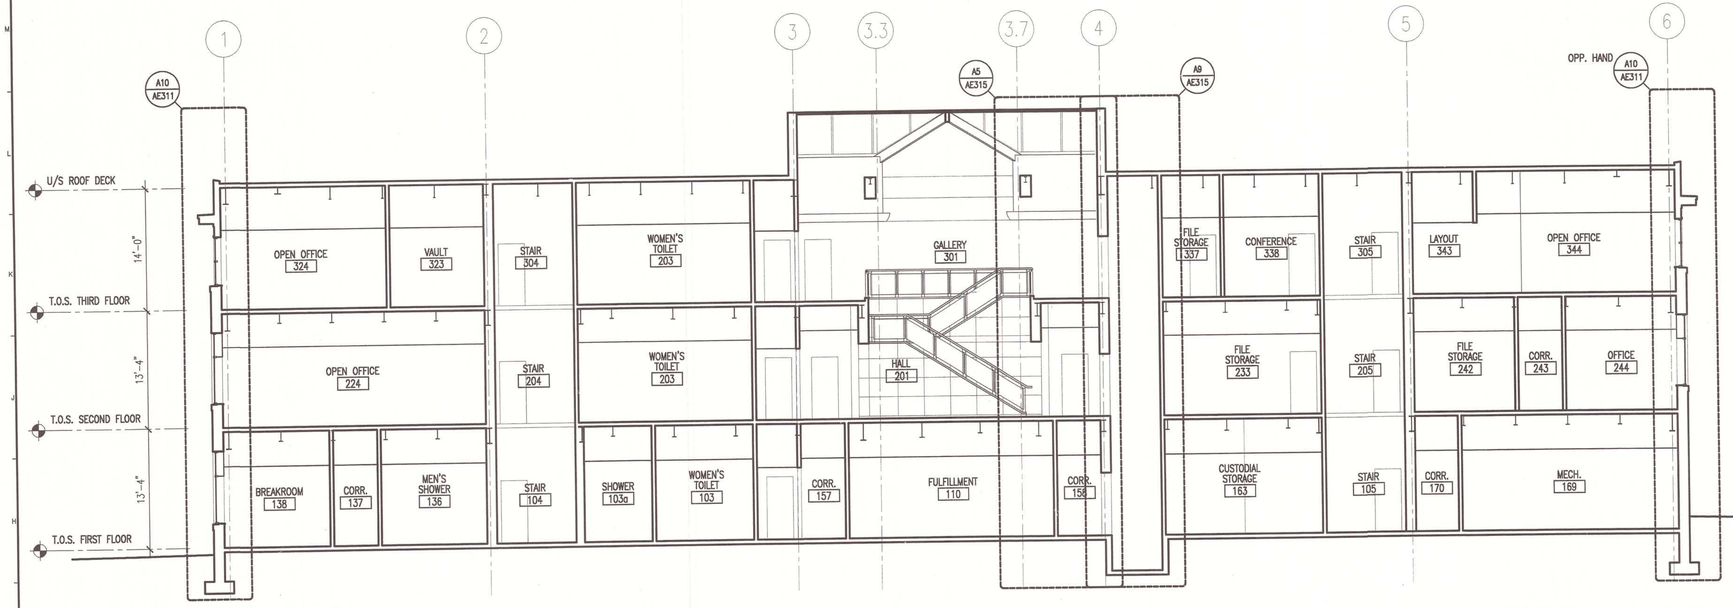

G1 BUILDING SECTION

1/8" = 1'-0"

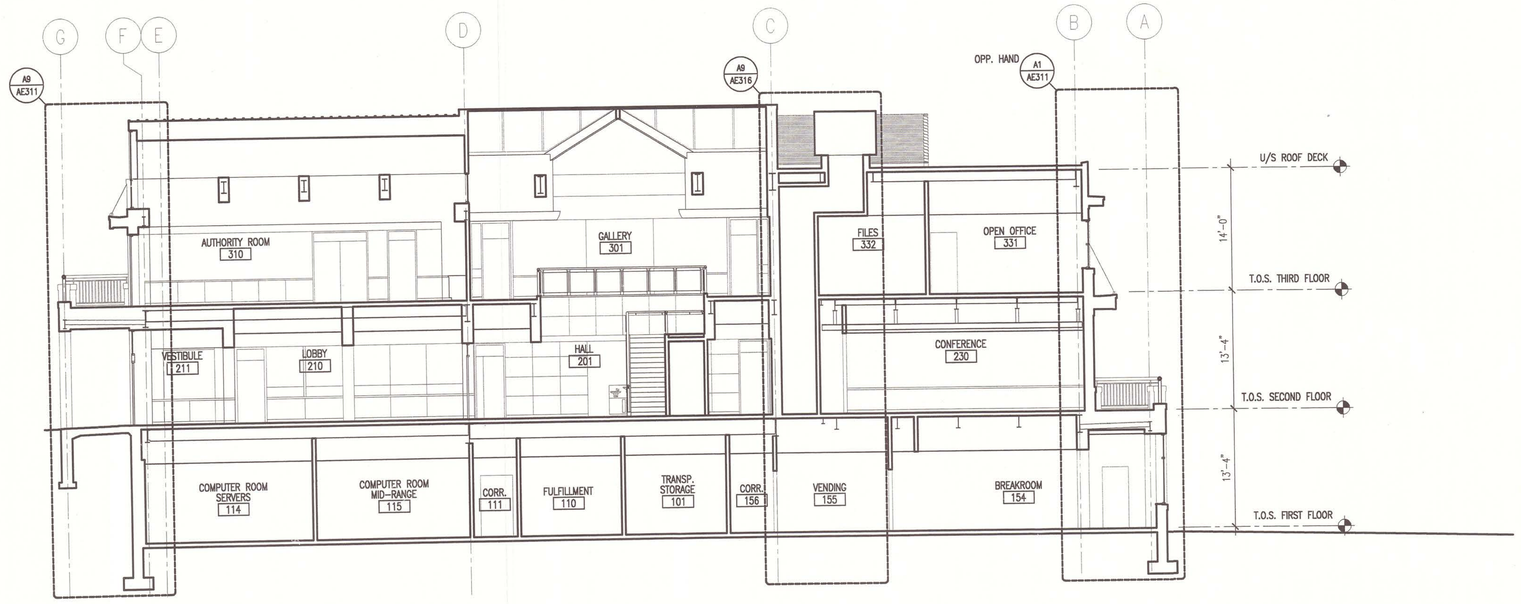

A1 BUILDING SECTION

1/8" = 1'-0"

GENERAL NOTES:

1. SEE G1001 FOR PROJECT GENERAL NOTES.

AS BUILT
Owner Copy

SMRT
ARCHITECTURE ENGINEERING PLANNING
SMRT
144 Fore Street / P.O. Box 618
Portland, Maine 04104
tel. (207) 772-3846
fax. (207) 772-1070

STATE OF MAINE SCOTT L BENSON No. 1772 REGISTERED PROFESSIONAL ARCHITECT

PROJECT TITLE:
MAINE TURNPIKE AUTHORITY
ADMINISTRATION BUILDING
PORTLAND, MAINE

CURRENT ISSUE STATUS:
ISSUED FOR BIDDING/CONSTRUCTION
7-9-07

REV	DESCRIPTION	DATE
0	BIDDING/CONSTRUCTION	7-9-07


GRAPHIC SCALE: 0" 1"

SCALE:	AS NOTED
PROJECT MANAGER:	SLB
JC/DRAWN BY:	TCM/ DG
A/E OF RECORD:	SLB
CAD FILE:	AE301-06016
PROJECT NO:	06016
DATE:	7-9-07


SHEET TITLE:
BUILDING SECTIONS

SHEET No. AE301


©COPYRIGHT 2007 SMRT INC.

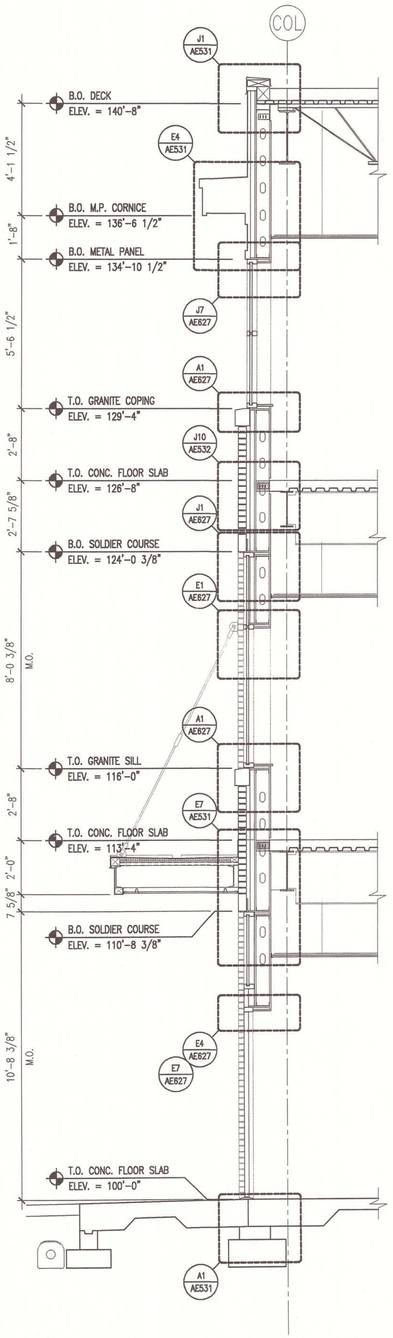


A1	WALL SECTION
3/8" = 1'-0"	–

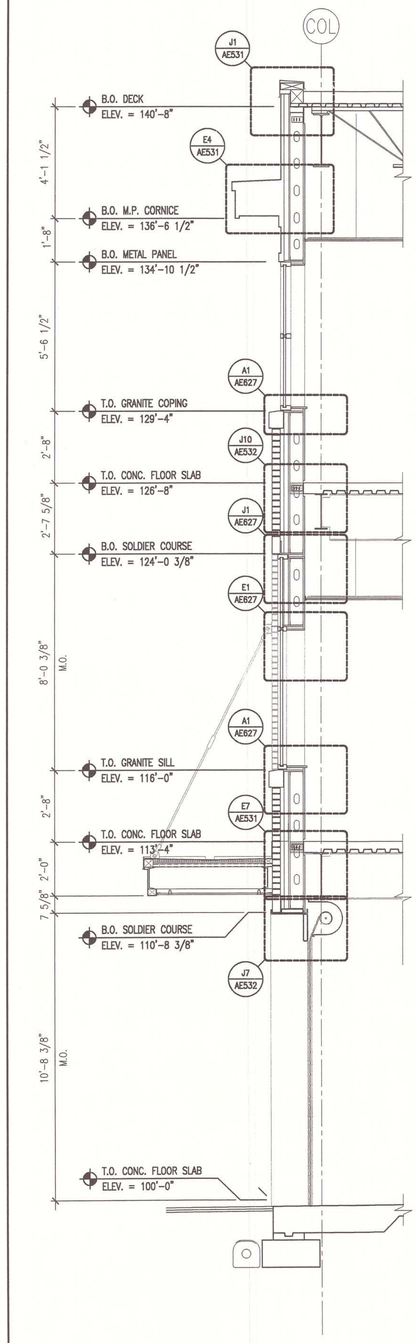

A4	WALL SECTION
3/8" = 1'-0"	–

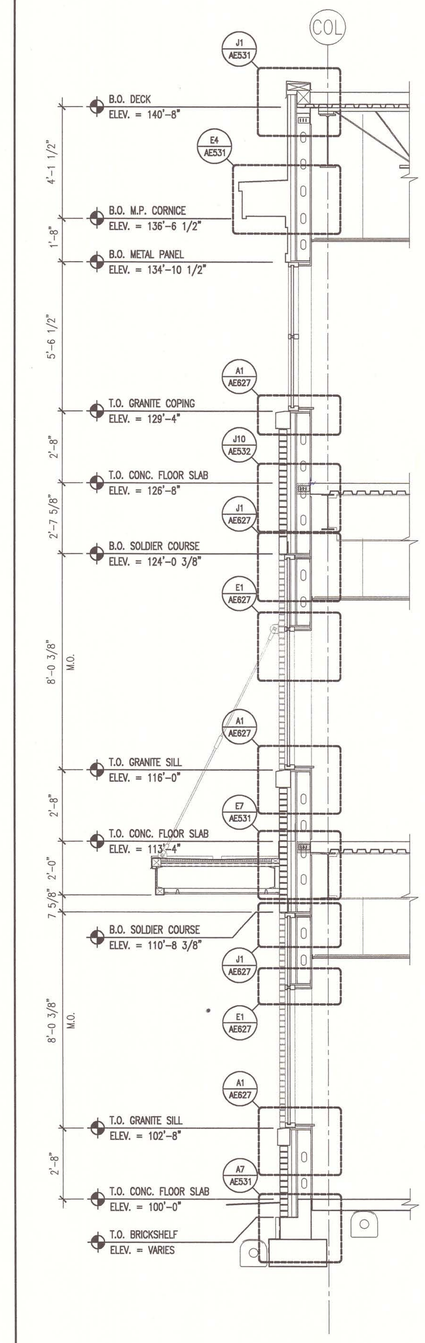

A7	WALL SECTION
3/8" = 1'-0"	–

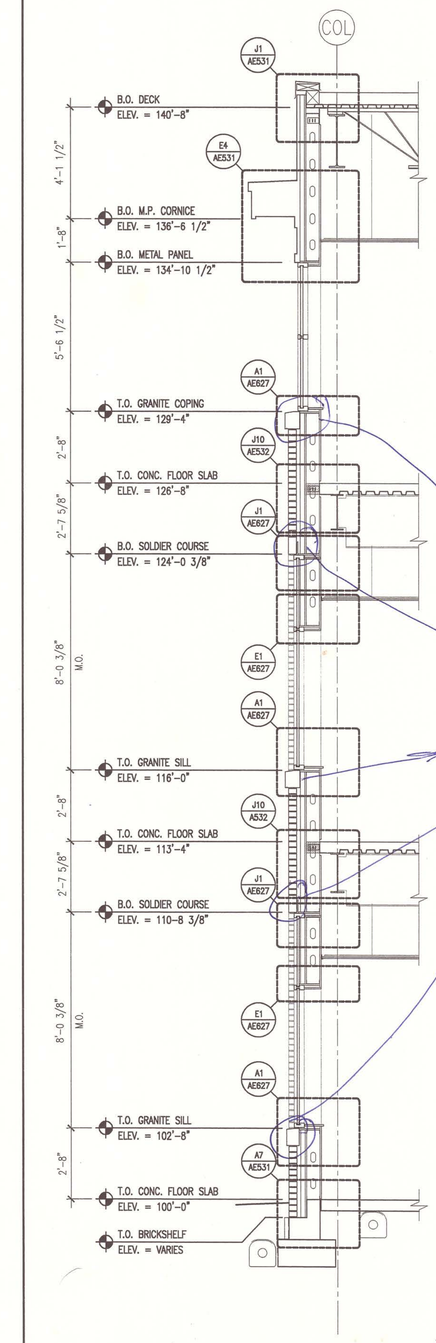

A10	WALL SECTION
3/8" = 1'-0"	

GENERAL NOTES:

1. SEE GI001 FOR PROJECT GENERAL NOTES.

Rigid Insulation Board Conflict REI 721

AS BUILT
Owner Copy

SMRT
ARCHITECTURE ENGINEERING PLANNING
SMRT
144 Fore Street/P.O. Box 618
Portland, Maine 04104
tel. (207) 772-3846
fax. (207) 772-1070

STATE OF MAINE
SCOTT L. BENSON
No. 1772
REGISTERED PROFESSIONAL ARCHITECT

PROJECT TITLE:
MAINE TURNPIKE AUTHORITY
ADMINISTRATION BUILDING
PORTLAND, MAINE

CURRENT ISSUE STATUS:
ISSUED FOR BIDDING/CONSTRUCTION
7-9-07

REV	DESCRIPTION	DATE
0	BIDDING/CONSTRUCTION	7-9-07


GRAPHIC SCALE: 0" 1"


SCALE:	AS NOTED
PROJECT MANAGER:	SLB
JC/DRAWN BY:	TCM/TCM
A/E OF RECORD:	SLB
CAD FILE:	AE311-06016
PROJECT NO:	06016
DATE:	7-9-07


SHEET TITLE:
WALL SECTIONS


SHEET No.
AE311

© COPYRIGHT 2007 SMRT INC

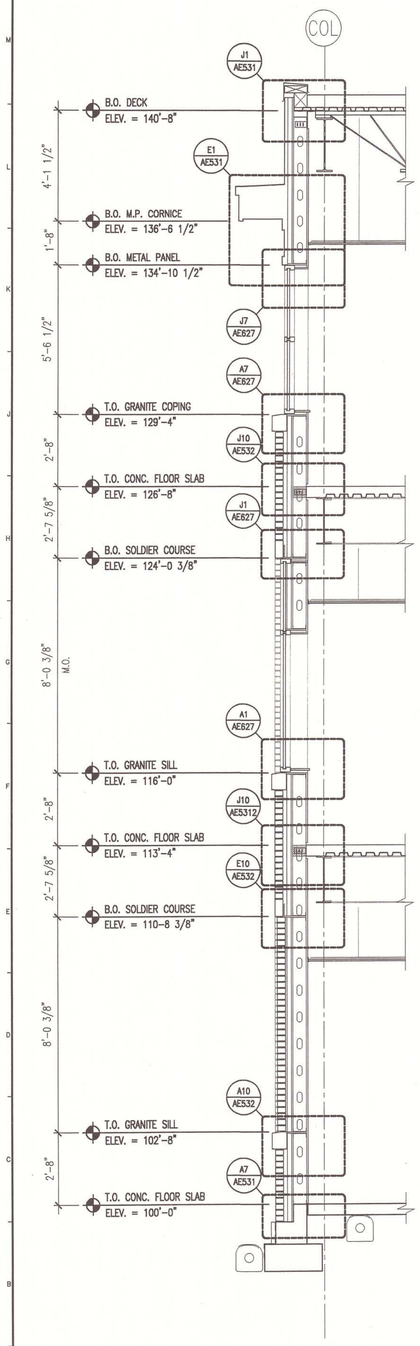

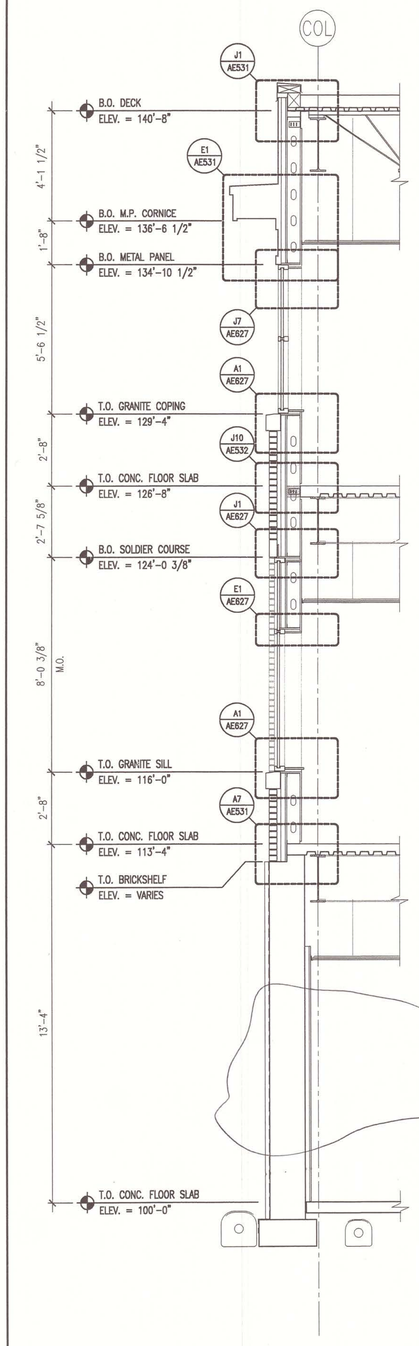

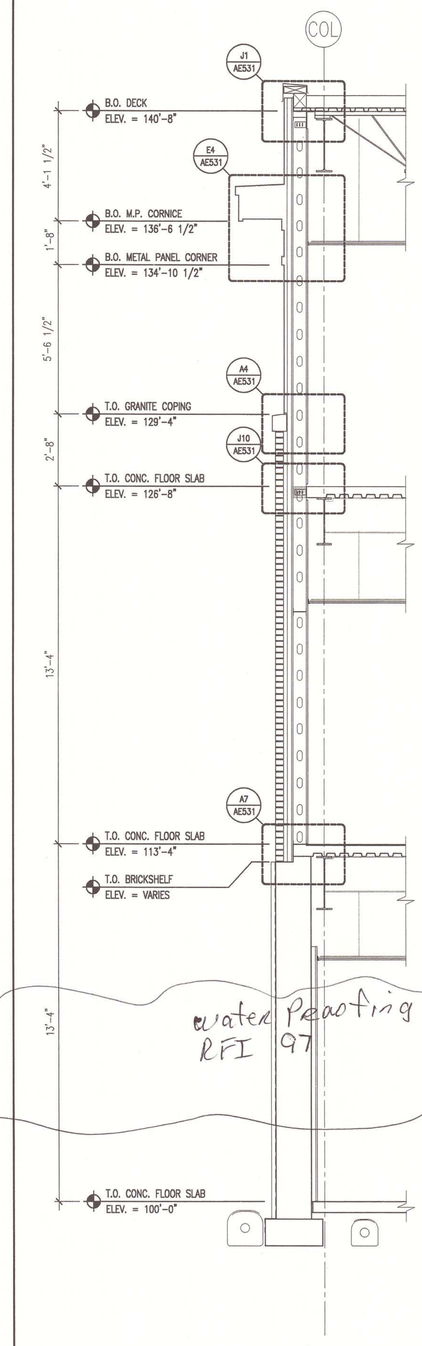

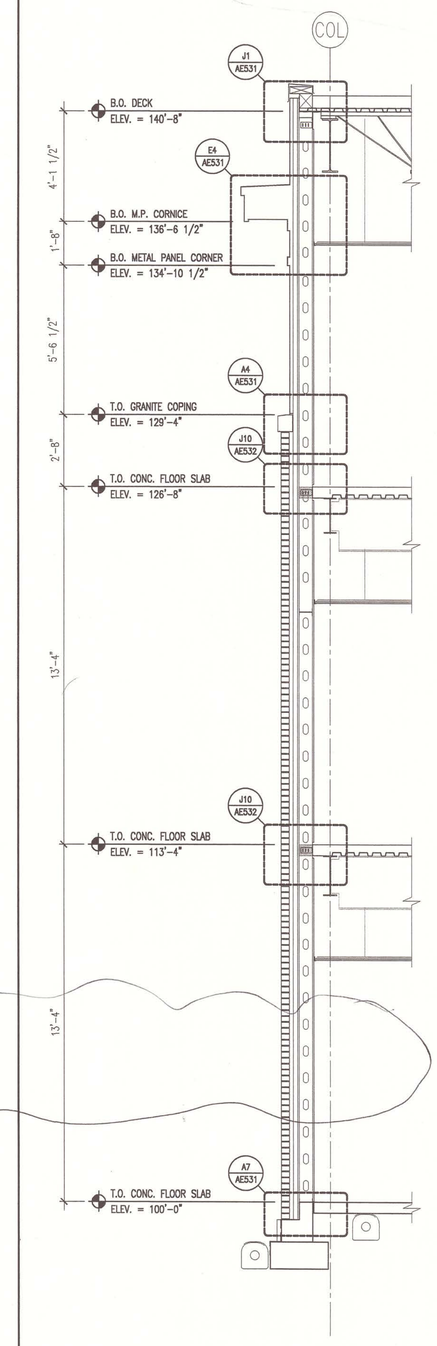

water Proofing
RFI 97

GENERAL NOTES:

1. SEE GI001 FOR PROJECT GENERAL NOTES.

A1	WALL SECTION	A4	WALL SECTION	A7	WALL SECTION	A10	WALL SECTION
3/8" = 1'-0"	–	3/8" = 1'-0"	–	3/8" = 1'-0"	–	3/8" = 1'-0"	

AS BUILT
Owner Copy

SMRT
ARCHITECTURE ENGINEERING PLANNING
SMRT
144 Fore Street/P.O. Box 618
Portland, Maine 04104
tel. (207) 772-3846
fax. (207) 772-1070

STATE OF MAINE
SCOTT L BENSON
No. 1772
REGISTERED PROFESSIONAL ARCHITECT

PROJECT TITLE:
MAINE TURNPIKE AUTHORITY
ADMINISTRATION BUILDING
PORTLAND, MAINE

CURRENT ISSUE STATUS:
ISSUED FOR BIDDING/CONSTRUCTION
7-9-07

REV	DESCRIPTION	DATE
0	BIDDING/CONSTRUCTION	7-9-07


GRAPHIC SCALE: 0" 1"

SCALE:	AS NOTED
PROJECT MANAGER:	SLB
JC/DRAWN BY:	TCM/TCM
A/E OF RECORD:	SLB
CAD FILE:	AE312-06016
PROJECT NO:	06016
DATE:	7-9-07


SHEET TITLE:
WALL SECTIONS

SHEET No.
AE312


©COPYRIGHT 2007 SMRT INC.

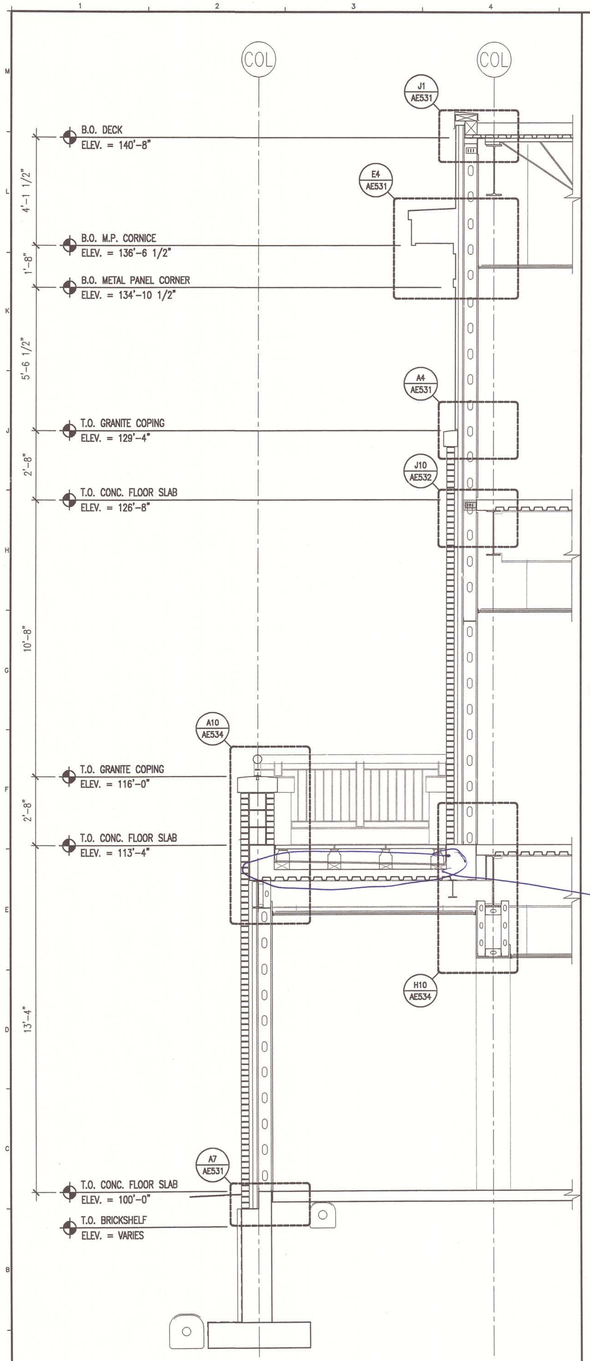

A1	WALL SECTION
3/8" = 1'-0"	–

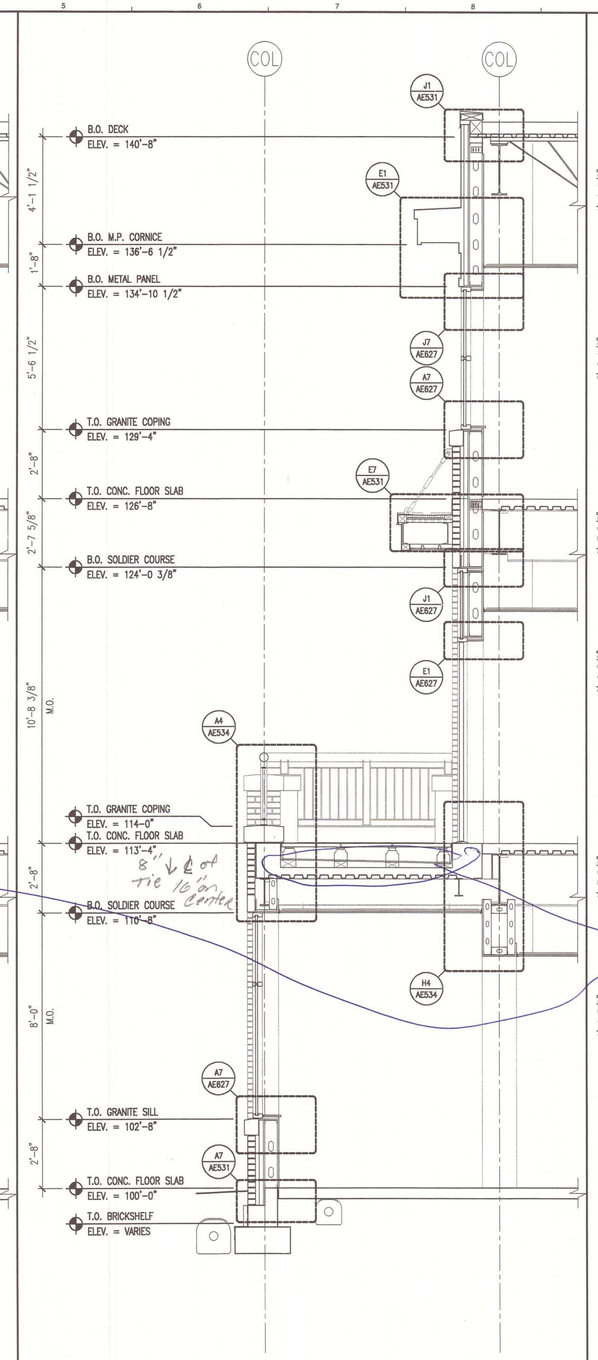

A5	WALL SECTION
3/8" = 1'-0"	–

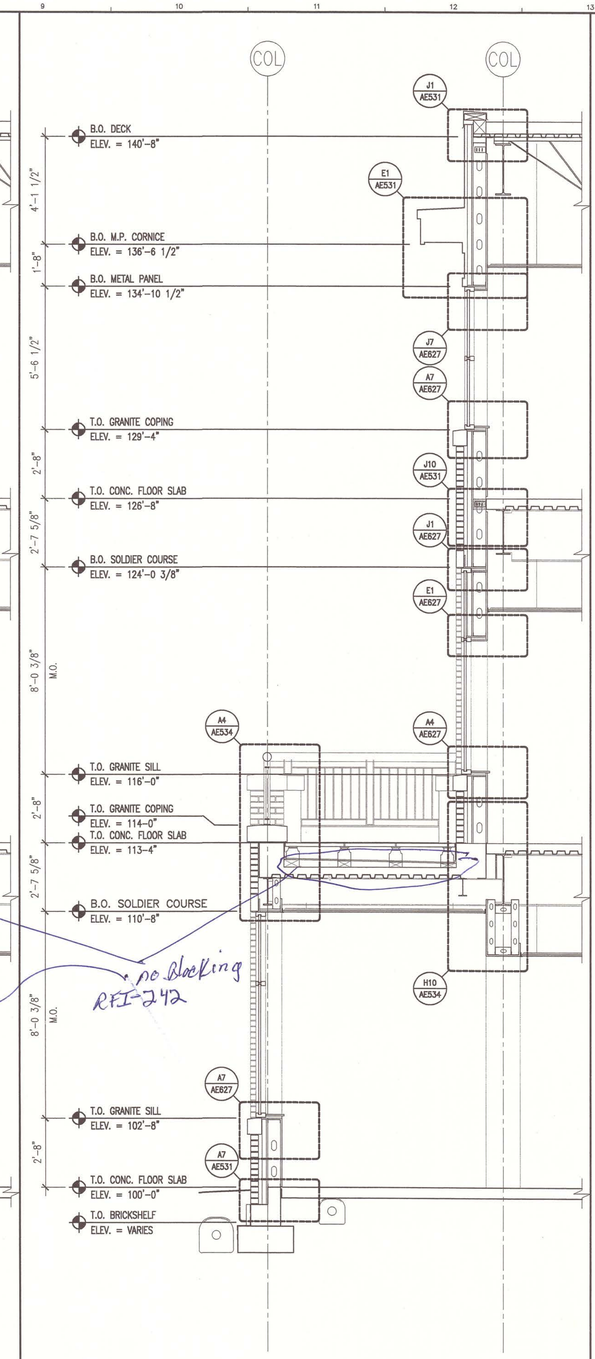

A9	WALL SECTION
3/8" = 1'-0"	

GENERAL NOTES:

1. SEE GI001 FOR PROJECT GENERAL NOTES.

AS BUILT
Owner Copy

SMRT
ARCHITECTURE ENGINEERING PLANNING
SMRT
144 Fore Street P.O. Box 618
Portland, Maine 04104
tel. (207) 772-3846
fax. (207) 772-1070

STATE OF MAINE
SCOTT
L.
BENSON
No. 1772
REGISTERED
PROFESSIONAL ARCHITECT

PROJECT TITLE:
MAINE TURNPIKE AUTHORITY
ADMINISTRATION BUILDING
PORTLAND, MAINE

CURRENT ISSUE STATUS:
ISSUED FOR BIDDING/CONSTRUCTION
7-9-07

REV.	DESCRIPTION	DATE
0	BIDDING/CONSTRUCTION	7-9-07


GRAPHIC SCALE: 0" 1"

SCALE:	AS NOTED
PROJECT MANAGER:	SLB
JC/DRAWN BY:	TCM/TCM
A/E OF RECORD:	SLB
CAD FILE:	AE313-06016
PROJECT NO:	06016
DATE:	7-9-07

SHEET TITLE:
WALL SECTIONS


SHEET No.
AE313

©COPYRIGHT 2007 SMRT INC.

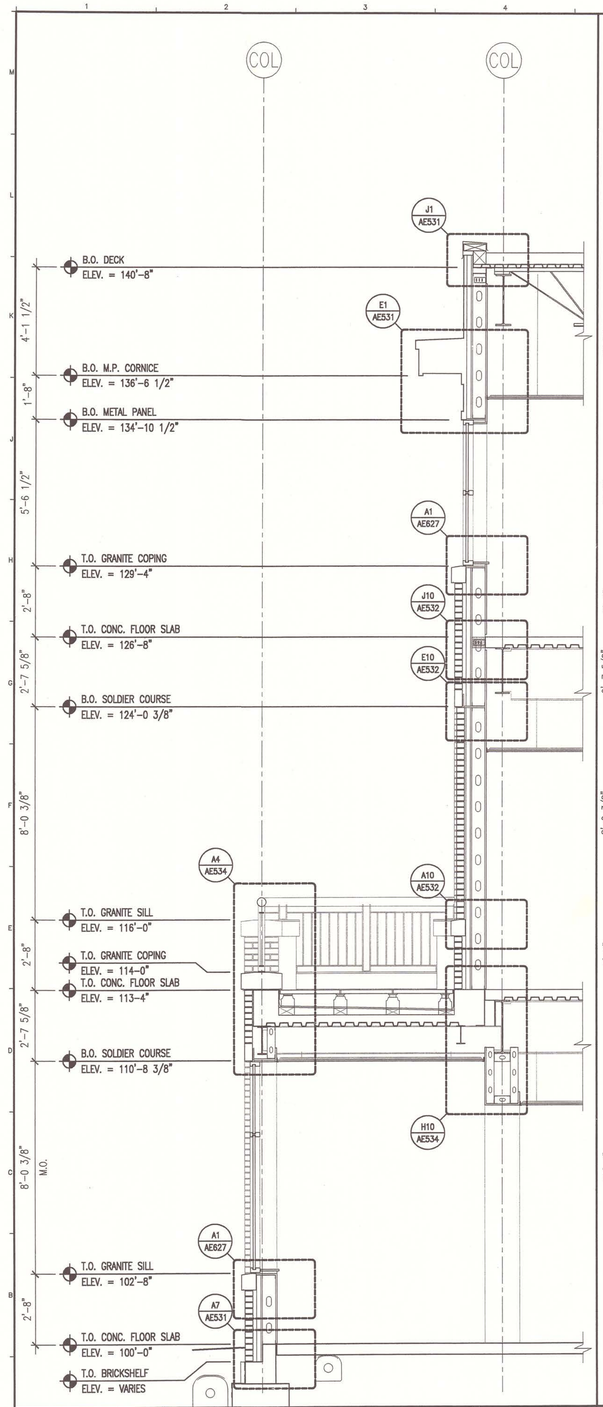


A1 WALL SECTION

3/8" = 1'-0"

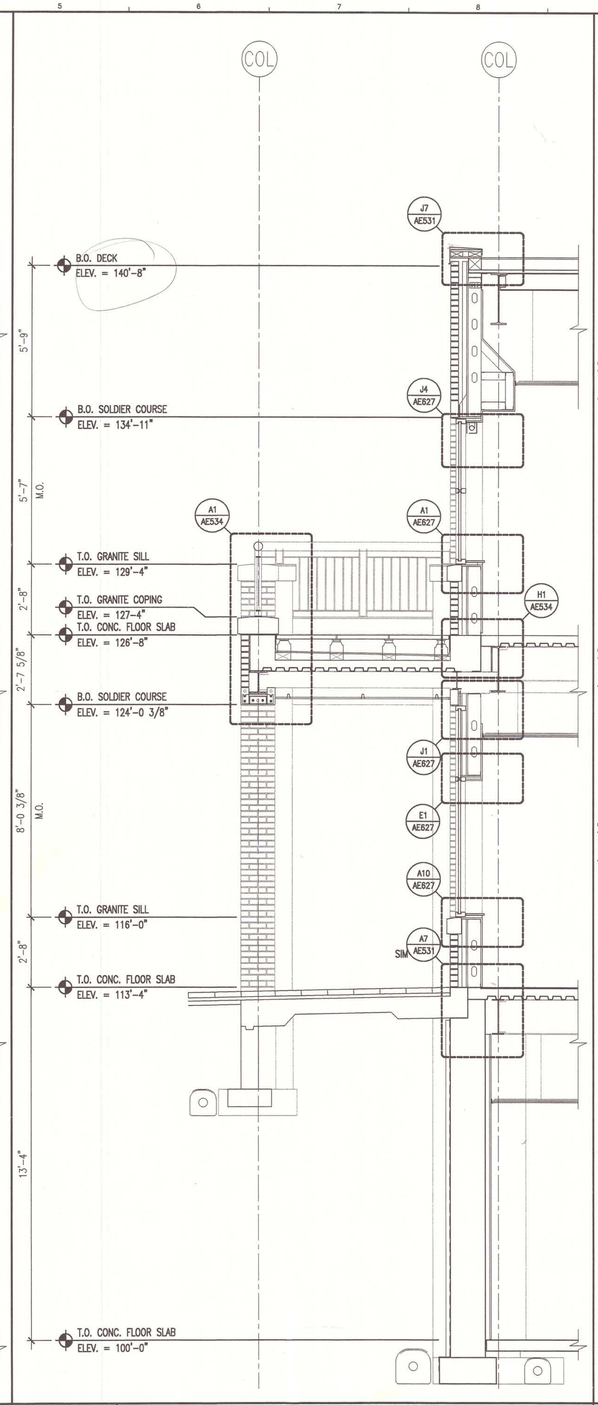

A5 WALL SECTION

3/8" = 1'-0"

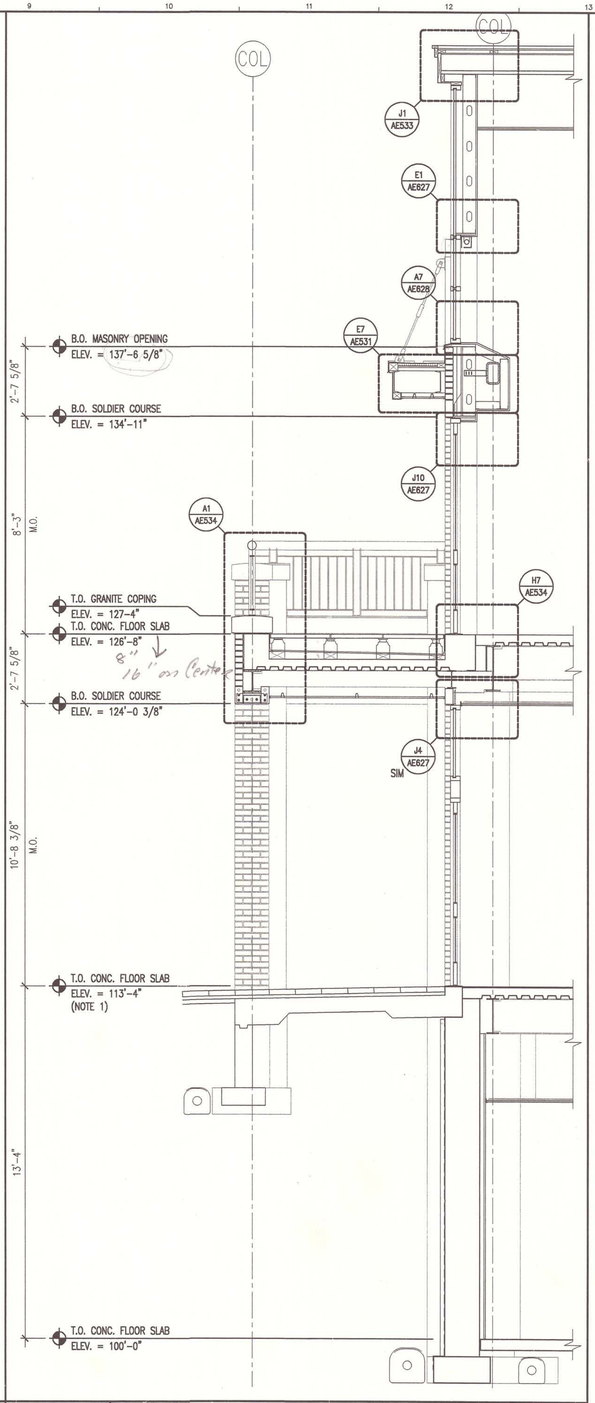

A9 WALL SECTION

3/8" = 1'-0"

GENERAL NOTES:

1. SEE GI001 FOR PROJECT GENERAL NOTES.

AS BUILT
Owner Copy

SMRT
ARCHITECTURE ENGINEERING PLANNING
SMRT
144 Fore Street/P.O. Box 618
Portland, Maine 04104
tel. (207) 772-3846
fax. (207) 772-1070

STATE OF MAINE
SCOTT L BENSON
No. 11772
REGISTERED PROFESSIONAL ARCHITECT

PROJECT TITLE:
MAINE TURNPIKE AUTHORITY
ADMINISTRATION BUILDING
PORTLAND, MAINE

CURRENT ISSUE STATUS:
ISSUED FOR BIDDING/CONSTRUCTION
7-9-07

REV	DESCRIPTION	DATE
0	BIDDING/CONSTRUCTION	7-9-07


GRAPHIC SCALE: 0" 1"

SCALE:	AS NOTED
PROJECT MANAGER:	SLB
JC/DRAWN BY:	TCM/TCM
A/E OF RECORD:	SLB
CAD FILE:	AE314-06016
PROJECT NO:	06016
DATE:	7-9-07


SHEET TITLE:
WALL SECTIONS

SHEET No. AE314


©COPYRIGHT 2007 SMRT INC.

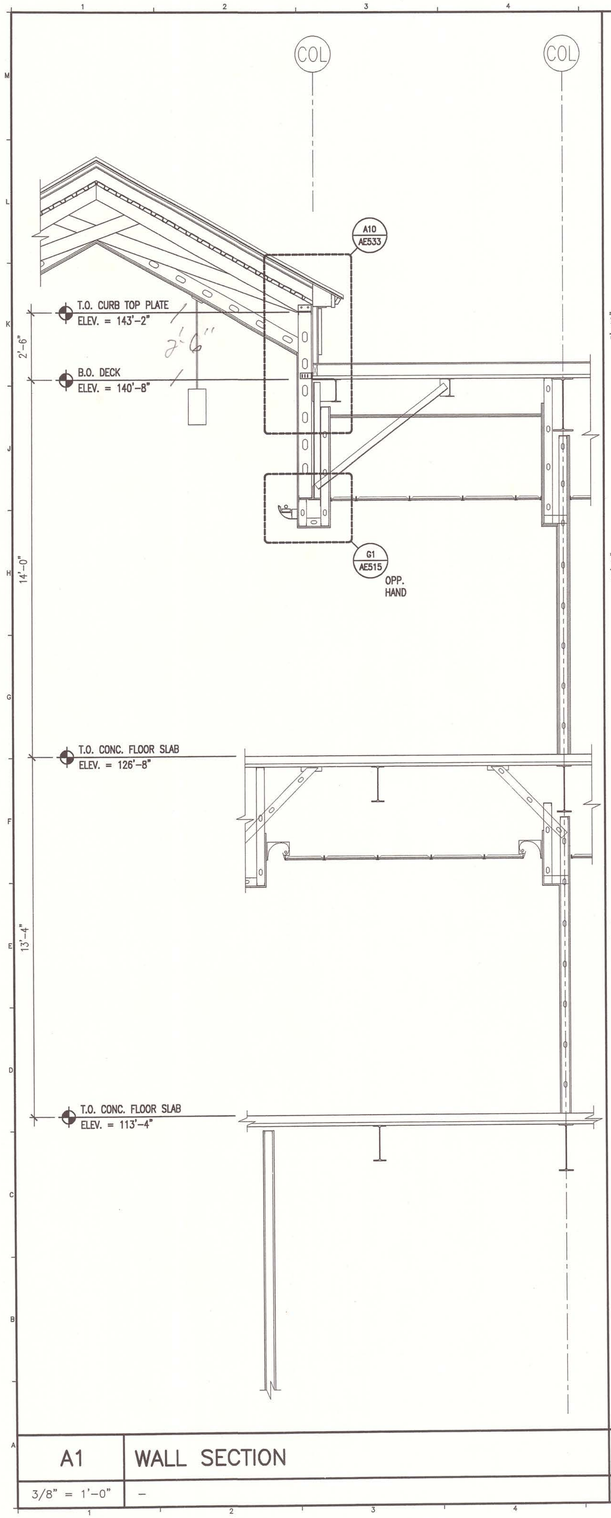

A1	WALL SECTION
3/8" = 1'-0"	–

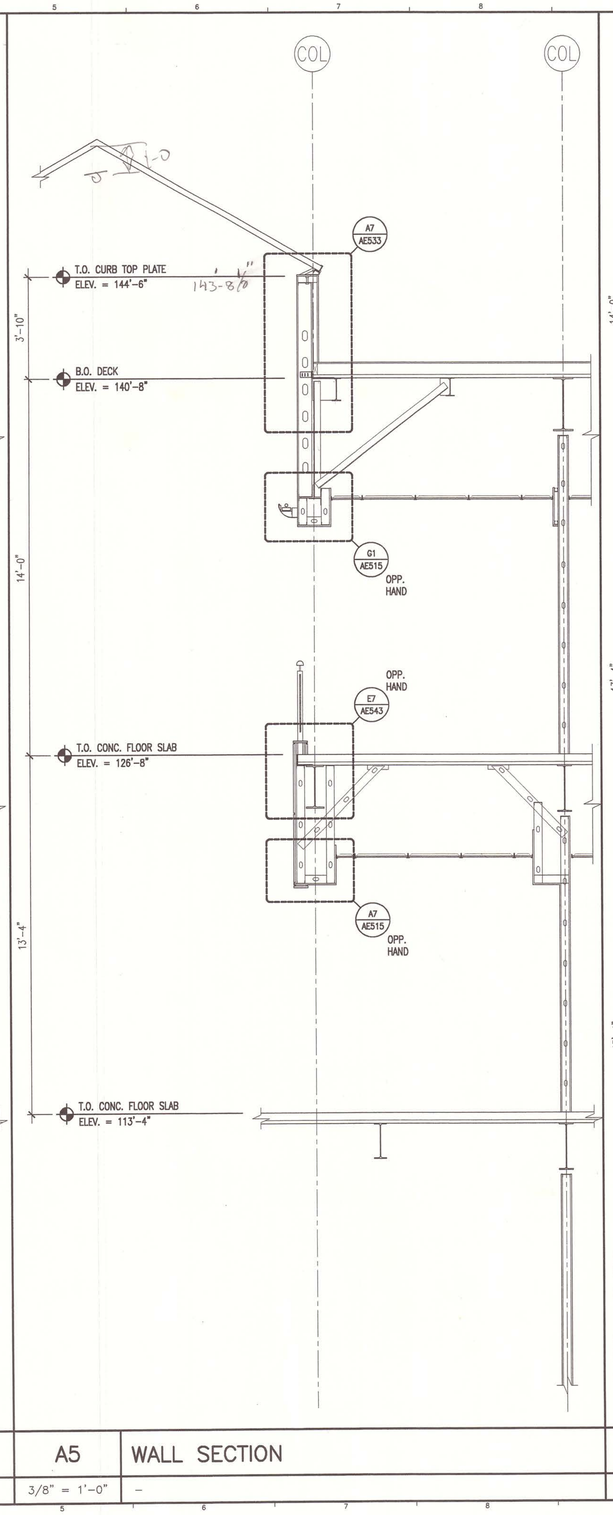

A5	WALL SECTION
3/8" = 1'-0"	–

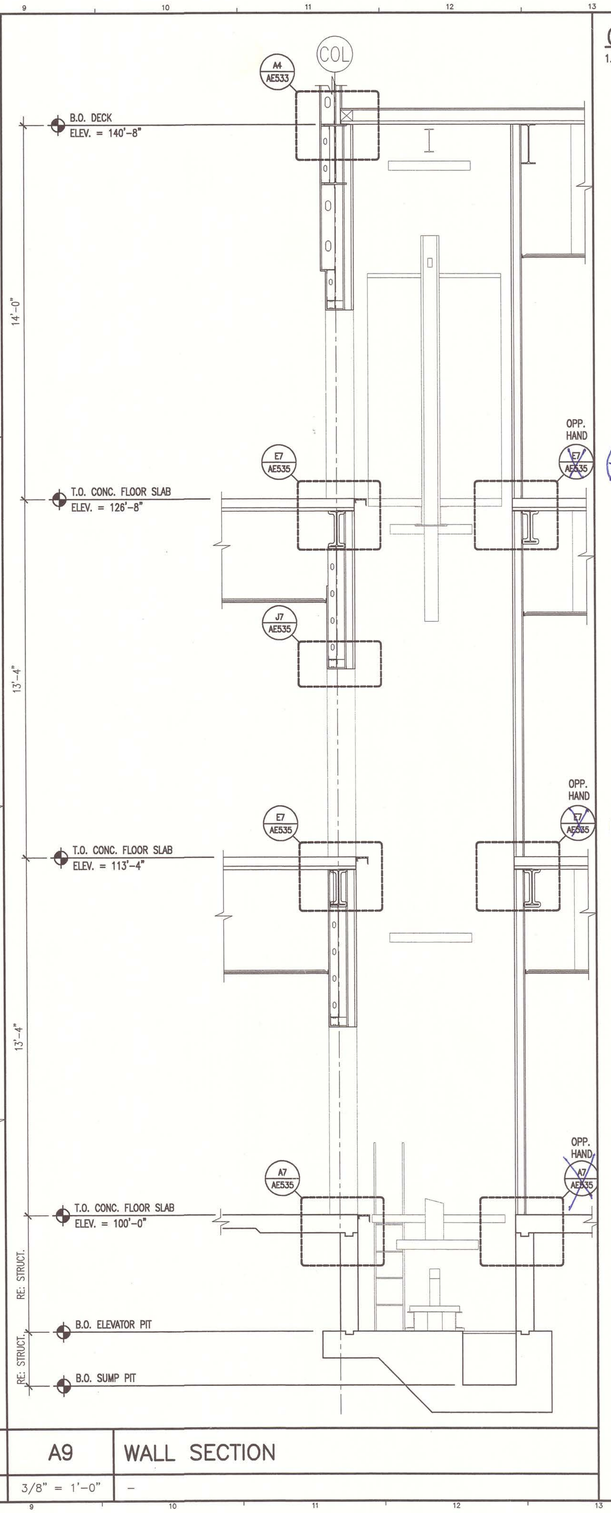

A9	WALL SECTION
3/8" = 1'-0"	–

GENERAL NOTES:

1. SEE GI001 FOR PROJECT GENERAL NOTES.

E-10 AE535 RFI-121

E-10 AE535 RFI-121

A-10 AE533 RFI-121

AS BUILT
Owner Copy

SMRT
ARCHITECTURE ENGINEERING PLANNING
SMRT
144 Fore Street / P.O. Box 618
Portland, Maine 04104
tel. (207) 772-3846
fax. (207) 772-1070

STATE OF MAINE
SCOTT
L
BENSON
No. 1772
REGISTERED
PROFESSIONAL ARCHITECT

PROJECT TITLE:
MAINE TURNPIKE AUTHORITY
ADMINISTRATION BUILDING
PORTLAND, MAINE

CURRENT ISSUE STATUS:
ISSUED FOR BIDDING/CONSTRUCTION
7-9-07

REV	DESCRIPTION	DATE
0	BIDDING/CONSTRUCTION	7-9-07


GRAPHIC SCALE: 0" 1"

SCALE:	AS NOTED
PROJECT MANAGER:	SLB
JC/DRAWN BY:	TCM/TCM
A/E OF RECORD:	SLB
CAD FILE:	AE315-06016
PROJECT NO:	06016
DATE:	7-9-07

SHEET TITLE:
WALL
SECTIONS

SHEET No.
AE315

© COPYRIGHT 2007 SMRT INC.

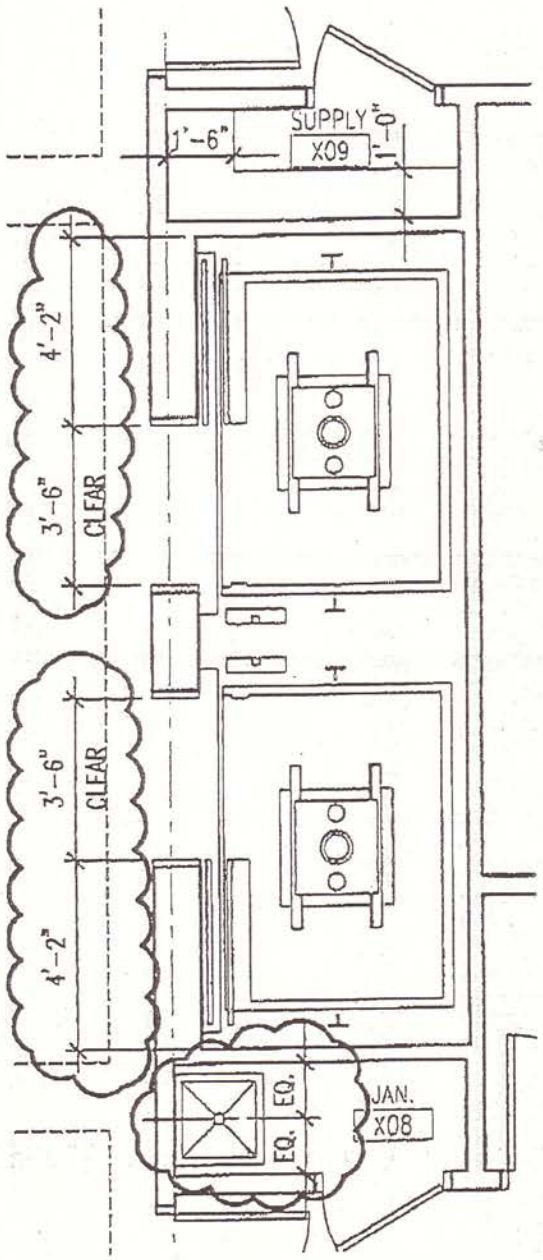

SMRT

ARCHITECTURE ENGINEERING PLANNING


SMRT
144 Fore Street/P.O.Box 618 PORTLAND, MAINE 04104
tel. (207) 772-3846 / fax. (207) 772-1070

SCALE:	1/4"=1'-0"
CAD FILE:	AE401-06016
PROJECT No.	06016
REF. SHEET:	AE401
PM: SLB	ADDENDUM No. ADD-6
A/E: SLB	SKETCH No. A-4
DATE: 8-23-07	

PROJECT: MAINE TURNPIKE AUTHORITY ADMINISTRATION BUILDING


SUBJECT: REVISED A13/AE401 ENLARGED PLAN @ ELEVATORS

© COPYRIGHT 2007 SMRT INC.

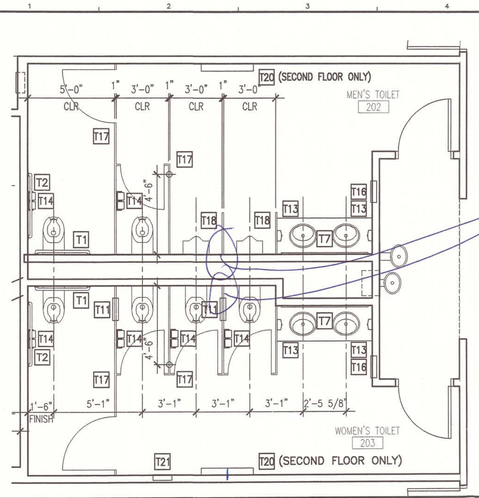

Toilet Partition Hinges RFI-402


Locker Bench RFI-403

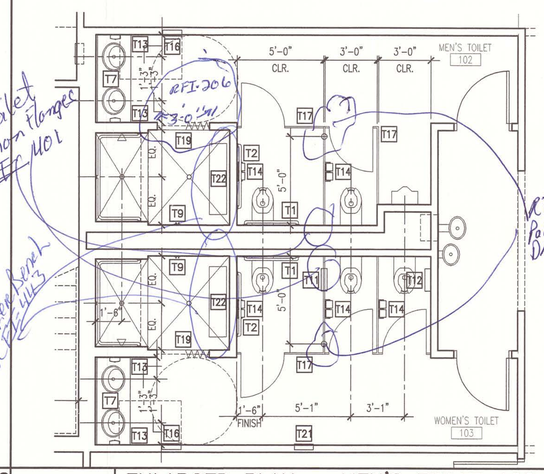


RFI-353 Partition at Drain Conflict

H1	ENLARGED PLAN – MEN'S TOILET 202/302 AND WOMEN'S TOILET 203/303
1/4" = 1'-0"	–

H5	ENLARGED PLAN – MEN'S TOILET 102 AND WOMEN'S TOILET 103
1/4" = 1'-0"	–

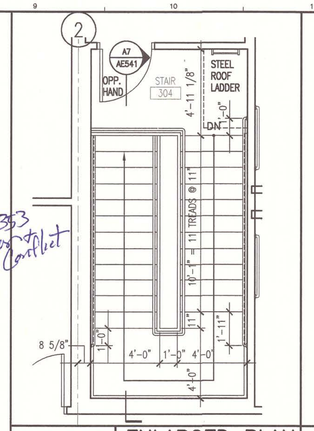

J9	ENLARGED PLAN STAIR 304
1/4" = 1'-0"	–

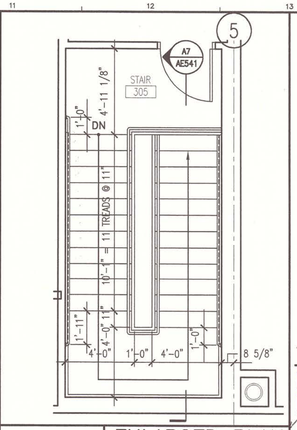

J11	ENLARGED PLAN STAIR 305
1/4" = 1'-0"	–


GENERAL NOTES:

1. REFER TO GI001 FOR PROJECT GENERAL NOTES.
2. REFER TO AE220 FOR INTERIOR ELEVATIONS OF MAJOR TOILET ROOMS.
3. PROVIDE BLOCKING AS REQUIRED TO ANCHOR TOILET ACCESSORIES.


AS BUILT Owner Copy

TOILET ACCESSORIES KEY NOTES:


- T1 36" GRAB BARS
- T2 42" GRAB BARS
- T3 SMALLER PAPER TOWEL DISPENSER/ WASTE RECEPTACLE O.S
- T4 36" GRAB BARS–DETENTION GRADE
- T5 42" GRAB BARS–DETENTION GRADE
- T6 PAPER TOWEL DISPENSER ?
- T7 MIRROR, 24"Wx48"H UNLESS OTHERWISE NOTED, RE: AE220
- T8 MIRROR–DETENTION GRADE, 24"Wx48"H
- T9 CLOTHES HOOKS, PAIR, MOUNTING HTS. 40" & 60" A.F.F.?
- T10 CLOTHES HOOKS–DETENTION GRADE, PAIR, MOUNTING HTS. 40" & 60" A.F.F.?
- T11 SANITARY NAPKIN DISPOSAL–PARTITION MOUNTED ?
- T12 SANITARY NAPKIN DISPOSAL–SURFACE MOUNTED ?
- T13 SOAP DISPENSER O.S
- T14 TOILET TISSUE DISPENSER O.I
- T15 TOILET TISSUE DISPENSER–DETENTION GRADE u/c Has on site
- T16 COMBINATION TOWEL DISPENSER/ WASTE RECEPTACLE–RECESSED O.S
- T17 TOILET PARTITIONS
- T18 URINAL PARTITIONS, 48"H
- T19 SHOWER CURTAIN, HOOKS & ROD ?
- T20 DIAPER CHANGING STATION ?
- T21 SANITARY NAPKIN VENDOR ?
- T22 LOCKER BENCH

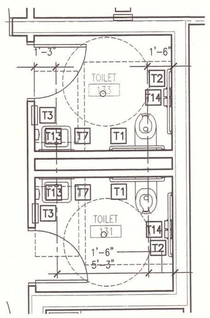

E1	ENLARGED PLAN TOILETS 133 & 131
1/4" = 1'-0"	–

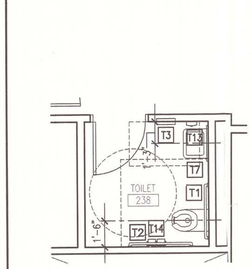


E3	ENLARGED PLAN TOILET 238
1/4" = 1'-0"	–

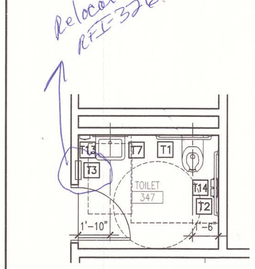


Relocate T23 RFI-326

E5	ENLARGED PLAN TOILET 347
1/4" = 1'-0"	–

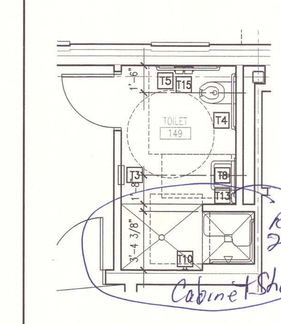


RFI 240 Cabinet + Shower


E7	ENLARGED PLAN TOILET 149
1/4" = 1'-0"	–

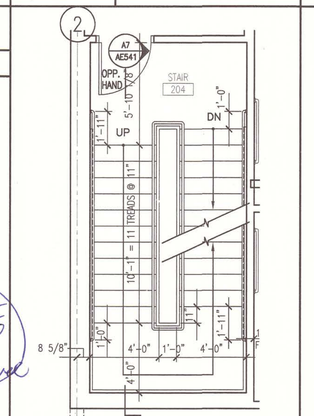

E9	ENLARGED PLAN STAIR 204
1/4" = 1'-0"	–

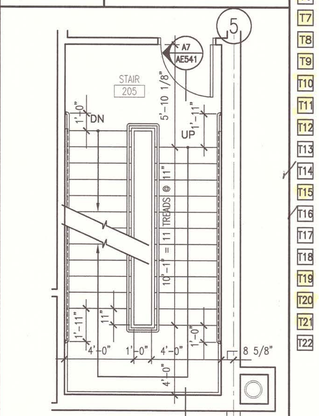


E11	ENLARGED PLAN STAIR 205
1/4" = 1'-0"	–

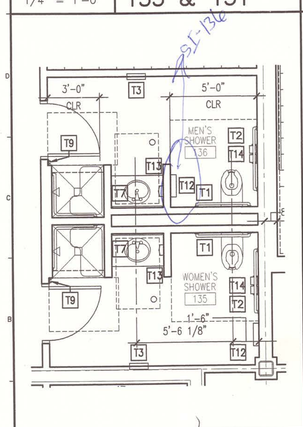

RFI-136

A1	ENLARGED PLAN SHOWERS 136 & 135
1/4" = 1'-0"	–

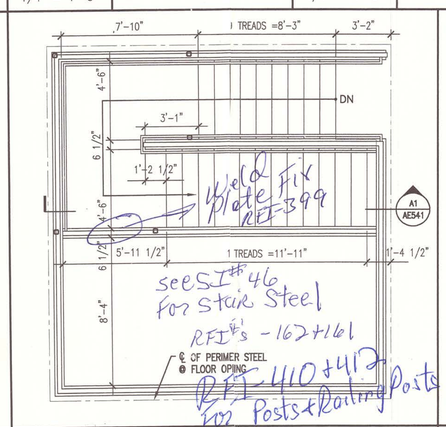


Weld Plate Fix RFI-399

See SI#46 For Stair Steel RFI's - 162+161

℄ OF PERIMER STEEL @ FLOOR OPING


RFI-410+412 For Posts + Railing Posts

A3	ENLARGED PLAN STAIRS @ GALLERY 301
1/4" = 1'-0"	–

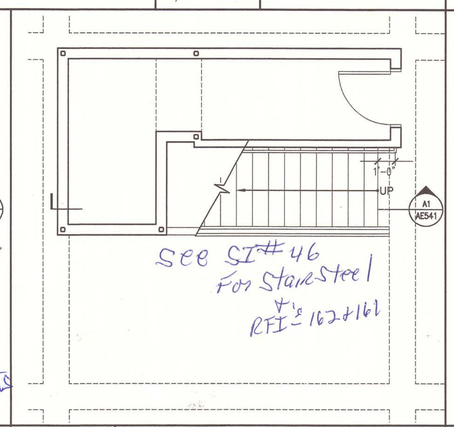

See SI#46 For Stair Steel RFI's - 162+161

A6	ENLARGED PLAN STAIRS @ HALL 201
1/4" = 1'-0"	–

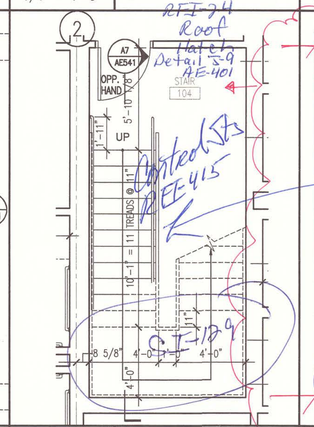


RFI-24 Roof Hatch Detail 3/A9 AE-401

Control Jt's RFE-415

SI-129


A9	ENLARGED PLAN STAIR 104
1/4" = 1'-0"	–

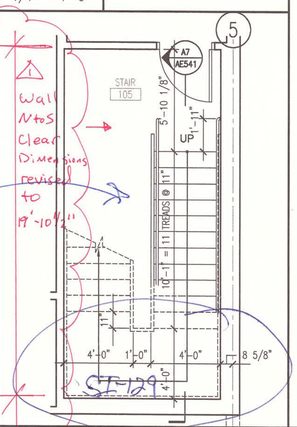

Wall N to S Clear Dimensioning revised to 19'-10 1/2"

SI-129

A11	ENLARGED PLAN STAIR 105
1/4" = 1'-0"	–

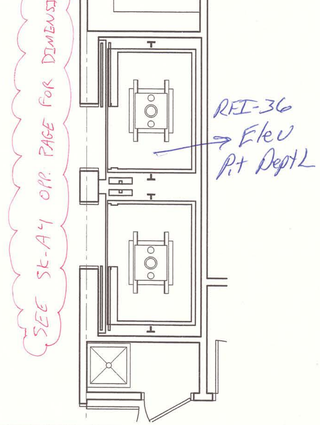

SEE SI-A1 FOR PAGE FOR DIMENSIONS

RFI-36 Elev Pit Depth

A13	ENLARGED PLAN @ ELEVATORS
1/4" = 1'-0"	–

SMRT
ARCHITECTURE ENGINEERING PLANNING
SMRT
144 Fore Street/P.O. Box 618
Portland, Maine 04104
tel. (207) 772-3846
fax. (207) 772-1070

STATE OF MAINE SCOTT L BENSON No. 1772 REGISTERED PROFESSIONAL ARCHITECT

PROJECT NORTH
MAG NORTH

PROJECT TITLE:
MAINE TURNPIKE AUTHORITY ADMINISTRATION BUILDING
PORTLAND, MAINE

CURRENT ISSUE STATUS:
ISSUED FOR BIDDING/CONSTRUCTION 7-9-07

REV	DESCRIPTION	DATE
0	BIDDING/CONSTRUCTION	7-9-07


GRAPHIC SCALE: 0" 1"

SCALE:	AS NOTED
PROJECT MANAGER:	SLB
JC/DRAWN BY:	TCM/TCM
A/E OF RECORD:	SLB
CAD FILE:	AE401-06016
PROJECT NO:	06016
DATE:	7-9-07

SHEET TITLE:
ENLARGED PARTIAL PLANS


SHEET No. AE401

©COPYRIGHT 2007 SMRT INC.

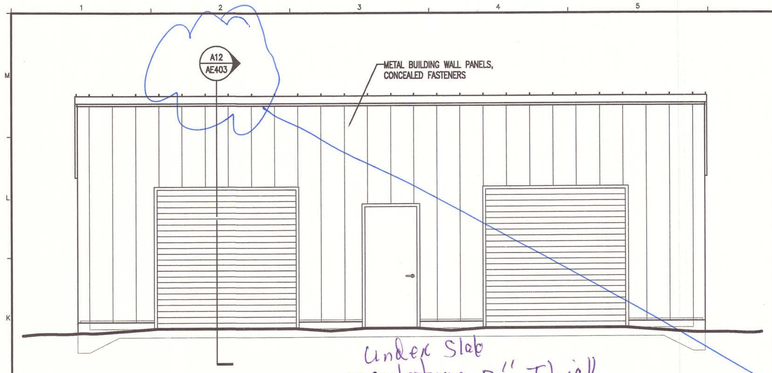


J1 FRONT ELEVATION

1/4" = 1'-0" –

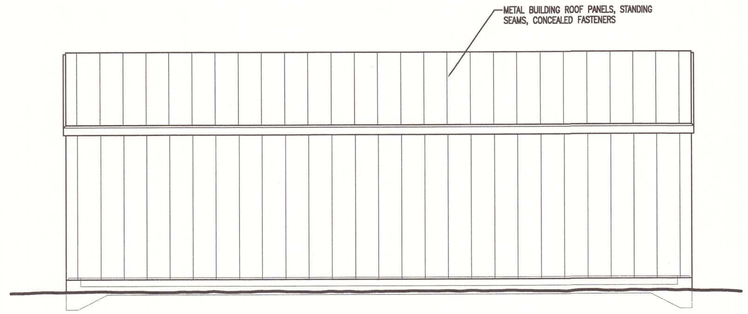


J6 REAR ELEVATION

1/4" = 1'-0" –

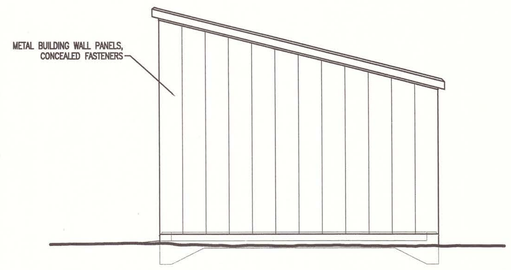


J12 SIDE ELEVATION

1/4" = 1'-0" –

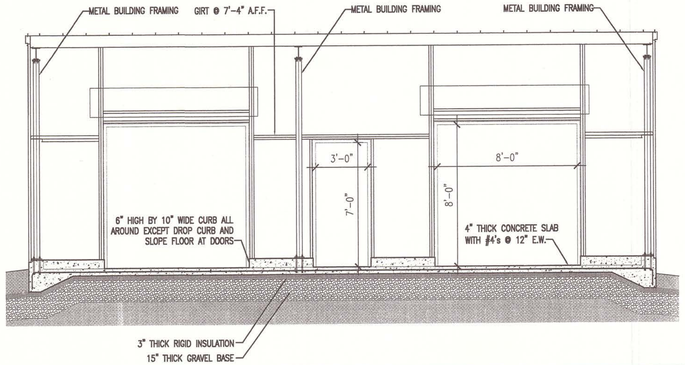


E1 FRONT WALL FRAMING ELEVATION

1/4" = 1'-0" –

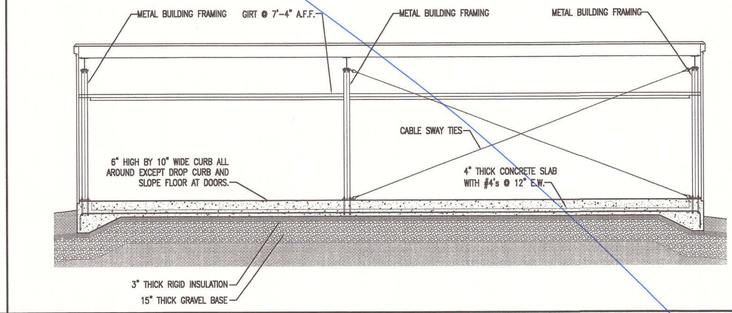


E6 REAR WALL FRAMING ELEVATION

1/4" = 1'-0" –

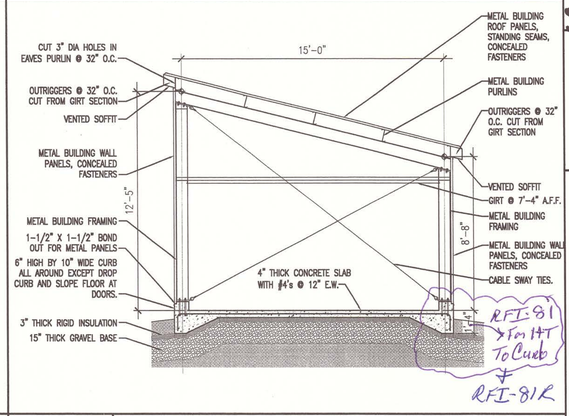


E12 SIDE WALL FRAMING ELEVATION

1/4" = 1'-0" –

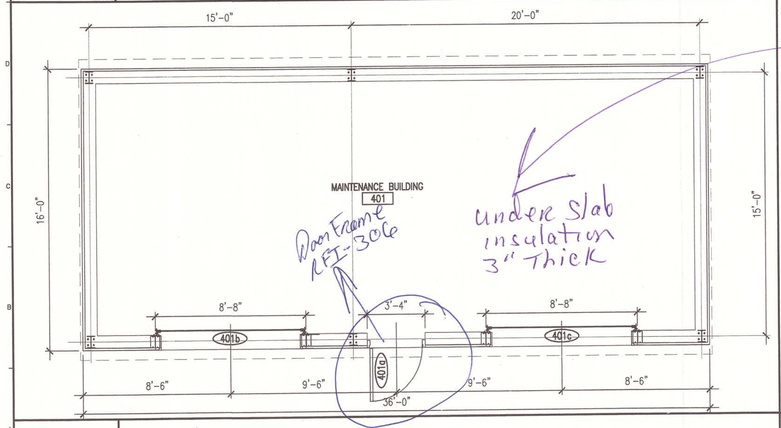


A1 FLOOR PLAN

1/4" = 1'-0" –

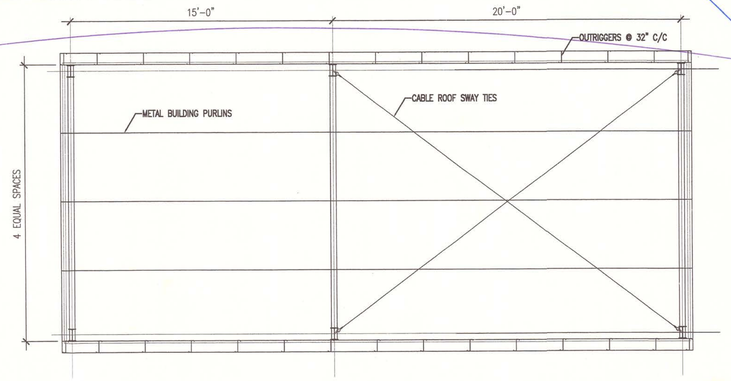

A6 ROOF FRAMING PLAN

1/4" = 1'-0" –

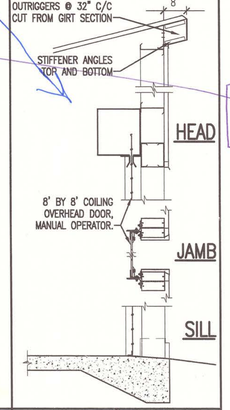

A12 SECTION

1/2" = 1'-0" –

GENERAL NOTES:

1. SEE G1001 FOR PROJECT GENERAL NOTES.
2. FOUNDATION: CLEAN GRAVEL COMPACTED TO 95% MIN DENSITY, EXTEND BEYOND FLOOR SLAB 36".
3. UNDER SLAB INSULATION: 3" THICK EXTRUDED POLY-STYRENE INSULATION, EXTEND 36" BEYOND FLOOR SLAB.
4. FLOOR SLAB: 3000 PSI 28 DAY COMPRESSIVE STRENGTH CONCRETE, 0.45 WATER CEMENT RATIO, STEEL TROWEL FINISH, CURE WITH CURING COMPOUND.
5. STRUCTURAL STEEL: PRE-ENGINEERED METAL BUILDING PACKAGE INCLUDING STRUCTURAL MEMBERS, COLD ROLLED GIRTS AND PURLINS, CABLE TIES, ANCHOR BOLTS, THREE COAT FLUROPOLYMER FINISH ON METAL WALL PANELS, GALVALUME FINISH ON ROOF PANELS, CONCEALED FASTENERS, WALL AND ROOF TRIM AND ALL ACCESSORIES NECESSARY FOR A COMPLETE BUILDING ENCLOSURE. COLOR OF PANELS TO BE SELECTED FROM MANUFACTURER'S STANDARD COLORS. REFER TO SPECIFICATIONS FOR ADDITIONAL INFORMATION.

"3-coat pluropolymer finish"

AS BUILT Owner Copy

SMRT
ARCHITECTURE ENGINEERING PLANNING
SMRT
144 Fore Street / P.O. Box 618
Portland, Maine 04104
tel. (207) 772-3846
fax. (207) 772-1070

STATE OF MAINE
SCOTT L. BENSON
No. 1772
REGISTERED PROFESSIONAL ARCHITECT

PROJECT NORTH
MAG NORTH

PROJECT TITLE: MAINE TURNPIKE AUTHORITY ADMINISTRATION BUILDING PORTLAND, MAINE

CURRENT ISSUE STATUS: ISSUED FOR BIDDING/CONSTRUCTION 7-9-07

NO	DESCRIPTION	DATE
0	BIDDING/CONSTRUCTION	7-9-07

GRAPHIC SCALE: 0" 1"

SCALE:	AS NOTED
PROJECT MANAGER:	SLB
JC/DRAWN BY:	TCM/TCM
A/E OF RECORD:	SLB
CAD FILE:	AE402-06016
PROJECT NO:	06016
DATE:	7-9-07


SHEET TITLE: MAINTENANCE BUILDING PLANS & ELEVATIONS

SHEET No. AE402


© COPYRIGHT 2007 SMRT INC.

GENERAL NOTES:


1. SEE GI001 FOR PROJECT GENERAL NOTES.

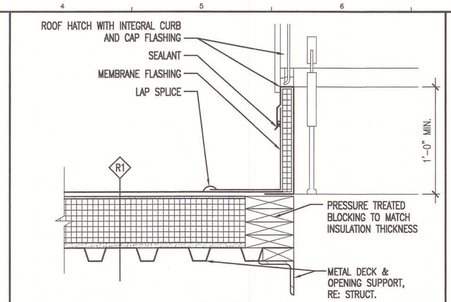


K1	–	K4	ROOF HATCH CURB
*	–	NOT TO SCALE	–

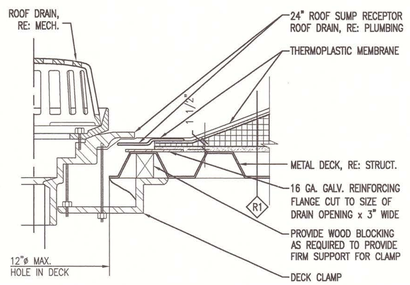


K7	ROOF DRAIN
NOT TO SCALE	–

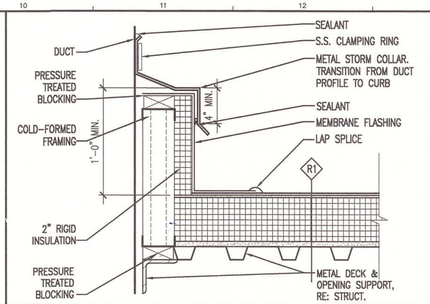


K10	DUCT PENETRATION
NOT TO SCALE	–

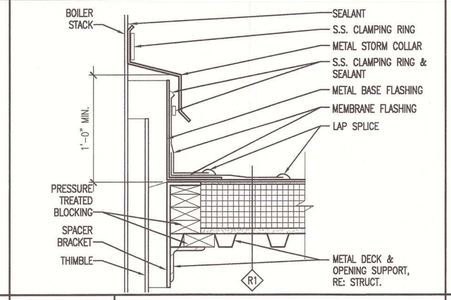


G1	–	G4	BOILER STACK PENETRATION
*	–	NOT TO SCALE	–

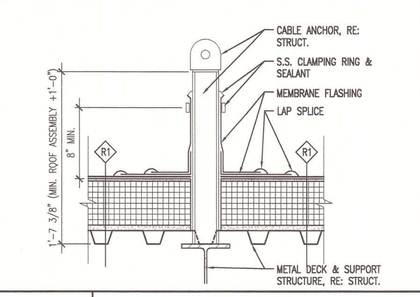


G7	CABLE ANCHOR PENETRATION
NOT TO SCALE	–

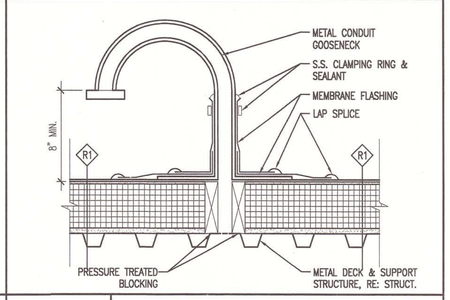


G10	FLEXIBLE PENETRATION
NOT TO SCALE	–

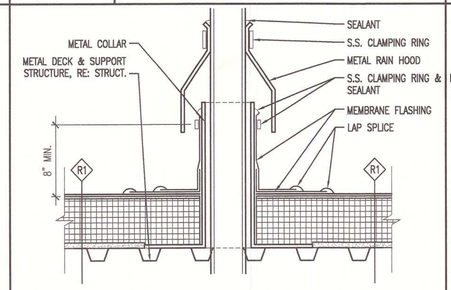


D1	–	D4	HOT PIPE PENETRATION
*	–	NOT TO SCALE	–

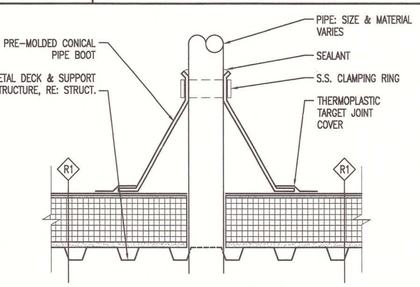


D7	PIPE PENETRATION (BOOT)
NOT TO SCALE	–

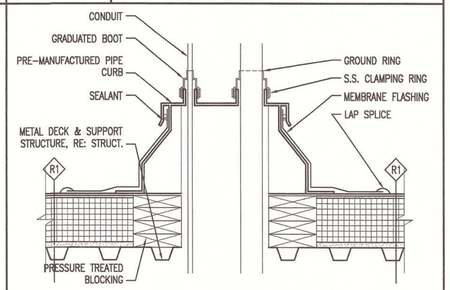


D10	MULTIPLE CONDUIT PENETRATION
NOT TO SCALE	–

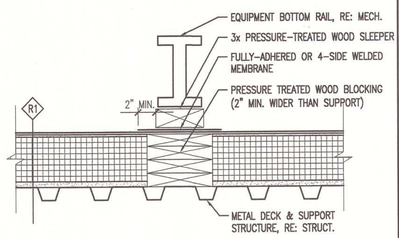


A1	FLOATING SLEEPER DETAIL
*	–

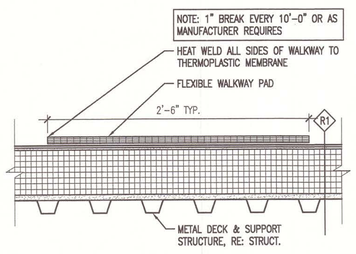

A4	FLEXIBLE WALKWAY
*	–

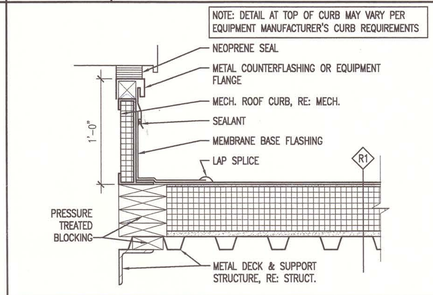

A7	MECHANICAL EQUIPMENT CURB
NOT TO SCALE	–

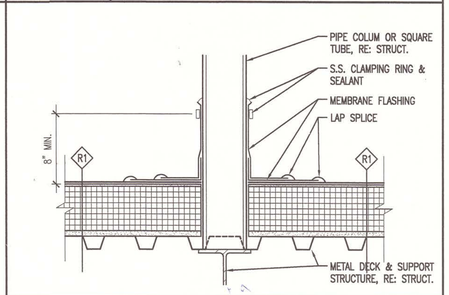

A10	STRUCTURAL SUPPORT PENETRATION
NOT TO SCALE	–

AS BUILT
Owner Copy

SMRT
ARCHITECTURE ENGINEERING PLANNING
SMRT
144 Fore Street P.O. Box 618
Portland, Maine 04104
tel. (207) 772-3846
fax. (207) 772-1070

STATE OF MAINE
SCOTT L BENSON
No. 1772
REGISTERED PROFESSIONAL ARCHITECT

PROJECT TITLE:
MAINE TURNPIKE AUTHORITY ADMINISTRATION BUILDING
PORTLAND, MAINE

CURRENT ISSUE STATUS:
ISSUED FOR BIDDING/CONSTRUCTION
7-9-07

REV	DESCRIPTION	DATE
0	BIDDING/CONSTRUCTION	7-9-07

GRAPHIC SCALE: 0" 1"

SCALE:	AS NOTED
PROJECT MANAGER:	SLB
JC/DRAWN BY:	TCM/TCM
A/E OF RECORD:	SLB
CAD FILE:	AE501-06016
PROJECT NO:	06016
DATE:	7-9-07


SHEET TITLE:
TYPICAL SECTIONS & DETAILS

SHEET No.
AE501


©COPYRIGHT 2007 SMRT INC


GENERAL NOTES:


1. SEE GI001 FOR PROJECT GENERAL NOTES.

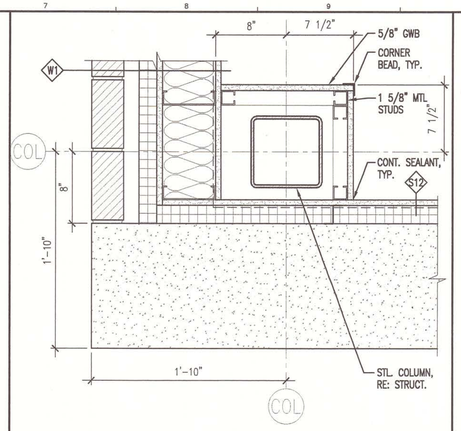


J1	–	J4	–	J7	PLAN DETAIL	J10	PLAN DETAIL
*	–	*	–	1 1/2" = 1'-0"	–	1 1/2" = 1'-0"	–

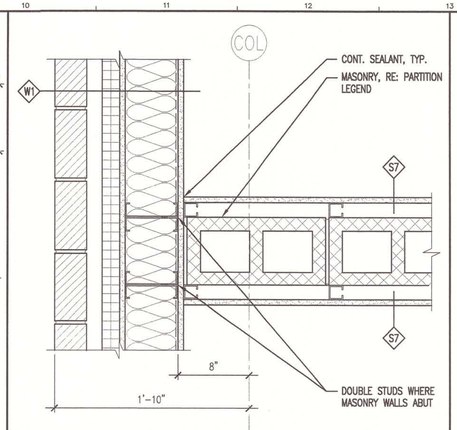


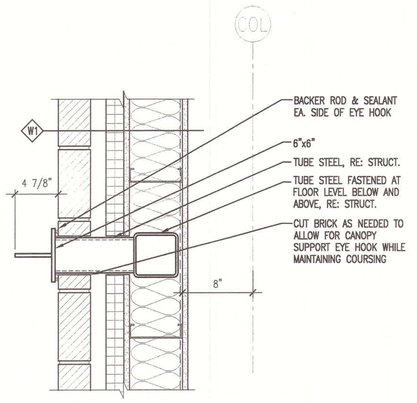


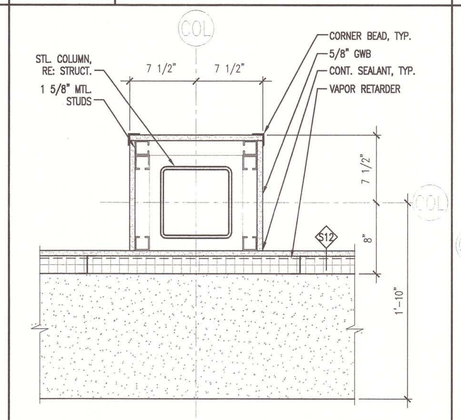


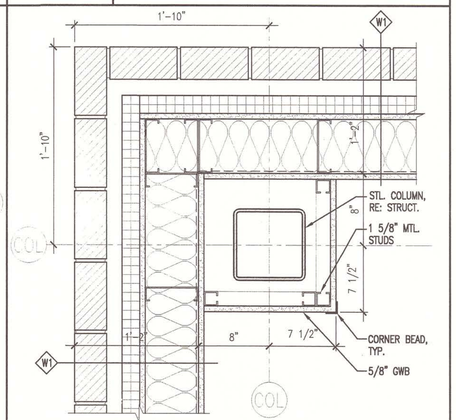

E1	–	E4	PLAN DETAIL @ CANOPY SUPPORT	E7	PLAN DETAIL	E10	PLAN DETAIL
*	–	1 1/2" = 1'-0"	–	1 1/2" = 1'-0"	–	1 1/2" = 1'-0"	–

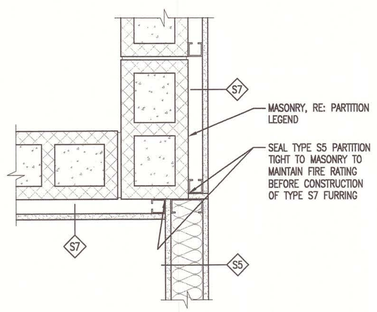

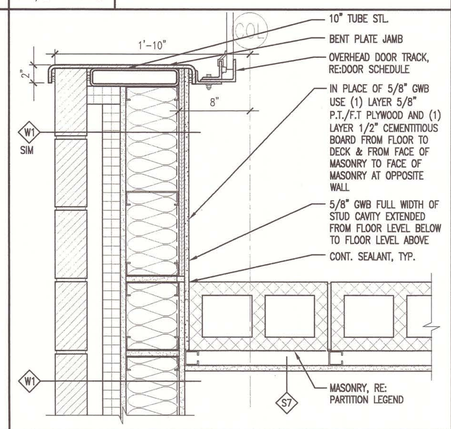

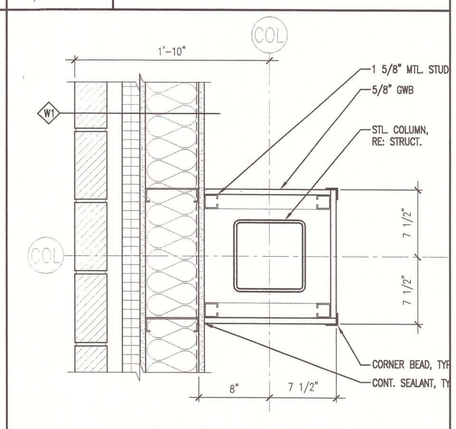

A1	–	A4	PLAN DETAIL	A7	PLAN DETAIL	A10	PLAN DETAIL
*	–	1 1/2" = 1'-0"		1 1/2" = 1'-0"	–	1 1/2" = 1'-0"	

AS BUILT
Owner Copy

SMRT
ARCHITECTURE ENGINEERING PLANNING
SMRT
144 Fore Street/P. O. Box 618
Portland, Maine 04104
tel. (207) 772-3846
fax. (207) 772-1070

STATE OF MAINE
SCOTT L BENSON
No. 1772
REGISTERED PROFESSIONAL ARCHITECT

PROJECT TITLE:
MAINE TURNPIKE AUTHORITY ADMINISTRATION BUILDING
PORTLAND, MAINE

CURRENT ISSUE STATUS:
ISSUED FOR BIDDING/CONSTRUCTION
7-9-07

REV	DESCRIPTION	DATE
0	BIDDING/CONSTRUCTION	7-9-07


GRAPHIC SCALE: 0" 1"

SCALE:	AS NOTED
PROJECT MANAGER:	SLB
JC/DRAWN BY:	TCM/TCM
A/E OF RECORD:	SLB
CAD FILE:	AE511-06016
PROJECT NO:	06016
DATE:	7-9-07


SHEET TITLE:
PLAN
SECTIONS & DETAILS

SHEET No.
AE511


©COPYRIGHT 2007 SMRT INC.

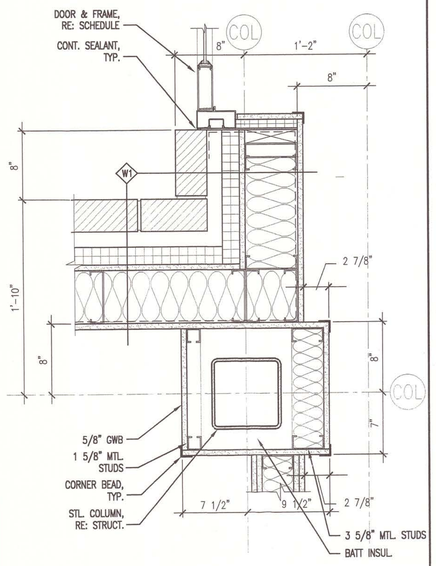


F1	PLAN DETAIL
1 1/2" = 1'-0"	–

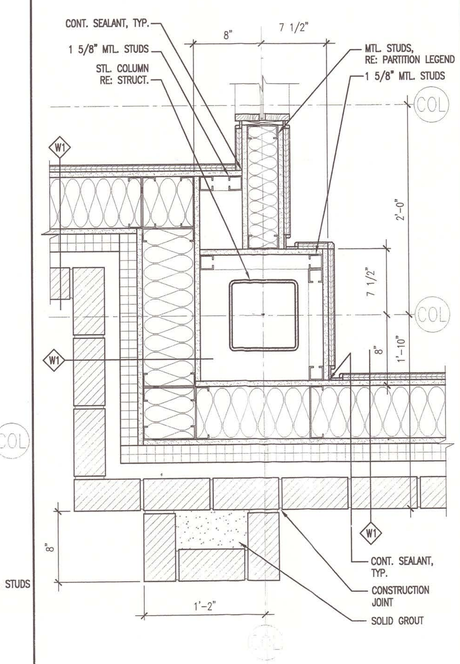


F4	PLAN DETAIL
1 1/2" = 1'-0"	–

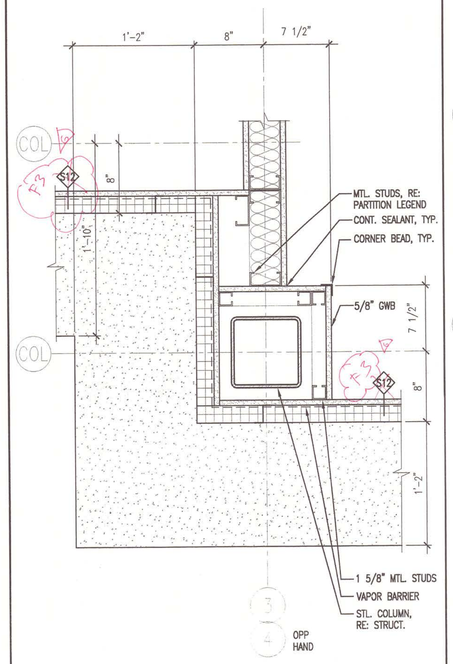


F7	PLAN DETAIL
1 1/2" = 1'-0"	–

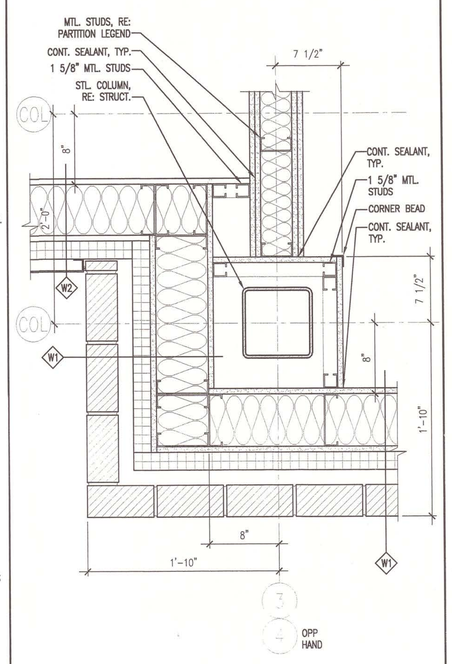

F10	PLAN DETAIL
1 1/2" = 1'-0"	–

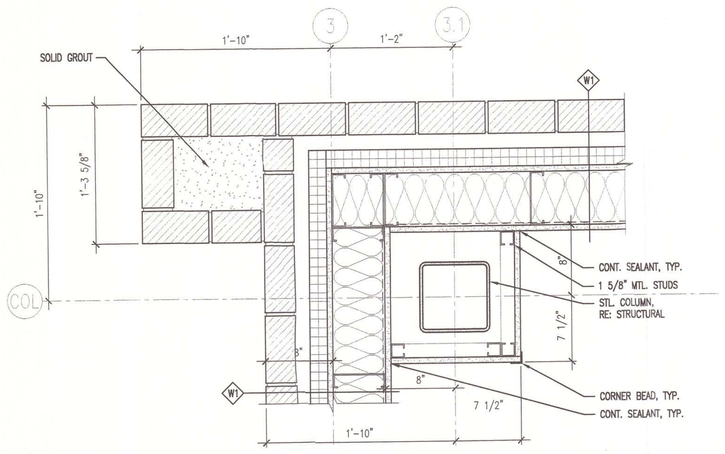

A1	PLAN DETAIL
1 1/2" = 1'-0"	–

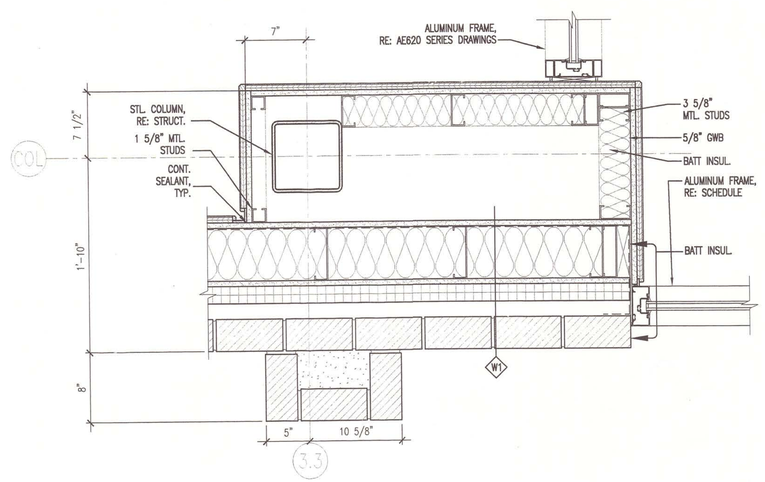

A7	PLAN DETAIL
1 1/2" = 1'-0"	–

GENERAL NOTES:

1. SEE G1001 FOR PROJECT GENERAL NOTES.

SMRT
ARCHITECTURE ENGINEERING PLANNING
SMRT
144 Fore Street/P.O. Box 618
Portland, Maine 04104
tel. (207) 772-3846
fax. (207) 772-1070

STATE OF MAINE
SCOTT L. BENSON
No. 1772
REGISTERED PROFESSIONAL ARCHITECT

PROJECT TITLE:
MAINE TURNPIKE AUTHORITY
ADMINISTRATION BUILDING
PORTLAND, MAINE

CURRENT ISSUE STATUS:
ISSUED FOR BIDDING/CONSTRUCTION
7-9-07

REV	DESCRIPTION	DATE
0	BIDDING/CONSTRUCTION	7-9-07

GRAPHIC SCALE: 0" 1"


SCALE:	AS NOTED
PROJECT MANAGER:	SLB
JC/DRAWN BY:	TCM/TCM
A/E OF RECORD:	SLB
CAD FILE:	AE512-06016
PROJECT NO:	06016
DATE:	7-9-07

SHEET TITLE:
PLAN
SECTIONS & DETAILS

SHEET No.
AE512


© COPYRIGHT 2007 SMRT INC.

AS BUILT
Owner Copy

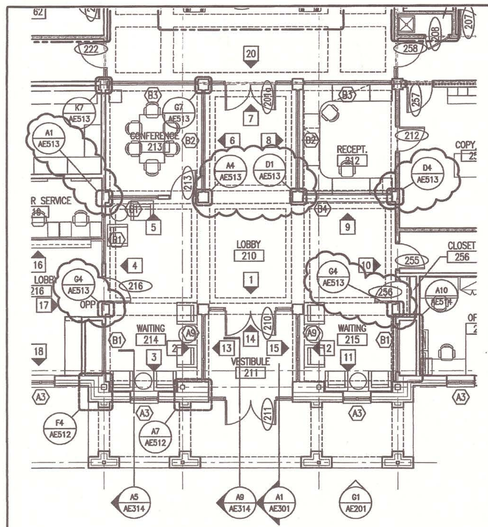

SM RT	ARCHITECTURE ENGINEERING PLANNING SMRT 144 Fore Street/P.O.Box 618 PORTLAND, MAINE 04104 tel. (207) 772-3846 / fax. (207) 772-1070
PROJECT:	MAINE TURNPIKE AUTHORITY ADMINISTRATION BUILDING
SUBJECT:	ADD DETAIL REFERENCES AS DESCRIBED

SCALE:	1/8"=1'-0"
CAD FILE:	AE102-06016
PROJECT No.	06016
REF. SHEET:	AE102
PM: SLB	SUPPLEMENTAL REVISION SI-49
A/E: SLB	SHEET No. A-6
DATE: 7-23-08	© COPYRIGHT 2008 SMRT INC.

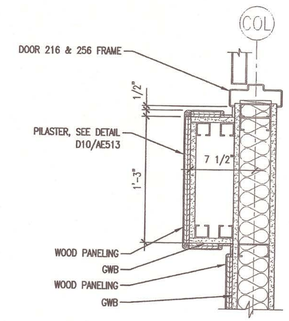


G4 PLAN DETAIL

1 1/2" = 1'-0"

SM RT	ARCHITECTURE ENGINEERING PLANNING SMRT 144 Fore Street/P.O.Box 618 PORTLAND, MAINE 04104 tel. (207) 772-3846 / fax. (207) 772-1070
SUBJECT:	ADD SUPPLEMENTAL DETAIL AS DESCRIBED

SCALE:	1-1/2"=1'-0"
CAD FILE:	AE513-06016
PROJECT No.	05055
REF. SHEET:	AE513
PM: DRL	ADDENDUM No. SI-49
A/E: SLB	SHEET No. A-5
DATE: 7-23-08	© COPYRIGHT 2007 SMRT INC.

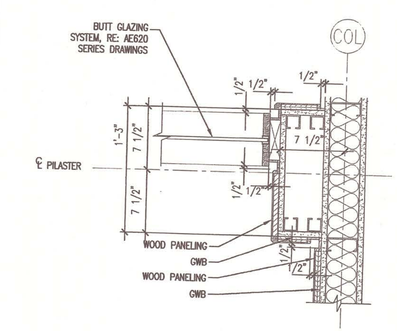


D4 PLAN DETAIL

1 1/2" = 1'-0"

SM RT	ARCHITECTURE ENGINEERING PLANNING SMRT 144 Fore Street/P.O.Box 618 PORTLAND, MAINE 04104 tel. (207) 772-3846 / fax. (207) 772-1070
SUBJECT:	ADD SUPPLEMENTAL DETAIL AS DESCRIBED

SCALE:	1-1/2"=1'-0"
CAD FILE:	AE513-06016
PROJECT No.	05055
REF. SHEET:	AE513
PM: DRL	ADDENDUM No. SI-49
A/E: SLB	SHEET No. A-4
DATE: 7-23-08	© COPYRIGHT 2007 SMRT INC.

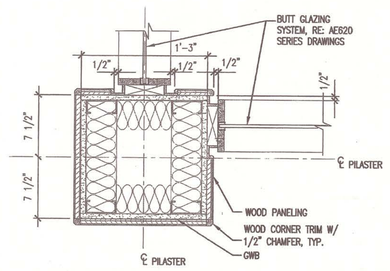


D1 PLAN DETAIL

1 1/2" = 1'-0"

SM RT	ARCHITECTURE ENGINEERING PLANNING SMRT 144 Fore Street/P.O.Box 618 PORTLAND, MAINE 04104 tel. (207) 772-3846 / fax. (207) 772-1070
SUBJECT:	ADD SUPPLEMENTAL DETAIL AS DESCRIBED

SCALE:	1-1/2"=1'-0"
CAD FILE:	AE513-06016
PROJECT No.	05055
REF. SHEET:	AE513
PM: DRL	ADDENDUM No. SI-49
A/E: SLB	SHEET No. A-3
DATE: 7-23-08	© COPYRIGHT 2007 SMRT INC.

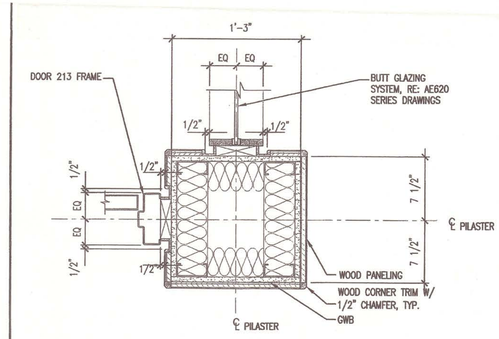


A4 PLAN DETAIL

1 1/2" = 1'-0"

SM RT	ARCHITECTURE ENGINEERING PLANNING SMRT 144 Fore Street/P.O.Box 618 PORTLAND, MAINE 04104 tel. (207) 772-3846 / fax. (207) 772-1070
SUBJECT:	ADD SUPPLEMENTAL DETAIL AS DESCRIBED

SCALE:	1-1/2"=1'-0"
CAD FILE:	AE513-06016
PROJECT No.	05055
REF. SHEET:	AE513
PM: DRL	ADDENDUM No. SI-49
A/E: SLB	SHEET No. A-2
DATE: 7-23-08	© COPYRIGHT 2007 SMRT INC.

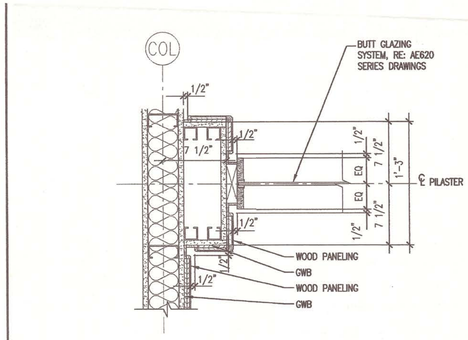


A1 PLAN DETAIL


1 1/2" = 1'-0"

SM RT	ARCHITECTURE ENGINEERING PLANNING SMRT 144 Fore Street/P.O.Box 618 PORTLAND, MAINE 04104 tel. (207) 772-3846 / fax. (207) 772-1070
SUBJECT:	ADD SUPPLEMENTAL DETAIL AS DESCRIBED

SCALE:	1-1/2"=1'-0"
CAD FILE:	AE513-06016
PROJECT No.	05055
REF. SHEET:	AE513
PM: DRL	ADDENDUM No. SI-49
A/E: SLB	SHEET No. A-1
DATE: 7-23-08	© COPYRIGHT 2007 SMRT INC.

K1	–	K4	–	K7	PLAN DETAIL	K10	PLAN DETAIL
*	–	*	–	1 1/2" = 1'–0"	–	1 1/2" = 1'–0"	–

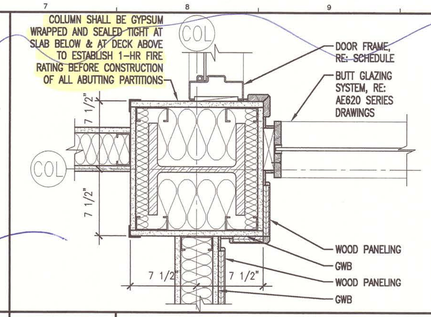

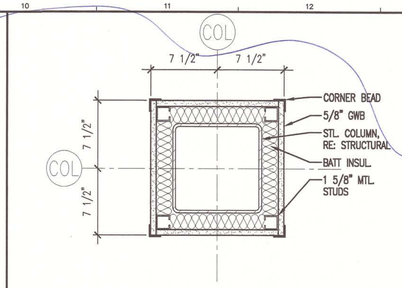



GENERAL NOTES:

1. SEE GI001 FOR PROJECT GENERAL NOTES.


G1	–	G4	–	G7	PLAN DETAIL	G10	PLAN DETAIL
*	–	*	–	1 1/2" = 1'–0"	–	1 1/2" = 1'–0"	–


See opposite Page For Details ST#49

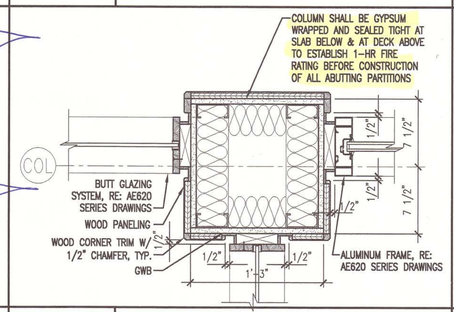

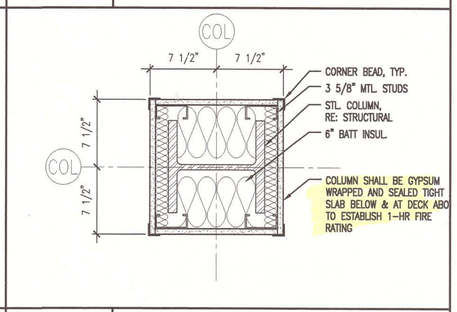



D1	–	D4	–	D7	PLAN DETAIL	D10	TYP. PILASTER PLAN DETAIL
*	–	*	–	1/2" = 1'–0"	–	1 1/2" = 1'–0"	–

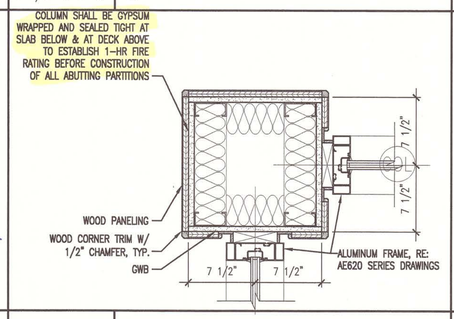

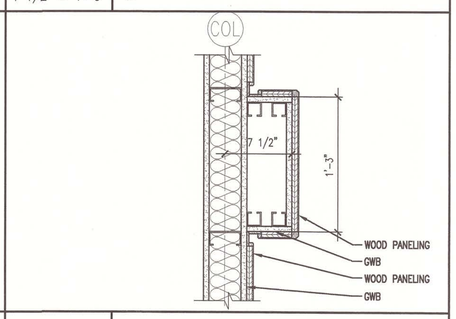

A1	–	A4	–	A7	PLAN DETAIL @ INTERIOR/ EXTERIOR WALL ABUTMENT	A10	PLAN DETAIL @ PARTITION/ MULLION ABUTMENT
*	–	*	–	1 1/2" = 1'–0"	–	1 1/2" = 1'–0"	–

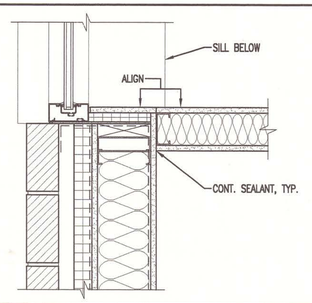

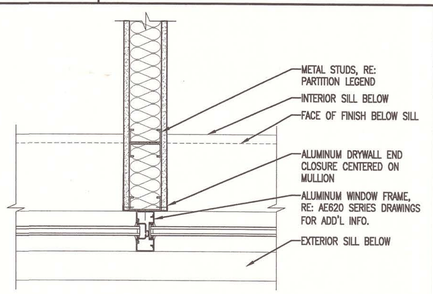

AS BUILT
Owner Copy

SMRT
ARCHITECTURE ENGINEERING PLANNING
SMRT
144 Fore Street/P.O. Box 618
Portland, Maine 04104
tel. (207) 772-3846
fax. (207) 772-1070

STATE OF MAINE
SCOTT L BENSON
No. 1772
REGISTERED PROFESSIONAL ARCHITECT

PROJECT TITLE:
MAINE TURNPIKE AUTHORITY
ADMINISTRATION BUILDING
PORTLAND, MAINE

CURRENT ISSUE STATUS:
ISSUED FOR BIDDING/CONSTRUCTION
7-9-07

REV	DESCRIPTION	DATE
0	BIDDING/CONSTRUCTION	7-9-07


GRAPHIC SCALE: 0" 1"

SCALE:	AS NOTED
PROJECT MANAGER:	SLB
JC/DRAWN BY:	TCM/TCM
A/E OF RECORD:	SLB
CAD FILE:	AE513-06016
PROJECT NO:	06016
DATE:	7-9-07

SHEET TITLE:
PLAN
SECTIONS & DETAILS

SHEET No.
AE513

© COPYRIGHT 2007 SMRT INC.

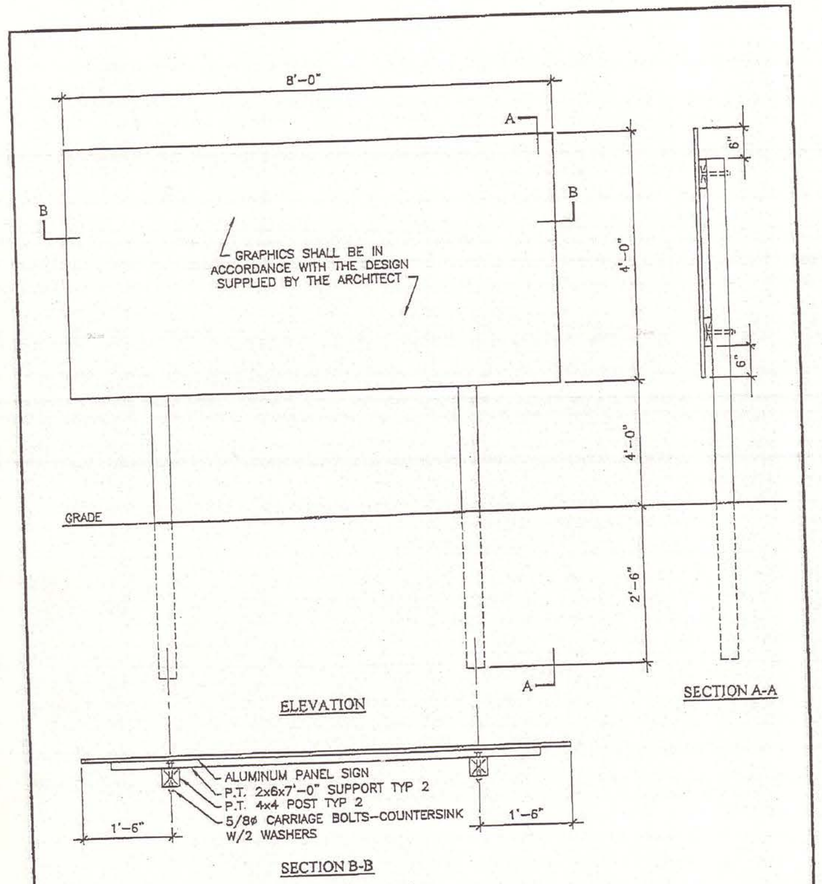

SMRT


ARCHITECTURE ENGINEERING PLANNING

SMRT
144 Fore Street/P.O.Box 618 PORTLAND, MAINE 04104
tel. (207) 772-3846 / fax. (207) 772-1070


PROJECT:	MAINE TURNPIKE AUTHORITY ADMINISTRATION BUILDING
SUBJECT:	ADDED A1/AE514 PROJECT IDENTIFICATION SIGN DETAILS

SCALE:	N.T.S.
CAD FILE:	AE514-06016
PROJECT No.	06016
REF. SHEET:	AE514
PM: SLB	ADDENDUM No. ADD-6
A/E: SLB	SHEET No. A-5
DATE: 8-23-07	©COPYRIGHT 2007 SMRT INC.


RFI-150
SI-48R
&
See SI-47R

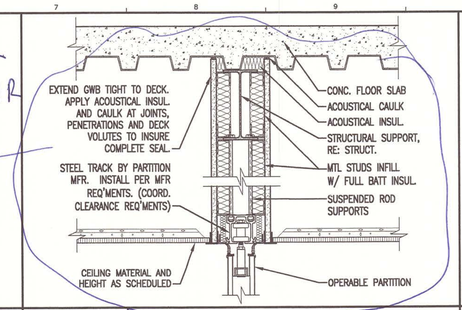

K1	–	K4	–	K7	SECTION @ OPERABLE PARTITION	K10	SECTION @ HORIZONTAL SHAFT ABOVE CEILING
*	–	*	–	1 1/2" = 1'-0"	–	1 1/2" = 1'-0"	–

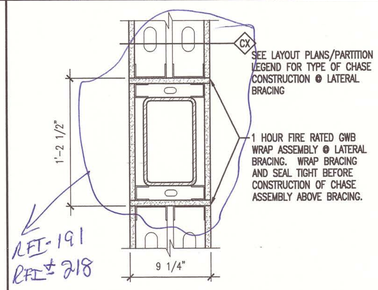


RFI-191
RFI-218

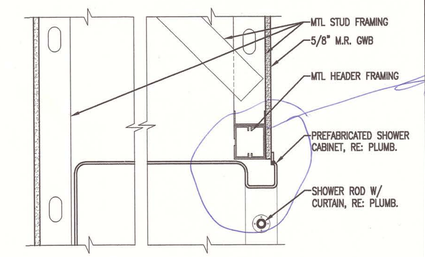

SI-81
Shower Title Details

G7	SECTION @ LATERAL BRACING	G10	SECTION @ SHOWER
1 1/2" = 1'-0"	–	1 1/2" = 1'-0"	–

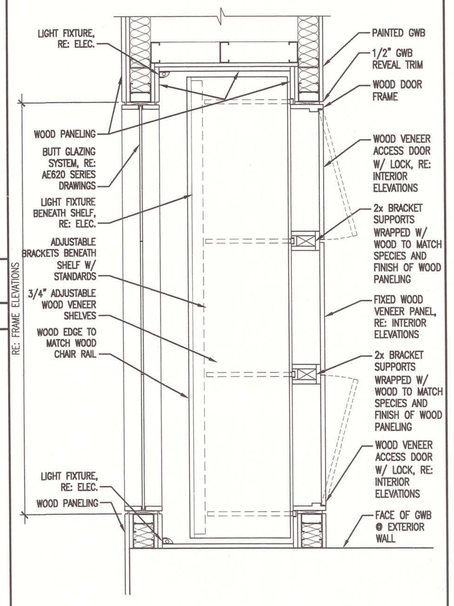

D7	–
*	–

SEE SK A-5 OPP. PAGE

A1	– PROJECT IDENTIFICATION SIGN DETAILS	A7	–	A10	PLAN DETAIL @ DISPLAY
*	–	*	–	1" = 1'-0"	–

GENERAL NOTES:

1. SEE G1001 FOR PROJECT GENERAL NOTES.

AS BUILT
Owner Copy

SMRT
ARCHITECTURE ENGINEERING PLANNING
SMRT
144 Fore Street P.O. Box 618
Portland, Maine 04104
tel. (207) 772-3846
fax. (207) 772-1070

STATE OF MAINE
SCOTT L. BENSON
No. 1772
REGISTERED PROFESSIONAL ARCHITECT

PROJECT TITLE:
MAINE TURNPIKE AUTHORITY
ADMINISTRATION BUILDING
PORTLAND, MAINE

CURRENT ISSUE STATUS:
ISSUED FOR BIDDING/CONSTRUCTION
7-9-07

REV	DESCRIPTION	DATE
0	BIDDING/CONSTRUCTION	7-9-07


GRAPHIC SCALE: 0" 1"

SCALE:	AS NOTED
PROJECT MANAGER:	SLB
JC/DRAWN BY:	TCM/TCM
A/E OF RECORD:	SLB
CAD FILE:	AE514-06016
PROJECT NO:	06016
DATE:	7-9-07

SHEET TITLE:
PLAN
SECTIONS & DETAILS


SHEET No.
AE514

©COPYRIGHT 2007 SMRT INC.

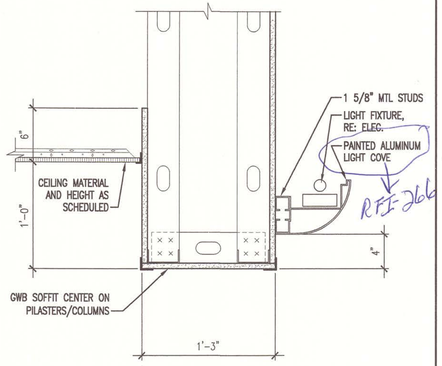


G1 SOFFIT SECTION @ LIGHT COVE

1 1/2" = 1'-0" | –

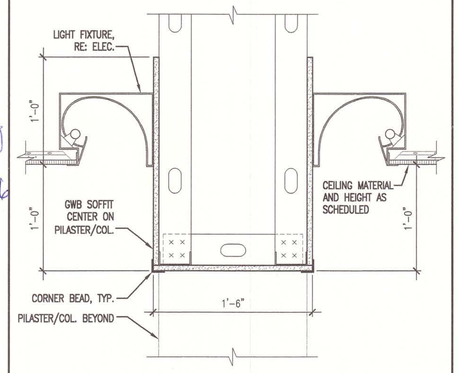


G4 SOFFIT SECTION @ RECESSED LIGHT COVE

1 1/2" = 1'-0" | –

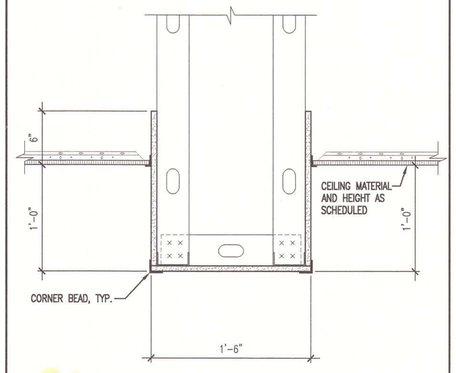


G4 SOFFIT SECTION

1 1/2" = 1'-0" | –

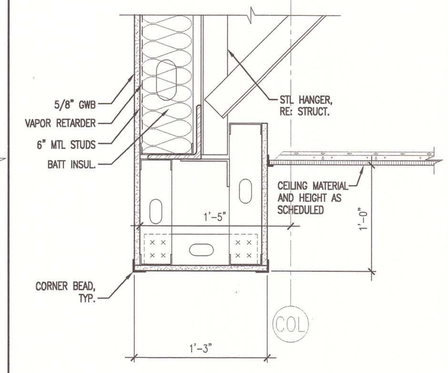


G10 SOFFIT SECTION @ CLEAR STORY/SKYLIGHT

1 1/2" = 1'-0" | –

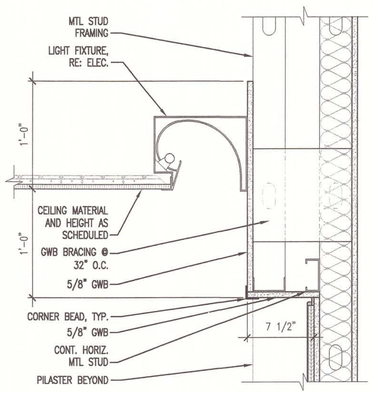


D1 SOFFIT SECTION @ RECESSED LIGHT COVE

1 1/2" = 1'-0" | –

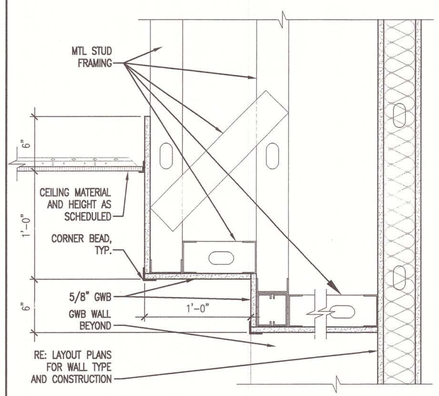


D4 SOFFIT SECTION

1 1/2" = 1'-0" | –

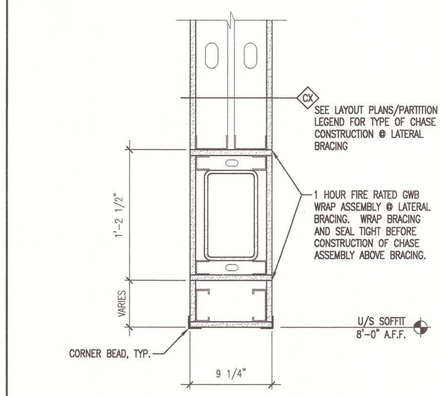


D7 SOFFIT SECTION @ BRACING

1 1/2" = 1'-0" | –

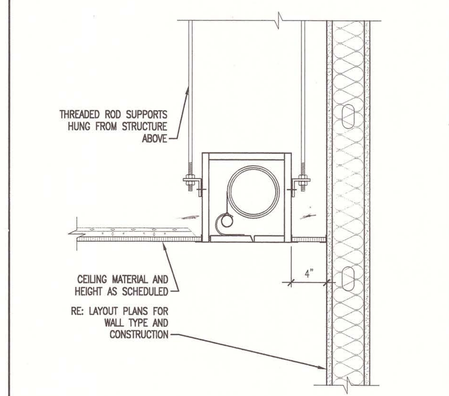


D10 SECTION @ RECESSED PROJECTION SCREEN

1 1/2" = 1'-0" | –

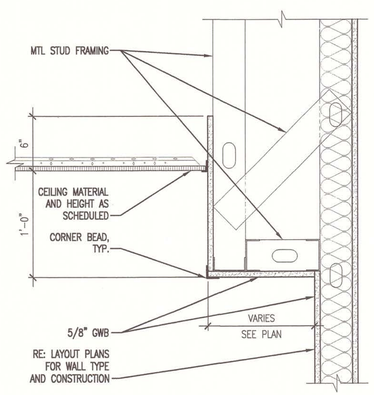


A1 SOFFIT SECTION

1 1/2" = 1'-0" | –

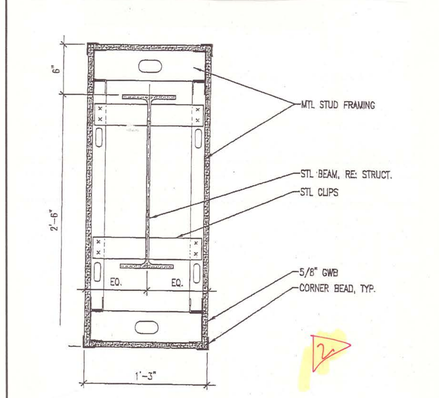


A4 SECTION @ OPERABLE PARTITION

1 1/2" = 1'-0" | –

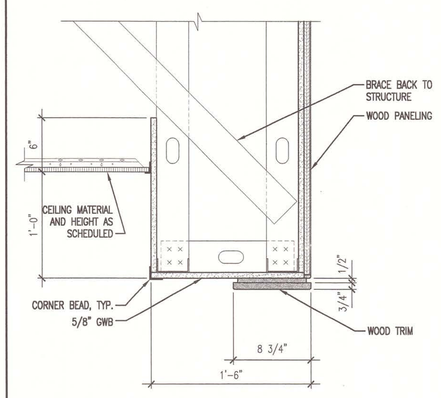

A7 SOFFIT SECTION

1 1/2" = 1'-0" | –

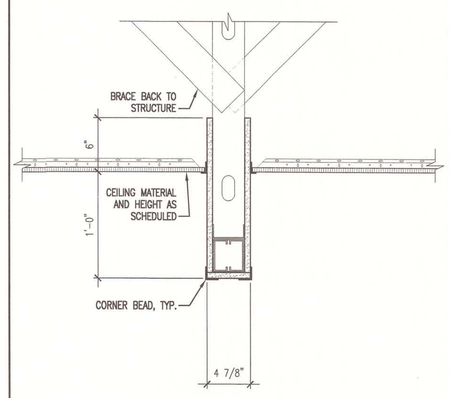

A10 SOFFIT SECTION

1 1/2" = 1'-0" | –

GENERAL NOTES:

1. SEE G1001 FOR PROJECT GENERAL NOTES.

SMRT
ARCHITECTURE ENGINEERING PLANNING
SMRT
144 Fore Street / P.O. Box 618
Portland, Maine 04104
tel. (207) 772-3846
fax. (207) 772-1070

STATE OF MAINE SCOTT L BENSON No. 1772 REGISTERED PROFESSIONAL ARCHITECT

PROJECT TITLE: MAINE TURNPIKE AUTHORITY ADMINISTRATION BUILDING PORTLAND, MAINE

CURRENT ISSUE STATUS: ISSUED FOR BIDDING/CONSTRUCTION 7-9-07

REV	DESCRIPTION	DATE
0	BIDDING/CONSTRUCTION	7-9-07

GRAPHIC SCALE: 0" 1"


SCALE:	AS NOTED
PROJECT MANAGER:	SLB
JC/DRAWN BY:	TCM/ DG
A/E OF RECORD:	SLB
CAD FILE:	AE515-06016
PROJECT NO:	06016
DATE:	7-9-07

SHEET TITLE: SECTIONS & DETAILS


SHEET No. AE515

© COPYRIGHT 2007 SMRT INC.


AS BUILT Owner Copy

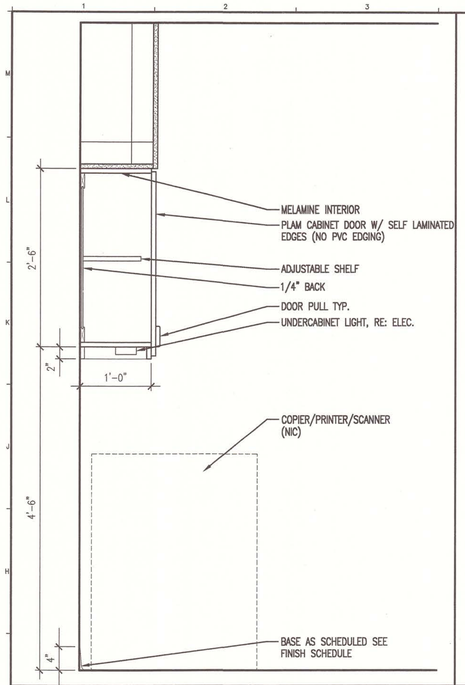

G1	SECTION @ CASEWORK
1" = 1'-0"	–

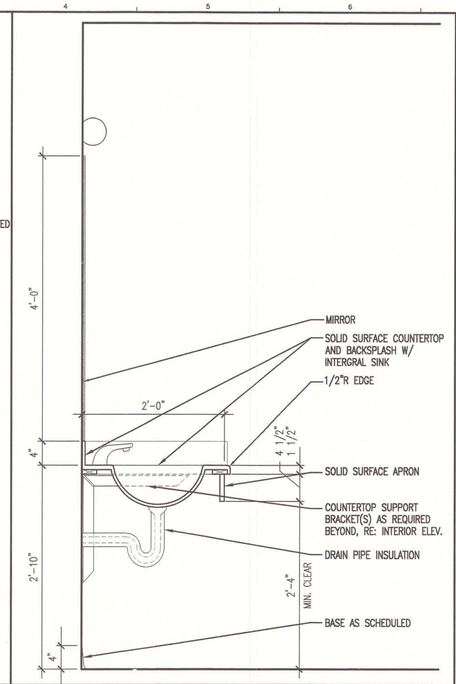

G4	SECTION @ COUNTER
1" = 1'-0"	–

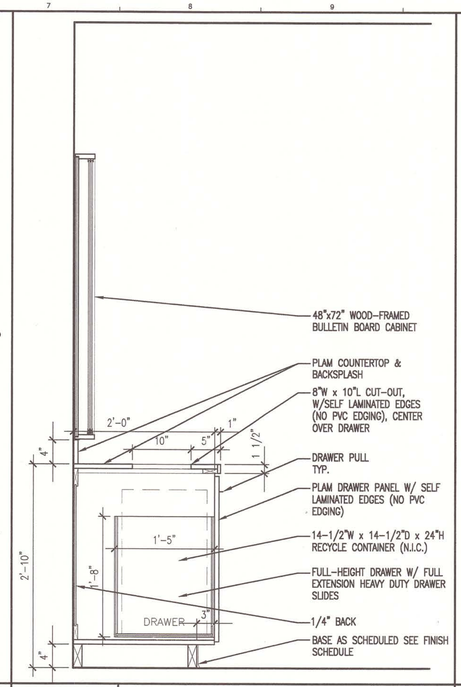


G7	SECTION @ RECYCLE AREA
1" = 1'-0"	–


G10	–
*	–

GENERAL NOTES:


1. SEE G1001 FOR PROJECT GENERAL NOTES.

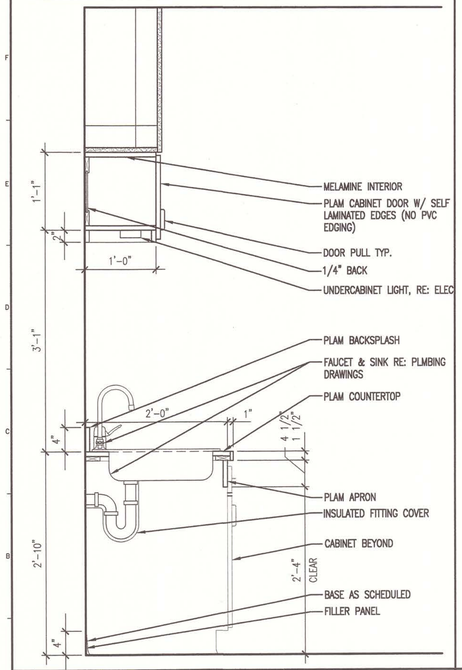


A1	SECTION @ CASEWORK
1" = 1'-0"	–

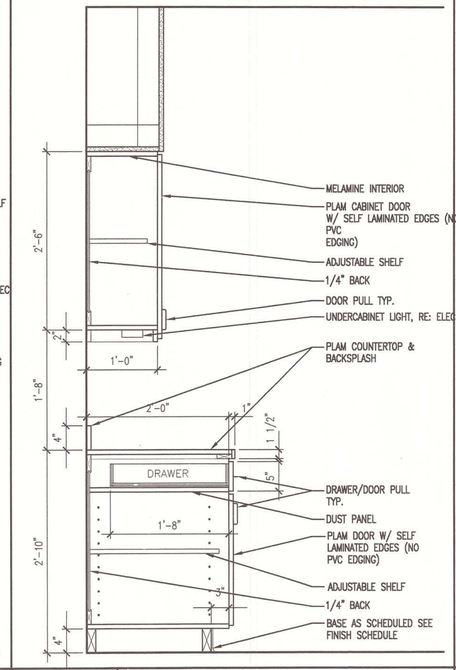

A4	SECTION @ CASEWORK
1" = 1'-0"	–

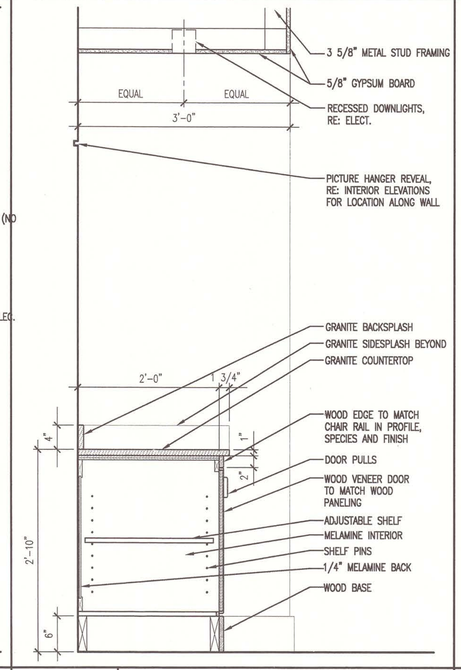

A7	SECTION @ CREDENZA
1" = 1'-0"	–

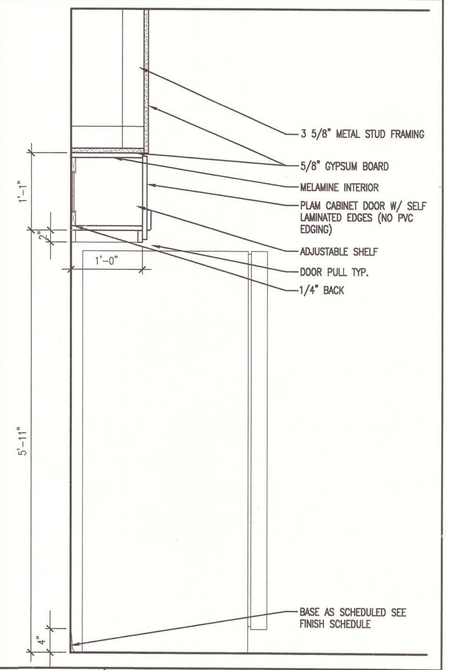

A10	SECTION @ CASEWORK
1" = 1'-0"	–

AS BUILT
Owner Copy

SMRT
ARCHITECTURE ENGINEERING PLANNING
SMRT
144 Fore Street/P.O. Box 618
Portland, Maine 04104
tel. (207) 772-3846
fax. (207) 772-1070

STATE OF MAINE
SCOTT L. BENSON
No. 1772
REGISTERED PROFESSIONAL ARCHITECT

PROJECT TITLE:
MAINE TURNPIKE AUTHORITY
ADMINISTRATION BUILDING
PORTLAND, MAINE

CURRENT ISSUE STATUS:
ISSUED FOR BIDDING/CONSTRUCTION
7-9-07

REV	DESCRIPTION	DATE
0	BIDDING/CONSTRUCTION	7-9-07

GRAPHIC SCALE: 0" 1"

SCALE:	AS NOTED
PROJECT MANAGER:	SLB
JC/DRAWN BY:	TCM/TCM
A/E OF RECORD:	SLB
CAD FILE:	AE521-06016
PROJECT NO:	06016
DATE:	7-9-07


SHEET TITLE:
INTERIOR ELEVATION SECTIONS & DETAILS

SHEET No.
AE521

©COPYRIGHT 2007 SMRT INC.


GENERAL NOTES:

1. SEE G1001 FOR PROJECT GENERAL NOTES.

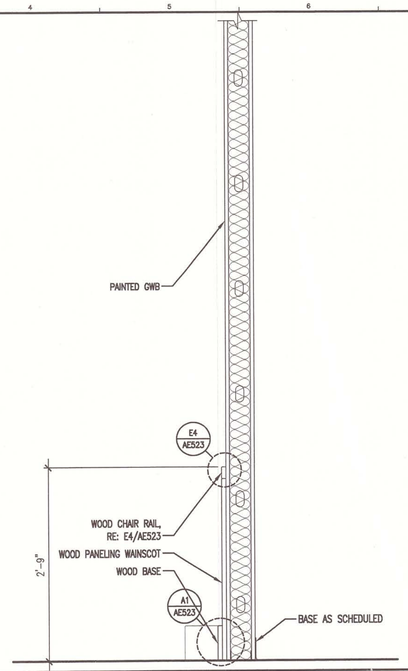


G1 — 1" = 1'-0"


G4 — SECTION @ WAINSCOT — 1" = 1'-0"

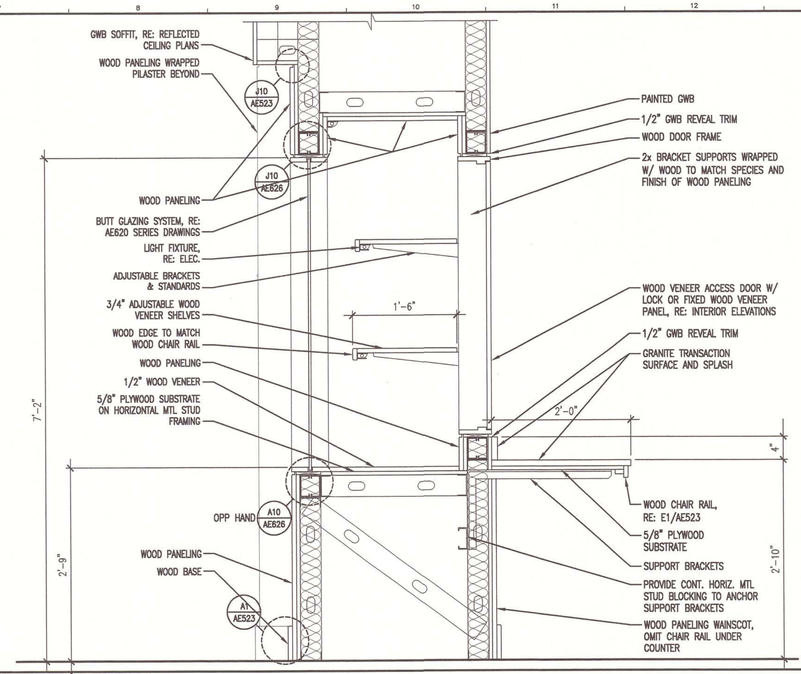


G7 — SECTION @ DISPLAY CASE — 1" = 1'-0"

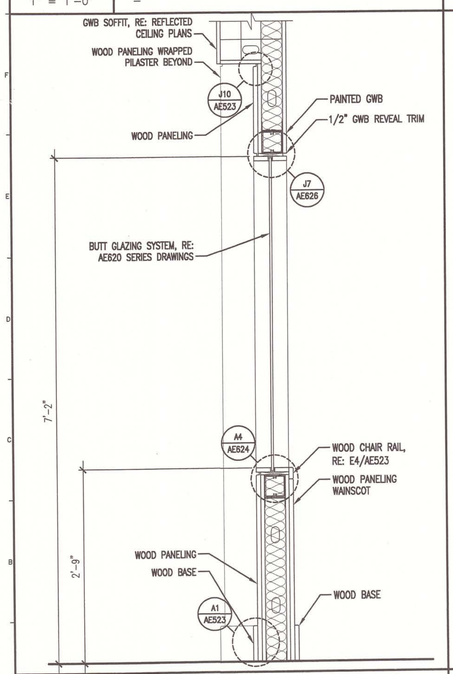


A1 — SECTION @ BUTT GLAZING IN WOOD WALL PANEL — 1" = 1'-0"

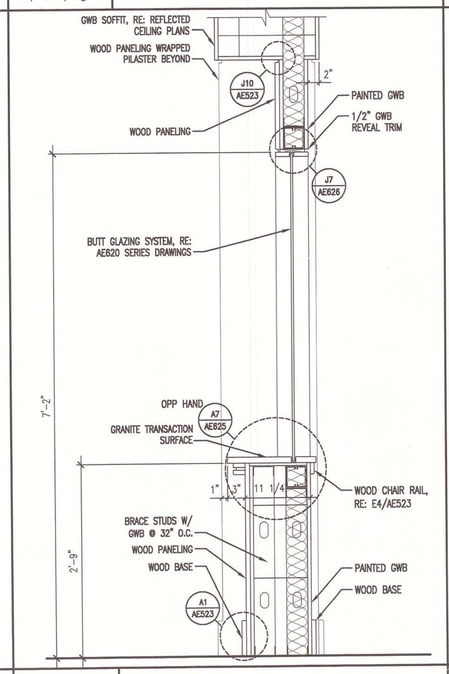

A4 — SECTION @ RECEPTION — 1" = 1'-0"

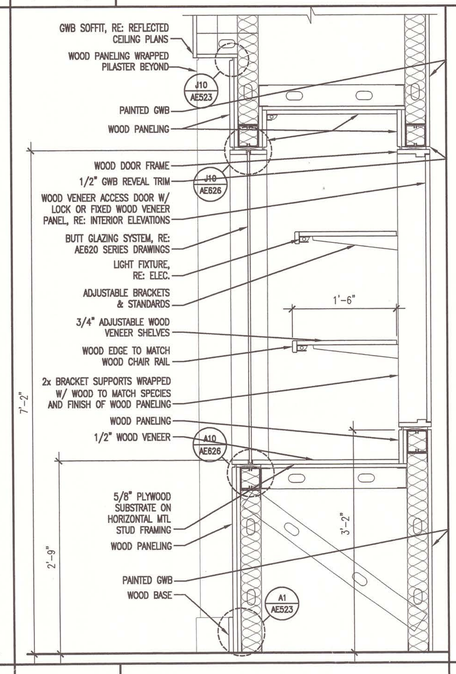

A7 — SECTION @ DISPLAY CASE — 1" = 1'-0"

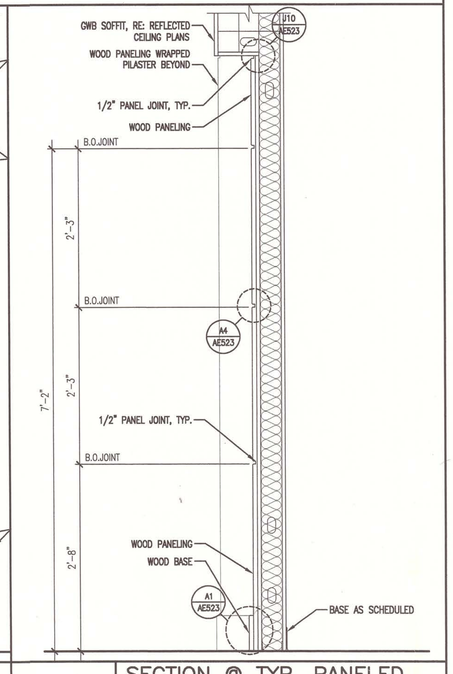

A10 — SECTION @ TYP. PANELED WALL — 1" = 1'-0"

AS BUILT
Owner Copy

SMRT
ARCHITECTURE ENGINEERING PLANNING
SMRT
144 Fore Street/P.O. Box 618
Portland, Maine 04104
tel. (207) 772-3846
fax. (207) 772-1070

STATE OF MAINE
SCOTT L. BENSON
No. 1772
REGISTERED PROFESSIONAL ARCHITECT

PROJECT TITLE:
MAINE TURNPIKE AUTHORITY
ADMINISTRATION BUILDING
PORTLAND, MAINE

CURRENT ISSUE STATUS:
ISSUED FOR BIDDING/CONSTRUCTION
7-9-07

REV	DESCRIPTION	DATE
0	BIDDING/CONSTRUCTION	7-9-07


GRAPHIC SCALE: 0" 1"

SCALE:	1"=1'-0"
PROJECT MANAGER:	SLB
JC/DRAWN BY:	TCM/DLG
A/E OF RECORD:	SLB
CAD FILE:	AE522-06016
PROJECT NO:	06016
DATE:	7-9-07


SHEET TITLE:
INTERIOR ELEVATION SECTIONS & DETAILS

SHEET No.
AE522


© COPYRIGHT 2007 SMRT INC

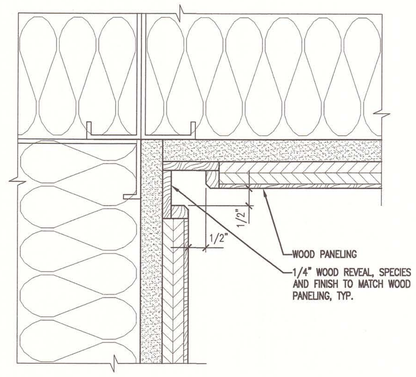


J1	TYP. INSIDE CORNER @ WOOD PANELING
6" = 1'-0"	–

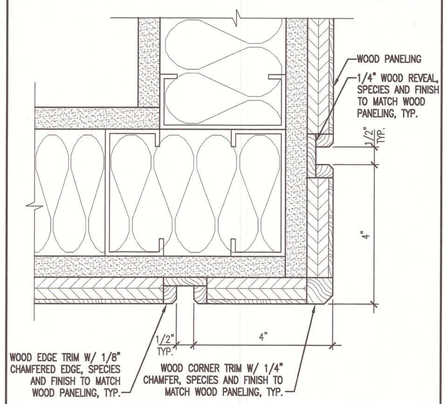


J4	TYP. OUTSIDE CORNER @ WOOD PANELING
6" = 1'-0"	–

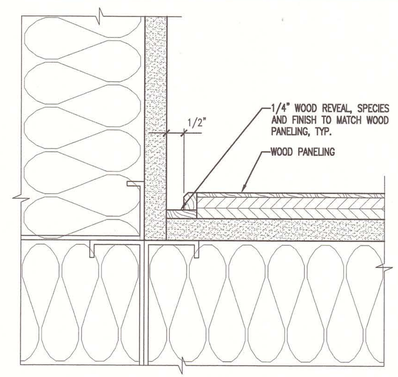


J7	INSIDE CORNER @ WOOD PANELING
6" = 1'-0"	–

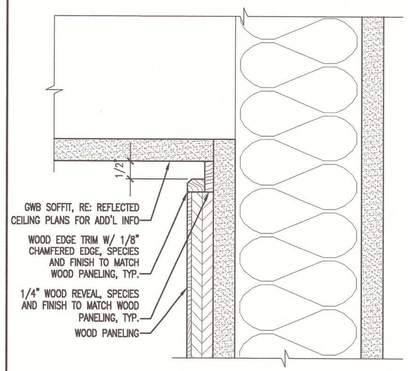


J10	TYP. WOOD PANELING REVEAL @ CEILING/SOFFIT
6" = 1'-0"	–

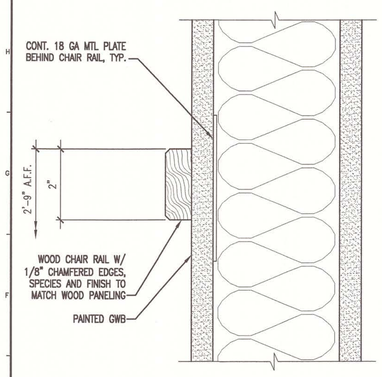


E4	TYP. CHAIRRAIL @ PAINTED GWB WALL
6" = 1'-0"	–

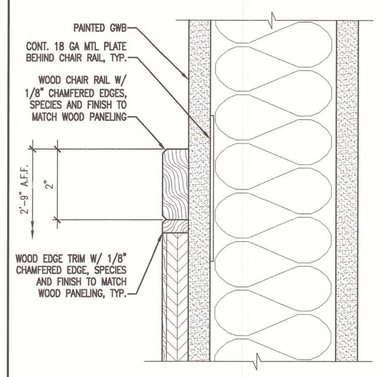


E4	TYP. CHAIRRAIL @ WOOD PANELING WAINSCOT
6" = 1'-0"	–

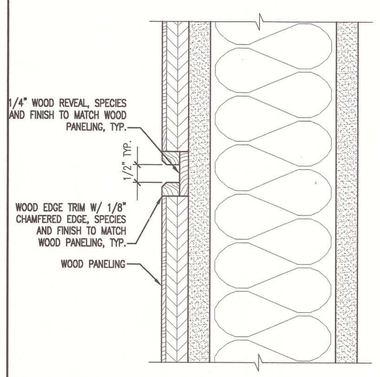


E7	TYP. HORIZ/VERT REVEAL @ WOOD PANELING
6" = 1'-0"	

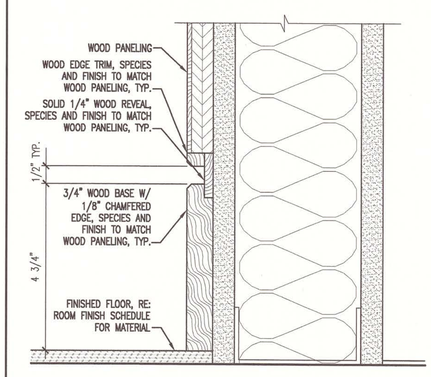


E10	WOOD BASE @ CENTRAL STAIR
6" = 1'-0"	

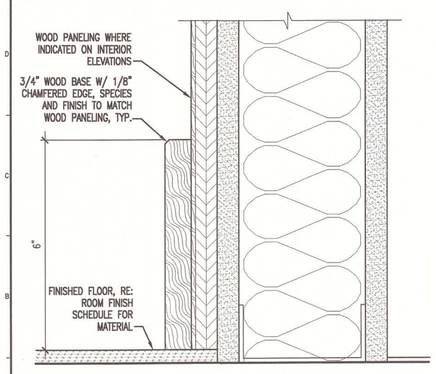


A1	TYP. WOOD BASE
6" = *1'-0"	

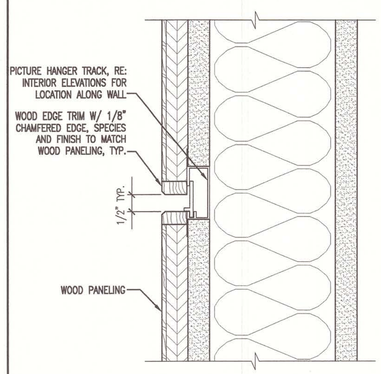

A4	TYP. PICTURE HANGER REVEAL @ WOOD PANELING
6" = 1'-0"	–

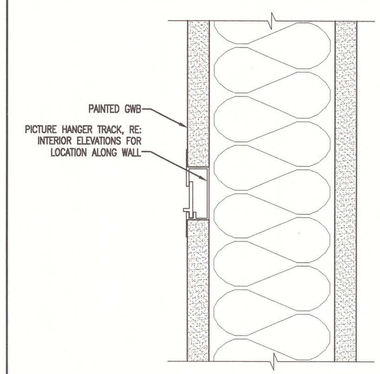

A7	TYP. PICTURE HANGER REVEAL @ PAINTED GWB WALL
6" = 1'-0"	–

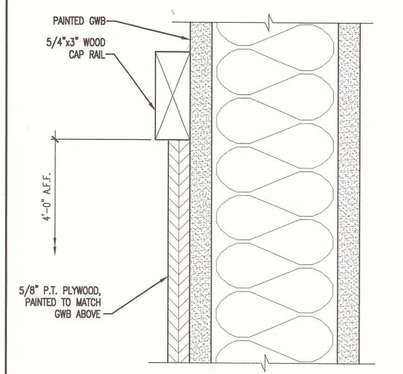

A10	SECTION @ ABUSE PROTECTED WALL (SHIP/RECEIVE 168)
6" = 1'-0"	–

GENERAL NOTES:

1. SEE GI001 FOR PROJECT GENERAL NOTES.

AS BUILT
Owner Copy

SMRT
ARCHITECTURE ENGINEERING PLANNING
SMRT
144 Fore Street/P.O. Box 618
Portland, Maine 04104
tel. (207) 772-3846
fax. (207) 772-1070

STATE OF MAINE
SCOTT L BENSON
No. 1772
REGISTERED PROFESSIONAL ARCHITECT

PROJECT TITLE:
MAINE TURNPIKE AUTHORITY
ADMINISTRATION BUILDING
PORTLAND, MAINE

CURRENT ISSUE STATUS:
ISSUED FOR BIDDING/CONSTRUCTION
7-9-07

REV	DESCRIPTION	DATE
0	BIDDING/CONSTRUCTION	7-9-07


GRAPHIC SCALE: 0" 1"

SCALE:	AS NOTED
PROJECT MANAGER:	SLB
JC/DRAWN BY:	TCM/ DG
A/E OF RECORD:	SLB
CAD FILE:	AE523-06016
PROJECT NO:	06016
DATE:	7-9-07

SHEET TITLE:
INTERIOR ELEVATION SECTIONS & DETAILS


SHEET No. AE523

©COPYRIGHT 2007 SMRT INC.

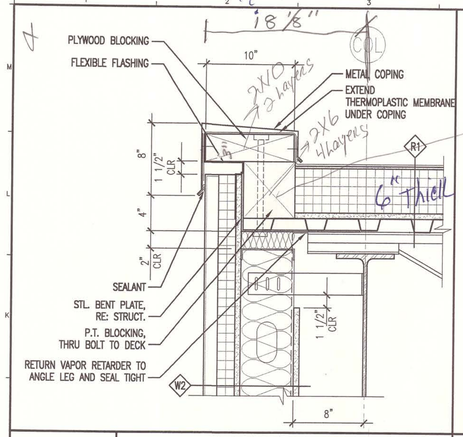


J1 ROOF EDGE DETAIL

1 1/2" = 1'-0" –

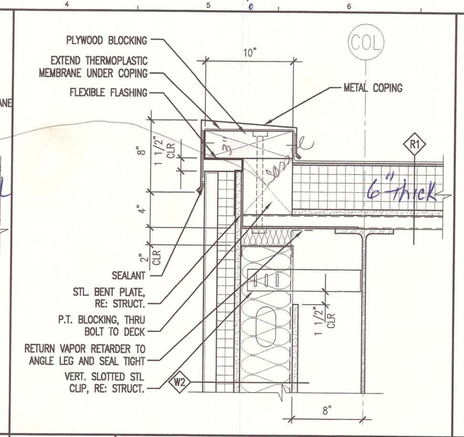


J4 SECTION DETAIL @ ROOF EDGE

1 1/2" = 1'-0" –

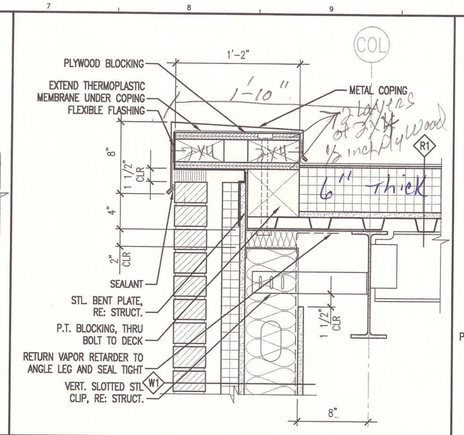

J7 ROOF EDGE DETAIL

1 1/2" = 1'-0" –

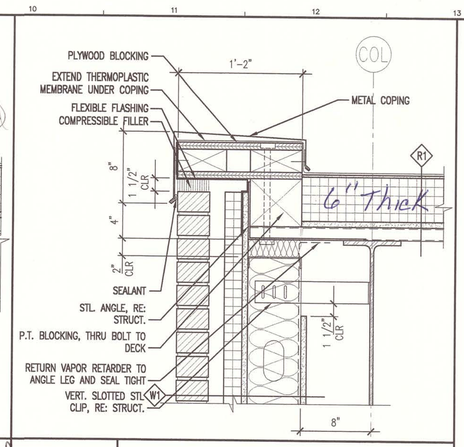


J10 ROOF EDGE DETAIL

1 1/2" = 1'-0" –


GENERAL NOTES:

1. SEE G1001 FOR PROJECT GENERAL NOTES.

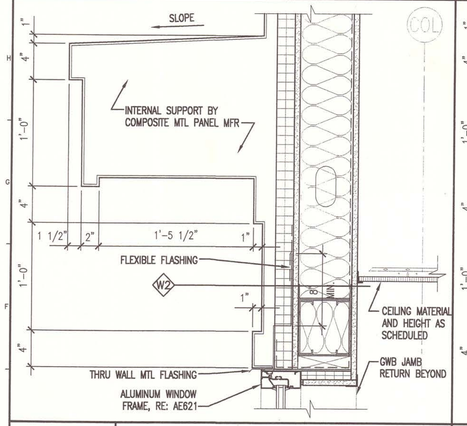


E1 SECTION DETAIL @ CORNICE

1 1/2" = 1'-0" –

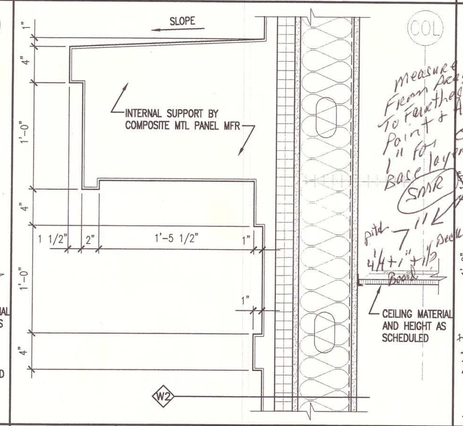


E4 SECTION DETAIL @ CORNICE

1 1/2" = 1'-0" –

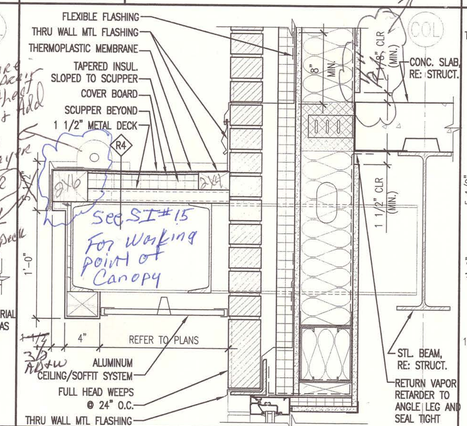


E7 SECTION DETAIL @ CANOPY

1 1/2" = 1'-0" –

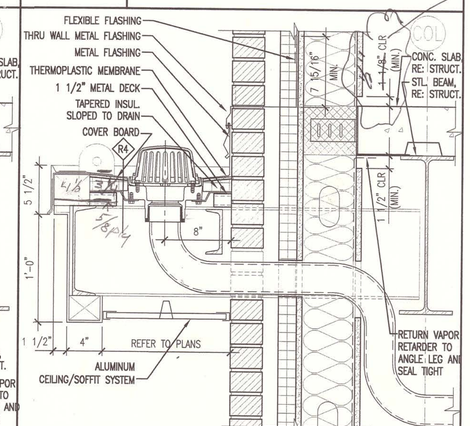


E10 SECTION DETAIL @ CANOPY

– –

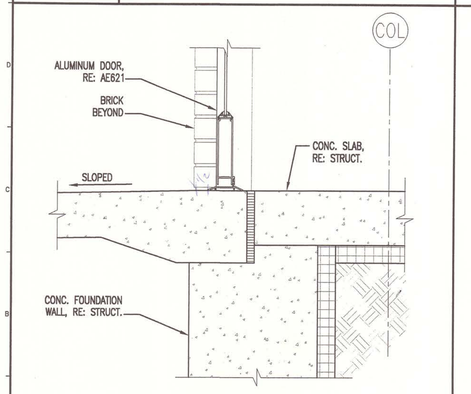


A1 SECTION DETAIL @ EXT. DOOR THRESHOLD

3" = 1'-0" –

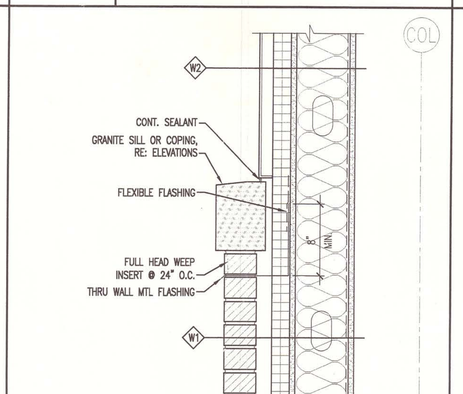


A4 SECTION DETAIL @ CORNICE

1 1/2" = 1'-0" –

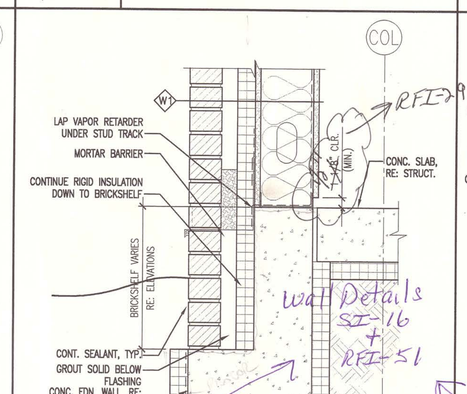

A7 SECTION DETAIL @ BOTTOM OF EXT. WALL

1 1/2" = 1'-0" –

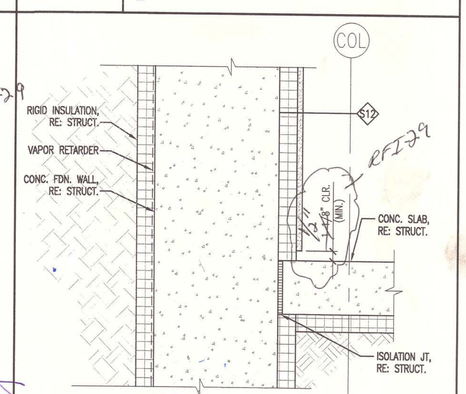

A10 SECTION DETAIL @

1 1/2" = 1'-0" –

AS BUILT Owner Copy

SMRT
ARCHITECTURE ENGINEERING PLANNING
SMRT
144 Fore Street/P.O. Box 618
Portland, Maine 04104
tel. (207) 772-3846
fax. (207) 772-1070

STATE OF MAINE SCOTT L. BENSON No. 1772 REGISTERED PROFESSIONAL ARCHITECT

PROJECT TITLE: MAINE TURNPIKE AUTHORITY ADMINISTRATION BUILDING PORTLAND, MAINE

CURRENT ISSUE STATUS: ISSUED FOR BIDDING/CONSTRUCTION 7-9-07

REV	DESCRIPTION	DATE
0	BIDDING/CONSTRUCTION	7-9-07

GRAPHIC SCALE: 0" 1"


SCALE:	AS NOTED
PROJECT MANAGER:	SLB
JC/DRAWN BY:	TCM/TCM
A/E OF RECORD:	SLB
CAD FILE:	AE531-06016
PROJECT NO:	06016
DATE:	7-9-07

SHEET TITLE: BUILDING AND WALL SECTION DETAILS

SHEET No. AE531

©COPYRIGHT 2007 SMRT INC

NOTE:
RE: AE531 FOR ADD'L INFO AT ROOF EDGE

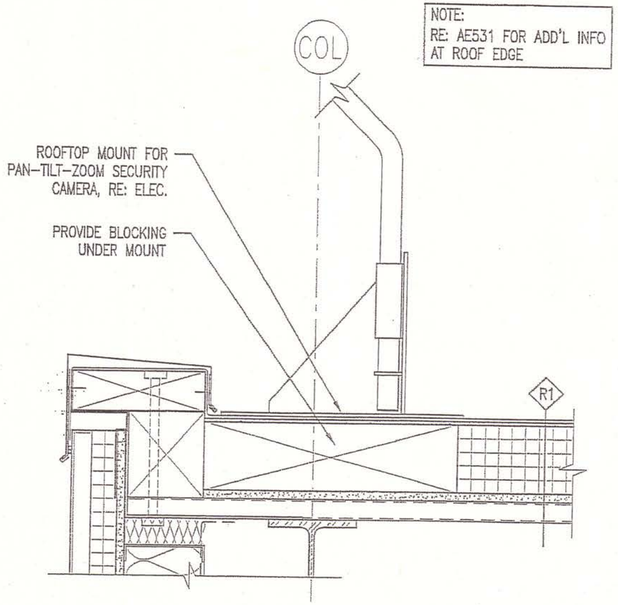


SMRT
ARCHITECTURE ENGINEERING PLANNING
SMRT
144 Fore Street/P.O.Box 618 PORTLAND, MAINE 04104
tel. (207) 772-3846 / fax. (207) 772-1070

PROJECT: MAINE TURNPIKE AUTHORITY ADMINISTRATION BUILDING

SUBJECT: ADDED J4/AE532

SCALE:	3/8"=1'-0"
CAD FILE:	AE532-06016
PROJECT No.	06016
REF. SHEET:	AE532
PM: SLB	ADDENDUM No. ADD-4
A/E: SLB	SKETCH No. A-10
DATE: 8-10-07	

© COPYRIGHT 2007 SMRT INC.

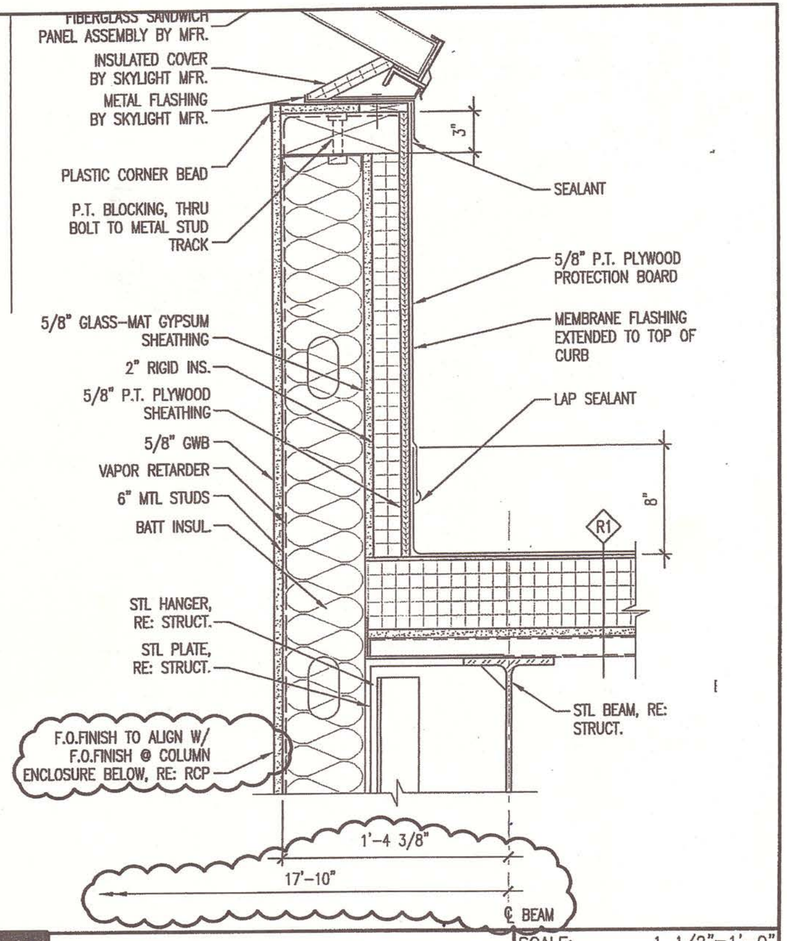



SMRT
ARCHITECTURE ENGINEERING PLANNING
SMRT
144 Fore Street/P.O.Box 618 PORTLAND, MAINE 04104
tel. (207) 772-3846 / fax. (207) 772-1070


PROJECT:	MAINE TURNPIKE AUTHORITY ADMINISTRATION BUILDING
SUBJECT:	REVISED A10/AE533 SECTION DETAIL @ SKYLIGHT

SCALE:	1 1/2"=1'-0"
CAD FILE:	AE533-06016
PROJECT No.	06016
REF. SHEET:	AE533
PM: SLB	ADDENDUM No. SI-
A/E: SLB	SKETCH No. A-2
DATE:	

RFI-51
+
SI-16
For Details

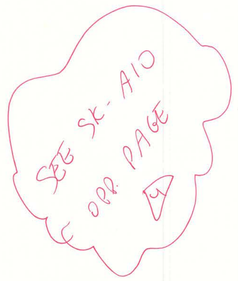

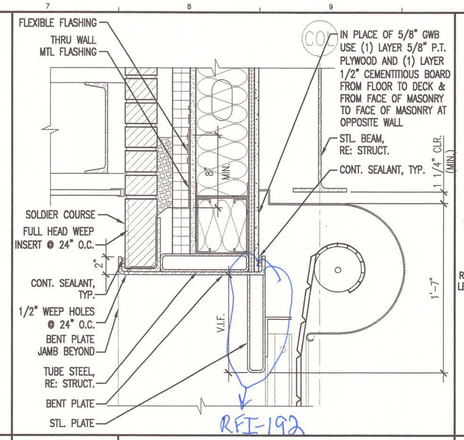


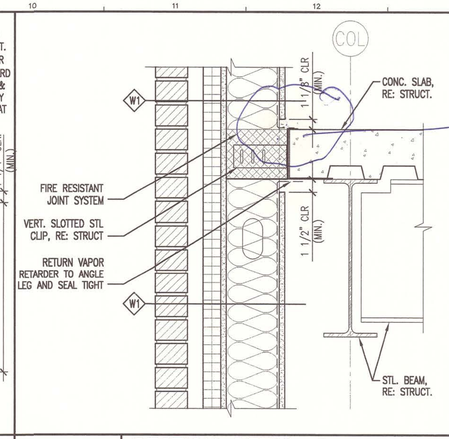


GENERAL NOTES:

1. SEE GI001 FOR PROJECT GENERAL NOTES.


J1	–	J4	–	J7	DETAIL @ OVERHEAD DOOR	J10	SECTION DETAIL @ EDGE OF FLOOR SLAB
*	–	*	–	1 1/2" = 1'–0"	–	1 1/2" = 1'–0"	–

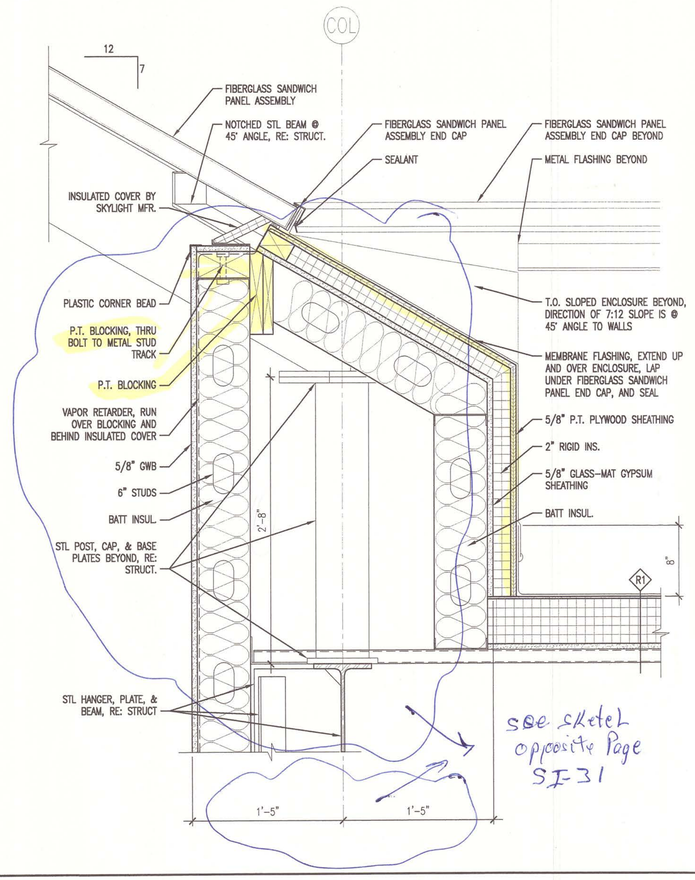


RFI-51
+
SI-16
For Details

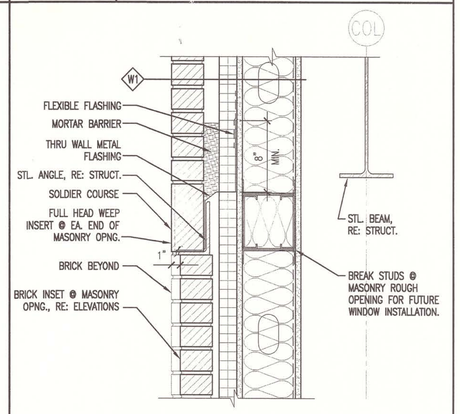

E7	–	E10	SECTION DETAIL @ HEAD OF INSET BRICK
*	–	1 1/2" = 1'–0"	–

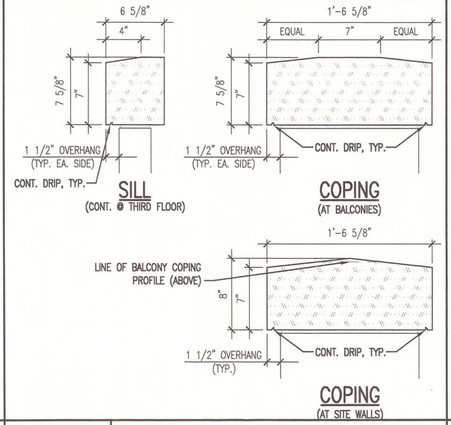

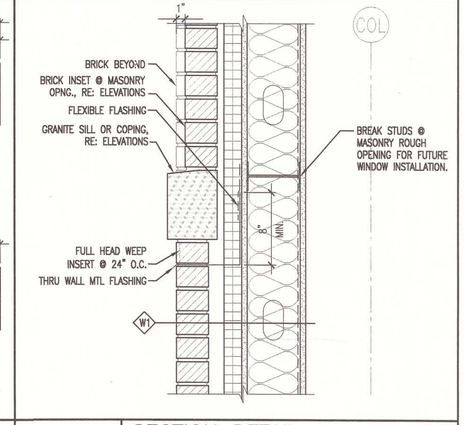

A1	SKYLIGHT VALLEY RAFTER & POST – ROOF ENCLOSURE	A7	EXTERIOR GRANITE PROFILES	A10	SECTION DETAIL @ SILL OF INSET BRICK
1 1/2" = 1'–0"	–	1 1/2" = 1'–0"	–	1 1/2" = 1'–0"	–

AS BUILT
Owner Copy

SMRT
ARCHITECTURE ENGINEERING PLANNING
SMRT
144 Fore Street/P.O. Box 618
Portland, Maine 04104
tel. (207) 772-3846
fax. (207) 772-1070

STATE OF MAINE
SCOTT L BENSON
No. 1772
REGISTERED PROFESSIONAL ARCHITECT

PROJECT TITLE:
MAINE TURNPIKE AUTHORITY
ADMINISTRATION BUILDING
PORTLAND, MAINE

CURRENT ISSUE STATUS:
ISSUED FOR BIDDING/CONSTRUCTION
7-9-07

REV	DESCRIPTION	DATE
0	BIDDING/CONSTRUCTION	7-9-07


GRAPHIC SCALE: 0" 1"

SCALE:	AS NOTED
PROJECT MANAGER:	SLB
JC/DRAWN BY:	TCM/TCM
A/E OF RECORD:	SLB
CAD FILE:	AE532-06016
PROJECT NO:	06016
DATE:	7-9-07

SHEET TITLE:
BUILDING AND WALL DETAILS

SHEET No.
AE532

© COPYRIGHT 2007 SMRT INC.

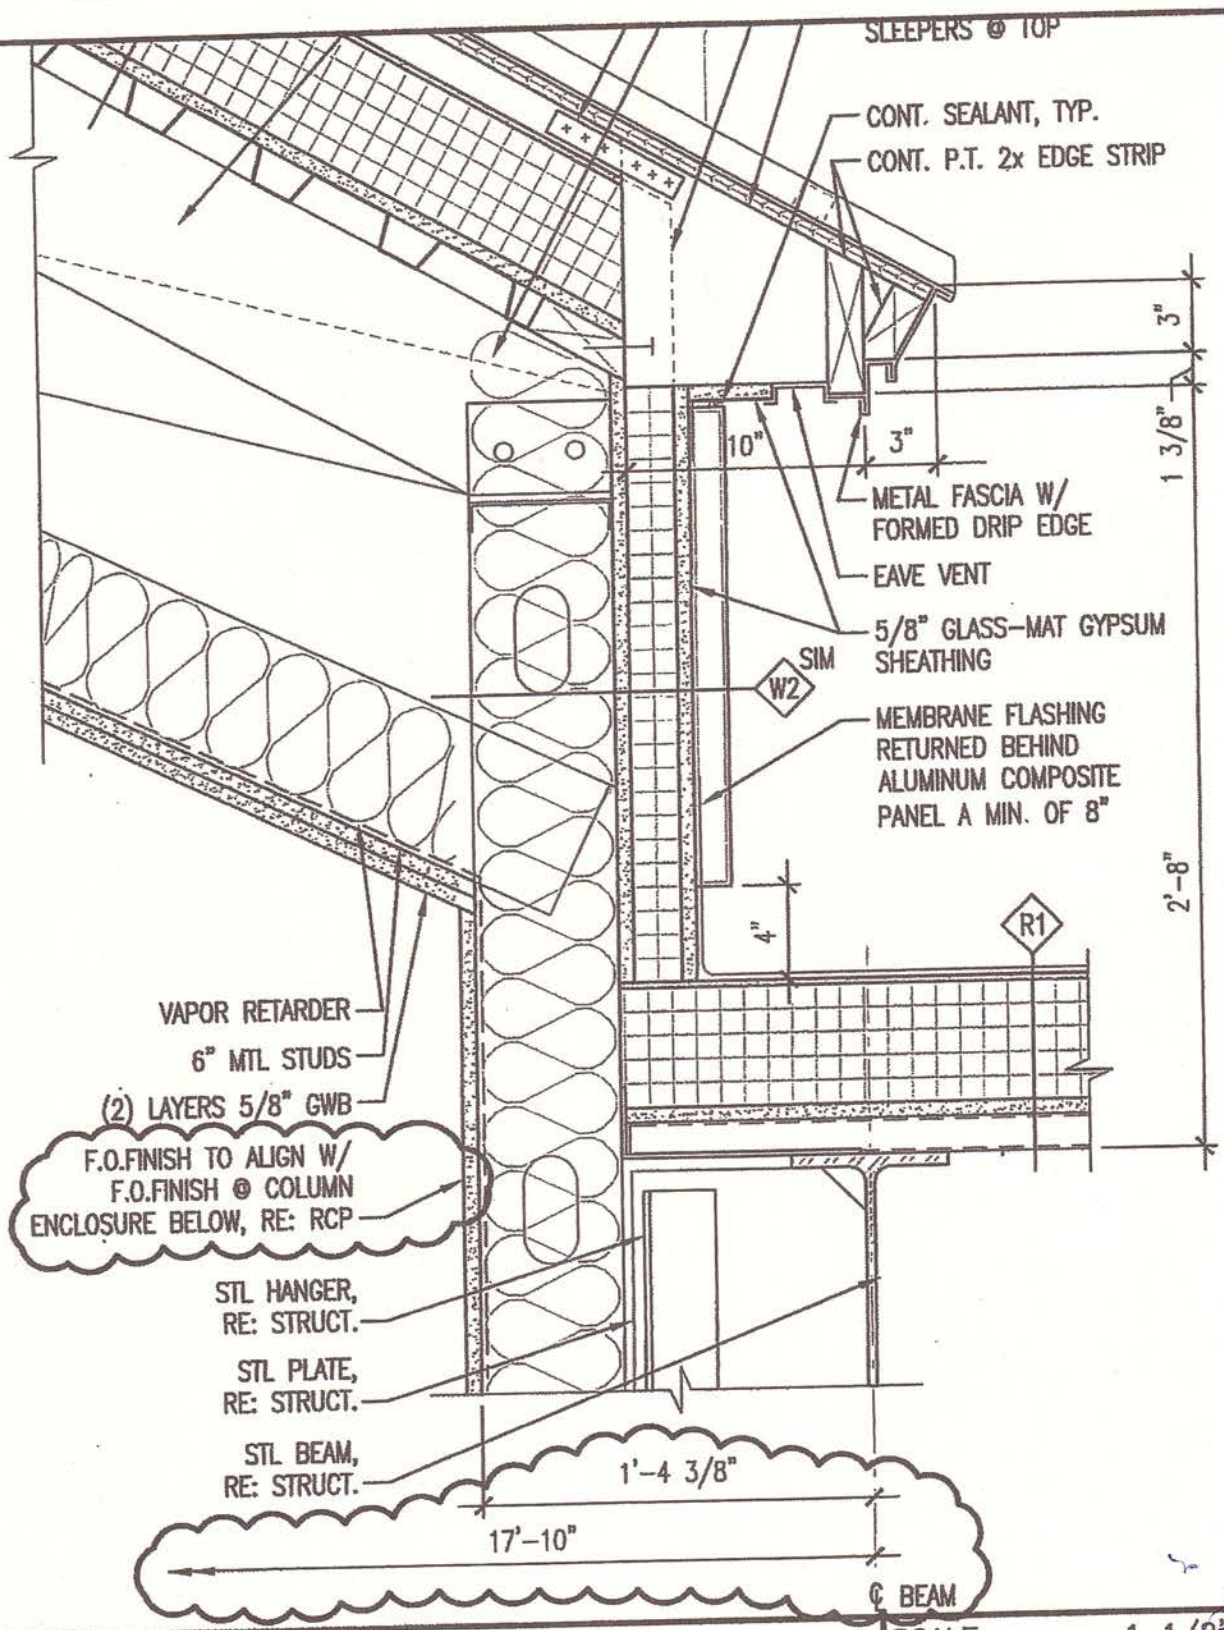

SMRT


ARCHITECTURE ENGINEERING PLANNING

SMRT
144 Fore Street/P.O.Box 618 PORTLAND, MAINE 04104
tel. (207) 772-3846 / fax. (207) 772-1070


SCALE:	1 1/2"=1'-0"
CAD FILE:	AE533-06016
PROJECT No.	06016
REF. SHEET:	AE533
PM: SLB	ADDENDUM No. SI-
A/E: SLB	SKETCH No. A-1
DATE:	

PROJECT: MAINE TURNPIKE AUTHORITY ADMINISTRATION BUILDING

SUBJECT: REVISED A10/AE533 SECTION DETAIL @ CLERESTORY ROOF EDGE

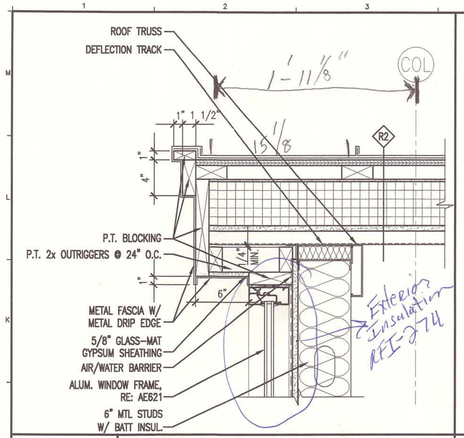

J1	SECTION DETAIL @ CLERESTORY ROOF RAKE
1 1/2" = 1'-0"	–

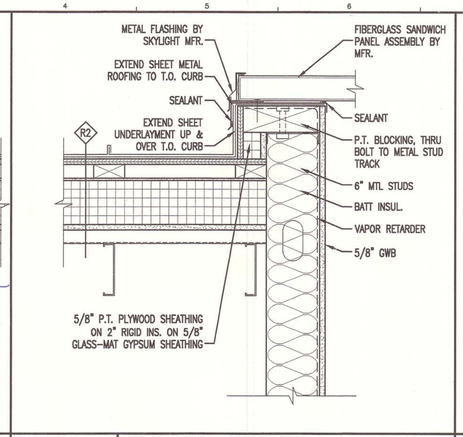


J4	SECTION DETAIL @ METAL ROOF & SKYLIGHT
1 1/2" = 1'-0"	–

J7	–
1 1/2" = 1'-0"	–


J10	–
1 1/2" = 1'-0"	–

GENERAL NOTES:


1. SEE G1001 FOR PROJECT GENERAL NOTES.

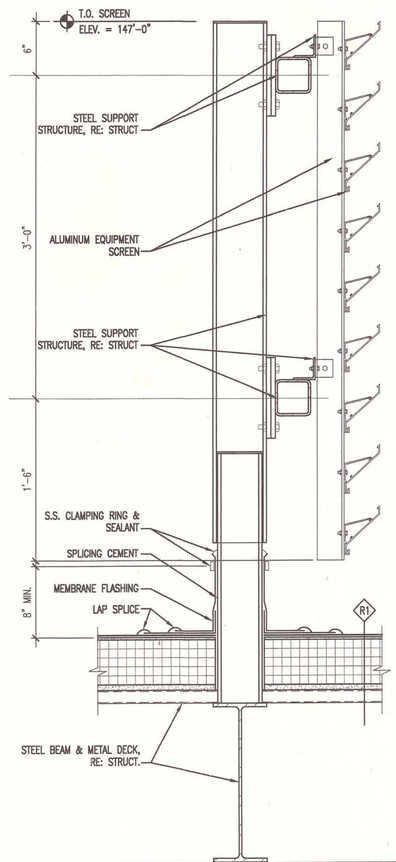


A1	SECTION DETAIL @ EQUIPMENT SCREEN
1 1/2" = 1'-0"	–

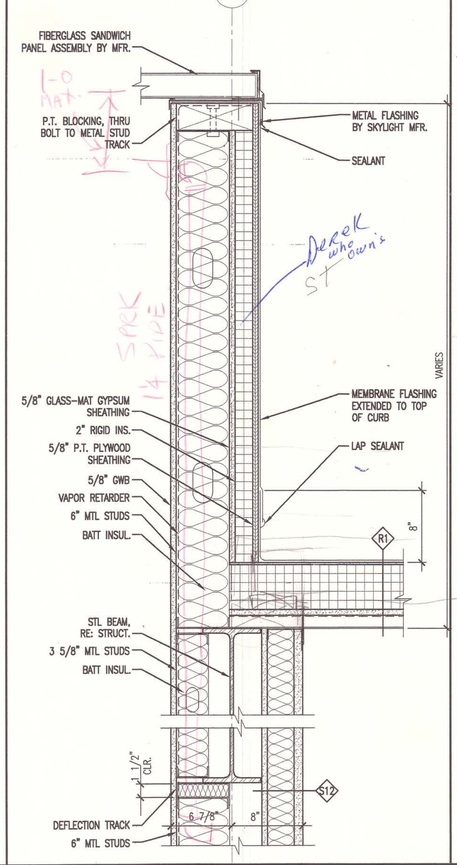

A4	SECTION DETAIL @ SKYLIGHT
1 1/2" = 1'-0"	–

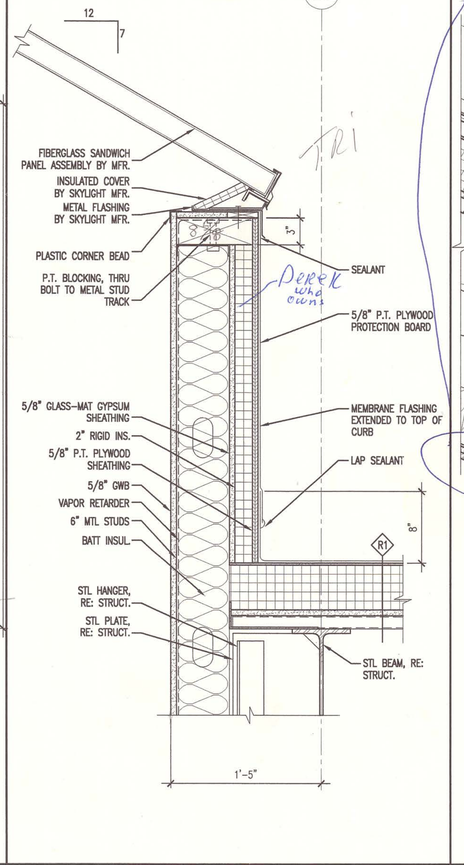

A7	SECTION DETAIL @ SKYLIGHT
1 1/2" = 1'-0"	–

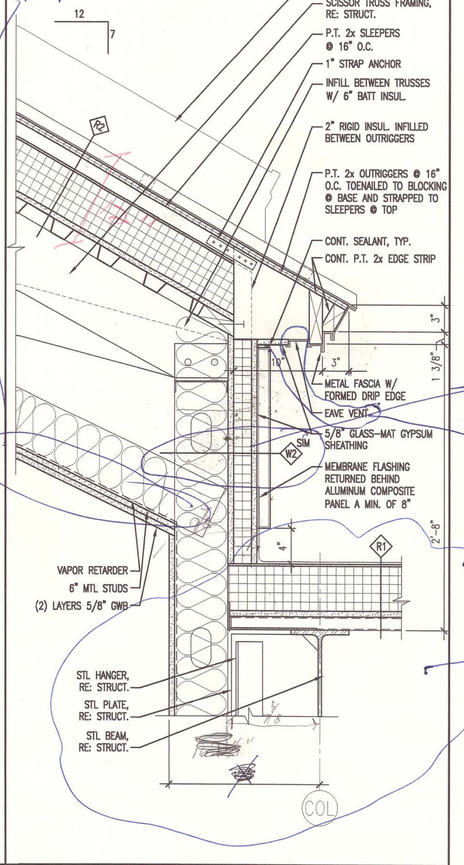

A10	SECTION DETAIL @ CLEAR STORY ROOF EDGE
1 1/2" = 1'-0"	–

AS BUILT
Owner Copy

SMRT
ARCHITECTURE ENGINEERING PLANNING
144 Fore Street/P.O. Box 618
Portland, Maine 04104
tel. (207) 772-3846
fax. (207) 772-1070

STATE OF MAINE
SCOTT L BENSON
No. 1772
REGISTERED PROFESSIONAL ARCHITECT

PROJECT TITLE:
MAINE TURNPIKE AUTHORITY
ADMINISTRATION BUILDING
PORTLAND, MAINE

CURRENT ISSUE STATUS:
ISSUED FOR BIDDING/CONSTRUCTION
7-9-07


REV	DESCRIPTION	DATE
0	BIDDING/CONSTRUCTION	7-9-07

GRAPHIC SCALE: 0" 1"


SCALE:	AS NOTED
PROJECT MANAGER:	SLB
JC/DRAWN BY:	TCM/TCM
A/E OF RECORD:	SLB
CAD FILE:	AE533-06016
PROJECT NO:	06016
DATE:	7-9-07

SHEET TITLE:
BUILDING AND WALL SECTION DETAILS


SHEET No.
AE533

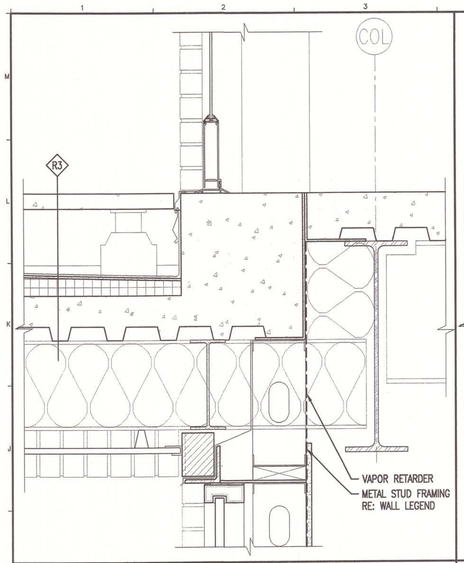


H1	SECTION DETAIL @ BALCONY
1 1/2" = 1'-0"	–

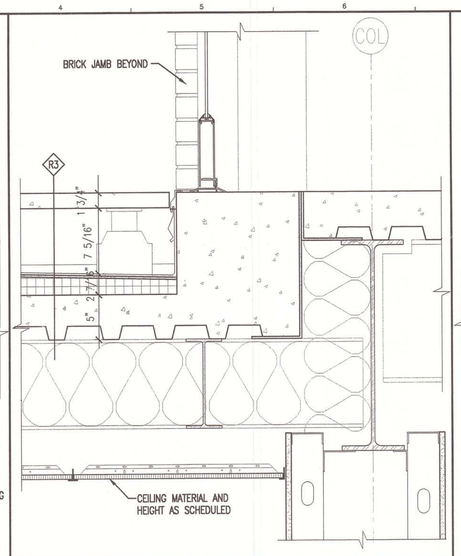


H4	SECTION DETAIL @ BALCONY
1 1/2" = 1'-0"	–

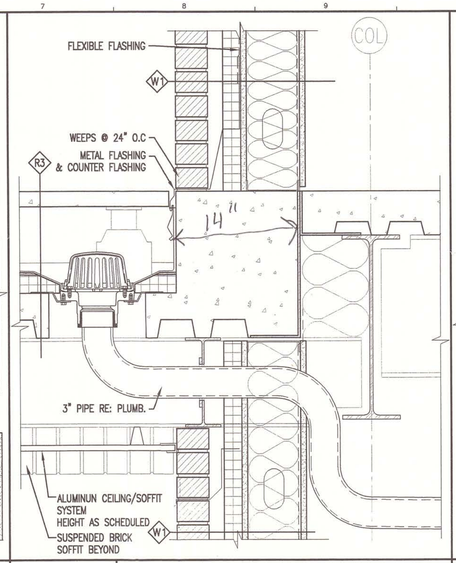


H7	SECTION DETAIL @ BALCONY
1 1/2" = 1'-0"	–

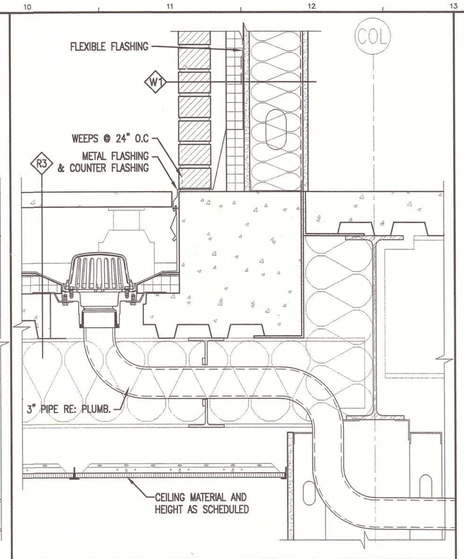


H10	SECTION DETAIL @ BALCONY
1 1/2" = 1'-0"	–

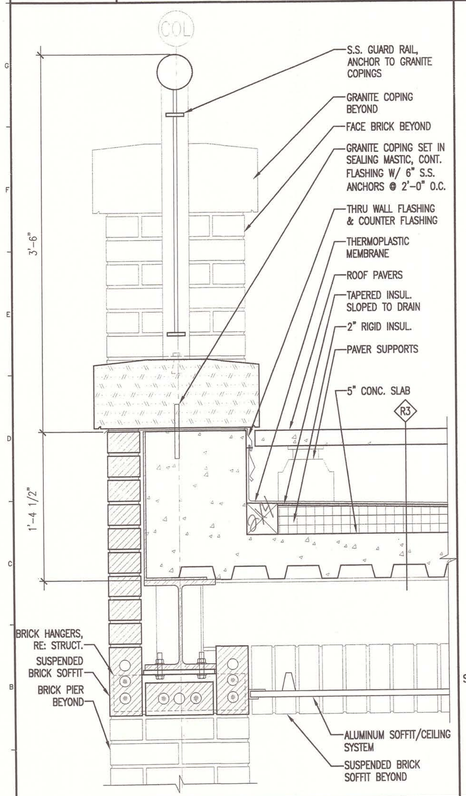


A1	SECTION DETAIL @ BALCONY
1 1/2" = 1'-0"	–

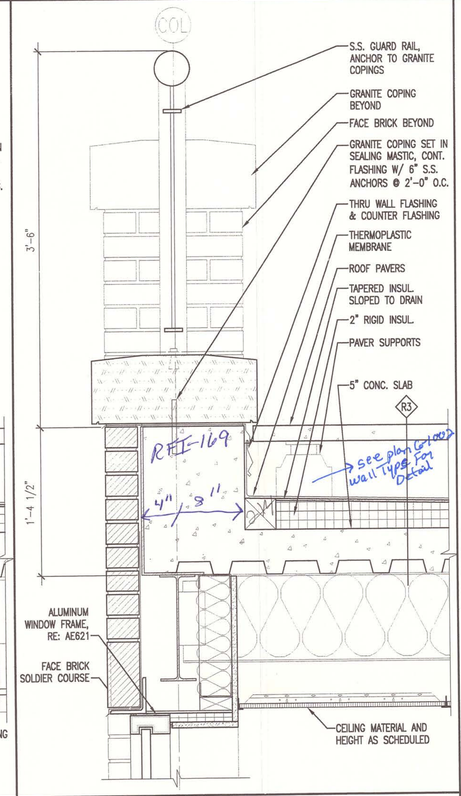

A4	SECTION DETAIL @ BALCONY
1 1/2" = 1'-0"	–

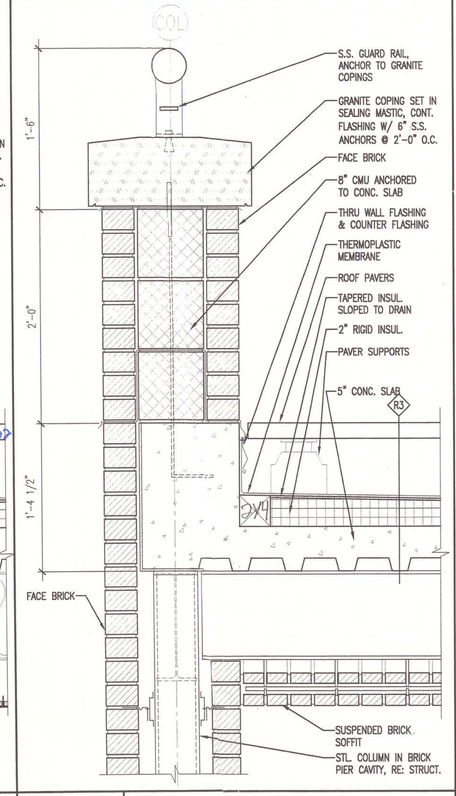

A7	SECTION DETAIL @ BALCONY
1 1/2" = 1'-0"	–

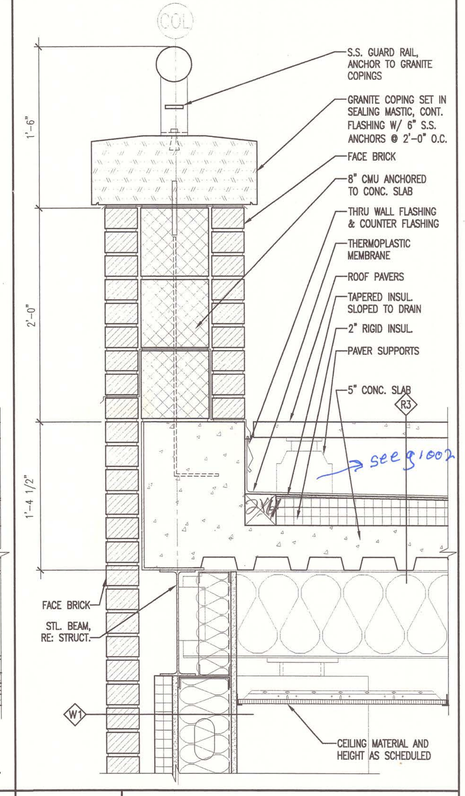

A10	SECTION DETAIL @ BALCONY
1 1/2" = 1'-0"	–

GENERAL NOTES:

1. SEE G1001 FOR PROJECT GENERAL NOTES.

AS BUILT
Owner Copy

SMRT
ARCHITECTURE ENGINEERING PLANNING
SMRT
144 Fore Street / P.O. Box 618
Portland, Maine 04104
tel. (207) 772-3846
fax. (207) 772-1070

STATE OF MAINE
SCOTT L. BENSON
No. 1772
REGISTERED PROFESSIONAL ARCHITECT

PROJECT TITLE:
MAINE TURNPIKE AUTHORITY
ADMINISTRATION BUILDING
PORTLAND, MAINE

CURRENT ISSUE STATUS:
ISSUED FOR BIDDING/CONSTRUCTION
7-9-07

REV	DESCRIPTION	DATE
0	BIDDING/CONSTRUCTION	7-9-07

GRAPHIC SCALE: 0" 1"

SCALE:	AS NOTED
PROJECT MANAGER:	SLB
JC/DRAWN BY:	TCM/TCM
A/E OF RECORD:	SLB
CAD FILE:	AE534-06016
PROJECT NO:	06016
DATE:	7-9-07


SHEET TITLE:
BUILDING AND WALL
SECTION DETAILS

SHEET No.
AE534


©COPYRIGHT 2007 SMRT INC

GENERAL NOTES:


1. SEE G1001 FOR PROJECT GENERAL NOTES.

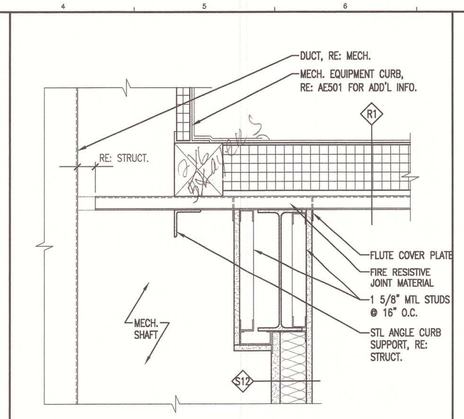


J4	MECHANICAL SHAFT DETAIL
1 1/2" = 1'-0"	–

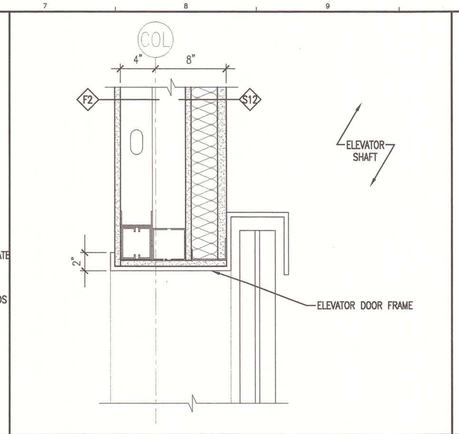


J7	ELEVATOR DOOR HEAD DETAIL
1 1/2" = 1'-0"	–

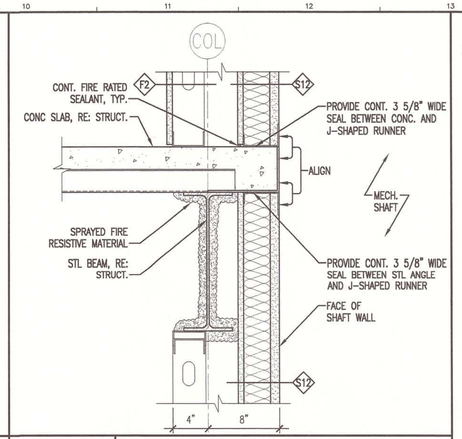


J10	MECHANICAL SHAFT DETAIL
1 1/2" = 1'-0"	–

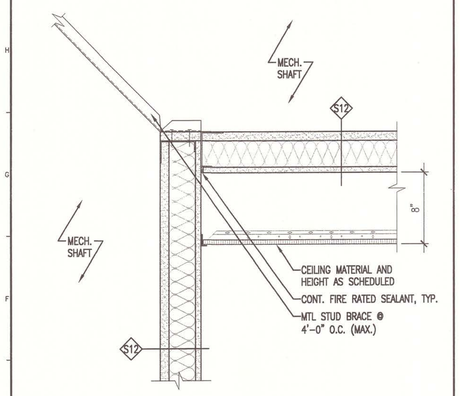


E1	MECHANICAL SHAFT DETAIL
1 1/2" = 1'-0"	–

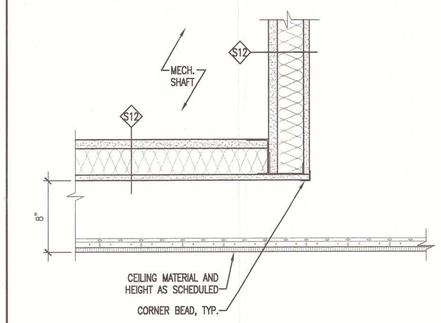


E4	MECHANICAL SHAFT DETAIL
1 1/2" = 1'-0"	–

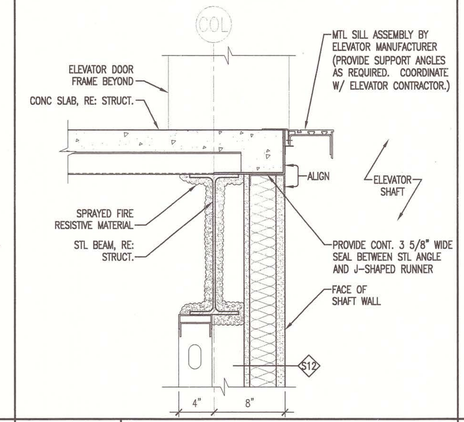


E7	ELEVATOR SHAFT DETAIL
1 1/2" = 1'-0"	–

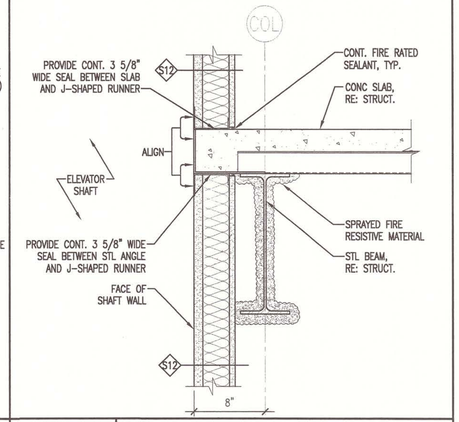


E10	ELEVATOR SHAFT DETAIL
1 1/2" = 1'-0"	–

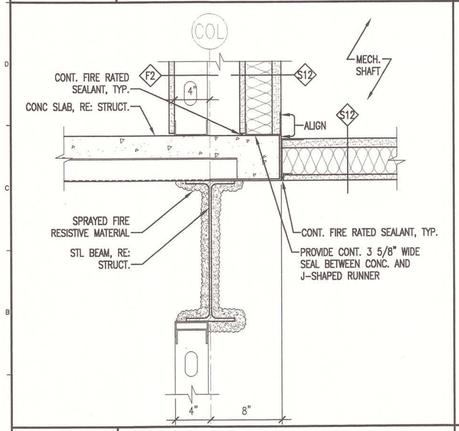


A1	MECHANICAL SHAFT DETAIL
1 1/2" = 1'-0"	–

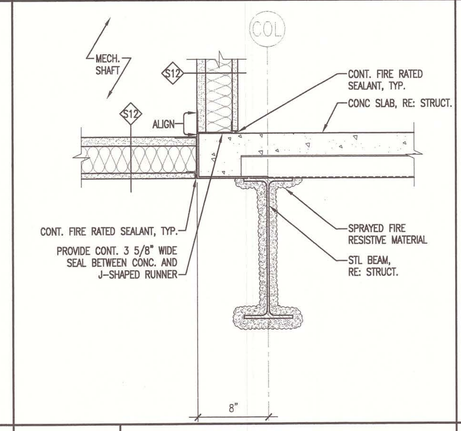

A4	MECHANICAL SHAFT DETAIL
1 1/2" = 1'-0"	–

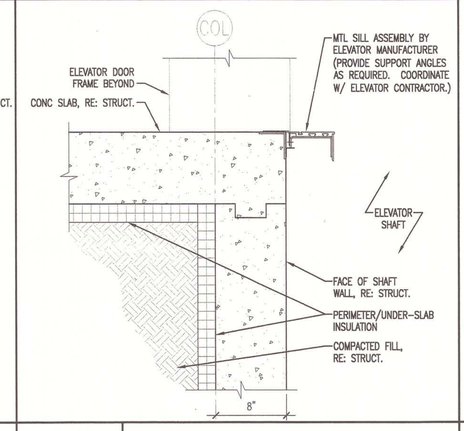

A7	ELEVATOR SHAFT DETAIL
1 1/2" = 1'-0"	–

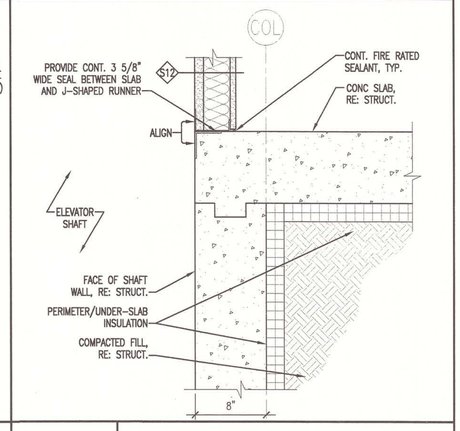

A10	ELEVATOR SHAFT DETAIL
1 1/2" = 1'-0"	–

AS BUILT
Owner Copy

SMRT
ARCHITECTURE ENGINEERING PLANNING
SMRT
144 Fore Street/P.O. Box 618
Portland, Maine 04104
tel. (207) 772-3846
fax. (207) 772-1070

STATE OF MAINE
SCOTT L BENSON
No. 1772
REGISTERED PROFESSIONAL ARCHITECT

PROJECT TITLE:
MAINE TURNPIKE AUTHORITY
ADMINISTRATION BUILDING
PORTLAND, MAINE

CURRENT ISSUE STATUS:
ISSUED FOR BIDDING/CONSTRUCTION
7-9-07

REV	DESCRIPTION	DATE
0	BIDDING/CONSTRUCTION	7-9-07


GRAPHIC SCALE: 0" 1"


SCALE:	AS NOTED
PROJECT MANAGER:	SLB
JC/DRAWN BY:	TCM/TCM
A/E OF RECORD:	SLB
CAD FILE:	AE535-06016
PROJECT NO:	06016
DATE:	7-9-07

SHEET TITLE:
BUILDING AND WALL SECTION DETAILS

SHEET No.
AE535

© COPYRIGHT 2007 SMRT INC

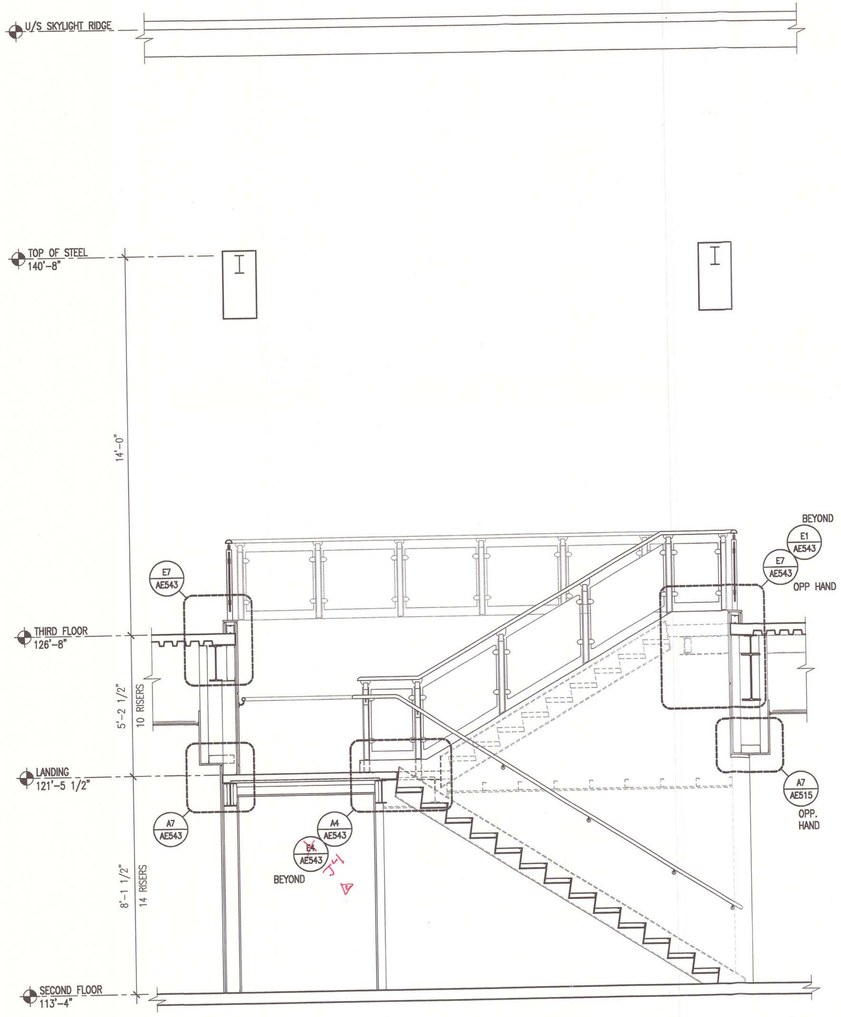

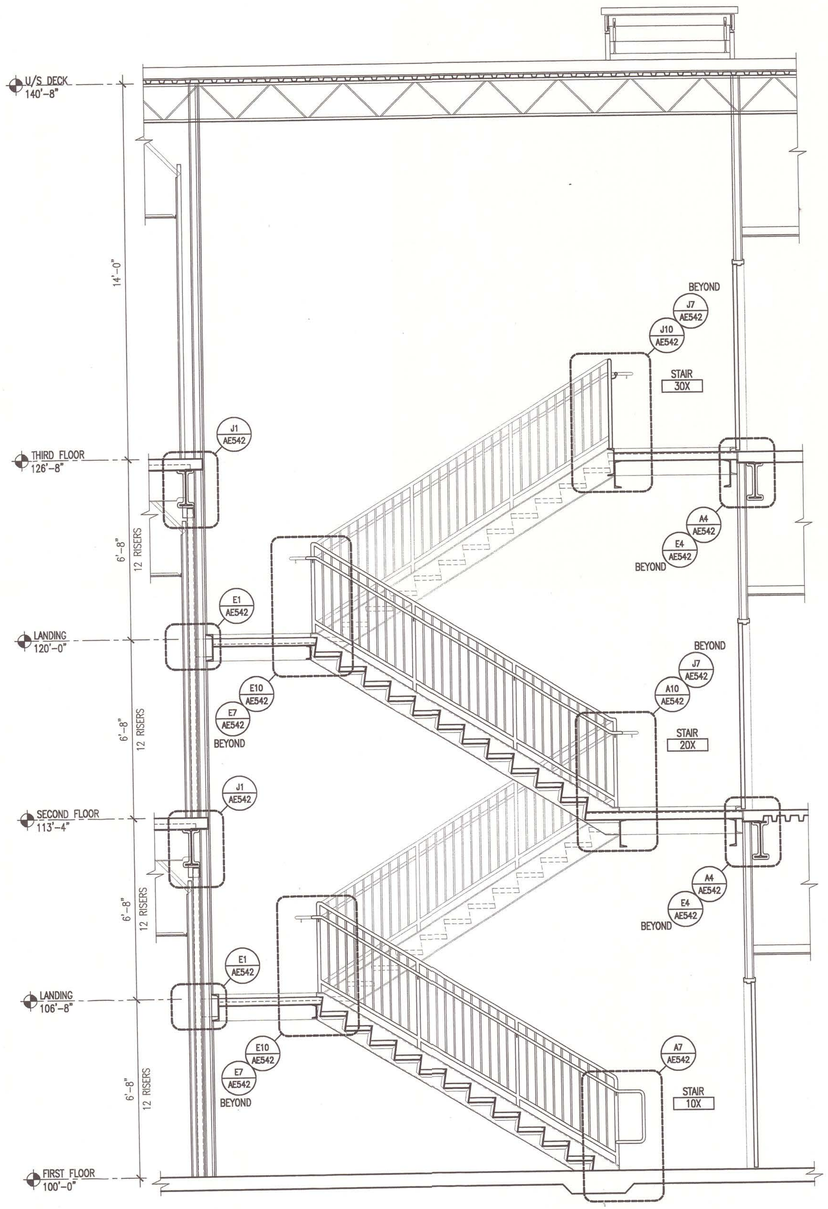

GENERAL NOTES:

1. SEE GI001 FOR PROJECT GENERAL NOTES.

A1	STAIR SECTION
3/8" = 1'-0"	–

A7	STAIR SECTION
3/8" = 1'-0"	–

AS BUILT
Owner Copy

SMRT
ARCHITECTURE ENGINEERING PLANNING
SMRT
144 Fore Street / P.O. Box 618
Portland, Maine 04104
tel. (207) 772-3846
fax. (207) 772-1070

STATE OF MAINE
SCOTT
L
BENSON
No. 1772
REGISTERED
PROFESSIONAL ARCHITECT

PROJECT TITLE:
MAINE TURNPIKE AUTHORITY
ADMINISTRATION BUILDING
PORTLAND, MAINE

CURRENT ISSUE STATUS:
ISSUED FOR BIDDING/CONSTRUCTION
7-9-07

REV	DESCRIPTION	DATE
0	BIDDING/CONSTRUCTION	7-9-07


GRAPHIC SCALE: 0" 1"

SCALE:	AS NOTED
PROJECT MANAGER:	SLB
JC/DRAWN BY:	TCM/TCM
A/E OF RECORD:	SLB
CAD FILE:	AE541-06016
PROJECT NO:	06016
DATE:	7-9-07


SHEET TITLE:
STAIR
SECTIONS & DETAILS

SHEET No.
AE541


©COPYRIGHT 2007 SMRT INC.

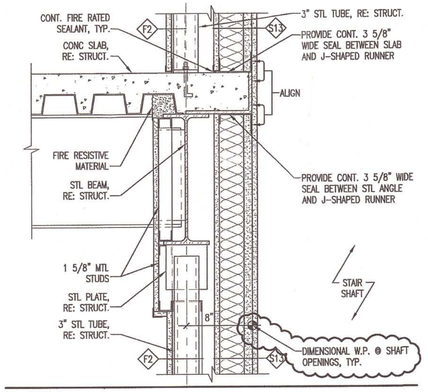


SMRT	ARCHITECTURE ENGINEERING PLANNING SMRT 144 Fore Street/P.O.Box 618 PORTLAND, MAINE 04104 tel. (207) 772-3846 / fax. (207) 772-1070	SCALE:	1 1/2"=1'-0"
		CAD FILE:	AE542-06016
		PROJECT No.	06016
		REF. SHEET:	AE542
PROJECT:	MAINE TURNPIKE AUTHORITY ADMINISTRATION BUILDING	PM: SLB	SUPPLEMENTAL INSTRUCTION RFI #1-120
SUBJECT:	REVISED J1/AE542 FOR DIMENSIONAL CLARIFICATION	A/E: SLB	SKETCH No. A-5
		DATE:	© COPYRIGHT 2008 SMRT INC.

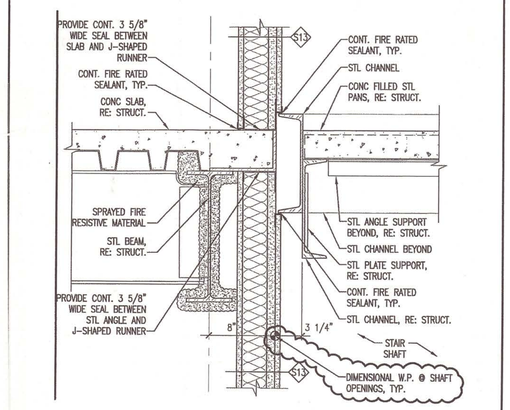


SMRT	ARCHITECTURE ENGINEERING PLANNING SMRT 144 Fore Street/P.O.Box 618 PORTLAND, MAINE 04104 tel. (207) 772-3846 / fax. (207) 772-1070	SCALE:	1 1/2"=1'-0"
		CAD FILE:	AE542-06016
		PROJECT No.	06016
		REF. SHEET:	AE542
PROJECT:	MAINE TURNPIKE AUTHORITY ADMINISTRATION BUILDING	PM: SLB	SUPPLEMENTAL INSTRUCTION RFI #1-120
SUBJECT:	REVISED E4/AE542 FOR DIMENSIONAL CLARIFICATION	A/E: SLB	SKETCH No. A-4
		DATE:	© COPYRIGHT 2008 SMRT INC.

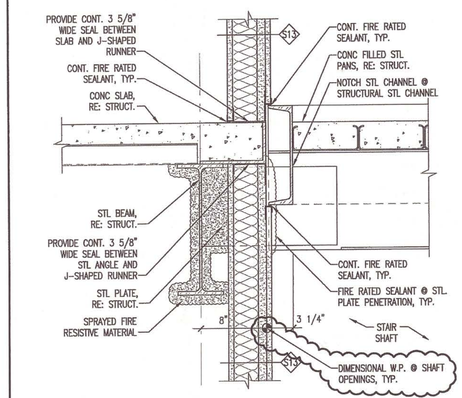


SMRT	ARCHITECTURE ENGINEERING PLANNING SMRT 144 Fore Street/P.O.Box 618 PORTLAND, MAINE 04104 tel. (207) 772-3846 / fax. (207) 772-1070	SCALE:	1 1/2"=1'-0"
		CAD FILE:	AE542-06016
		PROJECT No.	06016
		REF. SHEET:	AE542
PROJECT:	MAINE TURNPIKE AUTHORITY ADMINISTRATION BUILDING	PM: SLB	SUPPLEMENTAL INSTRUCTION RFI #1-120
SUBJECT:	REVISED J4/AE542 FOR DIMENSIONAL CLARIFICATION	A/E: SLB	SKETCH No. A-6
		DATE:	© COPYRIGHT 2008 SMRT INC.

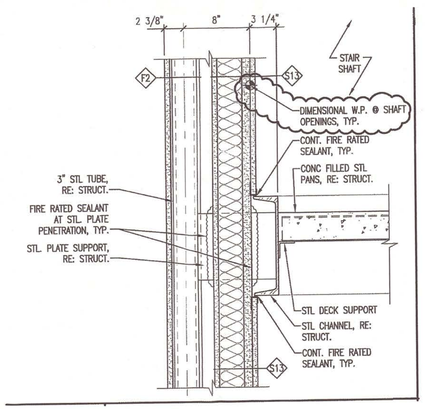


SMRT	ARCHITECTURE ENGINEERING PLANNING SMRT 144 Fore Street/P.O.Box 618 PORTLAND, MAINE 04104 tel. (207) 772-3846 / fax. (207) 772-1070	SCALE:	1 1/2"=1'-0"
		CAD FILE:	AE542-06016
		PROJECT No.	06016
		REF. SHEET:	AE542
PROJECT:	MAINE TURNPIKE AUTHORITY ADMINISTRATION BUILDING	PM: SLB	SUPPLEMENTAL INSTRUCTION RFI #1-120
SUBJECT:	REVISED E1/AE542 FOR DIMENSIONAL CLARIFICATION	A/E: SLB	SKETCH No. A-3
		DATE:	© COPYRIGHT 2008 SMRT INC.

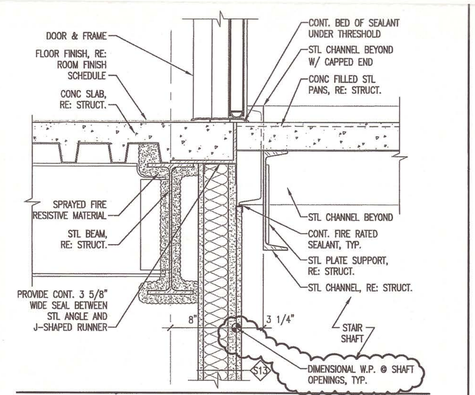


SMRT	ARCHITECTURE ENGINEERING PLANNING SMRT 144 Fore Street/P.O.Box 618 PORTLAND, MAINE 04104 tel. (207) 772-3846 / fax. (207) 772-1070	SCALE:	1 1/2"=1'-0"
		CAD FILE:	AE542-06016
		PROJECT No.	06016
		REF. SHEET:	AE542
ROJECT:	MAINE TURNPIKE AUTHORITY ADMINISTRATION BUILDING	PM: SLB	SUPPLEMENTAL INSTRUCTION RFI #1-120
UBJECT:	REVISED A4/AE542 FOR DIMENSIONAL CLARIFICATION	A/E: SLB	SKETCH No. A-2
		DATE:	© COPYRIGHT 2008 SMRT INC.

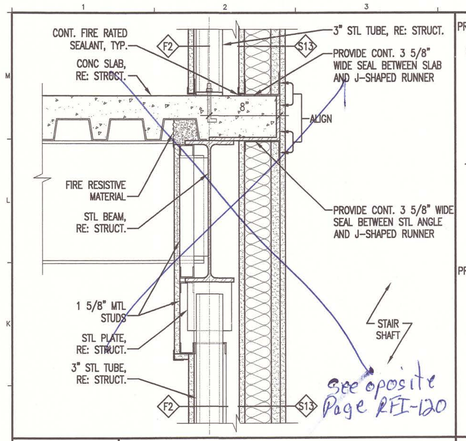


J1	STAIR SHAFT DETAIL
1 1/2" = 1'-0"	–

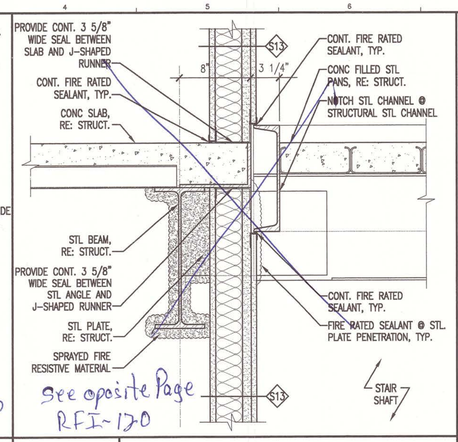

J4	STAIR SHAFT DETAIL
1 1/2" = 1'-0"	–

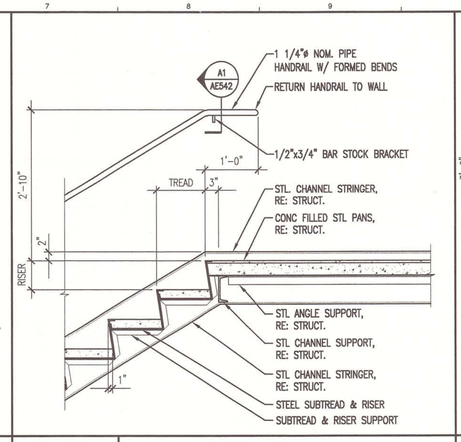


J7	STAIR DETAIL
3/4" = 1'-0"	–

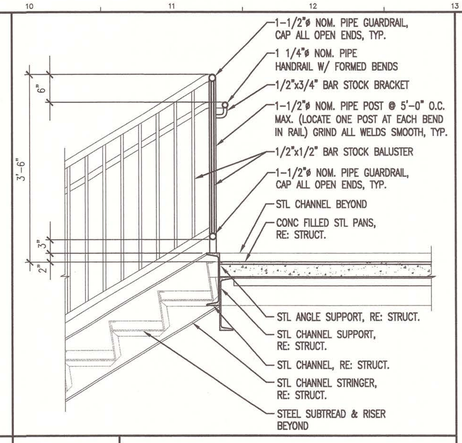


J10	STAIR DETAIL
3/4" = 1'-0"	–

GENERAL NOTES:


1. SEE G1001 FOR PROJECT GENERAL NOTES.

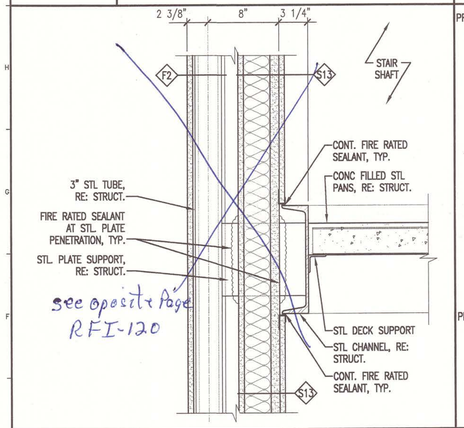


E1	STAIR SHAFT DETAIL
1 1/2" = 1'-0"	–

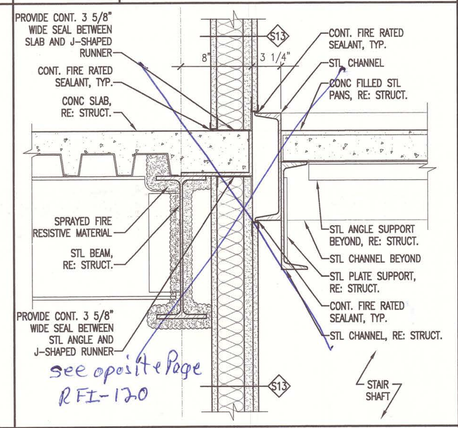

E4	STAIR SHAFT DETAIL
1 1/2" = 1'-0"	–

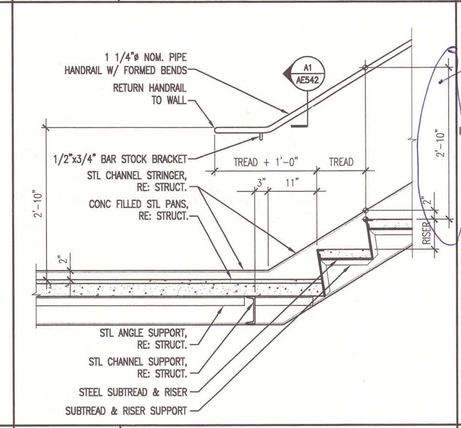


E7	STAIR DETAIL
3/4" = 1'-0"	–

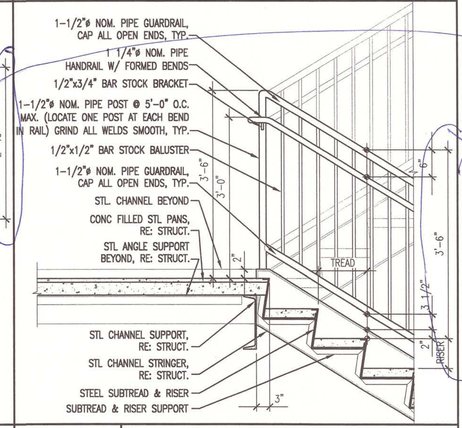


RFI-352, +363
Railing & HTs


E10	STAIR DETAIL
3/4" = 1'-0"	–

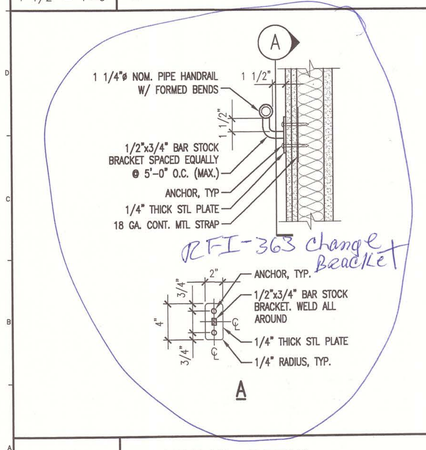


A1	HANDRAIL DETAIL
1 1/2" = 1'-0"	–

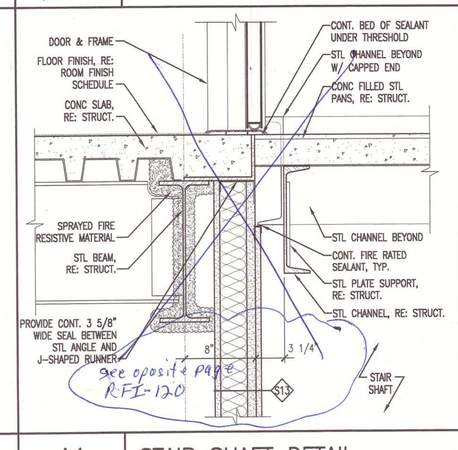

A4	STAIR SHAFT DETAIL
1 1/2" = 1'-0"	–

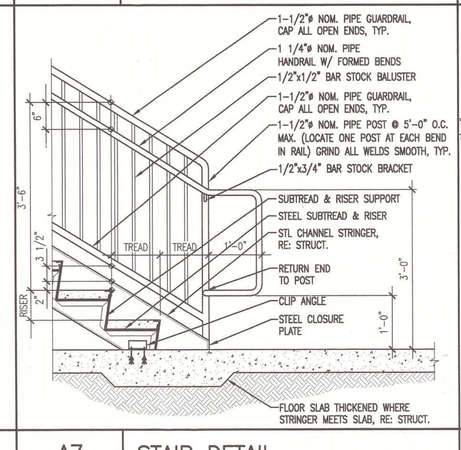

A7	STAIR DETAIL
3/4" = 1'-0"	–

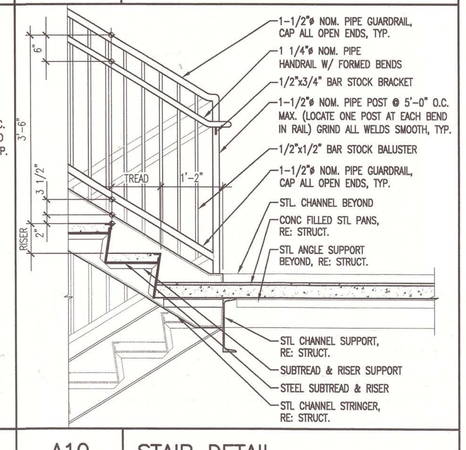

A10	STAIR DETAIL
3/4" = 1'-0"	–

AS BUILT
Owner Copy

SMRT
ARCHITECTURE ENGINEERING PLANNING
SMRT
144 Fore Street / P.O. Box 618
Portland, Maine 04104
tel. (207) 772-3846
fax. (207) 772-1070

STATE OF MAINE
SCOTT L BENSON
No. 11773
REGISTERED PROFESSIONAL ARCHITECT

PROJECT TITLE:
MAINE TURNPIKE AUTHORITY
ADMINISTRATION BUILDING
PORTLAND, MAINE

CURRENT ISSUE STATUS:
ISSUED FOR BIDDING/CONSTRUCTION
7-9-07

REV	DESCRIPTION	DATE
0	BIDDING/CONSTRUCTION	7-9-07


GRAPHIC SCALE: 0" 1"

SCALE:	AS NOTED
PROJECT MANAGER:	SLB
JC/DRAWN BY:	TCM/TCM
A/E OF RECORD:	SLB
CAD FILE:	AE542-06016
PROJECT NO:	06016
DATE:	7-9-07

SHEET TITLE:
STAIR DETAILS

SHEET No.
AE542

© COPYRIGHT 2007 SMRT INC.

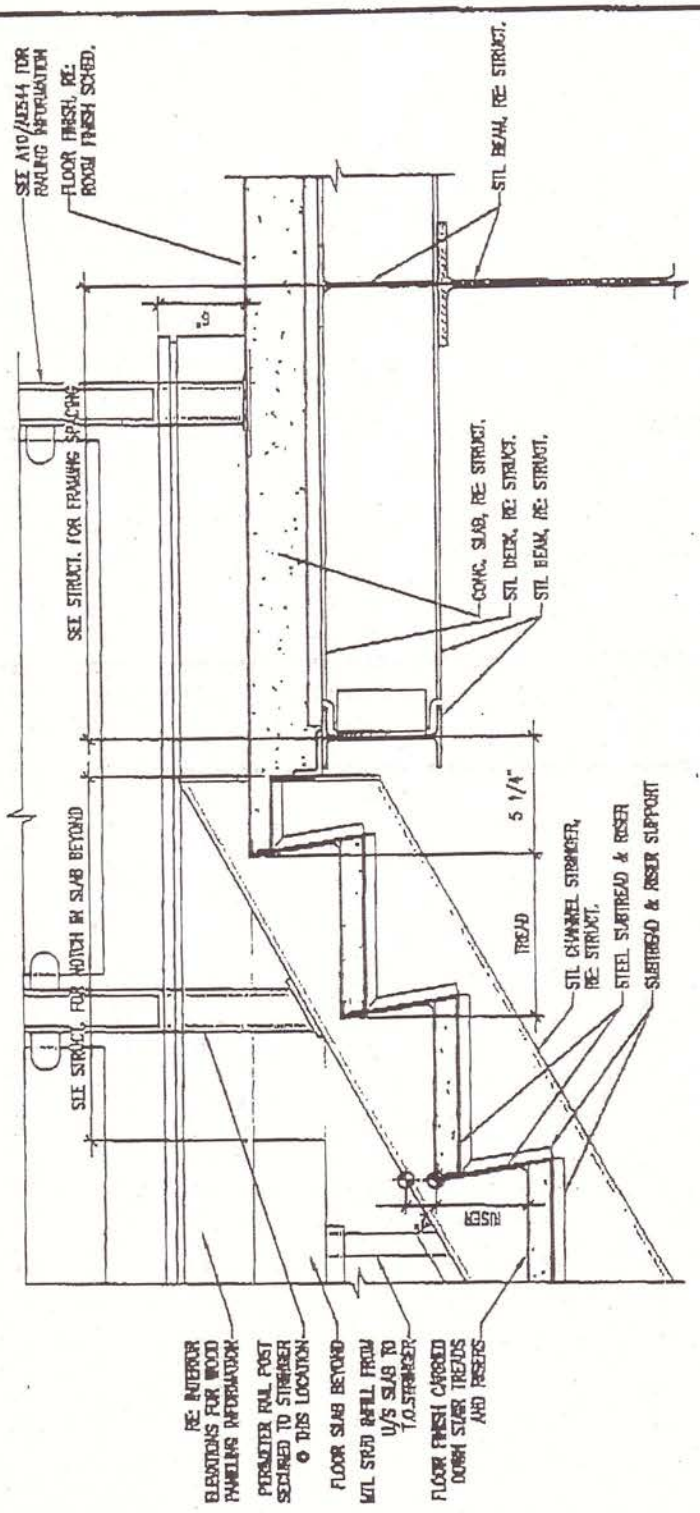

SMRT

ARCHITECTURE ENGINEERING PLANNING


SMRT
144 Fore Street/P.O.Box 618 PORTLAND, MAINE 04104
tel. (207) 772-3846 / fax. (207) 772-1070

SCALE:	1"=1'-0"
CAD FILE:	AE543-06016
PROJECT No.	06016
REF. SHEET:	AE543
PM: SLB	ADDENDUM no. ADD-2
A/E: SLB	SECTION No. A-2
DATE: 8-3-07	

PROJECT: MAINE TURNPIKE AUTHORITY ADMINISTRATION BUILDING


SUBJECT: ADDED E1/AE543 SECTION DETAIL @ TOP OF STAIR

© COPYRIGHT 2007 SMRT INC.

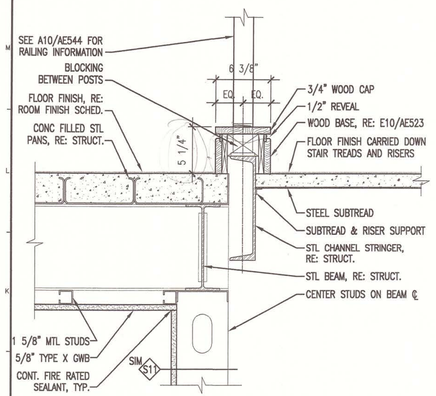


J E1 ▷ SECTION @ STAIR

1 1/2" = 1'-0" –

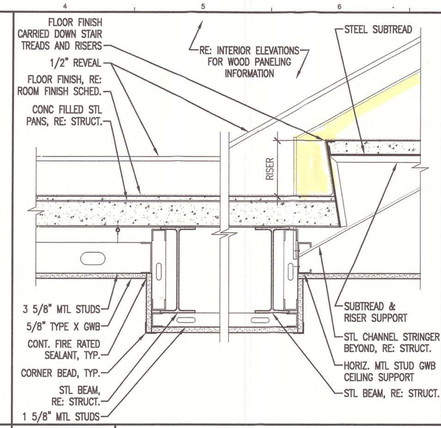


J E4 ▷ SECTION @ STAIR

1 1/2" = 1'-0" –

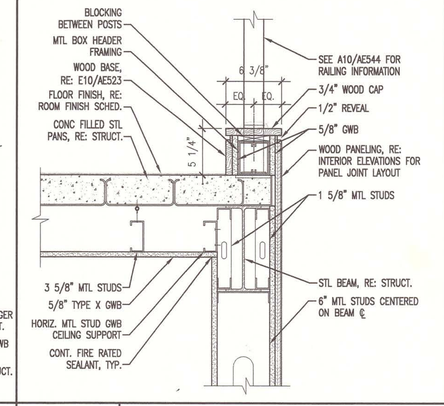

J E7 ▷ SECTION @ STAIR

1 1/2" = 1'-0" –

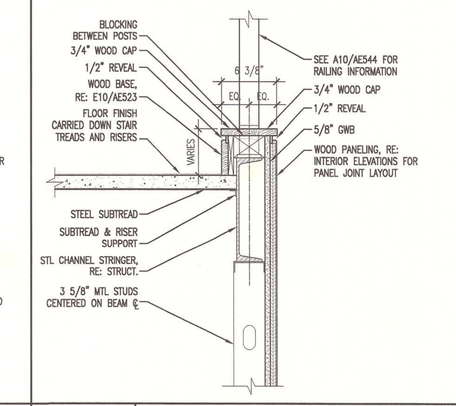


J E10 ▷ SECTION @ STAIR

1 1/2" = 1'-0" –


GENERAL NOTES:

1. SEE GI001 FOR PROJECT GENERAL NOTES.

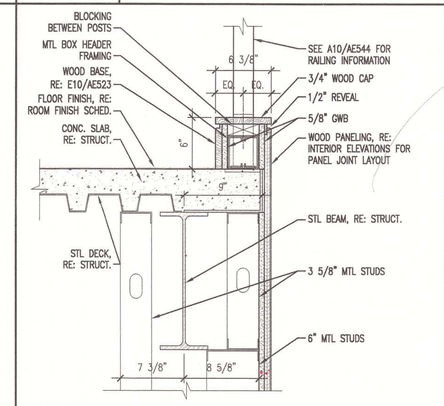


E7 SECTION @ STAIR

1 1/2" = 1'-0" –

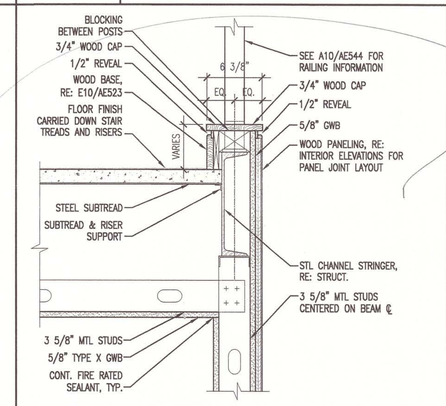


E10 SECTION @ STAIR

1 1/2" = 1'-0" –

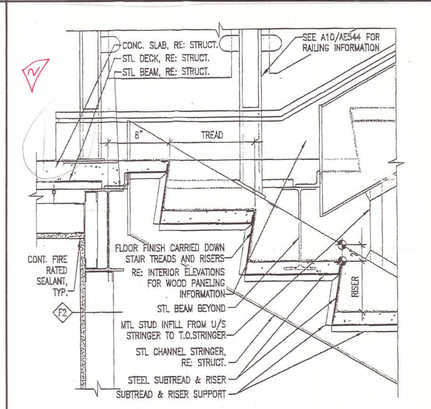


A4 – SECTION @ BEAM

1 1/2" = 1'-0" –

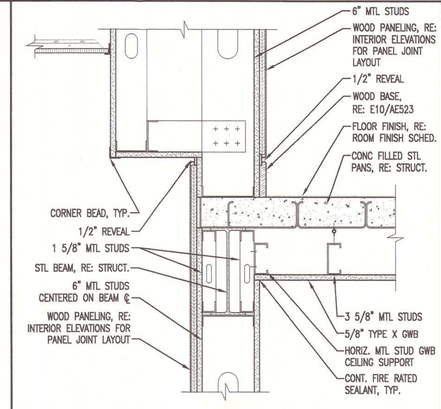

A7 SECTION @ STAIR

1 1/2" = 1'-0" –

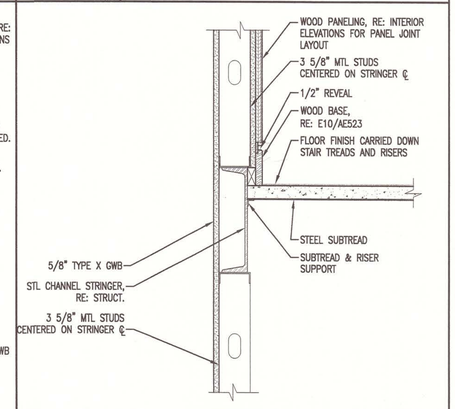

A10 SECTION @ STAIR

1 1/2" = 1'-0" –

See ST-46

AS BUILT
Owner Copy

SMRT
ARCHITECTURE ENGINEERING PLANNING
SMRT
144 Fore Street/P.O. Box 618
Portland, Maine 04104
tel. (207) 772-3846
fax. (207) 772-1070

STATE OF MAINE
SCOTT L. BENSON
No. 1772
REGISTERED PROFESSIONAL ARCHITECT

PROJECT TITLE:
MAINE TURNPIKE AUTHORITY
ADMINISTRATION BUILDING
PORTLAND, MAINE

CURRENT ISSUE STATUS:
ISSUED FOR BIDDING/CONSTRUCTION
7-9-07

REV	DESCRIPTION	DATE
0	BIDDING/CONSTRUCTION	7-9-07


GRAPHIC SCALE: 0" 1"

SCALE:	AS NOTED
PROJECT MANAGER:	SLB
JC/DRAWN BY:	TCM/TCM
A/E OF RECORD:	SLB
CAD FILE:	AE543-06016
PROJECT NO:	06016
DATE:	7-9-07

SHEET TITLE:
STAIR DETAILS

SHEET No.
AE543

© COPYRIGHT 2007 SMRT INC

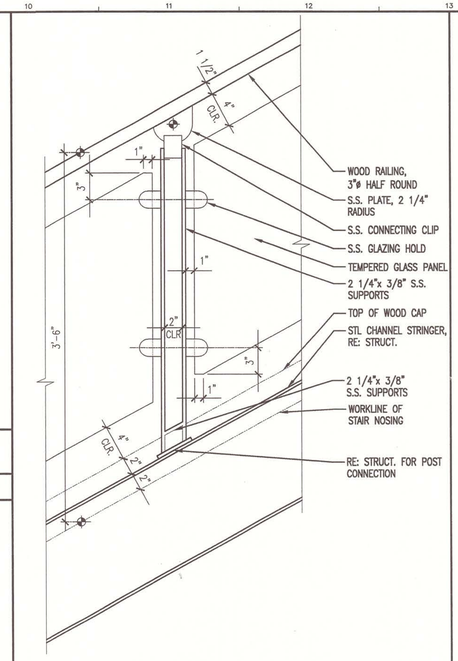


G10	SLOPED STAIR RAILING/POST
1 1/2" = 1'-0"	–


GENERAL NOTES:

1. SEE G1001 FOR PROJECT GENERAL NOTES.

E1	–	E4	–	E7	–
*	–	*		*	

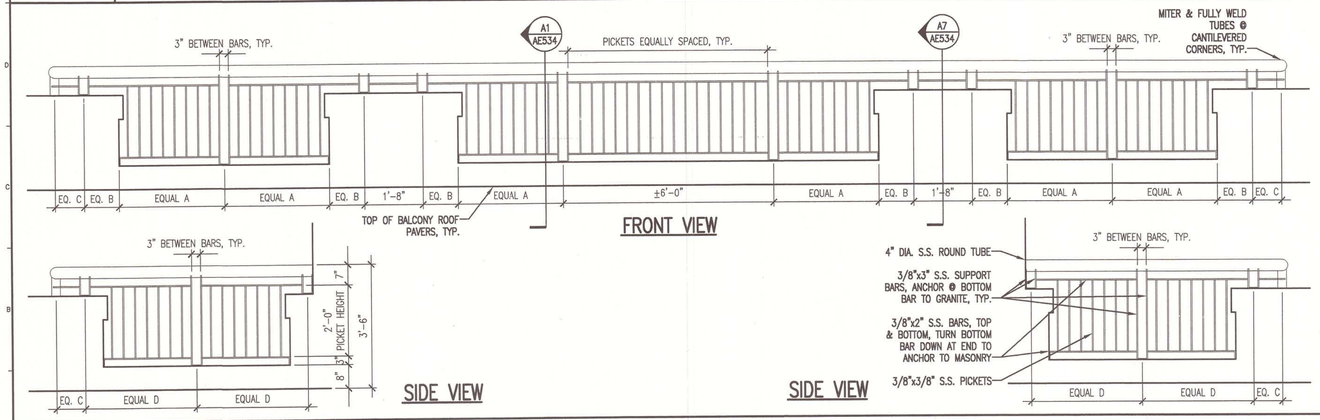

A1	EXTERIOR BALCONIES – RAIL ELEVATIONS
1/2" = 1'-0"	–

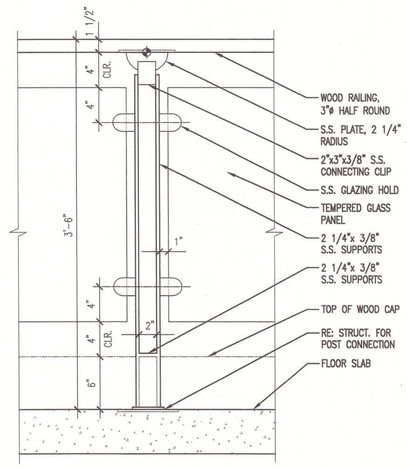

A10	TYPICAL STAIR RAILING/POST
1 1/2" = 1'-0"	–

AS BUILT
Owner Copy

SMRT
ARCHITECTURE ENGINEERING PLANNING
SMRT
144 Fore Street / P.O. Box 618
Portland, Maine 04104
tel. (207) 772-3846
fax. (207) 772-1070

STATE OF MAINE
SCOTT L BENSON
No. 1772
REGISTERED PROFESSIONAL ARCHITECT

PROJECT TITLE:
MAINE TURNPIKE AUTHORITY
ADMINISTRATION BUILDING
PORTLAND, MAINE

CURRENT ISSUE STATUS:
ISSUED FOR BIDDING/CONSTRUCTION
7-9-07

REV	DESCRIPTION	DATE
0	BIDDING/CONSTRUCTION	7-9-07

GRAPHIC SCALE: 0" 1"

SCALE:	AS NOTED
PROJECT MANAGER:	SLB
JC/DRAWN BY:	TCM/TCM
A/E OF RECORD:	SLB
CAD FILE:	AE544-06016
PROJECT NO:	06016
DATE:	7-9-07

SHEET TITLE:
RAILING DETAILS

SHEET No.
AE544

© COPYRIGHT 2007 SMRT INC.

FIRST FLOOR ROOM FINISH SCHEDULE

ROOM NUMBER	ROOM NAME	FLOOR	BASE	WALLS				CEILING		ROOM NUMBER	REMARKS
				NORTH	SOUTH	EAST	WEST	MATERIAL	HEIGHT		
101	FULLFILLMENT	VCT	RES	GWB	GWB	GWB	GWB	ACT	9'-0"	101	8'-6" Ceiling RFI-386
102	MEN'S TOILET	CT	CT	CT/GWB	CT/GWB	CT/GWB	CT/GWB	ACT	9'-0"	102	8'-10" Ceiling RFI-386
102a	SHOWER	CT	CT	CT/GWB	CT/GWB	CT/GWB	CT/GWB	GWB	8'-0"	102a	8'-10" Ceiling HT RFI-386
103	WOMEN'S TOILET	CT	CT	CT/GWB	CT/GWB	CT/GWB	CT/GWB	ACT	9'-0"	103	
103a	SHOWER	CT	CT	CT/GWB	CT/GWB	CT/GWB	CT/GWB	GWB	8'-0"	103a	
104	STAIR	RUBBER	RES	GWB	GWB	GWB	GWB	EXP	N/A	104	
105	STAIR	RUBBER	RES	GWB	GWB	GWB	GWB	EXP	N/A	105	
106	T/D	VCT	RES	GWB	GWB	GWB	GWB	EXP	N/A	106	
107	ELEC.	VCT	RES	GWB	GWB	GWB	GWB	EXP	N/A	107	→ Acetc
108	JAN.	VCT	RES	FRP	FRP	FRP	FRP	GWB	8'-0"	108	
109	SUPPLIES	VCT	RES	GWB	GWB	GWB	GWB	GWB	8'-0"	109	
110	TRANSP. STORAGE	VCT	RES	GWB	GWB	GWB	GWB	ACT	9'-0"	110	8'-6" Ceiling RFI-386
111	CORR.	VCT	RES	GWB/WP	GWB/WP	–	GWB/WP	ACT	9'-0"	111	
112	COMPUTER REPAIR LAB	SDVCT	RES	GWB	GWB	GWB	GWB	ACT	9'-0"	112	8'-10 Ceiling RFI-386
113	COMPUTER STORAGE	SDVCT	RES	GWB	GWB	GWB	GWB	ACT	9'-0"	113	
114	MID RANGE/SERVER ROOM	SDVCT	RES	GWB	GWB	GWB	GWB	PTD EXP	N/A	114	
115	BOTTLE	VCT	RES	GWB	GWB	GWB	GWB	EXP.	N/A	115	
116	FARE COLLECTION STORAGE	VCT	RES	GWB	GWB	GWB	GWB	EXP.	N/A	116	
117	SEC. EVID. STORAGE	VCT	RES	GWB	GWB	GWB	GWB	ACT	9'-0"	117	
118	INTERVIEW	CPT	RES	GWB	GWB	GWB	GWB	ACT	9'-0"	118	
119	OFFICE	CPT	RES	GWB	GWB	GWB	GWB	ACT	9'-0"	119	
120	OFFICE	CPT	RES	GWB	GWB	GWB	GWB	ACT	9'-0"	120	
121	OFFICE	CPT	RES	GWB	GWB	GWB	GWB	ACT	9'-0"	121	
122	CORR.	VCT	RES	GWB/WP	GWB/WP	GWB/WP	GWB/WP	ACT	9'-0"	122	
123	CONFERENCE TRAINING	CPT	RES	GWB/RAIL	GWB/RAIL	GWB/RAIL	GWB/RAIL	ACT	9'-0"	123	
124	STORAGE	CPT	RES	GWB	GWB	GWB	GWB	ACT	9'-0"	124	→ Acetc
125	JAN.	VCT	RES	FRP	FRP	FRP	FRP	GWB	8'-0"	125	
126	OFFICE	CPT	RES	GWB	GWB	GWB	GWB	ACT	9'-0"	126	
127	OFFICE	CPT	RES	GWB	GWB	GWB	GWB	ACT	9'-0"	127	
128	OFFICE	CPT	RES	GWB	GWB	GWB	GWB	ACT	9'-0"	128	
129	WAITING	VCT	RES	GWB	GWB	GWB	GWB	ACT	9'-0"	129	
130	CORR.	VCT	RES	GWB/WP	GWB/WP	GWB/WP	GWB/WP	ACT	9'-0"	130	
131	TOILET	CT	CT	CT/GWB	CT/GWB	CT/GWB	CT/GWB	ACT	8'-0"	131	
132	RECEPT.	CPT	RES	GWB	GWB	GWB	GWB	ACT	9'-0"	132	
133	TOILET	CT	CT	CT/GWB	CT/GWB	CT/GWB	CT/GWB	ACT	8'-0"	133	
134	WORK ROOM	VCT	RES	GWB	GWB	GWB	GWB	ACT	9'-0"	134	
135	WOMEN'S SHOWER	CT	CT	CT/GWB	CT/GWB	CT/GWB	CT/GWB	ACT	8'-0"	135	
136	MEN'S SHOWER	CT	CT	CT/GWB	CT/GWB	CT/GWB	CT/GWB	ACT	8'-0"	136	
137	CORR.	VCT	RES	GWB/WP	GWB/WP	GWB/WP	GWB/WP	ACT	9'-0"	137	
138	BREAKROOM	VCT	RES	GWB	GWB	GWB	GWB	ACT	9'-0"	138	
139	LOCKERS	VCT	RES	GWB	GWB	GWB	GWB	ACT	9'-0"	139	
140	CORR.	VCT	RES	GWB/WP	GWB/WP	GWB/WP	GWB/WP	ACT	9'-0"	140	→ John Cyr
141	COMP.	SDVCT	RES	GWB	GWB	GWB	GWB	EXP	N/A	141	
142	TROOPERS	VCT	RES	GWB	GWB	GWB	GWB	ACT	9'-0"	142	
143	CORR.	VCT	RES	GWB/WP	GWB/WP	GWBWP	GWB/WP	ACT	9'-0"	143	
144	SUP.	VCT	RES	GWB	GWB	GWB	GWB	ACT	9'-0"	144	
145	SALLYPORT	S. CONC.	–	CMU	CMU	CMU	CMU	EXP	N/A	145	
146	ARMORY	S. CONC.	–	CMU	CMU	CMU	CMU	EXP	N/A	146	
147	INTERVIEW	VCT	RES	GWB	CMU	GWB	GWB	ACT*	9'-0"	147	*PROVIDE HOLD DOWN CLIPS Ceilings
148	INTOX.	VCT	RES	GWB	CMU	GWB	GWB	GWB	9'-0"	148	EPOXY WALL FINISH ON GWB
149	TOILET	CT	CT	CT/GWB	CT/GWB	CT/GWB	CT/GWB	ACT*	8'-0"	149	EPOXY WALL FINISH ON GWB, *PROVIDE HOLD DOWN CLIPS Ceilings
150	VEST.	VCT	RES	GWB	GWB	GWB	GWB	GWB	9'-0"	150	
151	CORR.	VCT	RES	GWB/WP	GWB/WP	GWB/WP	GWB/WP	ACT	9'-0"	151	
152	OFFICE	CPT	RES	GWB	GWB	GWB	GWB	ACT	9'-0"	152	8'-4" Ceiling HT RFI-386
153	OPEN OFFICE	CPT	RES	GWB	GWB	GWB	GWB	ACT	9'-0"	153	8'-6" Ceiling HT RFI-386
154	BREAKROOM	VCT	RES	GWB	GWB	GWB	GWB	ACT/GWB	VARIES	154	8'-10" Ceiling HT RFI-386
155	VENDING	VCT	RES	GWB	GWB	GWB	GWB	ACT	9'-0"	155	7'-1" Ceiling HT RFI-386
156	CORR.	VCT	RES	GWB/WP	GWB/WP	GWB/WP	GWB/WP	ACT	9'-0"	156	
157	CORR.	VCT	RES	GWB/WP	GWB/WP	GWB/WP	GWB/WP	ACT	9'-0"	157	
157a	ALCOVE	VCT	RES	GWB/WP	GWB/WP	GWB/WP	GWB/WP	ACT	9'-0"	157a	
158	CORR.	VCT	RES	GWB/WP	GWB/WP	GWB/WP	GWB/WP	ACT	9'-0"	158	
159	CONFERENCE	CPT	RES	GWB	GWB	GWB	GWB	ACT	9'-0"	159	8'-8" Ceiling HT RFI-386
160	ELEV. MACH.	S. CONC.	RES	GWB	GWB	GWB	GWB	ACT	9'-0"	160	
161	OPEN OFFICE	CPT	RES	GWB	GWB	GWB	GWB	ACT	9'-0"	161	8'-6" Ceiling HT RFI-386
162	OFFICE	CPT	RES	GWB	GWB	GWB	GWB	ACT	9'-0"	162	8'-2" Ceiling HT RFI-386
163	CUSTODIAL STORAGE	VCT	RES	GWB	GWB	GWB	GWB	ACT	9'-0"	163	
164	CORR.	VCT	RES	GWB/WP	GWB/WP	GWB/WP	GWB/WP	ACT	9'-0"	164	
165	VEST.	VCT	RES	GWB	GWB	GWB	GWB	GWB	9'-0"	165	
166	OFFICE SUPPLIES	S. CONC.	RES	GWB	GWB	GWB	GWB	ACT	9'-0"	166	
167	BUILDING SERVICES	S. CONC.	RES	GWB	GWB	GWB	GWB	ACT	9'-0"	167	
168	SHIP/RECEIVE	S. CONC.	–	PLY/GWB	PLY/GWB	PLY/GWB	PLY/GWB	PT EXP.	N/A	168	4' HIGH PLYWOOD WAINSCOT ALL WALLS Who owns? Craig
169	MECH.	S. CONC.	RES	GWB	GWB	GWB	GWB	EXP.	N/A	169	
170	CORR.	VCT	RES	GWB/WP	GWB/WP	GWB/WP	GWB/WP	ACT	9'-0"	170	
171	TEL/DATA	S. CONC.	RES	GWB	GWB	GWB	GWB	EXP.	N/A	171	
172	ELEC.	S. CONC.	RES	GWB	GWB	GWB	GWB	EXP.	N/A	172	
173	FILE STORAGE	VCT	RES	GWB	GWB	GWB	GWB	EXP.	N/A	173	
174	PLAN STORAGE	VCT	RES	GWB	GWB	GWB	GWB	ACT	9'-0"	174	8'-10" Ceiling RFI-386

GENERAL NOTES:

1. SEE GI001 FOR PROJECT GENERAL NOTES.

FINISH NOTES:

1. SEE SPECIFICATIONS FOR ADDITIONAL INFORMATION REGARDING FINISH MATERIALS.
2. REFER TO PARTITION LEGEND FOR TYPE OF GWB COMPOSITION REQUIRED. "ABUSE RESISTANT", "MOISTURE RESISTANT" OR OTHER (TYPICAL).
3. REFER TO INTERIOR ELEVATIONS FOR MORE INFORMATION ON MATERIAL LOCATIONS

FINISH ABBREVIATIONS:

ACT	ACOUSTICAL CEILING TILE
CONC	CONCRETE, SEALED
CEM	CEMENT BOARD
CPT	CARPET
CT	CERAMIC TILE
EXP	EXPOSED STRUCTURE
FRP	FIBERGLASS REINFORCED PANEL
GWB	GYPSUM WALLBOARD, PAINTED
INS	INSULATED
MAT	WALK-OFF MAT
PF	PRE-FINISHED BY MANUFACTURER
PLAM	PLASTIC LAMINATE
PTD	PAINTED
QT	QUARRY TILE
RB	RUBBER BASE
RCP	REFLECTED CEILING PLAN
RES	RESILIENT BASE
SF	STOREFRONT (ALUMINUM)
SV	SHEET VINYL
VCT	VINYL COMPOSITION TILE
VWC	VINYL WALL COVERING
WD	WOOD
WDP	WOOD PANELING
WP	WALL PROTECTION
WSC	WOOD WAINSCOT

AS BUILT
Owner Copy

A1	FIRST FLOOR ROOM FINISH SCHEDULE
NONE	– *

SMRT
ARCHITECTURE ENGINEERING PLANNING
SMRT
144 Fore Street/P.O. Box 618
Portland, Maine 04104
tel. (207) 772-3846
fax. (207) 772-1070

STATE OF MAINE
SCOTT L BENSON
No. 1772
REGISTERED PROFESSIONAL ARCHITECT

PROJECT TITLE: MAINE TURNPIKE AUTHORITY ADMINISTRATION BUILDING
PORTLAND, MAINE

CURRENT ISSUE STATUS: ISSUED FOR BIDDING/CONSTRUCTION 7-9-07

REV	DESCRIPTION	DATE
0	BIDDING/CONSTRUCTION	7-9-07

GRAPHIC SCALE: 0" 1"

SCALE: AS NOTED
PROJECT MANAGER: SLB
JC/DRAWN BY: TCM/TCM
A/E OF RECORD: SLB
CAD FILE: AE601-06016
PROJECT NO: 06016
DATE: 7-9-07

SHEET TITLE: FIRST FLOOR ROOM FINISH SCHEDULE

SHEET No. AE601

© COPYRIGHT 2007 SMRT INC.

SECOND FLOOR ROOM FINISH SCHEDULE

ROOM NUMBER	ROOM NAME	FLOOR	BASE	WALLS				CEILING		ROOM NUMBER	REMARKS
				NORTH	SOUTH	EAST	WEST	MATERIAL	HEIGHT		
201a	HALL	STONE/CPT	WD	WDP	WDP	WDP	WDP	GWB/ACT	9'-6"/8'-6"	201a	
201b	HALL	STONE	WD	WDP	WDP	WDP	WDP	GWB/ACT	9'-6"/8'-6"	201b	→ Lux
201c	STORAGE	CONC	RES	GWB	GWB	GWB	GWB	GWB	7'-6"	201c	
201d	ALCOVE	STONE	WD	VWC	VWC	WDP	VWC	ACT	9'-0"	201d	
202	MEN'S TOILET	CT	CT	CT/GWB	CT/GWB	CT/GWB	CT/GWB	ACT	9'-0"	202	
203	WOMEN'S TOILET	CT	CT	CT/GWB	CT/GWB	CT/GWB	CT/GWB	ACT	9'-0"	203	
204	STAIR	RUBBER	RES	GWB	GWB	GWB	GWB	EXP	N/A	204	
205	STAIR	RUBBER	RES	GWB	GWB	GWB	GWB	EXP	N/A	205	
206	T/D	VCT	RES	GWB	GWB	GWB	GWB	EXP.	N/A	206	→ Acetb
207	ELEC.	VCT	RES	GWB	GWB	GWB	GWB	EXP.	N/A	207	
208	JAN.	VCT	RES	FRP	FRP	FRP	FRP	GWB	8'-0"	208	
209	SUPP.	VCT	RES	GWB	GWB	GWB	GWB	GWB	8'-0"	209	
210	LOBBY	STONE	WD	WDP*	WDP*	WDP*	WDP*	GWB/ACT	9'-6"/8'-6"	210	*SEE FINISH NOTE 3
211	VESTIBULE	STONE	WD	SF*	SF*	SF*	SF*	GWB	10'-8"	211	*SEE FINISH NOTE 3
212	RECEPT.	CPT	RES	GWB*	GWB*	GWB*	GWB*	ACT	9'-0"	212	*SEE FINISH NOTE 3
213	CONFERENCE ROOM	CPT	WD	GWB/RAIL*	GWB/RAIL*	GWB/RAIL*	GWB/RAIL*	ACT	9'-0"	213	*SEE FINISH NOTE 3
214	WAITING	CPT	WD	WDP*	WDP*	WDP*	WDP*	GWB/ACT	9'-6"/8'-6"	214	
215	WAITING	CPT	WD	WDP*	WDP*	WDP*	WDP*	GWB/ACT	9'-6"/8'-6"	215	
216	C.S. LOBBY	STONE	WD	GWB/WSC	GWB/WSC	GWB/WSC	GWB/WSC	ACT	9'-0"	216	
217	HEARING	CPT	WD	GWB/RAIL	GWB/RAIL	GWB/RAIL	GWB/RAIL	ACT	9'-0"	217	
218	HEARING	CPT	WD	GWB/RAIL	GWB/RAIL	GWB/RAIL	GWB/RAIL	ACT	9'-0"	218	
219	CUSTOMER SERVICE	CPT	RES	GWB	GWB	GWB	GWB	ACT	9'-0"	219	
220	NOTICE MAILING	VCT	RES	GWB	GWB	GWB	GWB	ACT	9'-0"	220	
221	VAULT	CPT	RES	GWB	GWB	GWB	GWB	ACT	9'-0"	221	
222	CORR.	CPT	RES	GWB	GWB	GWB	GWB	ACT	9'-0"	222	
223	OPEN OFFICE	CPT	RES	GWB	GWB	GWB	GWB	ACT	9'-0"	223	→ 8'-4" RFI-279
224	OPEN OFFICE	CPT	RES	–	–	GWB	GWB	ACT	9'-0"	224	8'-4" RFI-279
225	OPEN OFFICE	CPT	RES	GWB	GWB	GWB	GWB	ACT	9'-0"	225	9'-4" RFI-279
226	CORR.	CPT	RES	GWB	GWB	GWB	GWB	ACT	9'-0"	226	
227	VIOLATION REVIEW	CPT	RES	GWB	GWB	GWB	GWB	ACT	9'-0"	227	
228	OFFICE	CPT	RES	GWB	GWB	GWB	GWB	ACT	9'-0"	228	
229	CONFERENCE	CPT	WD	GWB/RAIL	GWB/RAIL	GWB/RAIL	GWB/RAIL	ACT/GWB	8'-0"	229	
230	CONFERENCE	CPT	WD	GWB/RAIL	GWB/RAIL	GWB/RAIL	GWB/RAIL	ACT/GWB	8'-0"	230	
231	STOR.	CPT	RES	GWB	GWB	GWB	GWB	ACT	8'-0"	231	
232	STOR.	CPT	RES	GWB	GWB	GWB	GWB	ACT	8'-0"	232	
233	FILE STORAGE	VCT	RES	GWB	GWB	GWB	GWB	ACT	9'-0"	233	
234	CORR.	CPT	RES	GWB	GWB	GWB	GWB	ACT	9'-0"	234	
235	KITCHEN	VCT	RES	GWB	GWB	GWB	GWB	ACT	9'-0"	235	
236	EQUIPMENT	SDVCT	RES	GWB	GWB	GWB	GWB	ACT	9'-0"	236	
237	COMMUNICATIONS	CPT	RES	GWB	GWB	GWB	GWB	ACT	9'-0"	237	
238	TOILET	CT	CT	CT/GWB	CT/GWB	CT/GWB	CT/GWB	ACT	8'-0"	238	
239	OFFICE	CPT	RES	GWB	GWB	GWB	GWB	ACT	9'-0"	239	
240	ANTE-ROOM	CPT	RES	GWB	GWB	GWB	GWB	ACT	9'-0"	240	
241	OPEN OFFICE	CPT	RES	GWB	GWB	GWB	GWB	ACT	9'-0"	241	
242	FILE STORAGE	VCT	RES	GWB	GWB	GWB	GWB	ACT	9'-0"	242	
243	HALL	CPT	RES	–	GWB	–	GWB	ACT	9'-0"	243	
244	OFFICE	CPT	RES	GWB	GWB	GWB	GWB	ACT	9'-0"	244	
245	OFFICE	CPT	RES	GWB	GWB	GWB	GWB	ACT	9'-0"	245	
246	NOT USED	–	–	–	–	–	–	–	–	246	
247	WAITING	CPT	RES	GWB	GWB	GWB	–	ACT	9'-0"	247	
248	OPEN OFFICE	CPT	RES	–	GWB	GWB	GWB	ACT	9'-0"	248	
249	OFFICE	CPT	RES	GWB	GWB	GWB	GWB	ACT	9'-0"	249	
250	OFFICE	CPT	RES	GWB	GWB	GWB	GWB	ACT	9'-0"	250	
251	CORR.	CPT	RES	GWB	GWB	GWB	GWB	ACT	9'-0"	251	
252	OFFICE	CPT	RES	GWB	GWB	GWB	GWB	ACT	9'-0"	252	
253	FILE STORAGE	VCT	RES	GWB	GWB	GWB	GWB	ACT	9'-0"	253	
254	OFFICE	CPT	RES	GWB	GWB	GWB	GWB	ACT	9'-0"	254	
255	CORRIDOR	CPT	RES	GWB	GWB	–	GWB	ACT	9'-0"	255	
256	CLOSET	STONE	WD	GWB	GWB	GWB	GWB	GWB	8'-0"	256	
257	COPY/MAIL	VCT	RES	GWB	GWB	GWB	GWB	ACT	9'-0"	257	

GENERAL NOTES:

1. SEE G1001 FOR PROJECT GENERAL NOTES.

FINISH NOTES:

1. SEE SPECIFICATIONS FOR ADDITIONAL INFORMATION REGARDING FINISH MATERIALS.
2. REFER TO PARTITION LEGEND FOR TYPE OF GWB COMPOSITION REQUIRED. "ABUSE RESISTANT", "MOISTURE RESISTANT" OR OTHER (TYPICAL).
3. REFER TO INTERIOR ELEVATIONS FOR MORE INFORMATION ON MATERIAL LOCATIONS

FINISH ABBREVIATIONS:

ACT	ACOUSTICAL CEILING TILE
CONC	CONCRETE, SEALED
CEM	CEMENT BOARD
CPT	CARPET
CT	CERAMIC TILE
EXP	EXPOSED STRUCTURE
FRP	FIBERGLASS REINFORCED PANEL
GWB	GYPSUM WALLBOARD, PAINTED
INS	INSULATED
MAT	WALK-OFF MAT
PF	PRE-FINISHED BY MANUFACTURER
PLAM	PLASTIC LAMINATE
PTD	PAINTED
QT	QUARRY TILE
RB	RUBBER BASE
RCP	REFLECTED CEILING PLAN
RES	RESILIENT BASE
SF	STOREFRONT (ALUMINUM)
SV	SHEET VINYL
VCT	VINYL COMPOSITION TILE
VWC	VINYL WALL COVERING
WD	WOOD
WDP	WOOD PANELING
WP	WALL PROTECTION
WSC	WOOD WAINSCOT

AS BUILT
Owner Copy

SMRT
ARCHITECTURE ENGINEERING PLANNING
SMRT
144 Fore Street/P.O. Box 618
Portland, Maine 04104
tel. (207) 772-3846
fax. (207) 772-1070

STATE OF MAINE
SCOTT L BENSON
No. 1772
REGISTERED PROFESSIONAL ARCHITECT

PROJECT TITLE:
MAINE TURNPIKE AUTHORITY
ADMINISTRATION BUILDING
PORTLAND, MAINE

CURRENT ISSUE STATUS:
ISSUED FOR BIDDING/CONSTRUCTION
7-9-07

REV	DESCRIPTION	DATE
0	BIDDING/CONSTRUCTION	7-9-07

GRAPHIC SCALE: 0" 1"

SCALE:	AS NOTED
PROJECT MANAGER:	SLB
JC/DRAWN BY:	TCM/TCM
A/E OF RECORD:	SLB
CAD FILE:	AE602-06016
PROJECT NO:	06016
DATE:	7-9-07

SHEET TITLE:
SECOND FLOOR ROOM FINISH SCHEDULE

SHEET No.
AE602

© COPYRIGHT 2007 SMRT INC.

A1 | SECOND FLOOR ROOM FINISH SCHEDULE

NONE | – | *

THIRD FLOOR ROOM FINISH SCHEDULE

ROOM NUMBER	ROOM NAME	FLOOR	BASE	WALLS				CEILING		ROOM NUMBER	REMARKS
				NORTH	SOUTH	EAST	WEST	MATERIAL	HEIGHT		
301	GALLERY	CPT	WD	GWB/WSC	GWB/WSC	GWB/WSC	GWB/WSC	GWB/ACT	9'-6"/8'-6"	301	WallBoard Soffits @ 8'-6" Accoustical @ 9'-6" RFI-273
301a	ALCOVE	CPT	WD	VWC	VWC	VWC/WSC	VWC	ACT	9'-0"	301a	
302	MEN'S TOILET	CT	CT	CT/GWB	CT/GWB	CT/GWB	CT/GWB	ACT	9'-0"	302	
303	WOMEN'S TOILET	CT	CT	CT/GWB	CT/GWB	CT/GWB	CT/GWB	ACT	9'-0"	303	
304	STAIR	RUBBER	RES	GWB	GWB	GWB	GWB	EXP	N/A	304	
305	STAIR	RUBBER	RES	GWB	GWB	GWB	GWB	EXP	N/A	305	
306	TEL/DATA	VCT	RES	GWB	GWB	GWB	GWB	EXP	N/A	306	
307	ELEC.	VCT	RES	GWB	GWB	GWB	GWB	EXP	N/A	307	
308	JAN.	VCT	RES	FRP	FRP	FRP	FRP	GWB	8'-0"	308	
309	SUPPLIES	VCT	RES	GWB	GWB	GWB	GWB	GWB	8'-0"	309	
310	AUTHORITY ROOM	CPT	WD	GWB/WSC	GWB/WSC	GWB/WSC	GWB/WSC	GWB/ACT*	9'-6"/8'-6"	310	*SEE WALL SECTIONS
311	CLOSET	CPT	RES	GWB	GWB	GWB	GWB	GWB	8'-0"	311	
312	CLOSET	CPT	RES	GWB	GWB	GWB	GWB	GWB	8'-0"	312	
313	CORRIDOR	CPT	RES	GWB	GWB	GWB	GWB	ACT	9'-0"	313	
314	KITCHEN	VCT	RES	GWB	GWB	GWB	GWB	ACT	9'-0"	314	
315	STORAGE	CPT	RES	GWB	GWB	GWB	GWB	ACT	9'-0"	315	
316	OFFICE	CPT	RES	GWB	GWB	GWB	GWB	ACT	9'-0"	316	
317	OPEN OFFICE	CPT	RES	GWB	GWB	GWB	GWB	ACT	9'-0"	317	
318	OFFICE	CPT	RES	GWB	GWB	GWB	GWB	ACT	9'-0"	318	
319	WAIT	CPT	RES	–	GWB	GWB	GWB	ACT	9'-0"	319	
320	OFFICE	CPT	RES	GWB	GWB	GWB	GWB	ACT	9'-0"	320	
321	OFFICE	CPT	RES	GWB	GWB	GWB	GWB	ACT	9'-0"	321	
322	OPEN OFFICE	CPT	RES	GWB	GWB	GWB	GWB	ACT	9'-0"	322	
323	VAULT	VCT	RES	GWB	GWB	GWB	GWB	ACT	9'-0"	323	
324	OPEN OFFICE	CPT	RES	–	GWB	GWB	GWB	ACT	9'-0"	324	
325	COPY	VCT	RES	GWB	GWB	GWB	GWB	ACT	9'-0"	325	
326	OPEN OFFICE	CPT	RES	GWB	GWB	GWB	GWB	ACT	9'-0"	326	
327	CORRIDOR	CPT	RES	GWB	GWB	GWB	GWB	ACT	9'-0"	327	
328	TEST	CPT	RES	GWB	GWB	GWB	GWB	ACT	9'-0"	328	
329	AUDIT	CPT	RES	GWB	GWB	GWB	GWB	ACT	9'-0"	329	
330	WAITING	CPT	RES	GWB	GWB	GWB	GWB	ACT	9'-0"	330	
331	OPEN OFFICE	CPT	RES	GWB	GWB	GWB	GWB	ACT	9'-0"	331	
332	FILES	VCT	RES	GWB	GWB	GWB	GWB	ACT	9'-0"	332	
333	OFFICE	CPT	RES	GWB	GWB	GWB	GWB	ACT	9'-0"	333	
334	OFFICE	CPT	RES	GWB	GWB	GWB	GWB	ACT	9'-0"	334	
335	OPEN OFFICE	CPT	RES	GWB	GWB	GWB	GWB	ACT	9'-0"	335	
336	CORRIDOR	CPT	RES	GWB	GWB	GWB	GWB	ACT	9'-0"	336	
337	FILE STORAGE	VCT	RES	GWB	GWB	GWB	GWB	ACT	9'-0"	337	
338	CONFERENCE	CPT	WD	GWB/RAIL	GWB/RAIL	GWB/RAIL	GWB/RAIL	ACT	9'-0"	338	
339	OPEN OFFICE	CPT	RES	GWB	GWB	GWB	GWB	ACT	9'-0"	339	
340	OFFICE	CPT	RES	GWB	GWB	GWB	GWB	ACT	9'-0"	340	
341	OFFICE	CPT	RES	GWB	GWB	GWB	GWB	ACT	9'-0"	341	
342	OFFICE	CPT	RES	GWB	GWB	GWB	GWB	ACT	9'-0"	342	
343	LAYOUT	CPT	RES	GWB	GWB	–	GWB	ACT	9'-0"	343	
344	OPEN OFFICE	CPT	RES	GWB	GWB	GWB	–	ACT	9'-0"	344	
345	CONFERENCE	CPT	WD	GWB/RAIL	GWB/RAIL	GWB/RAIL	GWB/RAIL	ACT	9'-0"	345	
346	OFFICE	CPT	WD	GWB/RAIL	GWB/RAIL	GWB/RAIL	GWB/RAIL	GWB/ACT	9'-0"	346	
347	TOILET	CT	CT	GWB/CT	GWB/CT	GWB/CT	GWB/CT	ACT	8'-0"	347	
348	STOR.	CPT	RES	GWB	GWB	GWB	GWB	ACT	9'-0"	348	
349	OPEN OFFICE	CPT	WD	GWB/RAIL	GWB/RAIL	GWB/RAIL	GWB/RAIL	ACT	9'-0"	349	
350	CLOSET	CPT	RES	GWB	GWB	GWB	GWB	GWB	9'-0"	350	
351	OFFICE	CPT	RES	GWB	GWB	–	GWB	ACT	9'-0"	351	
352	CORRIDOR	CPT	RES	GWB	GWB	GWB	GWB	ACT	9'-0"	352	
353	OFFICE	CPT	RES	GWB	GWB	GWB	GWB	ACT	9'-0"	353	
354	CORRIDOR	CPT	RES	GWB	GWB	GWB	GWB	ACT	9'-0"	354	

GENERAL NOTES:

1. SEE G1001 FOR PROJECT GENERAL NOTES.

FINISH NOTES:

1. SEE SPECIFICATIONS FOR ADDITIONAL INFORMATION REGARDING FINISH MATERIALS.
2. REFER TO PARTITION LEGEND FOR TYPE OF GWB COMPOSITION REQUIRED, "ABUSE RESISTANT", "MOISTURE RESISTANT" OR OTHER (TYPICAL).
3. REFER TO INTERIOR ELEVATIONS FOR MORE INFORMATION ON MATERIAL LOCATIONS

FINISH ABBREVIATIONS:

ACT	ACOUSTICAL CEILING TILE
CONC	CONCRETE, SEALED
CEM	CEMENT BOARD
CPT	CARPET
CT	CERAMIC TILE
EXP	EXPOSED STRUCTURE
FRP	FIBERGLASS REINFORCED PANEL
GWB	GYPSUM WALLBOARD, PAINTED
INS	INSULATED
MAT	WALK-OFF MAT
PF	PRE-FINISHED BY MANUFACTURER
PLAM	PLASTIC LAMINATE
PTD	PAINTED
QT	QUARRY TILE
RB	RUBBER BASE
RCP	REFLECTED CEILING PLAN
RES	RESILIENT BASE
SF	STOREFRONT (ALUMINUM)
SV	SHEET VINYL
VCT	VINYL COMPOSITION TILE
VWC	VINYL WALL COVERING
WD	WOOD
WDP	WOOD PANELING
WP	WALL PROTECTION
WSC	WOOD WAINSCOT

AS BUILT
Owner Copy

A1	THIRD FLOOR ROOM FINISH SCHEDULE
NONE	– *

SMRT
ARCHITECTURE ENGINEERING PLANNING
SMRT
144 Fore Street / P.O. Box 618
Portland, Maine 04104
tel. (207) 772-3846
fax. (207) 772-1070

STATE OF MAINE
SCOTT L. BENSON
No. 1772
REGISTERED PROFESSIONAL ARCHITECT

PROJECT TITLE:
MAINE TURNPIKE AUTHORITY
ADMINISTRATION BUILDING
PORTLAND, MAINE

CURRENT ISSUE STATUS:
ISSUED FOR BIDDING/CONSTRUCTION
7-9-07

REV	DESCRIPTION	DATE
0	BIDDING/CONSTRUCTION	7-9-07

GRAPHIC SCALE: 0" 1"

SCALE:	AS NOTED
PROJECT MANAGER:	SLB
JC/DRAWN BY:	TCM/TCM
A/E OF RECORD:	SLB
CAD FILE:	AE603-06016
PROJECT NO:	06016
DATE:	7-9-07

SHEET TITLE:
THIRD FLOOR ROOM FINISH SCHEDULE

SHEET No.
AE603

© COPYRIGHT 2007 SMRT INC

FIRST FLOOR DOOR SCHEDULE

DOOR NUMBER	DOOR SIZE	DOOR MATERIAL	DOOR ELEVATION	GLAZING	FRAME MATERIAL	FRAME ELEVATION	FRAME HEAD	FRAME JAMB	FRAME SILL	HWS	FIRE RATING (MIN.)	DOOR NUMBER	REMARKS
101	3'-8" x 7'-0"	WD1	F	N/A	HM	H1	J1/AE623	E1/AE623	–	1	–	101	NOTE 6
102	3'-0" x 7'-0"	WD1	F	N/A	HM	H1	J1/AE623	E1/AE623	–	2	–	102	
103	3'-0" x 7'-0"	WD1	F	N/A	HM	H1	J1/AE623	E1/AE623	–	2	–	103	
104	3'-0" x 7'-0"	WD1	NL	WIRE	HM	H1	J1/AE623	E1/AE623	–	3	60	104	
105	3'-0" x 7'-0"	WD1	NL	WIRE	HM	H1	J1/AE623	E1/AE623	–	3	60	105	
106	3'-0" x 7'-0"	WD1	F	N/A	HM	H1	J1/AE623	E1/AE623	–	13	–	106	
107	3'-0" x 7'-0"	WD1	F	N/A	HM	H1	J1/AE623	E1/AE623	–	13	–	107	
108	2'-8" x 7'-0"	WD1	F	N/A	HM	H1	J1/AE623	E1/AE623	–	13	–	108	
109	2'-8" x 7'-0"	WD1	F	N/A	HM	H1	J1/AE623	E1/AE623	–	4	–	109	Revise Lock set is SI-84
110	3'-8" x 7'-0"	WD1	F	N/A	HM	H1	J1/AE623	E1/AE623	–	4	–	110	NOTE 6
112	3'-8" x 7'-0"	WD1	NL	TEMP	HM	H1	J1/AE623	E1/AE623	–	6	–	112	
113	3'-8" x 7'-0"	WD1	F	N/A	HM	H1	J1/AE623	E1/AE623	–	6	–	113	
114	3'-8" x 7'-0"	WD1	NL	WIRE	HM	H1	J1/AE623	E1/AE623	–	7	45	114	
115	3'-0" X 7'-0"	WD1	F	N/A	HM	H1	J1/AE623	E1/AE623	–	4		115	
116	3'-8" x 7'-0"	WD1	F	N/A	HM	H1	J1/AE623	E1/AE623	–	1	–	116	NOTE 6
117	3'-8" x 7'-0"	WD1	F	N/A	HM	H1	J1/AE623	E1/AE623	–	1	–	117	~~ADD~~ SI-92 Install Deadlocks
118	3'-0" x 7'-0"	WD1	HG	TEMP	HM	H1	J1/AE623	E1/AE623	–	8	–	118	
119	3'-0" x 7'-0"	WD1	F	N/A	HM	H1	J1/AE623	E1/AE623	–	8	–	119	
120	3'-0" x 7'-0"	WD1	F	N/A	HM	H1	J1/AE623	E1/AE623	–	8	–	120	
121	3'-0" x 7'-0"	WD1	F	N/A	HM	H1	J1/AE623	E1/AE623	–	8	–	121	
123	3'-0" x 7'-0"	WD1	HG	TEMP	HM	H1	J1/AE623	E1/AE623	–	8	–	123	
124	(2) 3'-0" x 7'-0"	WD1	F	N/A	HM	H1	J1/AE623	E1/AE623	–	9	–	124	
125	3'-0" x 7'-0"	WD1	F	N/A	HM	H1	J1/AE623	E1/AE623	–	4	–	125	
126	3'-0" x 7'-0"	WD1	F	N/A	HM	H1	J1/AE623	E1/AE623	–	8	–	126	
127	3'-0" x 7'-0"	WD1	F	N/A	HM	H1	J1/AE623	E1/AE623	–	8	–	127	
128	3'-0" x 7'-0"	WD1	F	N/A	HM	H1	J1/AE623	E1/AE623	–	8	–	128	
129	3'-0" x 7'-0"	ALUM	FG	INS/TEMP	ALUM	A1	J1&E4/AE627	E7/AE628 HI E1/AE628 LO	–	10	–	129	
130	3'-8" x 7'-0"	HM	HG	TEMP	HM	H2	J7/AE625	E7/AE625	–	6	–	130	
131	3'-0" x 7'-0"	WD1	F	N/A	HM	H1	J1/AE623	E1/AE623	–	11	–	131	
132	3'-0" x 7'-0"	WD1	HG	TEMP	HM	H1	J1/AE623	E1/AE623	–	8	–	132	
133	3'-0" x 7'-0"	WD1	F	N/A	HM	H1	J1/AE623	E1/AE623	–	11	–	133	
134	3'-0" x 7'-0"	WD1	HG	TEMP	HM	H1	J1/AE623	E1/AE623	–	12	–	134	
135	3'-0" x 7'-0"	WD1	F	N/A	HM	H1	J1/AE623	E1/AE623	–	11	–	135	
136	3'-0" x 7'-0"	WD1	F	N/A	HM	H1	J1/AE623	E1/AE623	–	11	–	136	
137	3'-8" x 7'-0"	HM	HG	TEMP	HM	H1	J7/AE625	E7/AE625	–	1	–	137	Lockset Change REF-344
138	3'-0" x 7'-0"	WD1	HG	TEMP	HM	H1	J1/AE623	E1/AE623	–	12	–	138	
139	3'-0" x 7'-0"	WD1	HG	TEMP	HM	H1	J1/AE623	E1/AE623	–	12	–	139	
140	3'-0" x 7'-0"	ALUM	FG	INS/TEMP	ALUM	A1	J1&E4/AE627	E7/AE628 HI E1/AE628 LO	–	10	–	140	
141	3'-0" x 7'-0"	WD1	F	N/A	HM	H1	J1/AE623	E1/AE623	–	4	–	141	
142	3'-0" x 7'-0"	WD1	HG	TEMP	HM	H1	J1/AE623	E1/AE623	–	12	–	142	
143	3'-8" x 7'-0"	HM	HG	WIRE	HM	H2	J4/AE625	E4/AE625	–	6	45	143	
144	3'-0" x 7'-0"	WD1	F	N/A	HM	H1	J1/AE623	E1/AE623	–	4	–	144	
145	10'-0" x 10'-0"	STL	OH	N/A	STL	–	J7/AE532	A7/AE511	–	–	–	145	SPECIAL CARD ACCESS/COILING DOOR
146	3'-0" x 7'-0"	HM	F	N/A	HM	H1	J1/AE625	E1/AE625	–	1	45	146	SI-92 Install Dead Locks
147	3'-0" x 7'-0"	HM	HG	TEMP	HM	H1	J1/AE623	E1/AE623	–	12	–	147	
148	3'-0" x 7'-0"	HM	HG	WIRE	HM	H1	J4/AE625	E4/AE625	–	14	45	148	
149	3'-0" x 7'-0"	HM	F	N/A	HM	H1	J1/AE623	E1/AE623	–	12	–	149	
150	3'-0" x 7'-0"	ALUM	FG	INS/TEMP	ALUM	A1	J1&E4/AE627	E7/AE628 HI E1/AE628 LO	–	10	–	150	
151	3'-0" x 7'-0"	WD1	FG	TEMP	HM	H1	J1/AE623	E1/AE623	–	3	–	151	
152	3'-0" x 7'-0"	WD1	F	N/A	HM	H1	J1/AE623	E1/AE623	–	8	–	152	
153	3'-0" x 7'-0"	WD1	HG	TEMP	HM	H2	J4/AE624	E4/AE624	–	14	–	153	
154c	3'-0" x 7'-0"	ALUM	FG	INS/TEMP	ALUM	A1	J1&E4/AE627	E7/AE628 HI E1/AE628 LO	–	10	–	154c	
154b	3'-0" x 7'-0"	ALUM	FG	INS/TEMP	ALUM	A1	J1&E4/AE627	E7/AE628 HI E1/AE628 LO	–	10	–	154b	
154a	4'-0" x 7'-0"	HM	N/A	N/A	HM	H6	J4/AE623	E4/AE623	–	N/A	–	154a	
155	4'-0" x 7'-0"	HM	N/A	N/A	HM	H6	J4/AE623	E4/AE623	–	N/A	–	155	
156a	3'-0" x 7'-0"	WD1	NL	WIRE	HM	H1	J1/AE623	E1/AE623	–	28	45	156a	NOTE 6
156b	3'-8" x 7'-0"	WD1	NL	WIRE	HM	H1	J1/AE623	E1/AE623	–	28	45	156b	NOTE 6
159	3'-0" x 7'-0"	WD1	HG	TEMP	HM	H1	J1/AE623	E1/AE623	–	8	–	159	
160	3'-0" x 7'-0"	WD1	F	N/A	HM	H1	J1/AE623	E1/AE623	–	13	45	160	
161	3'-0" x 7'-0"	WD1	HG	TEMP	HM	H1	J1/AE623	E1/AE623	–	14	–	161	
162	3'-0" x 7'-0"	WD1	F	N/A	HM	H1	J1/AE623	E1/AE623	–	8	–	162	
163	3'-8" x 7'-0"	WD1	F	N/A	HM	H1	J1/AE623	E1/AE623	–	6	–	163	NOTE 6
164	3'-0" x 7'-0"	WD1	FG	TEMP	HM	H1	J1/AE623	E1/AE623	–	3	–	164	
165	3'-0" x 7'-0"	ALUM	FG	INS/TEMP	ALUM	A1	J1&E4/AE627	E1/AE628	–	10	–	165	
166	(2) 3'-0" x 7'-0"	HM	F	N/A	HM	H1	J1/AE623	E1/AE623	–	15	–	166	
167	3'-0" x 7'-0"	HM	HG	TEMP	HM	H1	J1/AE623	E1/AE623	–	14	–	167	
168a	3'-8" x 7'-0"	HM	NL	WIRE	HM	H1	J1/AE623	E1/AE623	–	6	45	168a	NOTE 6
168b	10'-0" x 10'-0"	STL	OH	N/A	STL	–	J7/AE532	A7/AE511	–	–	–	168b	
168c	3'-0" x 7'-0"	HM	NL	INS/TEMP	HM	H1&A10	J4&E7/AE627	E1/AE628 SIM	–	26	–	168c	
169	(2) 3'-0" x 7'-0"	HM	F	N/A	HM	H1	J1/AE623	E1/AE623	–	15	–	169	
170	3'-8" x 7'-0"	HM	NL	WIRE	HM	H1	J1/AE623	E1/AE623	–	28	45	170	
171	3'-0" x 7'-0"	HM	F	N/A	HM	H1	J1/AE623	E1/AE623	–	13	–	171	
172a	3'-0" x 7'-0"	HM	F	N/A	HM	H1	J1/AE623	E1/AE623	–	13	45	172a	
172b	3'-0" x 7'-0"	HM	F	N/A	HM	H1	J1/AE623	E1/AE623	–	13	45	172b	
173	3'-8" x 7'-0"	WD1	NL	TEMP	HM	H1	J1/AE623	E1/AE623	–	1	45	173	NOTE 6
174	3'-8" x 7'-0"	WD1	NL	TEMP	HM	H2	J4/AE624	E4/AE624	–	1	45	174	NOTE 6

GENERAL NOTES:

1. SEE G1001 FOR PROJECT GENERAL NOTES.

DOOR NOTES

1. ALL SWINGING DOORS TO BE 1-3/4" THICK (U.N.O.).
2. ALL DOORS SHALL BE 3/4" UNDERCUT (TYPICAL) EXCEPT WHEN THERE IS A BOTTOM FRAME, SILL THRESHOLD, WHERE RATED (1/2" UNDERCUT @ RATED LOCATIONS), OR SPECIFICALLY NOTED OTHERWISE.
3. ALL DOORS WITH BOTTOM FRAMES OR SILL THRESHOLDS SHALL HAVE MANUFACTURERS RECOMMENDED STANDARD UNDERCUT.
4. GLAZING NOTED ON DOOR SCHEDULE IS FOR THE DOOR AND SIDELIGHTS IN THE FRAME (TYPICAL).
5. SEE SPECIFICATIONS FOR HARDWARE SET DESCRIPTIONS.
6. DOOR FRAME ELEVATION TO RECEIVE DOOR FRAME PROTECTION.

DOOR ABBREVIATIONS

AL/ALUM	ALUMINUM
F	FLUSH
FG	FULL GLAZING
NL	NARROW LIGHT
HG	HALF GLAZING
HM	HOLLOW METAL
INS	INSULATED
STL	STEEL
SS	STAINLESS STEEL
TEMP	TEMPERED GLASS
WIRE	WIRE GLASS
LAM	LAMINATED GLASS
WD1	PLAIN SLICED OAK
WD2	RIFF CUT OAK
LAM	LAMINATED GLASS

RFI-33 Doors & ADA Clearances

AS BUILT
Owner Copy

A1	FIRST FLOOR DOOR SCHEDULE
NONE	– *

SMRT
ARCHITECTURE ENGINEERING PLANNING
SMRT
144 Fore Street/P.O. Box 618
Portland, Maine 04104
tel. (207) 772-3846
fax. (207) 772-1070

PROJECT TITLE:
MAINE TURNPIKE AUTHORITY
ADMINISTRATION BUILDING
PORTLAND, MAINE

CURRENT ISSUE STATUS:
ISSUED FOR BIDDING/CONSTRUCTION
7-9-07

REV	DESCRIPTION	DATE
0	BIDDING/CONSTRUCTION	7-9-07

GRAPHIC SCALE: 0" 1"

SCALE: AS NOTED
PROJECT MANAGER: SLB
JC/DRAWN BY: TCM/TCM
A/E OF RECORD: SLB
CAD FILE: AE611-06016
PROJECT NO: 06016
DATE: 7-9-07

SHEET TITLE:
FIRST FLOOR
DOOR SCHEDULE

SHEET No.
AE611

© COPYRIGHT 2007 SMRT INC.

SECOND FLOOR DOOR SCHEDULE

DOOR NUMBER	DOOR SIZE	DOOR MATERIAL	DOOR ELEVATION	GLAZING	FRAME MATERIAL	FRAME ELEVATION	FRAME HEAD	FRAME JAMB	FRAME SILL	HWS	FIRE RATING (MIN.)	DOOR NUMBER	REMARKS
201a	(2) 3'-0" x 7'-0"	ALUM	FG2	TEMP	ALUM	A8	J4/AE626	E4/AE626	A4/AE626	17	–	201a	Access Control RFI: 343
201c	3'-0" x 7'-0"	WD2 SI-54	F	N/A	HM	H1	J10/AE623	E10/AE623	–	14	45	201c	DELETE KICK PLATE
202	3'-0" x 7'-0"	WD2	F	N/A	HM	H1	J1/AE623 SIM	E1/AE623 SIM	–	2	–	202	
203	3'-0" x 7'-0"	WD2	F	N/A	HM	H1	J1/AE623 SIM	E1/AE623 SIM	–	2	–	203	
204	3'-0" x 7'-0"	WD1	NL	WIRE	HM	H1	J1/AE623	E1/AE623	–	3	60	204	
205	3'-0" x 7'-0"	WD1	NL	WIRE	HM	H1	J1/AE623	E1/AE623	–	3	60	205	
206	3'-0" x 7'-0"	WD1	F	N/A	HM	H1	J1/AE623	E1/AE623	–	13	–	206	
207	3'-0" x 7'-0"	WD1	F	N/A	HM	H1	J1/AE623	E1/AE623	–	13	–	207	
208	2'-8" x 7'-0"	WD1	F	N/A	HM	H1	J1/AE623	E1/AE623	–	13	–	208	
209	2'-8" x 7'-0"	WD1	F	N/A	HM	H1	J1/AE623	E1/AE623	–	5	–	209	Revise Lockset SI 54
210	(2) 3'-0" x 7'-0"	ALUM	FG2	INS/TEMP	ALUM	A8	J4/AE626	E4/AE626	A4/AE626	18	–	210	
211	(2) 3'-0" x 7'-0"	ALUM	FG2	INS/TEMP	ALUM	A2	J4/AE627	A4/AE628	–	19	–	211	
212	3'-0" x 7'-0"	WD2	HG	TEMP	HM	H1	J1/AE623	E1/AE623	–	8	–	212	
213	3'-0" x 7'-0"	WD2 SI-54	FG	TEMP	HM	H1	J10/AE623	E10/AE623	–	8	–	213	
216	3'-0" x 7'-0"	WD2	FG	TEMP	HM	H1	J10/AE623	E10/AE623 HI E1/AE624 LO	–	27	–	216	Insta II Card Reader RFI 341
217a	3'-0" x 7'-0"	WD1	F	N/A	HM	H1	J1/AE623	E1/AE623 HI E10/AE623 LO	–	27	–	217a	
217b	3'-0" x 7'-0"	WD1	HG	TEMP	HM	H1	J1/AE623	E1/AE623	–	21	–	217b	
218a	3'-0" x 7'-0"	WD1	F	N/A	HM	H1	J1/AE623	E1/AE623 HI E10/AE623 LO	–	27	–	218a	
218b	3'-0" x 7'-0"	WD1	HG	TEMP	HM	H1	J1/AE623	E1/AE623	–	21	–	218b	
219	3'-0" x 7'-0"	WD1	HG	TEMP	HM	H1	J1/AE623	E1/AE623	–	21	–	219	
220	3'-0" x 7'-0"	WD1	HG	TEMP	HM	H1	J7/AE623	E7/AE623	–	8	–	220	
221	3'-0" x 7'-0"	WD1	F	N/A	HM	H1	J1/AE623	E1/AE623	–	21	45	221	
222	3'-0" x 7'-0"	WD2	NL	TEMP	HM	H3	J10/AE623	E10/AE623	–	22	–	222	
226	3'-0" x 7'-0"	W1	NL	TEMP	HM	H3	J10/AE623	E10/AE623	–	23	–	226	
227	3'-0" x 7'-0"	WD1	F	N/A	HM	H1	J1/AE623	E1/AE623	–	8	–	227	
228	3'-0" x 7'-0"	WD1	F	N/A	HM	H1	J1/AE623	E1/AE623	–	8	–	228	
229a	3'-0" x 7'-0"	WD2	FG	TEMP	HM	H3	J10/AE623	E10/AE623	–	14	–	229a	
229b	3'-0" x 7'-0"	ALUM	FG	INS/TEMP	ALUM	A1	J1&E4/AE627	E7/AE628 HI E1/AE628 LO	–	27	–	229b	Hardware Scope RFI 342
229c	(2) 2'-6"x9'-6"	HM	F	N/A	HM	H1	J10/AE623	E10/AE623	–	9	–	229c	230b Change Hardware RFI 342
230a	3'-0" x 7'-0"	WD2	FG	TEMP	HM	H3	J1/AE623	E1/AE623	–	14	–	230a	
230	3'-0" x 7'-0"	ALUM	FG	INS/TEMP	ALUM	A1	J1&E4/AE627	E7/AE628 HI E1/AE628 LO	–	27	–	230	
231	3'-0" x 7'-0"	WD1	F	N/A	HM	H1	J1/AE623	E1/AE623	–	8	–	231	
232	3'-0" x 7'-0"	WD1	F	N/A	HM	H1	J1/AE623	E1/AE623	–	8	–	232	
233	3'-0" x 7'-0"	WD1	F	N/A	HM	H1	J1/AE623	E1/AE623	–	14	–	233	
234	3'-0" x 7'-0"	WD2	NL	TEMP	HM	H3	J10/AE623	E10/AE623	–	23	–	234	
235a	3'-0" x 7'-0"	WD1	HG	WIRE	HM	H1	J1/AE623	E1/AE623	–	25	45	235a	
235b	3'-0" x 7'-0"	WD1	F	N/A	HM	H1	J1/AE623	E1/AE623	–	21	45	235b	
236	3'-0" x 7'-0"	WD1	F	N/A	HM	H1	J1/AE623	E1/AE623	–	4	–	236	
237	3'-0" x 7'-0"	WD1	HG	TEMP	HM	H1	J1/AE623	E1/AE623	–	25	–	237	
238	3'-0" x 7'-0"	WD1	F	N/A	HM	H1	J1/AE623	E1/AE623	–	11	–	238	
239	3'-0" x 7'-0"	WD1	F	N/A	HM	H1	J1/AE623	E1/AE623	–	8	–	239	
240	3'-0" x 7'-0"	WD1	FG	TEMP	HM	H1	J1/AE623	E1/AE623	–	21	45	240	
242	3'-0" x 7'-0"	WD1	HG	TEMP	HM	H1	J1/AE623	E1/AE623	–	14	–	242	
244	3'-0" x 7'-0"	WD1	F	N/A	HM	H1	J1/AE623	E1/AE623	–	8	–	244	
245	3'-0" x 7'-0"	WD1	F	N/A	HM	H1	J1/AE623	E1/AE623	–	8	–	245	
249	3'-0" x 7'-0"	WD1	F	N/A	HM	H1	J1/AE623	E1/AE623	–	8	–	249	
250	3'-0" x 7'-0"	WD1	F	N/A	HM	H1	J1/AE623	E1/AE623	–	8	–	250	
251	3'-0" x 7'-0"	WD2	NL	TEMP	HM	H1	J10/AE623	E10/AE623	–	22	–	251	
252	3'-0" x 7'-0"	WD1	F	N/A	HM	H1	J1/AE623	E1/AE623	–	8	–	252	
253	3'-0" x 7'-0"	WD1	NL	TEMP	HM	H1	J1/AE623	E1/AE623	–	14	–	253	
254	3'-0" x 7'-0"	WD1	F	N/A	HM	H1	J1/AE623	E1/AE623	–	8	–	254	
255	3'-0" x 7'-0"	WD2	F	N/A	HM	H1	J10/AE623	E10/AE623	–	21	–	255	
256	2'-6" x 7'-0"	WD2	F	N/A	HM	H1	J10/AE623	E10/AE623	–	24	–	256	
257	3'-0" x 7'-0"	WD1	HG	TEMP	HM	H1	J4/AE624	E4/AE624	–	6	–	257	
258		See RFI-308 For Info											

SI-139 # Change to Wire Glass

GENERAL NOTES:

1. SEE G1001 FOR PROJECT GENERAL NOTES.

DOOR NOTES

1. ALL SWINGING DOORS TO BE 1-3/4" THICK (U.N.O.).
2. ALL DOORS SHALL BE 3/4" UNDERCUT (TYPICAL) EXCEPT WHEN THERE IS A BOTTOM FRAME, SILL THRESHOLD, WHERE RATED (1/2" UNDERCUT @ RATED LOCATIONS), OR SPECIFICALLY NOTED OTHERWISE.
3. ALL DOORS WITH BOTTOM FRAMES OR SILL THRESHOLDS SHALL HAVE MANUFACTURERS RECOMMENDED STANDARD UNDERCUT.
4. GLAZING NOTED ON DOOR SCHEDULE IS FOR THE DOOR AND SIDELIGHTS IN THE FRAME (TYPICAL).
5. SEE SPECIFICATIONS FOR HARDWARE SET DESCRIPTIONS.

DOOR ABBREVIATIONS

AL/ALUM	ALUMINUM
F	FLUSH
FG	FULL GLAZING
NL	NARROW LIGHT
HG	HALF GLAZING
HM	HOLLOW METAL
INS	INSULATED
STL	STEEL
SS	STAINLESS STEEL
TEMP	TEMPERED GLASS
WIRE	WIRE GLASS
WD1	PLAIN SLICED OAK
WD2	RIFF CUT OAK
LAM	LAMINATED GLASS

RFI-33 Doors + ADA Clearances

AS BUILT
Owner Copy

232
4105

SMRT
ARCHITECTURE ENGINEERING PLANNING
SMRT
144 Fore Street/P.O. Box 618
Portland, Maine 04104
tel. (207) 772-3846
fax. (207) 772-1070

STATE OF MAINE
SCOTT L BENSON
No. 1772
REGISTERED PROFESSIONAL ARCHITECT

PROJECT TITLE:
MAINE TURNPIKE AUTHORITY
ADMINISTRATION BUILDING
PORTLAND, MAINE

CURRENT ISSUE STATUS:
ISSUED FOR BIDDING/CONSTRUCTION
7-9-07

REV	DESCRIPTION	DATE
0	BIDDING/CONSTRUCTION	7-9-07

GRAPHIC SCALE: 0" 1"

SCALE: AS NOTED
PROJECT MANAGER: SLB
JC/DRAWN BY: TCM/TCM
A/E OF RECORD: SLB
CAD FILE: AE612-06016
PROJECT NO: 06016
DATE: 7-9-07

SHEET TITLE:
SECOND FLOOR DOOR SCHEDULE

SHEET No. AE612

© COPYRIGHT 2007 SMRT INC

A1	SECOND FLOOR DOOR SCHEDULE
NONE	– *

THIRD FLOOR DOOR SCHEDULE

DOOR NUMBER	DOOR SIZE	DOOR MATERIAL	DOOR ELEVATION	GLAZING	FRAME MATERIAL	FRAME ELEVATION	FRAME HEAD	FRAME JAMB	FRAME SILL	HWS	FIRE RATING (MIN.)	DOOR NUMBER	REMARKS
302	3'-0" x 7'-0"	WD2	F	N/A	HM	H1	J1/AE623 SIM	E1/AE623 SIM	–	2	–	302	
303	3'-0" x 7'-0"	WD2	F	N/A	HM	H1	J1/AE623 SIM	E1/AE623 SIM	–	2	–	303	
304	3'-0" x 7'-0"	WD1	NL	WIRE	HM	H1	J1/AE623	E1/AE623	–		60	304	
305	3'-0" x 7'-0"	WD1	NL	WIRE	HM	H1	J1/AE623	E1/AE623	–	3	60	305	
306	3'-0" x 7'-0"	WD1	F	N/A	HM	H1	J1/AE623	E1/AE623	–	13	–	306	
307	3'-0" x 7'-0"	WD1	F	N/A	HM	H1	J1/AE623	E1/AE623	–	13	–	307	
308	2'-8" x 7'-0"	WD1	F	N/A	HM	H1	J1/AE623	E1/AE623	–	13	–	308	
309	2'-8" x 7'-0"	WD1	F	N/A	HM	H1	J1/AE623	E1/AE623	–	5	–	309	Revise Locksets SI 84
310a	3'-0" x 7'-0"	WD2	FG	TEMP	HM	H3	J1/AE623	E1/AE623	–	20	–	310a	
310b	3'-0" x 7'-0"	WD2	FG	TEMP	HM	H3	J1/AE623	E1/AE623	–	20	–	310b	Change Hardware 310b RFI-342
310c	3'-0" x 7'-0"	ALUM	FG	INS/TEMP	HM	A1	J1&E4/AE627	E1/AE628	–	16	–	310c	
311	3'-0" x 7'-0"	WD2	F	N/A	HM	H1	J1/AE623	E1/AE623 HI E10/AE623 LO	–	24	–	311	
312	3'-0" x 7'-0"	WD2	LV	N/A	HM	H1	J1/AE623	E1/AE623 HI E10/AE623 LO	–	24	–	312	
313	3'-0" x 7'-0"	WD1	NL	TEMP	HM	H3	J1/AE623	E1/AE623 HI E10/AE623 LO	–	22	–	313	
314a	3'-0" x 7'-0"	WD2	NL	TEMP	HM	H1	J1/AE623	E1/AE623 HI E10/AE623 LO	–	25	–	314a	
314b	3'-0" x 7'-0"	WD2	F	N/A	HM	H1	J7/AE623	E7/AE623 HI A10/AE623 LO	–	25	–	314b	
315	3'-0" x 7'-0"	WD2	F	N/A	HM	H1	J7/AE623	E7/AE623 HI A10/AE623 LO	–	8	–	315	
316	3'-0" x 7'-0"	WD1	F	N/A	HM	H1	J1/AE623	E1/AE623	–	8	–	316	
318	3'-0" x 7'-0"	WD1	F	N/A	HM	H1	J1/AE623	E1/AE623	–	8	–	318	
320	3'-0" x 7'-0"	WD1	F	N/A	HM	H1	J7/AE623	E7/AE623	–	8	–	320	
321	3'-0" x 7'-0"	WD1	F	N/A	HM	H1	J1/AE623	E1/AE623	–	8	–	321	
322	3'-0" x 7'-0"	WD1	FG	TEMP	HM	H1	J1/AE623	E1/AE623	–	8	–	322	
323	3'-0" x 7'-0"	WD1	F	N/A	HM	H1	J1/AE623	E1/AE623	–	21	45	323	
325	3'-0" x 7'-0"	WD1	HG	TEMP	HM	H1	J1/AE623	E1/AE623	–	12	–	325	
327	3'-0" x 7'-0"	WD1	NL	TEMP	HM	H3	J1/AE623	E1/AE623 HI E10/AE623 LO	–	23	–	327	
328	3'-0" x 7'-0"	WD1	HG	TEMP	HM	H1	J1/AE623	E1/AE623	–	12	–	328	
329	3'-0" x 7'-0"	WD1	HG	TEMP	HM	H1	J1/AE623	E1/AE623	–	8	–	329	Cord Headers RFI 345
330	3'-0" x 7'-0"	HM	FG	TEMP	HM	H3	J1/AE623	E1/AE623 HI E10/AE623 LO	–	14	–	330	
331	3'-0" x 7'-0"	WD1	HG	TEMP	HM	H1	J1/AE623	E1/AE623	–	21	–	331	
332	3'-0" x 7'-0"	WD1	NL	TEMP	HM	H1	J1/AE623	E1/AE623	–	14	–	332	
333	3'-0" x 7'-0"	WD1	F	N/A	HM	H1	J1/AE623	E1/AE623	–	8	–	333	
334	3'-0" x 7'-0"	WD1	F	N/A	HM	H1	J1/AE623	E1/AE623	–	8	–	334	
335	3'-0" x 7'-0"	WD1	NL	TEMP	HM	H1	J1/AE623	E1/AE623	–	14	–	335	
336	3'-0" x 7'-0"	WD1	NL	TEMP	HM	H3	J1/AE623	E1/AE623 HI E10/AE623 LO	–	23	–	336	
337	3'-0" x 7'-0"	WD1	F	N/A	HM	H1	J1/AE623	E1/AE623	–	14	–	337	
338	3'-0" x 7'-0"	WD1	HG	TEMP	HM	H1	J1/AE623	E1/AE623	–	8	–	338	
339	3'-0" x 7'-0"	WD1	FG	TEMP	HM	H1	J1/AE623	E1/AE623	–	14	–	339	
340	3'-0" x 7'-0"	WD1	F	N/A	HM	H1	J1/AE623	E1/AE623	–	8	–	340	
341	3'-0" x 7'-0"	WD1	F	N/A	HM	H1	J1/AE623	E1/AE623	–	8	–	341	
342	3'-0" x 7'-0"	WD1	F	N/A	HM	H1	J1/AE623	E1/AE623	–	8	–	342	
345a	3'-0" x 7'-0"	WD1	HG	TEMP	HM	H1	J7/AE623	E7/AE623	–	8	–	345a	
345b	3'-0" x 7'-0"	WD1	F	N/A	HM	H1	J7/AE623	E7/AE623	–	8	–	345b	
346	3'-0" x 7'-0"	WD1	F	N/A	HM	H1	J7/AE623	E7/AE623	–	8	–	346	
347	3'-0" x 7'-0"	WD1	F	N/A	HM	H1	J1/AE623	E1/AE623	–	11	–	347	DELETE KICK PLATE
348	3'-0" x 7'-0"	WD1	F	N/A	HM	H1	J1/AE623	E1/AE623	–	8	–	348	
349	3'-0" x 7'-0"	WD1	FG	TEMP	HM	H1	J4/AE623	E4/AE623	–	14	–	349	
350	3'-0" x 7'-0"	WD1	F	N/A	HM	H1	J1/AE623	E1/AE623	–	24	–	350	
351	3'-0" x 7'-0"	WD1	F	N/A	HM	H1	J1/AE623	E1/AE623	–	8	–	351	
352	3'-0" x 7'-0"	WD2	F	N/A	HM	H1	J7/AE623	E7/AE623 HI A10/AE623 LO	–	8	–	352	DELETE KICK PLATE
353	3'-0" x 7'-0"	WD1	HG	TEMP	HM	H1	J1/AE623	E1/AE623	–	8	–	353	
354	3'-0" x 7'-0"	WD2	NL	TEMP	HM	H3	J1/AE623	E1/AE623 HI E10/AE623 LO	–	23	–	354	

347A Auxiliary Lockset SI-85

GENERAL NOTES:

1. SEE GI001 FOR PROJECT GENERAL NOTES.

DOOR NOTES

1. ALL SWINGING DOORS TO BE 1-3/4" THICK (U.N.O.).
2. ALL DOORS SHALL BE 3/4" UNDERCUT (TYPICAL) EXCEPT WHEN THERE IS A BOTTOM FRAME, SILL THRESHOLD, WHERE RATED (1/2" UNDERCUT @ RATED LOCATIONS), OR SPECIFICALLY NOTED OTHERWISE.
3. ALL DOORS WITH BOTTOM FRAMES OR SILL THRESHOLDS SHALL HAVE MANUFACTURERS RECOMMENDED STANDARD UNDERCUT.
4. GLAZING NOTED ON DOOR SCHEDULE IS FOR THE DOOR AND SIDELIGHTS IN THE FRAME (TYPICAL).
5. SEE SPECIFICATIONS FOR HARDWARE SET DESCRIPTIONS.

DOOR ABBREVIATIONS

AL/ALUM	ALUMINUM
F	FLUSH
FG	FULL GLAZING
NL	NARROW LIGHT
HG	HALF GLAZING
HM	HOLLOW METAL
INS	INSULATED
STL	STEEL
SS	STAINLESS STEEL
TEMP	TEMPERED GLASS
WIRE	WIRE GLASS
WD1	PLAIN SLICED OAK
WD2	RIFF CUT OAK
LAM	LAMINATED GLASS

RFI-33 Door's & ADA Clearances

AS BUILT
Owner Copy

A1	THIRD FLOOR DOOR SCHEDULE
NONE	– *

SMRT
ARCHITECTURE ENGINEERING PLANNING
SMRT
144 Fore Street/P.O. Box 618
Portland, Maine 04104
tel. (207) 772-3846
fax. (207) 772-1070

STATE OF MAINE
SCOTT L. BENSON
No. 1772
REGISTERED PROFESSIONAL ARCHITECT

PROJECT TITLE:
MAINE TURNPIKE AUTHORITY
ADMINISTRATION BUILDING
PORTLAND, MAINE

CURRENT ISSUE STATUS:
ISSUED FOR BIDDING/CONSTRUCTION
7-9-07

REV	DESCRIPTION	DATE
0	BIDDING/CONSTRUCTION	7-9-07


GRAPHIC SCALE: 0" 1"

SCALE:	AS NOTED
PROJECT MANAGER:	SLB
JC/DRAWN BY:	TCM/TCM
A/E OF RECORD:	SLB
CAD FILE:	AE613-06016
PROJECT NO:	06016
DATE:	7-9-07

SHEET TITLE: THIRD FLOOR DOOR SCHEDULE


SHEET No. AE613

©COPYRIGHT 2007 SMRT INC.

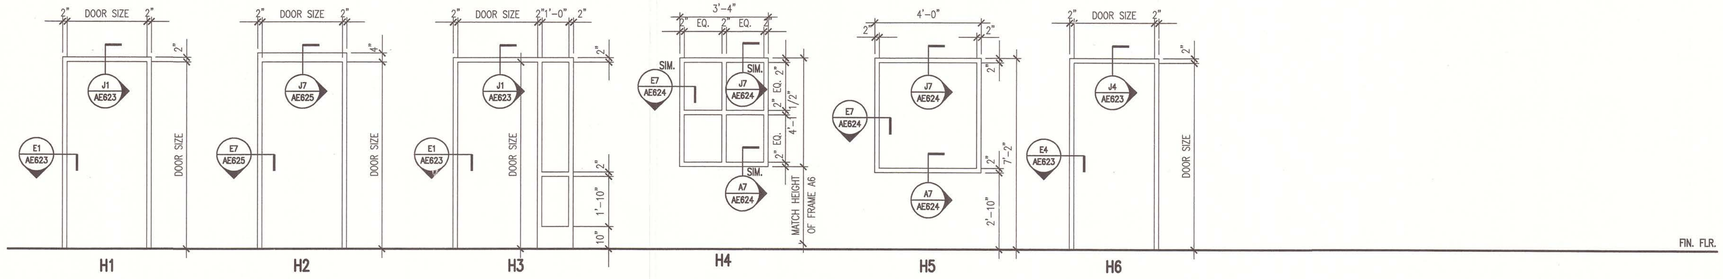


J1 HOLLOW METAL FRAME ELEVATIONS

3/8" = 1'-0"

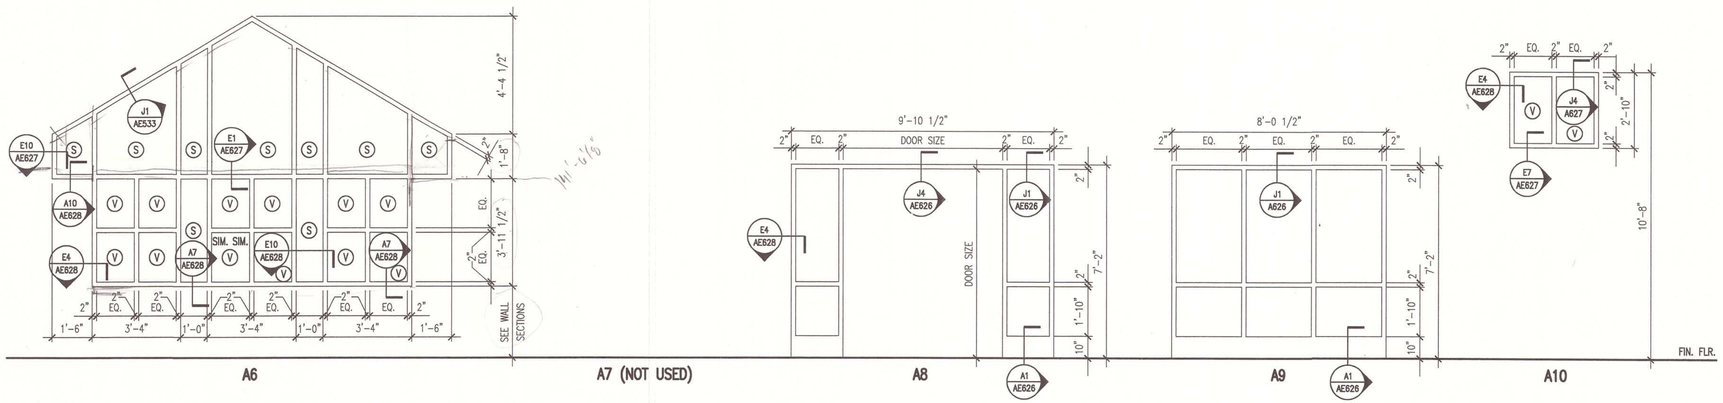

E1 ALUMINUM FRAME ELEVATIONS

3/8" = 1'-0"

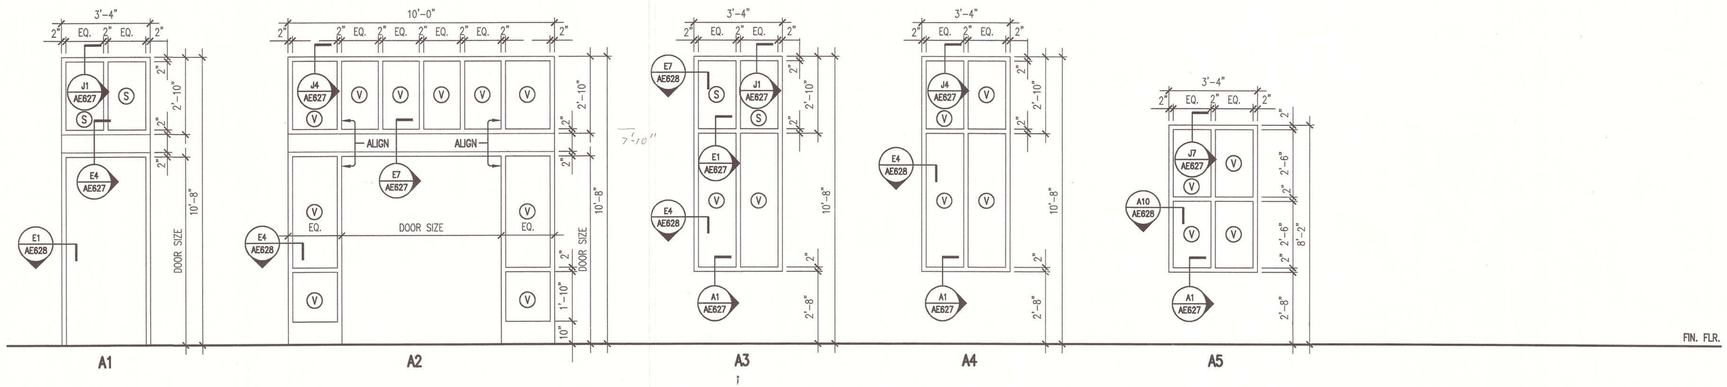

A1 ALUMINUM FRAME ELEVATIONS

3/8" = 1'-0"

GENERAL NOTES:

1. SEE GI001 FOR PROJECT GENERAL NOTES.

GLAZING TYPES:

(V) VISION GLAZING PANEL

(S) SPANDREL GLAZING PANEL

AS BUILT
Owner Copy

SMRT
ARCHITECTURE ENGINEERING PLANNING
SMRT
144 Fore Street/P.O. Box 618
Portland, Maine 04104
tel. (207) 772-3846
fax. (207) 772-1070

STATE OF MAINE
SCOTT L BENSON
No. 1772
REGISTERED PROFESSIONAL ARCHITECT

PROJECT TITLE:
MAINE TURNPIKE AUTHORITY
ADMINISTRATION BUILDING
PORTLAND, MAINE

CURRENT ISSUE STATUS:
ISSUED FOR BIDDING/CONSTRUCTION
7-9-07

REV	DESCRIPTION	DATE
0	BIDDING/CONSTRUCTION	7-9-07


GRAPHIC SCALE: 0" 1"

SCALE:	AS NOTED
PROJECT MANAGER:	SLB
JC/DRAWN BY:	TCM/TCM
A/E OF RECORD:	SLB
CAD FILE:	AE621-06016
PROJECT NO:	06016
DATE:	7-9-07

SHEET TITLE:
DOOR & WINDOW ELEVATIONS


SHEET No.
AE621

©COPYRIGHT 2007 SMRT INC.

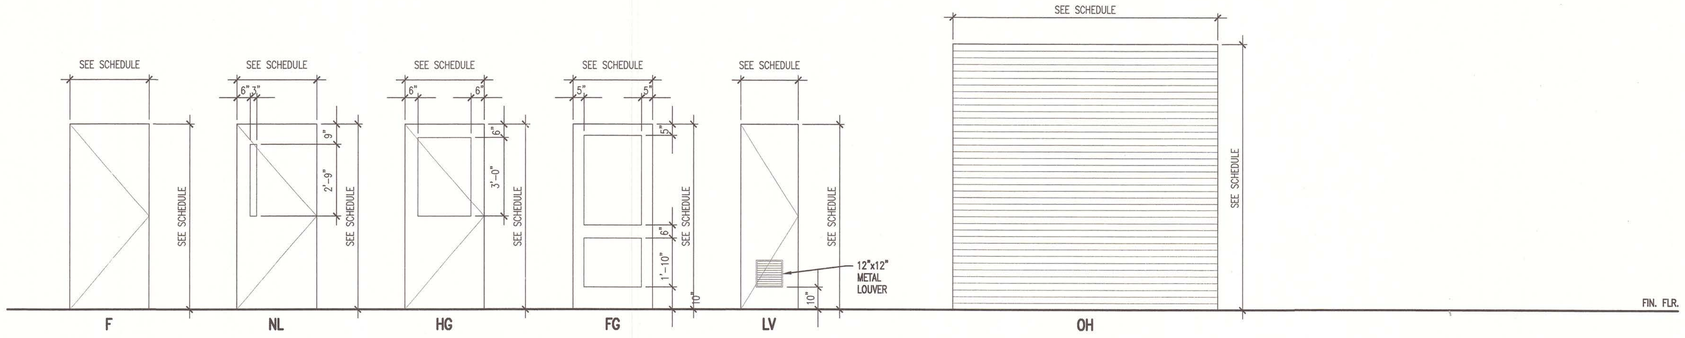


J1 DOOR TYPE ELEVATIONS

3/8" = 1'-0"

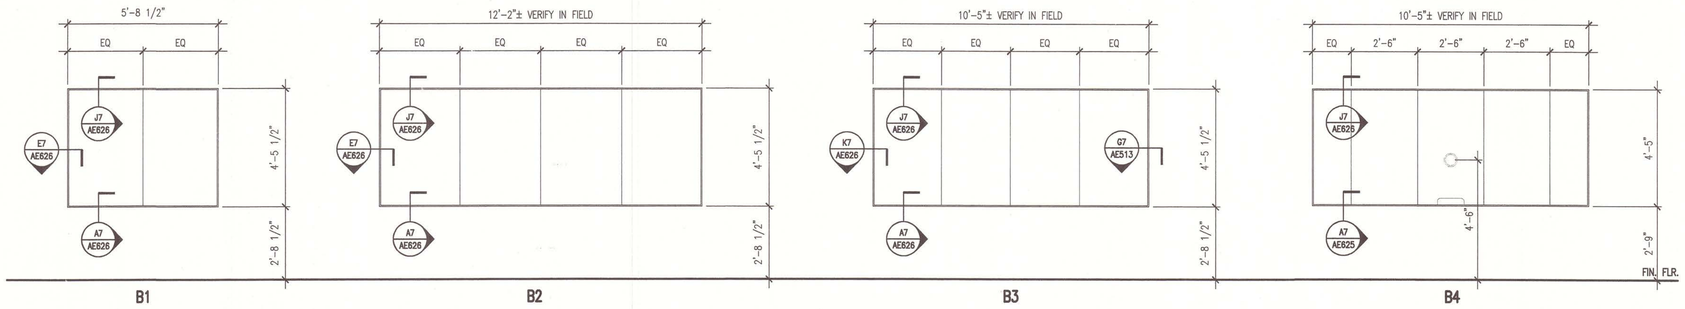

E1 BUTT-GLAZED FRAME ELEVATIONS

3/8"=1'-0" AE102

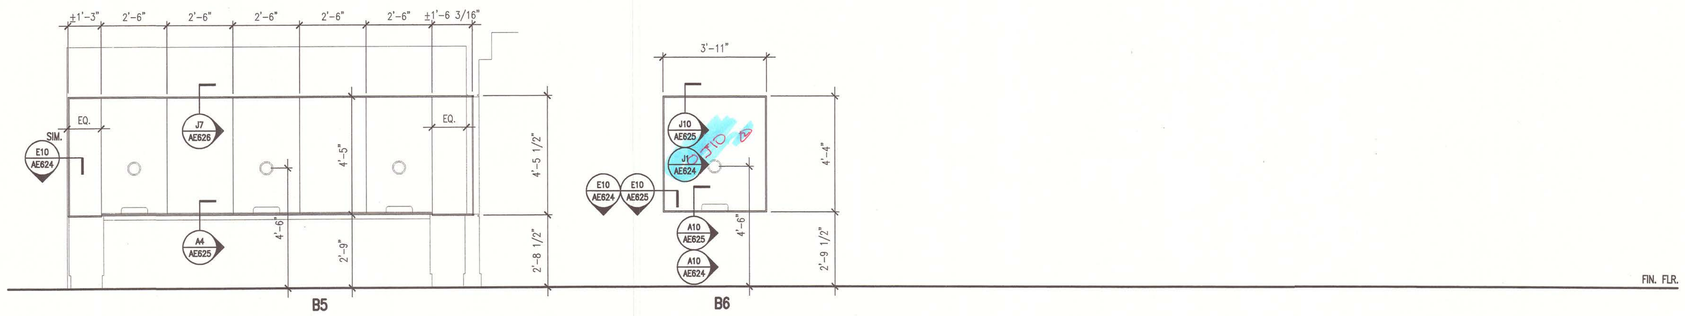

A1 BUTT-GLAZED FRAME ELEVATIONS

3/8" = 1'-0" AE101, AE102 & AE103

GENERAL NOTES:

1. SEE GI001 FOR PROJECT GENERAL NOTES.

SMRT
ARCHITECTURE ENGINEERING PLANNING
SMRT
144 Fore Street/P.O. Box 618
Portland, Maine 04104
tel. (207) 772-3846
fax. (207) 772-1070

STATE OF MAINE SCOTT L BENSON No. 1772 REGISTERED PROFESSIONAL ARCHITECT

PROJECT NORTH
MAG NORTH

PROJECT TITLE:
MAINE TURNPIKE AUTHORITY ADMINISTRATION BUILDING
PORTLAND, MAINE

CURRENT ISSUE STATUS:
ISSUED FOR BIDDING/CONSTRUCTION 7-9-07

REV	DESCRIPTION	DATE
0	BIDDING/CONSTRUCTION	7-9-07

GRAPHIC SCALE: 0" 1"


SCALE:	AS NOTED
PROJECT MANAGER:	SLB
JC/DRAWN BY:	TCM/TCM
A/E OF RECORD:	SLB
CAD FILE:	AE622-06016
PROJECT NO:	06016
DATE:	7-9-07

SHEET TITLE:
DOOR & WINDOW ELEVATIONS


SHEET No. AE622

© COPYRIGHT 2007 SMRT INC.


AS BUILT
Owner Copy

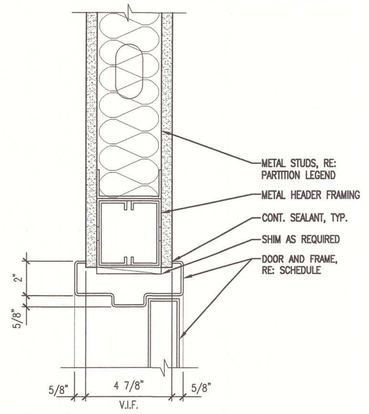


J1	HEAD DETAIL
3" = 1'-0"	–

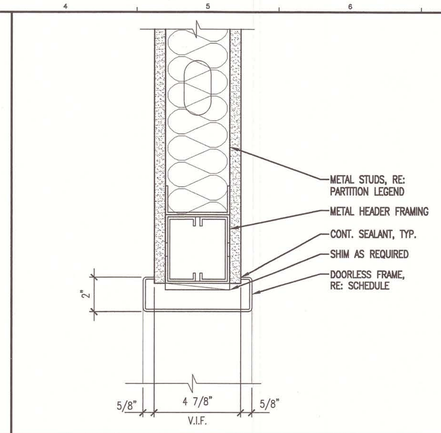


J4	HEAD DETAIL
3" = 1'-0"	–

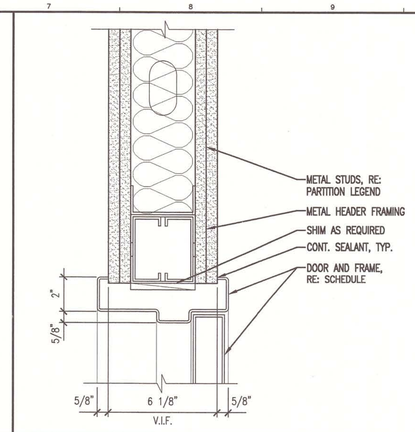


J7	HEAD DETAIL
3" = 1'-0"	–

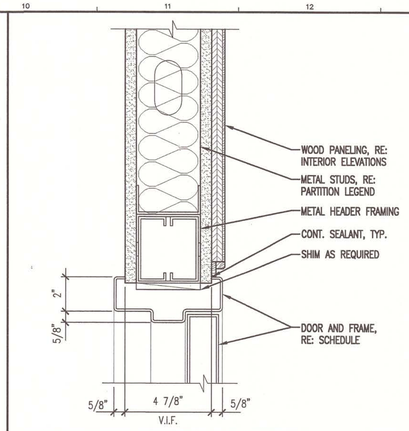


J10	HEAD DETAIL
3" = 1'-0"	–

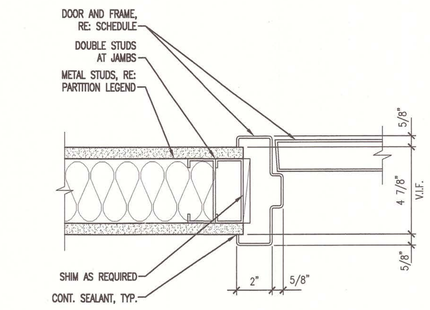


E1	JAMB DETAIL
3" = 1'-0"	–

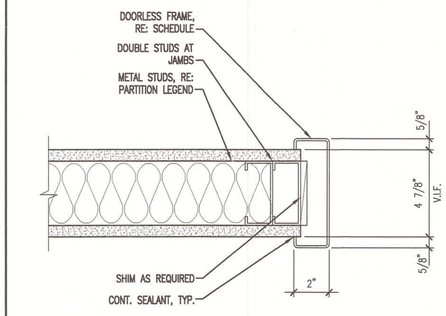


E4	JAMB DETAIL
3" = 1'-0"	–

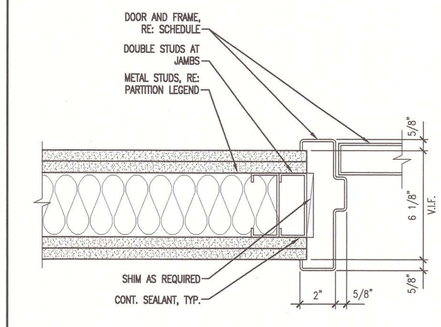

E7	JAMB DETAIL
3" = 1'-0"	–

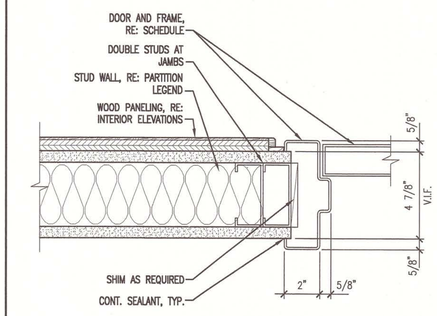


E10	JAMB DETAIL
3" = 1'-0"	–

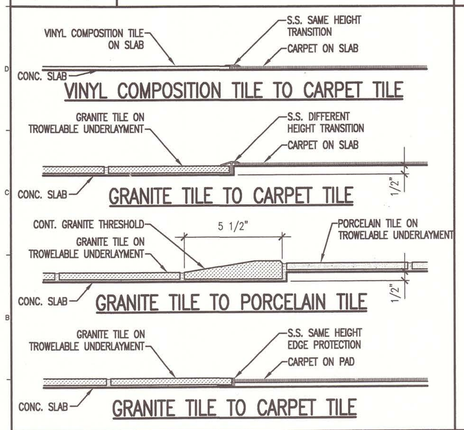

A1	FLOOR MATERIAL TRANSITIONS
3" = 1'-0"	

A4	–
*	–

A7	–
*	–

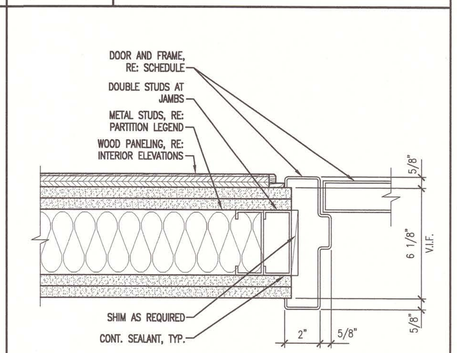

A10	JAMB DETAIL
3" = 1'-0"	–

GENERAL NOTES:

1. SEE G1001 FOR PROJECT GENERAL NOTES.

SMRT
ARCHITECTURE ENGINEERING PLANNING
SMRT
144 Fore Street/P.O. Box 618
Portland, Maine 04104
tel. (207) 772-3846
fax. (207) 772-1070

STATE OF MAINE SCOTT L BENSON No. 1772 REGISTERED PROFESSIONAL ARCHITECT

PROJECT TITLE:
MAINE TURNPIKE AUTHORITY
ADMINISTRATION BUILDING
PORTLAND, MAINE

CURRENT ISSUE STATUS:
ISSUED FOR BIDDING/CONSTRUCTION
7-9-07

REV	DESCRIPTION	DATE
0	BIDDING/CONSTRUCTION	7-9-07

GRAPHIC SCALE: 0" 1"

SCALE:	AS NOTED
PROJECT MANAGER:	SLB
JC/DRAWN BY:	TCM/TCM
A/E OF RECORD:	SLB
CAD FILE:	AE623-06016
PROJECT NO:	06016
DATE:	7-9-07

SHEET TITLE:
DOOR & WINDOW DETAILS


SHEET No.
AE623

© COPYRIGHT 2007 SMRT INC.


AS BUILT
Owner Copy

J1	–
*	–


J4	HEAD DETAIL
3" = 1'–0"	–

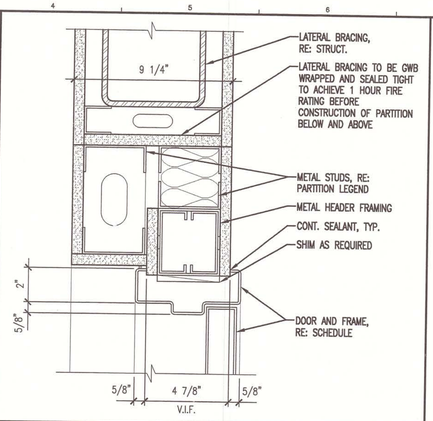

J7	HEAD DETAIL
3" = 1'–0"	–

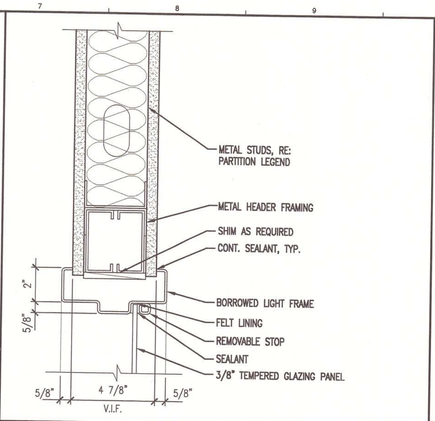


J10	HEAD DETAIL
3" = 1'–0"	–

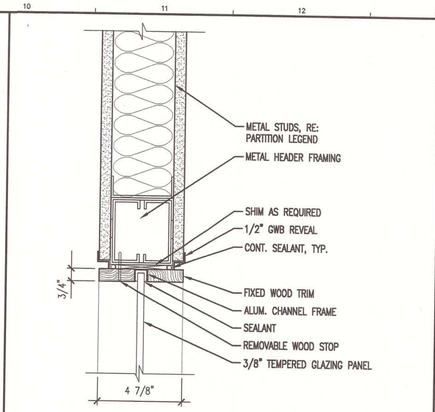


GENERAL NOTES:

1. SEE GI001 FOR PROJECT GENERAL NOTES.


E1	JAMB DETAIL
3" = 1'–0"	–

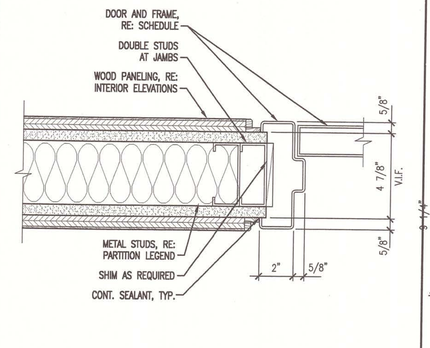


E4	JAMB DETAIL
3" = 1'–0"	–

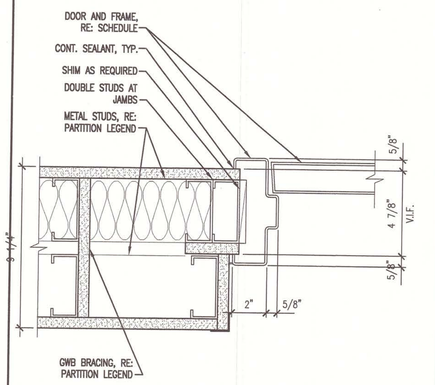

E7	JAMB DETAIL
3" = 1'–0"	–

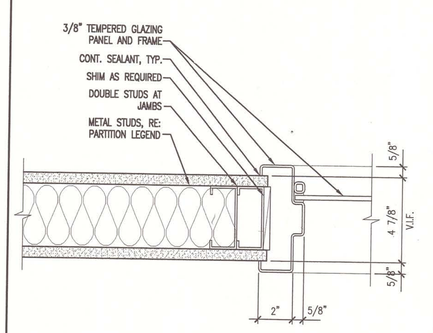


E10	JAMB DETAIL
3" = 1'–0"	–

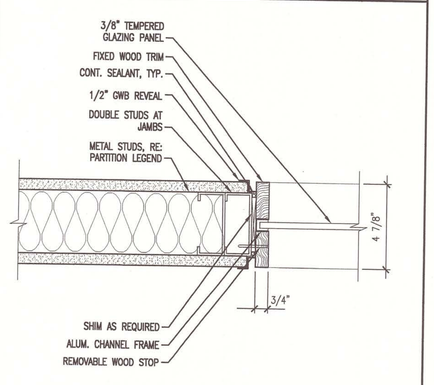


A1	–
*	


A4	SILL DETAIL
3" = 1'–0"	–

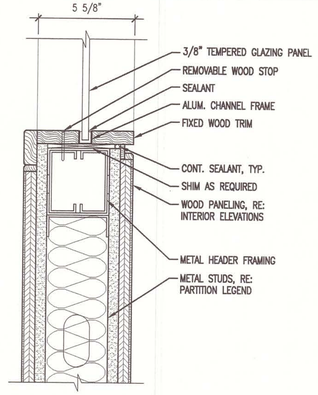

A7	SILL DETAIL
3" = 1'–0"	–

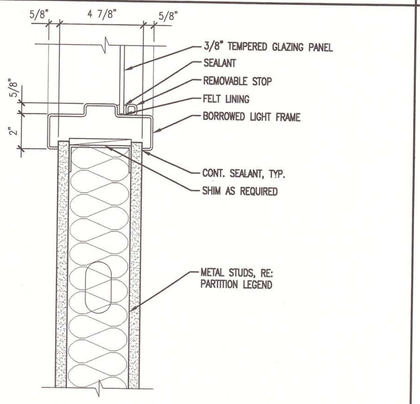

A10	SILL DETAIL
3" = 1'–0"	–

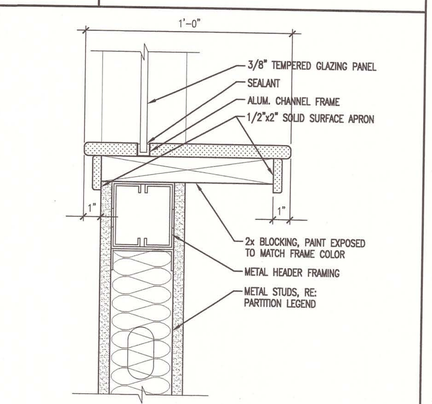

AS BUILT
Owner Copy

SMRT
ARCHITECTURE ENGINEERING PLANNING
SMRT
144 Fore Street / P.O. Box 618
Portland, Maine 04104
tel. (207) 772-3846
fax. (207) 772-1070

STATE OF MAINE
SCOTT L BENSON
No. 1772
REGISTERED PROFESSIONAL ARCHITECT

PROJECT NORTH
MAG. NORTH

PROJECT TITLE:
MAINE TURNPIKE AUTHORITY
ADMINISTRATION BUILDING
PORTLAND, MAINE

CURRENT ISSUE STATUS:
ISSUED FOR BIDDING/CONSTRUCTION
7-9-07

REV	DESCRIPTION	DATE
0	BIDDING/CONSTRUCTION	7-9-07


GRAPHIC SCALE: 0" 1"

SCALE:	AS NOTED
PROJECT MANAGER:	SLB
JC/DRAWN BY:	TCM/TCM
A/E OF RECORD:	SLB
CAD FILE:	AE624–06016
PROJECT NO:	06016
DATE:	7-9-07

SHEET TITLE:
DOOR & WINDOW DETAILS

SHEET No.
AE624

© COPYRIGHT 2007 SMRT INC

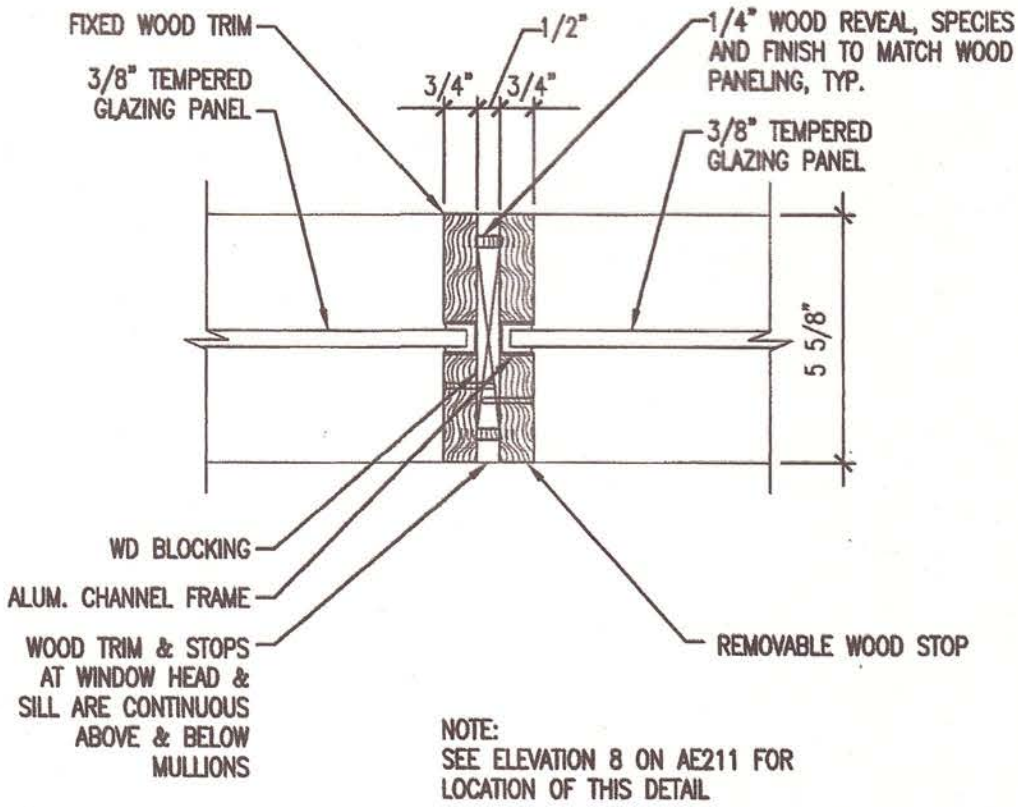


NOTE:
SEE ELEVATION 8 ON AE211 FOR LOCATION OF THIS DETAIL

E4	JAMB DETAIL
3" = 1'-0"	–

SMRT
ARCHITECTURE ENGINEERING PLANNING
SMRT
144 Fore Street/P.O.Box 618 PORTLAND, MAINE 04104
tel. (207) 772-3846 / fax. (207) 772-1070

PROJECT:	MAINE TURNPIKE AUTHORITY ADMINISTRATION BUILDING
SUBJECT:	ADD DETAIL E4/AE626 AS DESCRIBED

SCALE:	3"=1'-0"
CAD FILE:	AE626-06016
PROJECT No.	06016
REF. SHEET:	AE626
PM: SLB	SUPPLEMENTAL INSTRUCTION SI-64
A/E: SLB	SKETCH No. A-3
DATE:	© COPYRIGHT 2008 SMRT INC.

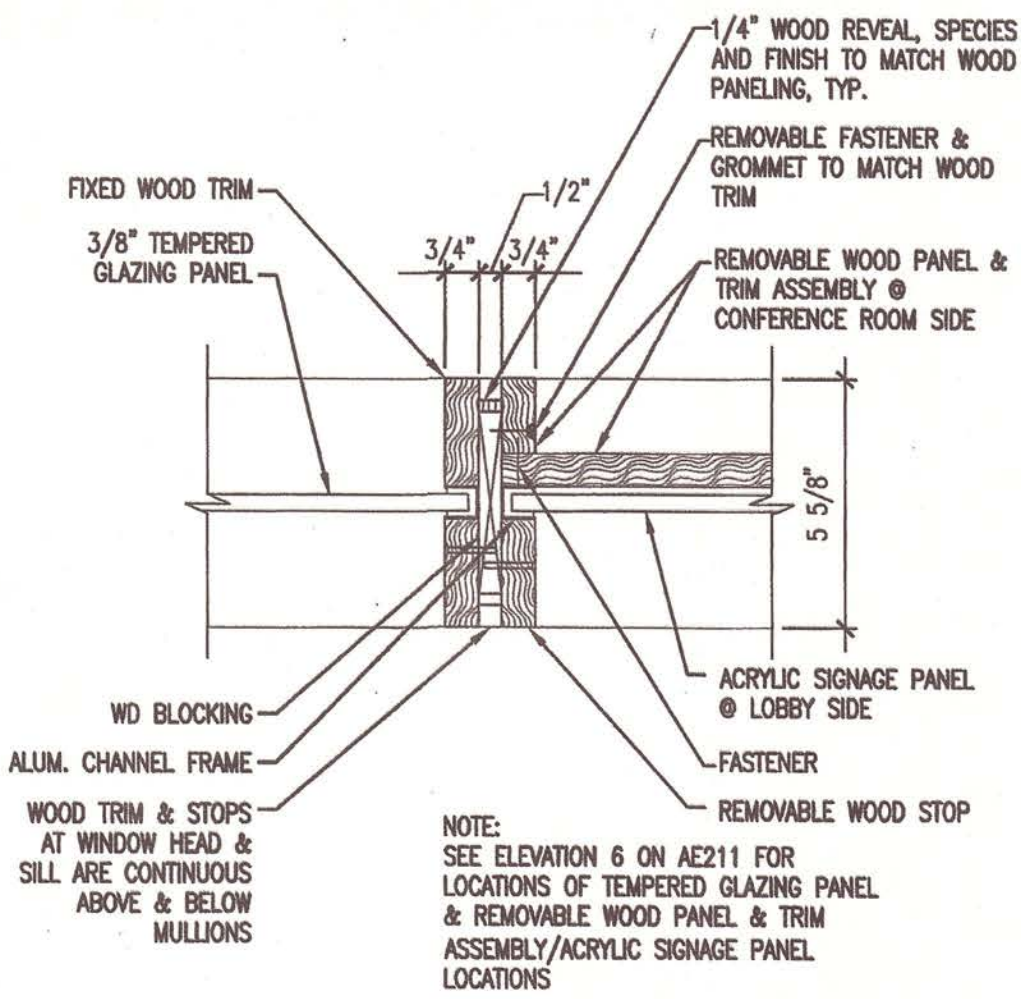


NOTE:
SEE ELEVATION 6 ON AE211 FOR LOCATIONS OF TEMPERED GLAZING PANEL & REMOVABLE WOOD PANEL & TRIM ASSEMBLY/ACRYLIC SIGNAGE PANEL LOCATIONS

E1	JAMB DETAIL
3" = 1'-0"	–

SMRT
ARCHITECTURE ENGINEERING PLANNING
SMRT
144 Fore Street/P.O.Box 618 PORTLAND, MAINE 04104
tel. (207) 772-3846 / fax. (207) 772-1070

PROJECT:	MAINE TURNPIKE AUTHORITY ADMINISTRATION BUILDING
SUBJECT:	ADD DETAIL E1/AE626 AS DESCRIBED


SCALE:	3"=1'-0"
CAD FILE:	AE626-06016
PROJECT No.	06016
REF. SHEET:	AE626
PM: SLB	SUPPLEMENTAL INSTRUCTION SI-64R
A/E: SLB	SKETCH No. A-2
DATE:	© COPYRIGHT 2008 SMRT INC.

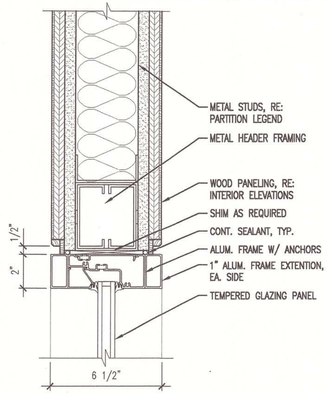

J1	HEAD DETAIL
3" = 1'-0"	–

See oposite Page


ST-64R

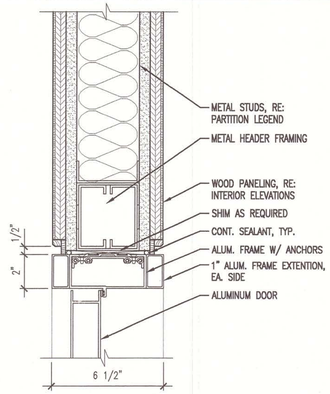


J4	HEAD DETAIL
3" = 1'-0"	–

See oposite Page

SI-64R

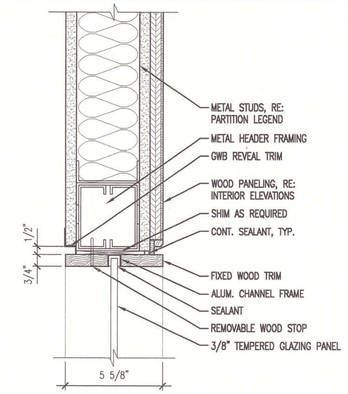


J7	HEAD DETAIL
3" = 1'-0"	–

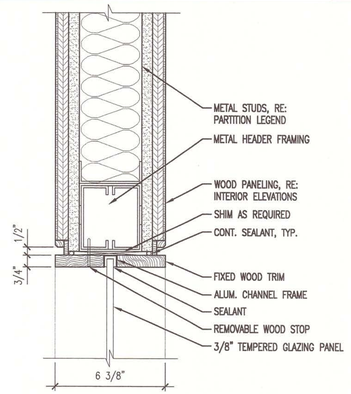


J10	HEAD DETAIL
3" = 1'-0"	–

E1	– Jamb Detail
*	–


E4	– Jamb Detail
*	–

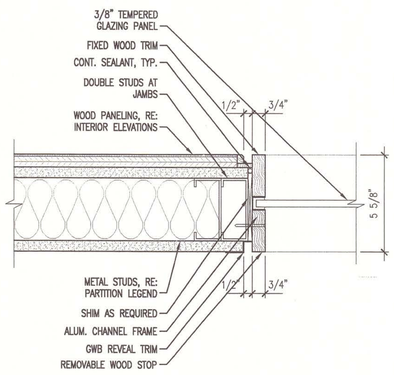


E7	JAMB DETAIL
3" = 1'-0"	–

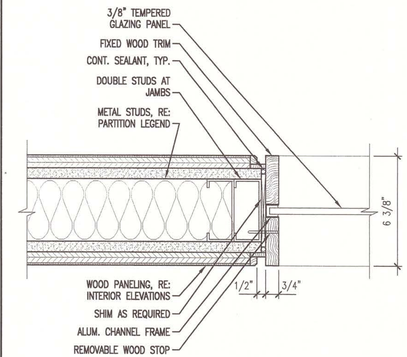


E10	JAMB DETAIL
3" = 1'-0"	–

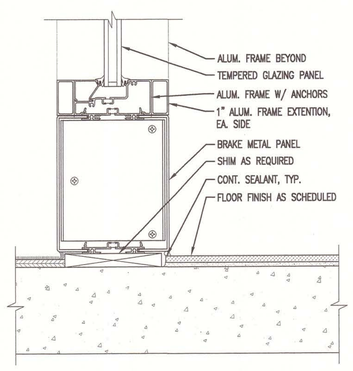


A1	SILL DETAIL
3" = 1'-0"	

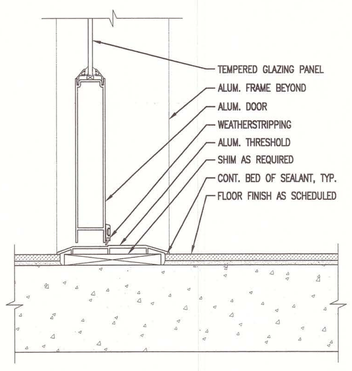

A4	THRESHOLD DETAIL
3" = 1'-0"	–

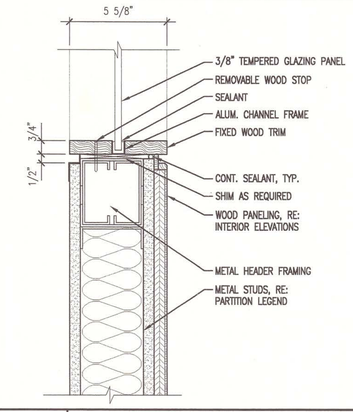

A7	SILL DETAIL
3" = 1'-0"	–

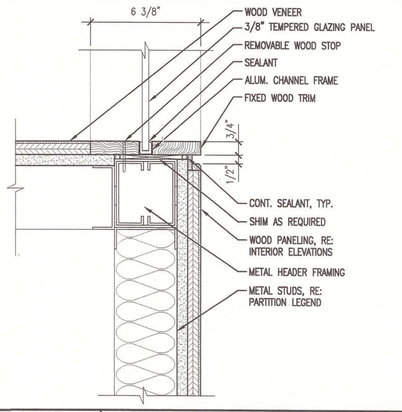

A10	SILL DETAIL
3" = 1'-0"	–

GENERAL NOTES:

1. SEE GI001 FOR PROJECT GENERAL NOTES.

AS BUILT
Owner Copy

SMRT
ARCHITECTURE ENGINEERING PLANNING
SMRT
144 Fore Street/P.O. Box 618
Portland, Maine 04104
tel. (207) 772-3846
fax. (207) 772-1070

STATE OF MAINE
SCOTT L BENSON
No. 1772
REGISTERED PROFESSIONAL ARCHITECT

PROJECT NORTH
MAG NORTH

PROJECT TITLE:
MAINE TURNPIKE AUTHORITY ADMINISTRATION BUILDING
PORTLAND, MAINE

CURRENT ISSUE STATUS:
ISSUED FOR BIDDING/CONSTRUCTION 7-9-07

REV	DESCRIPTION	DATE
0	BIDDING/CONSTRUCTION	7-9-07


GRAPHIC SCALE: 0" 1"

SCALE:	AS NOTED
PROJECT MANAGER:	SLB
JC/DRAWN BY:	TCM/TCM
A/E OF RECORD:	SLB
CAD FILE:	AE626-06016
PROJECT NO:	06016
DATE:	7-9-07


SHEET TITLE:
DOOR & WINDOW DETAILS

SHEET No.
AE626


©COPYRIGHT 2007 SMRT INC.

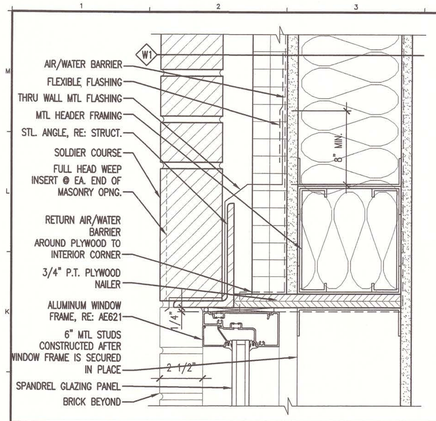

J1	HEAD DETAIL
3" = 1'-0"	–

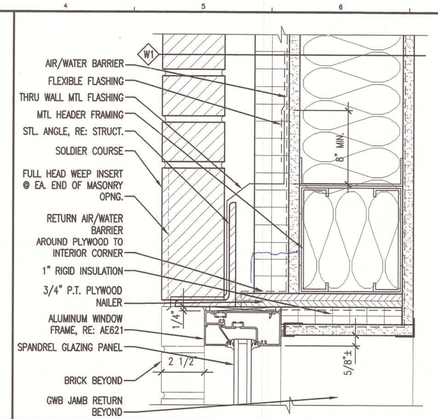

J4	HEAD DETAIL
3" = 1'-0"	–

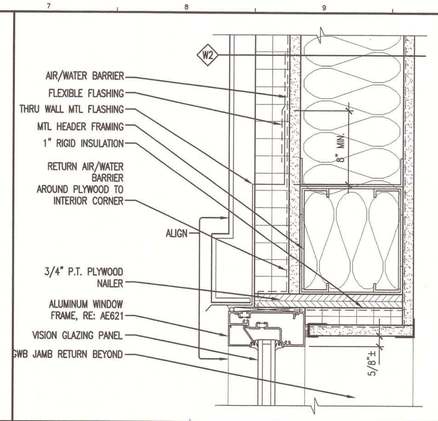


J7	HEAD DETAIL
3" = 1'-0"	–


J10	–
*	–

GENERAL NOTES:


1. SEE G001 FOR PROJECT GENERAL NOTES.

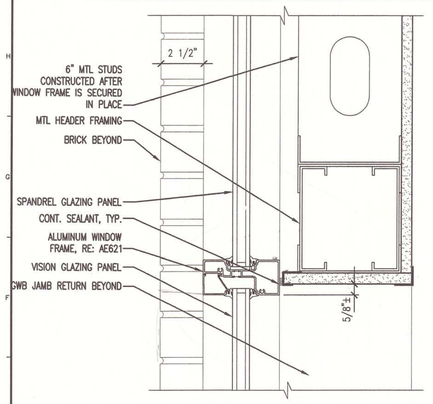


E1	MULLION DETAIL
3" = 1'-0"	–

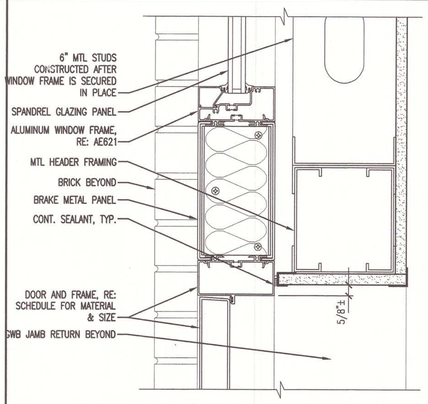


E4	MULLION DETAIL
3" = 1'-0"	–

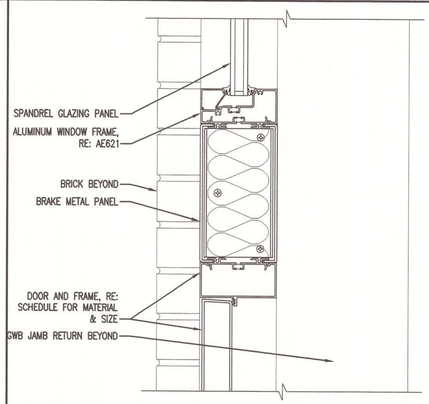


E7	MULLION DETAIL
3" = 1'-0"	–

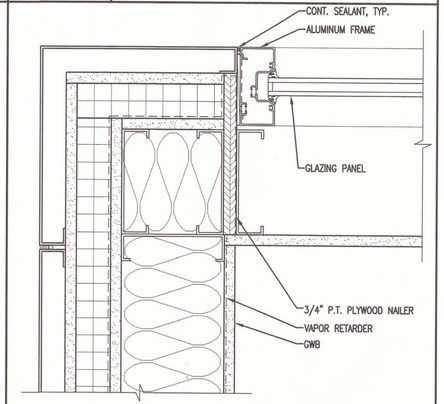


E10	JAMB DETAIL
3" = 1'-0"	–

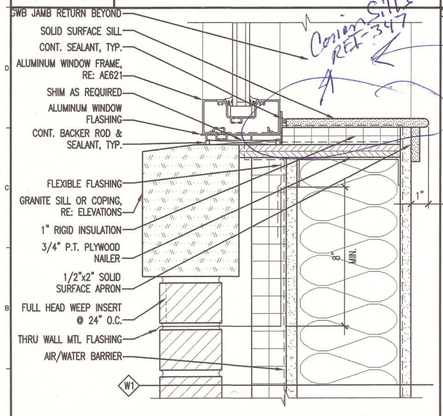


A1	SILL DETAIL
3" = 1'-0"	

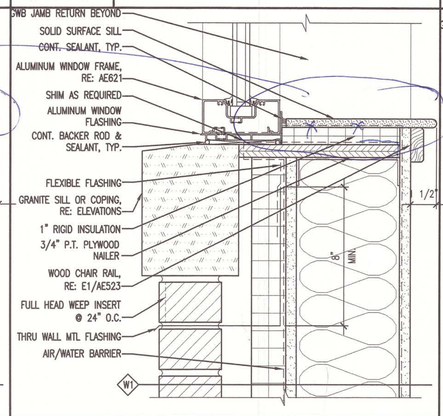

A4	SILL DETAIL
3" = 1'-0"	–

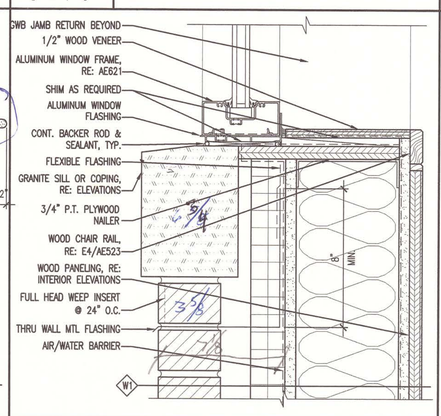

A7	SILL DETAIL
3" = 1'-0"	–

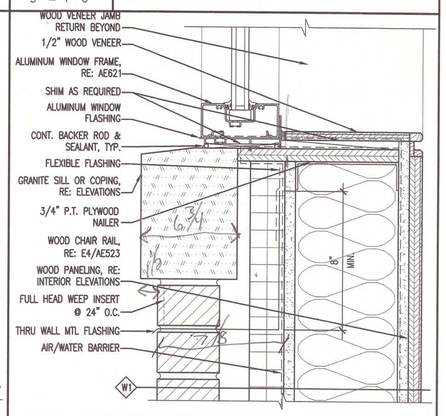

A10	SILL DETAIL
3" = 1'-0"	–

AS BUILT
Owner Copy

SMRT
ARCHITECTURE ENGINEERING PLANNING
SMRT
144 Fore Street/P.O. Box 618
Portland, Maine 04104
tel. (207) 772-3846
fax. (207) 772-1070

STATE OF MAINE
SCOTT L. BENSON
No. 1772
REGISTERED PROFESSIONAL ARCHITECT

PROJECT NORTH
MAG. NORTH

PROJECT TITLE:
MAINE TURNPIKE AUTHORITY
ADMINISTRATION BUILDING
PORTLAND, MAINE

CURRENT ISSUE STATUS:
ISSUED FOR BIDDING/CONSTRUCTION
7-9-07

REV	DESCRIPTION	DATE
0	BIDDING/CONSTRUCTION	7-9-07


GRAPHIC SCALE: 0" 1"

SCALE:	AS NOTED
PROJECT MANAGER:	SLB
JC/DRAWN BY:	TCM/TCM
A/E OF RECORD:	SLB
CAD FILE:	AE627-06016
PROJECT NO:	06016
DATE:	7-9-07


SHEET TITLE:
DOOR & WINDOW DETAILS

SHEET No.
AE627


©COPYRIGHT 2007 SMRT INC.

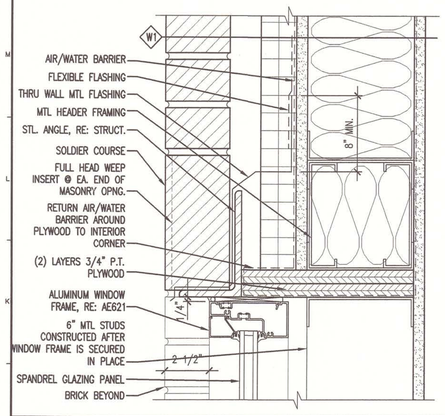


J1	HEAD DETAIL @ DOOR FRAME	J4	–	J7	–	J10	–
3" = 1'–0"	–	*	–	*	–	*	–

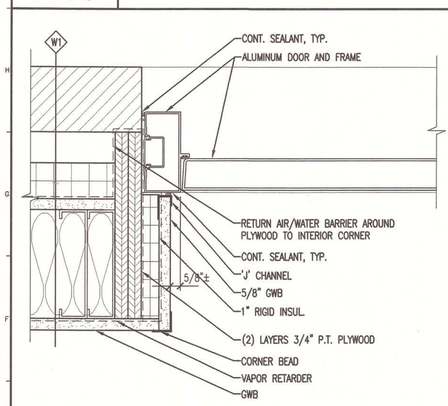


E1	JAMB DETAIL @ DOOR FRAME
3" = 1'–0"	–

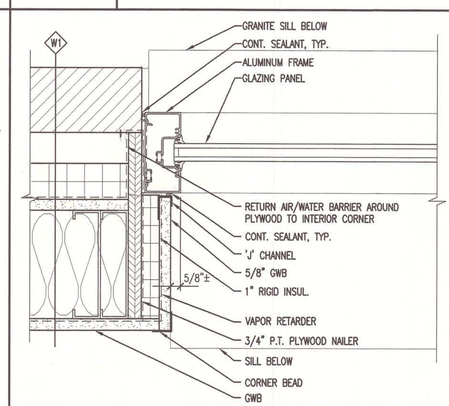

E4	JAMB DETAIL @ WINDOW
3" = 1'–0"	–

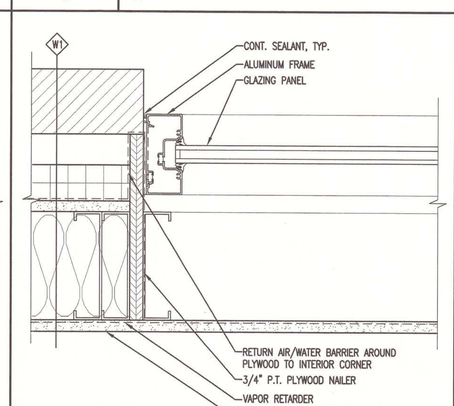


E7	JAMB DETAIL @ WINDOW
3" = 1'–0"	–

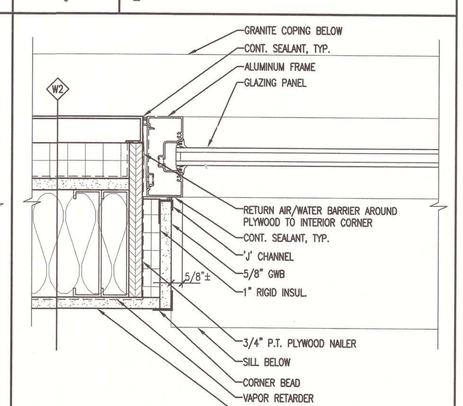


E10	JAMB DETAIL @ WINDOW
3" = 1'–0"	–


A1	–
*	

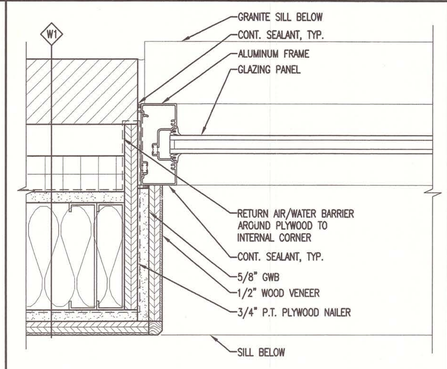

A4	JAMB DETAIL @ WINDOW
3" = 1'–0"	–

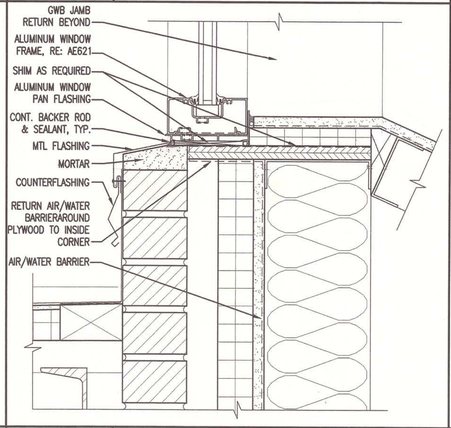

A7	SILL DETAIL
3" = 1'–0"	–

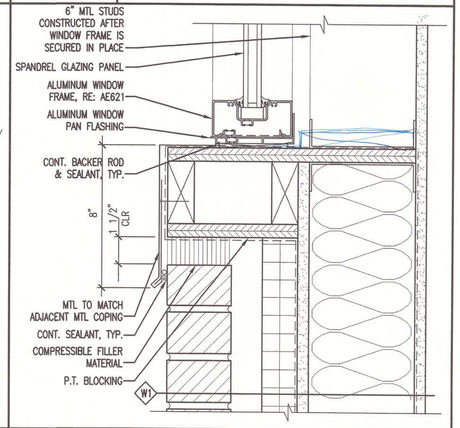

A10	SILL DETAIL ? Where ?
3" = 1'–0"	–

GENERAL NOTES:

1. SEE G1001 FOR PROJECT GENERAL NOTES.

AS BUILT
Owner Copy

SMRT
ARCHITECTURE ENGINEERING PLANNING
SMRT
144 Fore Street/P.O. Box 618
Portland, Maine 04104
tel. (207) 772-3846
fax. (207) 772-1070

STATE OF MAINE
SCOTT L. BENSON
No. 1772
REGISTERED PROFESSIONAL ARCHITECT

PROJECT NORTH
MAG. NORTH

PROJECT TITLE:
MAINE TURNPIKE AUTHORITY ADMINISTRATION BUILDING
PORTLAND, MAINE

CURRENT ISSUE STATUS:
ISSUED FOR BIDDING/CONSTRUCTION 7-9-07

REV	DESCRIPTION	DATE
0	BIDDING/CONSTRUCTION	7-9-07


GRAPHIC SCALE: 0" 1"

SCALE:	AS NOTED
PROJECT MANAGER:	SLB
JC/DRAWN BY:	TCM/TCM
A/E OF RECORD:	SLB
CAD FILE:	AE628–06016
PROJECT NO:	06016
DATE:	7-9-07

SHEET TITLE:
DOOR & WINDOW DETAILS

SHEET No.
AE628

© COPYRIGHT 2007 SMRT INC.

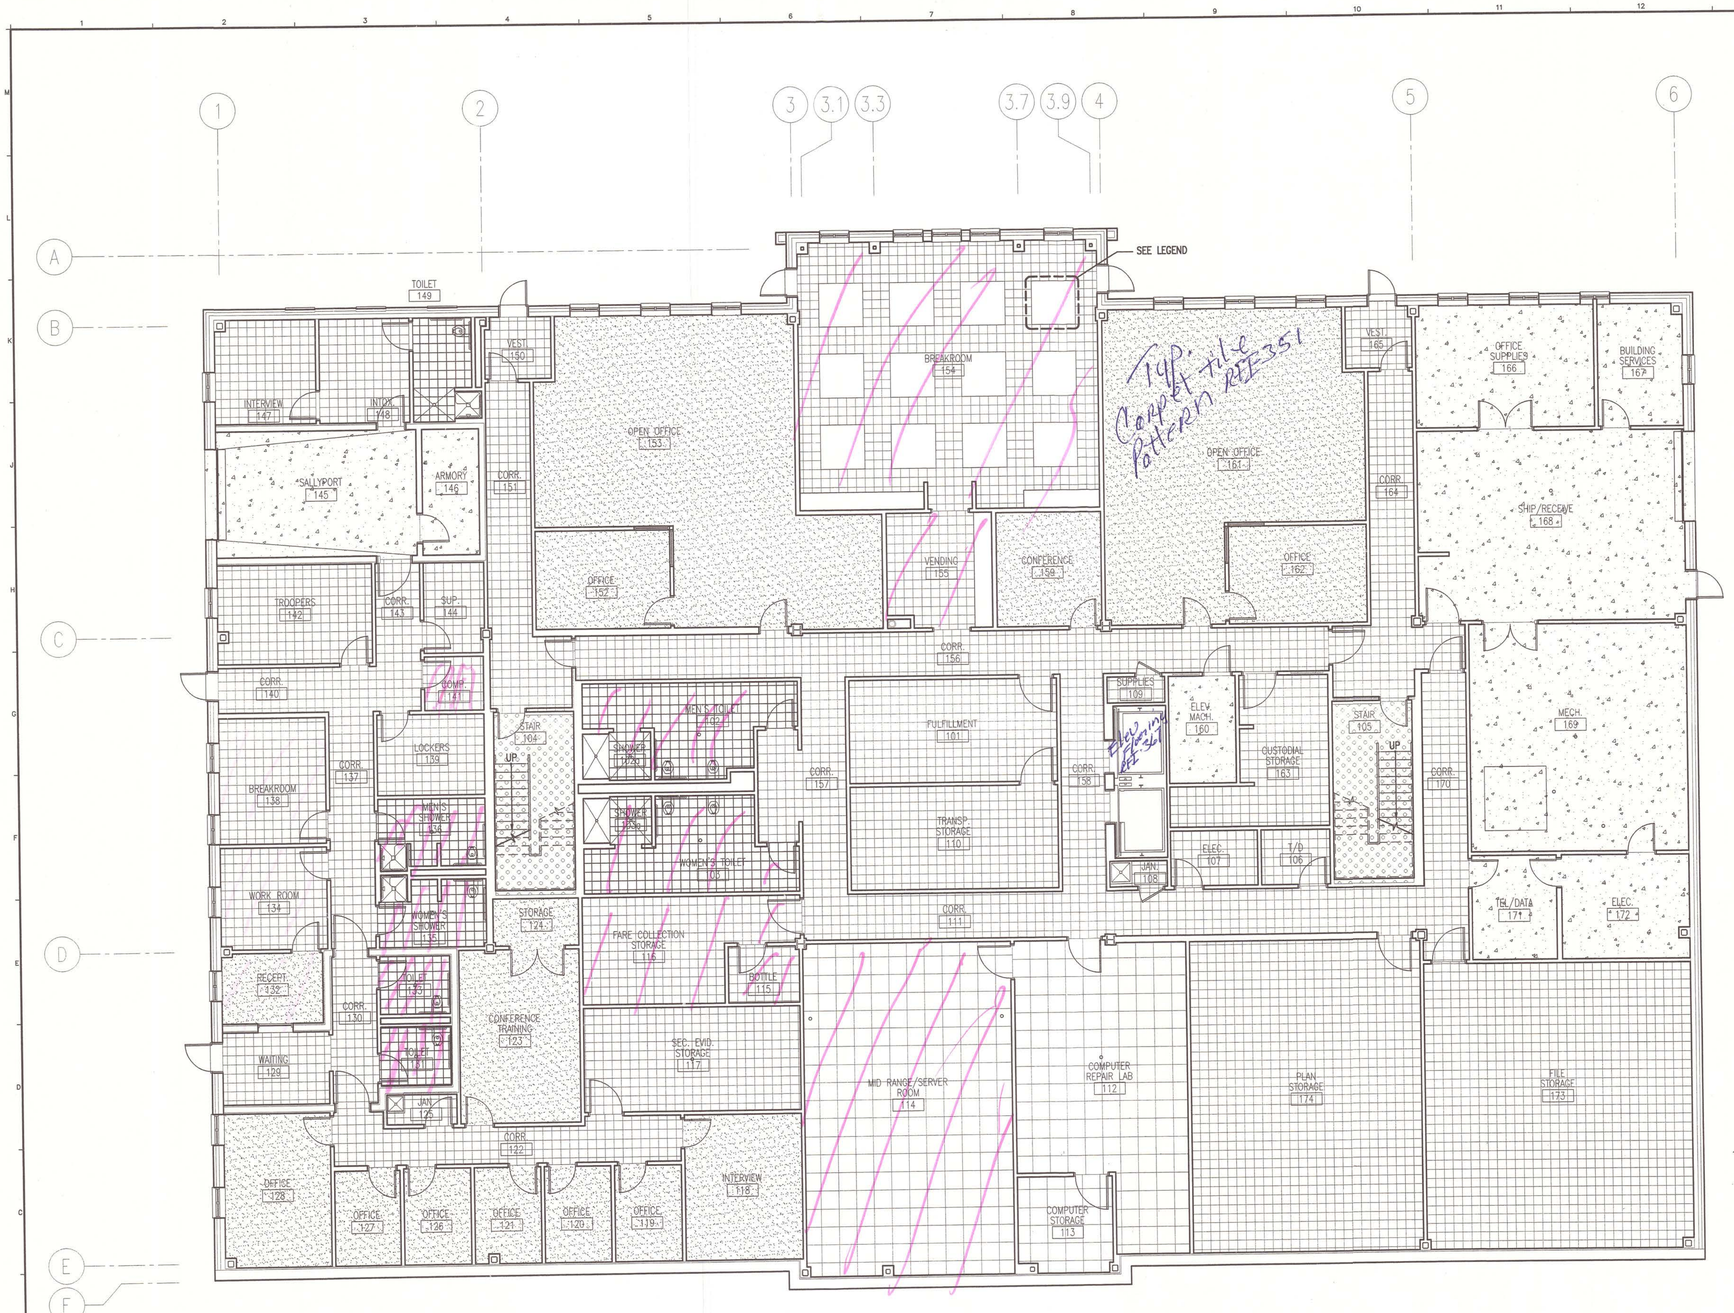

GENERAL NOTES:

1. SEE G1001 FOR PROJECT GENERAL NOTES.

REF-311 Conduits not Required to Be Painted in Elec Room's

Paint schedule- ST-60

LEGEND:

- VINYL COMPOSITION TILE (VCT-1)
- STONE TILE 1 (ST-1)
- STONE TILE 2 (ST-2)
- CERAMIC TILE (CT)
- CARPET (CPT-1 U.N.O.)
- RUBBER FLOORING
- SEALED CONCRETE (CONC)
- 2x2 STATIC DISSIPATIVE VINYL COMPOSITION TILE (SDVCT)

BREAKROOM VCT PATTERN

VCT-4	VCT-3	VCT-3	VCT-3	VCT-4
VCT-3	VCT-2	VCT-2	VCT-2	VCT-3
VCT-3	VCT-2	VCT-2	VCT-2	VCT-3
VCT-3	VCT-2	VCT-2	VCT-2	VCT-3
VCT-4	VCT-3	VCT-3	VCT-3	VCT-4

REF-276 VCT Colors

AS BUILT Owner Copy

SMRT
ARCHITECTURE ENGINEERING PLANNING
SMRT
144 Fore Street / P.O. Box 618
Portland, Maine 04104
tel. (207) 772-3846
fax. (207) 772-1070

STATE OF MAINE SCOTT L BENSON No. 1772 REGISTERED PROFESSIONAL ARCHITECT

PROJECT NORTH
MAG. NORTH

PROJECT TITLE: MAINE TURNPIKE AUTHORITY ADMINISTRATION BUILDING PORTLAND, MAINE

CURRENT ISSUE STATUS: ISSUED FOR BIDDING/CONSTRUCTION 7-9-07

REV	DESCRIPTION	DATE
0	BIDDING/CONSTRUCTION	7-9-07

GRAPHIC SCALE: 0" 1"

SCALE: AS NOTED
PROJECT MANAGER: SLB
JC/DRAWN BY: TCM/PJP
A/E OF RECORD: SLB
CAD FILE: AF101-06016
PROJECT NO: 06016
DATE: 7-9-07

SHEET TITLE: FIRST FLOOR FINISH PLAN

SHEET No. AF101

© COPYRIGHT 2007 SMRT INC.

A1 FIRST FLOOR FINISH PLAN

1/8" = 1'-0"

Poston Flooring Plan

Rick Paulison

From: Derek Converse [dconverse@wright-ryan.com]
Sent: Friday, July 18, 2008 9:04 AM
To: 'Scott Benson'
Cc: 'Rick Paulison'; 'Laurie Warhol'; 'Charles Myers'; 'Warchol, Scott A.'
Subject: RE: MTA RFI #133 Response

Scott:

We will proceed as noted below with no cost impacts to the owner. Thanks.

Derek

From: Scott Benson [mailto:SBenson@SMRTInc.com]
Sent: Monday, June 23, 2008 5:21 PM
To: Derek Converse
Cc: Rick Paulison; Laurie Warhol; Charles Myers; Warchol, Scott A.
Subject: RE: MTA RFI #133 Response

hi derek: with the understanding that no cost to the owner is proposed, smrt accepts wrc's recommendations as described below with one exception, that exception being the use of a stone transition along the line separating the stone tile on the lobby floor from the carpeted waiting areas located on both sides of the vestibule. the transition pieces will be made from the same dark stone as the accent tile, will run from column to column the entire width of the waiting areas, and will be 4" wide and a min. of 2'-0" long with a 3/16" high 45 degree bevel on that edge of the transition facing the carpeted waiting area. thank you for your concern for these details. please verify how wrc would like to proceed. regards, scott

-----Original Message-----
From: Derek Converse [mailto:dconverse@wright-ryan.com]
Sent: Monday, June 23, 2008 2:46 PM
To: Scott Benson
Cc: Rick Paulison
Subject: MTA RFI #133 Response

Scott:

In your response to RFI #133, you noted that you would like for the slab to be depressed 1/4" at the locations to receive stone tile.

We feel this approach is not the best approach to address the flooring thickness difference. We believe this construction joint could result in potential slab problems and maintenance problems down the road.

In lieu of placing two separate placements on the 2nd floor, we would like to place the 2nd floor in one placement all at the same elevation. At areas where the stone tile abuts a different flooring material, we would propose to use Ardex Feather Finish (or other such system as approved by SMRT and Paul White Tile) out for a distance of 6-8 feet to create a smooth transition between the two systems. Please also note that the difference will actually be closer to 3/16" and not 1/4".

Thanks for your consideration. Call me if you have any questions.

Sincerely,

7/21/2008

From: Scott Benson [SBenson@SMRTInc.com]
Sent: Monday, June 23, 2008 5:21 PM
To: Derek Converse
Cc: Rick Paulison; Laurie Warhol; Charles Myers; Warchol, Scott A.
Subject: RE: MTA RFI #133 Response

hi derek: with the understanding that no cost to the owner is proposed, smrt accepts wrc's recommendations as described below with one exception, that exception being the use of a stone transition along the line separating the stone tile on the lobby floor from the carpeted waiting areas located on both sides of the vestibule. the transition pieces will be made from the same dark stone as the accent tile, will run from column to column the entire width of the waiting areas, and will be 4" wide and a min. of 2'-0" long with a 3/16" high 45 degree bevel on that edge of the transition facing the carpeted waiting area. thank you for your concern for these details. please verify how wrc would like to proceed. regards, scott

-----Original Message-----
From: Derek Converse [mailto:dconverse@wright-ryan.com]
Sent: Monday, June 23, 2008 2:46 PM
To: Scott Benson
Cc: Rick Paulison
Subject: MTA RFI #133 Response

Scott:

In your response to RFI #133, you noted that you would like for the slab to be depressed 1/4" at the locations to receive stone tile.

We feel this approach is not the best approach to address the flooring thickness difference. We believe this construction joint could result in potential slab problems and maintenance problems down the road.

In lieu of placing two separate placements on the 2nd floor, we would like to place the 2nd floor in one placement all at the same elevation. At areas where the stone tile abuts a different flooring material, we would propose to use Ardex Feather Finish (or other such system as approved by SMRT and Paul White Tile) out for a distance of 6-8 feet to create a smooth transition between the two systems. Please also note that the difference will actually be closer to 3/16" and not 1/4".


Thanks for your consideration. Call me if you have any questions.

Sincerely,

Derek Converse, LEED® AP
Project Manager
P 207.773.3625x15
F 207.773.5173

No virus found in this incoming message.
Checked by AVG.
Version: 7.5.524 / Virus Database: 270.4.1/1516 - Release Date: 6/24/2008 7:53 AM

6/24/2008

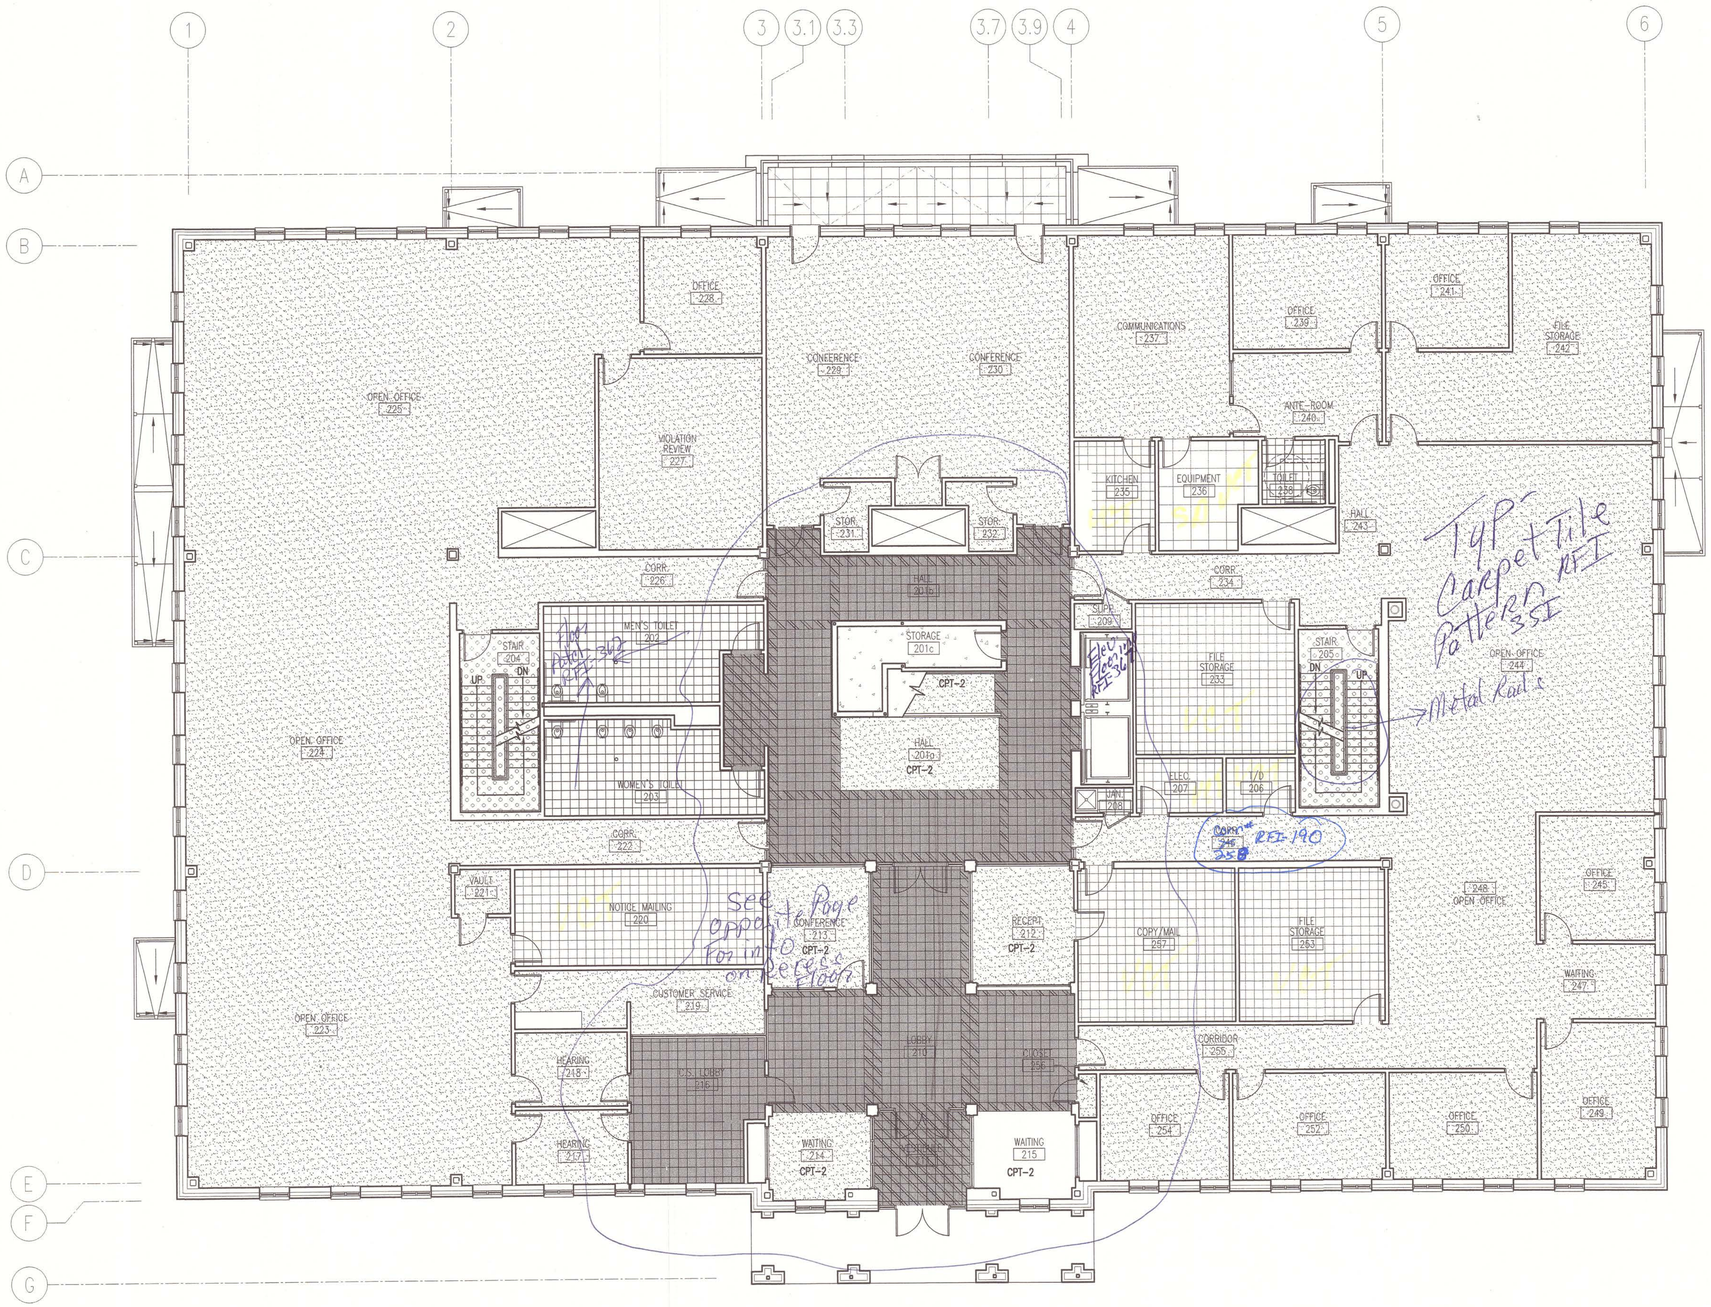

GENERAL NOTES:

1. SEE GI001 FOR PROJECT GENERAL NOTES.

Paint schedule - SI-60

Typ Carpet Tile per SI

Metal Rails

LEGEND:

- VINYL COMPOSITION TILE (VCT-1)
- STONE TILE 1 (ST-1)
- STONE TILE 2 (ST-2)
- CERAMIC TILE (CT)
- CARPET (CPT-1 U.N.O.)
- RUBBER FLOORING
- SEALED CONCRETE (CONC)
- 2x2 STATIC DISSIPATIVE VINYL COMPOSITION TILE (SDVCT)

AS BUILT Owner Copy

A1	SECOND FLOOR FINISH PLAN
1/8" = 1'-0"	–

SMRT
ARCHITECTURE ENGINEERING PLANNING
SMRT
144 Fore Street/P.O. Box 618
Portland, Maine 04104
tel. (207) 772-3846
fax. (207) 772-1070

STATE OF MAINE SCOTT L BENSON No. 1772 REGISTERED PROFESSIONAL ARCHITECT

PROJECT NORTH
MAG. NORTH

PROJECT TITLE:
MAINE TURNPIKE AUTHORITY ADMINISTRATION BUILDING
PORTLAND, MAINE

CURRENT ISSUE STATUS:
ISSUED FOR BIDDING/CONSTRUCTION 7-9-07

REV	DESCRIPTION	DATE
0	BIDDING/CONSTRUCTION	7-9-07


GRAPHIC SCALE: 0" 1"

SCALE:	AS NOTED
PROJECT MANAGER:	SLB
JC/DRAWN BY:	TCM/PJP
A/E OF RECORD:	SLB
CAD FILE:	AF102-06016
PROJECT NO:	06016
DATE:	7-9-07

SHEET TITLE:
SECOND FLOOR FINISH PLAN

SHEET No.
AF102

© COPYRIGHT 2007 SMRT INC.

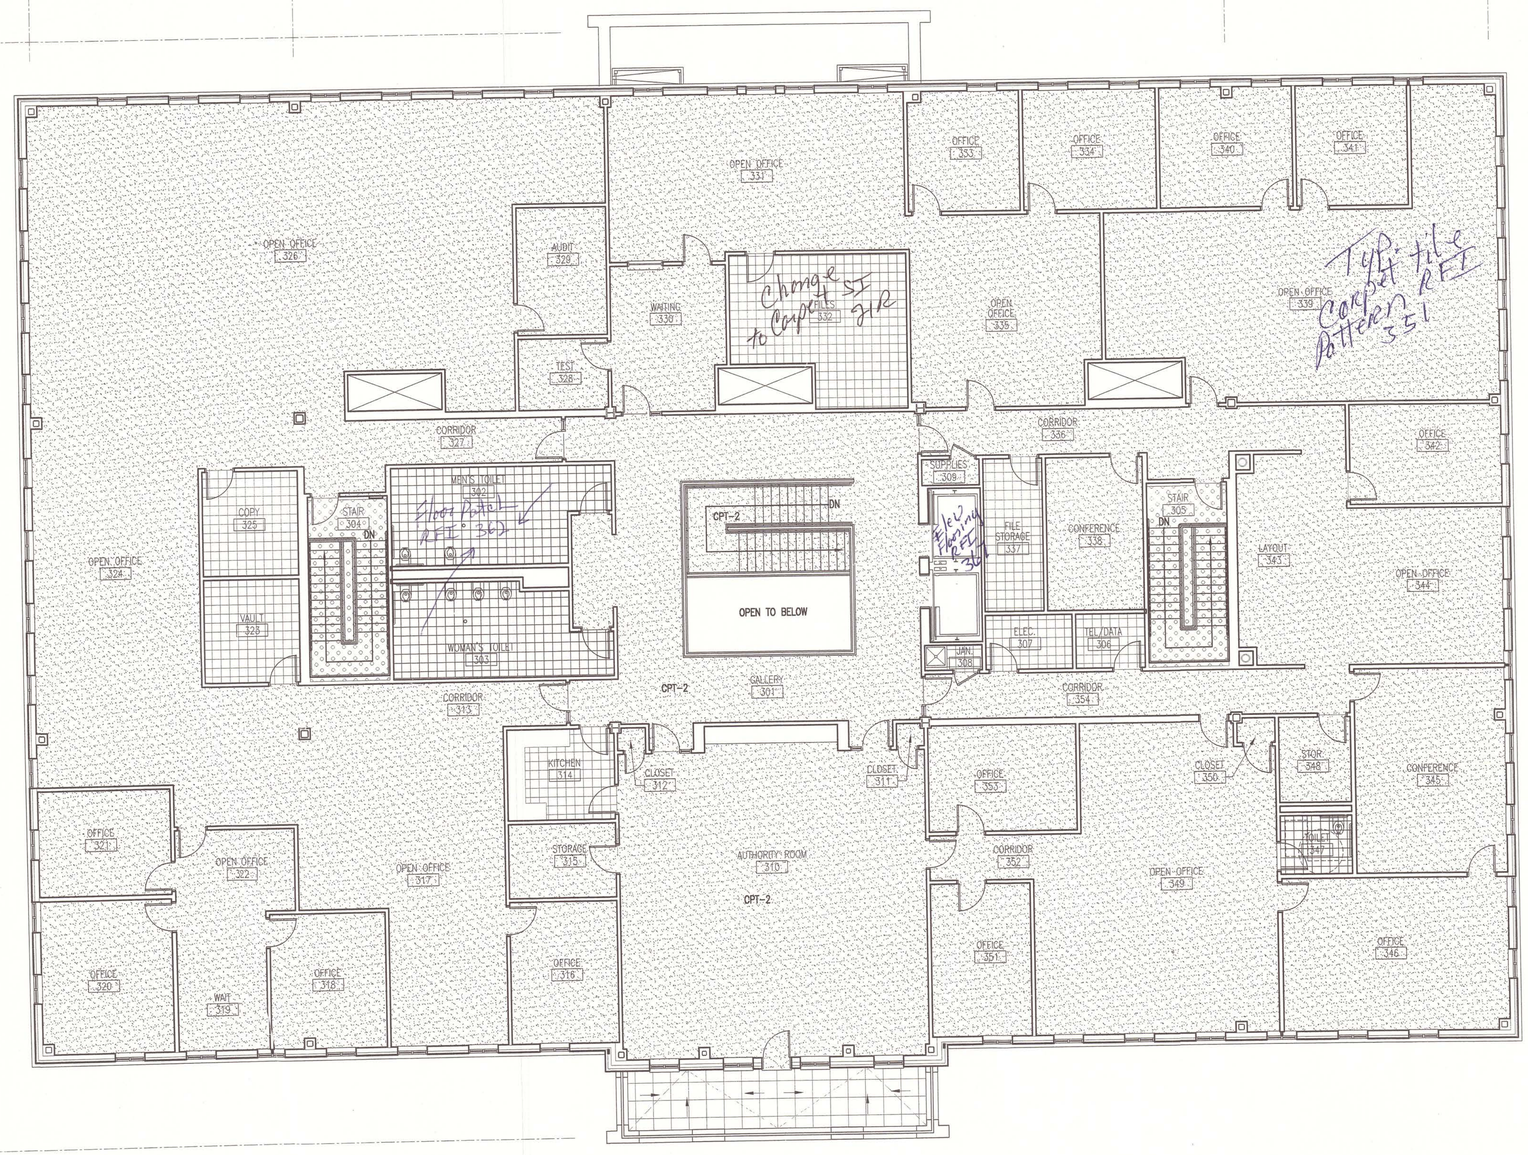

GENERAL NOTES:

1. SEE GI001 FOR PROJECT GENERAL NOTES.

Paint Schedule - see SI-60

LEGEND:

- VINYL COMPOSITION TILE (VCT-1)
- STONE TILE 1 (ST-1)
- STONE TILE 2 (ST-2)
- CERAMIC TILE (CT)
- CARPET (CPT-1 U.N.O.)
- RUBBER FLOORING
- SEALED CONCRETE (CONC)
- 2x2 STATIC DISSIPATIVE VINYL COMPOSITION TILE (SDVCT)

AS BUILT Owner Copy

A1	THIRD FLOOR FINISH PLAN
1/8" = 1'-0"	–

SMRT
ARCHITECTURE ENGINEERING PLANNING
SMRT
144 Fore Street / P.O. Box 618
Portland, Maine 04104
tel. (207) 772-3846
fax. (207) 772-1070

STATE OF MAINE SCOTT L BENSON No. 1772 REGISTERED PROFESSIONAL ARCHITECT

PROJECT NORTH
MAG. NORTH

PROJECT TITLE: MAINE TURNPIKE AUTHORITY ADMINISTRATION BUILDING
PORTLAND, MAINE

CURRENT ISSUE STATUS: ISSUED FOR BIDDING/CONSTRUCTION 7-9-07

REV	DESCRIPTION	DATE
0	BIDDING/CONSTRUCTION	7-9-07

GRAPHIC SCALE: 0" 1"

SCALE:	AS NOTED
PROJECT MANAGER:	SLB
JC/DRAWN BY:	TCM/PJP
A/E OF RECORD:	SLB
CAD FILE:	AF103-06016
PROJECT NO:	06016
DATE:	7-9-07

SHEET TITLE: THIRD FLOOR FINISH PLAN

SHEET No. AF103

©COPYRIGHT 2007 SMRT INC.